


KEY PLAN / SECTION

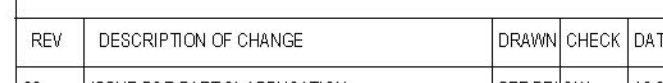

REV	DESCRIPTION OF CHANGE	DRAWN	CHECK	DATE
00	AS-BUILT			

KEY

	PUBLIC + VISITOR CIRCULATION		FUNCTIONAL AREA
	STAFF + PATIENT + SERVICE CIRCULATION		PLANT

GRAPHIC SCALE

QUANTITY SURVEYOR
RIDER LEVETT BUCKNALL

LEVEL 5 41 MCLAREN STREET
NORTH SYDNEY 2060

P: 02 9922 2277
F: 02 9957 4197
www.rlb.com

RLB

SERVICES ENGINEER
SINGL AIR KNIGHT MERZ

SKM 100 CHRISTIE STREET
ST LEONARDS 2065
P: 02 9928 2100
www.skm.com

STRUCTURAL ENGINEER

SCP CONSULTING

LEVEL 2 DANCHEN HOUSE 507 KENT STREET
SYDNEY 2000

P: 02 9267 9312
F: 02 9261 5871
www.szczepinski.com.au

 SZCZEPINSKI
ARCHITECTS
INTERIORS

PROJECT DIRECTOR

CAPITAL INSIGHT



LEVEL 6 77 BERRY STREET
NORTH SYDNEY 2165

P: 02 9955 2300
F: 02 9955 5574
www.capitalinsight.com.au

CLIENT
LIFEHOUSE

PO BOX M5 MISSENDEN ROAD
CAMPERDOWN 2050

P: 029515 6018
www.lifehouse.org.au



ARCHITECTS

RICE DAUBNEY

ANALYSING CREATING AND
IMPLEMENTING ARCHITECTURE

110 WALKER STREET | NORTH SYDNEY 2060
T: 02 9955 2686 | F: 02 9959 3015
rd@rice-daubney.com.au | www.rice-daubney.com.au

the rice daubney group (pwn)pty ltd - abs: 77 001 550 760
rice daubney trading trust - abs: 96 880 904 003



PROJECT:
The Chris O'Brien Lifehouse at RPA Stg A / B1
119 - 143 MISSENDEN ROAD
CAMPERDOWN
SYDNEY, NSW, 2050

DRAWING TITLE:


UPPER FLOOR PLANS
LEVEL 09

SCALE:	DRAWN:	CHECKED:
AS SHOWN	SA	AF

PROJECT NUMBER:	DRAWING NUMBER:	ISSUE:
08500	DA1300	00

teamwork: Wdrbm01GB500 MA

teamwork: N4dbim01.06500 MA

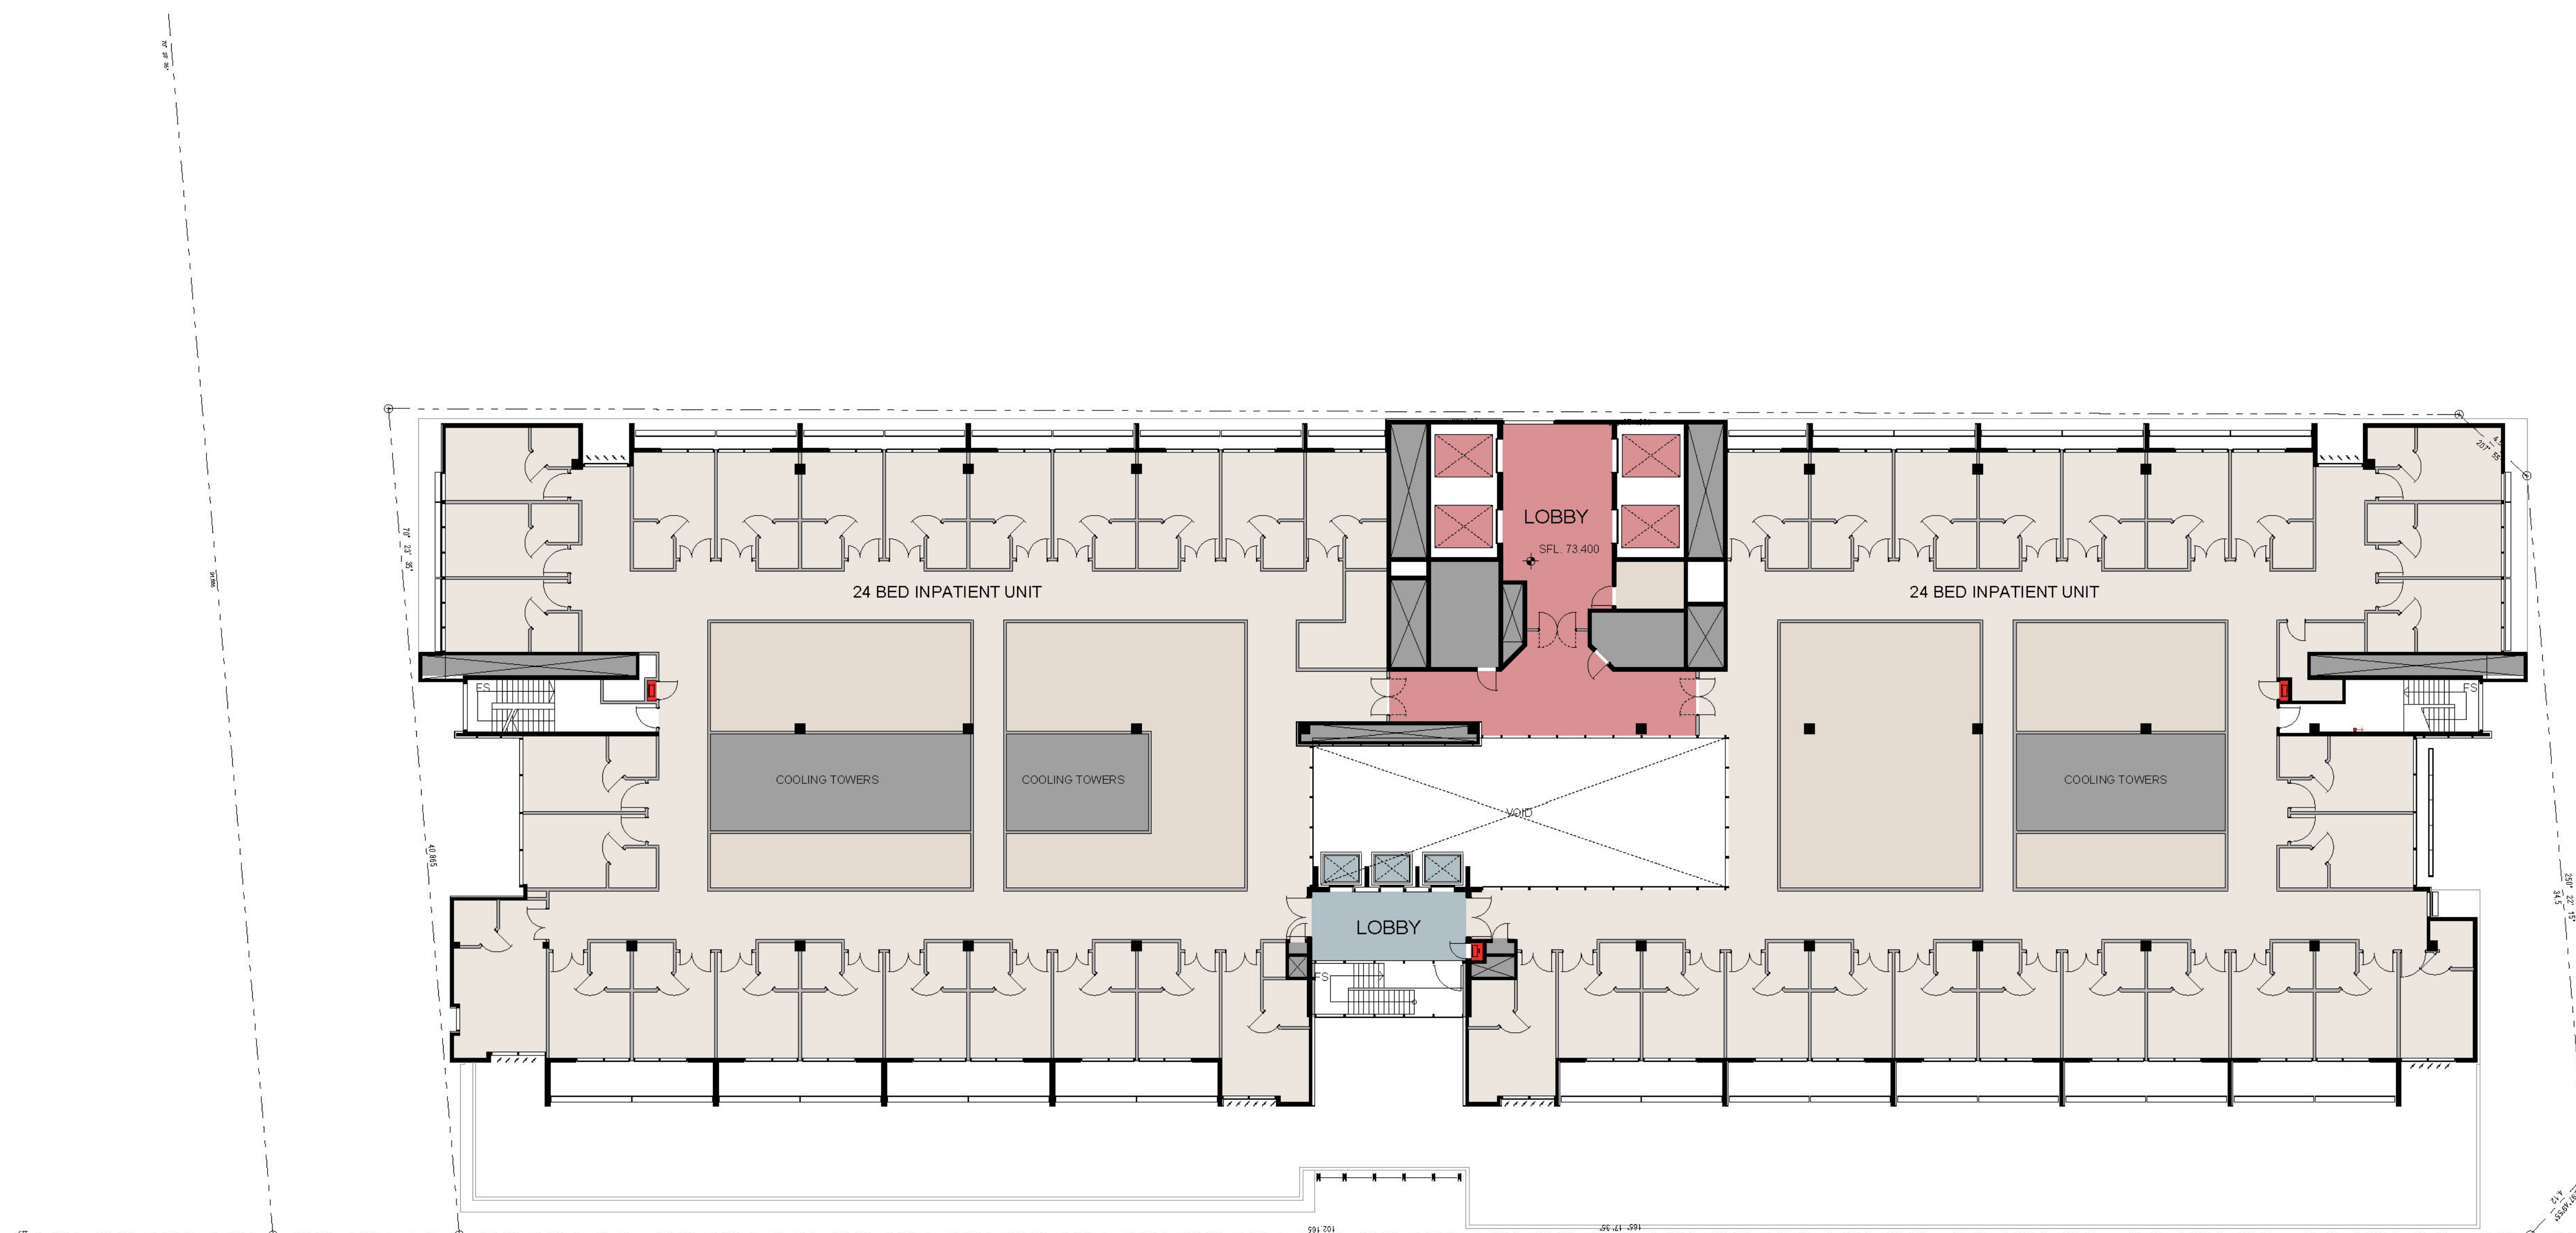

LEVEL 09

@ A1 - 1:200