



EXTERNAL FINISHES	
CONCRETE	
CN1	Concrete natural finish
CR1	Concrete render finish
RF1	Roof Finish - Grand
MASONRY	
PF1	Texture applied finish - White
PF2	Texture applied finish - Light Warm Grey
PF3	Texture applied finish - Dark Grey
ST1	Stone cladding - Stacked grey colour
ST2	Stone cladding - Sandstone Finish
GLAZING	
GL1	Clear Glass Windows
GL2	Louvre/ Clear Glass Windows
GL3	Obscure Glazing Balustrade
GL4	Feature Coloured Glass
GB1	Clear glass balustrade with Metal handrail
WG	Wintergarden
METALWORKS	
MB1	Metal Balustrade - Steel Galvanneal
MF1	Metal Finish - Window + Door Frames
MF2	Metal Finish - Shading blades
MF3	Metal Finish - Louvre screen
MS1	Metal Finish - Plant Screening
MS2	Metal Finish - Screen to apartment entries
TIMBER	
TC1	External cladding - Timber Boards
TB1	Timber Floor Boards - Natural Stain


NOTE: AS BUILT LEVELS MAY VARY +/- 30mm FROM NOTMINATED SSL's

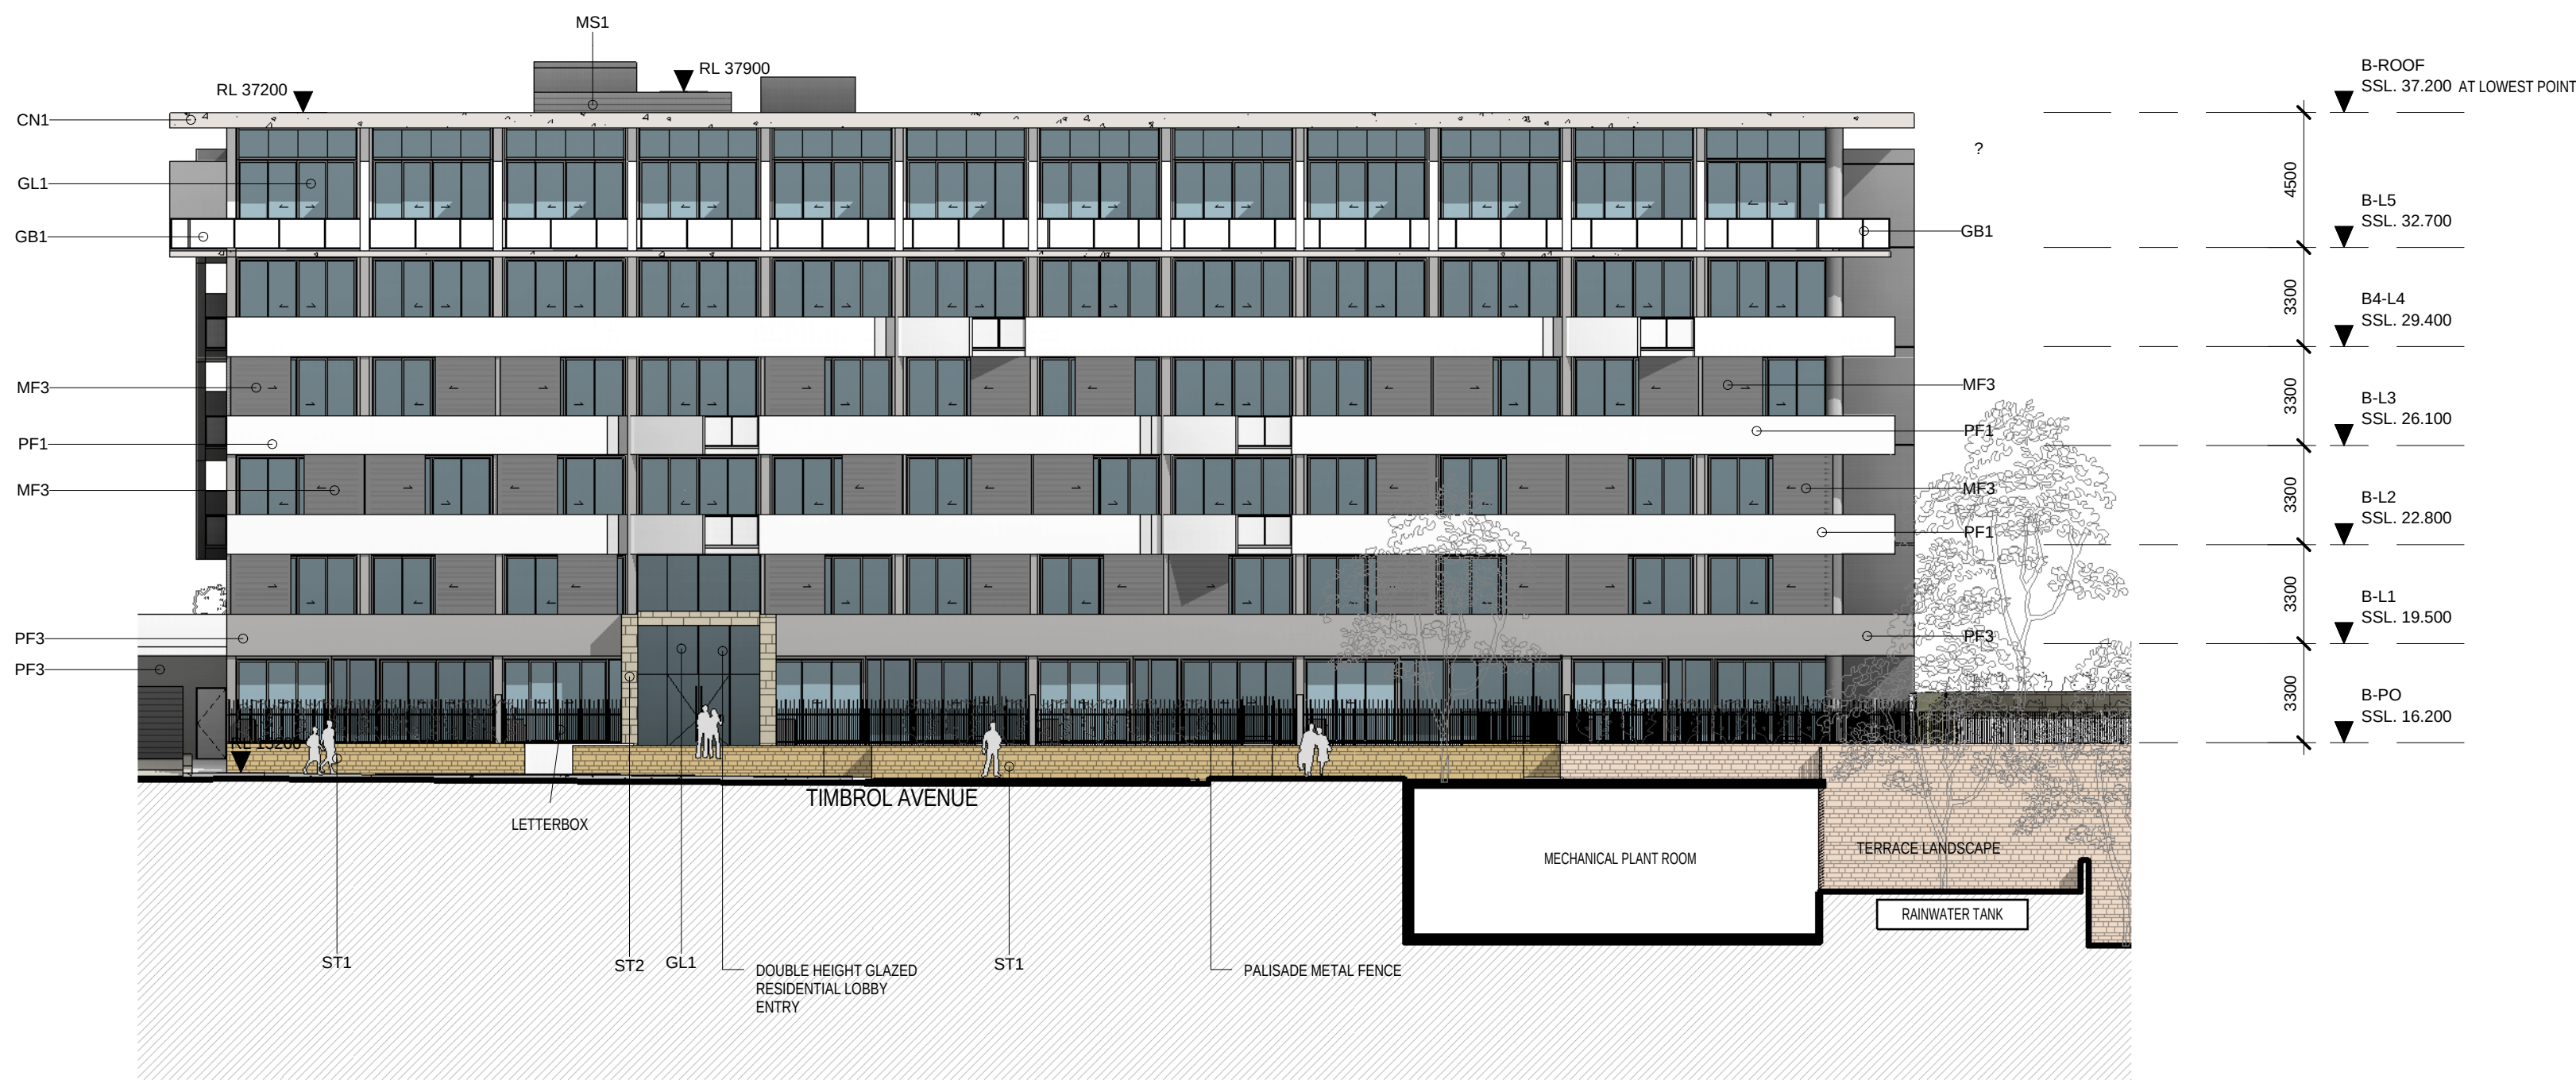


1 ELEVATION
BLDG B - NORTH
1 : 200

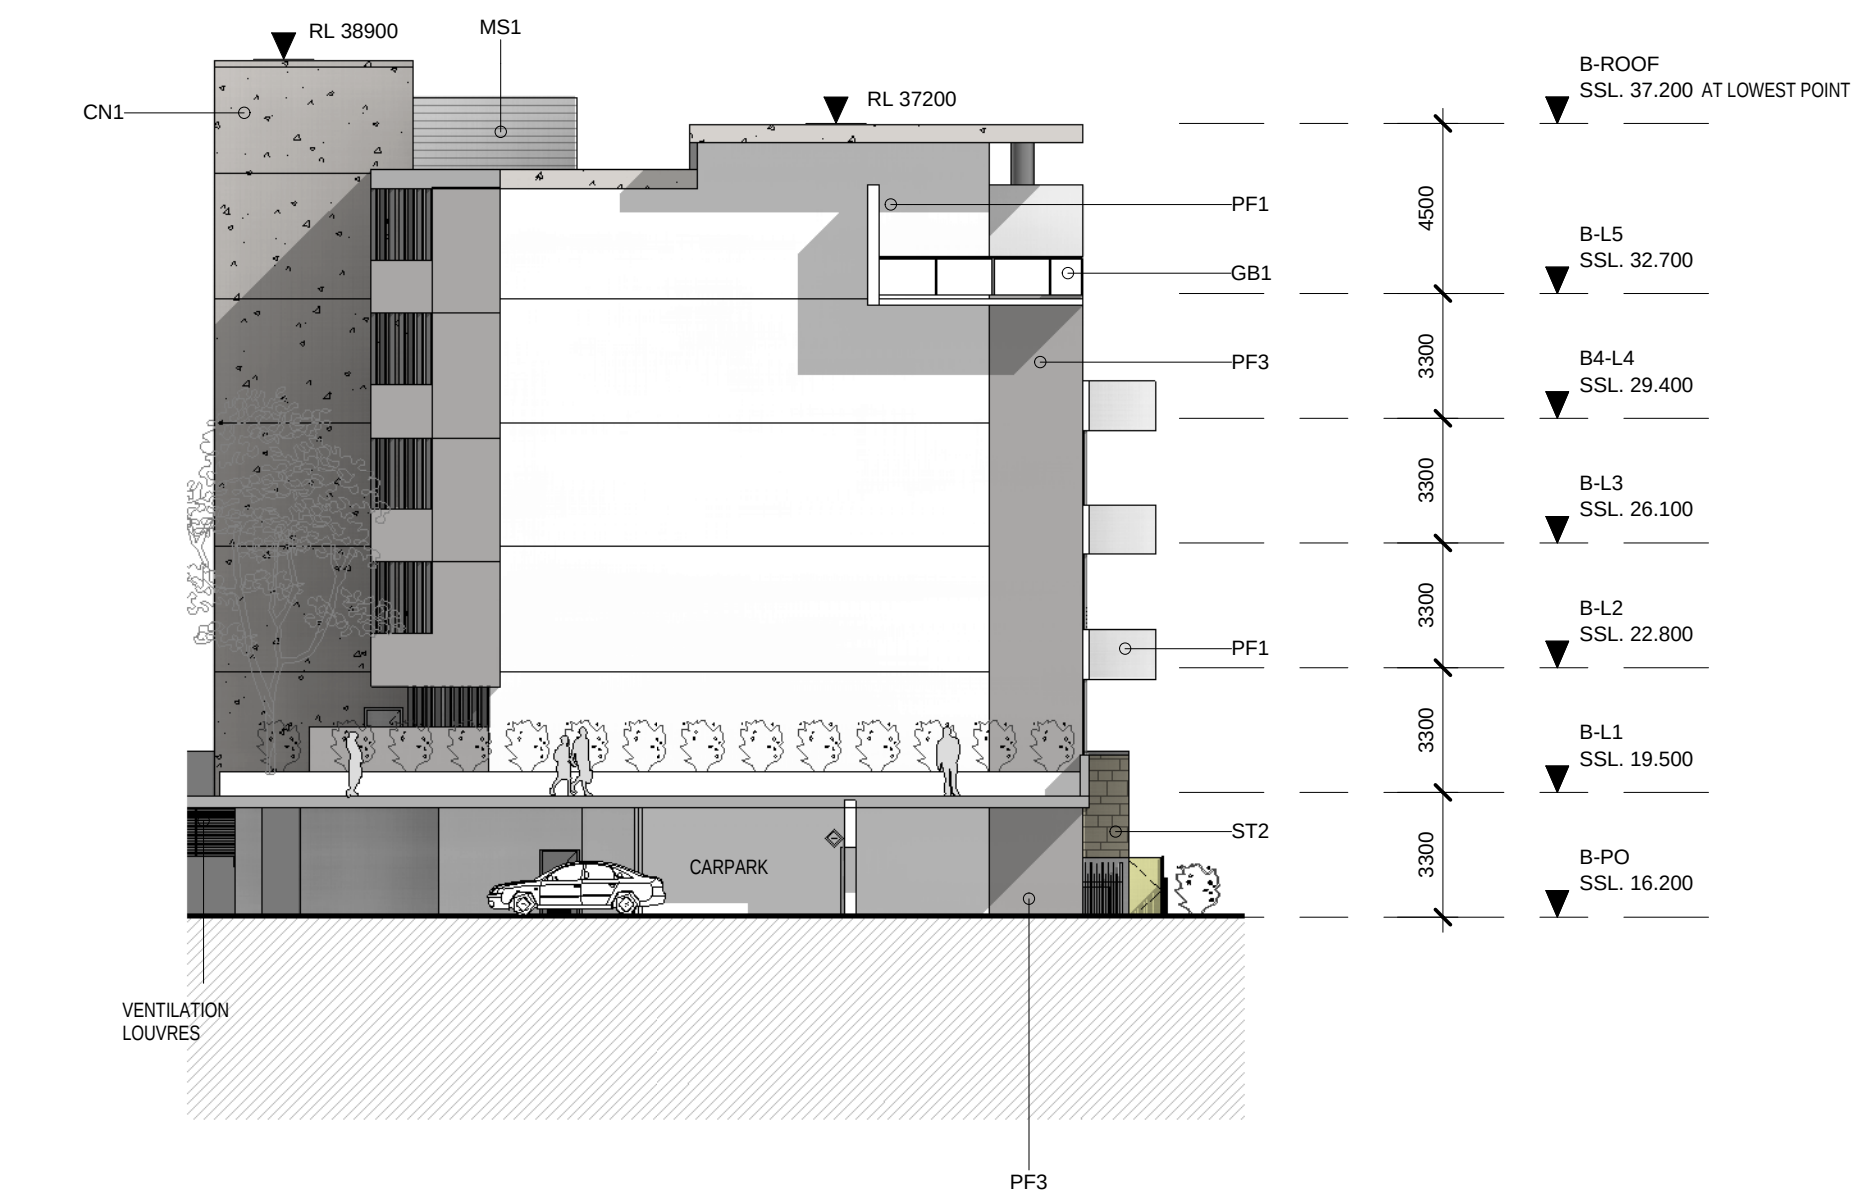


3 ELEVATION
BLDG B - EAST
1 : 200

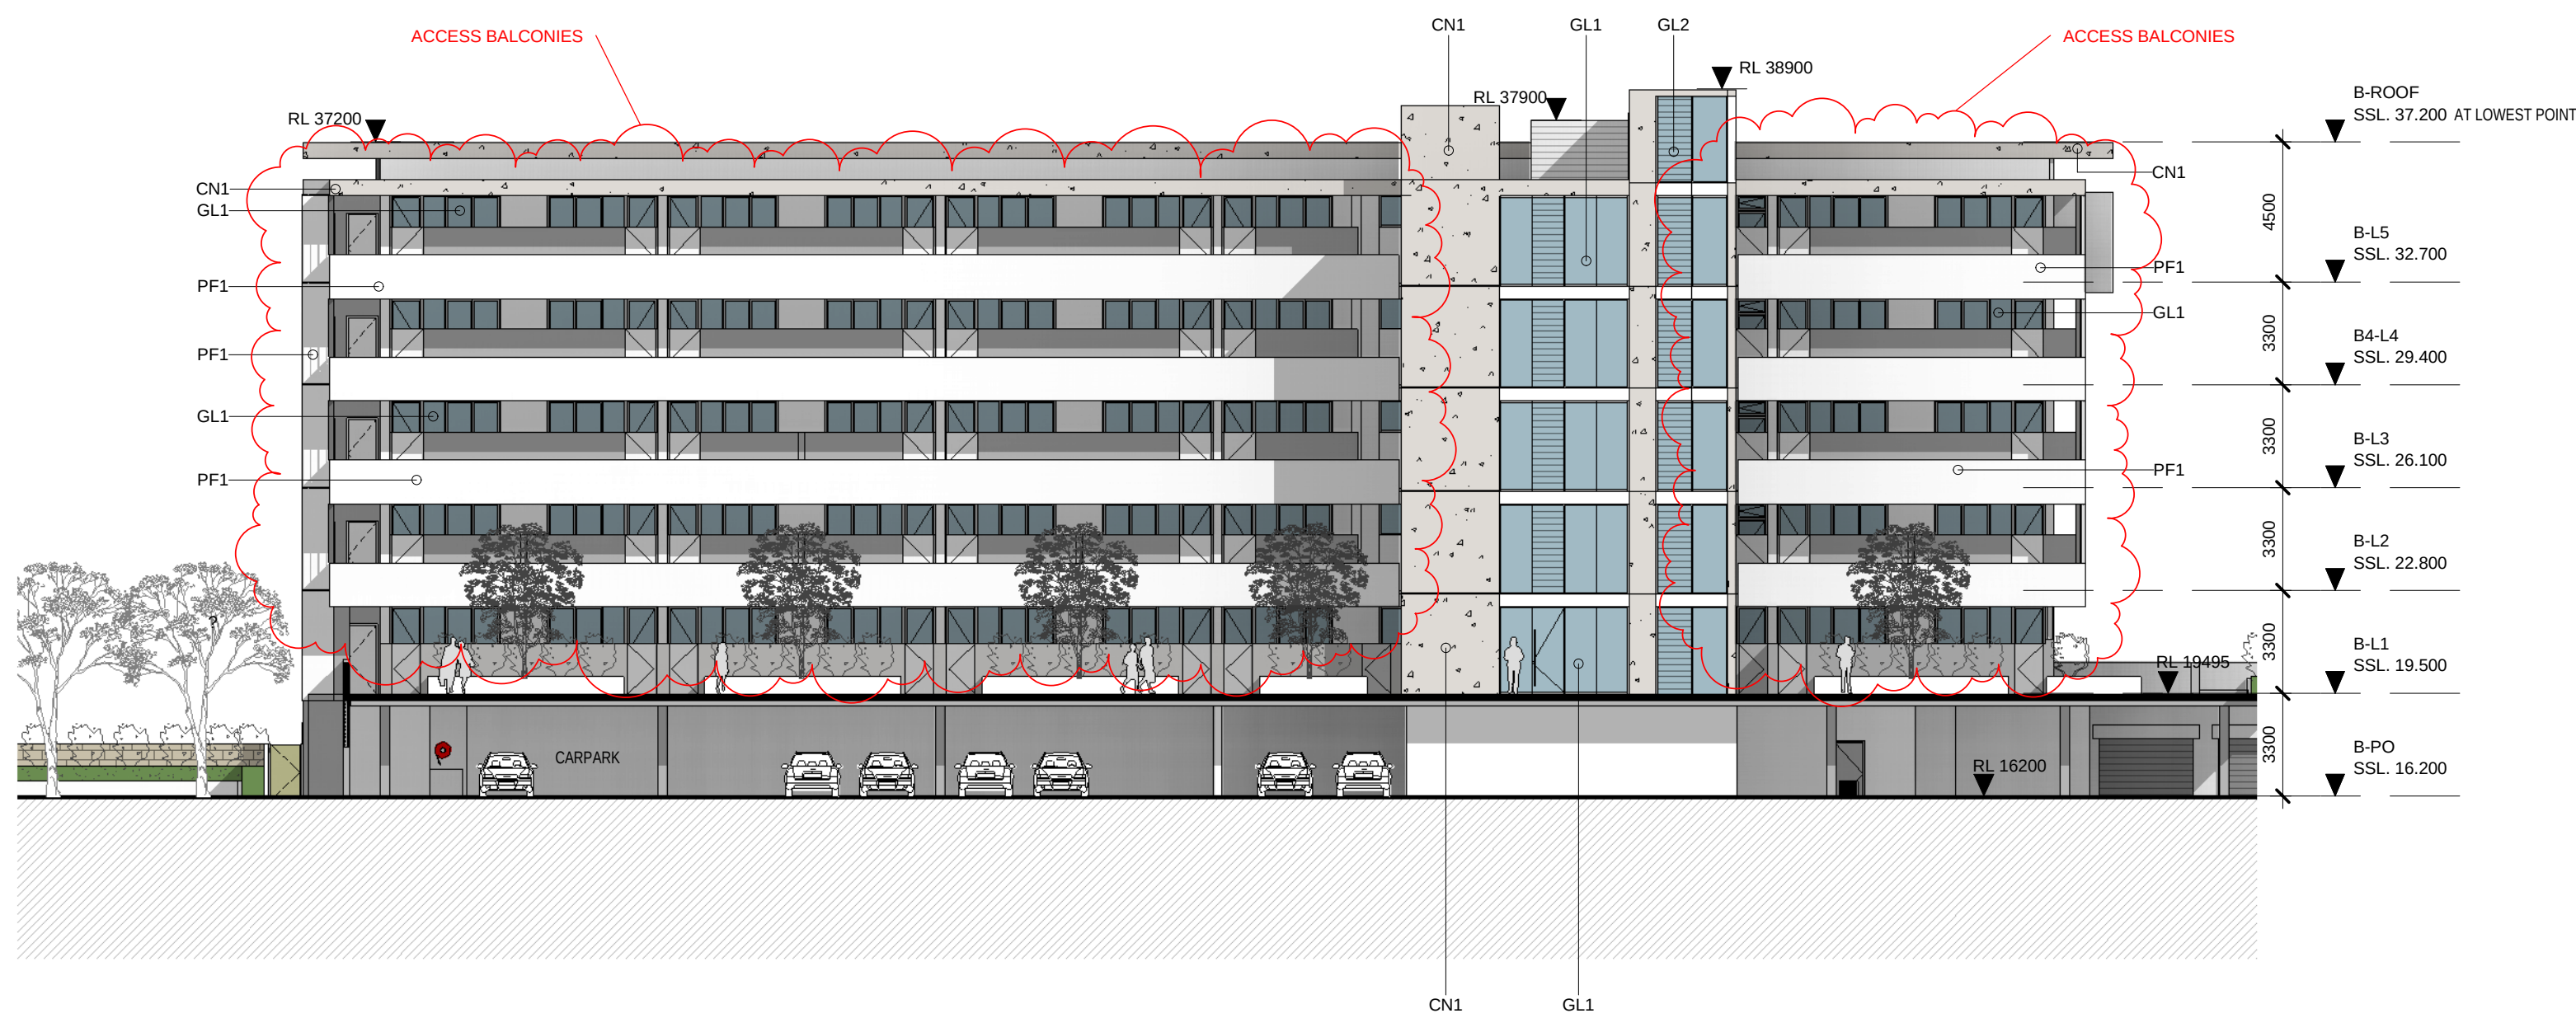

2 ELEVATION
BLDG B - SOUTH
1 : 200

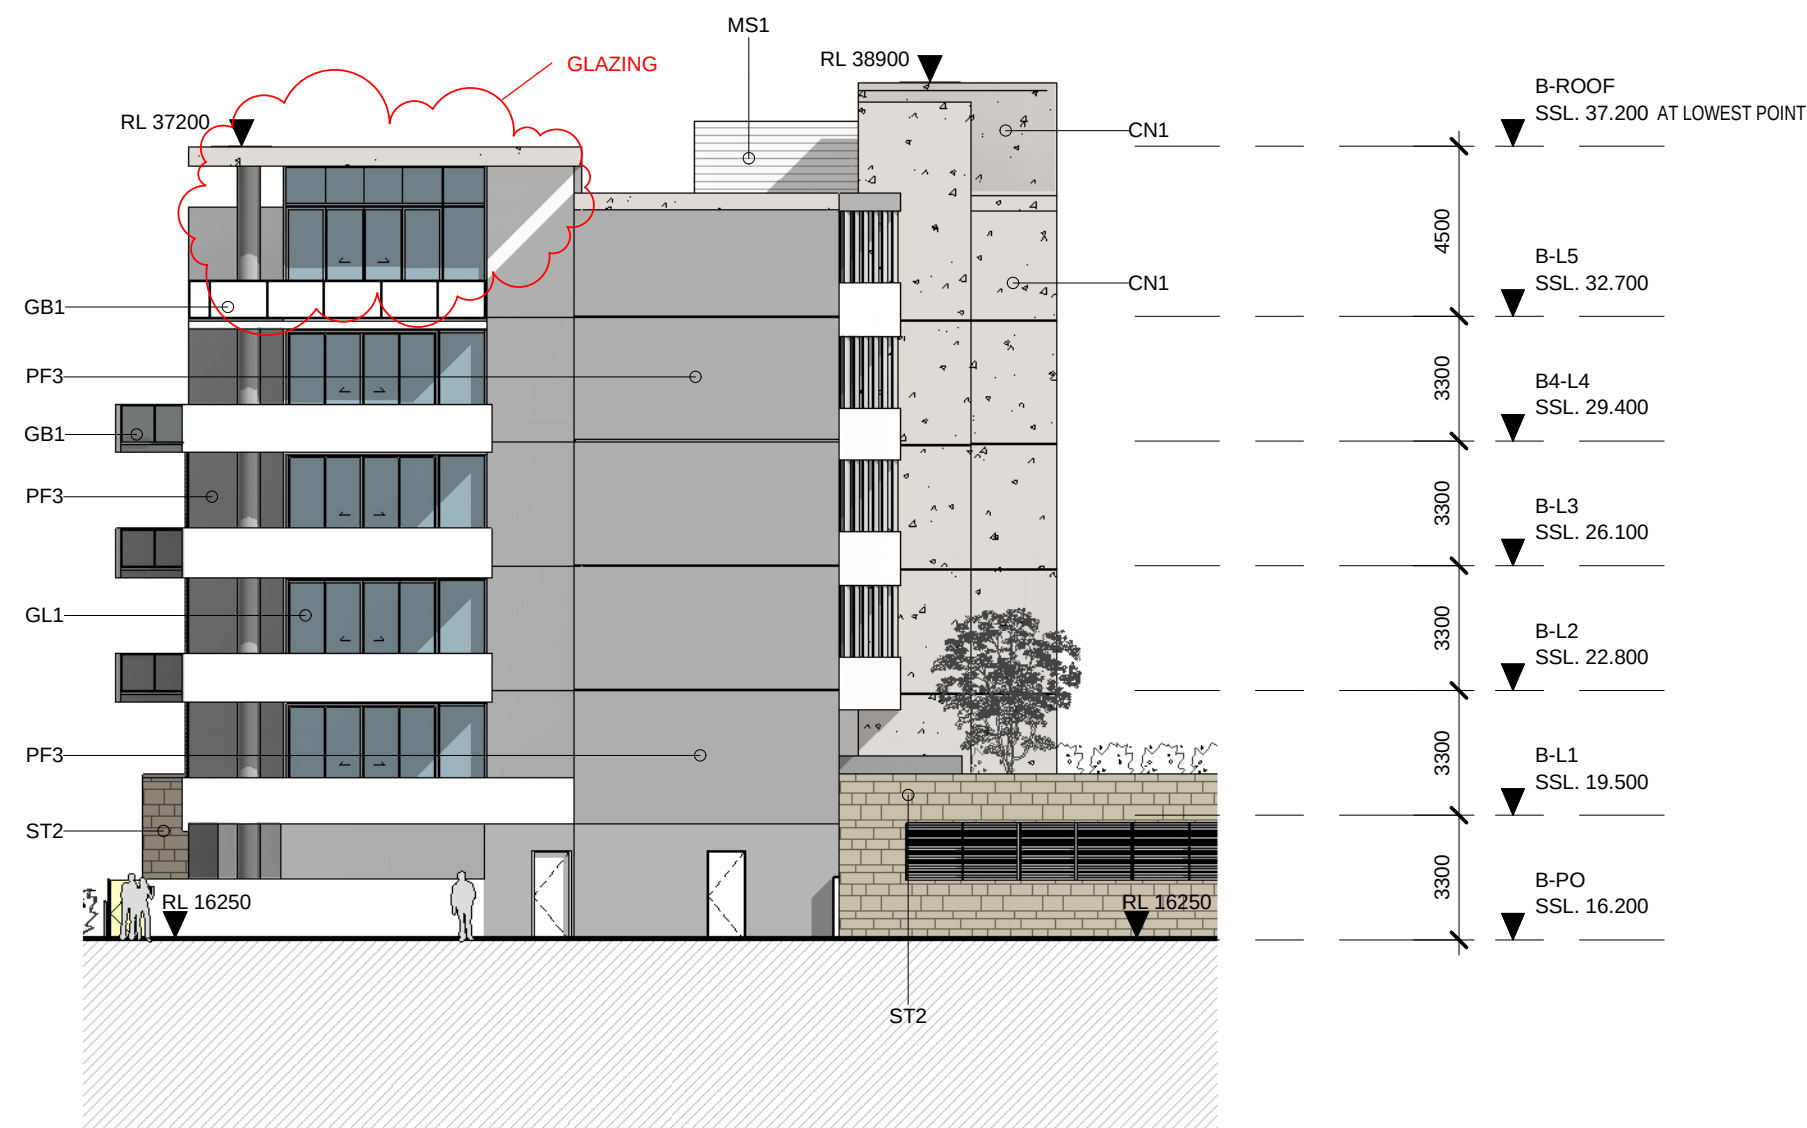

4 ELEVATION
BLDG B - WEST
1 : 200

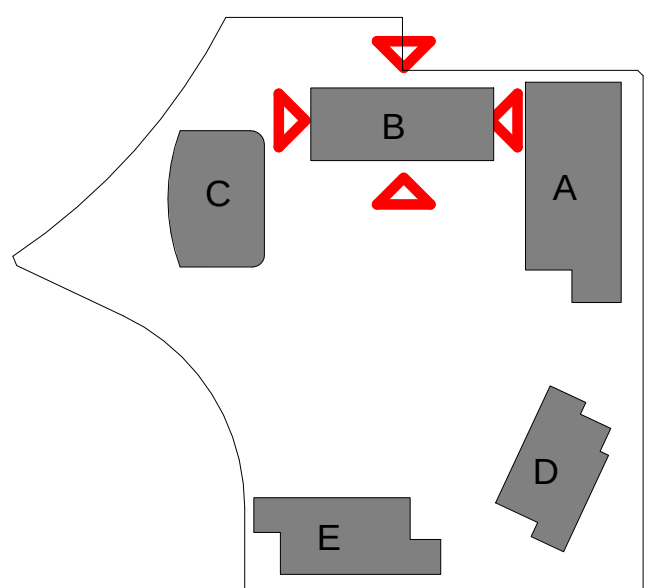

Client

Billbergia
creating communities®

Project

STAGE 2A + 3A
WALKER ST.
RHODES
for
Billbergia Developments

Drawing Name

Elevations - BLDG B
North, South, East & West

Date	Scale	Sheet Size
18.04.2012	1 : 200	@ B1
Reg No.	Drawn	Chk.
	MM/NH	JP
Job No.	Drawing No.	Revision
4410	A-0505	A-2