


Rev.	Date	Revision
A	12/11/2010	DA Test of Adequacy
A-1	22/02/2011	Preferred Project
A-2	15/04/2012	S75W - March 2012

	CONCRETE
CN1	Concrete natural finish
CR1	Concrete render finish
RF1	Roof Finish - Gravel
	MASONRY
PF1	Tonure applied finish - White
T2	Tonure applied finish - Light Warm Grey
PF2	Tonure applied finish - Dark Grey
ST1	Stone cladding - Sackled grey colour
ST2	Stone cladding - Sandstone Finish
	GLAZING
GL1	Clear Glass Windows
GL2	Lowered Clear Glass Windows
GL3	Obscure Glazing Balustrade
GL4	Feature Coloured Glass
GB1	Clear glass balustrade with Metal handrail
WO	Worktops
	METALWORK
MB1	Metal balustrade - Steel Galvanised
M2	Metal Finish - Window Door Frames
M3	Metal Finish - Window Blinds
M4	Metal Finish - Louvre screen
M5	Metal Finish - Plant Screening
MS2	Metal Finish - Screen to apartment entries

NOTE: AS BUILT LEVELS MAY VARY +/- 30mm FROM NOTMINATED SSL'S

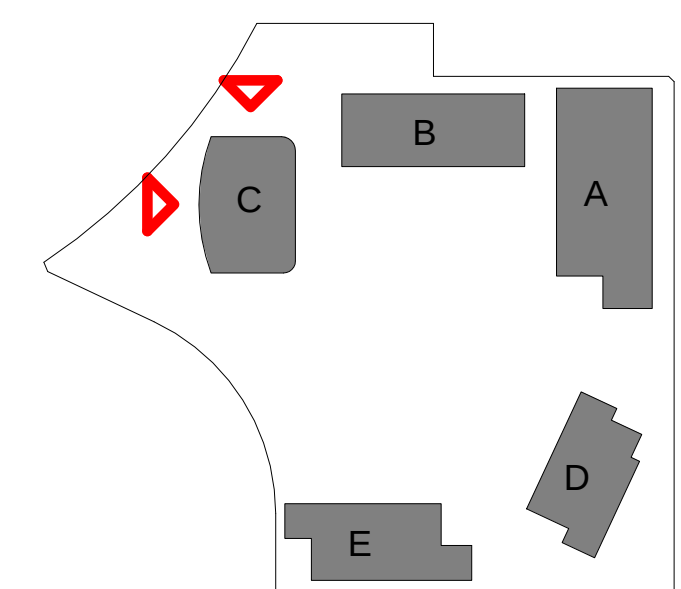

Client _____



Billbergia
creating communities®

Project

STAGE 2A + 3A
WALKER ST.
RHODES
for
Billbergia Developments

Drawing Name

Elevations - BLDG C
North & South

Date	Scale	Sheet Size
18.04.2012	1 : 200	@ B1
Reg No.	Drawn	Chk.
	MM/NH	JP
Job No.	Drawing No.	Revision



4410 A-0506 A-2

SJB Architects
Level 2, 490 Crown St
Surry Hills NSW
2010 Australia
T 61 2 9380 9911
F 61 2 9380 9922
www.sjb.com.au

Nominated Architects
Adam Haddow 7188
John Pradel 7004

A large, bold, black logo consisting of the letters 'SJB' in a highly stylized, rounded, and interconnected font. The 'S' and 'J' are particularly thick and rounded, while the 'B' is also very bold and rounded, creating a cohesive and modern monogram.

1 ELEVATION
BLDG C - NORTH 1:200

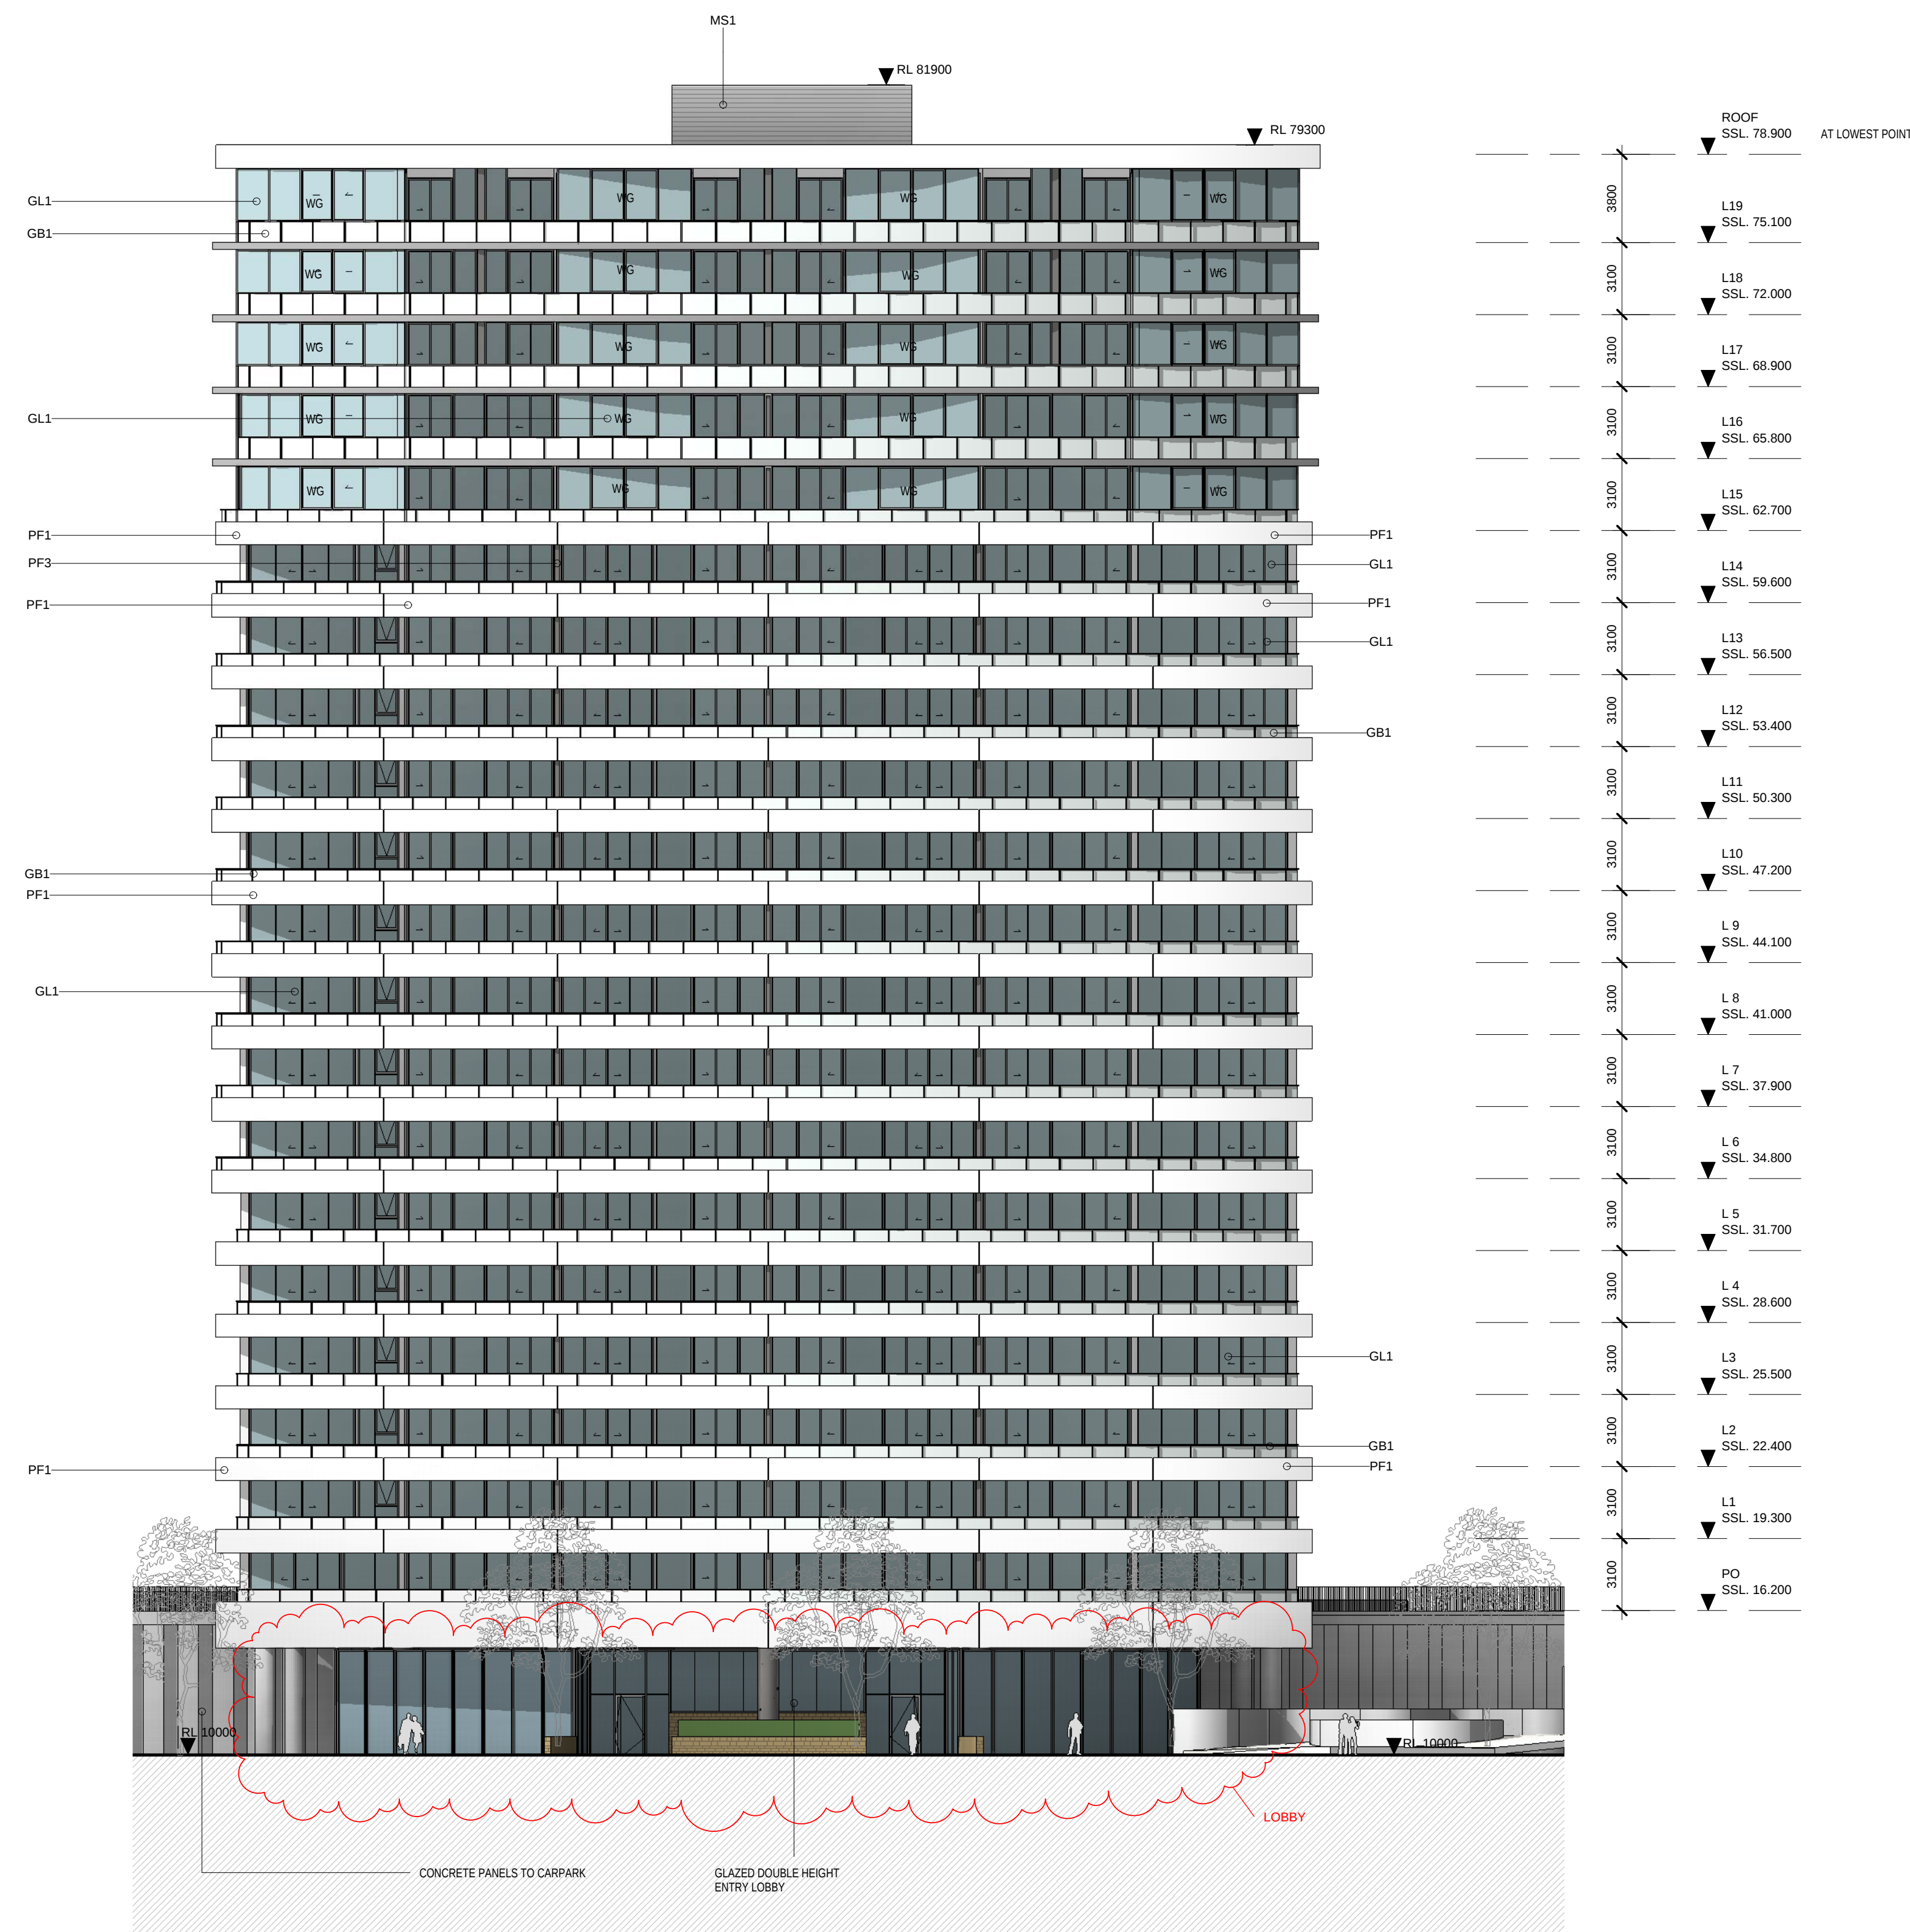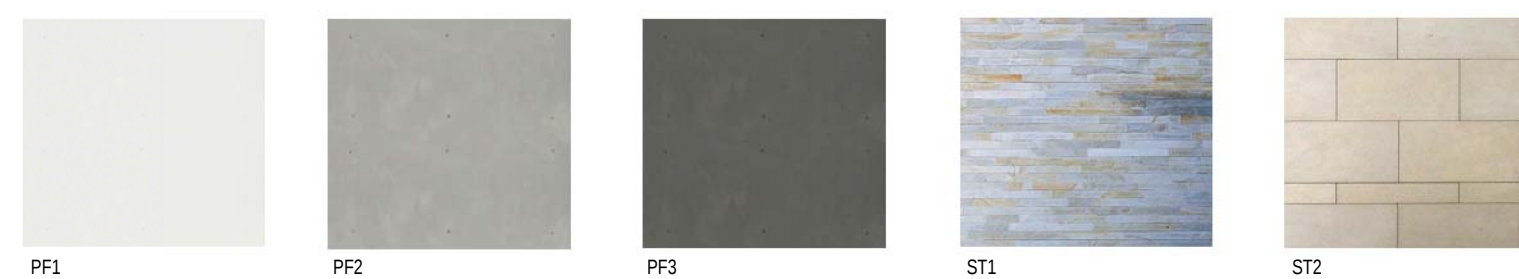

3 ELEVATION
BLDG C - WEST 1:200