


## S75W - FOR APPROVAL

| CONCRETE   |                                            |
|------------|--------------------------------------------|
| CN1        | Concrete natural finish                    |
| CRL        | Concrete render finish                     |
| RF1        | Roof Finish - Grand                        |
| MASONRY    |                                            |
| PF1        | Texture applied finish - White             |
| PF2        | Texture applied finish - Light Warm Grey   |
| PF3        | Texture applied finish - Dark Grey         |
| ST1        | Stone cladding - Stacked grey colour       |
| ST2        | Stone cladding - Sandstone Finish          |
| GLAZING    |                                            |
| GL1        | Clear Glass Windows                        |
| GL2        | Louvered Clear Glass Windows               |
| GL3        | Obscure Glazing Balustrade                 |
| GL4        | Feature Coloured Glass                     |
| GB1        | Clear glass balustrade with Metal handrail |
| WG         | Wintergarden                               |
| METALWORKS |                                            |
| MB1        | Metal Balustrade - Steel Galvanised        |
| MF1        | Metal Finish - Window + Door Frames        |
| MF2        | Metal Finish - Shading blades              |
| MF3        | Metal Finish - Louvre screen               |
| MS1        | Metal Finish - Plant Screening             |
| MS2        | Metal Finish - Screen to apartment entries |
| TIMBER     |                                            |
| TC1        | External cladding - Timber Boards          |
| TB1        | Timber Floor Boards - Natural Stain        |

NOTE: AS BUILT LEVELS MAY VARY +/- 30mm FROM NOTIMATED SSL'S

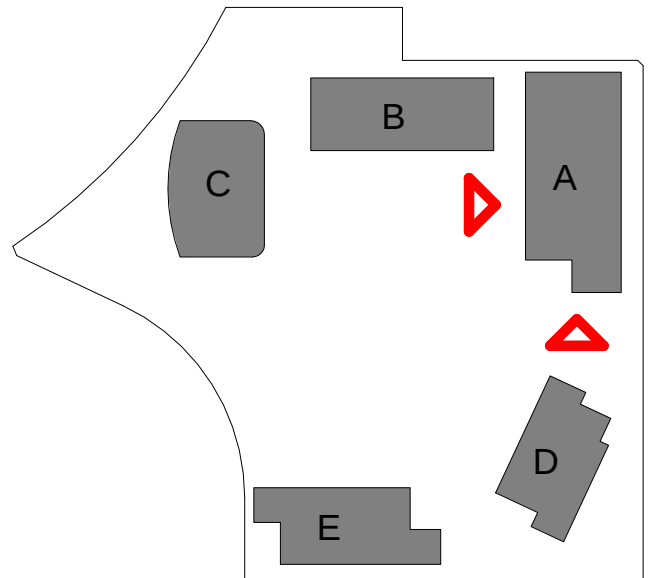

Client

**Billbergia**  
creating communities®

Project

**STAGE 2A + 3A  
WALKER ST.  
RHODES  
for  
Billbergia Developments**


Drawing Name

**Elevations - BLDG A  
East & West**

| Date       | Scale       | Sheet Size |
|------------|-------------|------------|
| 22.10.2004 | 1 : 200     | @ B1       |
| Reg No.    | Drawn       | Chk.       |
|            | JT          | JP         |
| Job No.    | Drawing No. | Revision   |
| 4410       | A-0504      | A-5        |



**1 ELEVATION**  
BLDG A - SOUTH  
1 : 200

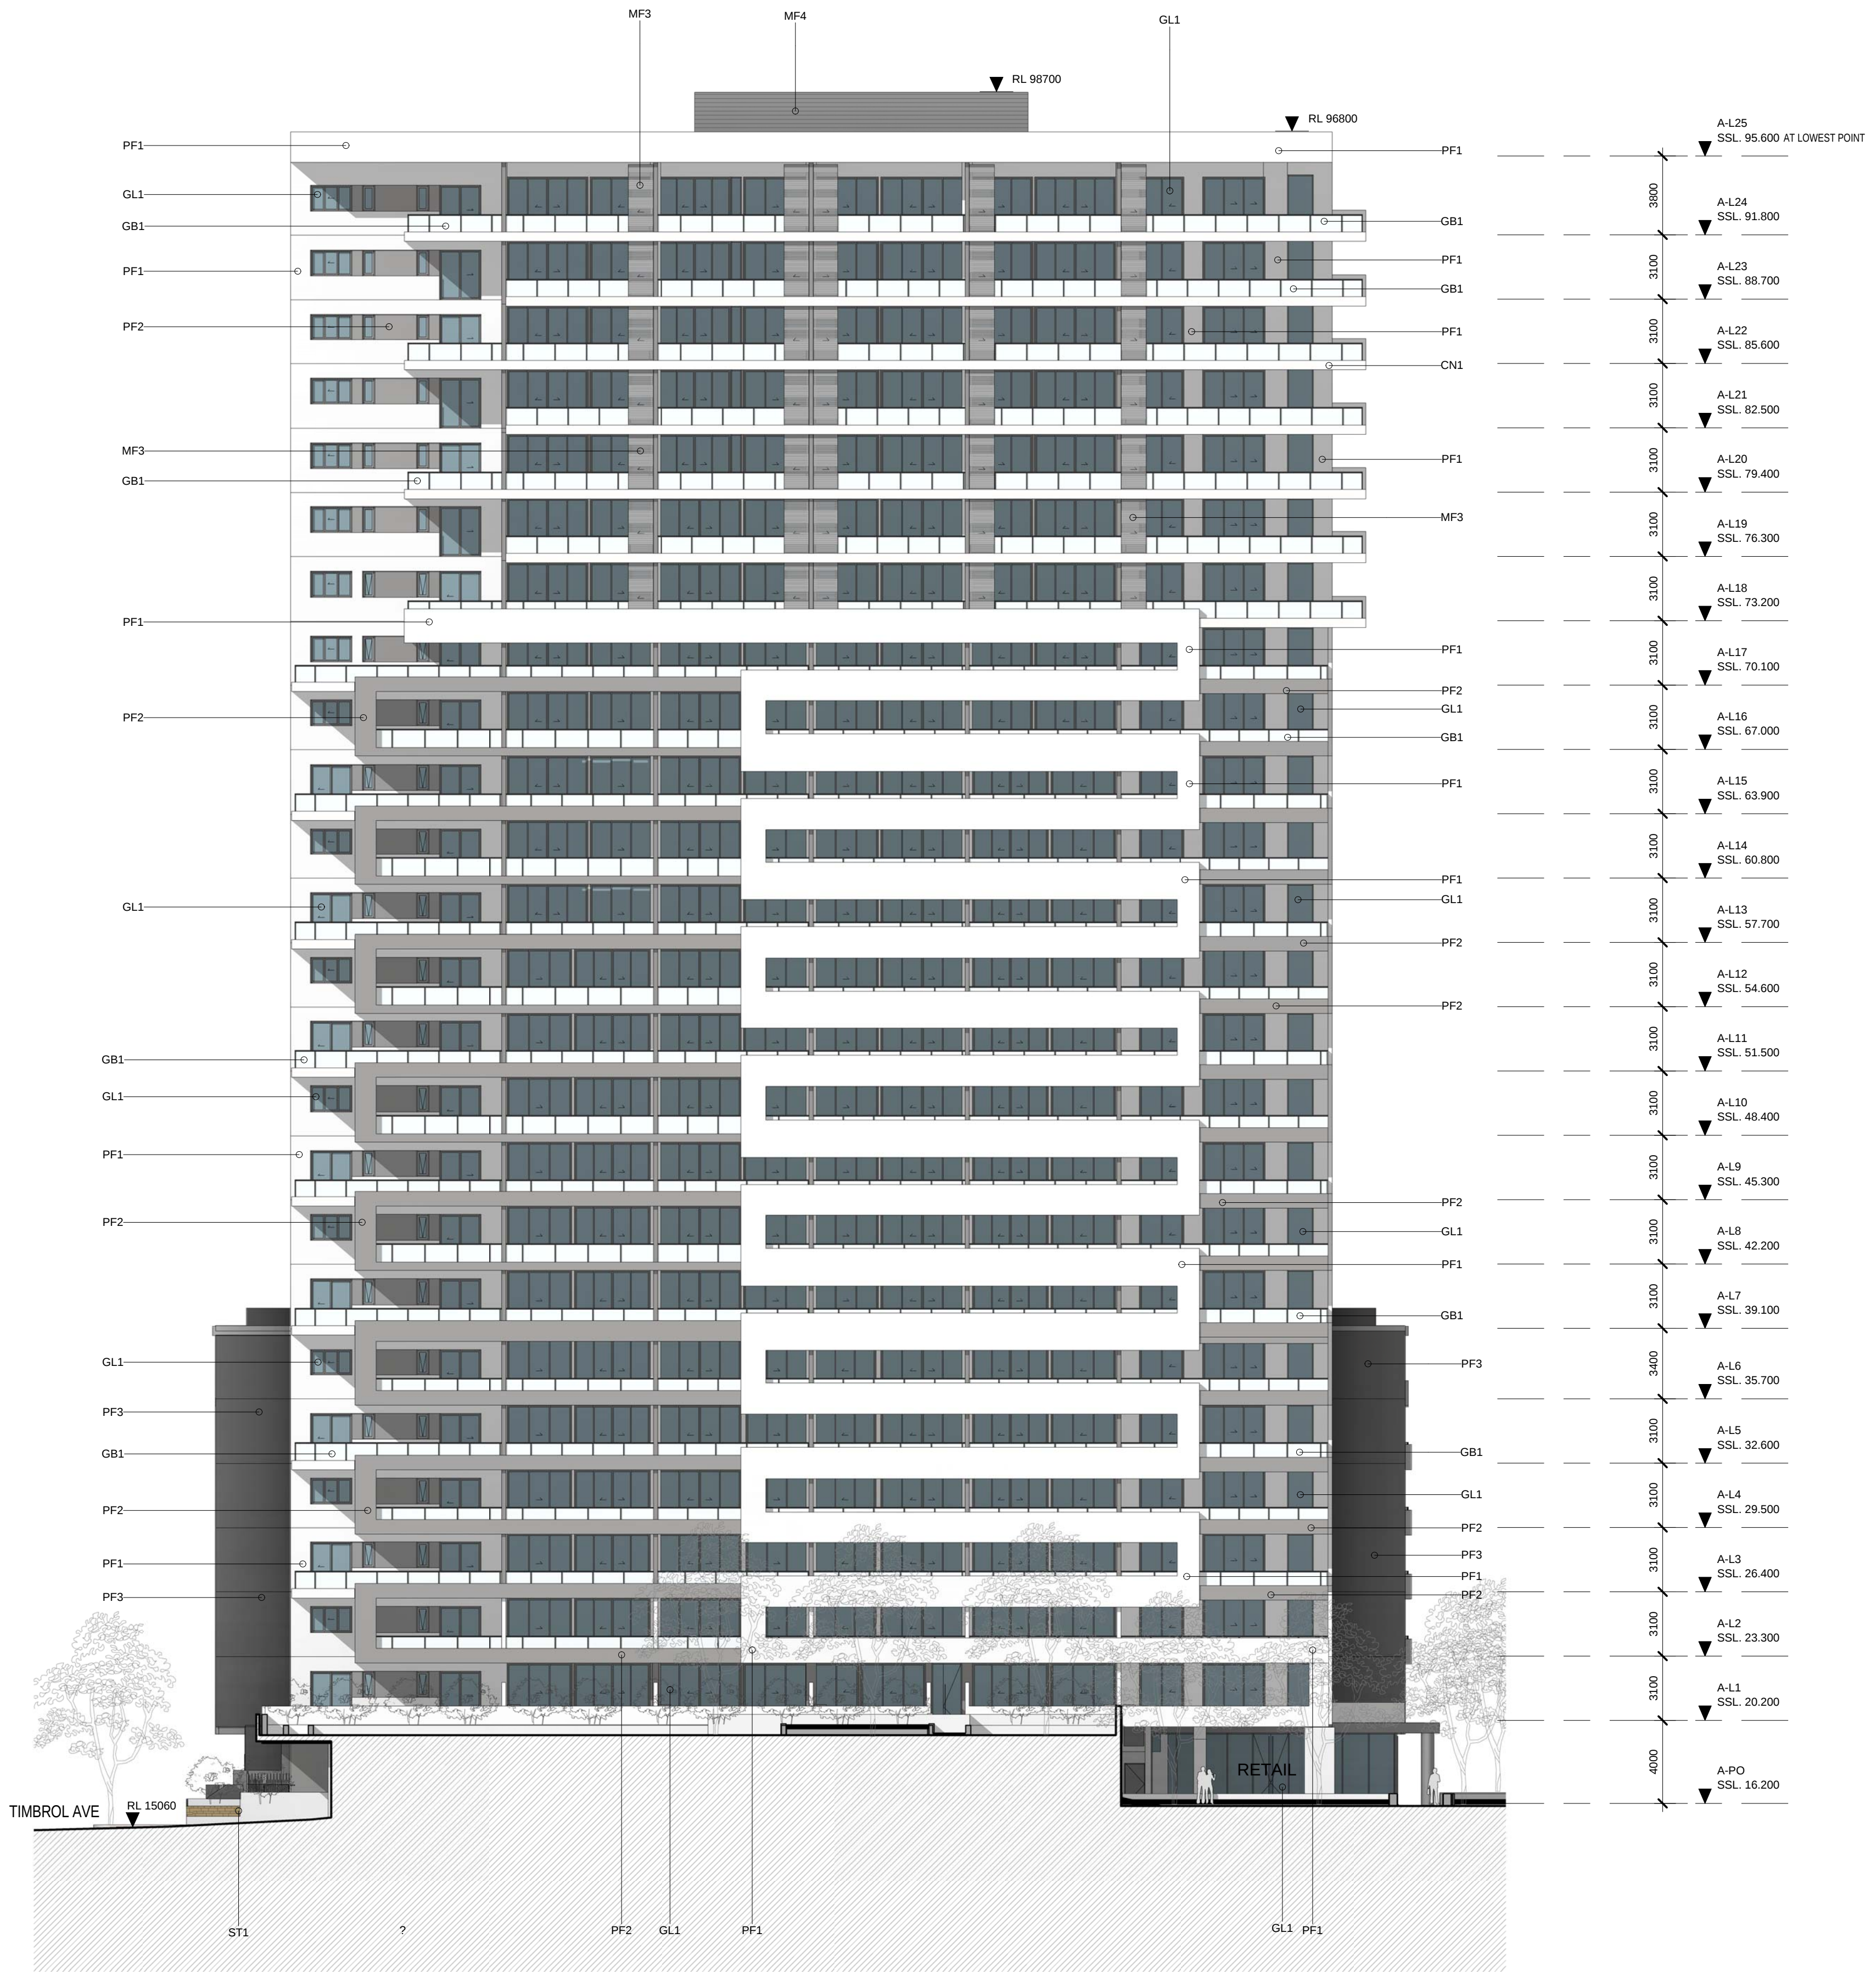

**2 ELEVATION**  
BLDG A - WEST  
1 : 200

