




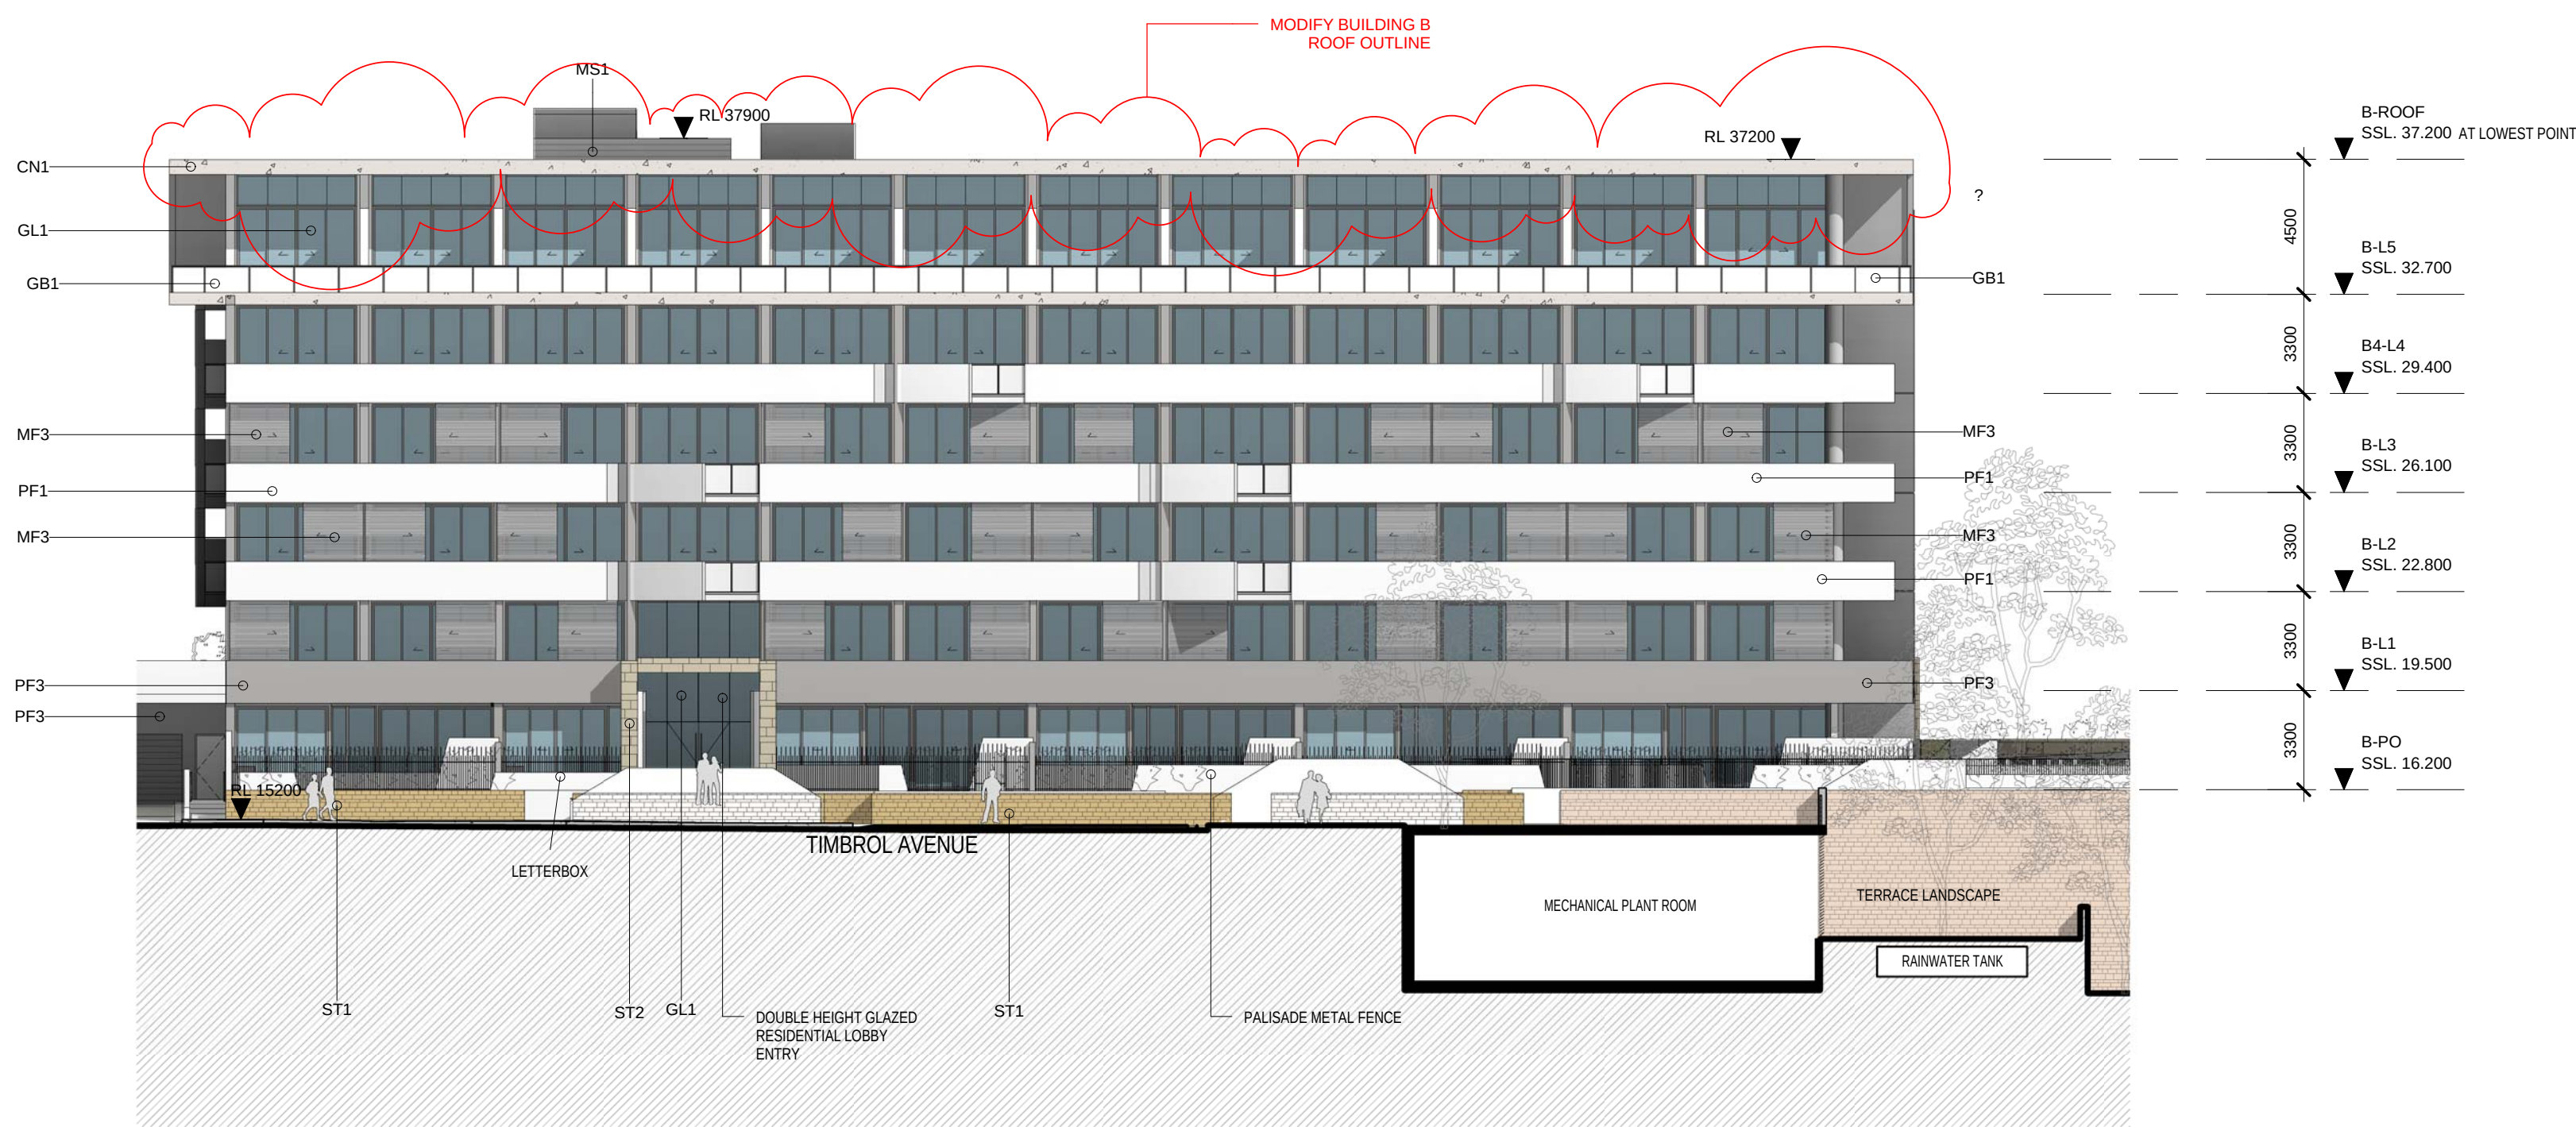

1 ELEVATION
BLDG B - NORTH
1 : 200

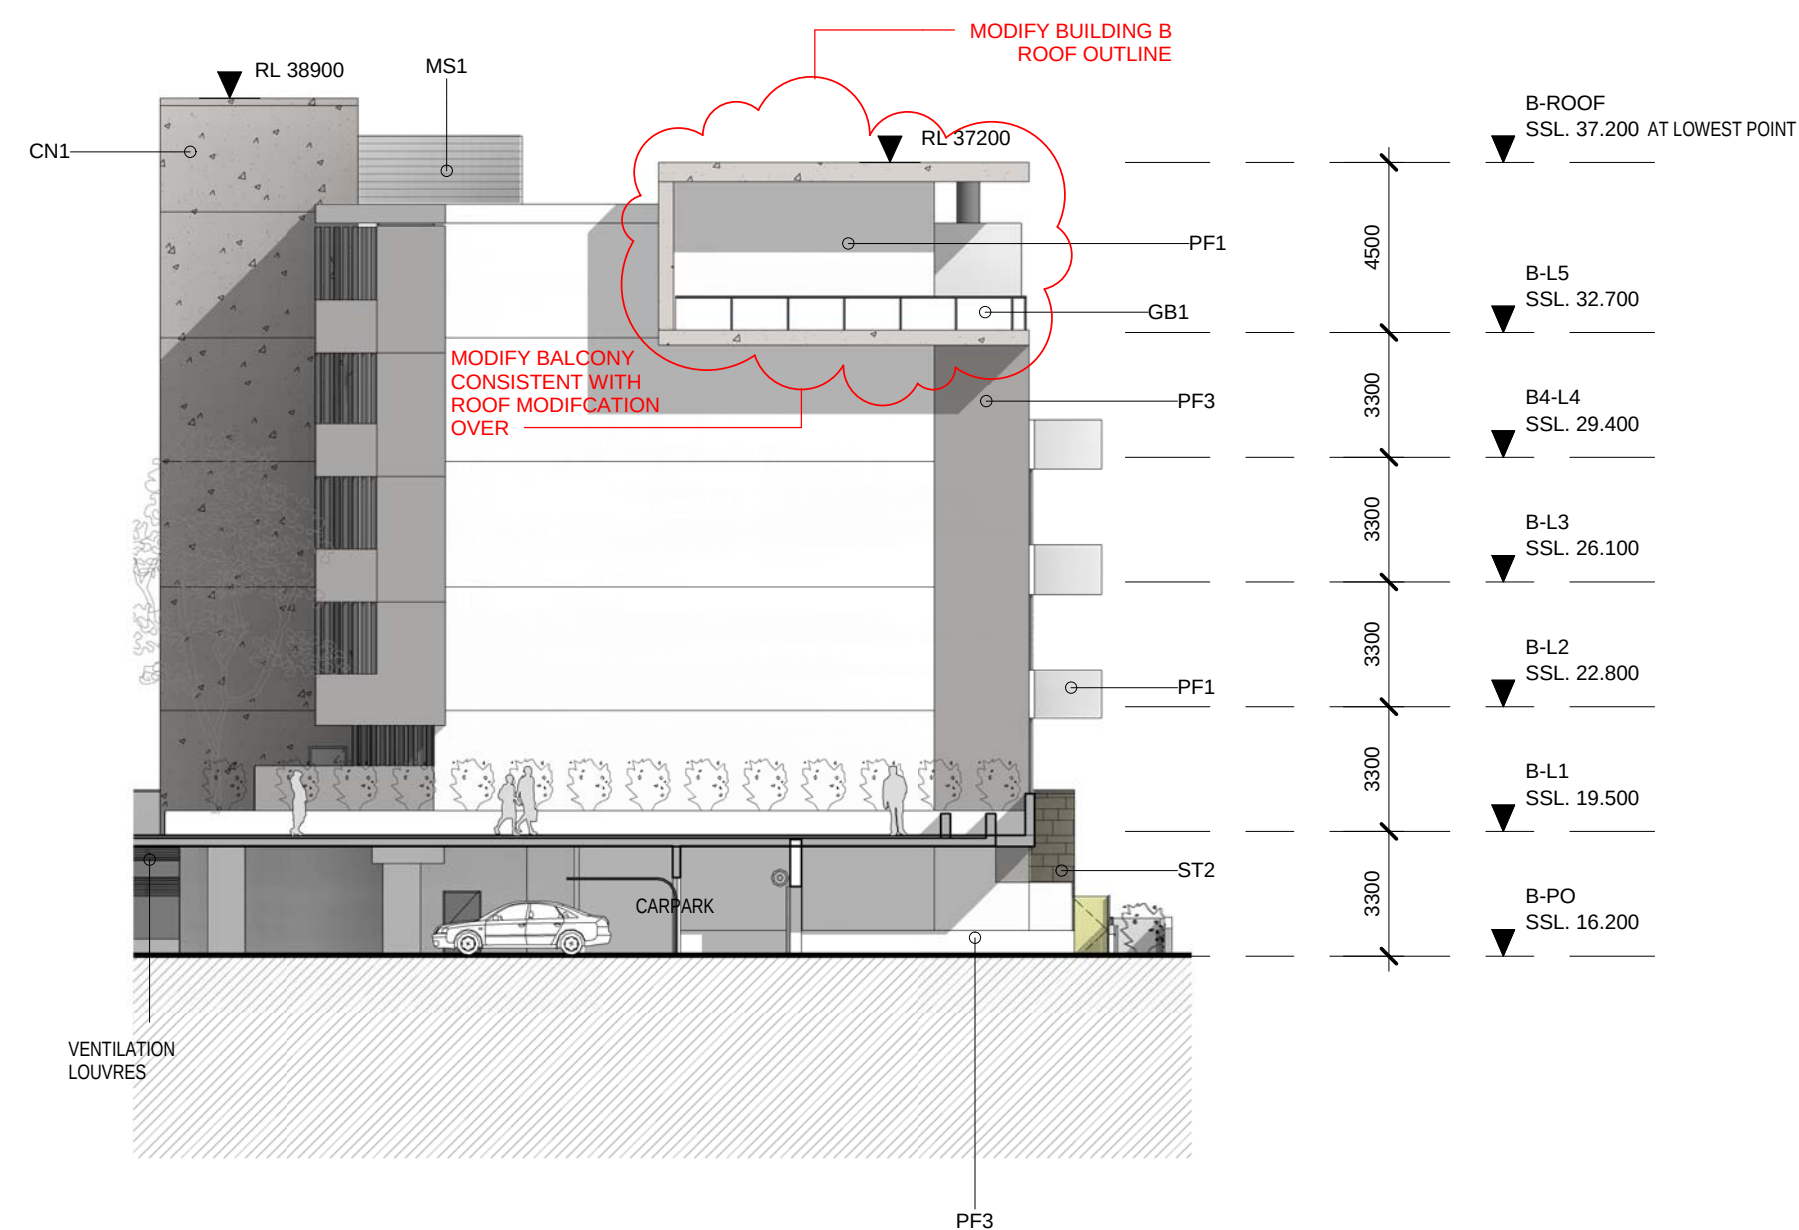


3 ELEVATION
BLDG B - EAST
1 : 200

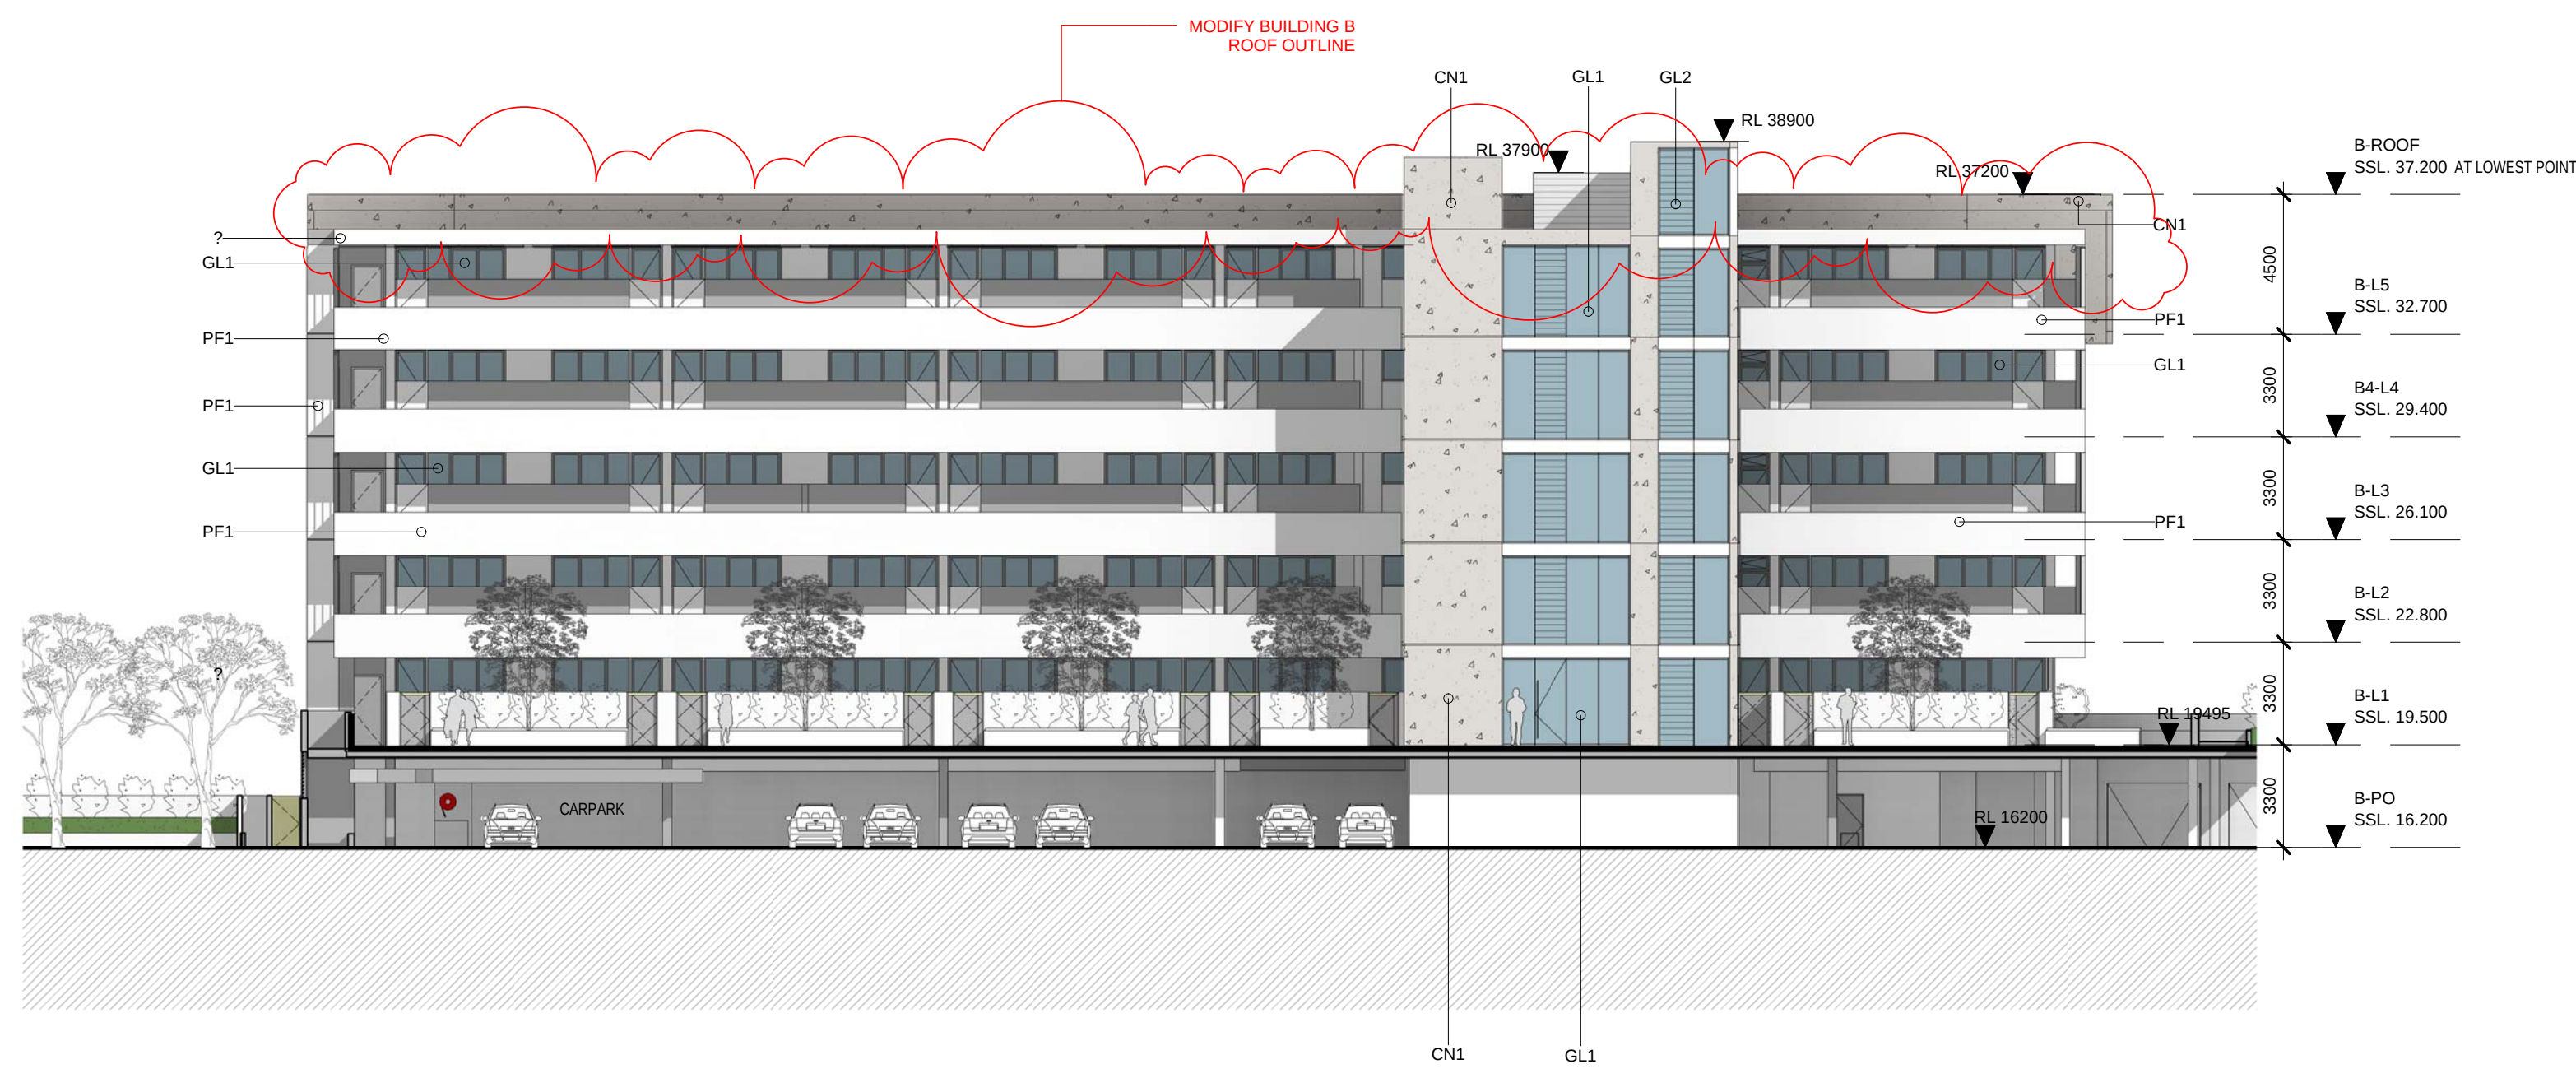

2 ELEVATION
BLDG B - SOUTH
1 : 200



4 ELEVATION
BLDG B - WEST
1 : 200

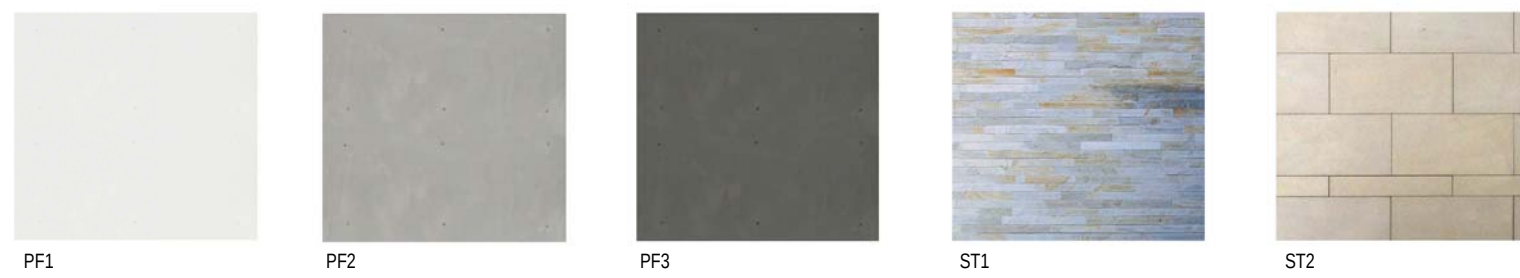


In accepting and using this document the recipient agrees that SJB Architecture (NSW) Pty. Ltd. ACN 081 094 724 T/A SJB Architects, retain all common law, statutory law and other rights including copyright and intellectual property rights. The recipient agrees not to use this document for any purpose other than its intended use: to waive all claims against SJB Architects resulting from unauthorised changes, or to reuse the document on other projects without the prior written consent of SJB Architects. Under no circumstances shall transfer of this document be deemed a sale. SJB Architects makes no warranties of fitness for any purpose.

The Builder/Contractor shall verify job dimensions prior to any work commencing. Figured dimensions shall take precedence over scaled work.

S75W - FOR APPROVAL		
Rev.	Date	Revision
A	12/11/2010	DA Test of Adequacy
A-1	22/02/2011	Preferred Project
A-2	15/04/2012	S75W MOD1 - March 2012
A-3	16/07/2012	Adaptable Parking
A-4	24/08/2012	Adaptable Parking - 3bed to 1bed
A-5	16/10/2012	S75W MOD2 - October 2012

EXTERNAL FINISHES	
CONCRETE	
CN1	Concrete natural finish
CRL	Concrete render finish
RF1	Roof Finish - Grand
MASONRY	
PF1	Texture applied finish - White
PF2	Texture applied finish - Light Warm Grey
PF3	Texture applied finish - Dark Grey
ST1	Stone cladding - Stacked grey colour
ST2	Stone cladding - Sandstone Finish
GLAZING	
GL1	Clear Glass Windows
GL2	Louvre'd Clear Glass Windows
GL3	Obscure Glazing Balustrade
GL4	Feature Coloured Glass
GB1	Clear glass balustrade with Metal handrail
WG	Wintergarden
METALWORKS	
MB1	Metal Balustrade - Steel Galvanised
MF1	Metal Finish - Window + Door Frames
MF2	Metal Finish - Shading blades
MF3	Metal Finish - Louvre screen
MS1	Metal Finish - Plant Screening
MS2	Metal Finish - Screen to apartment entries
TIMBER	
TC1	External cladding - Timber Boards
TB1	Timber Floor Boards - Natural Stain

NOTE: AS BUILT LEVELS MAY VARY +/- 30mm FROM NOTMINATED SSL's

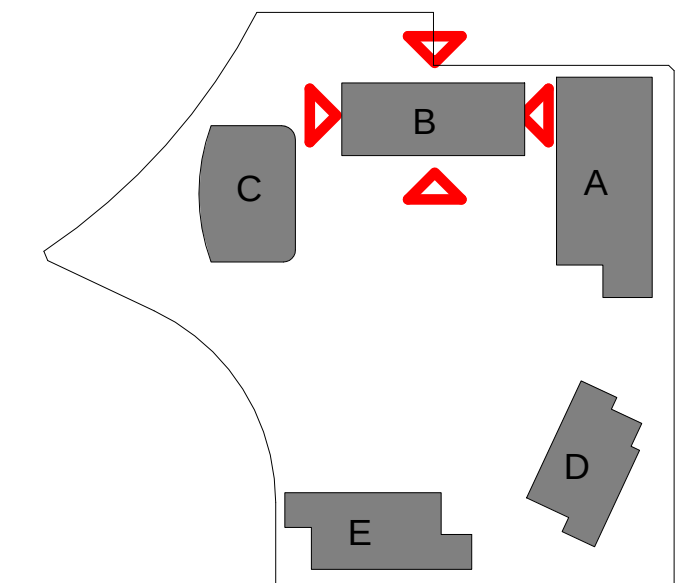

Client

Billbergia
creating communities®

Project

**STAGE 2A + 3A
WALKER ST.
RHODES**
for
Billbergia Developments

Drawing Name

**Elevations - BLDG B
North, South, East & West**

Date	Scale	Sheet Size
22.10.2012	1 : 200	@ B1
Reg No.	Drawn	Chk.
	JT	JP
Job No.	Drawing No.	Revision
4410	A-0505	A-5

SJB Architects
Level 2, 490 Crown St
Sunny Hills NSW
2010 Australia
T 61 2 9380 9911
F 61 2 9380 9922
www.sjb.com.au

Nominated Architects
Adam Haddow 7188
John Pradel 7004

SJB