


| EXTERNAL FINISHES |                                            |
|-------------------|--------------------------------------------|
| <b>CONCRETE</b>   |                                            |
| CN1               | Concrete natural finish                    |
| CRL               | Concrete render finish                     |
| RF1               | Roof Finish - Grand                        |
| <b>MASONRY</b>    |                                            |
| PF1               | Texture applied finish - White             |
| PF2               | Texture applied finish - Light Warm Grey   |
| PF3               | Texture applied finish - Dark Grey         |
| ST1               | Stone cladding - Stacked grey colour       |
| ST2               | Stone cladding - Sandstone Finish          |
| <b>GLAZING</b>    |                                            |
| GL1               | Clear Glass Windows                        |
| GL2               | Lowiron Clear Glass Windows                |
| GL3               | Obscure Glazing Balustrade                 |
| GL4               | Feature Coloured Glass                     |
| GB1               | Clear glass balustrade with Metal handrail |
| WG                | Wintergarden                               |
| <b>METALWORKS</b> |                                            |
| MB1               | Metal Balustrade - Steel Galvanised        |
| MF1               | Metal Finish - Window & Door Frames        |
| MF2               | Metal Finish - Shading blades              |
| MF3               | Metal Finish - Louvre screen               |
| MS1               | Metal Finish - Plant Screening             |
| MS2               | Metal Finish - Screen to apartment entries |
| <b>TIMBER</b>     |                                            |
| TC1               | External cladding - Timber Boards          |
| TB1               | Timber Floor Boards - Natural Stain        |

NOTE: AS BUILT LEVELS MAY VARY +/- 30mm FROM NOTIMINATED SSL's

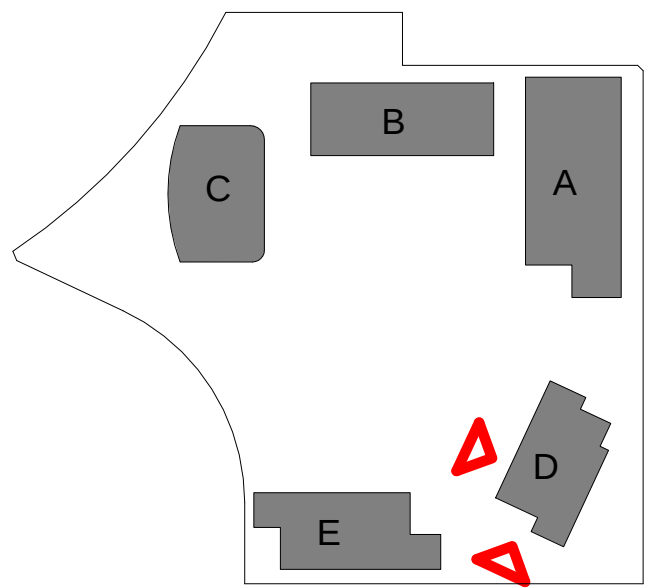

Client

  
**Billbergia**  
creating communities®

Project

**STAGE 2A + 3A**  
**WALKER ST.**  
**RHODES**  
for  
Billbergia Developments


Drawing Name

**Elevations - BLDG D**  
**South & West**


| Date       | Scale       | Sheet Size |
|------------|-------------|------------|
| 22.10.2012 | 1 : 200     | @ B1       |
| Reg No.    | Drawn       | Chk.       |
|            | MM/NH       | JP         |
| Job No.    | Drawing No. | Revision   |
| 4410       | A-0509      | A-5        |

**SJB Architects**  
Level 2, 490 Crown St  
Sunny Hills NSW  
2010 Australia  
T 61 2 9380 9911  
F 61 2 9380 9922  
www.sjb.com.au

Nominated Architects  
Adam Haddow 7188  
John Pradel 7004

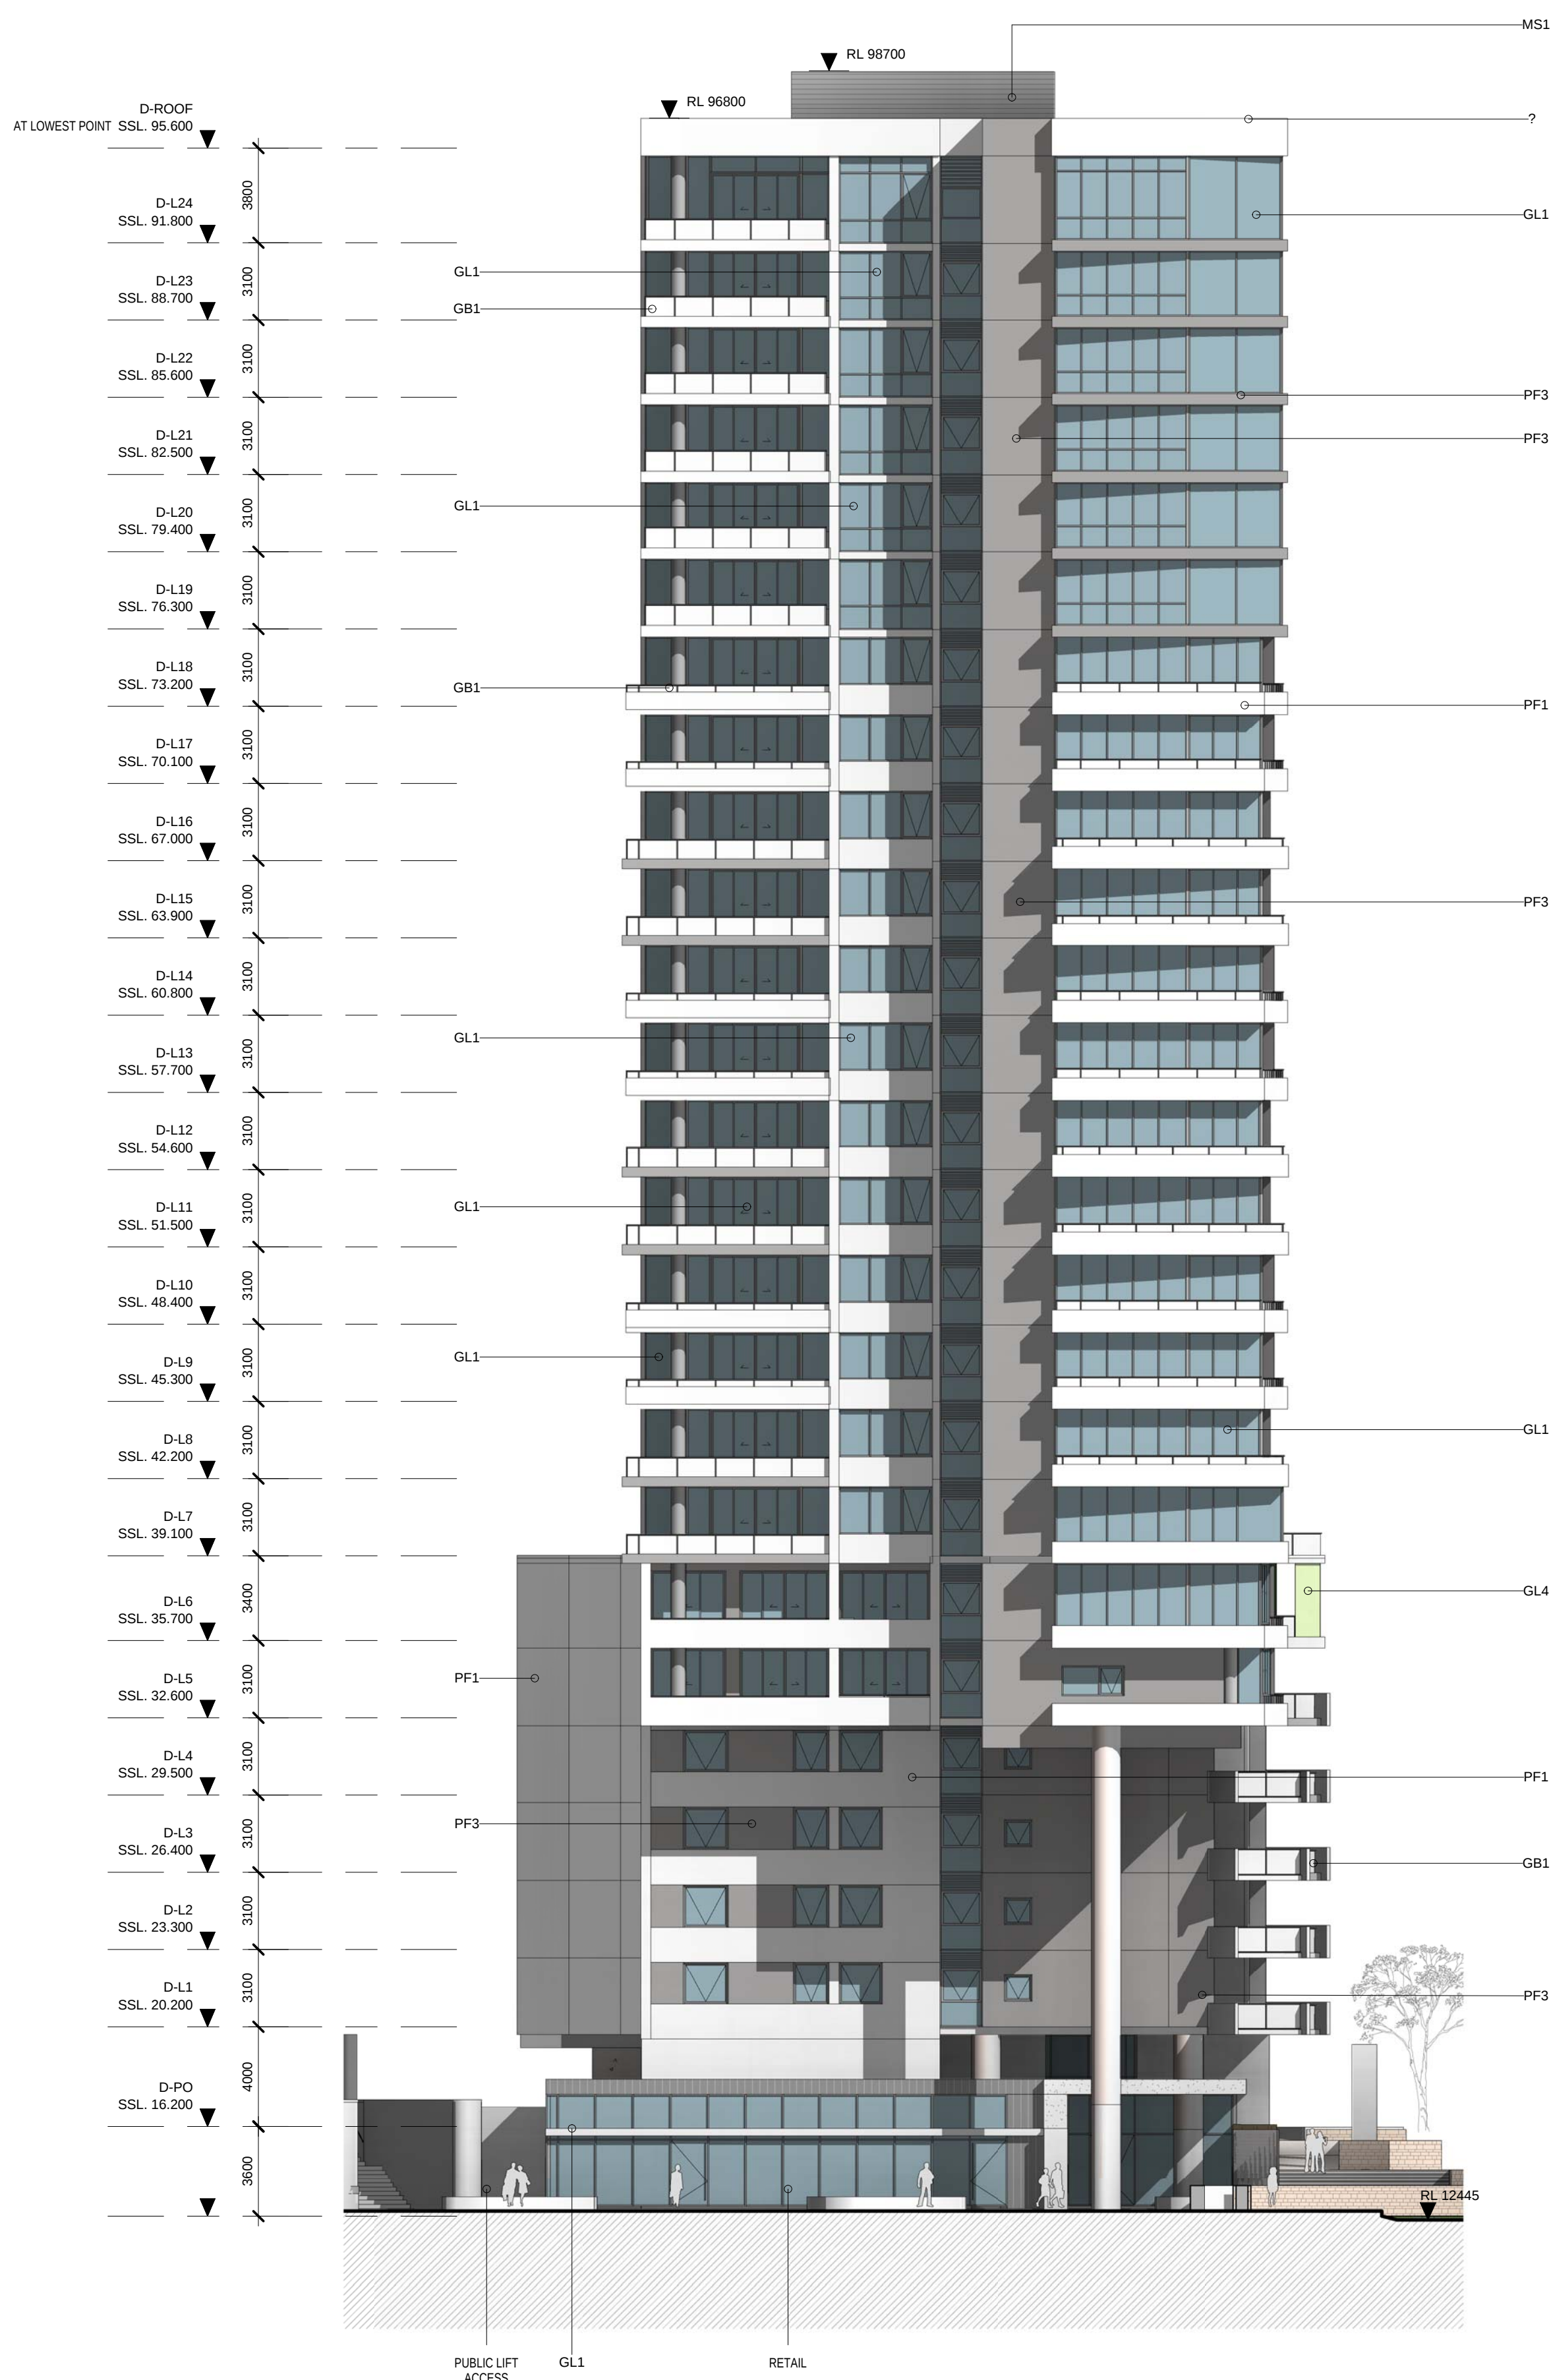

1 ELEVATION  
BLDG D - SOUTH  
1 : 200

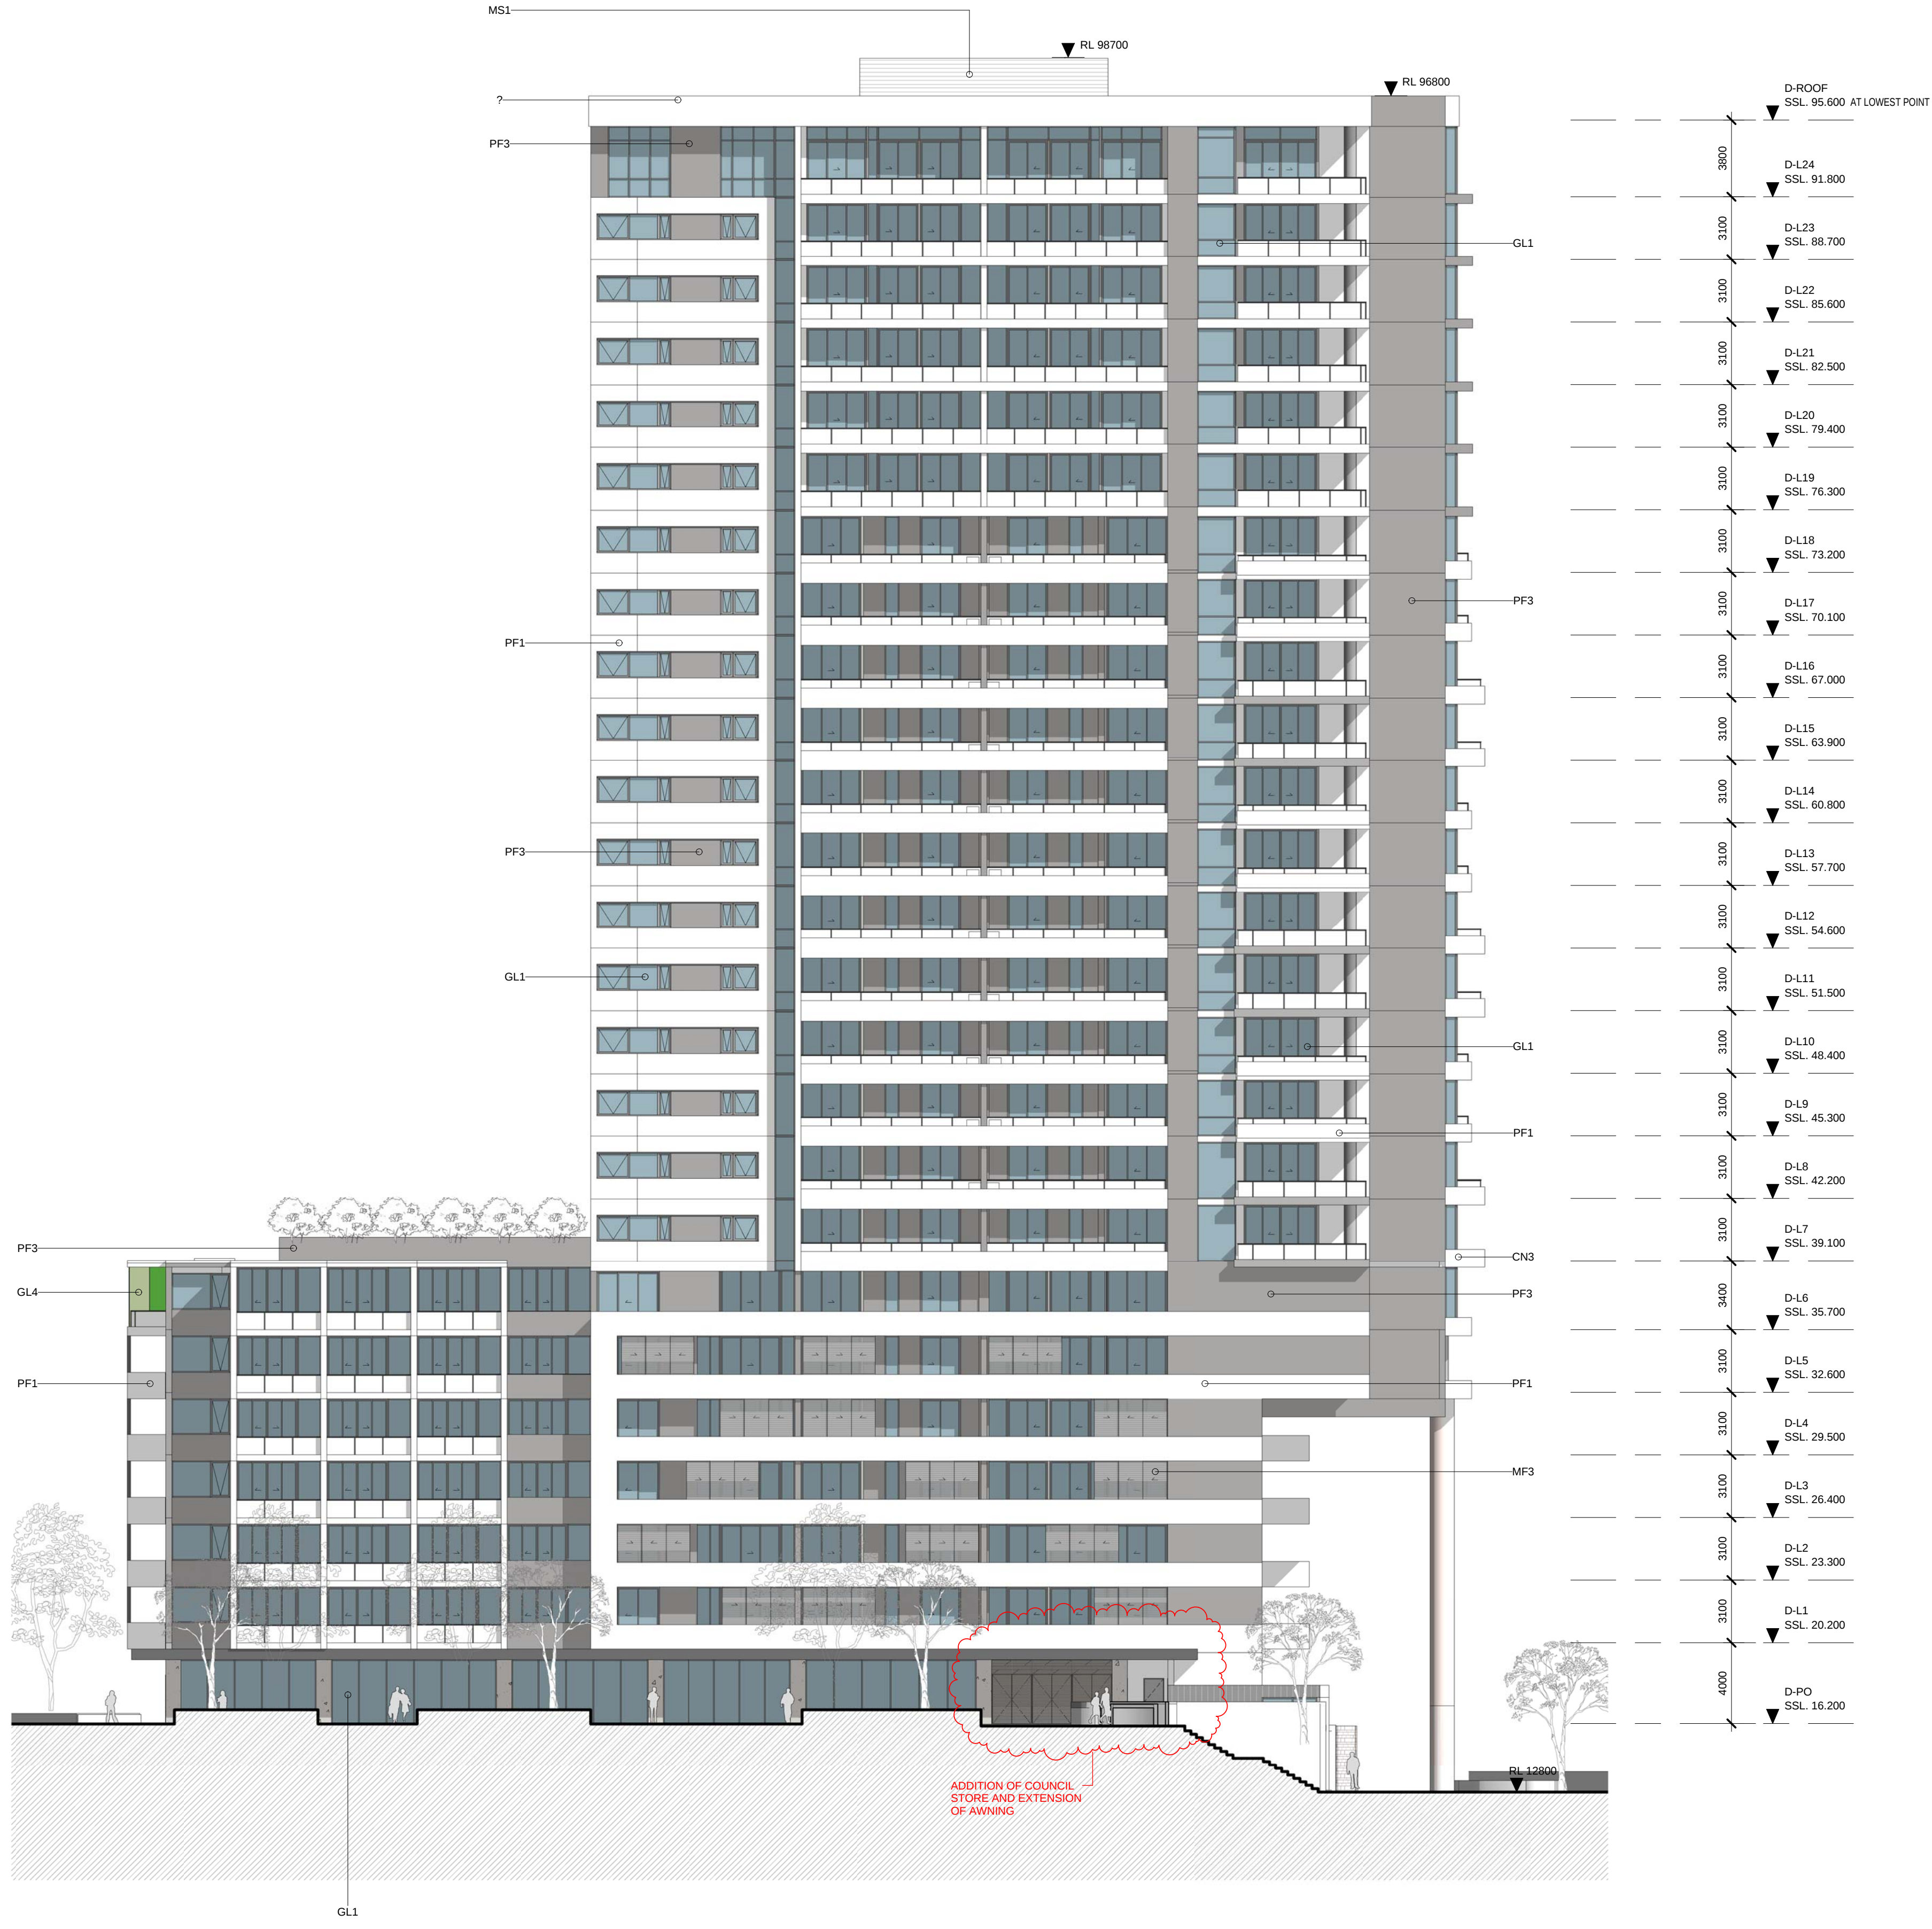

2 ELEVATION  
BLDG D - WEST  
1 : 200

