


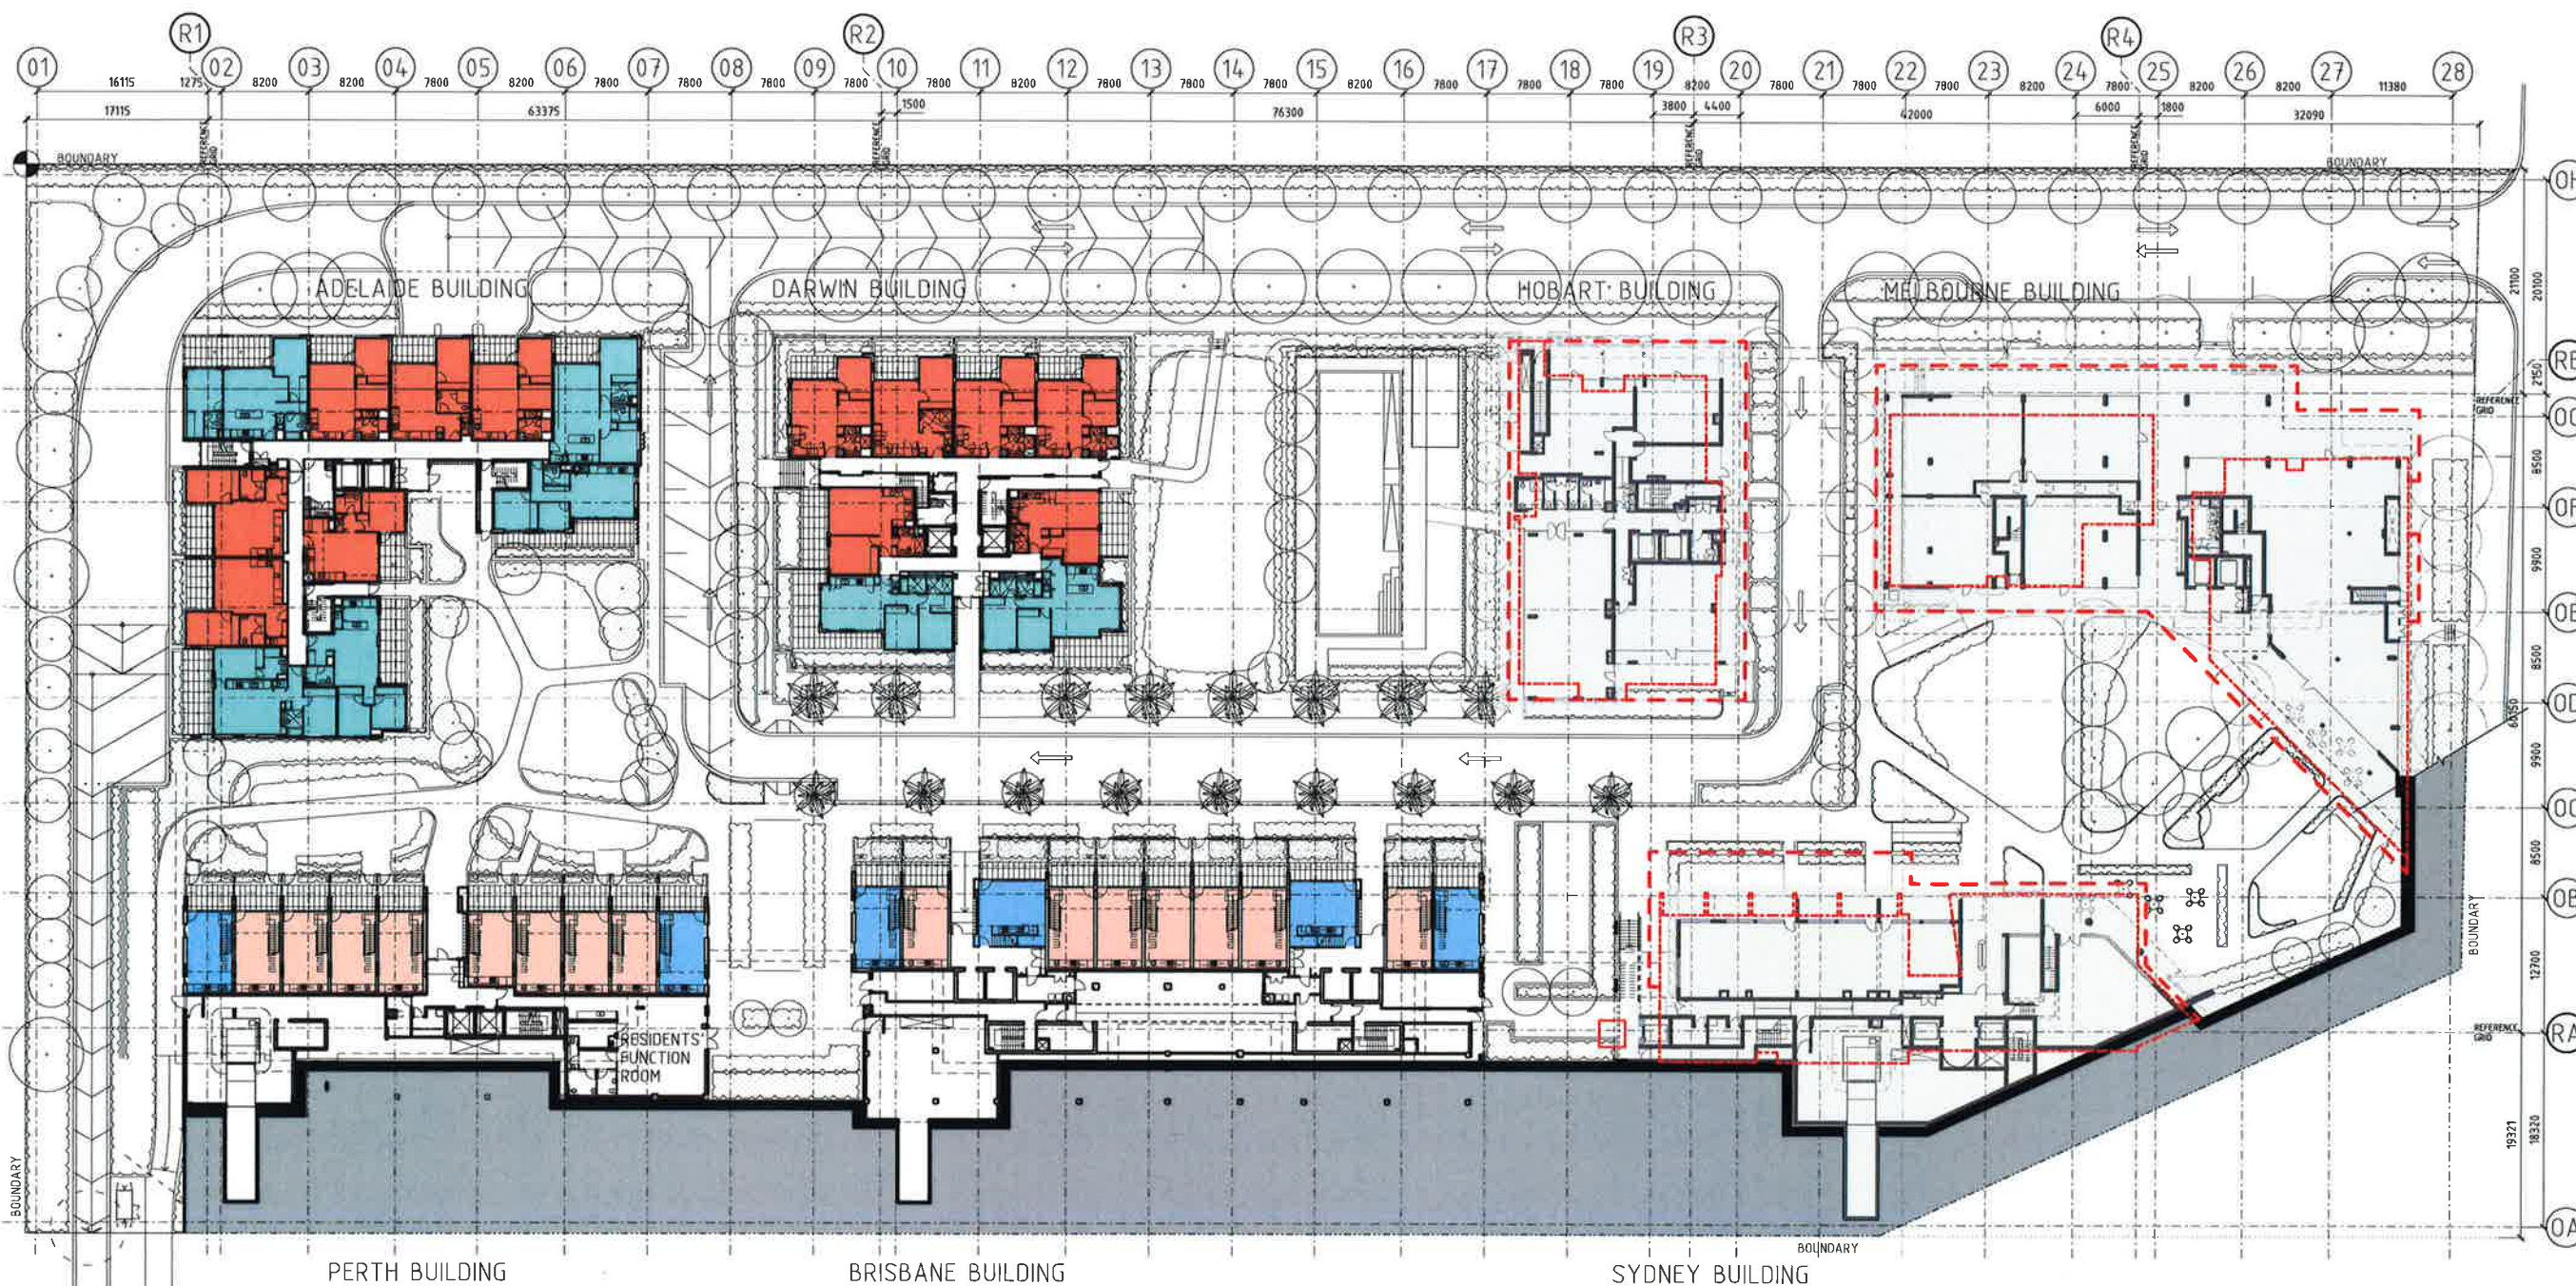

EMERGENCY VEHICLE
EGRESS TO EPPING ROAD

KEY

--- STAGE TWO BUILDING ENVELOPE
AS PER APPROVED DRAWING DATED 17.06.13

--- STAGE TWO BUILDING OUTLINE
AS PER APPROVED DRAWING DATED 17.06.13

1 BED

1 BED SOHO (COMMERCIAL/RESIDENTIAL)

2 BED

2 BED SOHO (COMMERCIAL/RESIDENTIAL)

3 BED

STAGE 2 DEVELOPMENT

Revisions:

No 1 Date Description

F 26.05.14 75W SUBMISSION - CAN PARKING

G 31.07.14 75W SUBMISSION - LANDSCAPE DESIGN, ROAD NETWORK, GARBAGE AND RECYCLING AREAS REVISED

DARWIN, PERTH AND BRISBANE - PLANNING REVISED

ALL BUILDINGS - EXTENT OF SCREENS, GLAZING, CLADDING AND BLADE WALLS REVISED

H 11.10.14 OUTLINE STAGE TWO BUILDINGS AS APPROVED 17.06.13

SHOWN IN RED IDOP REQUEST 11.11.14

Site Location Plan

STAGE 2 SHOWN IN GREY

Do not scale drawings. Use figured dimensions only. Check & verify levels and dimensions on site prior to the commencement of any work, the preparation of shop drawings or the fabrication of components.

This drawing is the copyright of Allen Jack + Collier Architects and is protected under the Copyright Act 1968. Do not alter, reproduce or transmit in any form, or by any means without the express permission of Allen Jack + Collier Architects.

Headmaster Architects: Michael Newman 5264, Peter Ireland 6667



Client

STAMFORD
LAND CORPORATION LTD

Architect

AJ+C
ARCHITECTS

79 Myrtle Street Chippendale NSW 2008 AUSTRALIA
ph +61 2 9311 8222 fx +61 2 9311 8200 abn 53 003 782 250

Project

MACQUARIE PARK VILLAGE
110-114 HERRING ROAD
MACQUARIE PARK

Proj No. 10_030

Drawing Title

LEVEL 00 PLAN

Drawing Status

NOT FOR CONSTRUCTION


Scale

1:330@A1DA2100

Issue

H

PLOT DATE & TIME 6/8/2014 11:32 PM PLOTTED & CHECKED BY Bening REF: A:\2015\1030_Macquarie_Village\A3_CAD\Layouts\110-114_Herring_Road_Plan_A1.dwg 2/10/2014

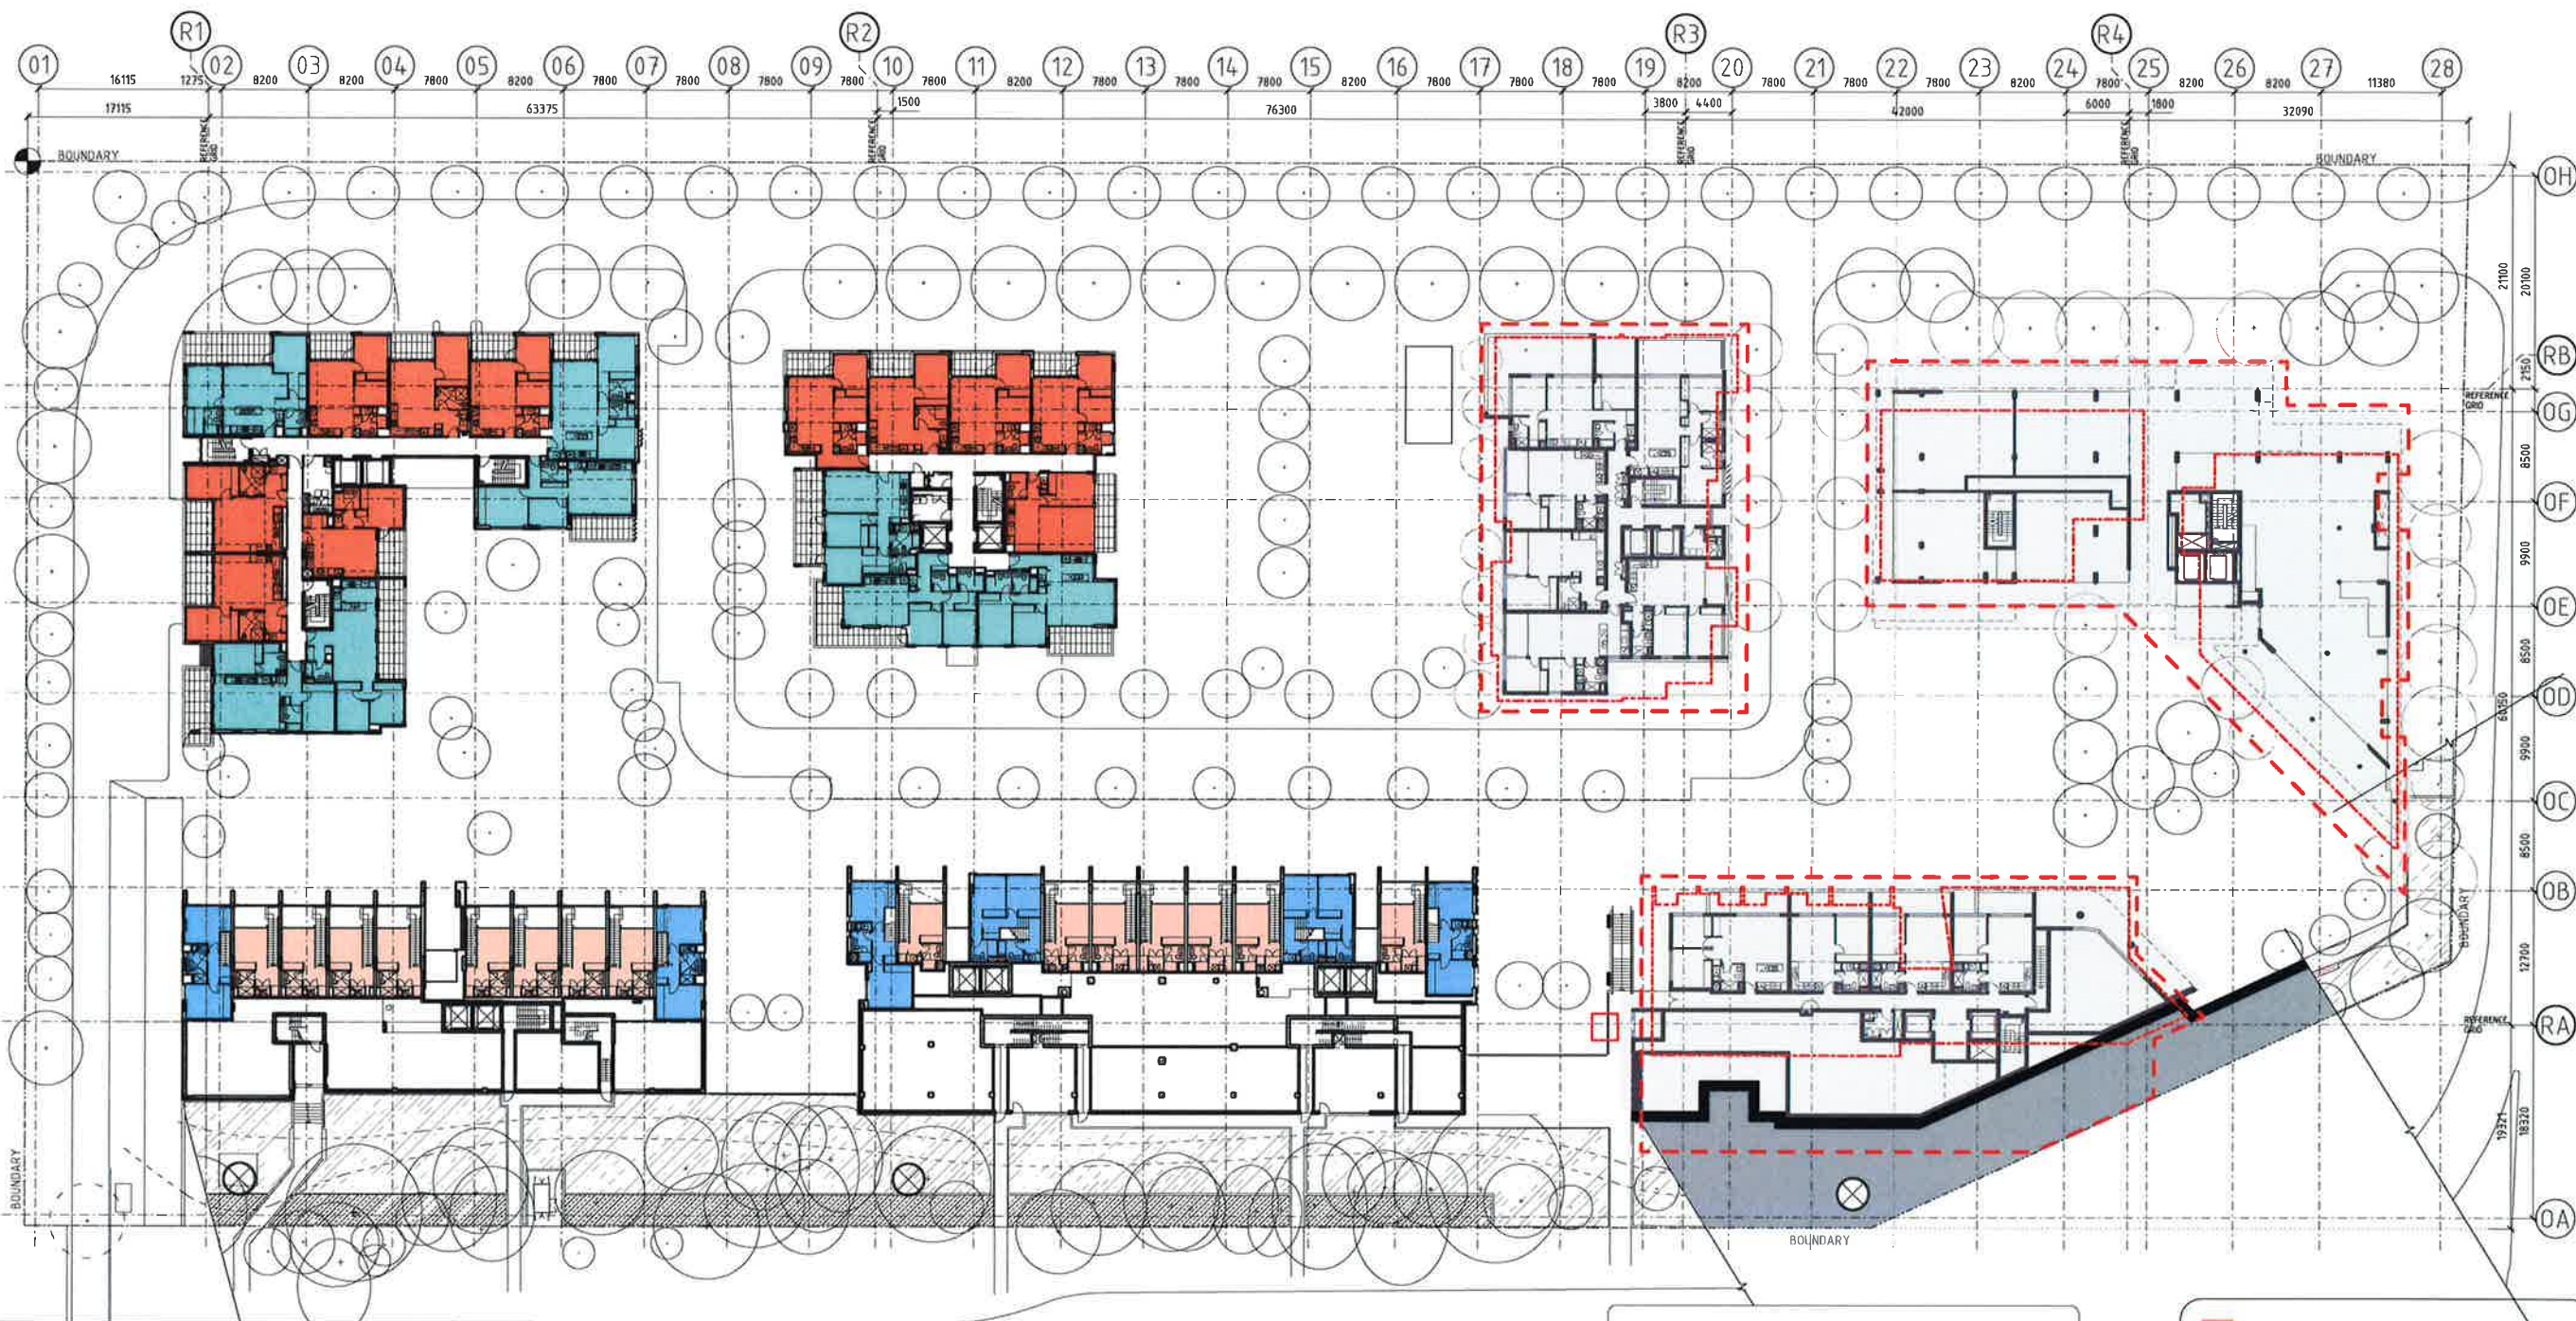

KEY

--- STAGE TWO BUILDING ENVELOPE
AS PER APPROVED DRAWING DATED 17.06.13

--- STAGE TWO BUILDING OUTLINE
AS PER APPROVED DRAWING DATED 17.06.13

1 BED
1 BED SOHO (COMMERCIAL/RESIDENTIAL)
2 BED
2 BED SOHO (COMMERCIAL/RESIDENTIAL)
3 BED
STAGE 2 DEVELOPMENT

Revisions	No	Date	Description	By	App'd
F	26.05.14		PSW SUBMISSION - CAR PARKING		
G	31.07.14		LANDSCAPE DESIGN, ROAD NETWORK, GARRAGE AND RECYCLING AREAS REVISED		
			DRAWING, PERTH AND DORSET - PLANNING REVISED		
			ALL BUILDINGS - EXTENT OF SCREENS, GLAZING, CLADDING AND BLADE WALLS REVISED		


H 11.11.14 OUTLINE STAGE TWO BUILDINGS AS APPROVED 17.06.13
SHOWN IN RED (DOP REQUEST 11.11.14)

Do not scale drawings. Use figured dimensions only. Check & verify levels and dimensions on site prior to the commencement of any work, the preparation of shop drawings or the fabrication of components.

This drawing is the copyright of Allen Jack & Collier Architects and is protected under the Copyright Act 1968. Do not alter, reproduce or transmit in any form, or by any means without the express permission of Allen Jack & Collier Architects.

Responsible Architects: Michael Heenan SMA, Peter Ireland SM

Site Location Plan

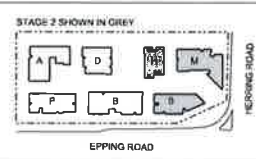

Client

STAMFORD
LAND CORPORATION LTD

Architect

AJ+C
ARCHITECTS
79 Myrtle Street Chippendale NSW 2008 AUSTRALIA
ph +61 2 9311 8222 fx +61 2 9311 8200 abn 53 003 782 250

Project

MACQUARIE PARK VILLAGE
110-114 HERRING ROAD
MACQUARIE PARK

Drawing Title

LEVEL 01 PLAN

Drawing Status

NOT FOR CONSTRUCTION

Scale


1:330@A1

Drawing No

DA2101

Issue

H

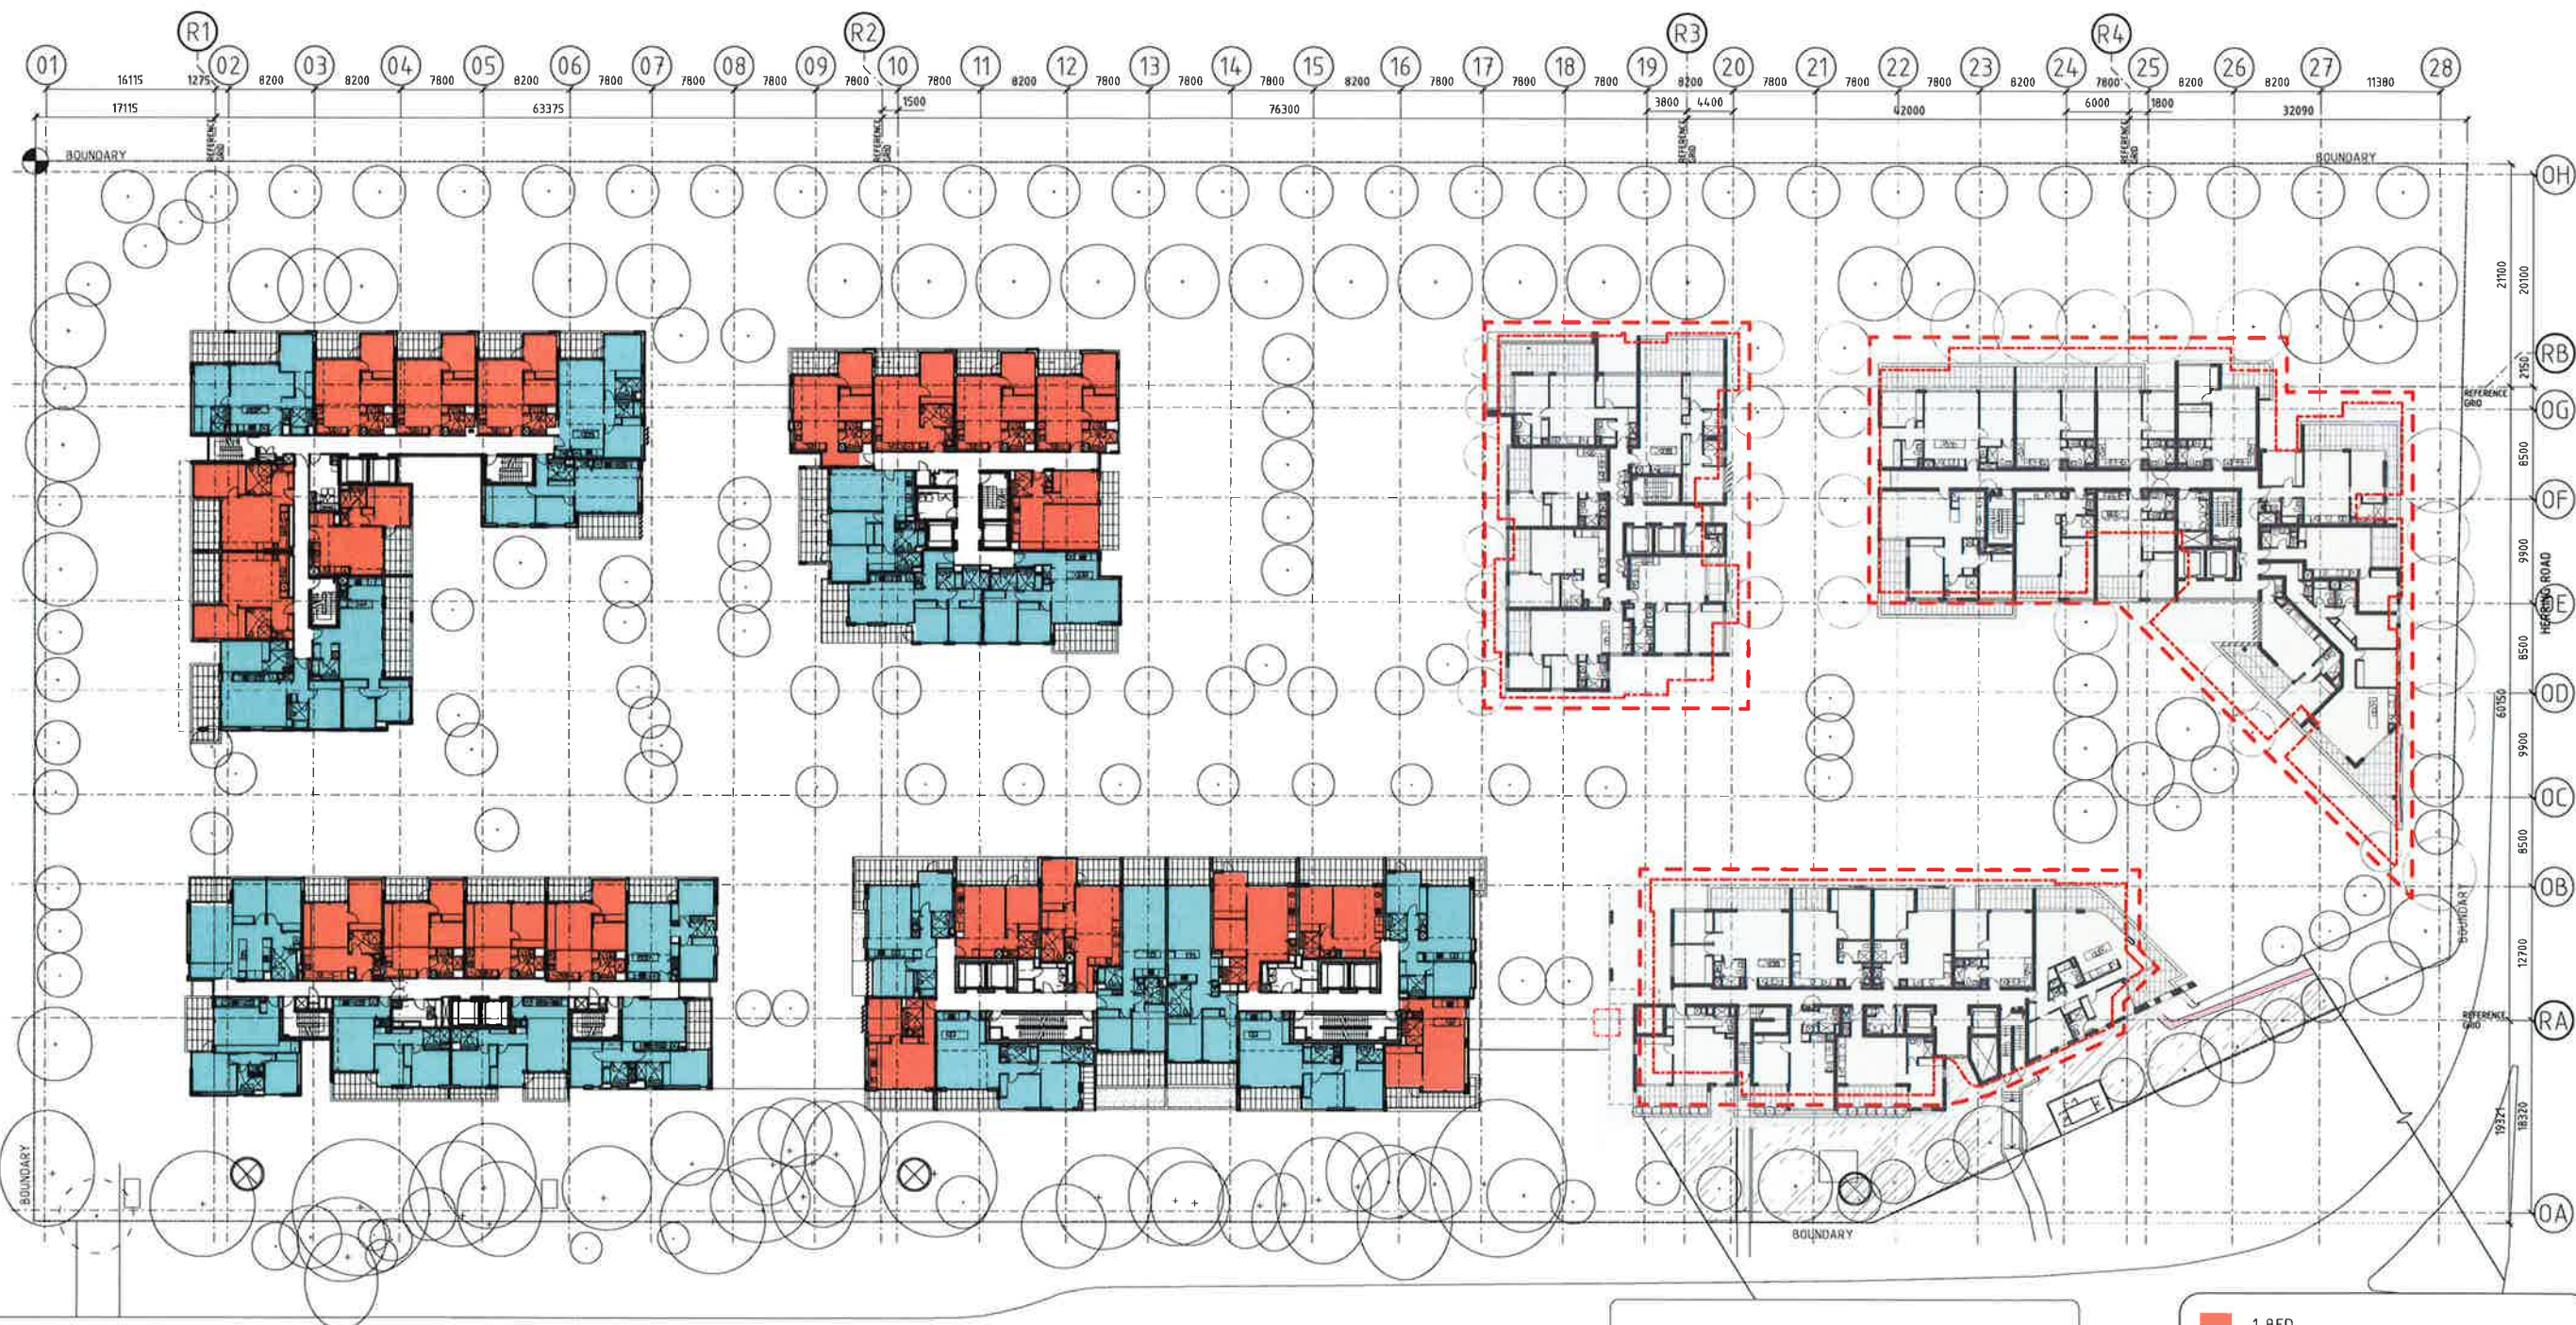

KEY

--- STAGE TWO BUILDING ENVELOPE
AS PER APPROVED DRAWING DATED 17.06.13

--- STAGE TWO BUILDING OUTLINE
AS PER APPROVED DRAWING DATED 17.06.13

- 1 BED
- 1 BED SOHO (COMMERCIAL/RESIDENTIAL)
- 2 BED
- 2 BED SOHO (COMMERCIAL/RESIDENTIAL)
- 3 BED
- STAGE 2 DEVELOPMENT

Revisions

No	Date	Description	Drawn
F	26.05.14	PSW SUBMISSION - CAR PARKING	
G	31.07.14	PSW SUBMISSION LANDSCAPE DESIGN, ROAD NETWORK, GARBAGE AND RECYCLING AREAS REVISED DARWIN, PERTH AND BRISBANE - PLANNING REVISED ALL BUILDINGS - EXTENT OF SCREENS, GLAZING, CLADDING AND BLADE WALLS REVISED	

H 11.11.14 OUTLINE STAGE TWO BUILDINGS AS APPROVED 17.06.13
SHOWN IN RED (DOP REQUEST 11.11.14)


Do not scale drawings. Use figured dimensions only. Check & verify levels and dimensions on site prior to the commencement of any work, the preparation of shop drawings or the fabrication of components.

This drawing is the copyright of Allen Jack & Co. Architects and is protected under the Copyright Act 1968. Do not alter, reproduce or transmit in any form, or by any means without the express permission of Allen Jack & Co. Architects.

Responsible Architect: Michael Heenan SM4, Peter Ireland SM4

Site Location Plan

STAGE 2 SHOWN IN GREY

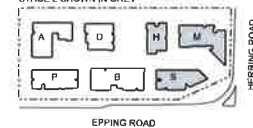

Client

STAMFORD
LAND CORPORATION LTD

Architect

AJ+C
ALLEN JACK & CO. ARCHITECTS
79 Myrtle Street Chippendale NSW 2008 AUSTRALIA
ph +61 2 9311 8222 fx +61 2 9311 8200 abn 53 003 782 210

Project

MACQUARIE PARK VILLAGE
110-114 HERRING ROAD
MACQUARIE PARK

Proj No. 10_030

Drawing Title

LEVEL 02 PLAN

Drawing Status


NOT FOR CONSTRUCTION

Scale

1:330@A1DA2102

Issue

H

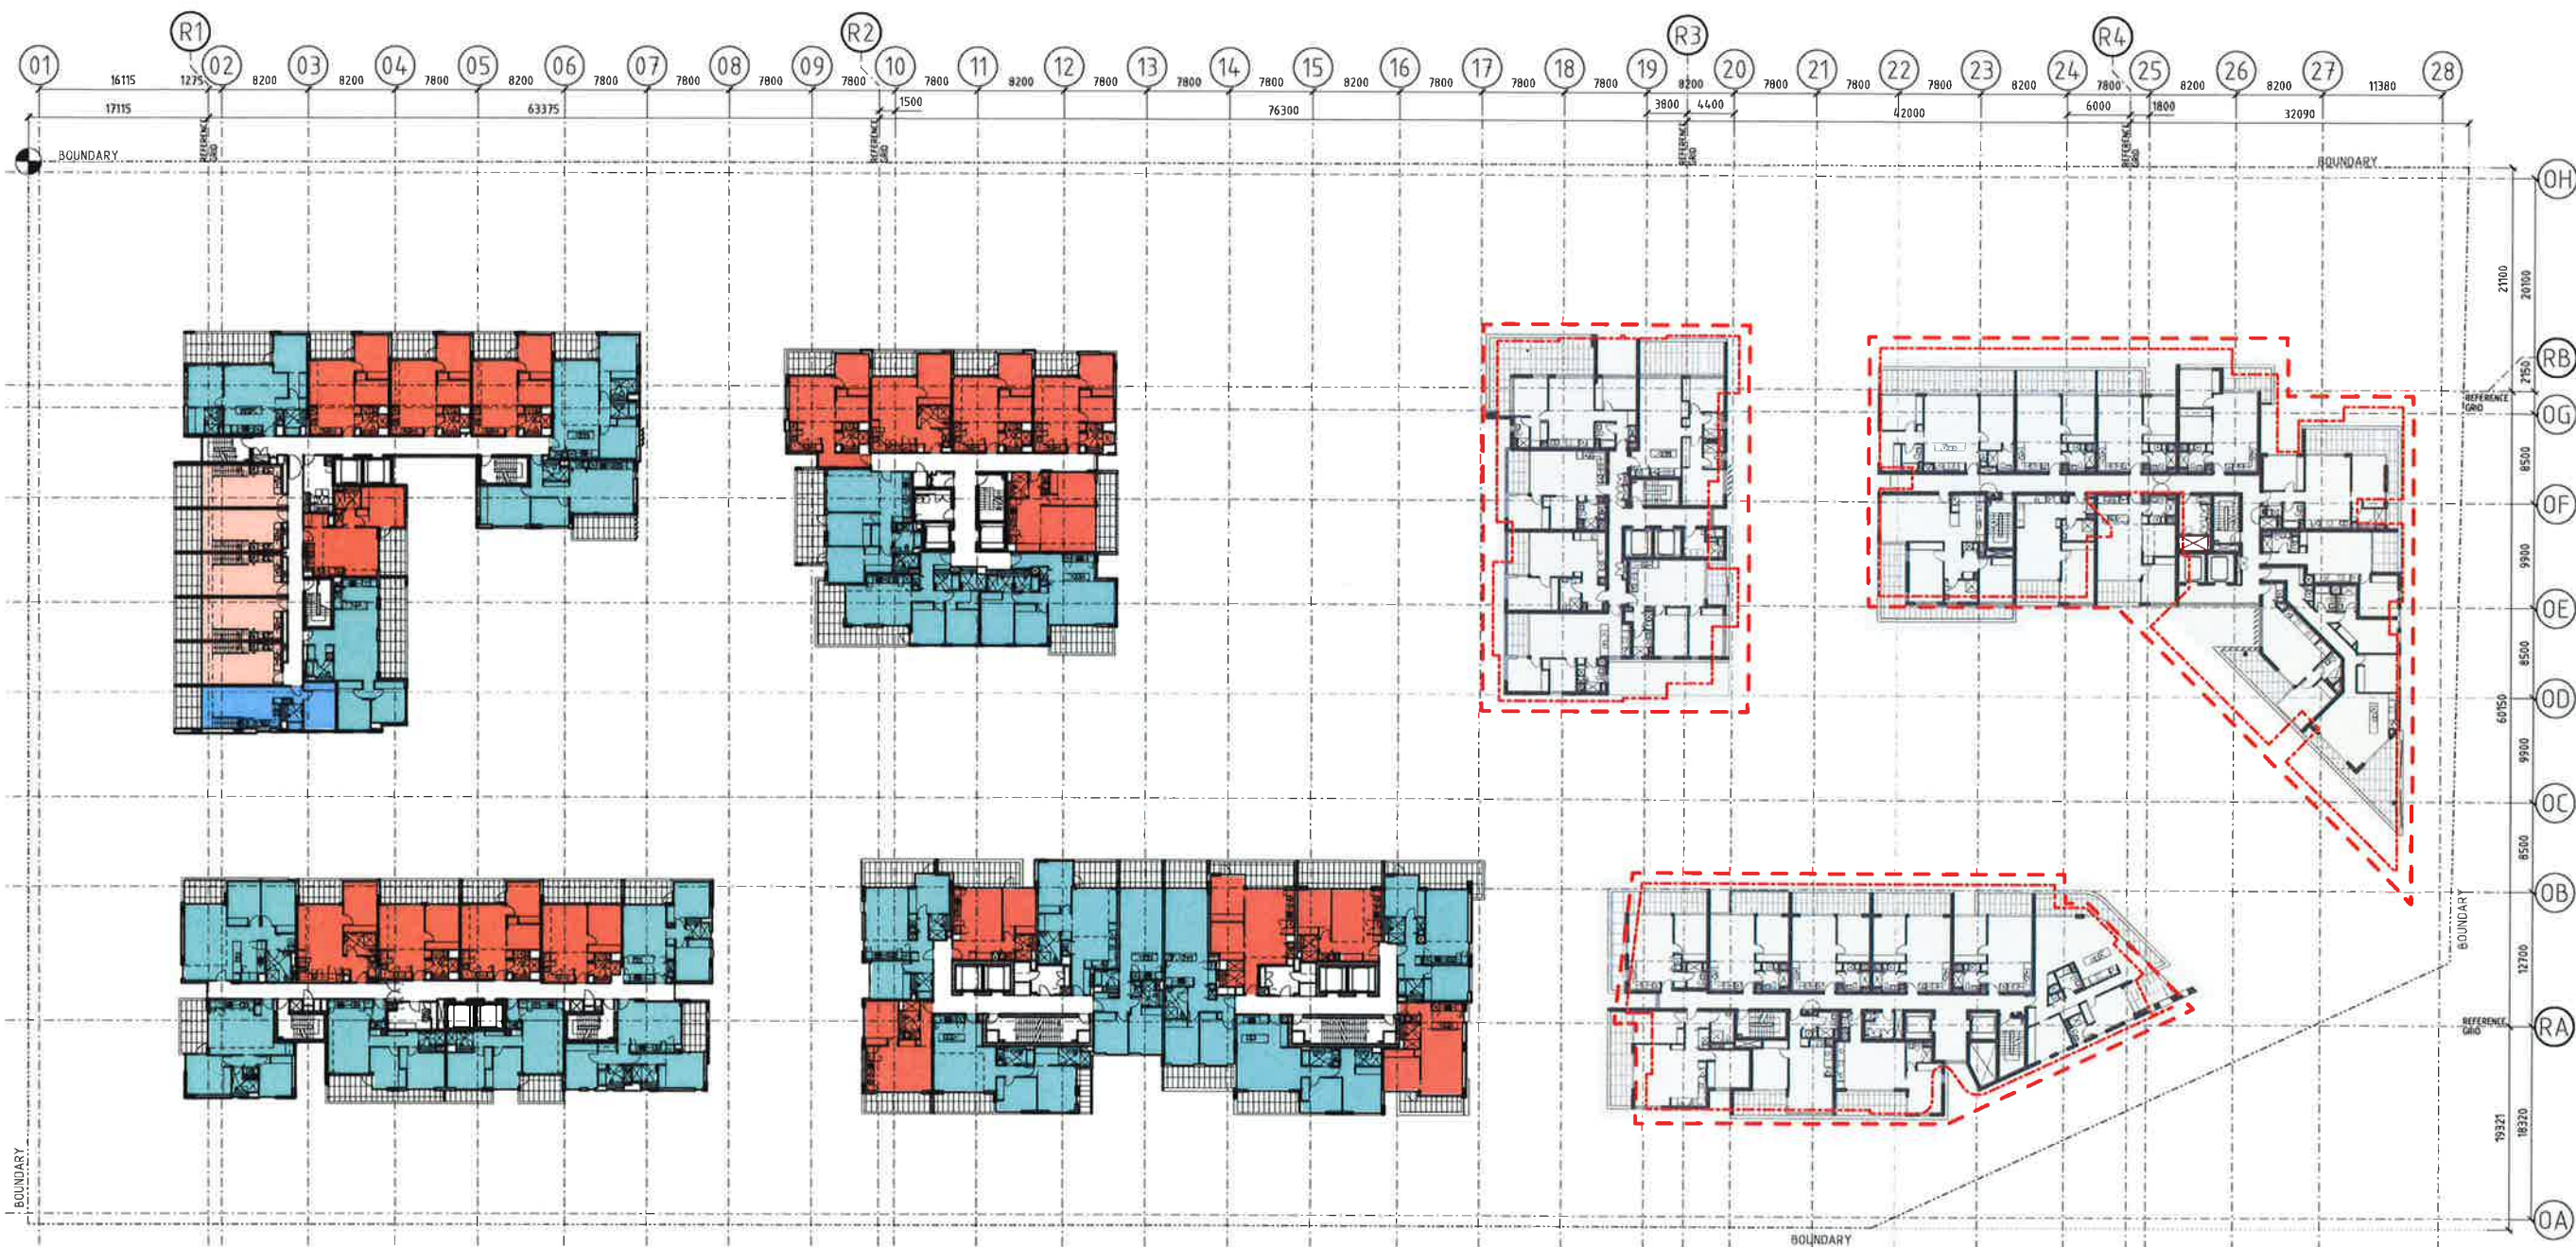

KEY

- STAGE TWO BUILDING ENVELOPE
AS PER APPROVED DRAWING DATED 17.06.13
- STAGE TWO BUILDING OUTLINE
AS PER APPROVED DRAWING DATED 17.06.13

- 1 BED
- 1 BED SOHO (COMMERCIAL/RESIDENTIAL)
- 2 BED
- 2 BED SOHO (COMMERCIAL/RESIDENTIAL)
- 3 BED
- STAGE 2 DEVELOPMENT

Revisions	No	Date	Description	Ver	App'd
G	20.06.13		ISSUE FOR INFORMATION		
H	31.07.14		75% SUBMISSION		
I	11.11.14		OUTLINE STAGE TWO BUILDINGS AS APPROVED 17.06.13		
			SHOWN IN RED ISOP REQUEST 11.11.14		

Do not scale drawings. Use legend dimensions only. Check & verify levels and dimensions on site prior to the commencement of any work, the preparation of shop drawings or the fabrication of components.

This drawing is the copyright of Allen Jack + Collier Architects and is protected under the Copyright Act 1968. Do not make, reproduce or transmit in any form, or by any means without the express permission of Allen Jack + Collier Architects.

Residential Architects: Michael Thomas 1294, Peter Ireland 5883

Site Location Plan

STAGE 2 SHOWN IN GREY



Client



Architect



Project

MACQUARIE PARK VILLAGE
110-114 HERRING ROAD
MACQUARIE PARK


Proj No. 10_030

Drawing Title
LEVEL 03 PLAN
(LEVEL 04 OMITTED)

Drawing Status
NOT FOR CONSTRUCTION

Scale
1:330@A1
Drawing No.
DA2103

Issue
1

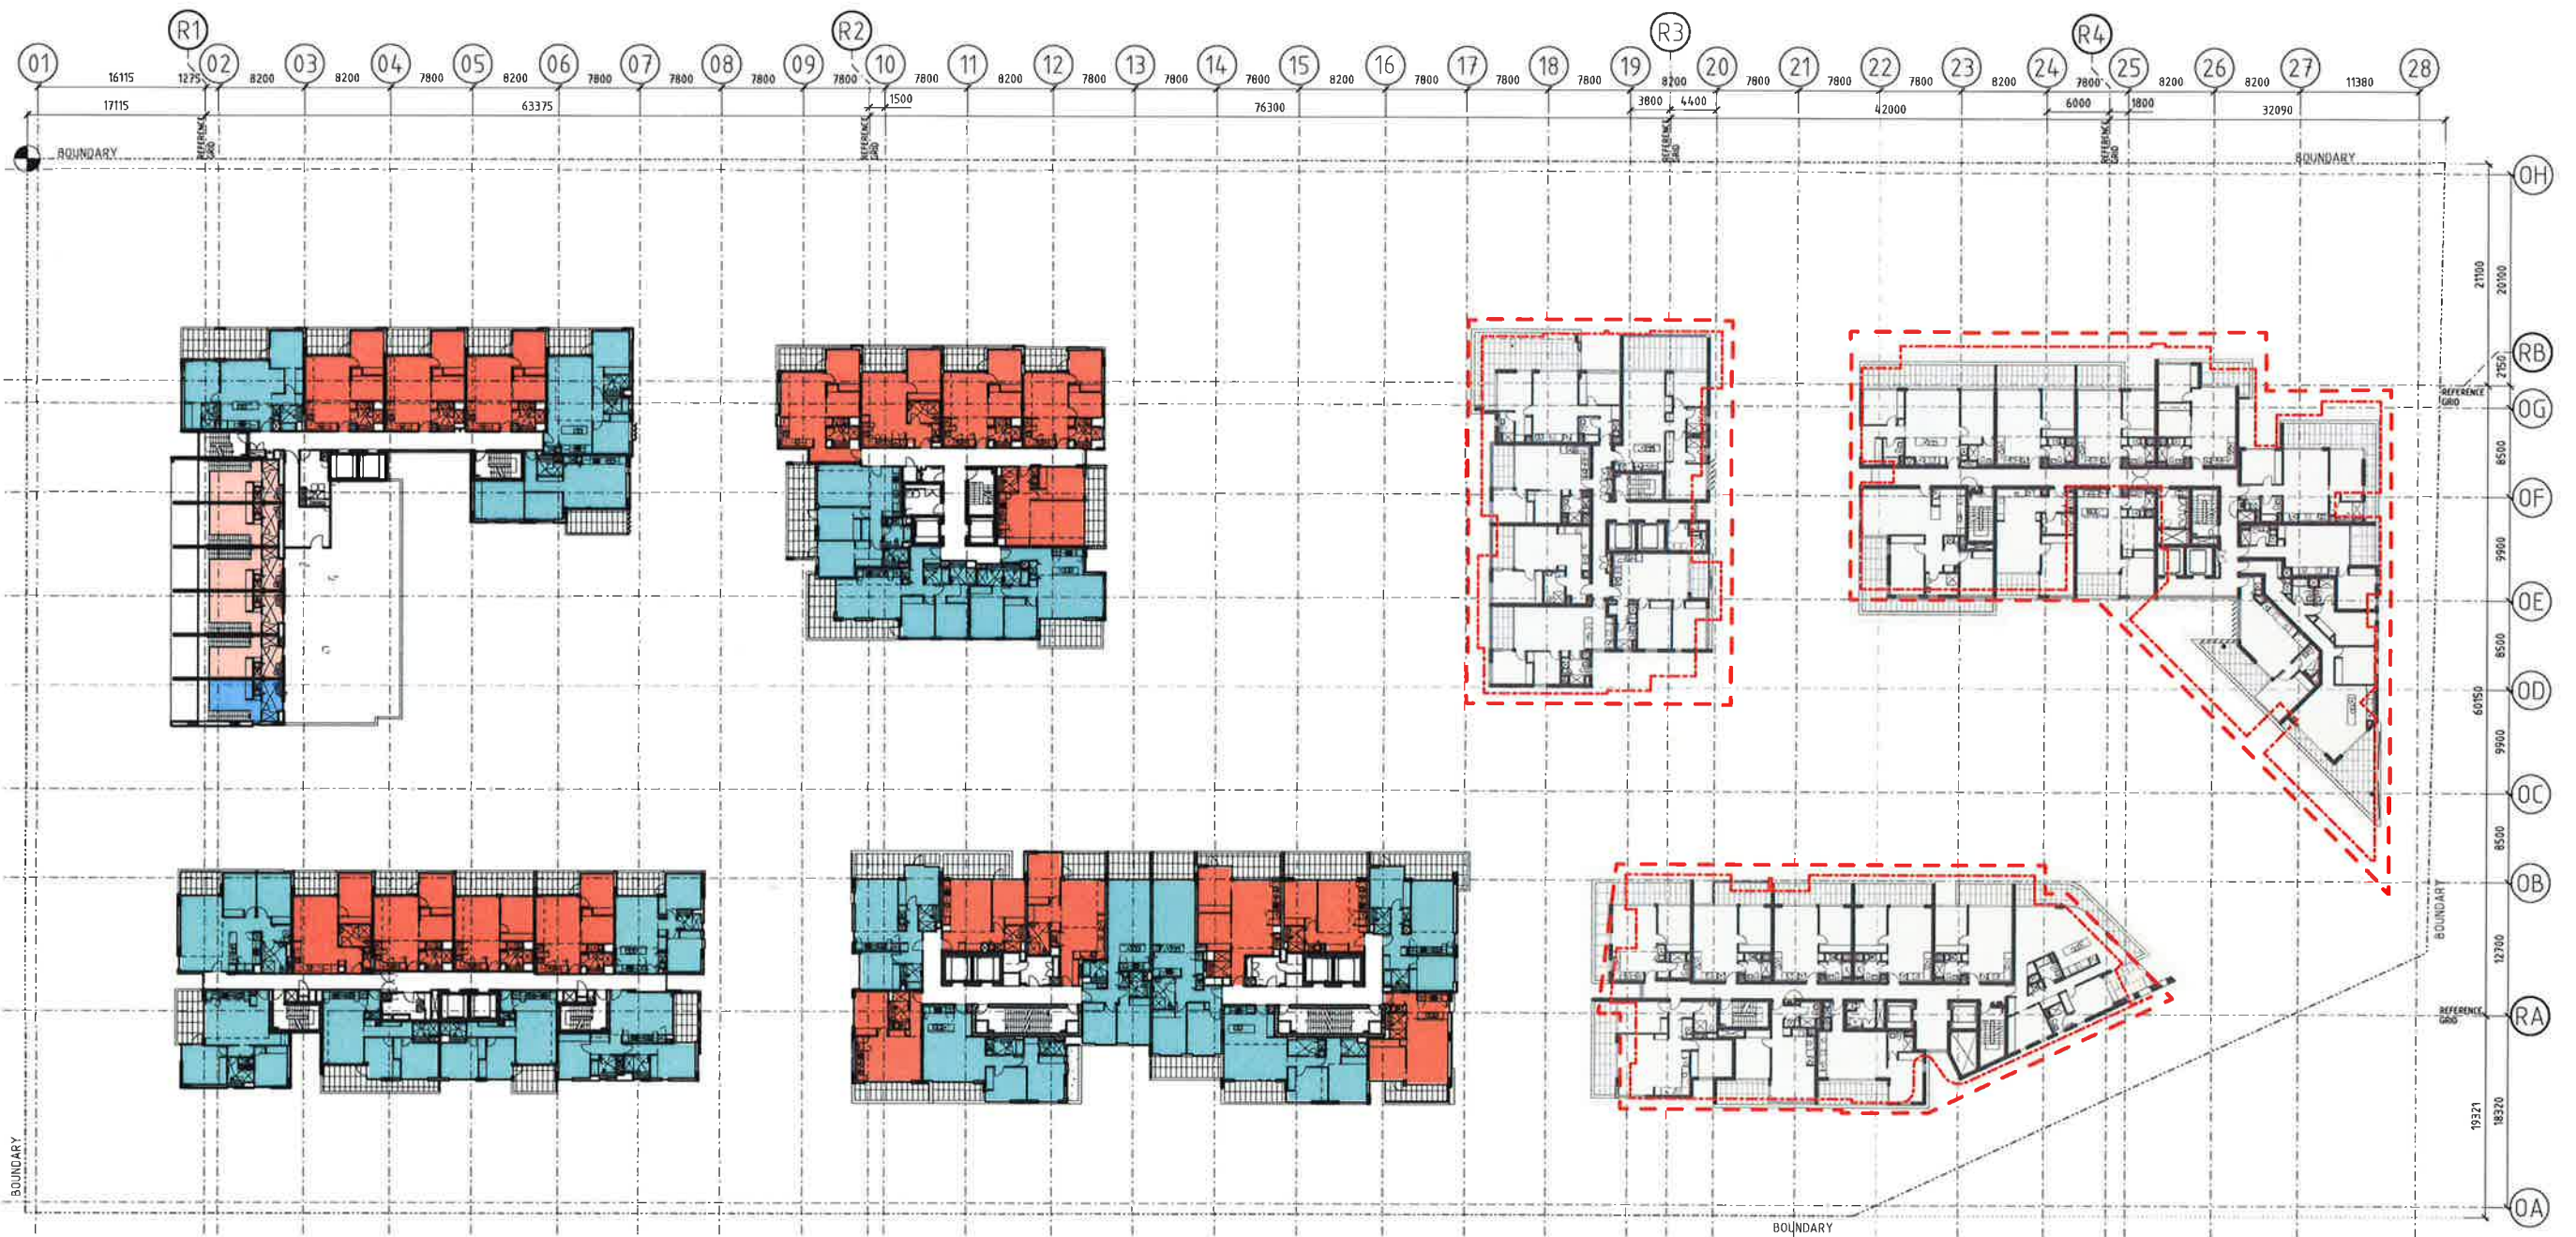

KEY

--- STAGE TWO BUILDING ENVELOPE
AS PER APPROVED DRAWING DATED 17.06.13

--- STAGE TWO BUILDING OUTLINE
AS PER APPROVED DRAWING DATED 17.06.13

1 BED

1 BED SOHO (COMMERCIAL/RESIDENTIAL)

2 BED

2 BED SOHO (COMMERCIAL/RESIDENTIAL)

3 BED

STAGE 2 DEVELOPMENT

Revisions	Date	Description	Author
G	20.08.13	ISSUE FOR INFORMATION	
H	31.07.14	PSM SUBMISSION	
		ADelaide - ROOF PLANT ENCLOSURE REVISED	
		DAWSON - EXT STAIRS REVISED	
		ALL BUILDINGS - EXTENT OF SCREENS, GLAZING, CLADDING AND BLADE WALLS REVISED	

11.11.14 OUTLINE STAGE TWO BUILDINGS AS APPROVED 17.06.13
SHOWN IN RED (OOP REQUEST 11.11.14)

Do not scale drawings. Use figured dimensions only. Check & verify levels and dimensions on site prior to the commencement of any work, the preparation of shop drawings or the fabrication of components.

This drawing is the copyright of Allen Jack + Collier Architects and is protected under the Copyright Act 1968. Do not alter, reproduce or transmit in any form, or by any means without the express permission of Allen Jack + Collier Architects.

Responsible Architects: Michael Thompson SPA, Peter Ireland SPA

Site Location Plan



STAMFORD
LAND CORPORATION LTD

AJ+C
ALLEN JACK + COLLIER
79 Myrtle Street Chippendale NSW 2008 AUSTRALIA
ph +61 2 9311 8222 fx +61 2 9311 8200 ABN 53 003 782 250


Project
MACQUARIE PARK VILLAGE
110-114 HERRING ROAD
MACQUARIE PARK

Proj No: 10_030

Drawing Title
LEVEL 05 PLAN
(LEVEL 04 OMITTED)

Drawing Status
NOT FOR CONSTRUCTION

Scale
1:330@A1
Drawing No
10_030@A1DA2105

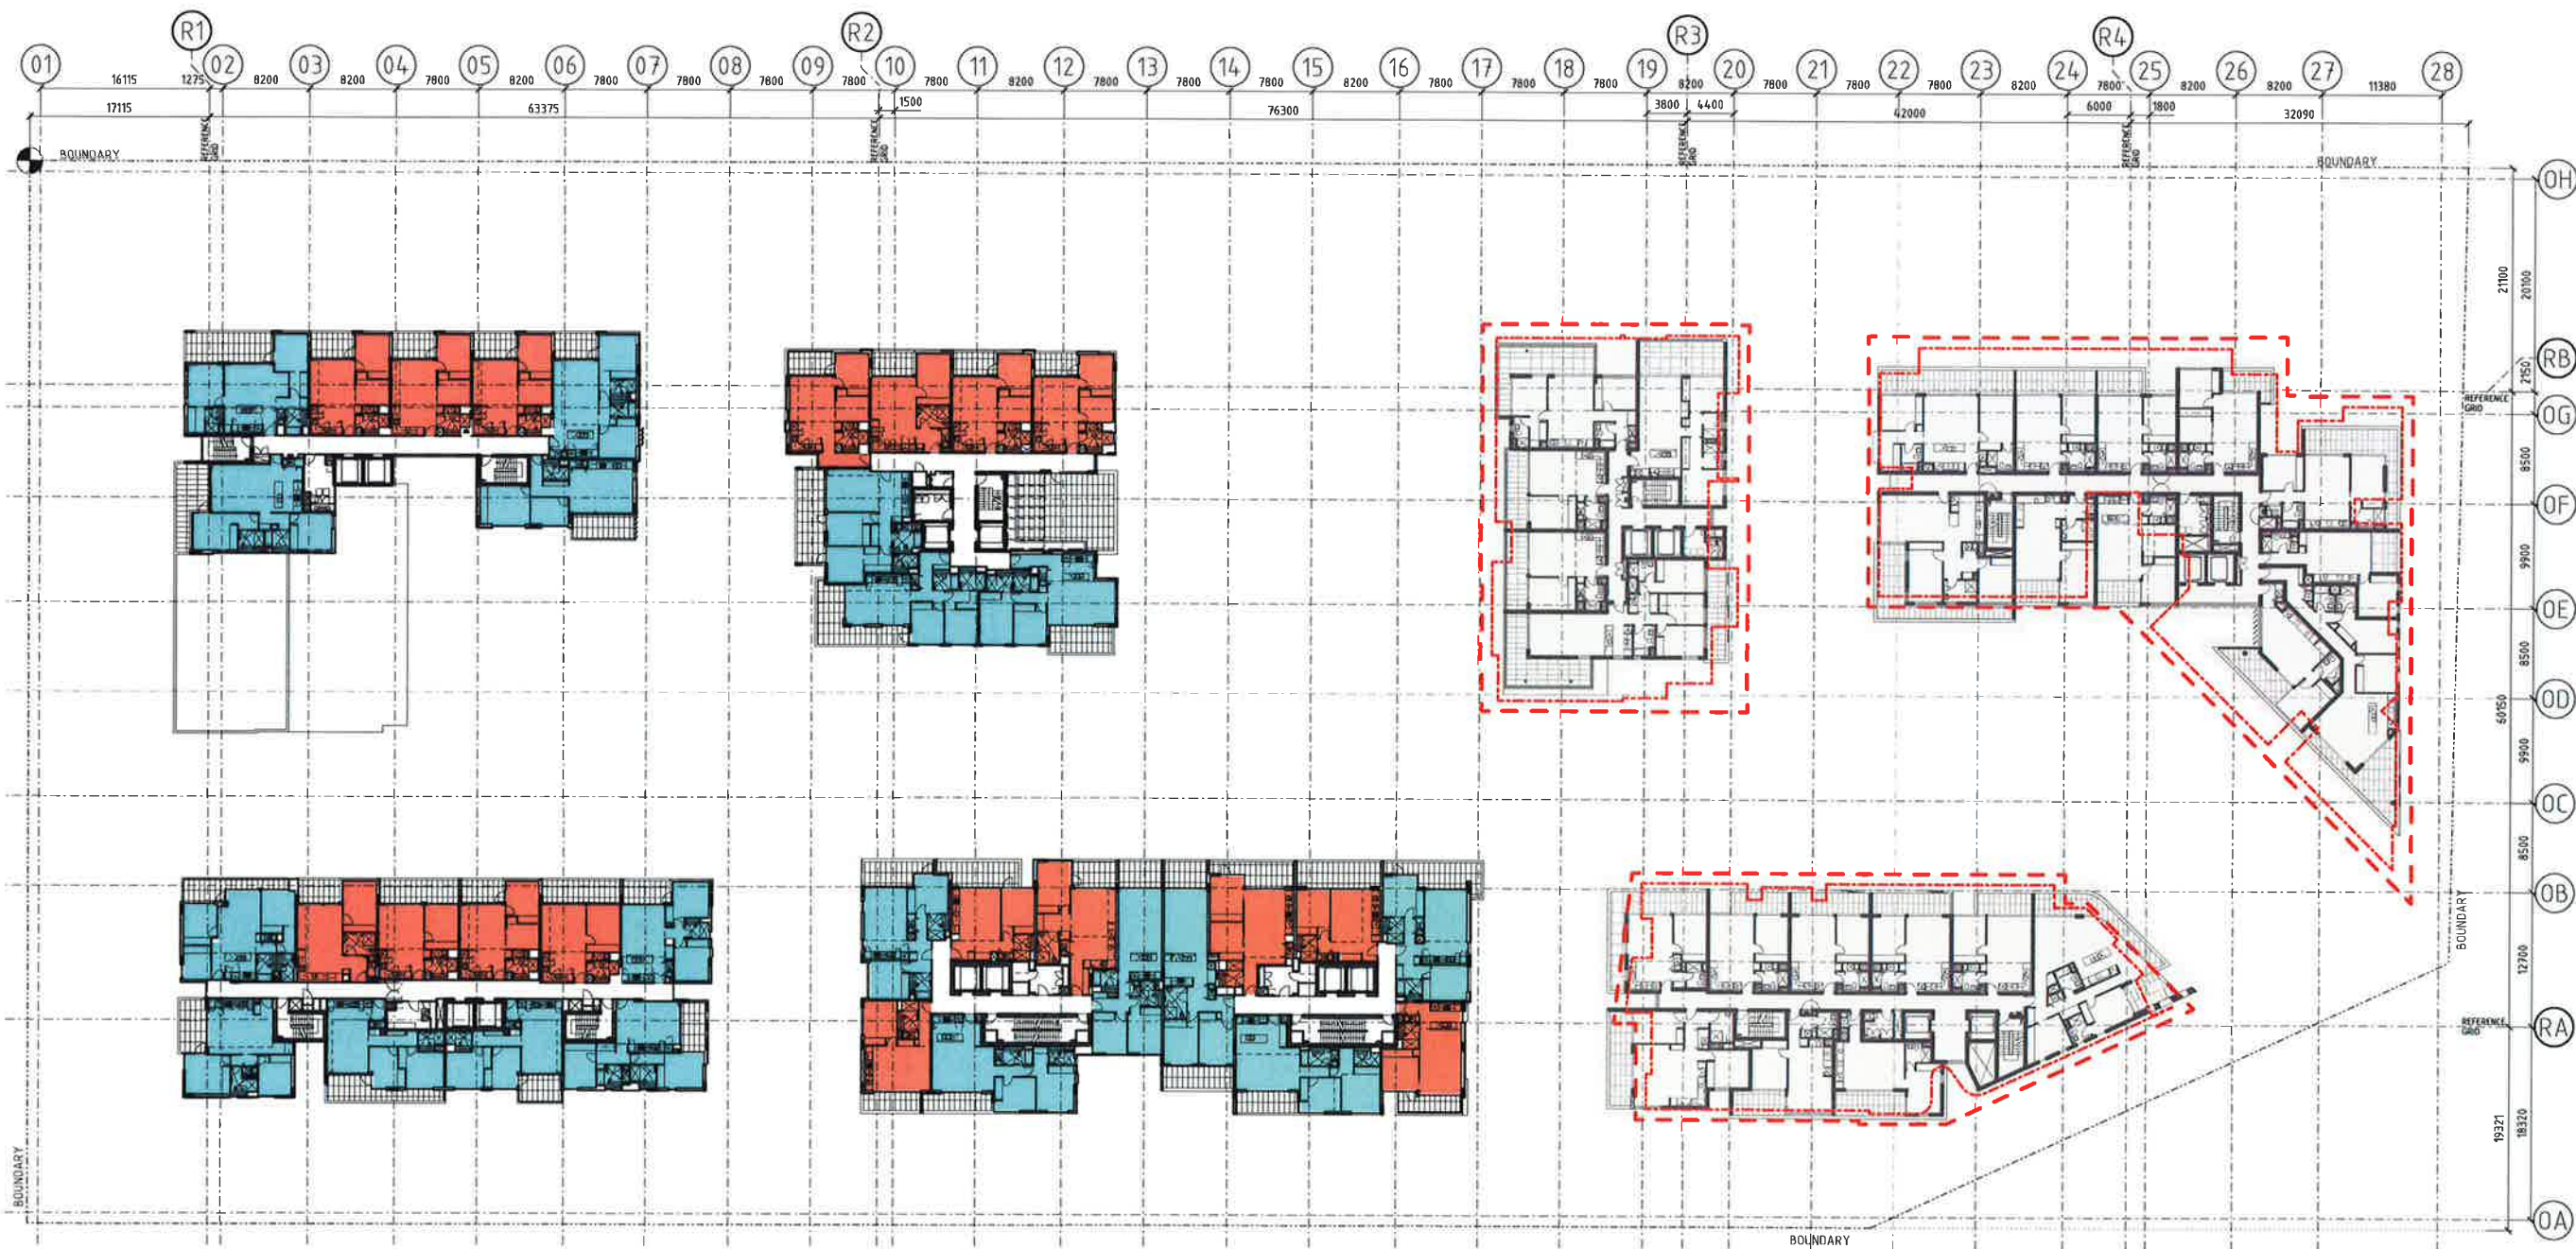

KEY

- STAGE TWO BUILDING ENVELOPE
AS PER APPROVED DRAWING DATED 17.06.13
- STAGE TWO BUILDING OUTLINE
AS PER APPROVED DRAWING DATED 17.06.13

- 1 BED
- 1 BED SOHO (COMMERCIAL/RESIDENTIAL)
- 2 BED
- 2 BED SOHO (COMMERCIAL/RESIDENTIAL)
- 3 BED
- STAGE 2 DEVELOPMENT

Revisions
No. Date Description
1 20.08.13 75W SUBMISSION
2 31.07.14 ADLCLD - ROOF PLANT ENCLOSURE REVISED
DAWING - EXT STAIRS REVISED
ALL BUILDINGS - EXTENT OF SCREENS, GLAZING,
CLADDING AND BLADE WALLS REVISED

17.06.13 OUTLINE STAGE TWO BUILDINGS AS APPROVED 17.06.13
SHOWN IN RED (DOP REQUEST 11.11.14)
This drawing is the copyright of Allen Jack + Collier Architects and is protected
under the Copyright Act 1969. Do not alter, reproduce or transmit in any form,
or by any means without the express permission of Allen Jack + Collier Architects.
Notwithstanding, Michael Hession 5264, Peter Ireland 5487

Site Location Plan



Client
STAMFORD
LAND CORPORATION LTD

Architect
AJ+C
ALLEN JACK + COLLIER
79 Myrtle Street Chippendale NSW 2008 AUSTRALIA
ph +61 2 9311 8222 fx +61 2 9311 8200 ABN 53 003 792 230

Project
MACQUARIE PARK VILLAGE
110-114 HERRING ROAD
MACQUARIE PARK

Proj No: 10_030


Drawing Title
LEVEL 06 PLAN

Drawing Status
NOT FOR CONSTRUCTION

Scale
1:330@A1

Drawing No
DA2106

Issue
F

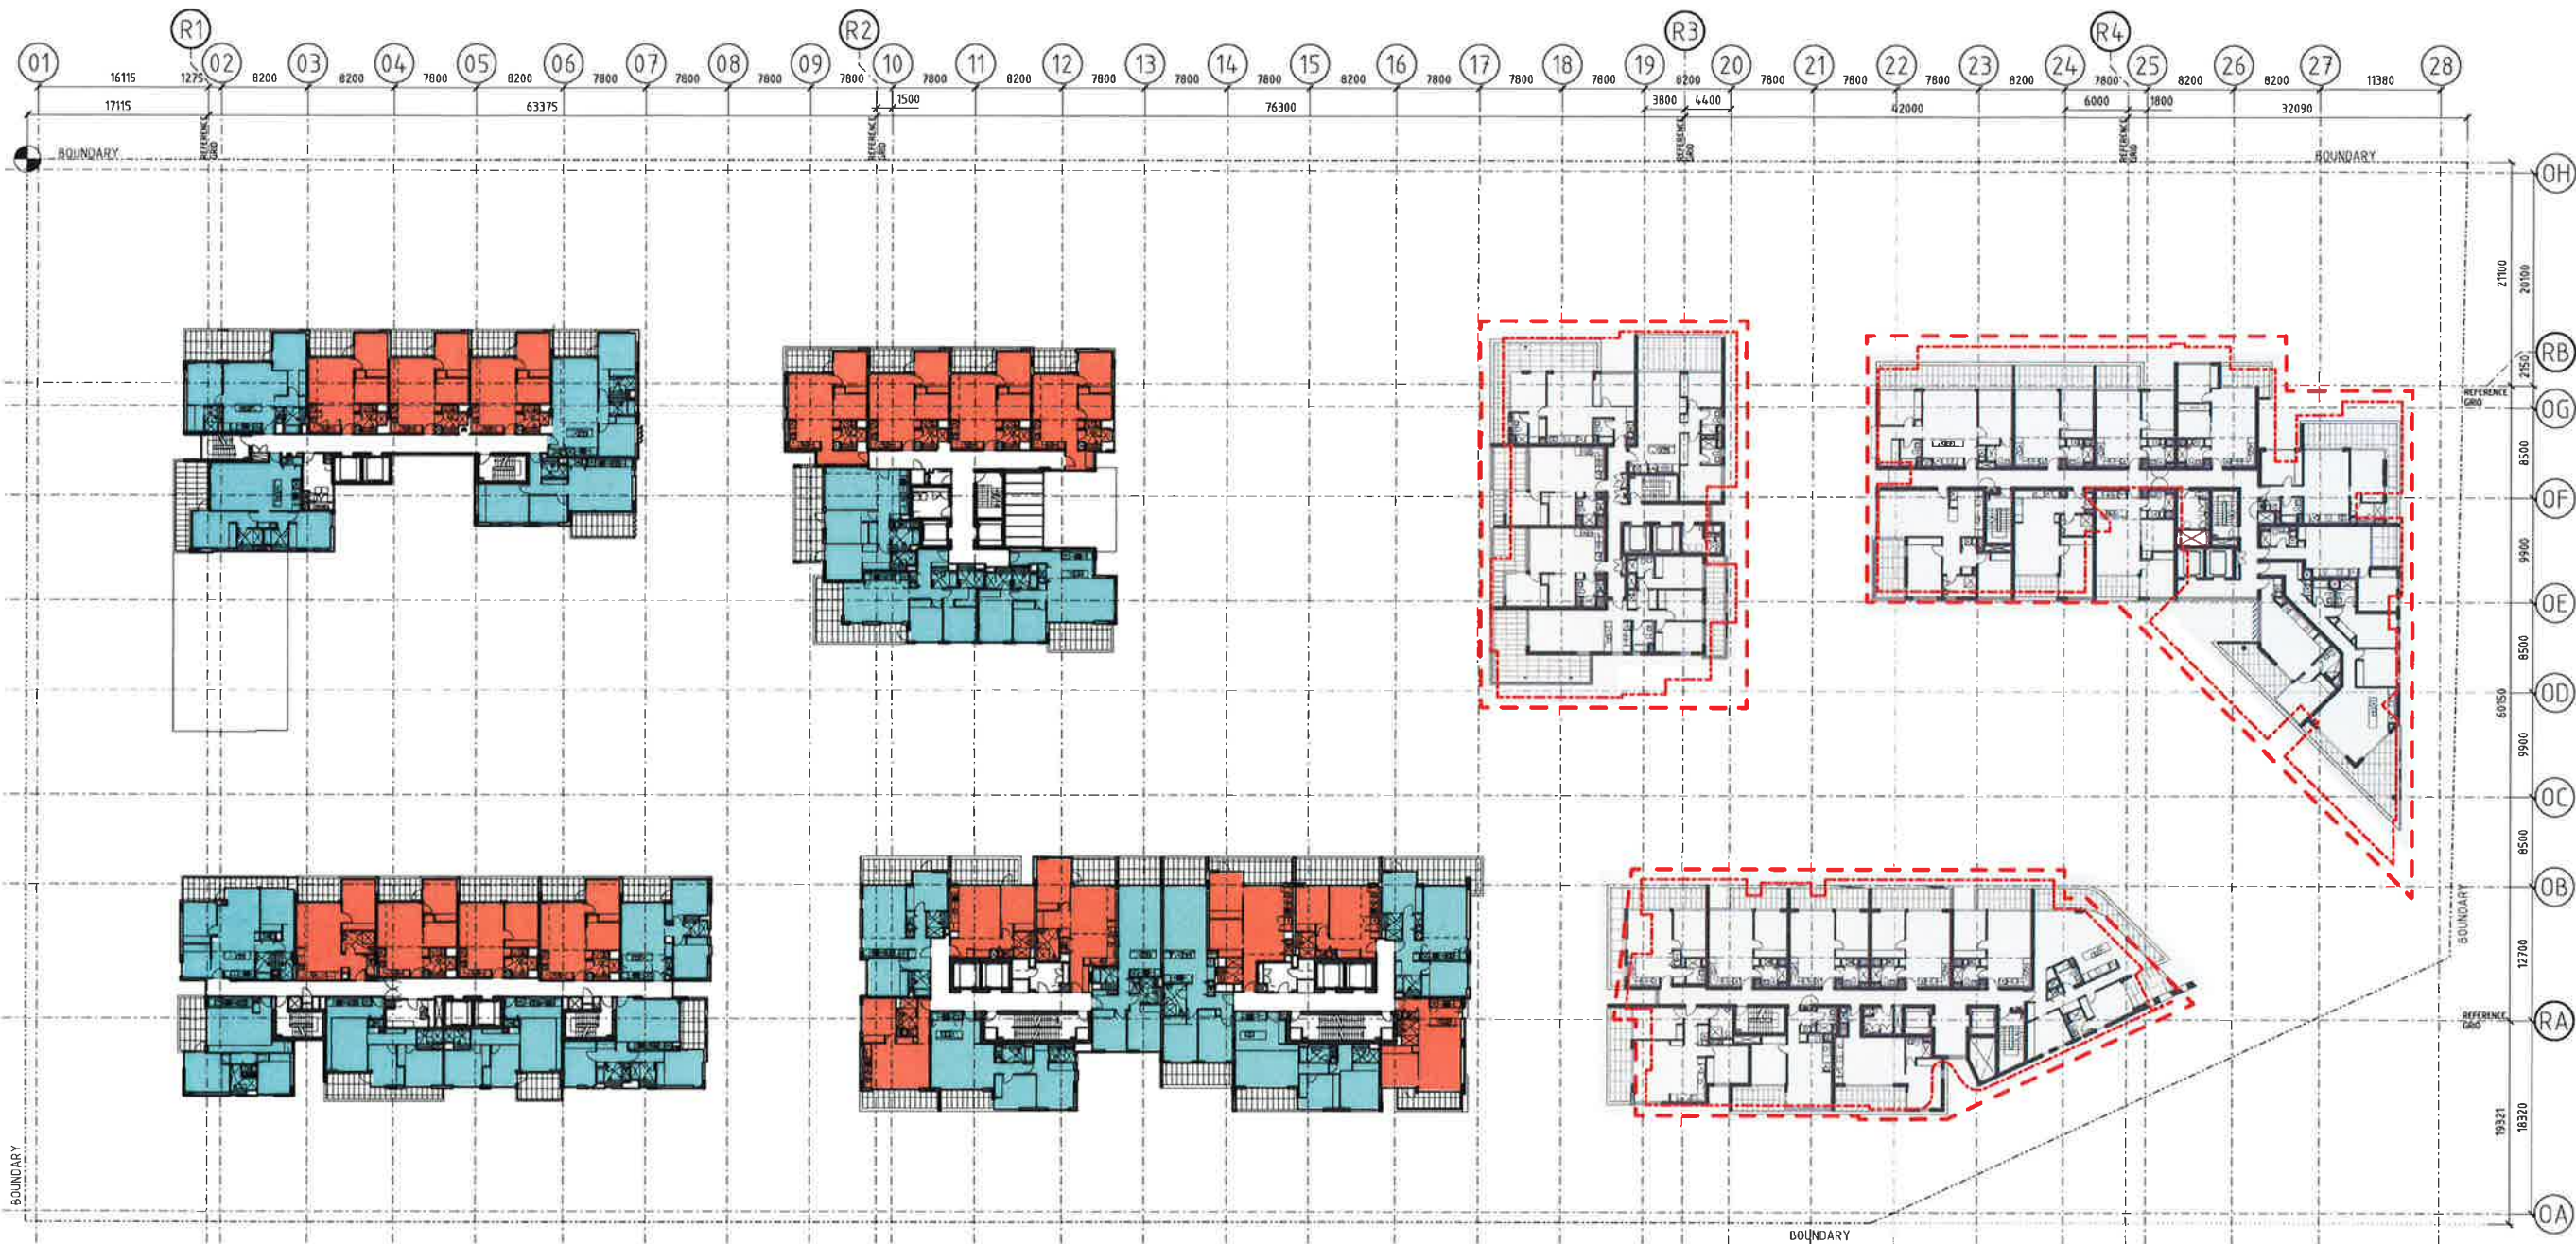

KEY

--- STAGE TWO BUILDING ENVELOPE
AS PER APPROVED DRAWING DATED 17.06.13

--- STAGE TWO BUILDING OUTLINE
AS PER APPROVED DRAWING DATED 17.06.13

- 1 BED
- 1 BED SOHO (COMMERCIAL/RESIDENTIAL)
- 2 BED
- 2 BED SOHO (COMMERCIAL/RESIDENTIAL)
- 3 BED
- STAGE 2 DEVELOPMENT

Revisions	No	Date	Description	Ver	App'd
0	20.08.19	ISSUE FOR INFORMATION			
1	31.07.16	75W SUBMISSION			
		ADelaide - ROOF PLANT ENCLOSURE REVISED			
		DARWIN - EXIT STAIRS REVISED			
		ALL BUILDINGS - EXTENT OF SCREENS, GLAZING, CLADDING AND BLADE WALLS REVISED			

F 11.11.14 OUTLINE STAGE TWO BUILDINGS AS APPROVED 17.06.13
SHOWN IN RED (DOP REQUEST 11.11.14)

Do not scale drawings. Use figured dimensions only. Check & verify levels and orientations on site prior to the commencement of any work, the preparation of shop drawings or the fabrication of components.

This drawing is the copyright of Alan Jack - Gifford Architects and is protected under the Copyright Act 1968. Do not alter, reproduce or transmit in any form, or by any means without the express permission of Alan Jack - Gifford Architects. Notwithstanding, Michael Henson 0885, Peter Ireland 0881

Site Location Plan



Client

STAMFORD
LAND CORPORATION LTD

Architect

AJ+C
MICHAEL JACK & CO
79 Myrtle Street Chippendale NSW 2008 AUSTRALIA
ph +61 2 9311 8222 fx +61 2 9311 8200 ABN 53 003 792 290

Project

MACQUARIE PARK VILLAGE
110-114 HERRING ROAD
MACQUARIE PARK

Proj No. 10_030

Drawing Title

LEVEL 07 PLAN

Drawing Status


NOT FOR CONSTRUCTION

Scale

1:330@A1DA2107

Issue

F

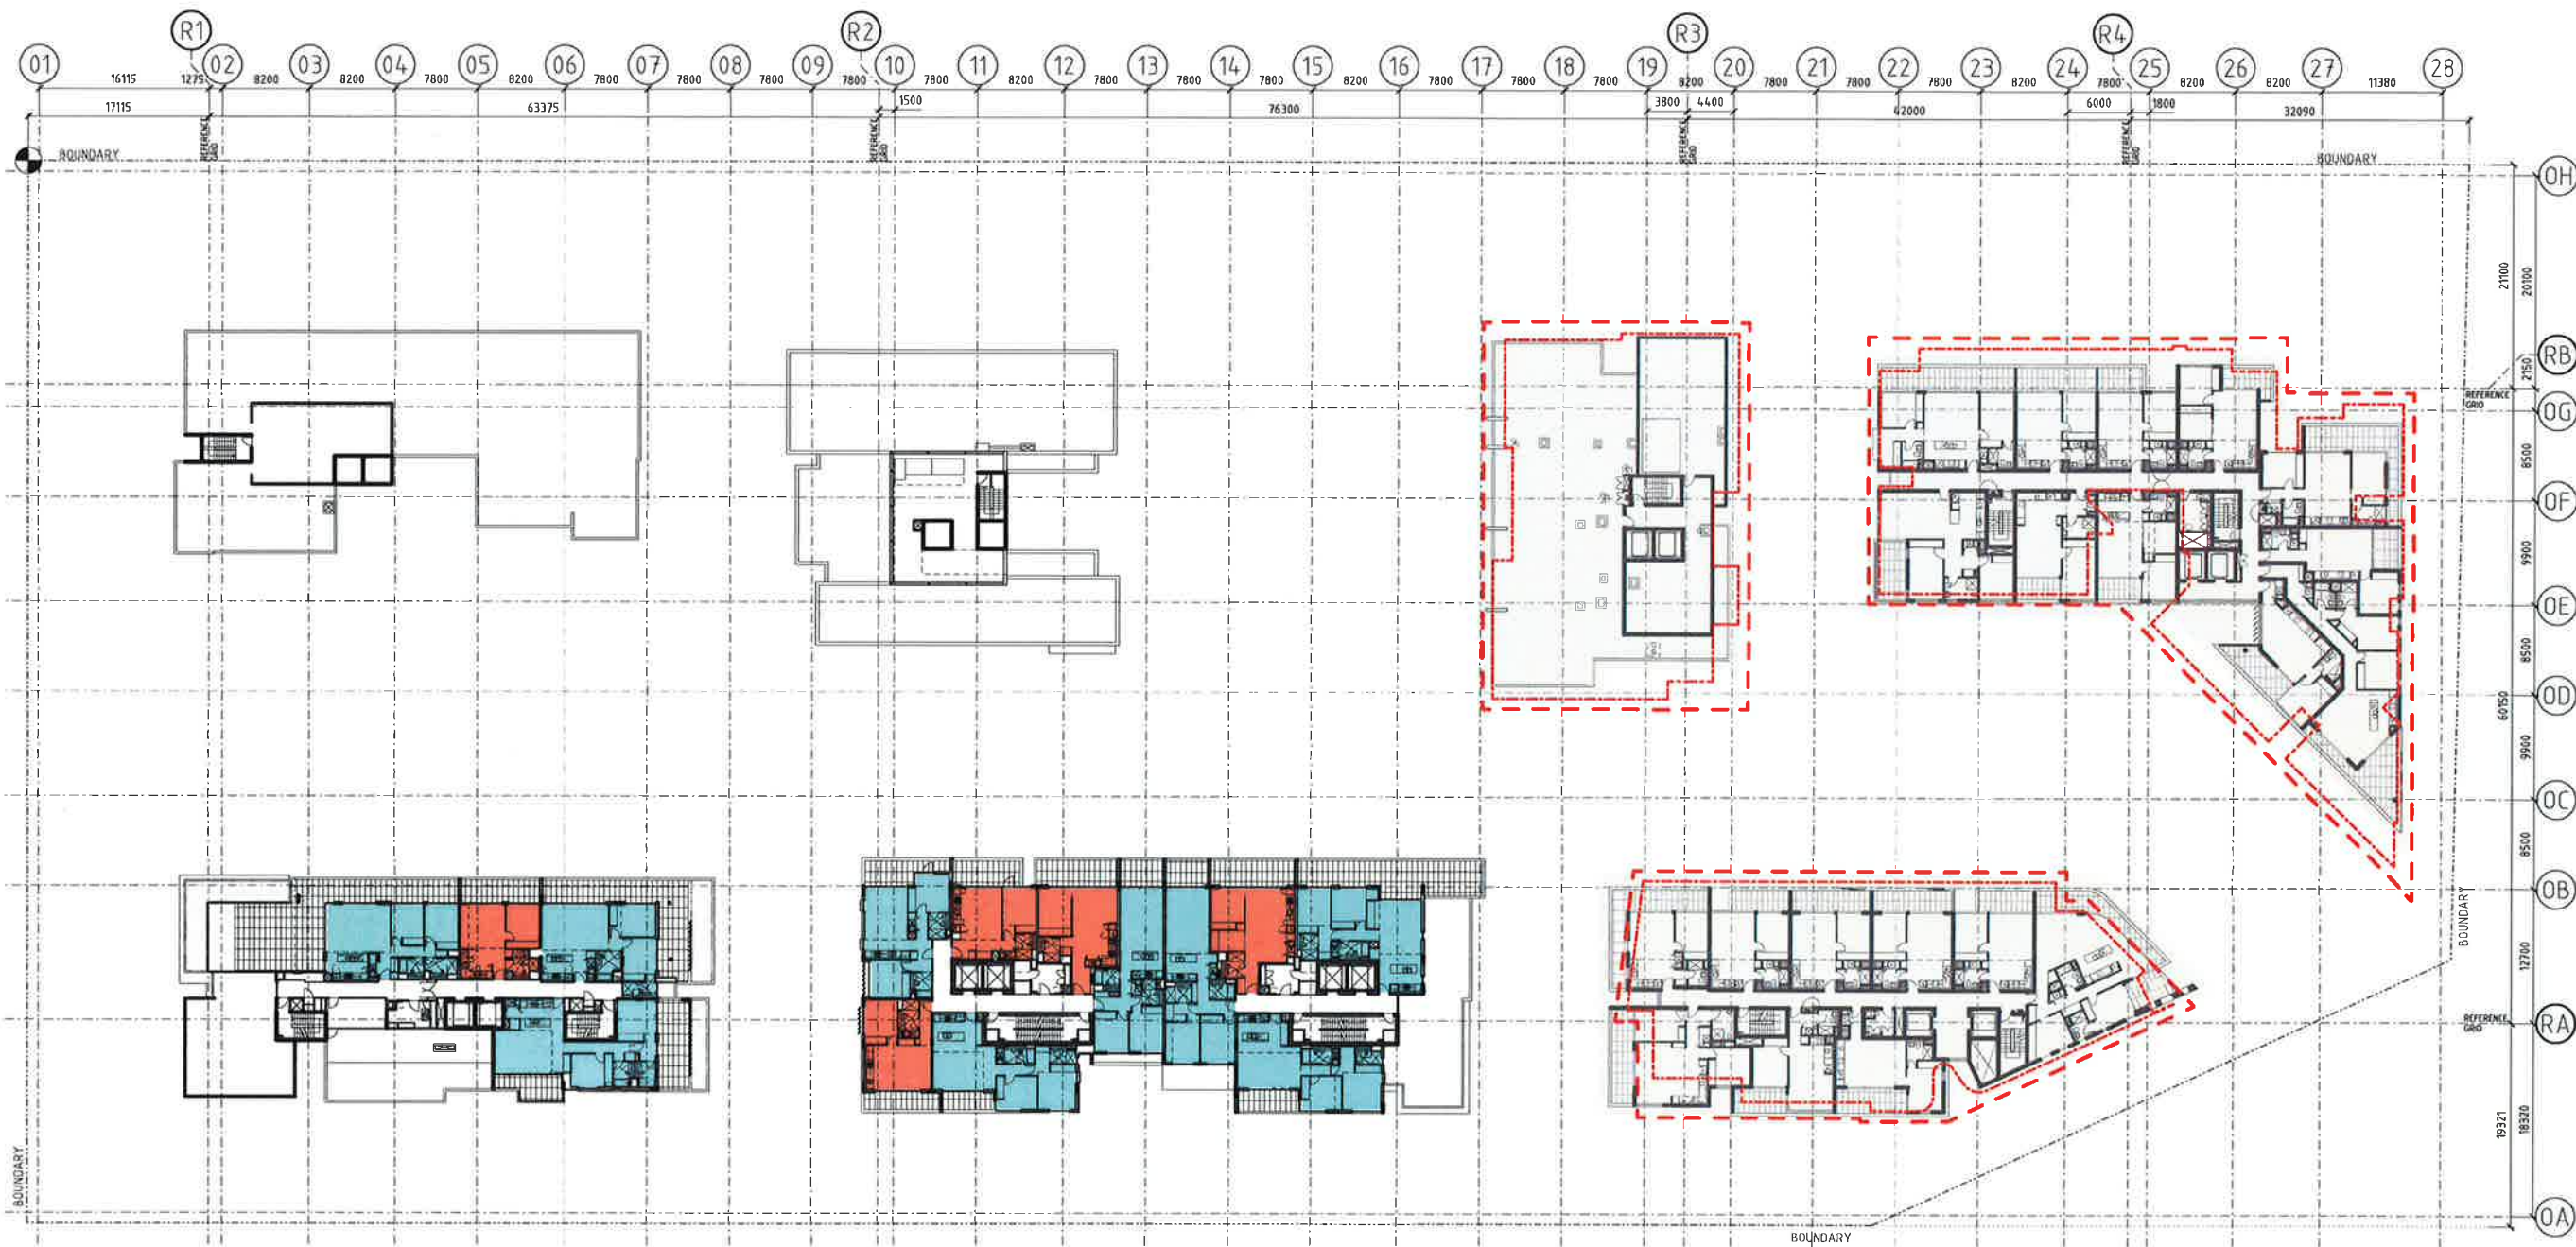

KEY

- STAGE TWO BUILDING ENVELOPE
AS PER APPROVED DRAWING DATED 17.06.13
- STAGE TWO BUILDING OUTLINE
AS PER APPROVED DRAWING DATED 17.06.13

- 1 BED
- 1 BED SOHO (COMMERCIAL/RESIDENTIAL)
- 2 BED
- 2 BED SOHO (COMMERCIAL/RESIDENTIAL)
- 3 BED
- STAGE 2 DEVELOPMENT

Revisions	No	Date	Description	By	App'd
D	20.08.13		ISSUE FOR INFORMATION		
E	31.07.14		PSW SUBMISSION		
			ALL BUILDINGS - ROOF AND PLANT EQUIPMENT, EXTENT OF SCREENS, GLAZING, CLADDING AND BLADE WALLS REVISED		
F	19.11.14		OUTLINE STAGE TWO BUILDINGS AS APPROVED 17.06.13 SHOWN IN RED (DOP REQUEST 11.11.14)		


Do not scale drawings. Use figure dimensions only. Check & verify levels and dimensions on site prior to the commencement of any work, the preparation of shop drawings or the fabrication of components.

This drawing is the copyright of Allen Jack + Collier Architects and is protected under the Copyright Act 1968. Do not alter, reproduce or transmit in any form, or in any means without the express permission of Allen Jack + Collier Architects.

Named Architects: Michael Heenan SMA, Peter Island SMAT

Site Location Plan

STAGE 2 SHOWN IN GREY

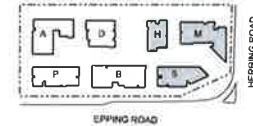

Client



Architect



Project
MACQUARIE PARK VILLAGE
110-114 HERRING ROAD
MACQUARIE PARK

Proj No. 10_030


Drawing Title
LEVEL 09 PLAN

Drawing Status
NOT FOR CONSTRUCTION

Scale
1:330@A1DA2109

Issue

F

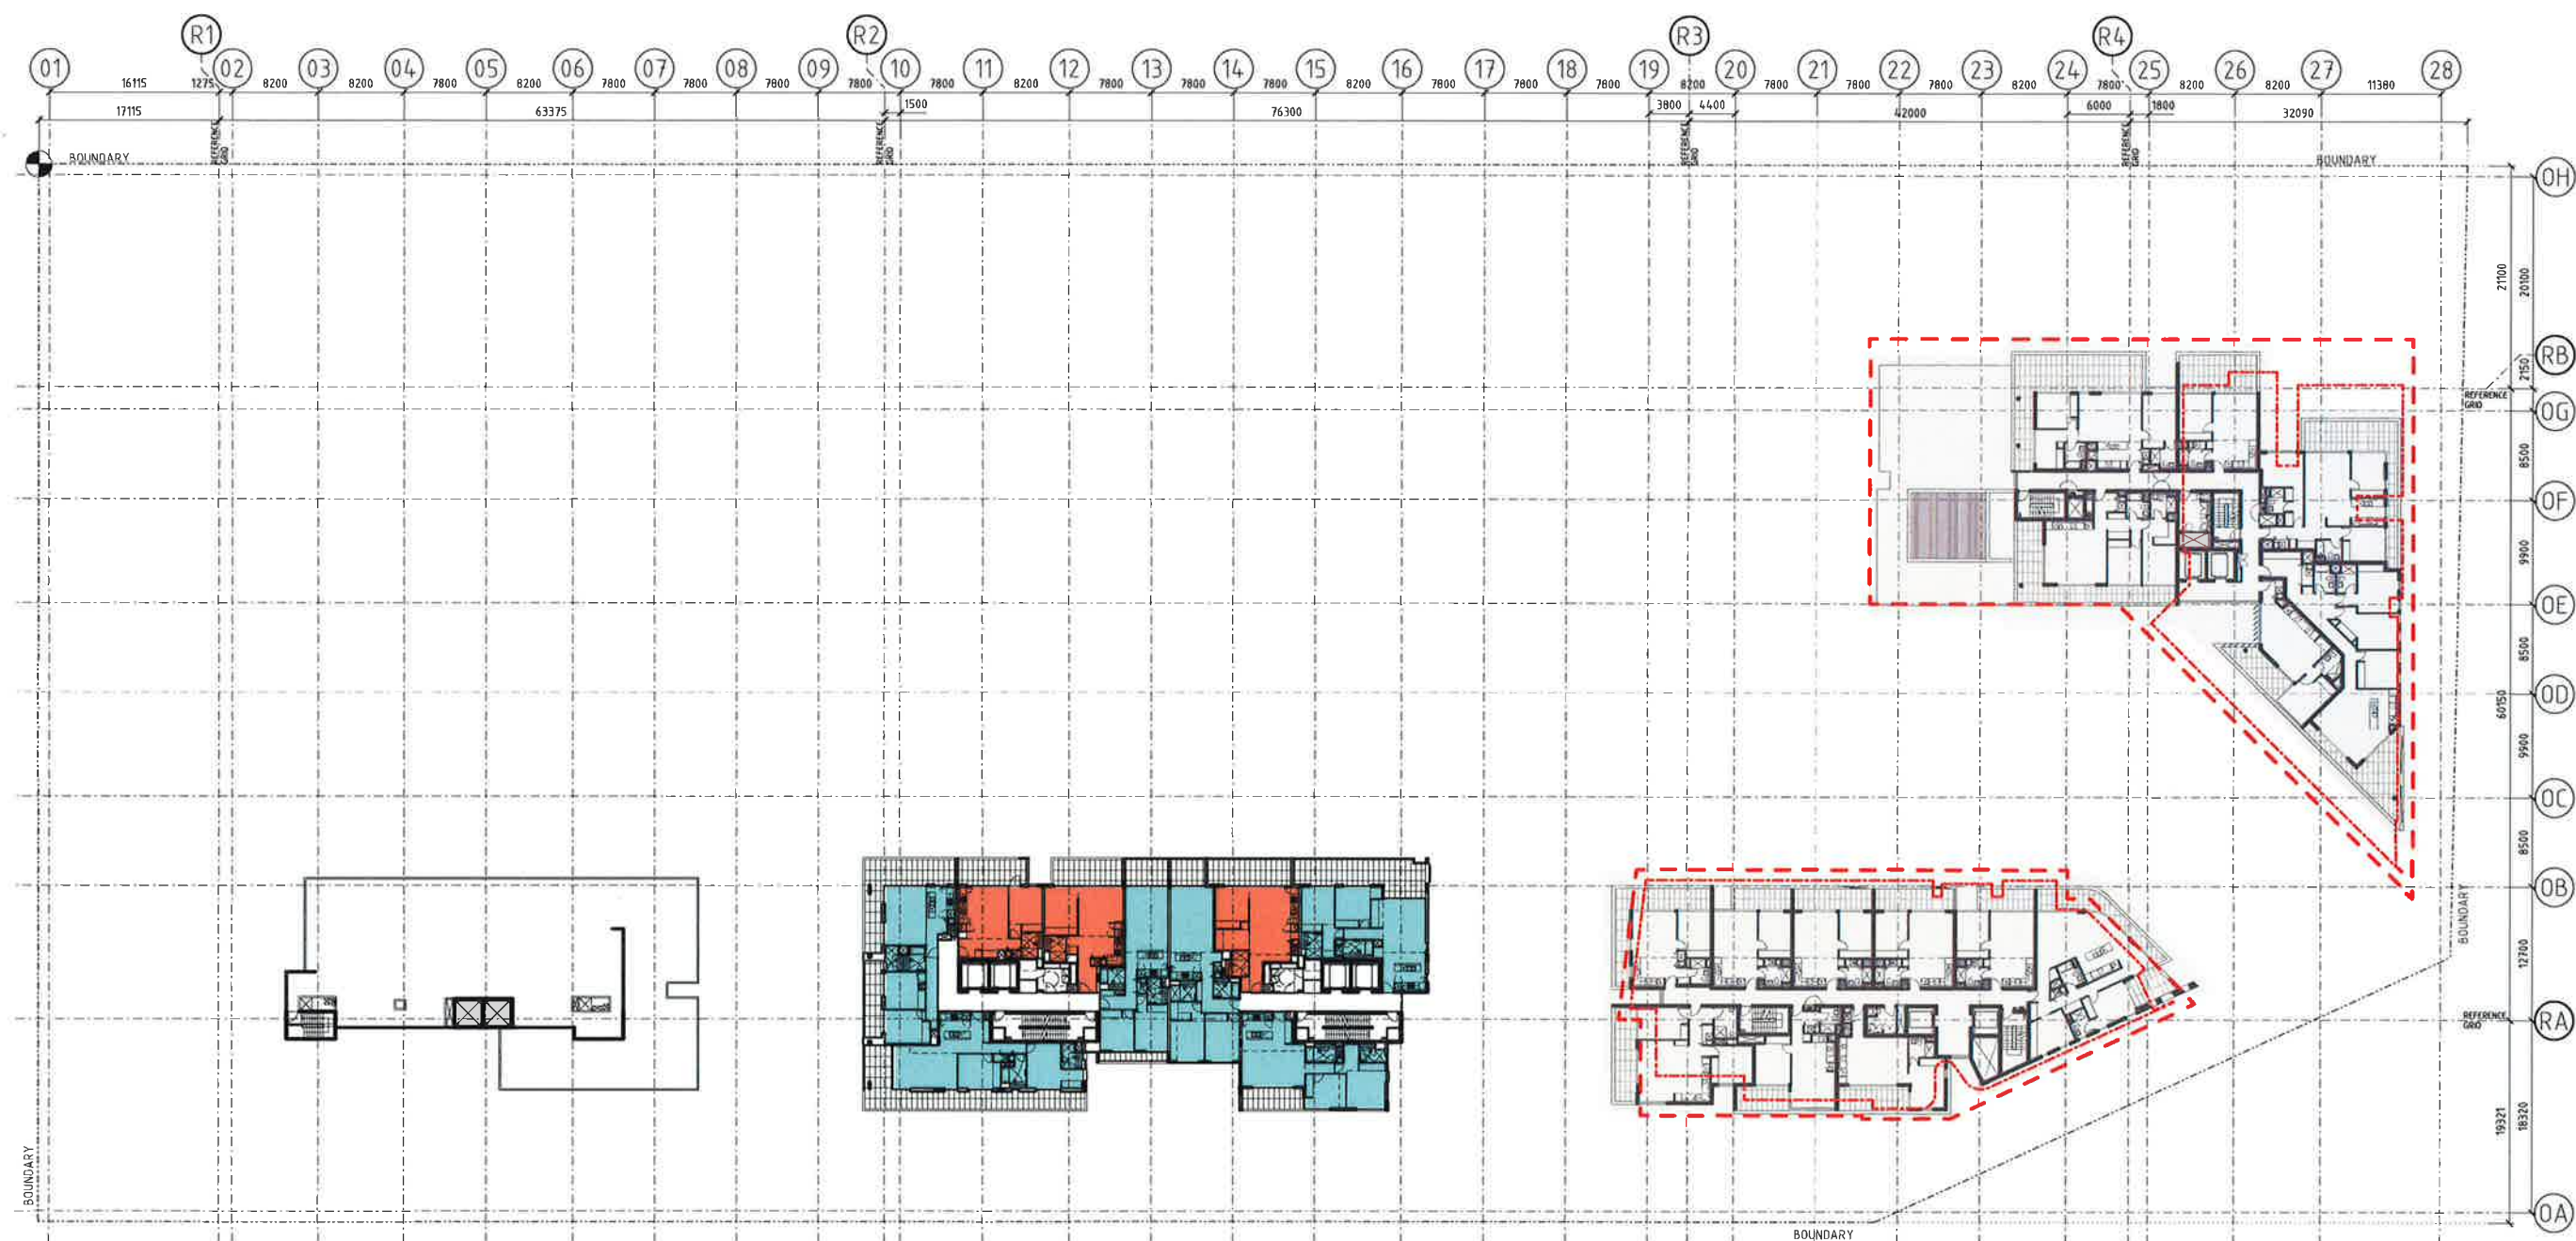

KEY

--- STAGE TWO BUILDING ENVELOPE
AS PER APPROVED DRAWING DATED 17.06.13

----- STAGE TWO BUILDING OUTLINE
AS PER APPROVED DRAWING DATED 17.06.13

-  1 BED
-  1 BED SOHO (COMMERCIAL/RESIDENTIAL)
-  2 BED
-  2 BED SOHO (COMMERCIAL/RESIDENTIAL)
-  3 BED
-  STAGE 2 DEVELOPMENT

Revisions		
No	Date	Description
E	20 08 13	ISSUE FOR INFORMATION
F	31 07 16	75W SUBMISSION
		PERTH - ROOF AND PLANT EQUIPMENT REVISED
		BRISBANE - APARTMENT ADDED
		ALL BUILDINGS - ROOF AND PLANT EQUIPMENT,
		EXTENT OF SCREENS, GLAZING, CLADDING AND
		BLADE WALLS REVISED

G 1111 14 OUTLINE STAGE TWO BUILDINGS AS APPROVED 17/04/13
SHOWN IN REQ (DOP REQUEST 1111 14)

Do not scale drawings. Use figured dimensions only. Check & verify levels and dimensions on site prior to the commencement of any work, the preparation of shop drawings or the fabrication of components.

This drawing is the copyright of Allen Jack + Collier Architects and is protected under the Copyright Act 1968. Do not alter, reproduce or transmit in any form, or by any means without the express permission of Allen Jack + Collier Architects.

Resonant Architects, Michael Pearson 1264, Peter Ireland 1881

[Site Location Plan]



| Client:



STAMFORD
LAND CORPORATION LTD

Architect

AJ+C
AUS JACK-COTTER
79 Myrle Street Chippendale NSW 2008 AUSTRALIA
ph +61 2 9311 8222 fx +61 2 9311 8200 ABN 53 003 782 250

Project
MACQUARIE PARK VILLAGE
110-114 HERRING ROAD
MACQUARIE PARK

Proj No. 10_030




Drawing Title
LEVEL 11 PLAN

Drawing Status
NOT FOR CONSTRUCTION

Scale | Drawing No
1:330@A1 DA2111

1

1. **Introduction**
 2. **Background**
 3. **Methodology**
 4. **Results**
 5. **Discussion**
 6. **Conclusion**
 7. **References**
 8. **Appendix**
 9. **Notes**
 10. **Tables**
 11. **Figures**
 12. **Supplementary Materials**
 13. **Author Contributions**
 14. **Conflicts of Interest**
 15. **Acknowledgments**
 16. **References**
 17. **Appendix**
 18. **Notes**
 19. **Tables**
 20. **Figures**
 21. **Supplementary Materials**
 22. **Author Contributions**
 23. **Conflicts of Interest**
 24. **Acknowledgments**
 25. **References**
 26. **Appendix**
 27. **Notes**
 28. **Tables**
 29. **Figures**
 30. **Supplementary Materials**
 31. **Author Contributions**
 32. **Conflicts of Interest**
 33. **Acknowledgments**
 34. **References**
 35. **Appendix**
 36. **Notes**
 37. **Tables**
 38. **Figures**
 39. **Supplementary Materials**
 40. **Author Contributions**
 41. **Conflicts of Interest**
 42. **Acknowledgments**
 43. **References**
 44. **Appendix**
 45. **Notes**
 46. **Tables**
 47. **Figures**
 48. **Supplementary Materials**
 49. **Author Contributions**
 50. **Conflicts of Interest**
 51. **Acknowledgments**
 52. **References**
 53. **Appendix**
 54. **Notes**
 55. **Tables**
 56. **Figures**
 57. **Supplementary Materials**
 58. **Author Contributions**
 59. **Conflicts of Interest**
 60. **Acknowledgments**
 61. **References**
 62. **Appendix**
 63. **Notes**
 64. **Tables**
 65. **Figures**
 66. **Supplementary Materials**
 67. **Author Contributions**
 68. **Conflicts of Interest**
 69. **Acknowledgments**
 70. **References**
 71. **Appendix**
 72. **Notes**
 73. **Tables**
 74. **Figures**
 75. **Supplementary Materials**
 76. **Author Contributions**
 77. **Conflicts of Interest**
 78. **Acknowledgments**
 79. **References**
 80. **Appendix**
 81. **Notes**
 82. **Tables**
 83. **Figures**
 84. **Supplementary Materials**
 85. **Author Contributions**
 86. **Conflicts of Interest**
 87. **Acknowledgments**
 88. **References**
 89. **Appendix**
 90. **Notes**
 91. **Tables**
 92. **Figures**
 93. **Supplementary Materials**
 94. **Author Contributions**
 95. **Conflicts of Interest**
 96. **Acknowledgments**
 97. **References**
 98. **Appendix**
 99. **Notes**
 100. **Tables**
 101. **Figures**
 102. **Supplementary Materials**
 103. **Author Contributions**
 104. **Conflicts of Interest**
 105. **Acknowledgments**
 106. **References**
 107. **Appendix**
 108. **Notes**
 109. **Tables**
 110. **Figures**
 111. **Supplementary Materials**
 112. **Author Contributions**
 113. **Conflicts of Interest**
 114. **Acknowledgments**
 115. **References**
 116. **Appendix**
 117. **Notes**
 118. **Tables**
 119. **Figures**
 120. **Supplementary Materials**
 121. **Author Contributions**
 122. **Conflicts of Interest**
 123. **Acknowledgments**
 124. **References**
 125. **Appendix**
 126. **Notes**
 127. **Tables**
 128. **Figures**
 129. **Supplementary Materials**
 130. **Author Contributions**
 131. **Conflicts of Interest**
 132. **Acknowledgments**
 133. **References**
 134. **Appendix**
 135. **Notes**
 136. **Tables**
 137. **Figures**
 138. **Supplementary Materials**
 139. **Author Contributions**
 140. **Conflicts of Interest**
 141. **Acknowledgments**
 142. **References**
 143. **Appendix**
 144. **Notes**
 145. **Tables**
 146. **Figures**
 147. **Supplementary Materials**
 148. **Author Contributions**
 149. **Conflicts of Interest**
 150. **Acknowledgments**
 151. **References**
 152. **Appendix**
 153. **Notes**
 154. **Tables**
 155. **Figures**
 156. **Supplementary Materials**
 157. **Author Contributions**
 158. **Conflicts of Interest**
 159. **Acknowledgments**
 160. **References**
 161. **Appendix**
 162. **Notes**
 163. **Tables**
 164. **Figures**
 165. **Supplementary Materials**
 166. **Author Contributions**
 167. **Conflicts of Interest**
 168. **Acknowledgments**
 169. **References**
 170. **Appendix**
 171. **Notes**
 172. **Tables**
 173. **Figures**
 174. **Supplementary Materials**
 175. **Author Contributions**
 176. **Conflicts of Interest**
 177. **Acknowledgments**
 178. **References**
 179. **Appendix**
 180. **Notes**
 181. **Tables**
 182. **Figures**
 183. **Supplementary Materials**
 184. **Author Contributions**
 185. **Conflicts of Interest**
 186. **Acknowledgments**
 187. **References**
 188. **Appendix**
 189. **Notes**
 190. **Tables**
 191. **Figures**
 192. **Supplementary Materials**
 193. **Author Contributions**
 194. **Conflicts of Interest**
 195. **Acknowledgments**
 196. **References**
 197. **Appendix**
 198. **Notes**
 199. **Tables**
 200. **Figures**
 201. **Supplementary Materials**
 202. **Author Contributions**
 203. **Conflicts of Interest**
 204. **Acknowledgments**
 205. **References**
 206. **Appendix**
 207. **Notes**
 208. **Tables**
 209. **Figures**
 210. **Supplementary Materials**
 211. **Author Contributions**
 212. **Conflicts of Interest**
 213. **Acknowledgments**
 214. **References**
 215. **Appendix**
 216. **Notes**
 217. **Tables**
 218. **Figures**
 219. **Supplementary Materials**
 220. **Author Contributions**
 221. **Conflicts of Interest**
 222. **Acknowledgments**
 223. **References**
 224. **Appendix**
 225. **Notes**
 226. **Tables**
 227. **Figures**
 228. **Supplementary Materials**
 229. **Author Contributions**
 230. **Conflicts of Interest**
 231. **Acknowledgments**
 232. **References**
 233. **Appendix**
 234. **Notes**
 235. **Tables**
 236. **Figures**
 237. **Supplementary Materials**
 238. **Author Contributions**
 239. **Conflicts of Interest**
 240. **Acknowledgments**
 241. **References**
 242. **Appendix**
 243. **Notes**
 244. **Tables**
 245. **Figures**
 246. **Supplementary Materials**

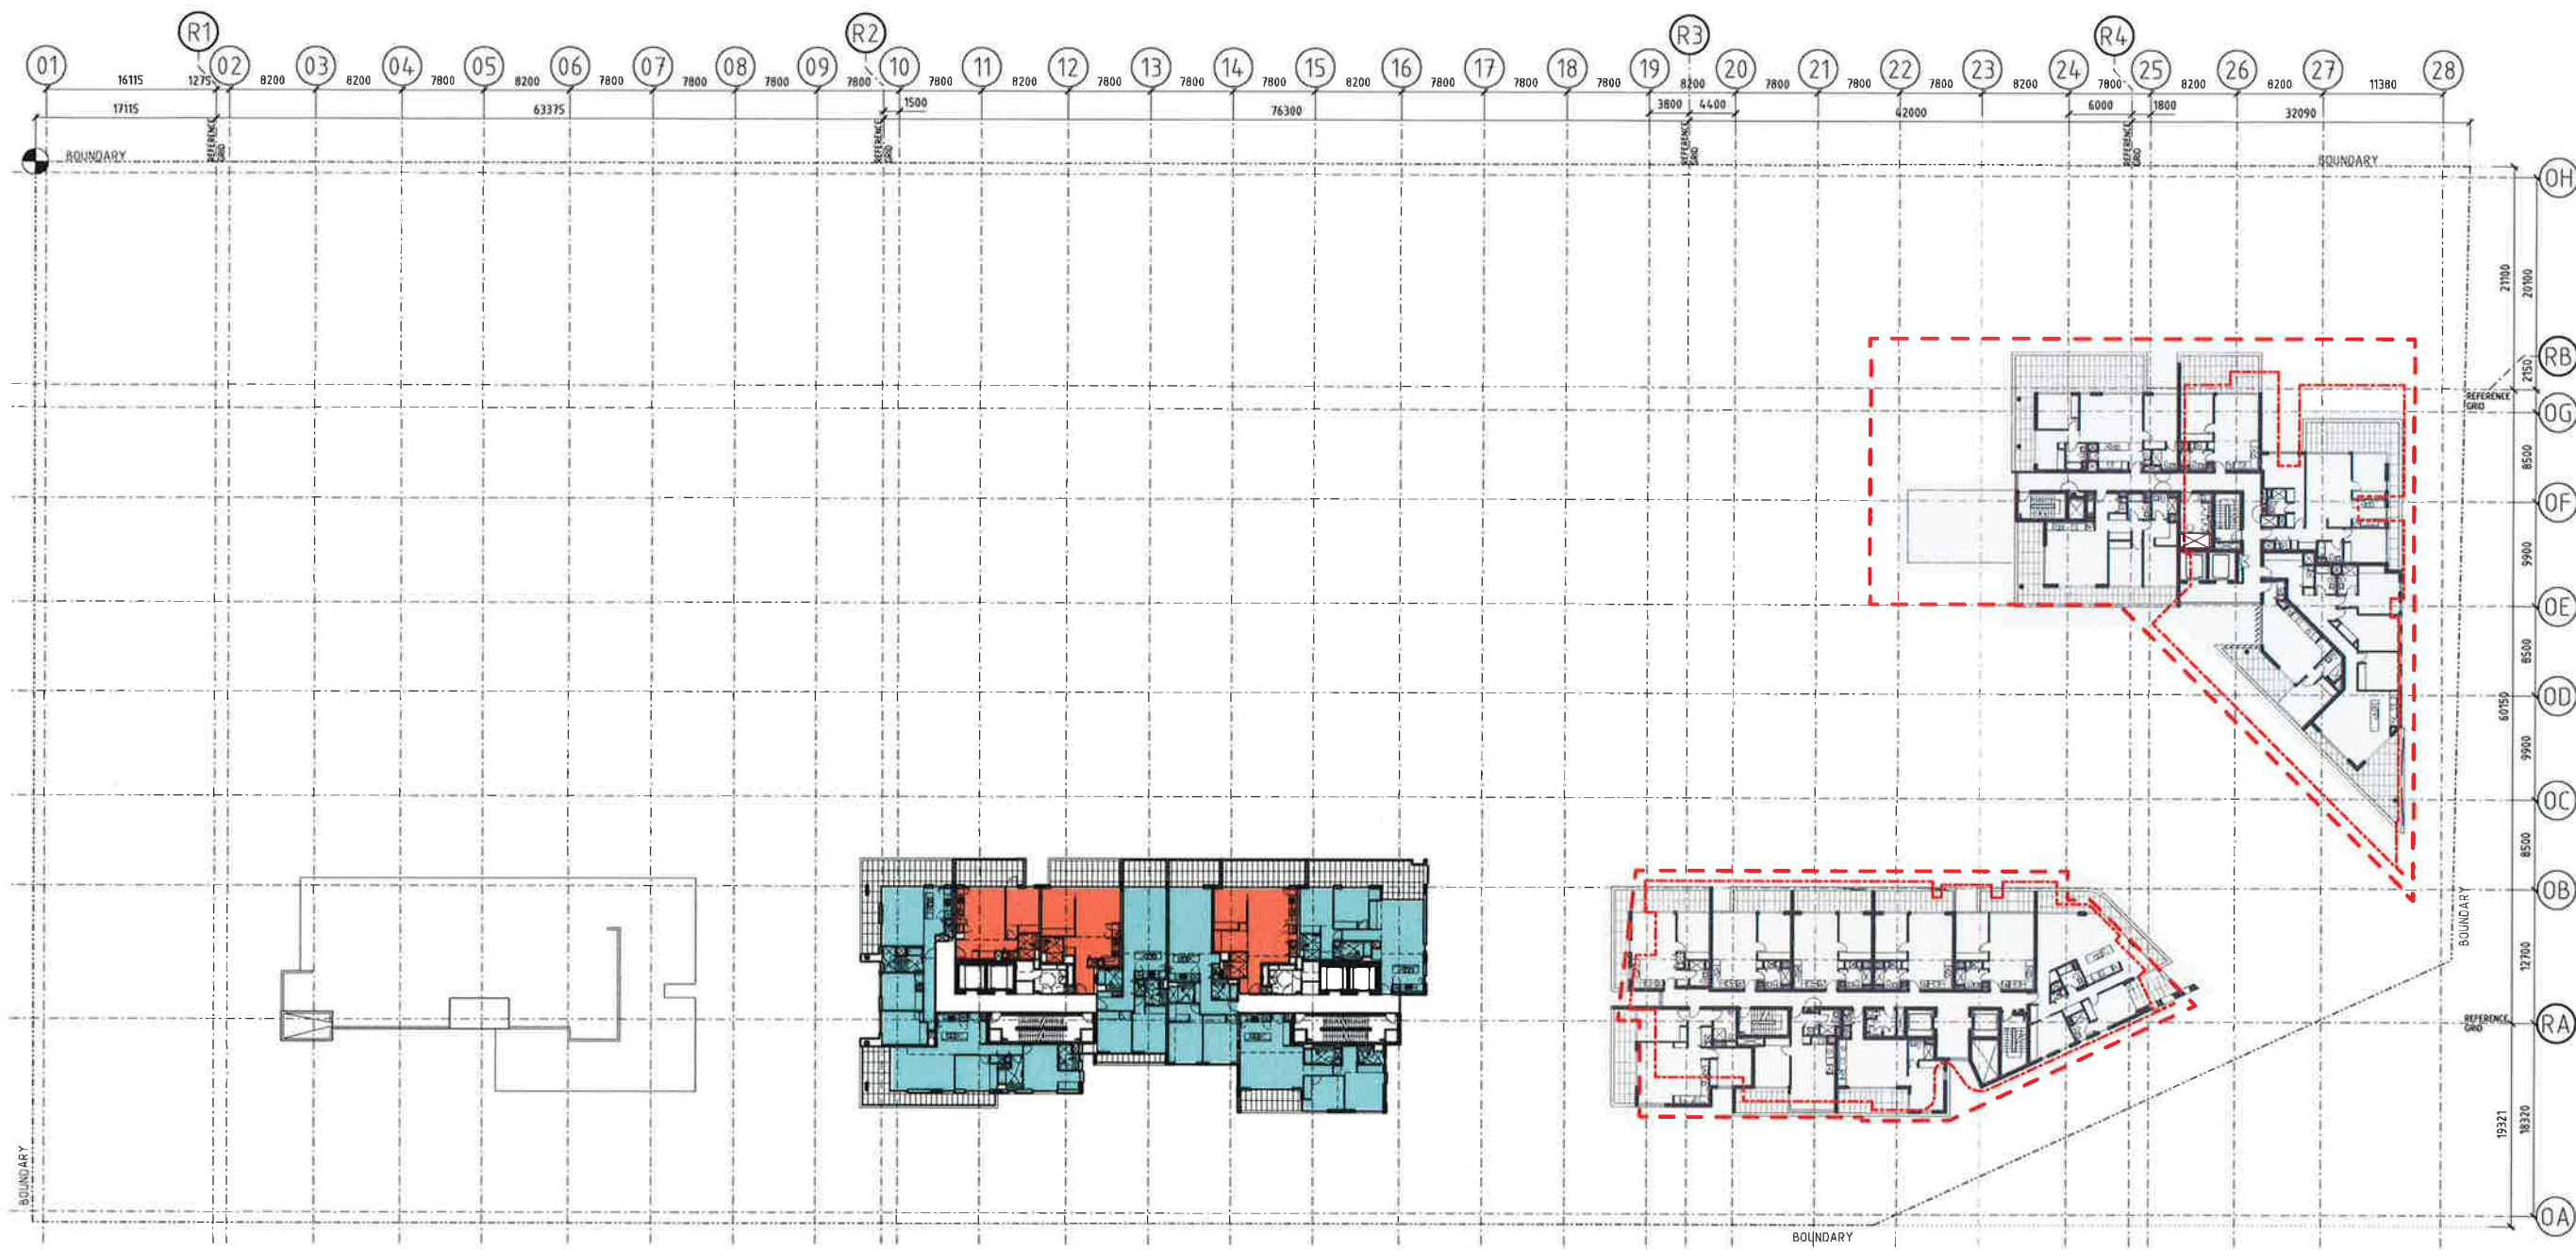


KEY

- STAGE TWO BUILDING ENVELOPE
AS PER APPROVED DRAWING DATED 17.06.13
- STAGE TWO BUILDING OUTLINE
AS PER APPROVED DRAWING DATED 17.06.13

- 1 BED
- 1 BED SOHO (COMMERCIAL/RESIDENTIAL)
- 2 BED
- 2 BED SOHO (COMMERCIAL/RESIDENTIAL)
- 3 BED
- STAGE 2 DEVELOPMENT

REF: P:\120\10030_Macquarie Park Village\10030_110-114 Herring Road\10030_12W_01.dwg
PLOT DATE: 11.11.14
PLOT BY: 11.11.14

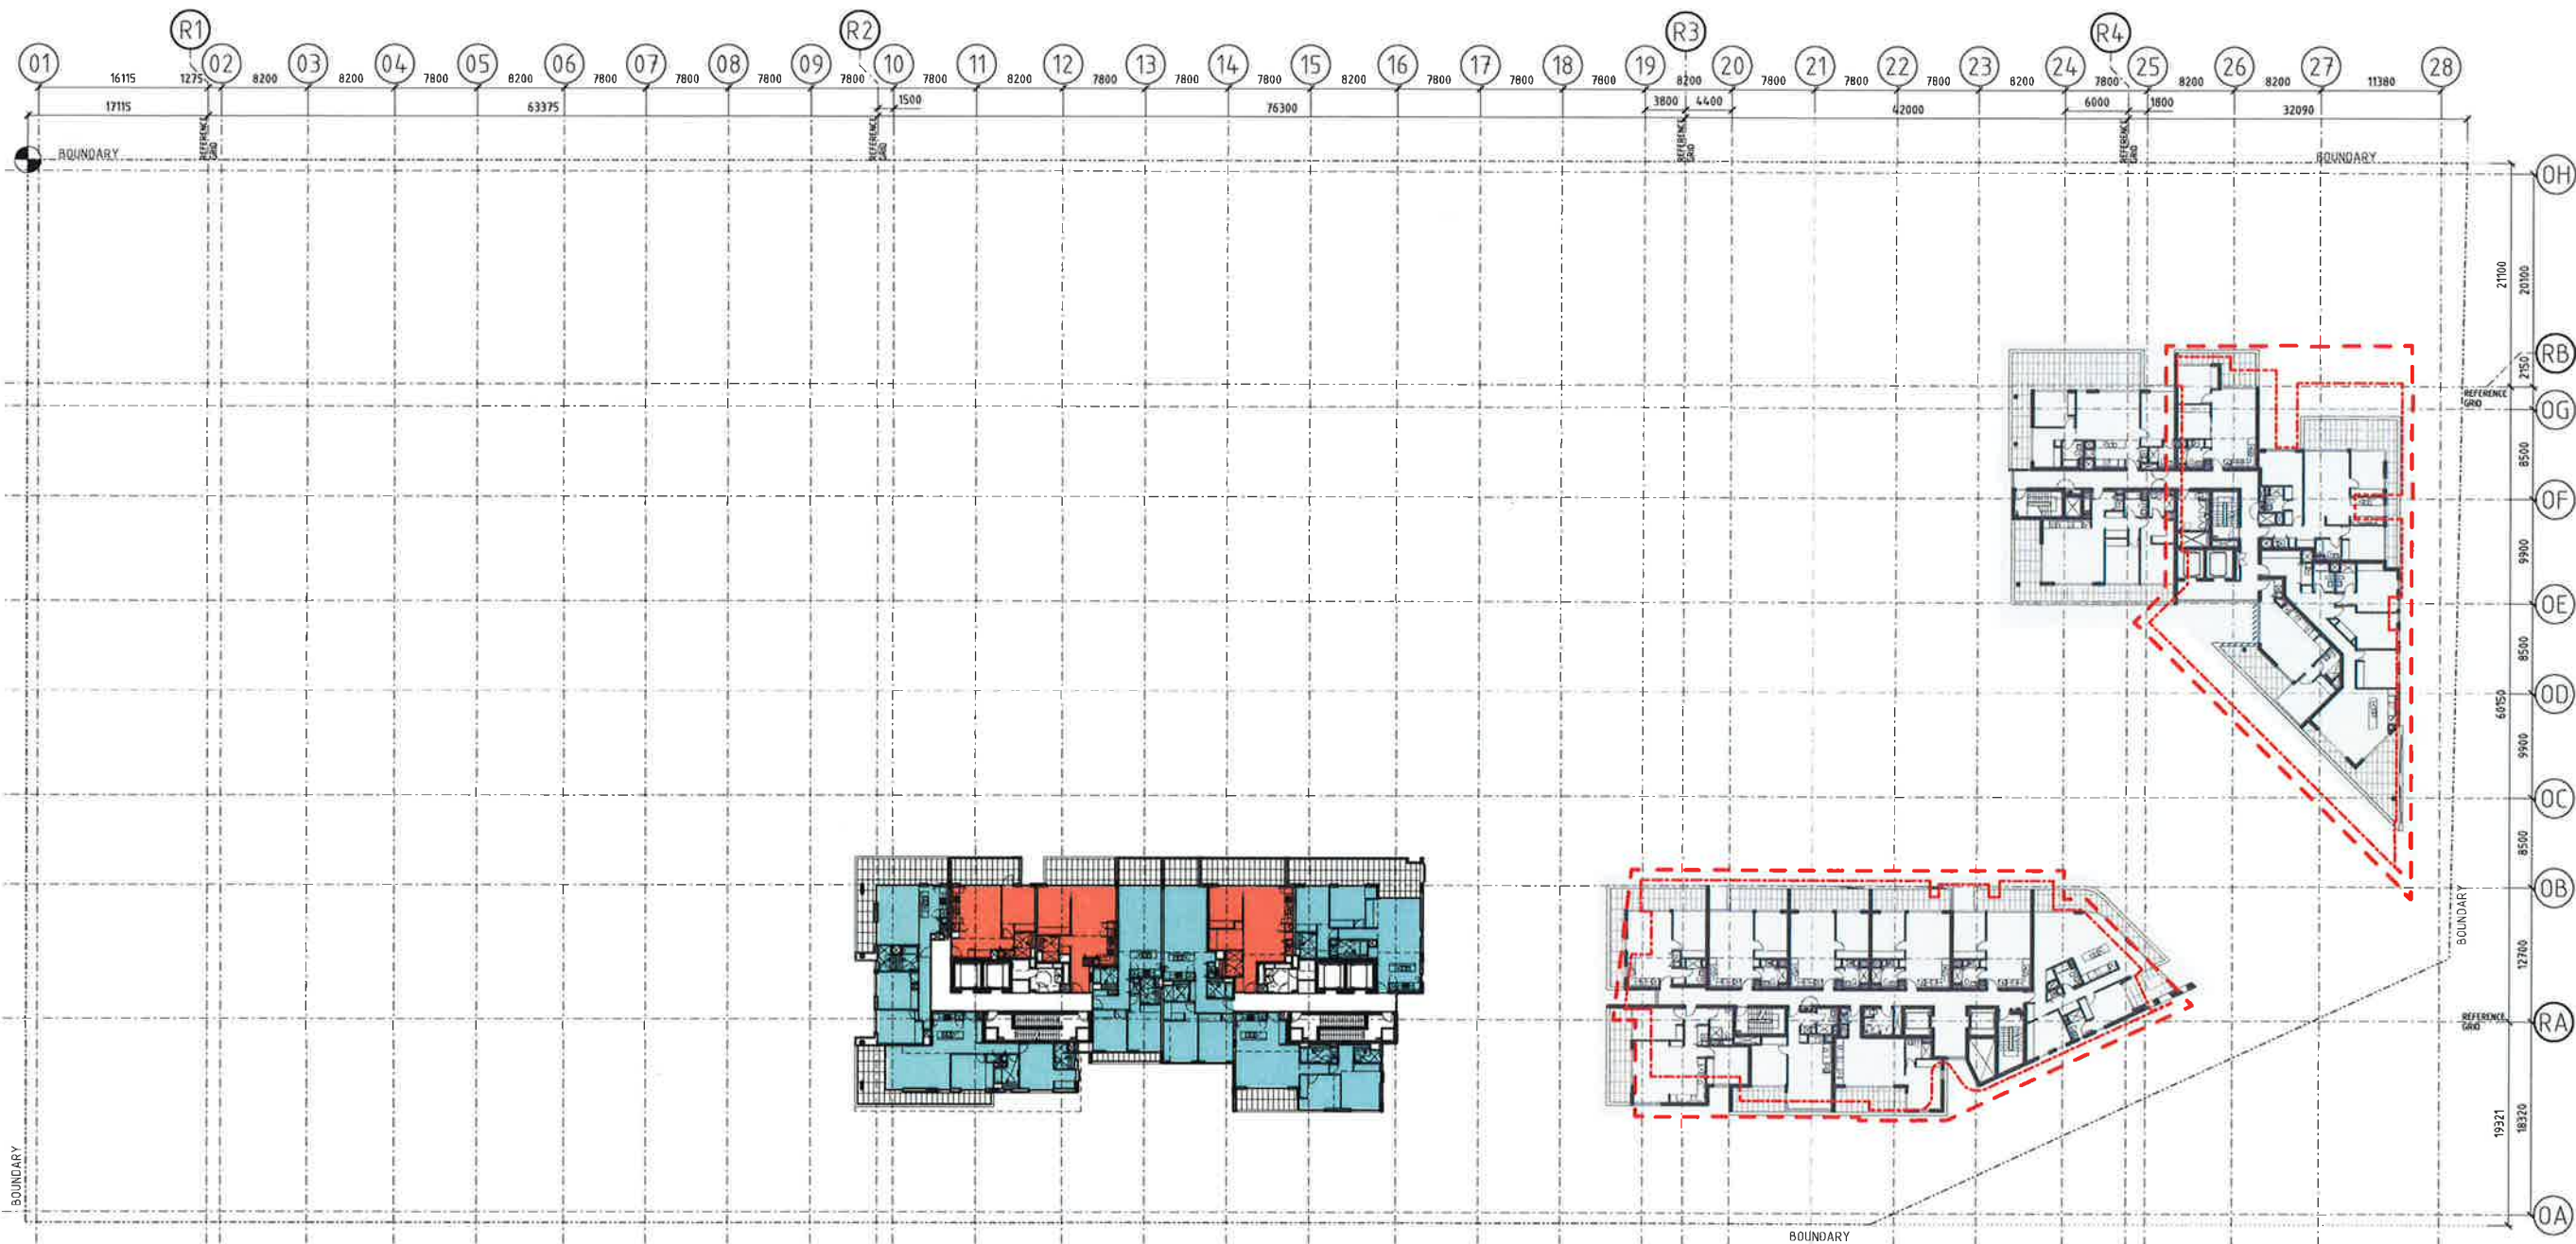

KEY

- STAGE TWO BUILDING ENVELOPE
AS PER APPROVED DRAWING DATED 17.06.13
- STAGE TWO BUILDING OUTLINE
AS PER APPROVED DRAWING DATED 17.06.13

- 1 BED
- 1 BED SOHO (COMMERCIAL/RESIDENTIAL)
- 2 BED
- 2 BED SOHO (COMMERCIAL/RESIDENTIAL)
- 3 BED
- STAGE 2 DEVELOPMENT


Revisions	No	Date	Description	Drawn	App'd
E	20.08.13	ISSUE FOR INFORMATION			
F	31.07.16	FSW SUBMISSION			
BRISBANE - APARTMENT ADDED					
ALL BUILDINGS - ROOF AND PLANT EQUIPMENT,					
EXTENT OF SCREENS, GLAZING, CLADDING AND					
GLAZE WALLS REVISED					

G 11.11.16 OUTLINE STAGE TWO BUILDINGS AS APPROVED 17.06.13
SHOWN IN RED (DOP REQUEST 11.11.16)

Do not scale drawings. Use legible dimensions only. Check & verify levels and dimensions on site prior to the commencement of any work, the preparation of shop drawings or the fabrication of components.
This drawing is the copyright of Allen Jack + Collier Architects and is protected under the Copyright Act 1968. Do not alter, reproduce or transmit in any form, or by any means without the express permission of Allen Jack + Collier Architects.
Notified Architects: Michael Pearson 5265, Peter Ireland 8881

Site Location Plan

STAGE 2 SHOWN IN GREY

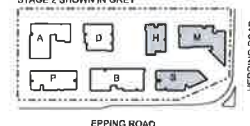

Client
STAMFORD
LAND CORPORATION LTD
79 Myrtle Street Chippendale NSW 2008 AUSTRALIA
ph +61 2 9511 8222 fx +61 2 9311 8200 ABRN 93 003 782 250

Project
MACQUARIE PARK VILLAGE
110-114 HERRING ROAD
MACQUARIE PARK

Proj No. 10_030


Drawing Title
LEVEL 13 PLAN
(LEVEL 14 OMITTED)

Drawing Status
NOT FOR CONSTRUCTION

Scale
1:330@A1

Drawing No.
DA2113

Issue
G

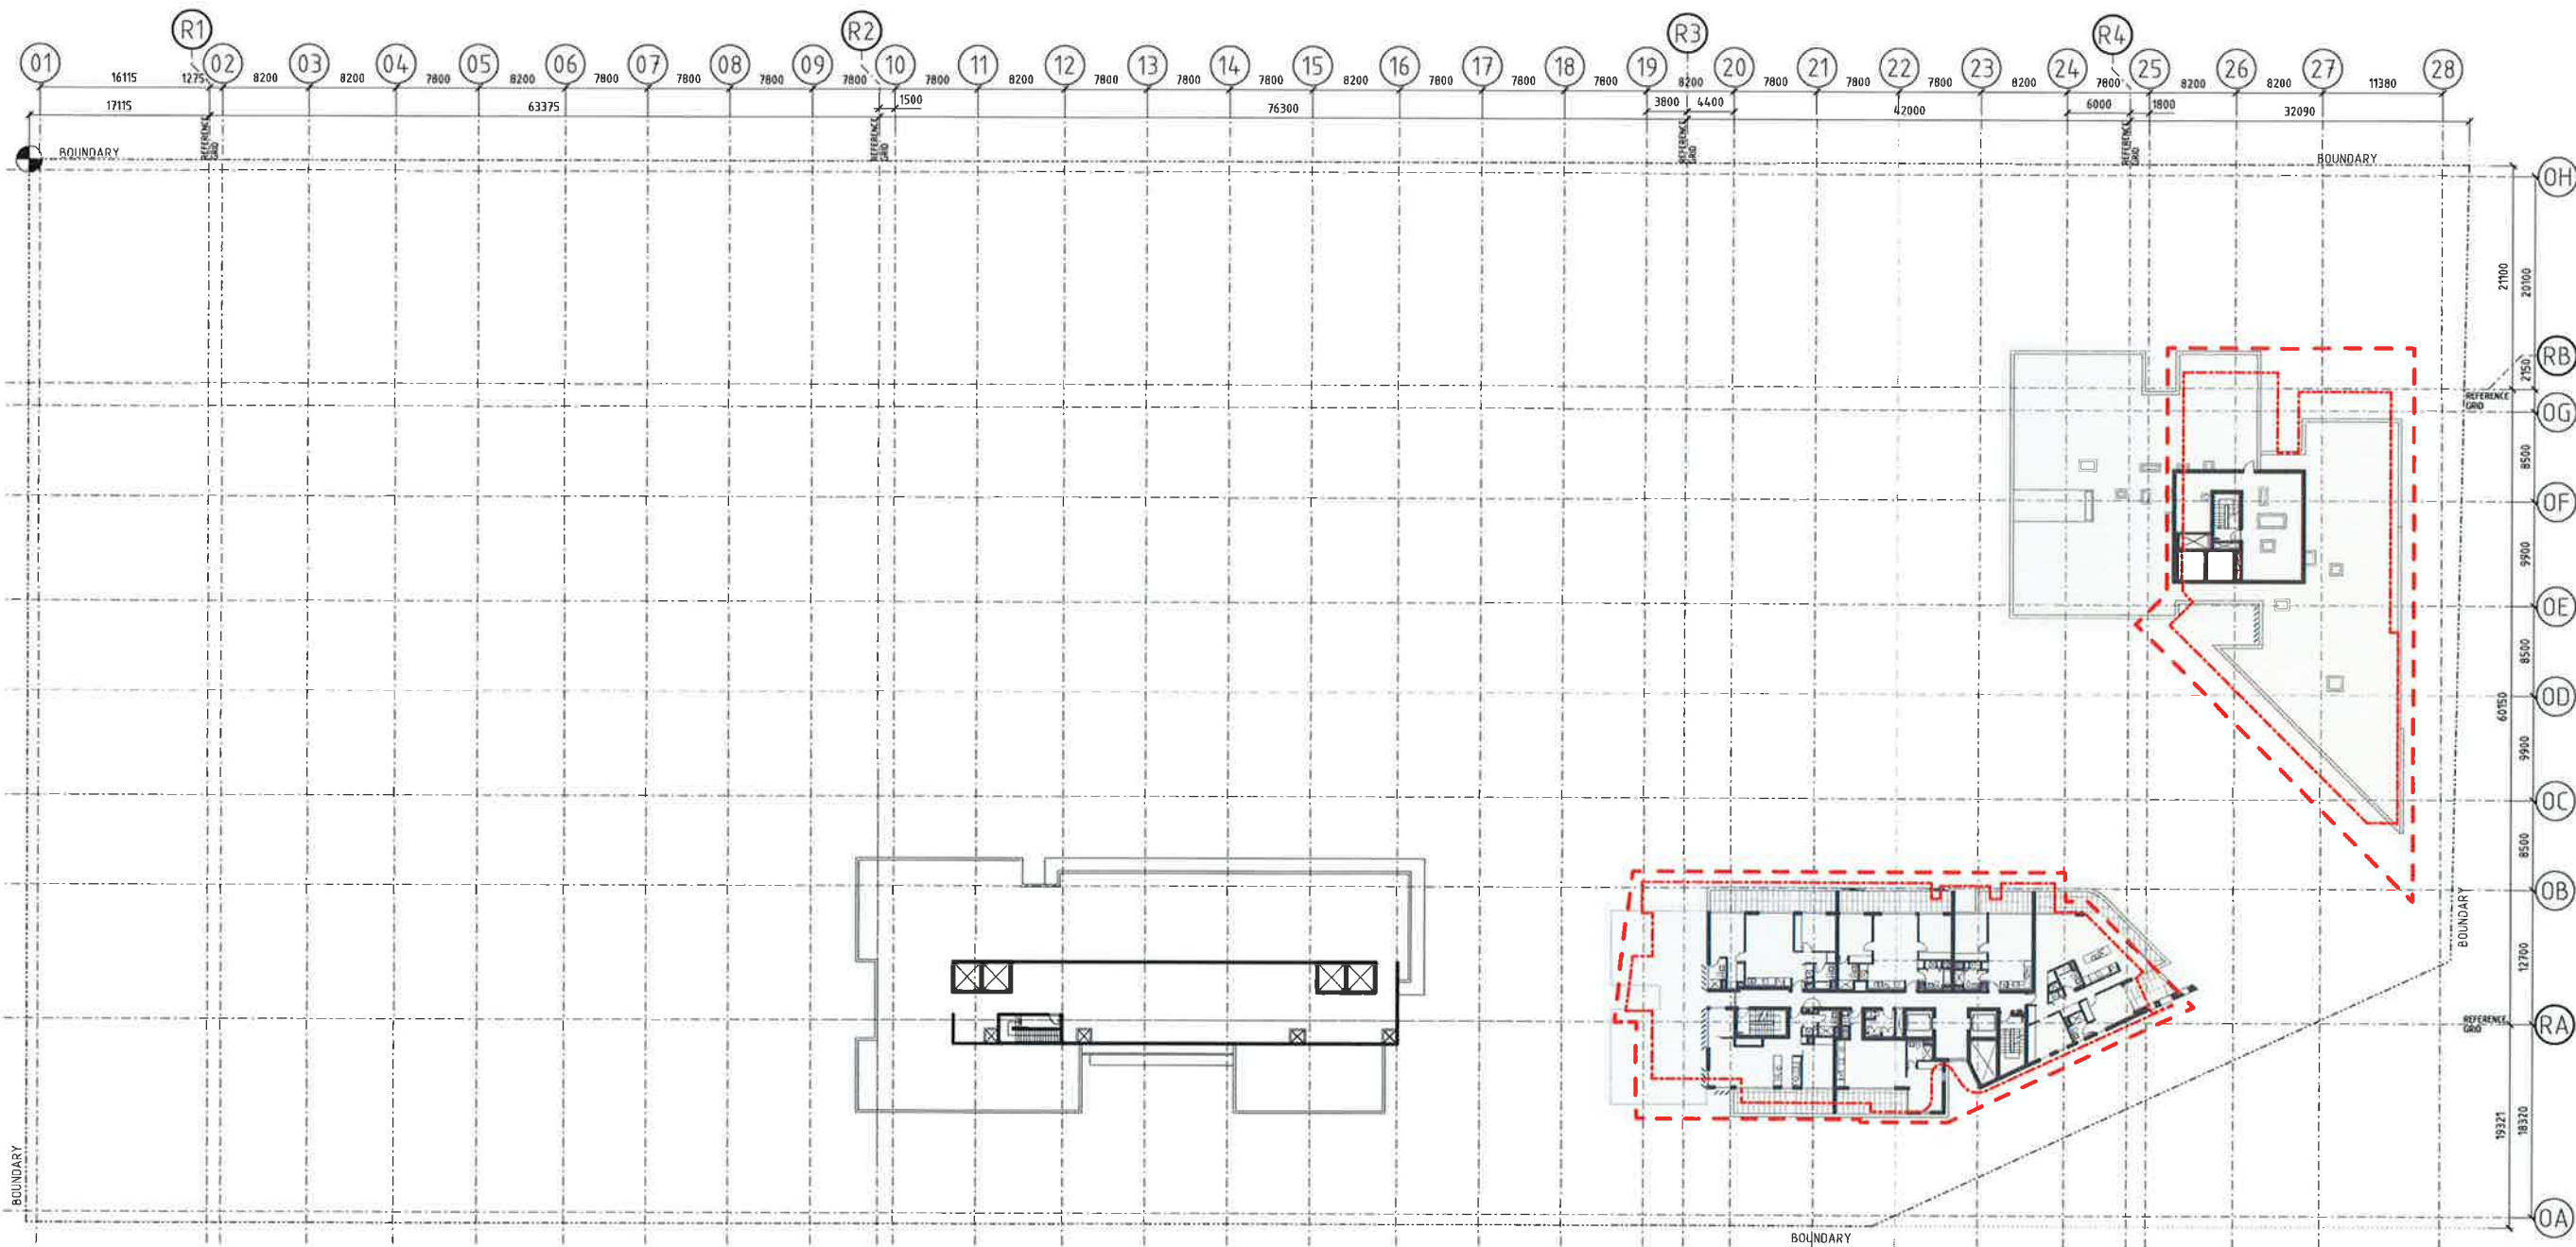

KEY

- STAGE TWO BUILDING ENVELOPE
AS PER APPROVED DRAWING DATED 17.06.13
- STAGE TWO BUILDING OUTLINE
AS PER APPROVED DRAWING DATED 17.06.13

- 1 BED
- 1 BED SOHO (COMMERCIAL/RESIDENTIAL)
- 2 BED
- 2 BED SOHO (COMMERCIAL/RESIDENTIAL)
- 3 BED
- STAGE 2 DEVELOPMENT

Rev	Date	Description	Rev App'd
0	17.06.13	ISSUE FOR INFORMATION	
1	17.07.14	PSW SUBMISSION	
2	11.11.14	SHOWN IN RED (SOP REQUEST 11.11.14)	

This drawing is the copyright of Allen Jack + Collier Architects and is protected under the Copyright Act 1968. Do not alter, reproduce or transmit in any form, or by any means without the express permission of Allen Jack + Collier Architects.
Notwithstanding to Michael Norman 5265, Peter Ireland 6661

Site Location Plan

STAGE 2 SHOWN IN GREY



Client

STAMFORD
LAND CORPORATION LTD

Architect

AJ+C
79 Myrtle Street Chippendale NSW 2008 AUSTRALIA
ph +61 2 9311 6222 fx +61 2 9311 6209 abn 63 003 782 280

Project

MACQUARIE PARK VILLAGE
110-114 HERRING ROAD
MACQUARIE PARK


Proj No: 10_030

Drawing Title
LEVEL 15 PLAN
(LEVEL 14 OMITTED)

Drawing Status
NOT FOR CONSTRUCTION

Scale
1:330@A1DA2115

Issue
F

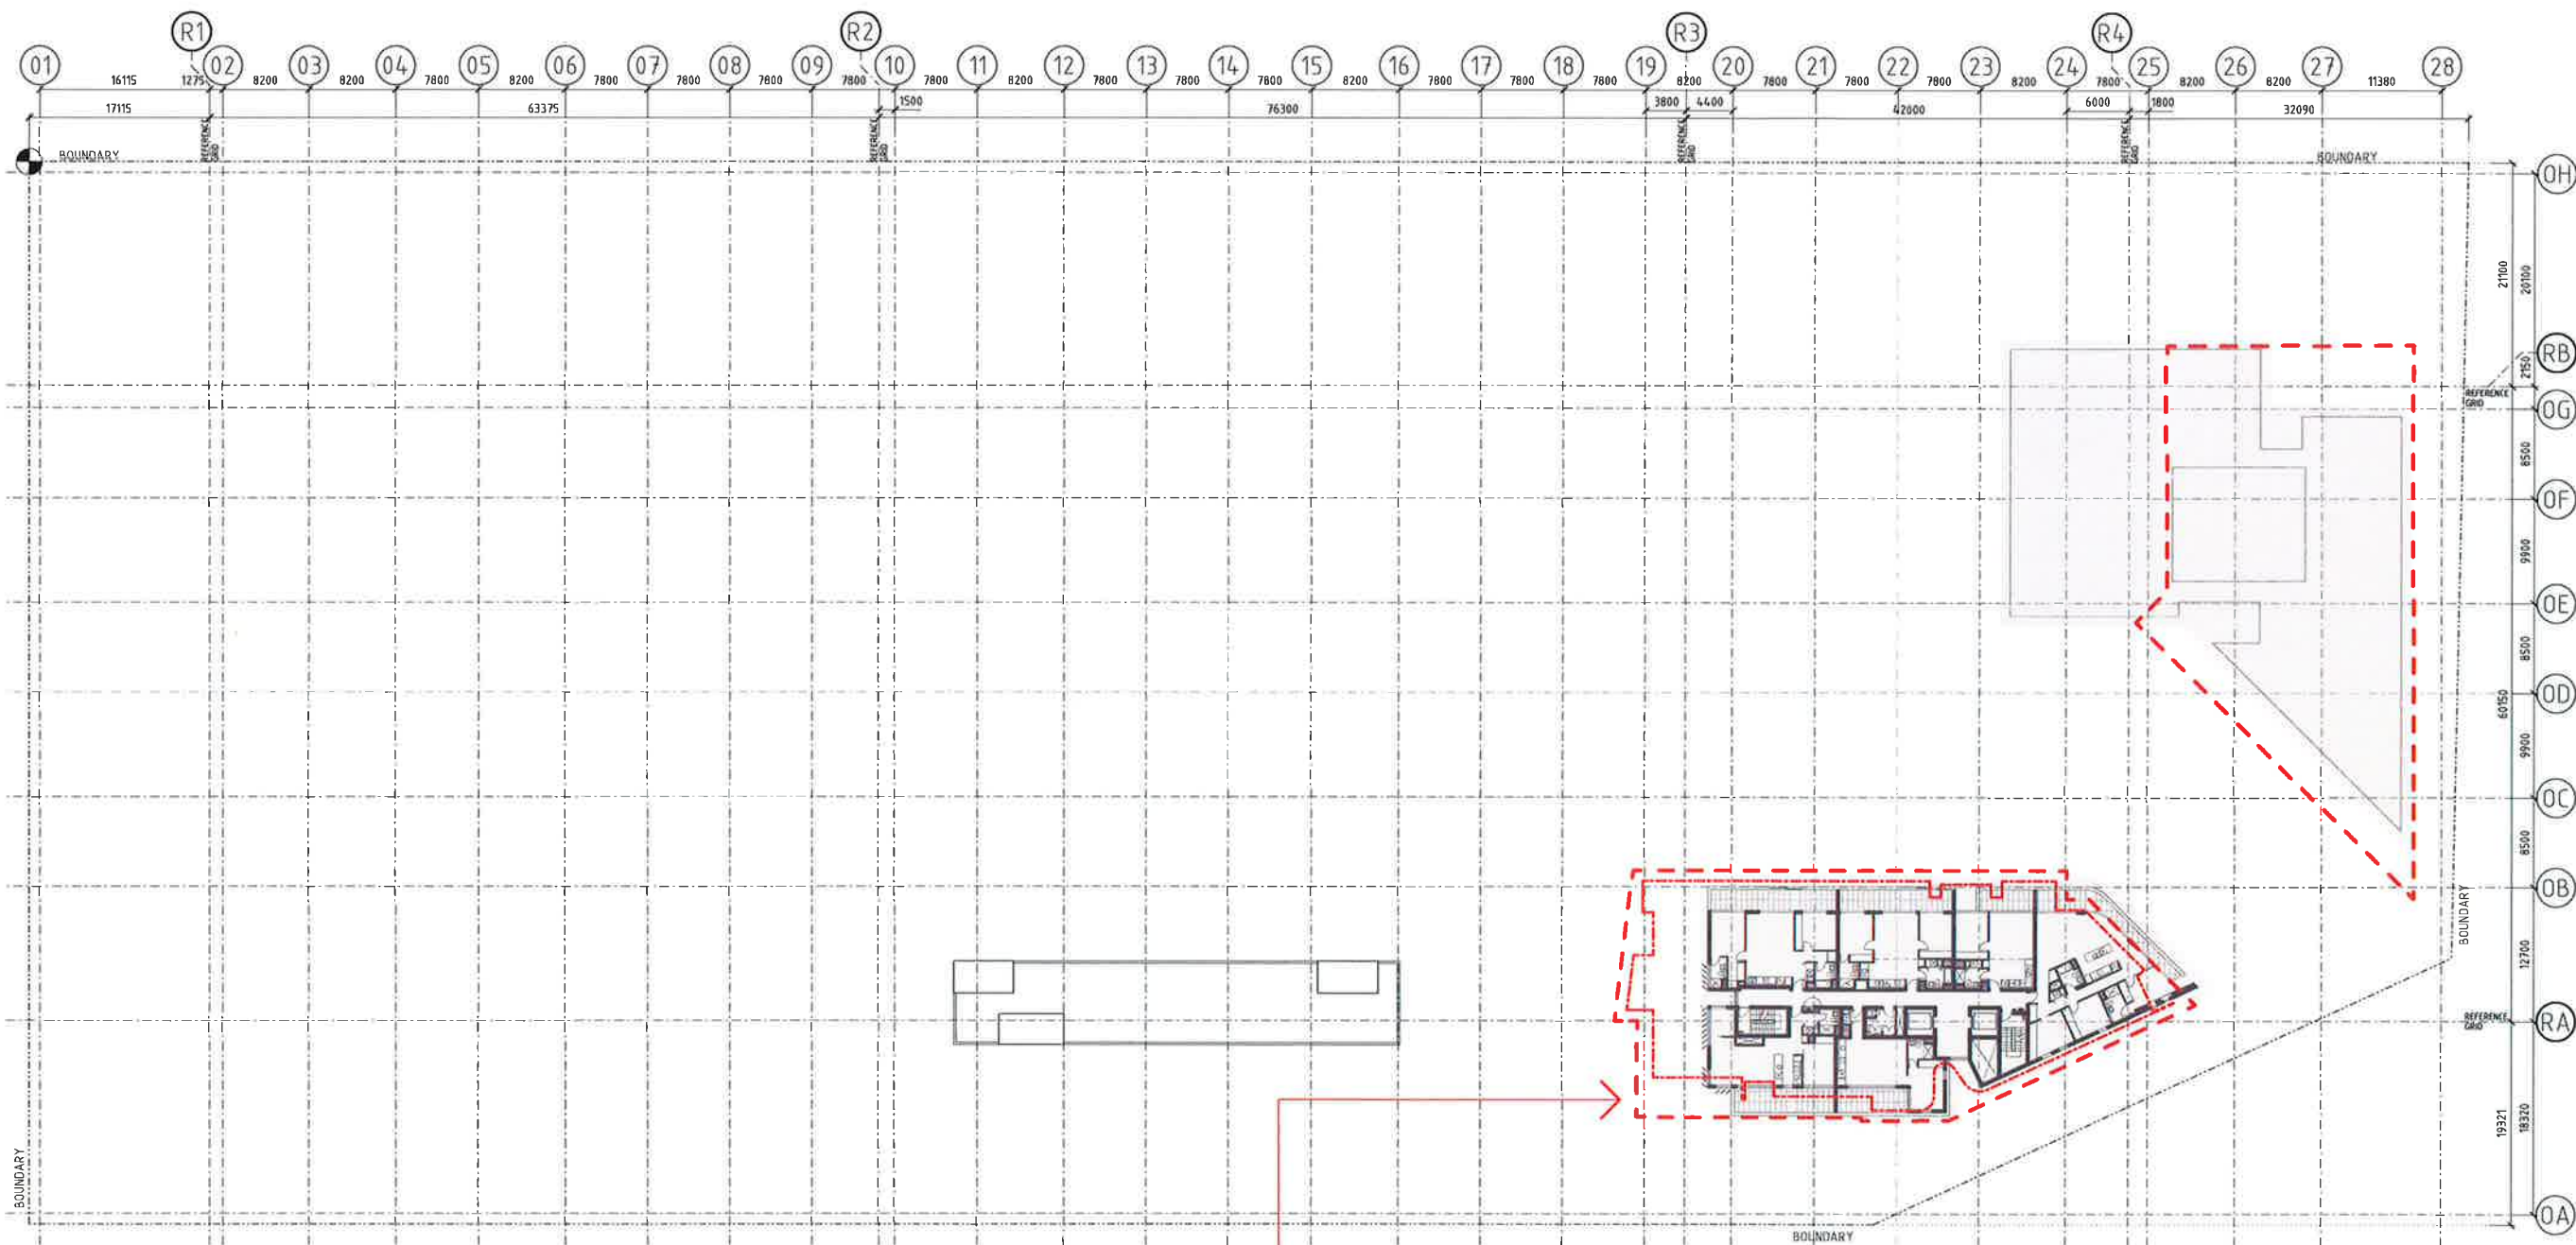

SYDNEY BUILDING APARTMENT LEVELS
17, 18, 19, 20, 21, 22 AND 23 MATCH
LEVEL 16 AS SHOWN

KEY

- STAGE TWO BUILDING ENVELOPE
AS PER APPROVED DRAWING DATED 17.06.13
- STAGE TWO BUILDING OUTLINE
AS PER APPROVED DRAWING DATED 17.06.13

- 1 BED
- 1 BED SOHO (COMMERCIAL/RESIDENTIAL)
- 2 BED
- 2 BED SOHO (COMMERCIAL/RESIDENTIAL)
- 3 BED
- STAGE 2 DEVELOPMENT

Revisions	No	Date	Description	Ver	App'd
	0	17.06.13	ISSUE FOR INFORMATION		
	1	31.07.14	PSM SUBMISSION		
	2	11.11.14	SHOWN IN RED (DOF REQUEST 10.11.14)		

Do not scale drawings. Use figured dimensions only. Check & verify levels and dimensions on site prior to the commencement of any work, the preparation of shop drawings or the fabrication of components.

This drawing is the copyright of Allen Jack - Collier Architects and is protected under the Copyright Act 1969. Do not alter, reproduce or transmit in any form, or by any means without the express permission of Allen Jack - Collier Architects.

Notified Architects: Michael Heenan 5284, Peter Ireland 6651

Site Location Plan

STAGE 2 SHOWN IN GREY



Client



Architect



Project

MACQUARIE PARK VILLAGE
110-114 HERRING ROAD
MACQUARIE PARK


Proj No. 10_030

Drawing Title
LEVEL 16 PLAN

Drawing Status
NOT FOR CONSTRUCTION

Scale
1:330@A1DA2116

Issue
F

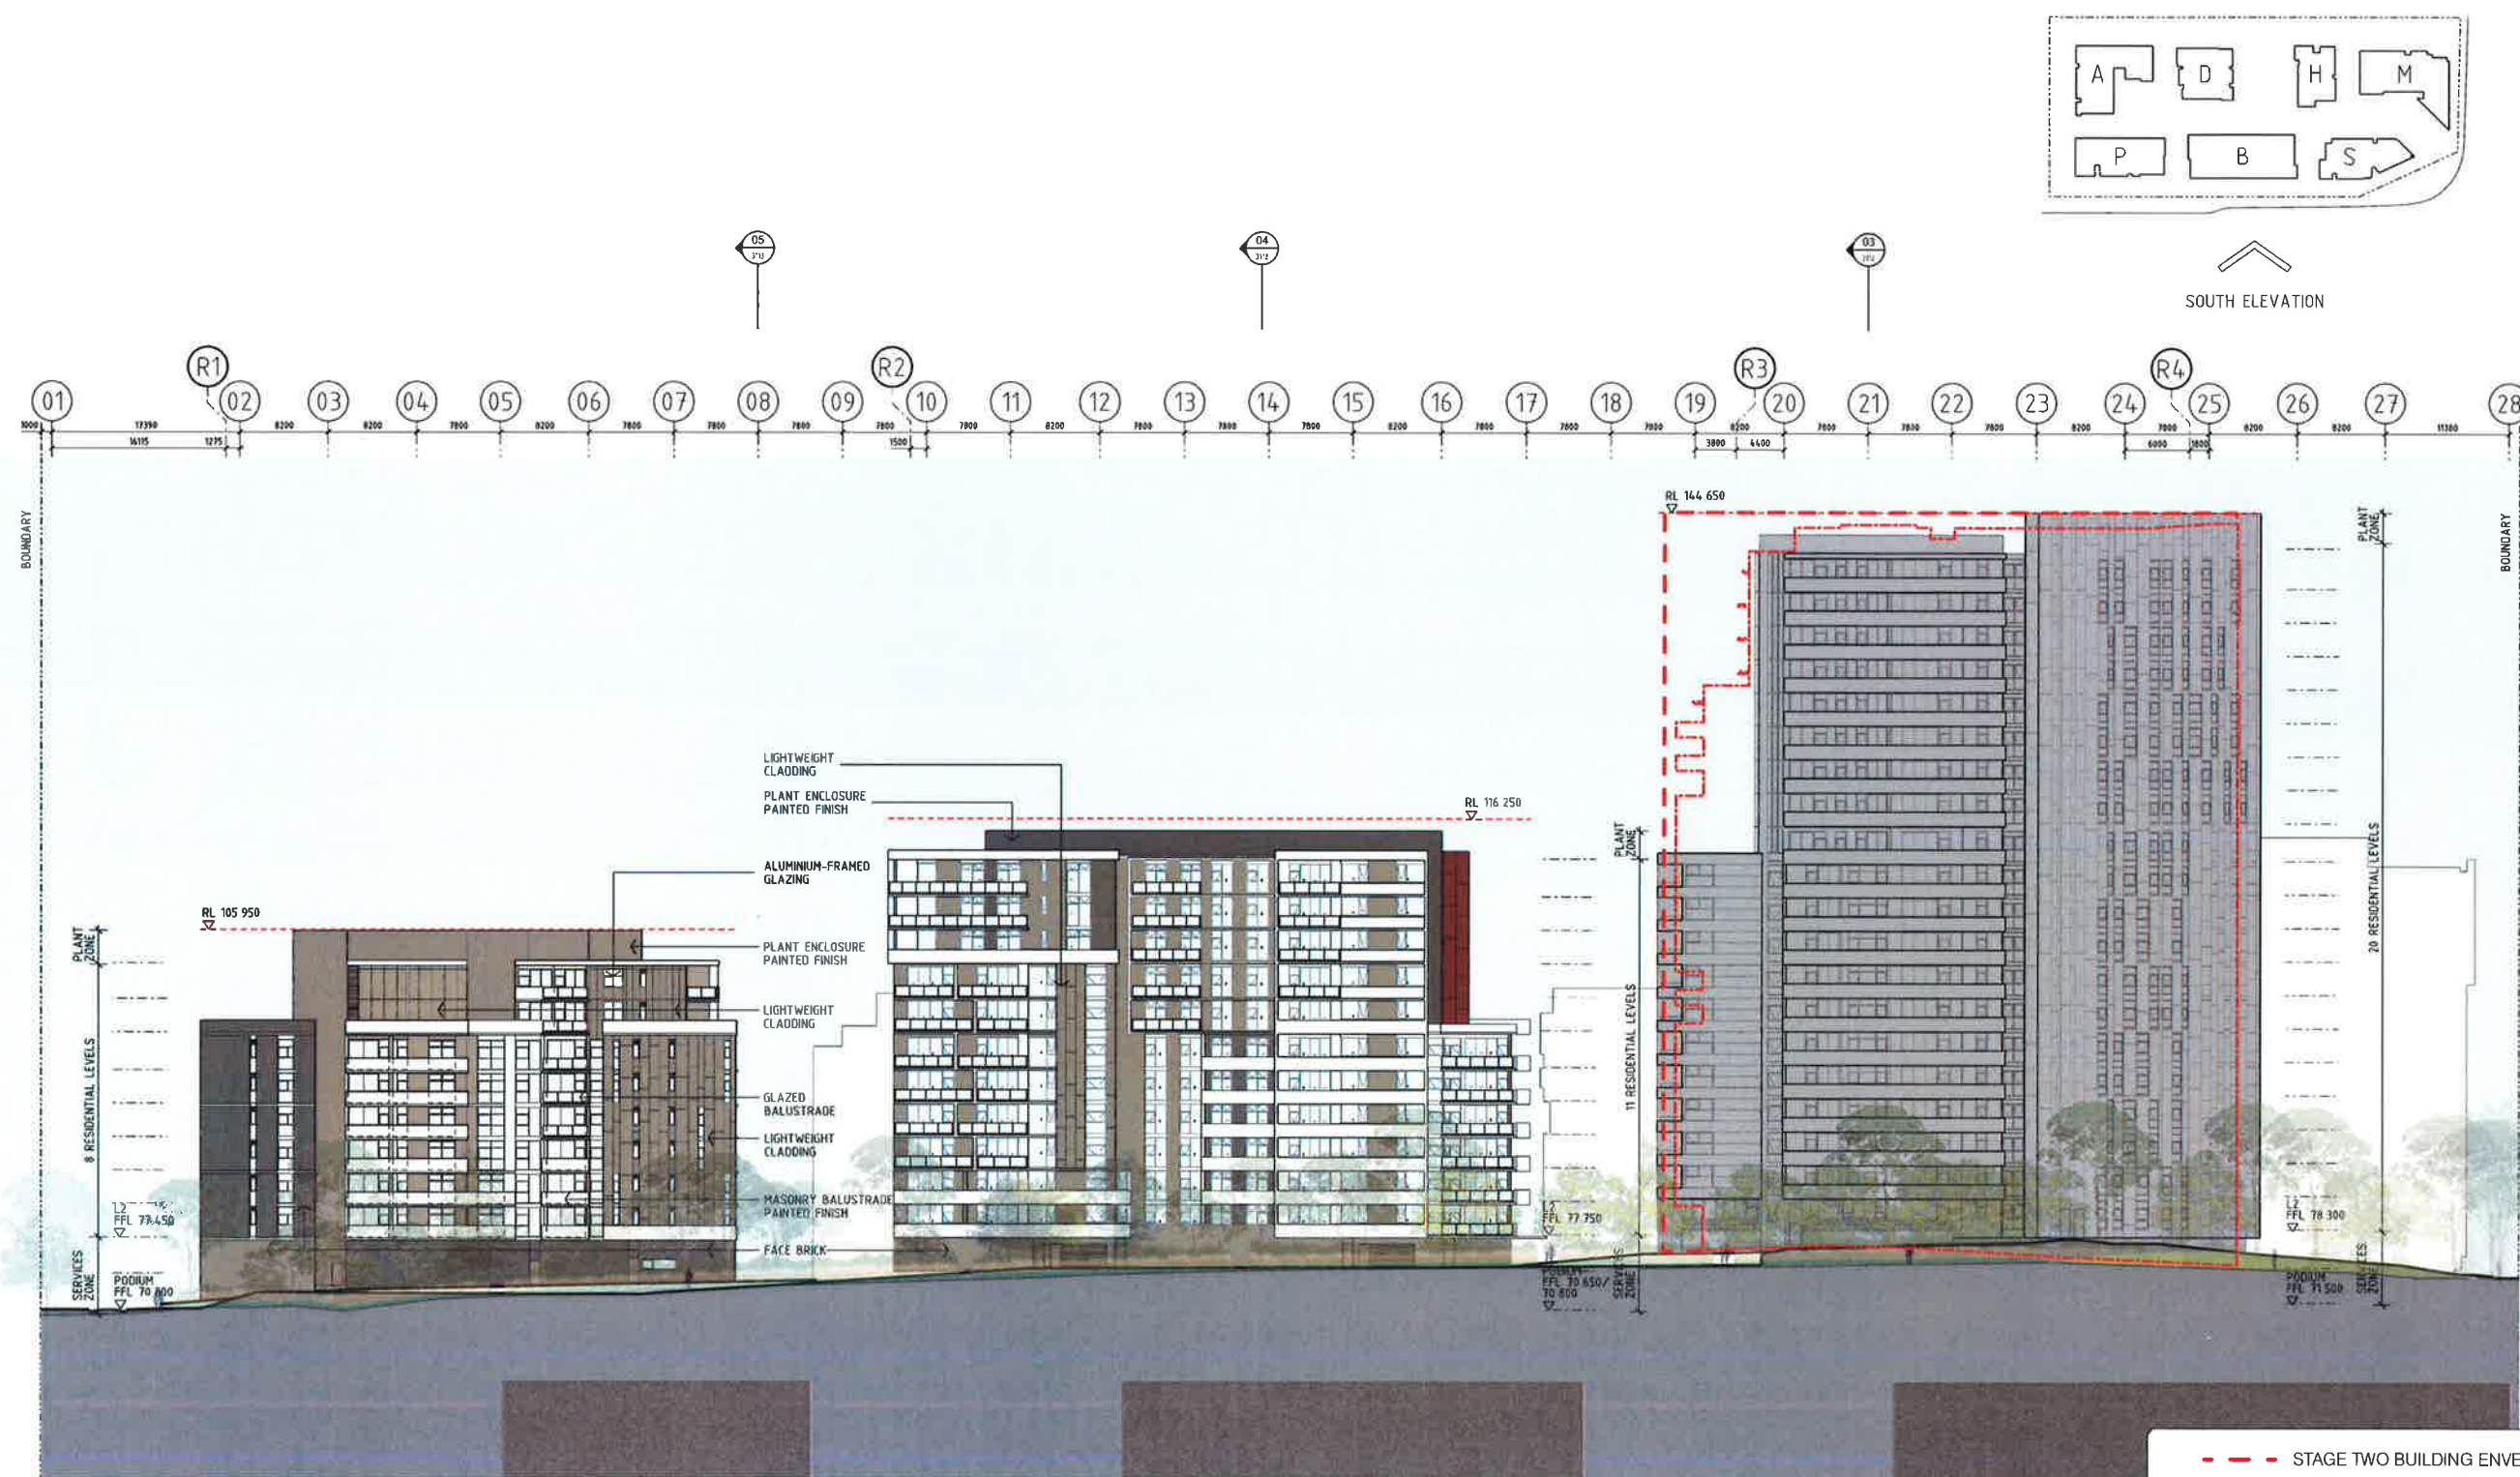

BUILDING PERTH

BUILDING BRISBANE
BUILDING DARWIN BEYOND

BUILDING SYDNEY
BUILDINGS HOBART AND
MELBOURNE BEYOND



--- STAGE TWO BUILDING ENVELOPE
AS PER APPROVED DRAWING DATED 17.06.13

--- STAGE TWO BUILDING OUTLINE
AS PER APPROVED DRAWING DATED 17.06.13

■ STAGE 2 DEVELOPMENT

--- PAC APPROVED HEIGHT

NORTH ELEVATION

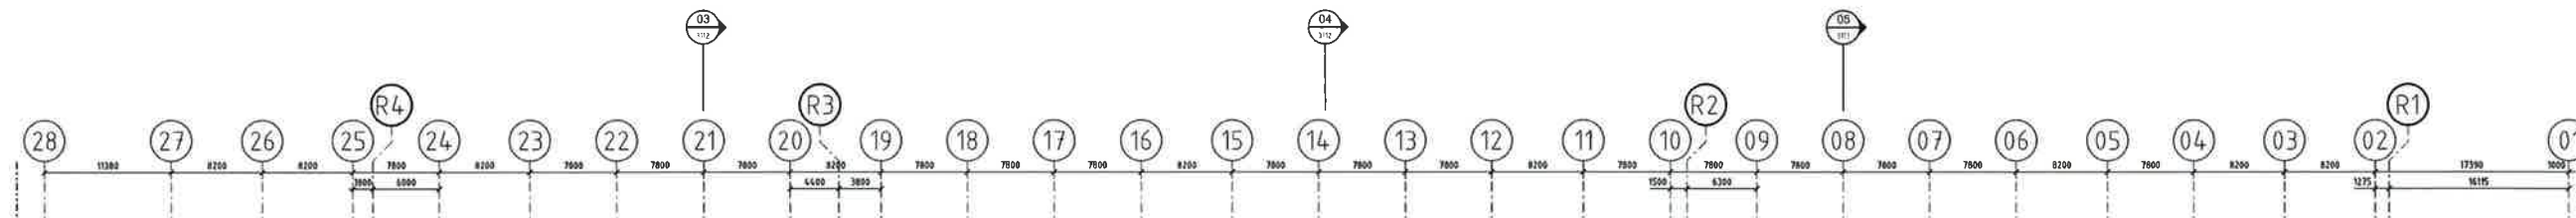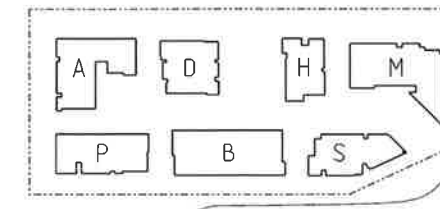

BUILDING MELBOURNE
BUILDING SYDNEY BEYOND

BUILDING HOBART

BUILDING DARWIN
BUILDING BRISBANE BEYOND

BUILDING ADELAIDE
BUILDING PERTH BEYOND

--- STAGE TWO BUILDING ENVELOPE
AS PER APPROVED DRAWING DATED 17.06.13

--- STAGE TWO BUILDING OUTLINE
AS PER APPROVED DRAWING DATED 17.06.13

■ STAGE 2 DEVELOPMENT

--- PAC APPROVED HEIGHT

Revisions	No	Date	Description	Author
A	21.01.11		PART 3A SUBMISSION	
B	09.12.11		PREFERRED PROJECT	
C	24.02.12		PREFERRED PROJECT	
D	22.11.12		75M SUBMISSION	
E	18.01.13		75M SUBMISSION	
F	17.06.13		75M SUBMISSION	
G	31.07.14		75M SUBMISSION	

11.11.14 OUTLINE STAGE TWO BUILDINGS AS APPROVED 17.06.13
SHOWN IN RED IDOP REQUEST 11.11.14

Do not scale drawings. Use figured dimensions only. Check & verify levels and dimensions on site prior to the commencement of any work. The preparation of shop drawings or the fabrication of components.

This drawing is the copyright of Allen Jack + Collier Architects and is protected under the Copyright Act 1968. Do not alter, reproduce or transmit in any form, or by any means without the express permission of Allen Jack + Collier Architects.

Notified Architects: Michael Norman 5265, Peter Ireland 6667

Site Location Plan

STAGE 2 SHOWN IN GREY



AJ+C
79 Myrtle Street Chippendale NSW 2008 AUSTRALIA
ph +61 2 9311 8222 fx +61 2 9311 8200 ABN 53 003 782 250


Project
MACQUARIE PARK VILLAGE
110-114 HERRING ROAD
MACQUARIE PARK
Proj No. 10_030



Drawing Title
NORTH ELEVATION
Drawing Status
NOT FOR CONSTRUCTION


Scale
1:330@A1
Drawing No.
DA3101

Issue
H

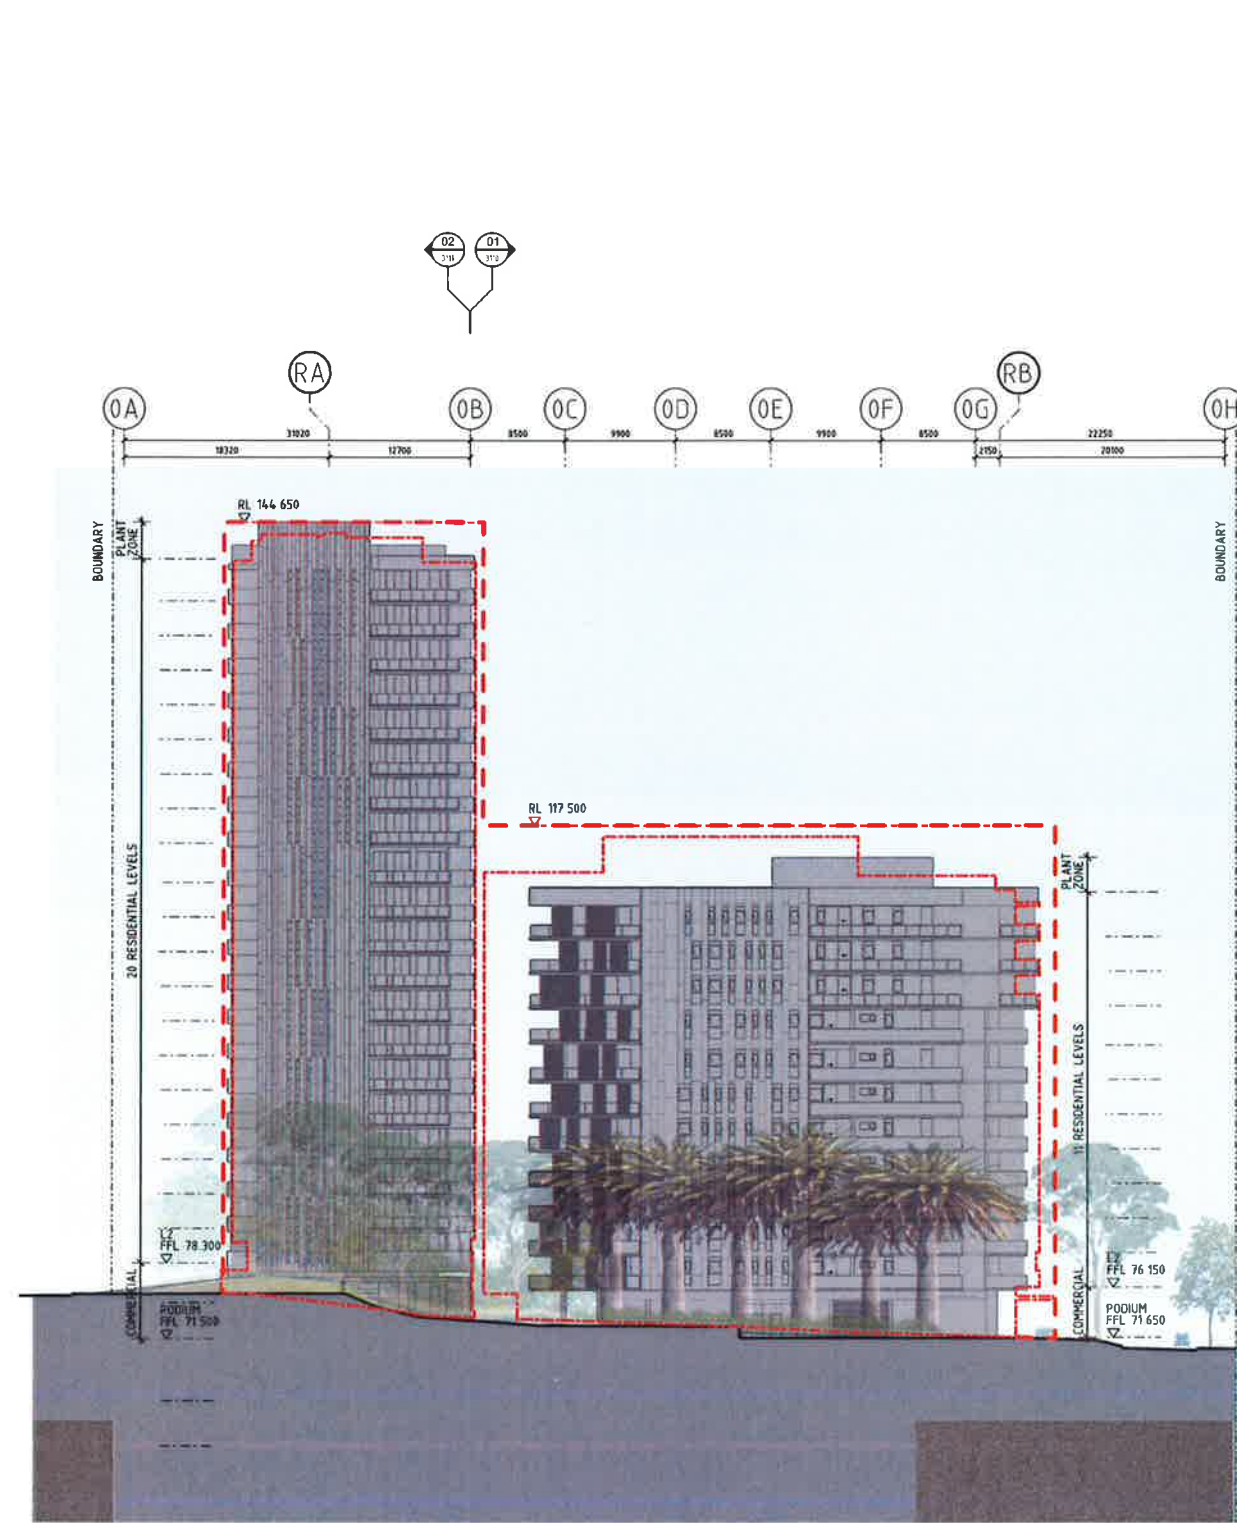

BUILDING SYDNEY BUILDING MELBOURNE

EAST ELEVATION

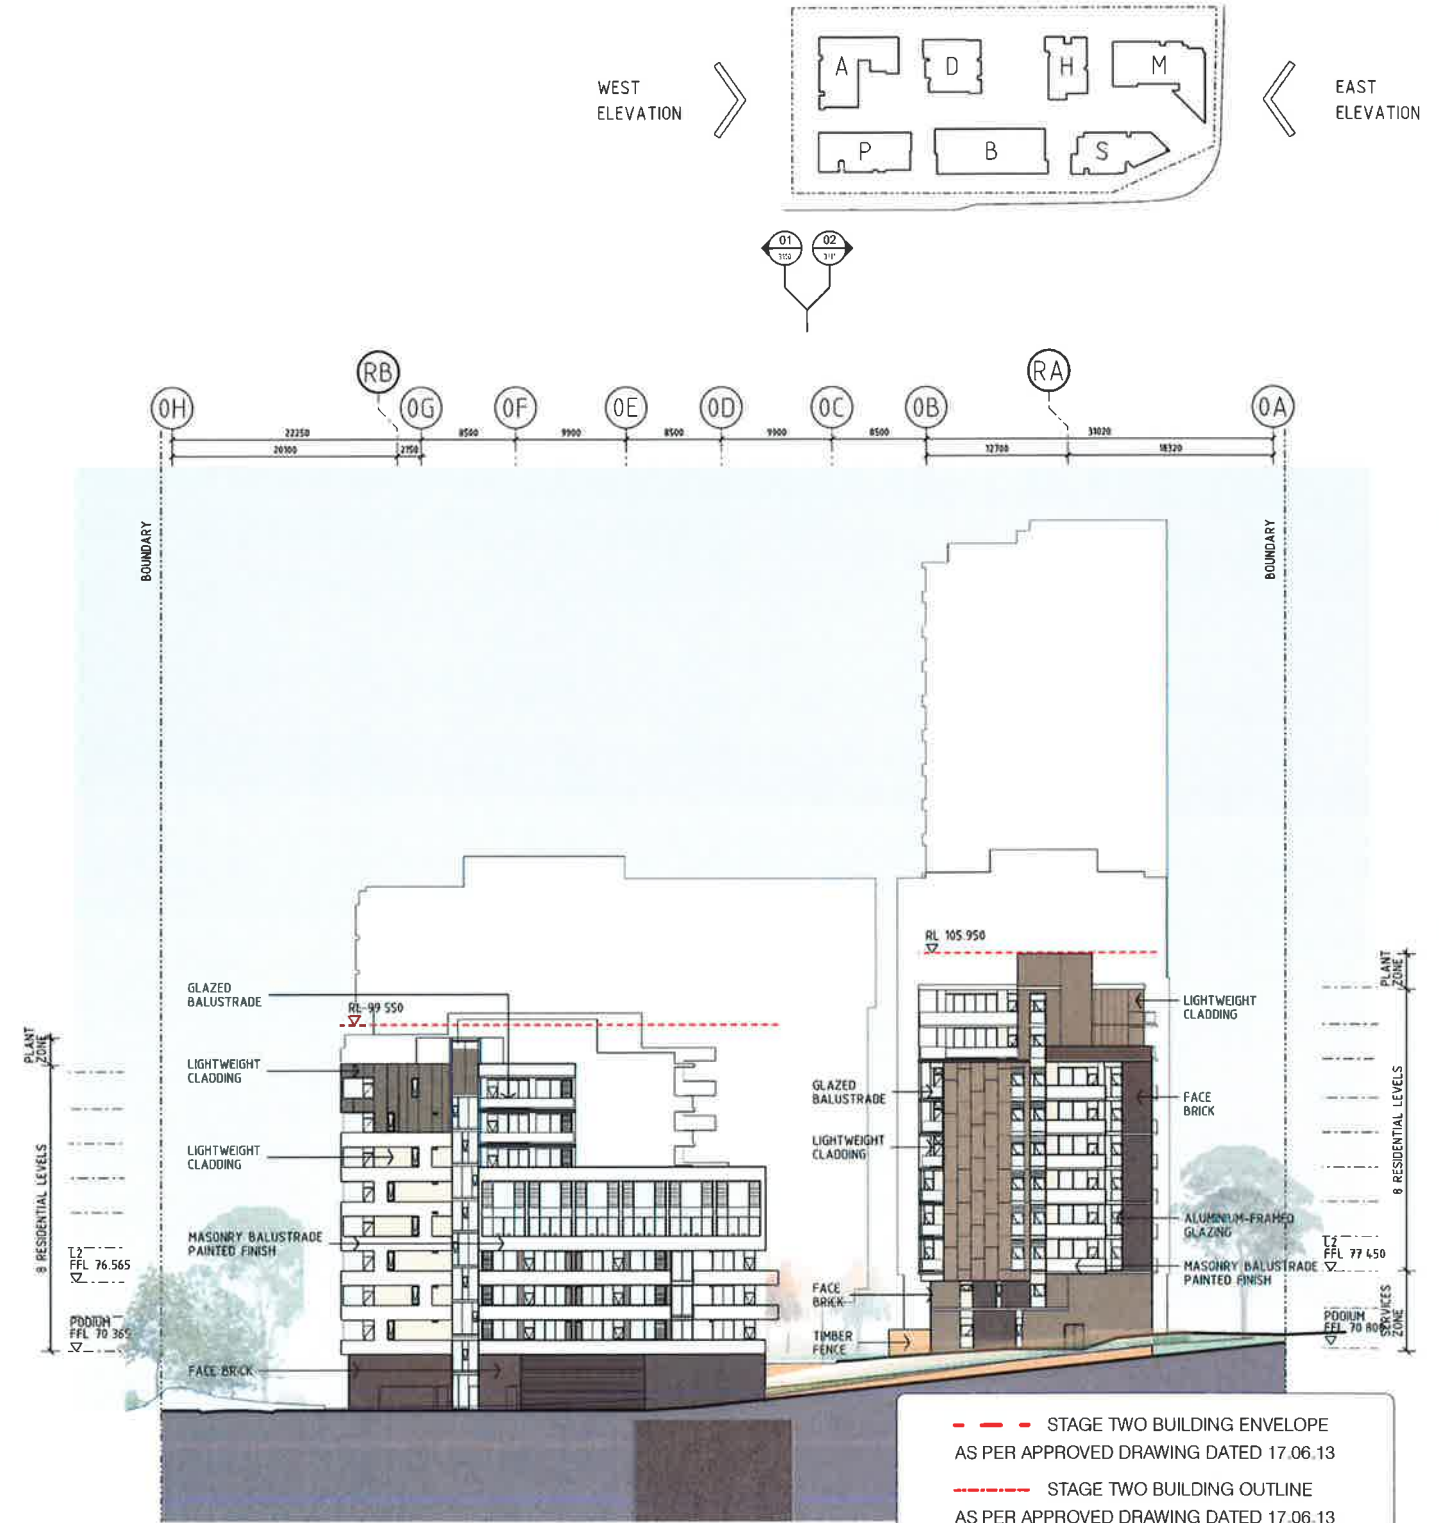

BUILDING ADELAIDE
BUILDINGS DARWIN, HOBART
AND MELBOURNE BEYOND

BUILDING PERTH
BUILDINGS BRISBANE AND SYDNEY BEYOND

WEST ELEVATION

Revisions	Description	Date
A	21.01.11 PART 3A SUBMISSION	21.01.11
B	09.12.11 PREFERRED PROJECT	09.12.11
C	24.02.12 PREFERRED PROJECT	24.02.12
D	22.11.12 TSW SUBMISSION	22.11.12
E	18.01.13 TSW SUBMISSION	18.01.13
F	17.04.13 TSW SUBMISSION	17.04.13
G	31.07.14 TSW SUBMISSION	31.07.14

H 11.11.14 OUTLINE STAGE TWO BUILDINGS AS APPROVED 17.06.13
SHOWN IN RED (DOP REQUEST 11.11.14)

Do not scale drawings. The figures dimensions only. Check & verify levels and dimensions on site prior to the commencement of any work, the preparation of shop drawings or the fabrication of components.

This drawing is the copyright of Allan Jack + Collier Architects and is protected under the Copyright Act 1968. Do not alter, reproduce or transmit in any form, or by any means without the express permission of Allan Jack + Collier Architects.

Notified Architects: Michael Pearson (NSW), Peter Ireland (NSW)

Site Location Plan

STAGE 2 SHOWN IN GREY



Client



Architect



Project

MACQUARIE PARK VILLAGE
110-114 HERRING ROAD
MACQUARIE PARK

Drawing Title
EAST (HERRING ROAD)
AND WEST ELEVATIONS

Drawing Status
NOT FOR CONSTRUCTION

Scale
1:330@A1DA3102

Issue
H