


**1 PUBLIC DOMAIN - LOWER GROUND LEVEL - WHEAT ROAD DEMOLITION**  
SCALE 1 : 200  
(DEMOLITION SHOWN IN DASHED RED LINE)

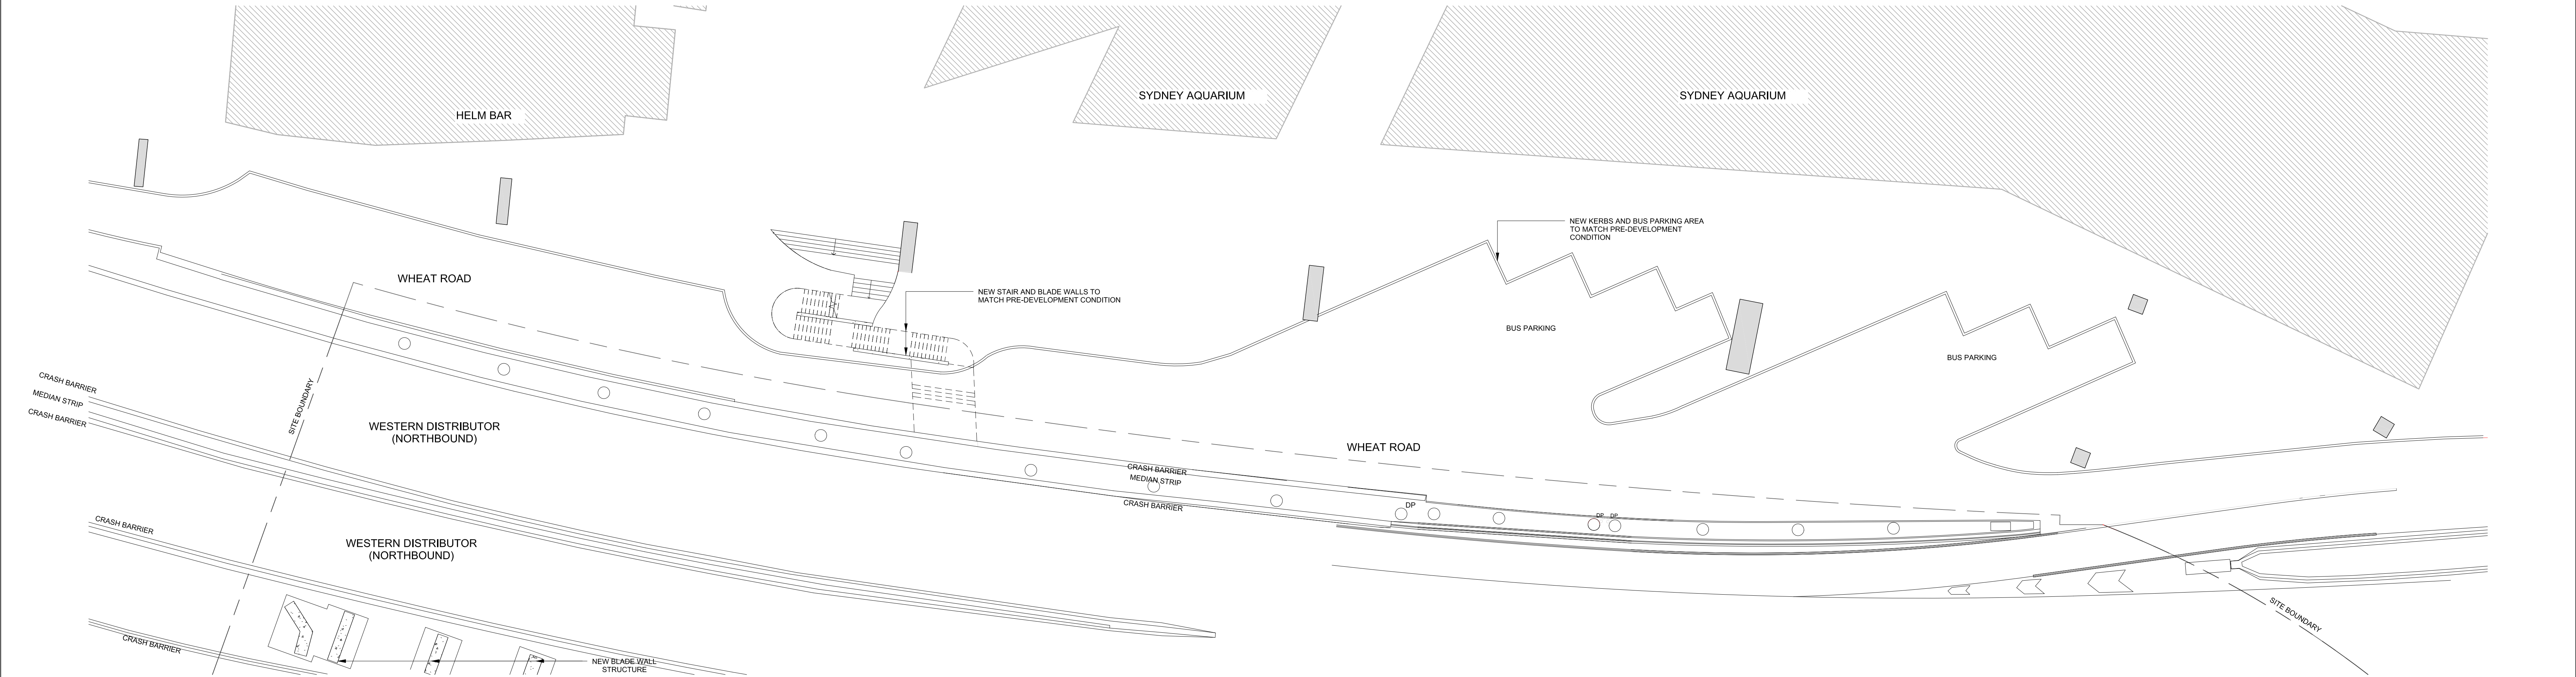

**2 PUBLIC DOMAIN - LOWER GROUND LEVEL - WHEAT ROAD PROPOSED**  
SCALE 1 : 200