

NOTES

HORIZONTAL DATUM:
CO-ORDINATE SYSTEM: N/A
MARKS ADOPTED:

VERTICAL DATUM:
DATUM: A.H.D.
B.M. ADOPTED: P.M 42338
R.L.: 16.71
SOURCE: S.C.I.M.S.

B	DRAINAGE PIT ADDED	11/04/11
A	FINAL	31/03/11
REV.	AMENDMENTS	DATE

CLIENT:

CHRISTIE CIVIL

FRASERS PROPERTY

PLAN
SHOWING AS BUILT SURVEY
OF DRAINAGE, SEWER AND
ELECTRICAL CONDUIT WORKS
AT FRASERS BROADWAY
CHIPPENDALE


Degotardi, Smith & Partners
Consulting Surveyors
Established 1957

11/19-23 Bridge Street
Pymble NSW 2073
Telephone: (02) 9440 1100
Facsimile: (02) 9440 1055
E-mail: surveys@degotardi.com.au
Website: www.degotardi.com.au



Winner : "Sir Thomas Mitchell Excellence in
Surveying & Mapping Award 2004"

L.G.A. SYDNEY		SHEET 1 OF 3	
SURVEYED LB/PG	DRAWN PG	CHECKED PG	APPROVED PG
SURVEY REFERENCE 32313		SCALE 1:200	DATE 30/03/11
DRAWING NUMBER 32313A06.dwg			REV. B

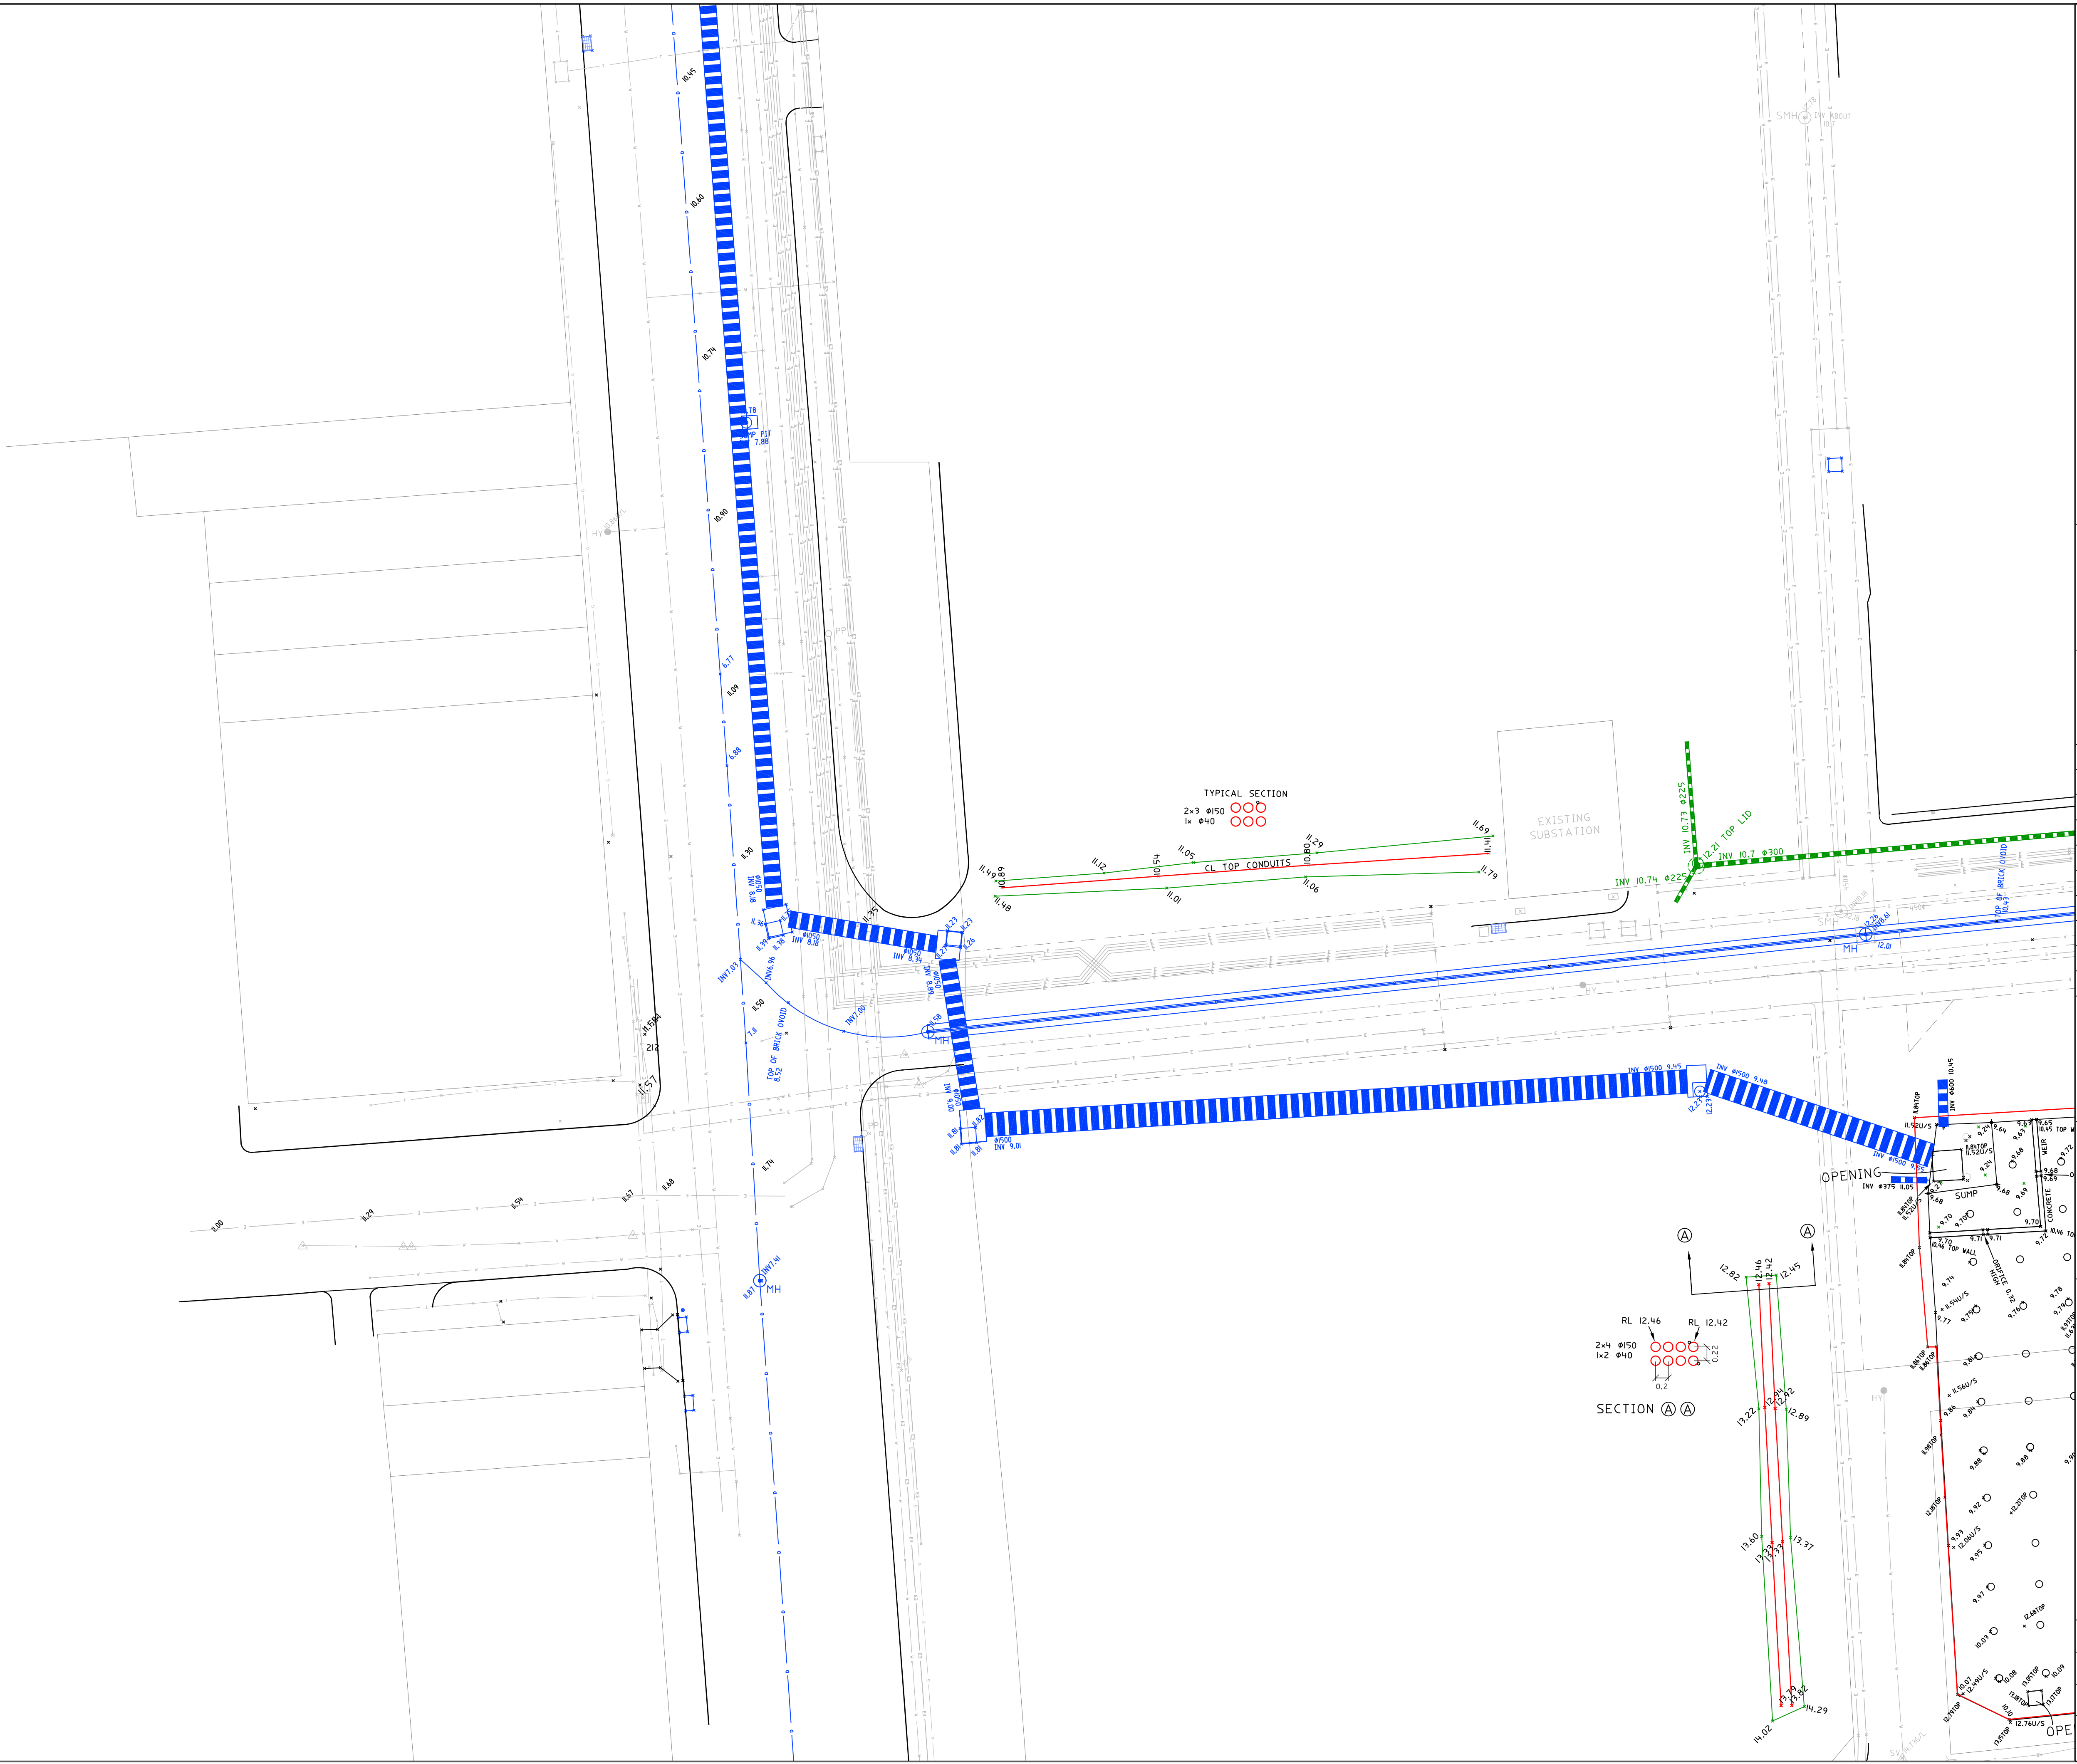

NOTES

HORIZONTAL DATUM:
CO-ORDINATE SYSTEM: N/A
MARKS ADOPTED:

VERTICAL DATUM:
DATUM: A.H.D.
B.M. ADOPTED: P.M 42338
R.L.: 16.71
SOURCE: S.C.I.M.S.

B	DRAINAGE PIT ADDED	11/04/11
A	FINAL	31/03/11
REV.	AMENDMENTS	DATE

CLIENT:

CHRISTIE CIVIL

FRASERS PROPERTY

PLAN
SHOWING AS BUILT SURVEY
OF DRAINAGE, SEWER AND
ELECTRICAL CONDUIT WORKS
AT FRASERS BROADWAY
CHIPPENDALE


Degotardi, Smith & Partners
Consulting Surveyors
Established 1957

11/19-23 Bridge Street
Pymble NSW 2073
Telephone: (02) 9440 1100
Facsimile: (02) 9440 1055
E-mail: surveys@degotardi.com.au
Website: www.degotardi.com.au



Winner : "Sir Thomas Mitchell Excellence in
Surveying & Mapping Award 2004"

L.G.A. SYDNEY		SHEET 2 OF 3	
SURVEYED LB/PG	DRAWN PG	CHECKED PG	APPROVED PG
SURVEY REFERENCE 32313		SCALE 1:200	DATE 30/03/11
DRAWING NUMBER 32313A06.dwg			REV. B

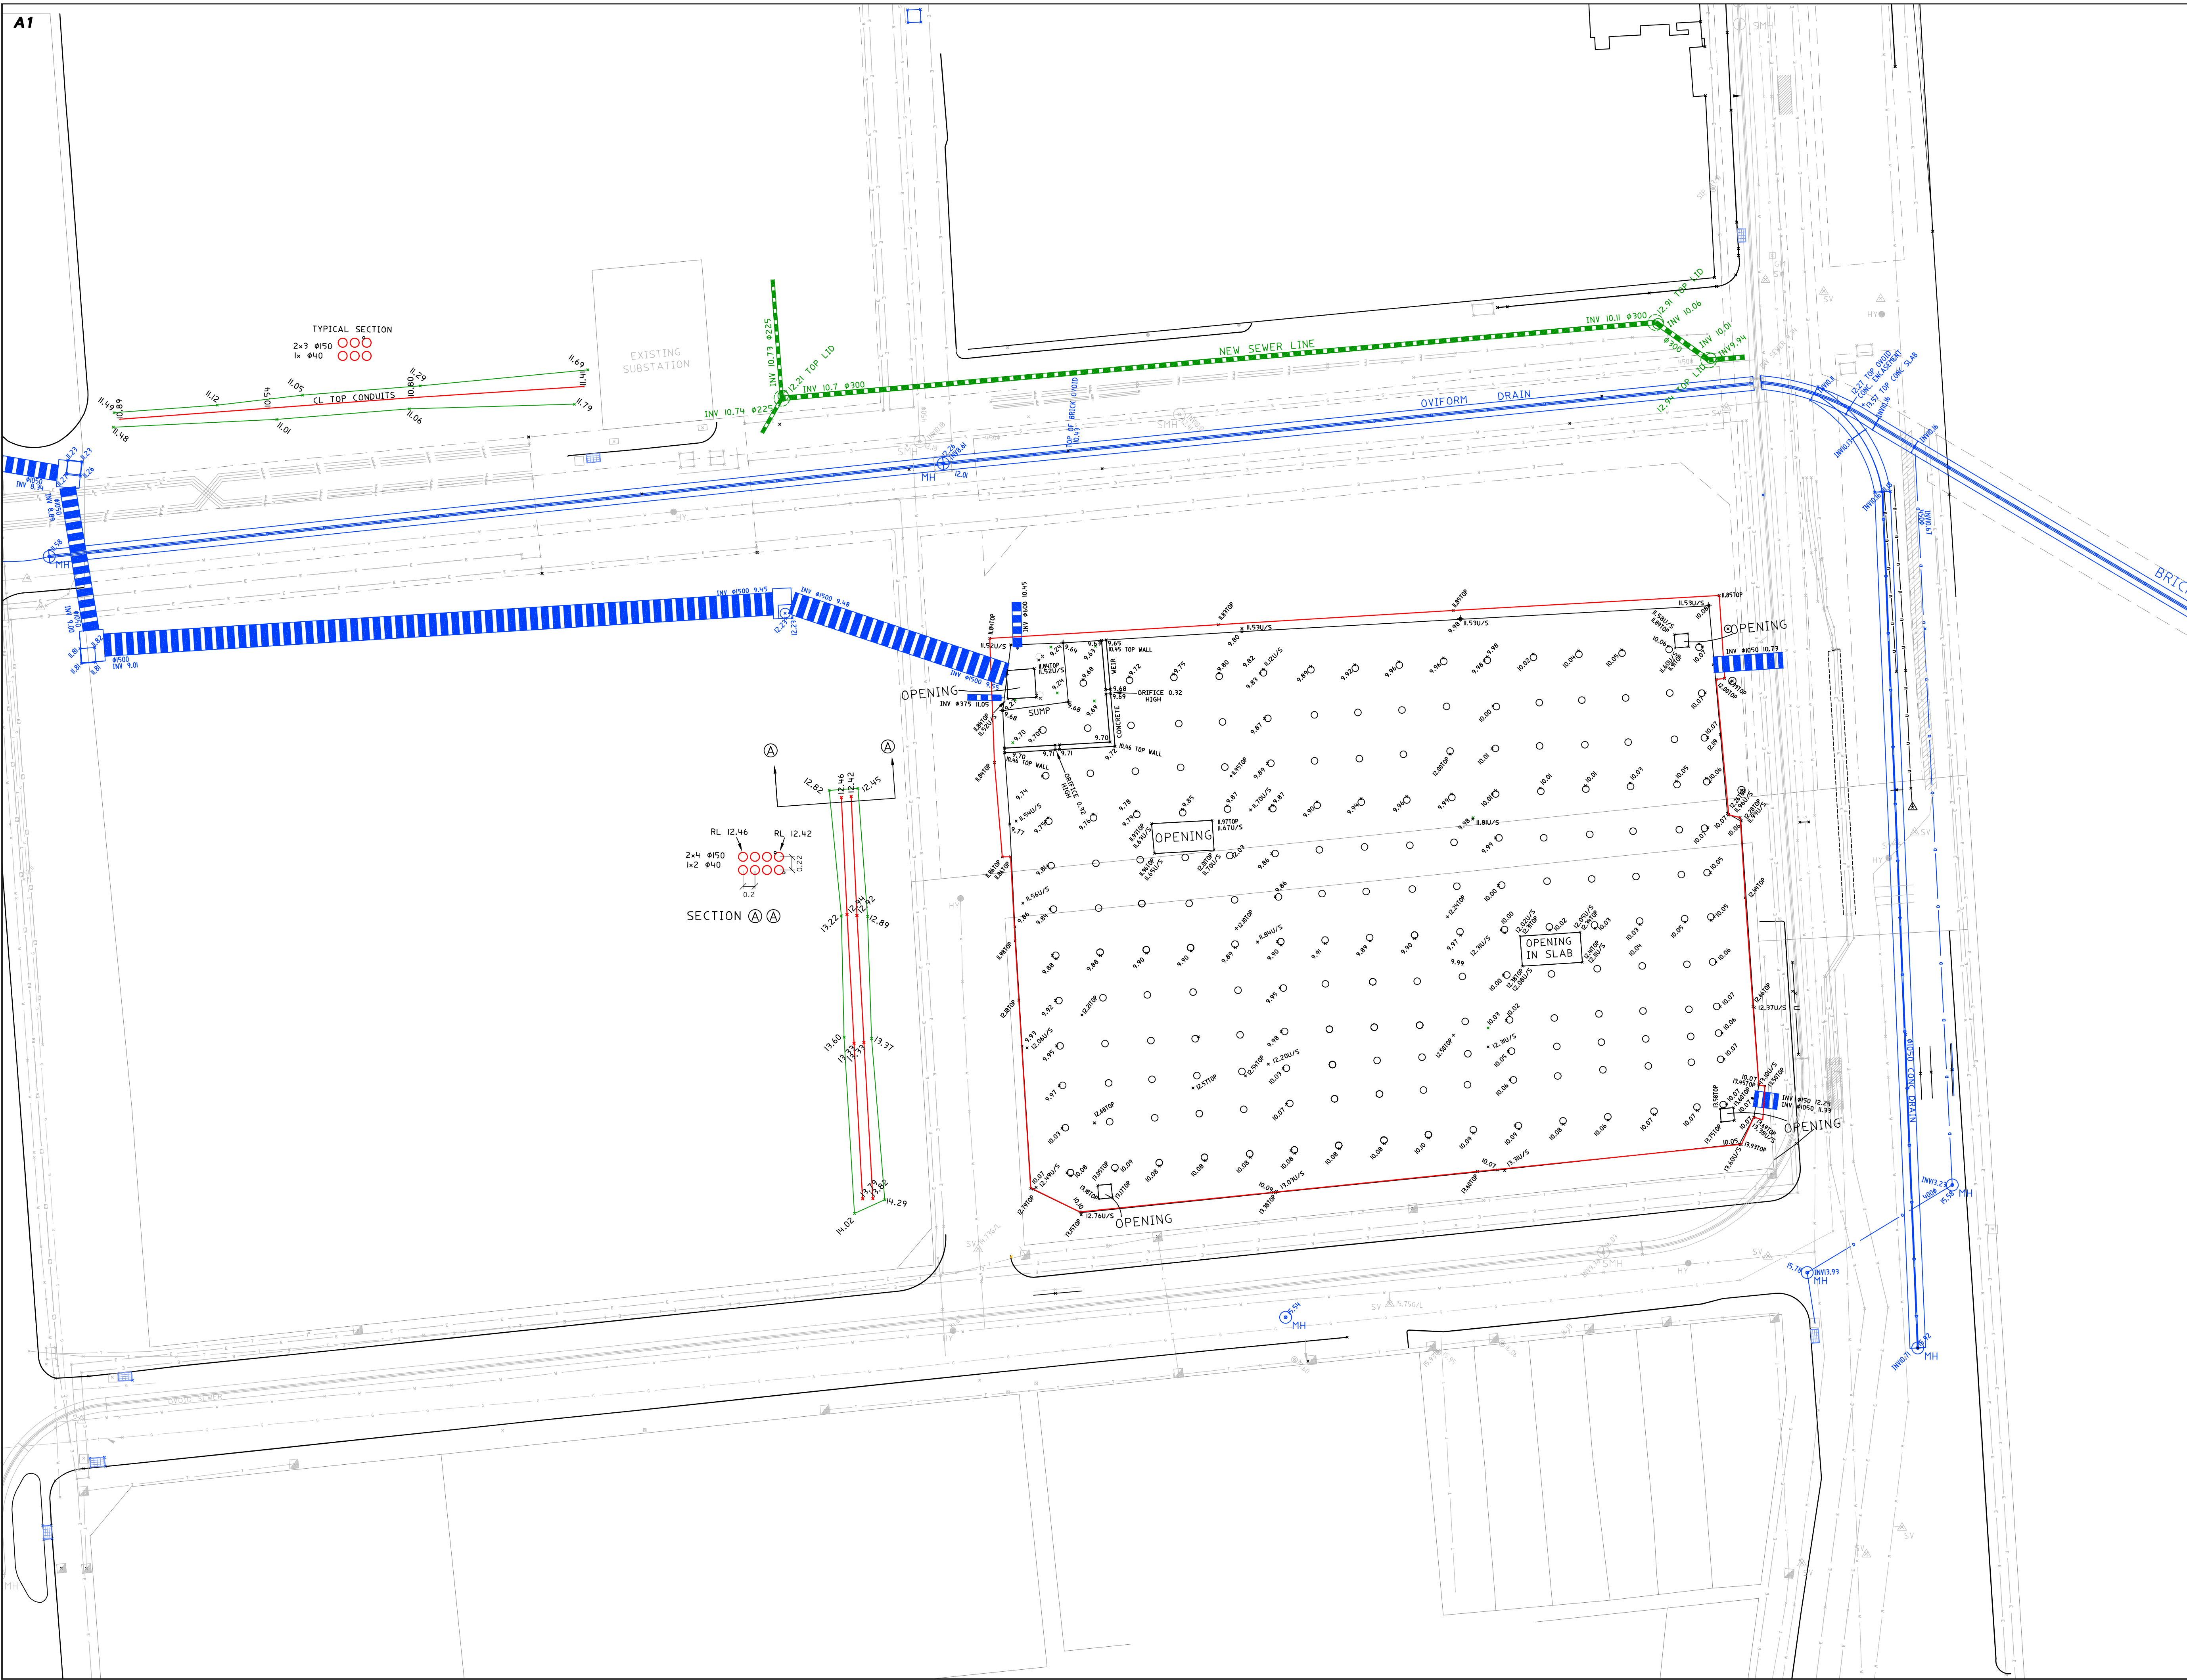

NOTES

HORIZONTAL DATUM:
CO-ORDINATE SYSTEM: N/A
MARKS ADOPTED:

VERTICAL DATUM:
DATUM: A.H.D.
B.M. ADOPTED: P.M 42338
R.L.: 16.71
SOURCE: S.C.I.M.S.

B	DRAINAGE PIT ADDED	11/04/11
A	FINAL	31/03/11
REV.	AMENDMENTS	DATE

CLIENT:

CHRISTIE CIVIL

FRASERS PROPERTY

PLAN
SHOWING AS BUILT SURVEY
OF DRAINAGE, SEWER AND
ELECTRICAL CONDUIT WORKS
AT FRASERS BROADWAY
CHIPPENDALE


Degotardi, Smith & Partners
Consulting Surveyors
Established 1957

11/19-23 Bridge Street
Pymble NSW 2073
Telephone: (02) 9440 1100
Facsimile: (02) 9440 1055
E-mail: surveys@degotardi.com.au
Website: www.degotardi.com.au




Winner : "Sir Thomas Mitchell Excellence in
Surveying & Mapping Award 2004"

L.G.A. SYDNEY	SHEET 3 OF 3		
SURVEYED LB/PG	DRAWN PG	CHECKED PG	APPROVED PG
SURVEY REFERENCE 32313		SCALE 1:200	DATE 30/03/11
DRAWING NUMBER 32313A06.dwg			REV. B

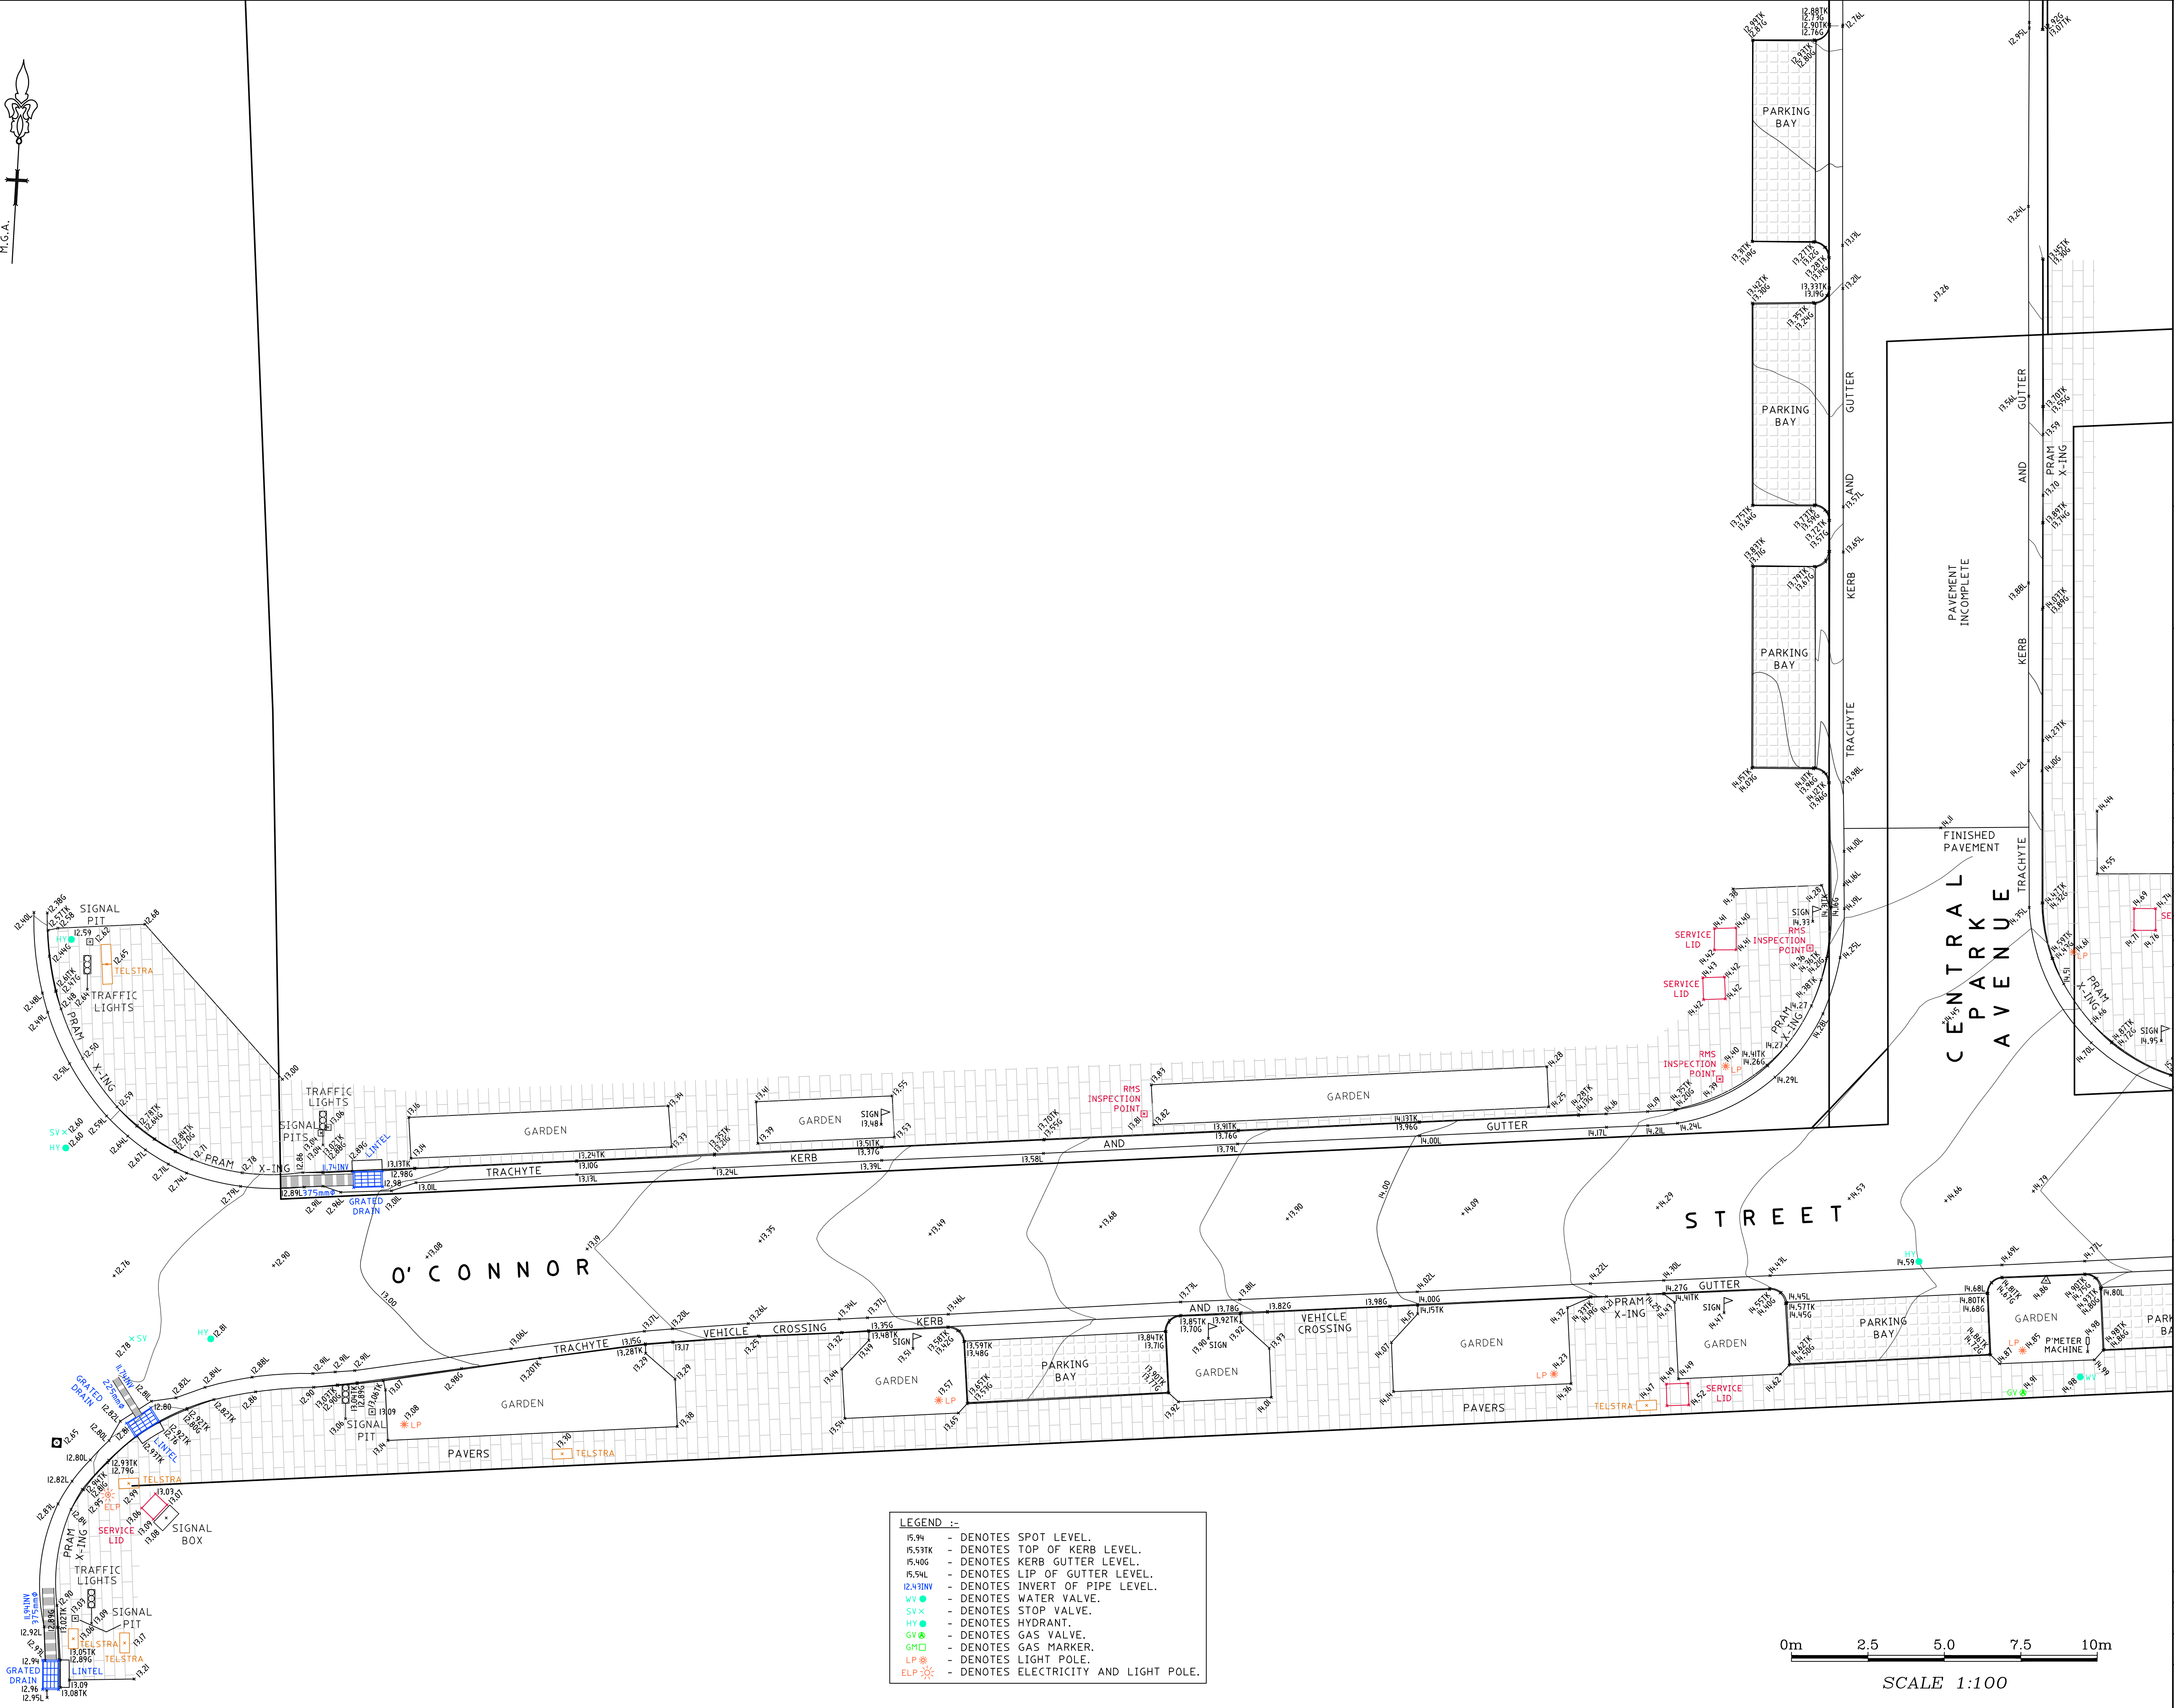

LEGEND :-	
15.94	- DENOTES SPOT LEVEL.
15.53TK	- DENOTES TOP OF KERB LEVEL.
15.40G	- DENOTES KERB GUTTER LEVEL.
15.54L	- DENOTES LIP OF GUTTER LEVEL.
12.43INV	- DENOTES INVERT OF PIPE LEVEL.
WV	- DENOTES WATER VALVE.
SV	- DENOTES STOP VALVE.
HY	- DENOTES HYDRANT.
GV	- DENOTES GAS VALVE.
GM	- DENOTES GAS MARKER.
LP	- DENOTES LIGHT POLE.
ELP	- DENOTES ELECTRICITY AND LIGHT POLE.

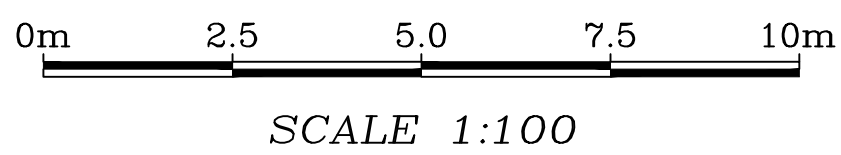

NOTES

- CONTOURS ARE INDICATIVE ONLY. CONTOUR INTERVAL 0.2m.
- ONLY VISIBLE SERVICES HAVE BEEN LOCATED IN THIS SURVEY.
- USERS OF THIS DRAWING HAVE A DUTY OF CARE TO CONTACT "DIAL BEFORE YOU DIG" FREE CALL 1100 OR FOR SPEED OF RESPONSE VISIT www.dialbeforeyoudig.com.au
- TELSTRA ADVISES THAT THIS SITE IS WITHIN THE PROXIMITY OF SOME OF THEIR MAJOR NETWORK. AS PART OF YOUR DUTY OF CARE PLEASE CONTACT THE NETWORKING INTEGRITY AND COMPLIANCE GROUP (1800 653935) PRIOR TO PROCEEDING WITH ANY WORK.
- AS PART OF YOUR DUTY OF CARE PLEASE CONTACT THE FOLLOWING:
 - JEMENA GAS Ph: 132909
 - ENERGY AUSTRALIA Ph: 131525
 - INTEGRAL ENERGY Ph: 131002
 - SYDNEY WATER Ph: 132092
 - OPTUS-VISION Ph: 1800 505777
- THIS PLAN HAS BEEN PREPARED FOR THE EXCLUSIVE USE OF CHRISTIE CIVIL.
- THE POSITION OF SURVEYED DATA HAS BEEN LOCATED AND IS SHOWN TO TOPOGRAPHIC ACCURACIES. IF CLEARANCES TO BOUNDARIES OR OTHER FEATURES ARE CRITICAL AND DIMENSIONS ARE NOT SHOWN FURTHER SURVEY MAY BE REQUIRED.
- BOUNDARIES HAVE NOT BEEN DEFINED AS PART OF THIS SURVEY.
- BOUNDARIES ARE APPROXIMATE AND WILL REQUIRE FURTHER DEFINITION.
- COPYRIGHT © DEGOTARDI SMITH & PARTNERS SURVEYORS 2013.
- NO PART OF THIS SURVEY MAY BE REPRODUCED, STORED IN A RETRIEVAL SYSTEM OR TRANSMITTED IN ANY FORM, WITHOUT THE WRITTEN PERMISSION OF THE COPYRIGHT OWNER EXCEPT AS PERMITTED BY THE COPYRIGHT ACT 1968.
- ANY PERMITTED DOWNLOADING, ELECTRONIC STORAGE, DISPLAY, PRINT, COPY OR REPRODUCTION OF THIS SURVEY SHOULD CONTAIN NO ALTERATION OR ADDITION TO THE ORIGINAL SURVEY. THIS NOTICE MUST NOT BE ERASED.

HORIZONTAL DATUM:

CO-ORDINATE SYSTEM: M.G.A.

MARKS ADOPTED:

VERTICAL DATUM:

DATUM: A.H.D.
B.M. ADOPTED: P.M. 42338
R.L. 16.71
SOURCE: S.C.I.M.S.

C	IRVINE STREET SURVEYED	04/07/13
B	FINAL	6/03/13
A	PRELIMINARY ISSUE	21/12/12
REV.	AMENDMENTS	DATE

CLIENT:

CHRISTIE CIVIL

PLAN

ROAD AS BUILT PLAN SHOWING
PART OF O'CONNOR STREET
AND PART OF
CENTRAL PARK AVENUE
AND IRVINE STREET




Degotardi Smith & Partners
CONSULTING SURVEYORS ESTABLISHED 1957

11/19-23 Bridge Street | Pymble
NSW 2073 | Australia
t. (+61) 2 9440 1100
f. (+61) 2 9440 1055
e. surveys@degotardi.com.au
w. www.degotardi.com.au



L.G.A. CITY OF SYDNEY		SHEET 1 OF 4	
SURVEYED L.B.	DRAWN P.R.G./R.N.	CHECKED L.B.	APPROVED P.L.G.
SURVEY REFERENCE 32313		SCALE 1:100	DATE 04/07/13
DRAWING NUMBER 32313A09.DWG		REV. C	

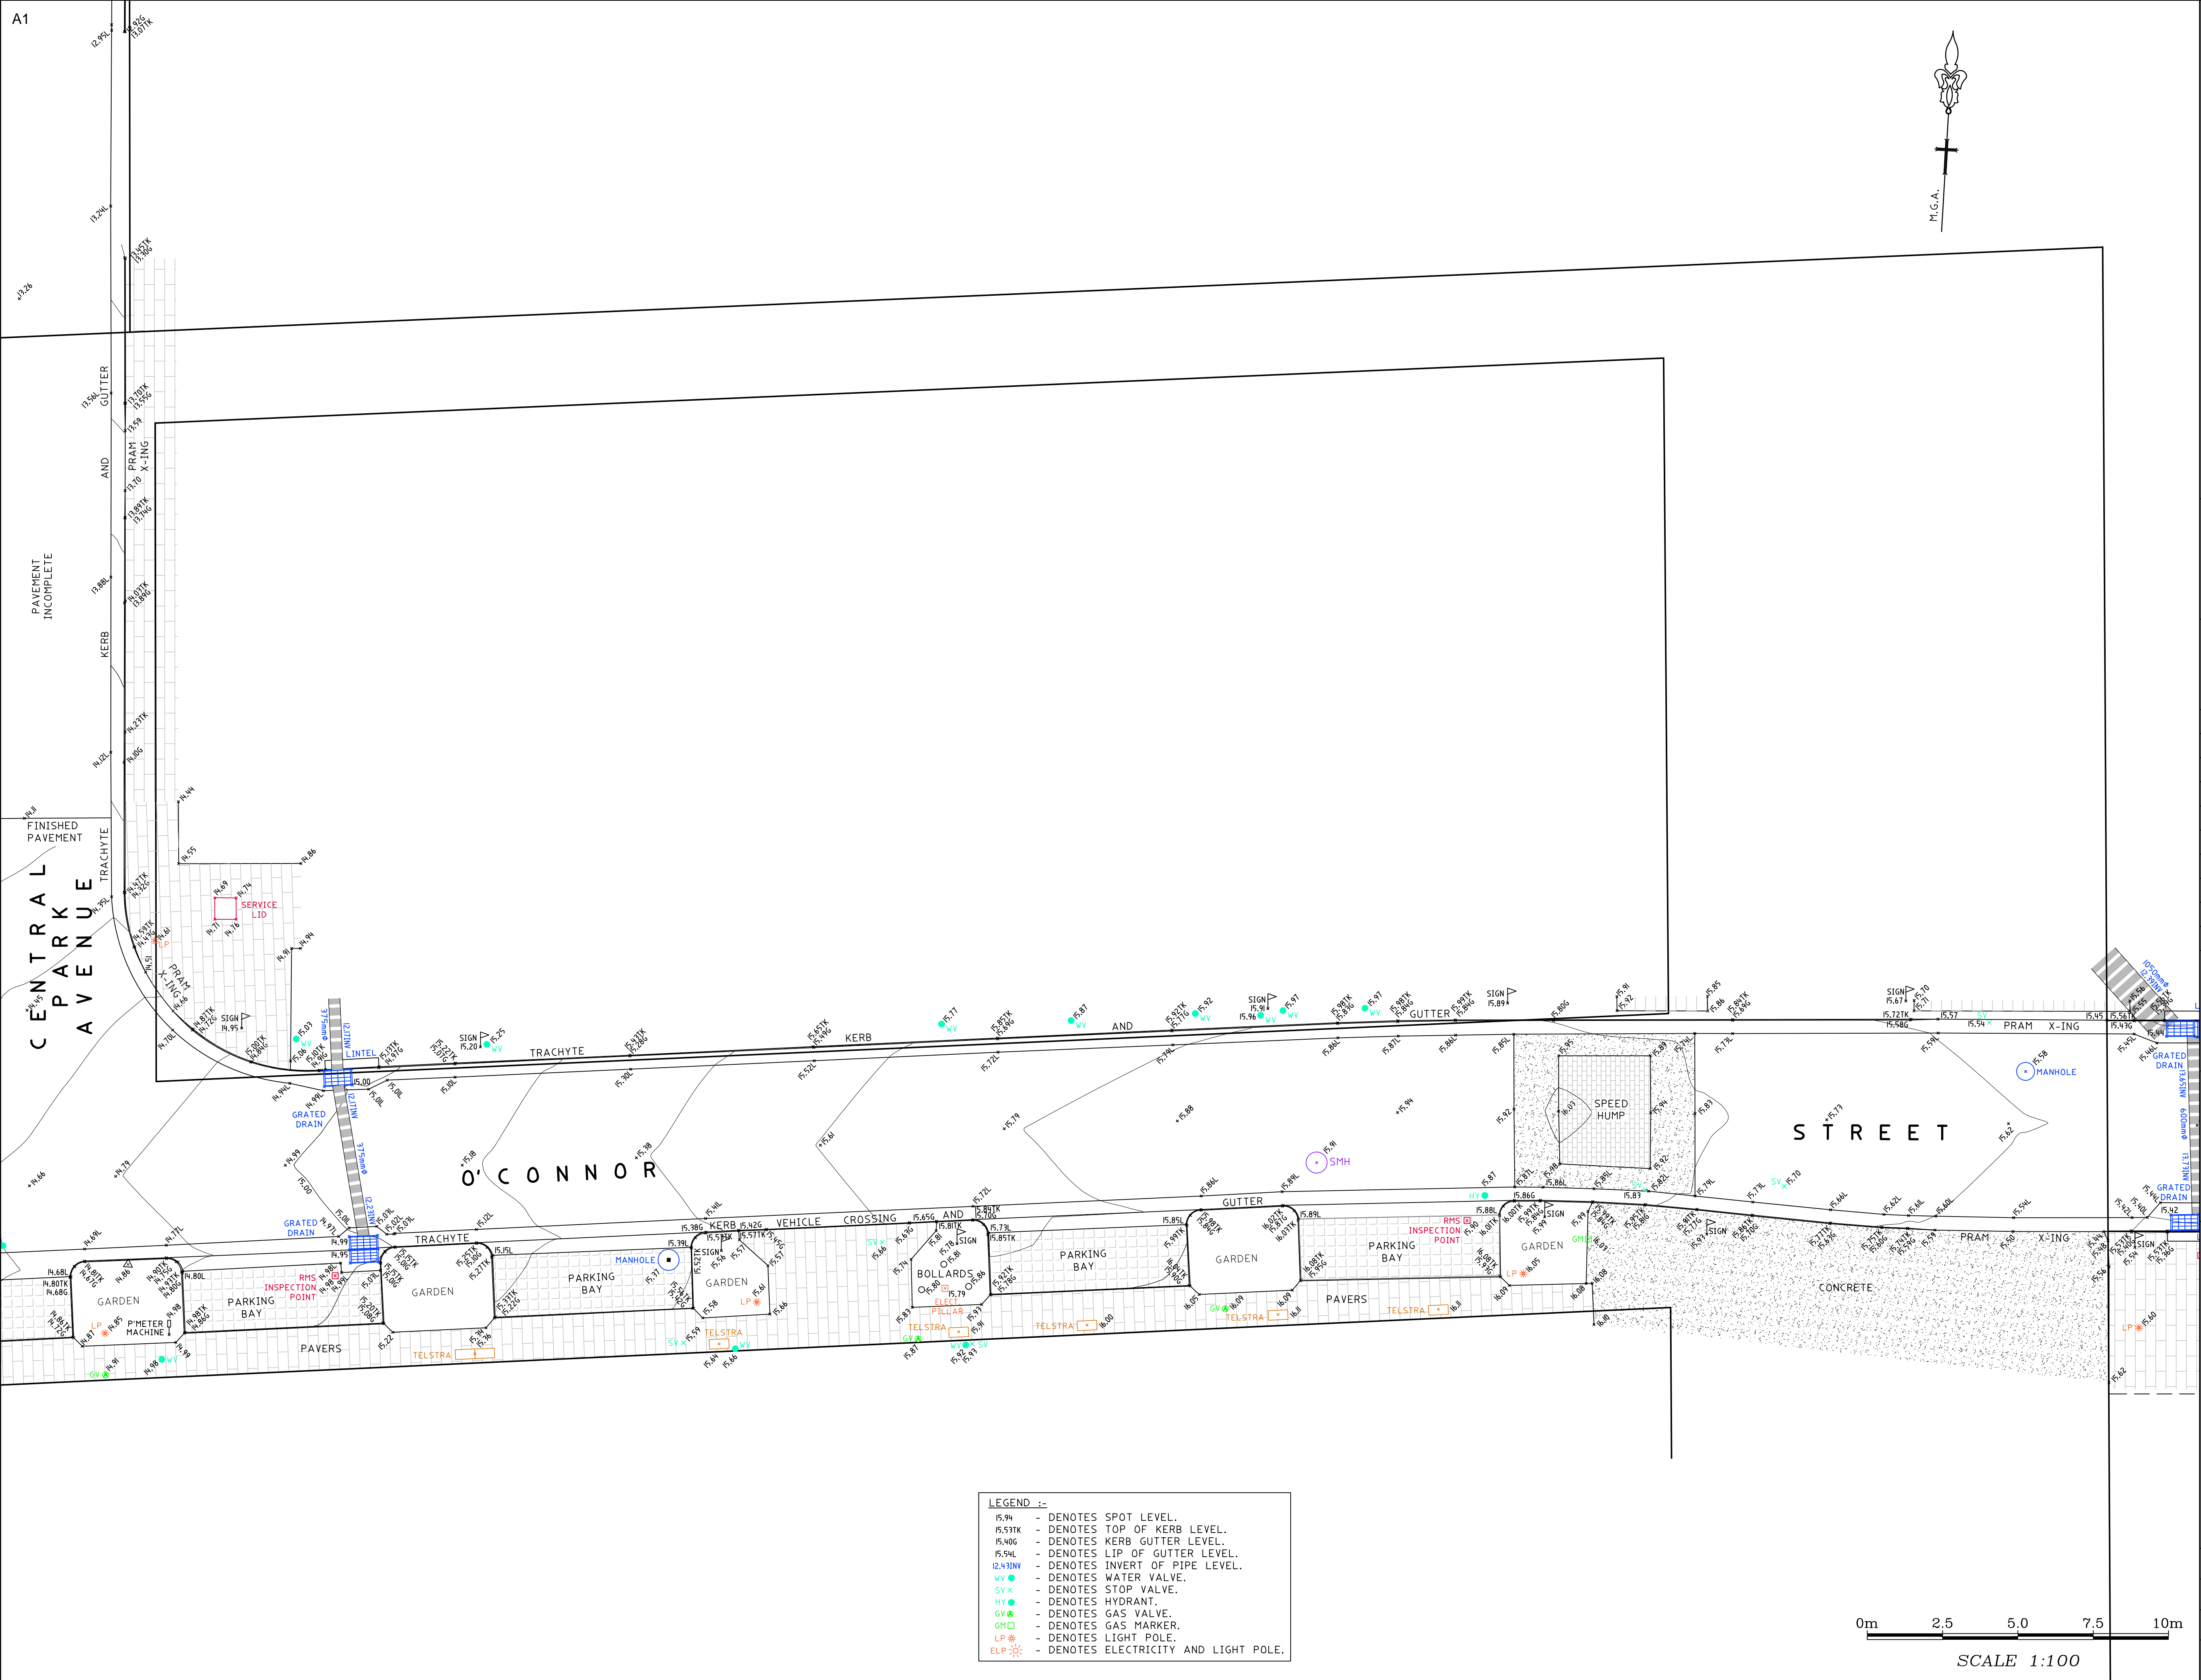

NOTES

- CONTOURS ARE INDICATIVE ONLY. CONTOUR INTERVAL 0.2m.
- ONLY VISIBLE SERVICES HAVE BEEN LOCATED IN THIS SURVEY.
- USERS OF THIS DRAWING HAVE A DUTY OF CARE TO CONTACT "DIAL BEFORE YOU DIG" FREE CALL 1100 OR FOR SPEED OF RESPONSE VISIT www.dialbeforeyoudig.com.au
- TELSTRA ADVISES THAT THIS SITE IS WITHIN THE PROXIMITY OF SOME OF THEIR MAJOR NETWORK. AS PART OF YOUR DUTY OF CARE PLEASE CONTACT THE NETWORKING INTEGRITY AND COMPLIANCE GROUP (1800 653935) PRIOR TO PROCEEDING WITH ANY WORK.
- AS PART OF YOUR DUTY OF CARE PLEASE CONTACT THE FOLLOWING:

JEMENA GAS
ENERGY AUSTRALIA
INTEGRAL ENERGY
SYDNEY WATER
OPTUS-VISION

Ph. 132909
Ph. 131525
Ph. 131002
Ph. 132092
Ph. 1800 505777
- THIS PLAN HAS BEEN PREPARED FOR THE EXCLUSIVE USE OF CHRISTIE CIVIL.
- THE POSITION OF SURVEYED DATA HAS BEEN LOCATED AND IS SHOWN TO TOPOGRAPHIC ACCURACIES. IF CLEARANCES TO BOUNDARIES OR OTHER FEATURES ARE CRITICAL AND DIMENSIONS ARE NOT SHOWN FURTHER SURVEY MAY BE REQUIRED.
- BOUNDARIES HAVE NOT BEEN DEFINED AS PART OF THIS SURVEY.
- BOUNDARIES ARE APPROXIMATE AND WILL REQUIRE FURTHER DEFINITION.
- COPYRIGHT © DEGOTARDI SMITH & PARTNERS SURVEYORS 2013.

NO PART OF THIS SURVEY MAY BE REPRODUCED, STORED IN A RETRIEVAL SYSTEM OR TRANSMITTED IN ANY FORM, WITHOUT THE WRITTEN PERMISSION OF THE COPYRIGHT OWNER EXCEPT AS PERMITTED BY THE COPYRIGHT ACT 1968.

ANY PERMITTED DOWNLOADING, ELECTRONIC STORAGE, DISPLAY, PRINT, COPY OR REPRODUCTION OF THIS SURVEY SHOULD CONTAIN NO ALTERATION OR ADDITION TO THE ORIGINAL SURVEY. THIS NOTICE MUST NOT BE ERASED.

HORIZONTAL DATUM:

CO-ORDINATE SYSTEM: M.G.A.

MARKS ADOPTED:

VERTICAL DATUM:

DATUM: A.H.D.

B.M. ADOPTED: P.M. 42338

R.L. 16.71

SOURCE: S.C.I.M.S.

C	IRVINE STREET SURVEYED	04/07/13
B	FINAL	6/03/13
A	PRELIMINARY ISSUE	21/12/12
REV.	AMENDMENTS	DATE

CLIENT:

CHRISTIE CIVIL

PLAN

ROAD AS BUILT PLAN SHOWING PART OF O'CONNOR STREET AND PART OF CENTRAL PARK AVENUE AND IRVINE STREET

D

S

&

P

Degotardi Smith & Partners

CONSULTING SURVEYORS ESTABLISHED 1957

11/19-23 Bridge Street | Pymble
NSW 2073 | Australia
t. (+61) 2 9440 1100
f. (+61) 2 9440 1055
e. surveys@degotardi.com.au
w. www.degotardi.com.au

Quality Management ISO 9001


Global Mark.com.au®

L.G.A. CITY OF SYDNEY

SHEET 2 OF 4

SURVEYED L.B.	DRAWN P.R.G./R.N.	CHECKED L.B.	APPROVED P.L.G.
SURVEY REFERENCE 32313		SCALE 1:100	DATE 04/07/13
DRAWING NUMBER 32313A09.DWG			REV. C

LEGEND :-	
15.94	- DENOTES SPOT LEVEL.
15.53TK	- DENOTES TOP OF KERB LEVEL.
15.40G	- DENOTES KERB GUTTER LEVEL.
15.54L	- DENOTES LIP OF GUTTER LEVEL.
12.43INV	- DENOTES INVERT OF PIPE LEVEL.
WV ●	- DENOTES WATER VALVE.
SV x	- DENOTES STOP VALVE.
HY ●	- DENOTES HYDRANT.
GV ●	- DENOTES GAS VALVE.
GM □	- DENOTES GAS MARKER.
LP *	- DENOTES LIGHT POLE.
ELP *	- DENOTES ELECTRICITY AND LIGHT POLE.

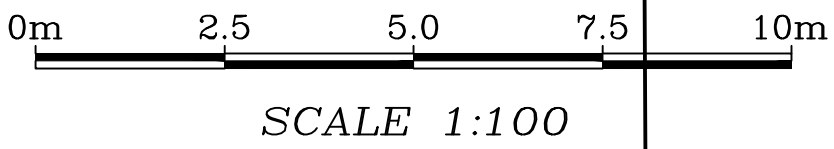



NOTES

- CONTOURS ARE INDICATIVE ONLY. CONTOUR INTERVAL 0.2m.
 - ONLY VISIBLE SERVICES HAVE BEEN LOCATED IN THIS SURVEY.
 - USERS OF THIS DRAWING HAVE A DUTY OF CARE TO CONTACT "DIAL BEFORE YOU DIG" FREE CALL 1100 OR FOR SPEED OF RESPONSE VISIT www.dialbeforeyoudig.com.au
 - TELSTRA ADVISES THAT THIS SITE IS WITHIN THE PROXIMITY OF SOME OF THEIR MAJOR NETWORK. AS PART OF YOUR DUTY OF CARE PLEASE CONTACT THE NETWORKING INTEGRITY AND COMPLIANCE GROUP (1800 653935) PRIOR TO PROCEEDING WITH ANY WORK.
 - AS PART OF YOUR DUTY OF CARE PLEASE CONTACT THE FOLLOWING:
 - JEMENA GAS Ph. 132909
 - ENERGY AUSTRALIA Ph. 131525
 - INTEGRAL ENERGY Ph. 131002
 - SYDNEY WATER Ph. 132092
 - OPTUS-VISION Ph. 1800 505777
 - THIS PLAN HAS BEEN PREPARED FOR THE EXCLUSIVE USE OF CHRISTIE CIVIL.
 - THE POSITION OF SURVEYED DATA HAS BEEN LOCATED AND IS SHOWN TO TOPOGRAPHIC ACCURACIES. IF CLEARANCES TO BOUNDARIES OR OTHER FEATURES ARE CRITICAL AND DIMENSIONS ARE NOT SHOWN FURTHER SURVEY MAY BE REQUIRED.
 - BOUNDARIES HAVE NOT BEEN DEFINED AS PART OF THIS SURVEY.
 - BOUNDARIES ARE APPROXIMATE AND WILL REQUIRE FURTHER DEFINITION.
 - COPYRIGHT © DEGOTARDI SMITH & PARTNERS SURVEYORS 2013.
- NO PART OF THIS SURVEY MAY BE REPRODUCED, STORED IN A RETRIEVAL SYSTEM OR TRANSMITTED IN ANY FORM, WITHOUT THE WRITTEN PERMISSION OF THE COPYRIGHT OWNER EXCEPT AS PERMITTED BY THE COPYRIGHT ACT 1968.
- ANY PERMITTED DOWNLOADING, ELECTRONIC STORAGE, DISPLAY, PRINT, COPY OR REPRODUCTION OF THIS SURVEY SHOULD CONTAIN NO ALTERATION OR ADDITION TO THE ORIGINAL SURVEY. THIS NOTICE MUST NOT BE ERASED.

HORIZONTAL DATUM:
CO-ORDINATE SYSTEM: M.G.A.
MARKS ADOPTED:

VERTICAL DATUM:
DATUM: A.H.D.
B.M. ADOPTED: P.M. 42338
R.L. 16.71
SOURCE: S.C.I.M.S.

C	IRVINE STREET SURVEYED	04/07/13
B	FINAL	6/03/13
A	PRELIMINARY ISSUE	21/12/12
REV.	AMENDMENTS	DATE

CLIENT:
CHRISTIE CIVIL

PLAN
ROAD AS BUILT PLAN SHOWING
PART OF O'CONNOR STREET
AND PART OF
CENTRAL PARK AVENUE
AND IRVINE STREET




Degotardi Smith & Partners
CONSULTING SURVEYORS ESTABLISHED 1957

11/19-23 Bridge Street | Pymble
NSW 2073 | Australia
t. (+61) 2 9440 1100
f. (+61) 2 9440 1055
e. surveys@degotardi.com.au
w. www.degotardi.com.au



L.G.A. CITY OF SYDNEY		SHEET 3 OF 4	
SURVEYED L.B.	DRAWN P.R.G./R.N.	CHECKED L.B.	APPROVED P.L.G.
SURVEY REFERENCE 32313		SCALE 1:100	DATE 04/07/13
DRAWING NUMBER 32313A09.DWG		REV. C	

- LEGEND :-
- 15.94 - DENOTES SPOT LEVEL.
 - 15.53TK - DENOTES TOP OF KERB LEVEL.
 - 15.406 - DENOTES KERB GUTTER LEVEL.
 - 15.54L - DENOTES LIP OF GUTTER LEVEL.
 - 12.43INV - DENOTES INVERT OF PIPE LEVEL.
 - WV - DENOTES WATER VALVE.
 - SV X - DENOTES STOP VALVE.
 - HY - DENOTES HYDRANT.
 - GV - DENOTES GAS VALVE.
 - GM - DENOTES GAS MARKER.
 - LP - DENOTES LIGHT POLE.
 - ELP - DENOTES ELECTRICITY AND LIGHT POLE.

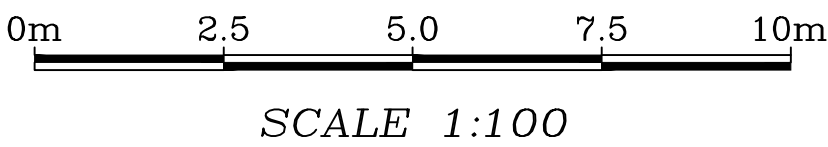




ABERCROMBIE STREET

IRVINE STREET

CENTRAL PARK AVENUE

LEGEND :-	
15.94	- DENOTES SPOT LEVEL.
15.53TK	- DENOTES TOP OF KERB LEVEL.
15.40G	- DENOTES KERB GUTTER LEVEL.
15.54L	- DENOTES LIP OF GUTTER LEVEL.
12.43INV	- DENOTES INVERT OF PIPE LEVEL.
WV●	- DENOTES WATER VALVE.
SV×	- DENOTES STOP VALVE.
HY●	- DENOTES HYDRANT.
GV●	- DENOTES GAS VALVE.
GM□	- DENOTES GAS MARKER.
LP*	- DENOTES LIGHT POLE.
ELP*	- DENOTES ELECTRICITY AND LIGHT POLE.

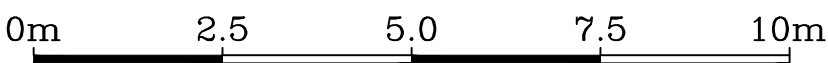

SCALE 1:100

NOTES

- CONTOURS ARE INDICATIVE ONLY. CONTOUR INTERVAL 0.5m.
 - ONLY VISIBLE SERVICES HAVE BEEN LOCATED IN THIS SURVEY.
 - USERS OF THIS DRAWING HAVE A DUTY OF CARE TO CONTACT "DIAL BEFORE YOU DIG" FREE CALL 1100 OR FOR SPEED OF RESPONSE VISIT www.dialbeforeyoudig.com.au
 - TELSTRA ADVISES THAT THIS SITE IS WITHIN THE PROXIMITY OF SOME OF THEIR MAJOR NETWORK. AS PART OF YOUR DUTY OF CARE PLEASE CONTACT THE NETWORKING INTEGRITY AND COMPLIANCE GROUP (1800 653935) PRIOR TO PROCEEDING WITH ANY WORK.
 - AS PART OF YOUR DUTY OF CARE PLEASE CONTACT THE FOLLOWING:

JEMENA GAS	Ph. 132909
ENERGY AUSTRALIA	Ph. 131525
INTEGRAL ENERGY	Ph. 131002
SYDNEY WATER	Ph. 132092
OPTUS-VISION	Ph. 1800 505777
 - THIS PLAN HAS BEEN PREPARED FOR THE EXCLUSIVE USE OF CHRISTIE CIVIL.
 - THE POSITION OF SURVEYED DATA HAS BEEN LOCATED AND IS SHOWN TO TOPOGRAPHIC ACCURACIES. IF CLEARANCES TO BOUNDARIES OR OTHER FEATURES ARE CRITICAL AND DIMENSIONS ARE NOT SHOWN FURTHER SURVEY MAY BE REQUIRED.
 - BOUNDARIES HAVE NOT BEEN DEFINED AS PART OF THIS SURVEY.
 - COPYRIGHT © DEGOTARDI SMITH & PARTNERS SURVEYORS 2013.
- NO PART OF THIS SURVEY MAY BE REPRODUCED, STORED IN A RETRIEVAL SYSTEM OR TRANSMITTED IN ANY FORM, WITHOUT THE WRITTEN PERMISSION OF THE COPYRIGHT OWNER EXCEPT AS PERMITTED BY THE COPYRIGHT ACT 1968.
- ANY PERMITTED DOWNLOADING, ELECTRONIC STORAGE, DISPLAY, PRINT, COPY OR REPRODUCTION OF THIS SURVEY SHOULD CONTAIN NO ALTERATION OR ADDITION TO THE ORIGINAL SURVEY. THIS NOTICE MUST NOT BE ERASED.

HORIZONTAL DATUM:

CO-ORDINATE SYSTEM: M.G.A.

MARKS ADOPTED:

VERTICAL DATUM:

DATUM: A.H.D.
B.M. ADOPTED: P.M. 42338
R.L. 16.71
SOURCE: S.C.I.M.S.

C	IRVINE STREET SURVEYED	04/07/13
B	FINAL	6/03/13
A	PRELIMINARY ISSUE	21/12/12
REV.	AMENDMENTS	DATE

CLIENT:

CHRISTIE CIVIL

PLAN

ROAD AS BUILT PLAN SHOWING
PART OF O'CONNOR STREET
AND PART OF
CENTRAL PARK AVENUE
AND IRVINE STREET



Degotardi Smith & Partners
CONSULTING SURVEYORS ESTABLISHED 1957

11/19-23 Bridge Street | Pymble
NSW 2073 | Australia
t. (+61) 2 9440 1100
f. (+61) 2 9440 1055
e. surveys@degotardi.com.au
w. www.degotardi.com.au



L.G.A. CITY OF SYDNEY		SHEET 4 OF 4	
SURVEYED L.B.	DRAWN P.R.G./R.N.	CHECKED L.B.	APPROVED P.L.G.
SURVEY REFERENCE 32313		SCALE 1:100	DATE 04/07/13
DRAWING NUMBER 32313A09.DWG			REV. C