



Approved Section 96 (1A) (1) (2) Modification Application

in respect to ~~MR.~~ SSR 6603

Signed HR

Sheet No. 1 of 30

[illegible]

Revision Summary:

Revision 04 - Section 96 Amendments

- A = Second retail tenancy proposed at ground floor, 94 bicycle parking spaces moved to basement.
- B = Revision to landscape details.
Tower lobby FFL lowered from 10.70 to 10.50. Entrance gradient from road front to site reduced from 1:11 to 1:14.
Refer to Landscape drawings or list of detailed amendments.

NOT FOR CONSTRUCTION

04	25.05.16	z96 Application	KM	MLS
03	22.01.16	Development Application	KM	MLS
02	19.09.14	Development Application	KM	MLS
01	10.09.14	For Information	KM	MLS
Revision	Date	Description	Initial	Checked

Site 68
Sydney Olympic Park

Site Plan
Ground Plane



Scale 1:400 @ A1, 1:800 @ A3

Drawn _____ Checked _____

Project No.	S11611
Status	S96 Application
Plot Date	23/6/2015 5:14 PM
Plot File	S:\11600-11609\11611_move_topo\to000_mnrcad\plots\DA- -001\3025.dwg
Drawing No.	[Revision]

A01.30[04]

Melbourne 1 Nicholson Street
Melbourne VIC 3000 Australia
T 03 8664 6200 F 03 8664 6300
email melb@bates-smart.com.au
<http://www.bates-smart.com.au>

Sydney 43 Brisbane Street
Surry Hills NSW 2010 Australia
T 02 8354 5100 F 02 8354 5199
email syd@batesmart.com.au
<http://www.batesmart.com.au>

Bates Smart Architects Pty Ltd ABN 68 094 740 986

BATES SMART™



Approved Section 96 (1A) (1) (2) Modification Application

in respect to ~~MP~~ SSD 6603

Signed.....*PR*

Sheet No. 2 of 30

Do not scale drawings - refer to figured dimensions only. Any discrepancies shall immediately be referred to the architect for clarification.

[illegible]

A - Rooftop crown raised by 1800mm. Projecting lift machine room deleted. No change to total building height.

NOT FOR CONSTRUCTION

04	25.05.15	s98 Application	KM	MLS
03	27.01.16	Development Application	KM	MLS
02	19.08.14	Development Application	KM	MLS
01	10.03.14	For Information	KM	MLS
Revision	Date	Description	Initial	Checked

Site Plan
Roof Plan



Project No. S11611

s96 Application

Plot Date 23/6/2015 5:14 PM

Plot File S:\11600-11699\11611_ecovs_sep07e800_malica
- JAD1.10041.dwg

A01.50[04]

Melbourne 1 Nicholson Street
Melbourne VIC 3000 Australia
T 03 8664 6200 F 03 8664 6300
email melb@batesmart.com.au
<http://www.batesmart.com.au>

Sydney 43 Brisbane Street
Surry Hills NSW 2010 Australia
T 02 8354 5100 F 02 8354 5199
email syd@batesmart.com.au
<http://www.batesmart.com.au>

Bates Smart Architects Pty Ltd ABN 68 094 740 986

BATESSMARTTM



NSW GOVERNMENT
Planning

Issued under the Environmental Planning and Assessment Act 1979

Approved Section 96 (1A) (1) (2) Modification Application

No. 1 granted on the 15/12/2015

in respect to MR S50 6603

Signed MR

Sheet No. 3 of 30

Check all dimensions and site conditions prior to commencement of any work, the purchase or ordering of any materials, fittings, plant, services or equipment and the preparation of shop drawings and/or the fabrication of any components.

All drawings to be read in conjunction with all architectural documents and all other consultants' documents.

Do not scale drawings - refer to figured dimensions only. Any discrepancies shall immediately be referred to the architect for clarification.

All drawings may not be reproduced or distributed without prior permission from the architect.

Revision Summary:
Revision 09 - Section 96 Amendments

A - Accessible car space converted to conventional space.
B - Divisarys enlarged from 61 to 68 bays due to increased unit count.
C - Conventional space converted to accessible space.
D - Car space drive aisles rotated by 90°. Ramp moved north.
E - Car parking count increased from 145 to 153 spaces.
F - Bike parking count increased from 156 to 259 spaces.

NOT FOR CONSTRUCTION

09	25.05.15	s96 Application	KM	MLS
08	22.01.15	Development Application	KM	MLS
07	03.11.14	Development Application	KM	MLS
06	19.09.14	Development Application	KM	MLS
05	03.09.14	For Information	JC	MLS
04	28.06.14	For Information	JC	MLS
03	28.06.14	For Information	JC	MLS
02	02.07.14	For Information	JC	MLS
01	25.06.14	For Information	JC	MLS
Revision	Date	Description	Initial	Checked

Site 68
Sydney Olympic Park

Plan
Basement Level B1


Scale 1:250 @ A1 1:500 @ A3
Drawn Checked
Project No. S11611
Status s96 Application
Plot Date 23/6/2015 5:15 PM
Plot File S:\11600-11620\11611_s96\scott\020_main\plan\plan\A02.B1[09].dwg
Drawing No. [Revision]

A02.B1[09]
Melbourne 1 Nicholson Street
Melbourne VIC 3000 Australia
T 03 8664 6200 F 03 8664 6300
email melb@batesmart.com.au
http://www.batesmart.com.au

Sydney 43 Brisbane Street
Surry Hills NSW 2010 Australia
T 02 8354 5100 F 02 8354 5199
email syd@batesmart.com.au
http://www.batesmart.com.au

Bates Smart Architects Pty Ltd ABN 68 094 740 986

BATESSMART

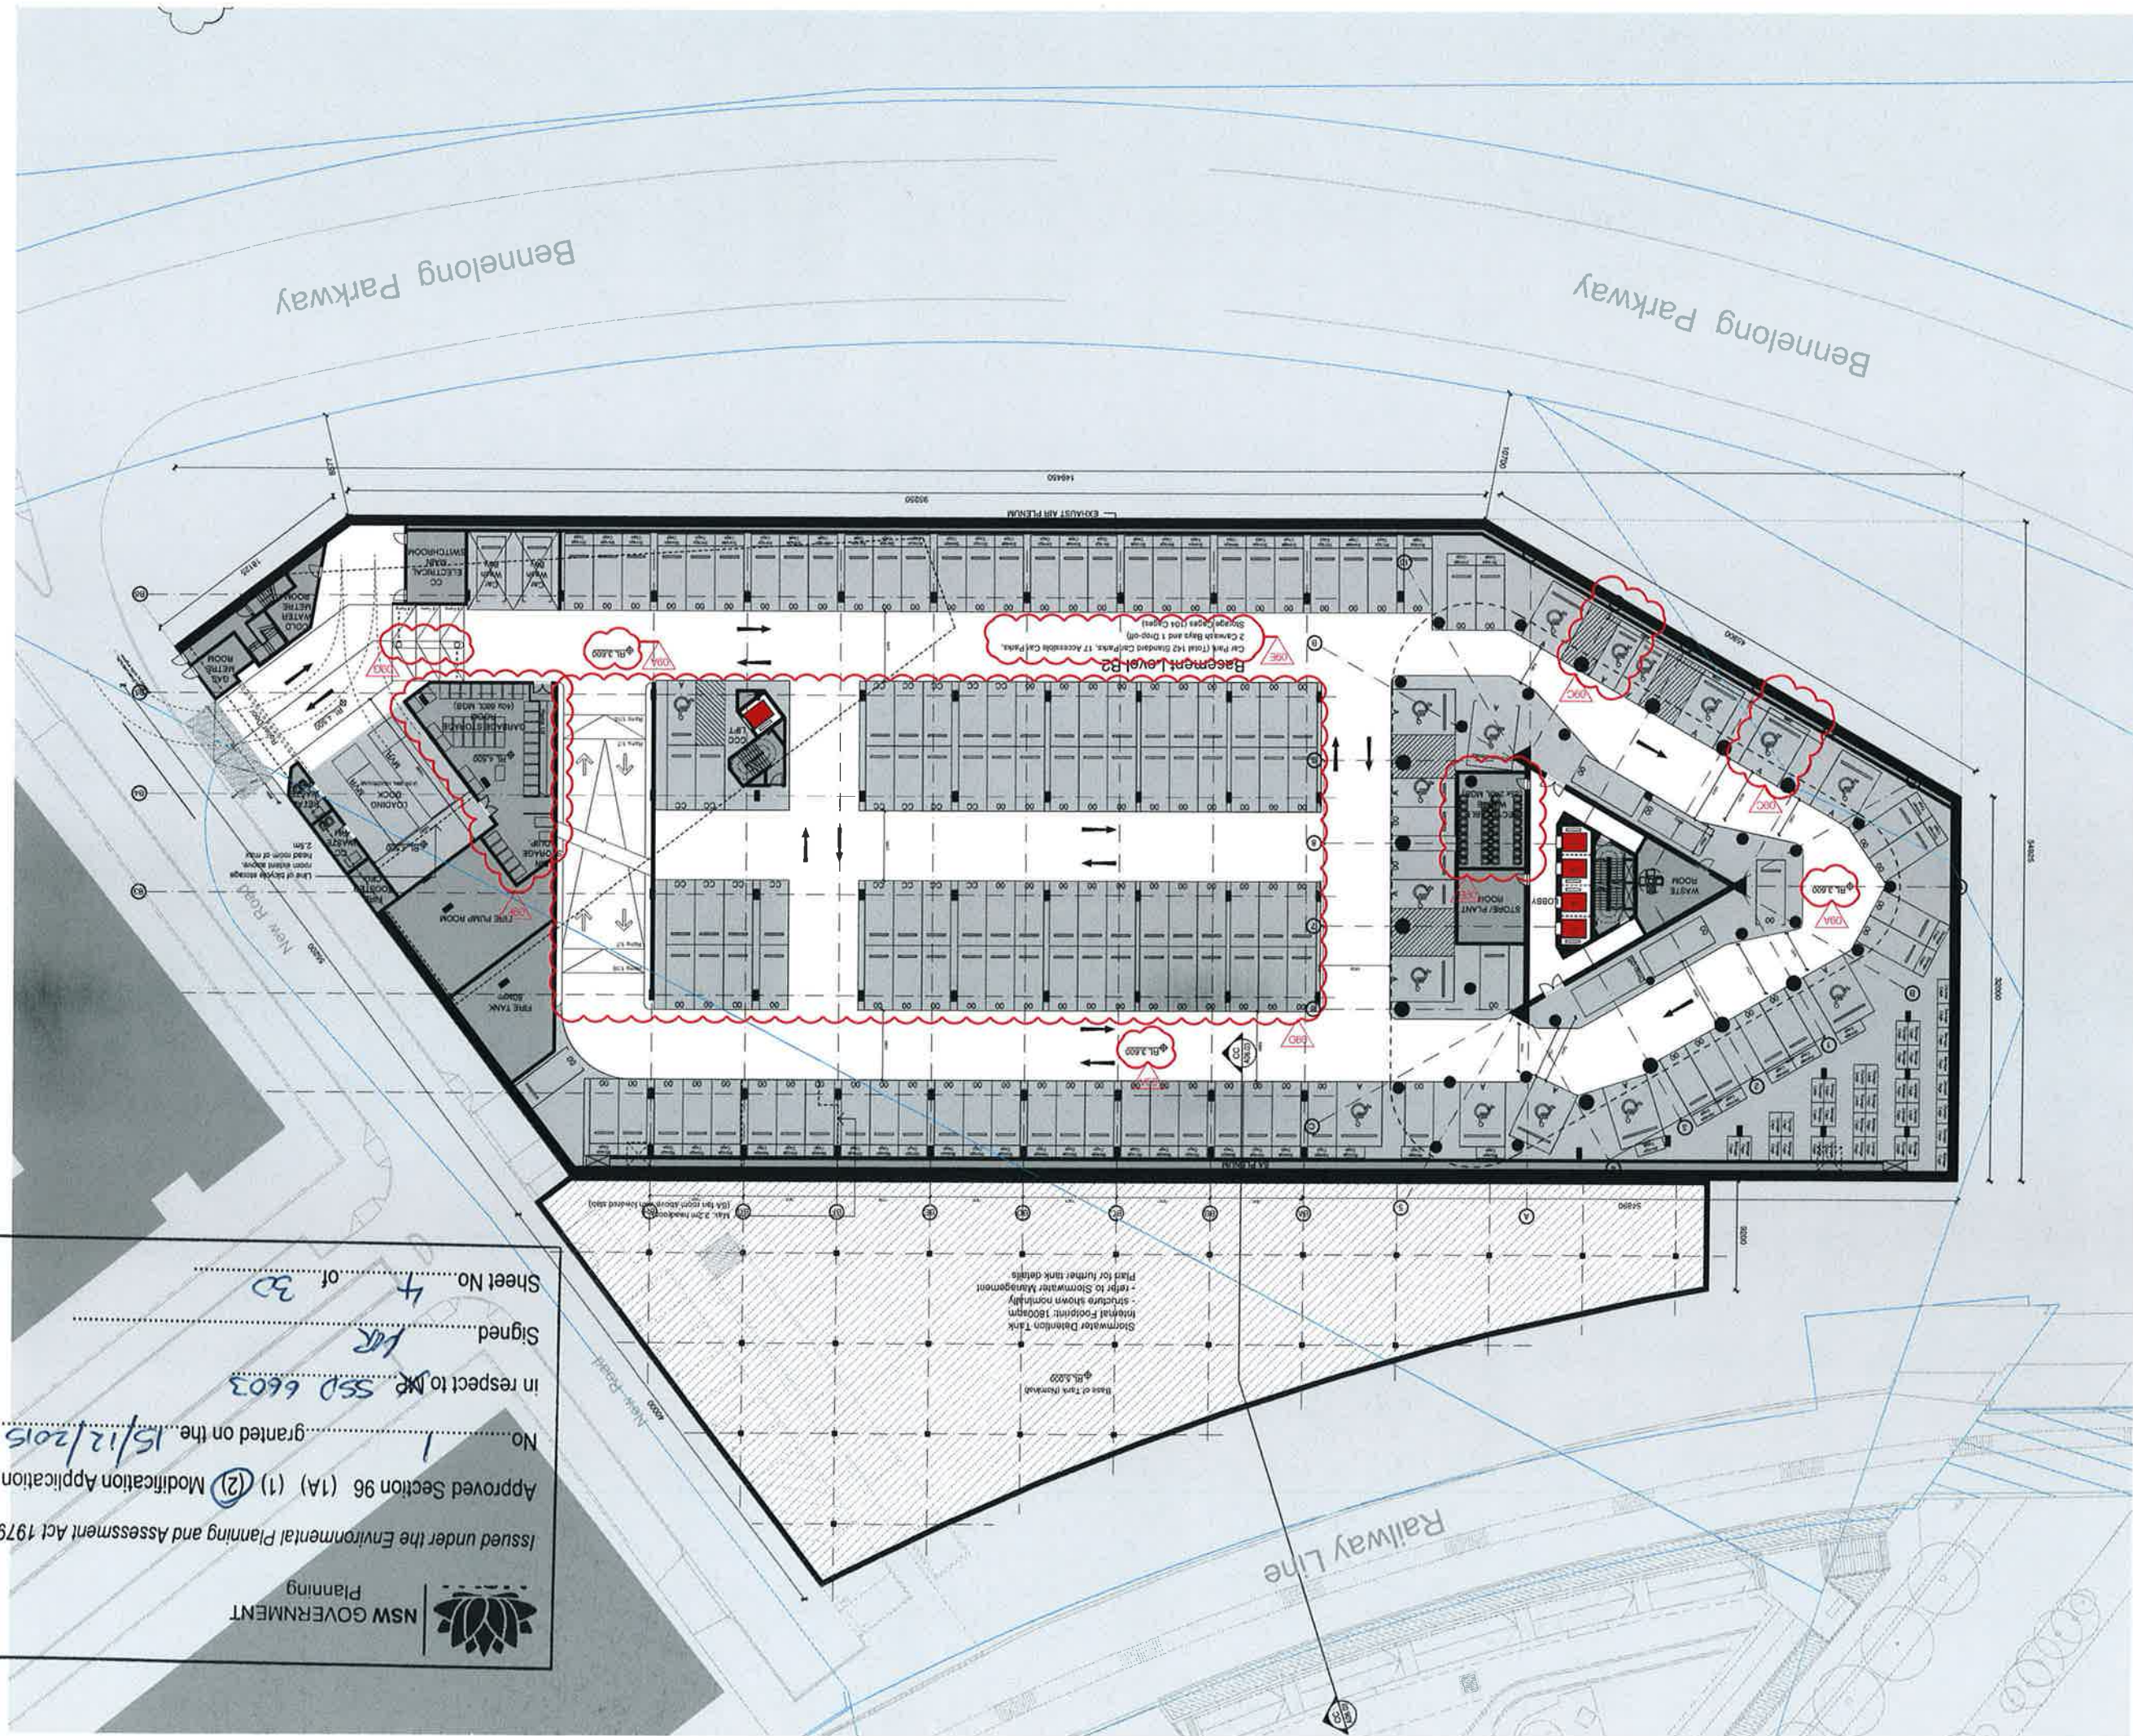

Check all dimensions and site conditions prior to commencement of any work. The purchaser is responsible for obtaining all necessary permits and approvals. Any discrepancies between the drawings and the actual site conditions shall be the responsibility of the client. All drawings are to be read in conjunction with all relevant documents and all other information provided by the client. Do not scale drawings - refer to figure dimensions only. Any discrepancies shall immediately be referred to the architect for clarification. All drawings may not be reproduced or distributed without prior permission from the architect.



NSW GOVERNMENT
Planning

Issued under the Environmental Planning and Assessment Act 1979

Approved Section 96 (1A) (1) (2) Modification Application

No. 1 granted on the 15/12/2015

In respect to MP SSD 6603

Signed *MR*

Sheet No. 5 of 30

Revision Summary:

A - Refer to local height limits 32 & 33 which are from 2.0m to 2.5m.

B - Ben notes re-align from 33 to 34 have also in previous set out.

C - Circular road constructed to accurate space.

D - Car space drive access moved by 200mm to allow for 150mm.

E - Car parking court increased from 184 to 153 spaces.

F - Additional basement storage.

NOT FOR CONSTRUCTION

Revision	Date	Description	Checked
01	25.06.14	For Information	JC
02	02.07.14	For Information	JC
03	26.08.14	For Information	JC
04	20.09.14	For Information	JC
05	03.09.14	For Information	JC
06	19.09.14	Development Application	ML
07	22.01.15	Development Application	ML
08	25.06.15	s96 Application	ML

Site 68
Sydney Olympic Park
Basement Level B3

Scale
1:250 @ A1 1:500 @ A3

Drawn
Checked

Project No.
S11611

Status
s96 Application

Plot Date
23/6/2015 5:14 PM


Plot File
S:\11600-11609\11611\score_sop\sheet\B3\B3.DWG

Drawing No.
A02.B3[08]

Melbourne 1 Nicholson Street
Melbourne VIC 3000 Australia
T 03 8664 6200 F 03 8664 6300
http://www.batesmart.com.au
email: info@batesmart.com.au
Sydney 43 Brisbane Street
Sydney NSW 2010 Australia
T 02 8364 5100 F 02 8364 5199
http://www.batesmart.com.au

Bates Smart Architects Pty Ltd ABN 68 094 740 086

BATESSMART

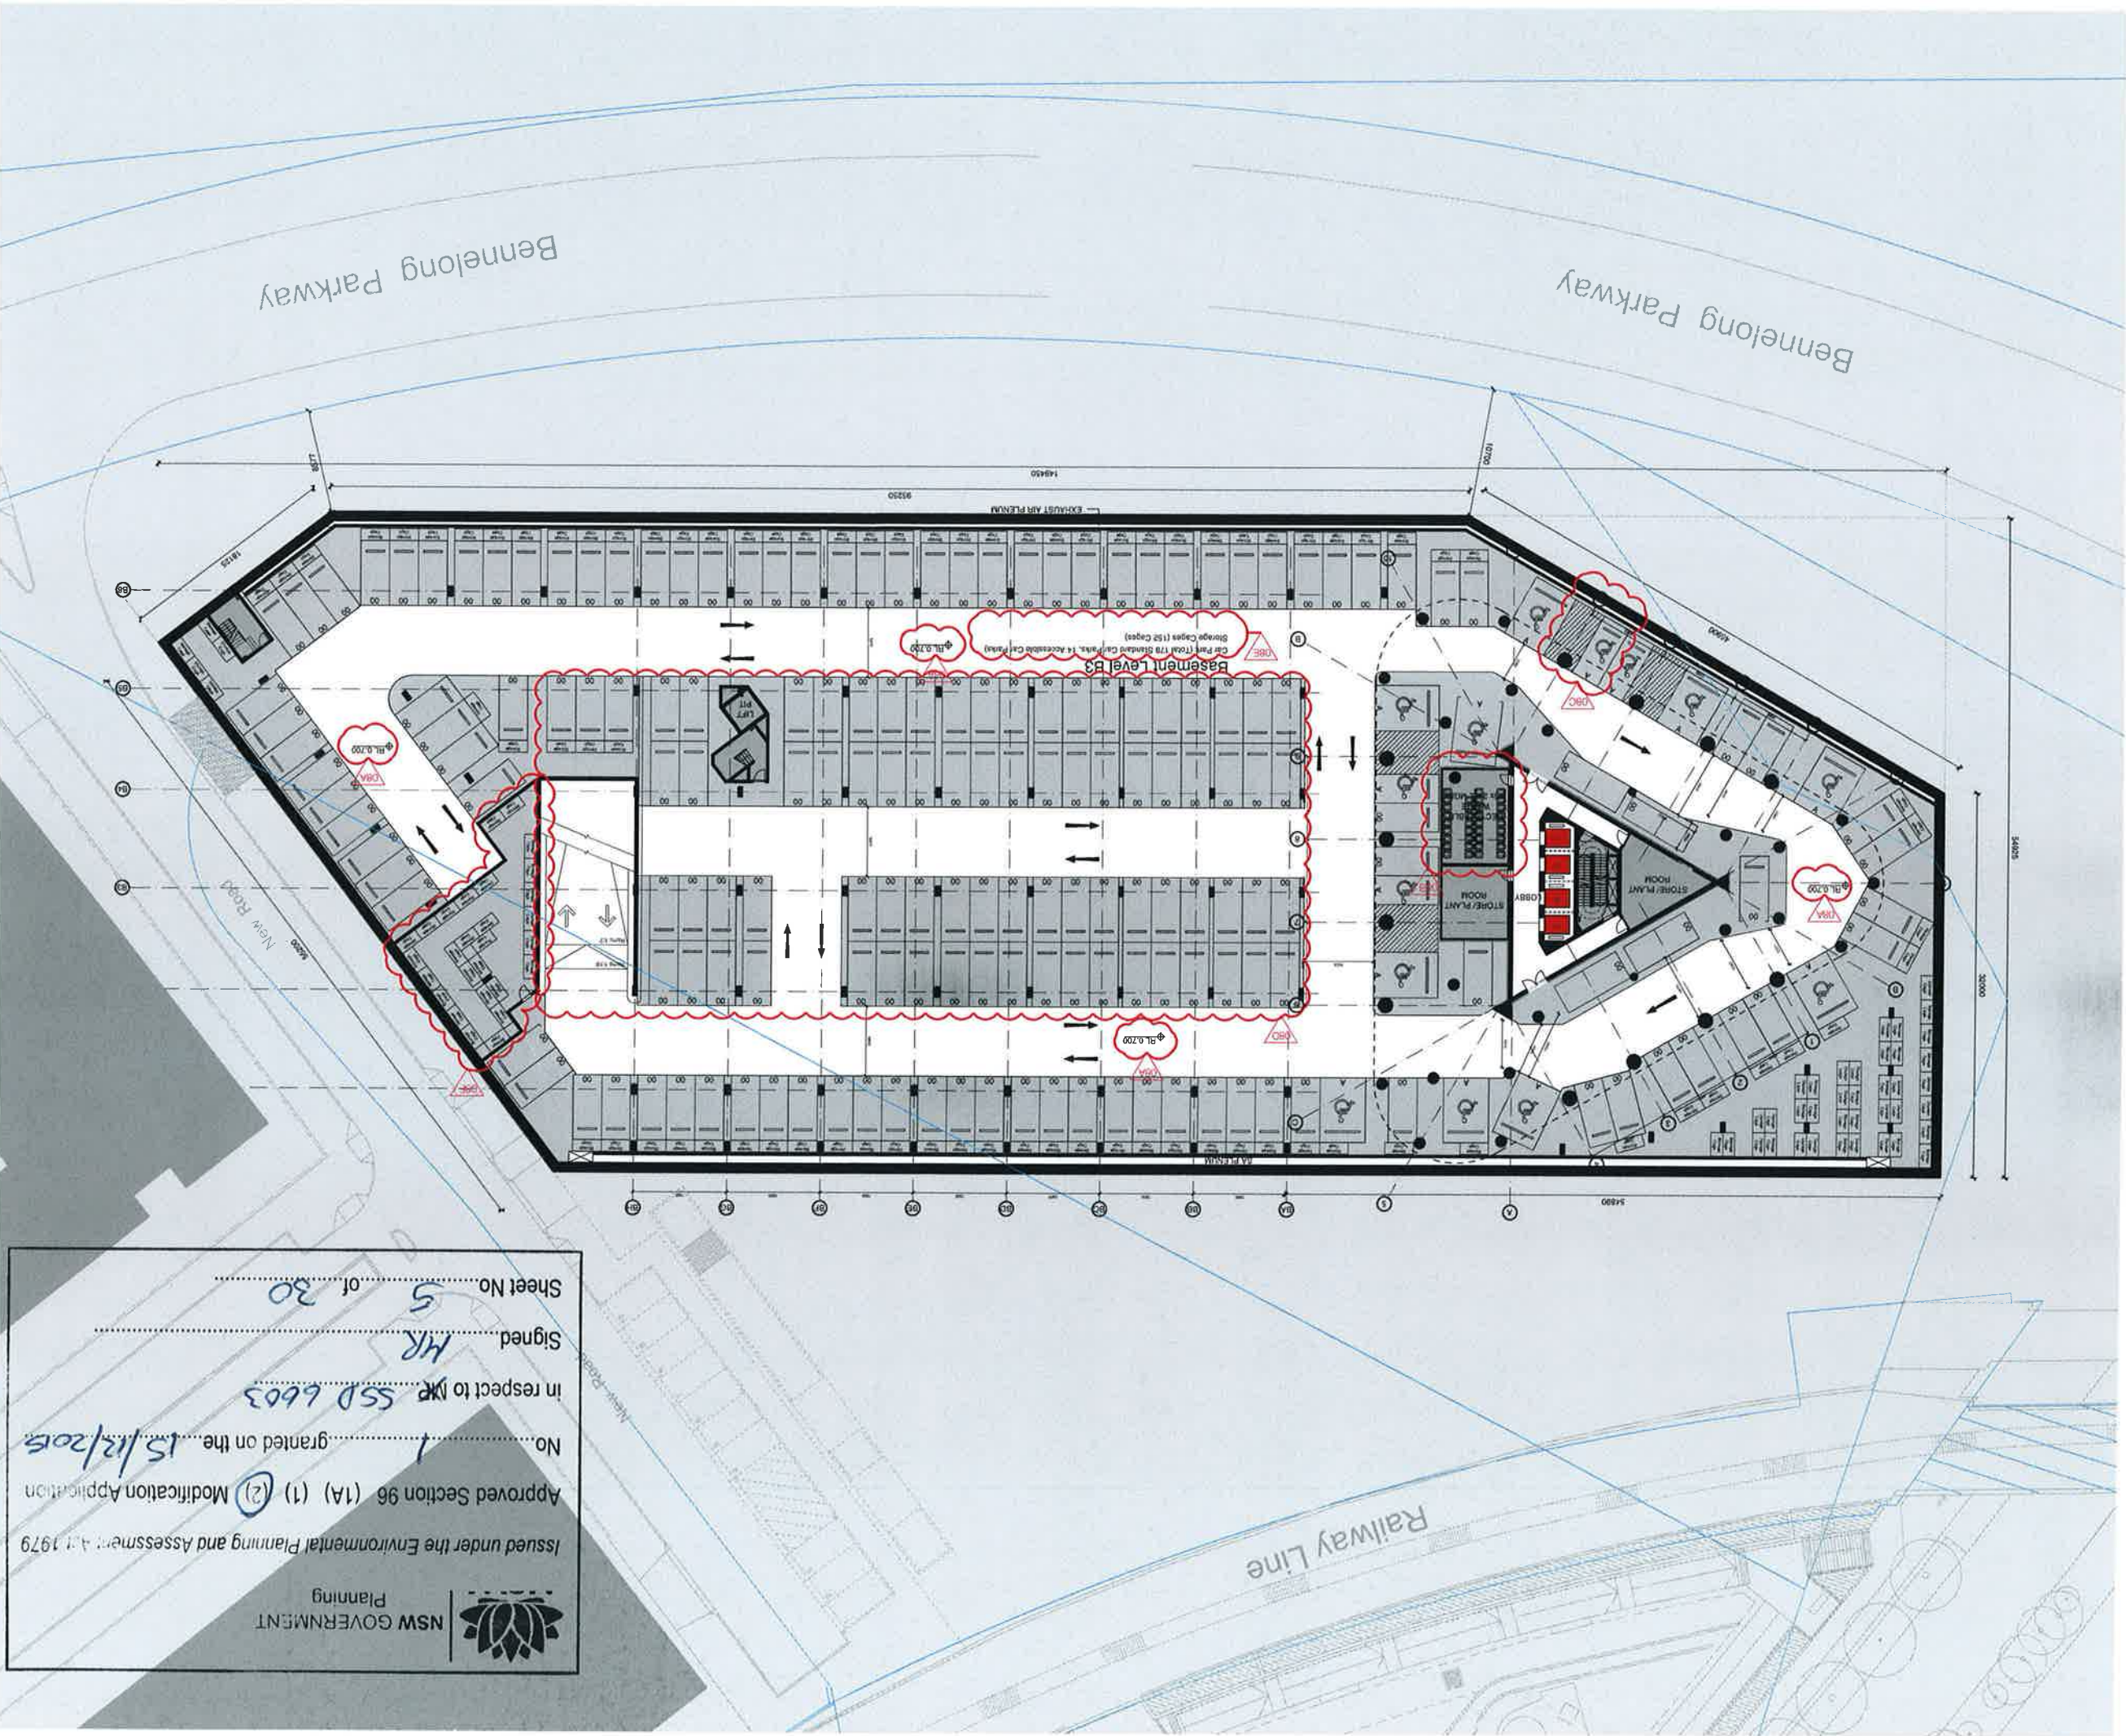



NSW GOVERNMENT
Planning

Issued under the Environmental Planning and Assessment Act 1979

Approved Section 96 (1A) (1) (2) Modification Application

No. 1 granted on the 15/12/2015

in respect to S5D 6603

Signed MR

Sheet No. 6 of 30



Check all dimensions and site conditions prior to commencement of any work, the purchaser or owner of any materials, fittings, plant, services or equipment and the preparation of shop drawings and the fabrication of any components.

All drawings to be read in conjunction with all architectural documents and all other consultants' documents.

Do not scale drawings - refer to figured dimensions only. Any discrepancies shall immediately be referred to the architect for clarification.

All drawings may not be reproduced or distributed without prior permission from the architect.

Revision	Description	By	Date
04	25.05.15 S96 Application	JC	MLS
03	22.01.15 Development Application	KM	MLS
02	18.08.14 Development Application	KM	MLS
01	29.08.14 For Information	JC	MLS

Revision Summary:
Revision 04 - Section 96 Amendments
A = Formerly levels 17-24

NOT FOR CONSTRUCTION

Revision	Date	Description	Initial	Checked
04	25.05.15	S96 Application	JC	MLS
03	22.01.15	Development Application	KM	MLS
02	18.08.14	Development Application	KM	MLS
01	29.08.14	For Information	JC	MLS

Site 68
Sydney Olympic Park

General Arrangement Plan
Levels 17-25

Scale: 1:100 @ A1, 1:200 @ A3

Drawn: Checked

Project No: S11611

Status: s96 Application

Plot Date: 23/6/2015 5:15 PM

Plot File: S:\11600-11699\11611_s96_application\A02_17[04].dwg

Drawing No: [Revision]

A02.17[04]

Melbourne 1 Nicholson Street
Melbourne VIC 3000 Australia
T 03 8664 6200 F 03 8664 6300
email melb@batesmart.com.au
http://www.batesmart.com.au

Sydney 43 Brisbane Street
Surry Hills NSW 2010 Australia
T 02 8354 5100 F 02 8354 5199
email syd@batesmart.com.au
http://www.batesmart.com.au

Bates Smart Architects Pty Ltd ABN 68 004 740 986

Legend:
K: Kitchen
D: Dining
L: Living
B: Bedroom
S: Storage
M: Multimedia
St: Study/Store
En: Ensuite
Bal: Balcony
W: Wintergarden

BATESSMART



Sheet No. 7 of 30

[illegible]

A. Now Drawing: Same layout as annexed Levels 25-26.

NOT FOR CONSTRUCTION

01	25.06.15	536 Application	JC	MLS
Revision	Date	Description	Initial	Checked

01A General Arrangement Plan
Levels 26-27

Scale 1:100 @ A1, 1:200 @A3

Drawn	Checked
-------	---------

Project No. S11611

Status	n06 Application
--------	-----------------

S96 Application

23/6/2015 5:15 PM

Plot File S:\11600-11699\11611_ecore_sops\1168100_11

Drawing No. _____ (Revision)

ADD-ON-11

A02.26[01]

2011

Melbourne 1 Nicholson Street
Melbourne VIC 3000 Australia

T 03 8664 6200 F 03 8664 6300
small.malk@holcommod.com.au

http://www.balessmart.com.au

Bates Smart Architects Pty Ltd ABN 68 094 740 986

DATE: 01/11/2018

BALES

DATA LOG 739942

Legend:
K: Kitchen
D: Dining
L: Living
B: Bedroom
S: Storage
M: Multimedia
St: Study/Store
Ens: Ensuite

Balc: Balcony
W: Wintergarden

BATES SMART



Sheet No. 8 of 30



All drawings may not be reproduced or distributed without prior permission from the architect.

[illegible]

A New Drawing: Same layouts as approved Levels 27-33

NOT FOR CONSTRUCTION

01	28.05.15	500 Application	JC	MLS
Revision	Date	Description	Initial	Checked

Bates Smart Architects Pty Ltd ABN 68 094 740 986

BATESSMART™



Sheet No. 9 of 30



All drawings may not be reproduced or distributed without prior permission from the architect.

[illegible]

A - New Drawing, New residential floorplate

NOT FOR CONSTRUCTION

01	23.05.15	500 Application	JC	MLS
Revision	Date	Description	Initial	Check



Drawing No. _____ [Revision _____]

Bates Smart Architects Pty Ltd ABN 68 094 740 986


Legend:
K: Kitchen
D: Dining
L: Living
B: Bedroom
S: Storage
M: Multimedia
St.: Study/Store
Ens.: Ensuite

Bal.: Balcony
Wf.: Wfnergarden

BATES SMART



Sheet No. 10 of 30

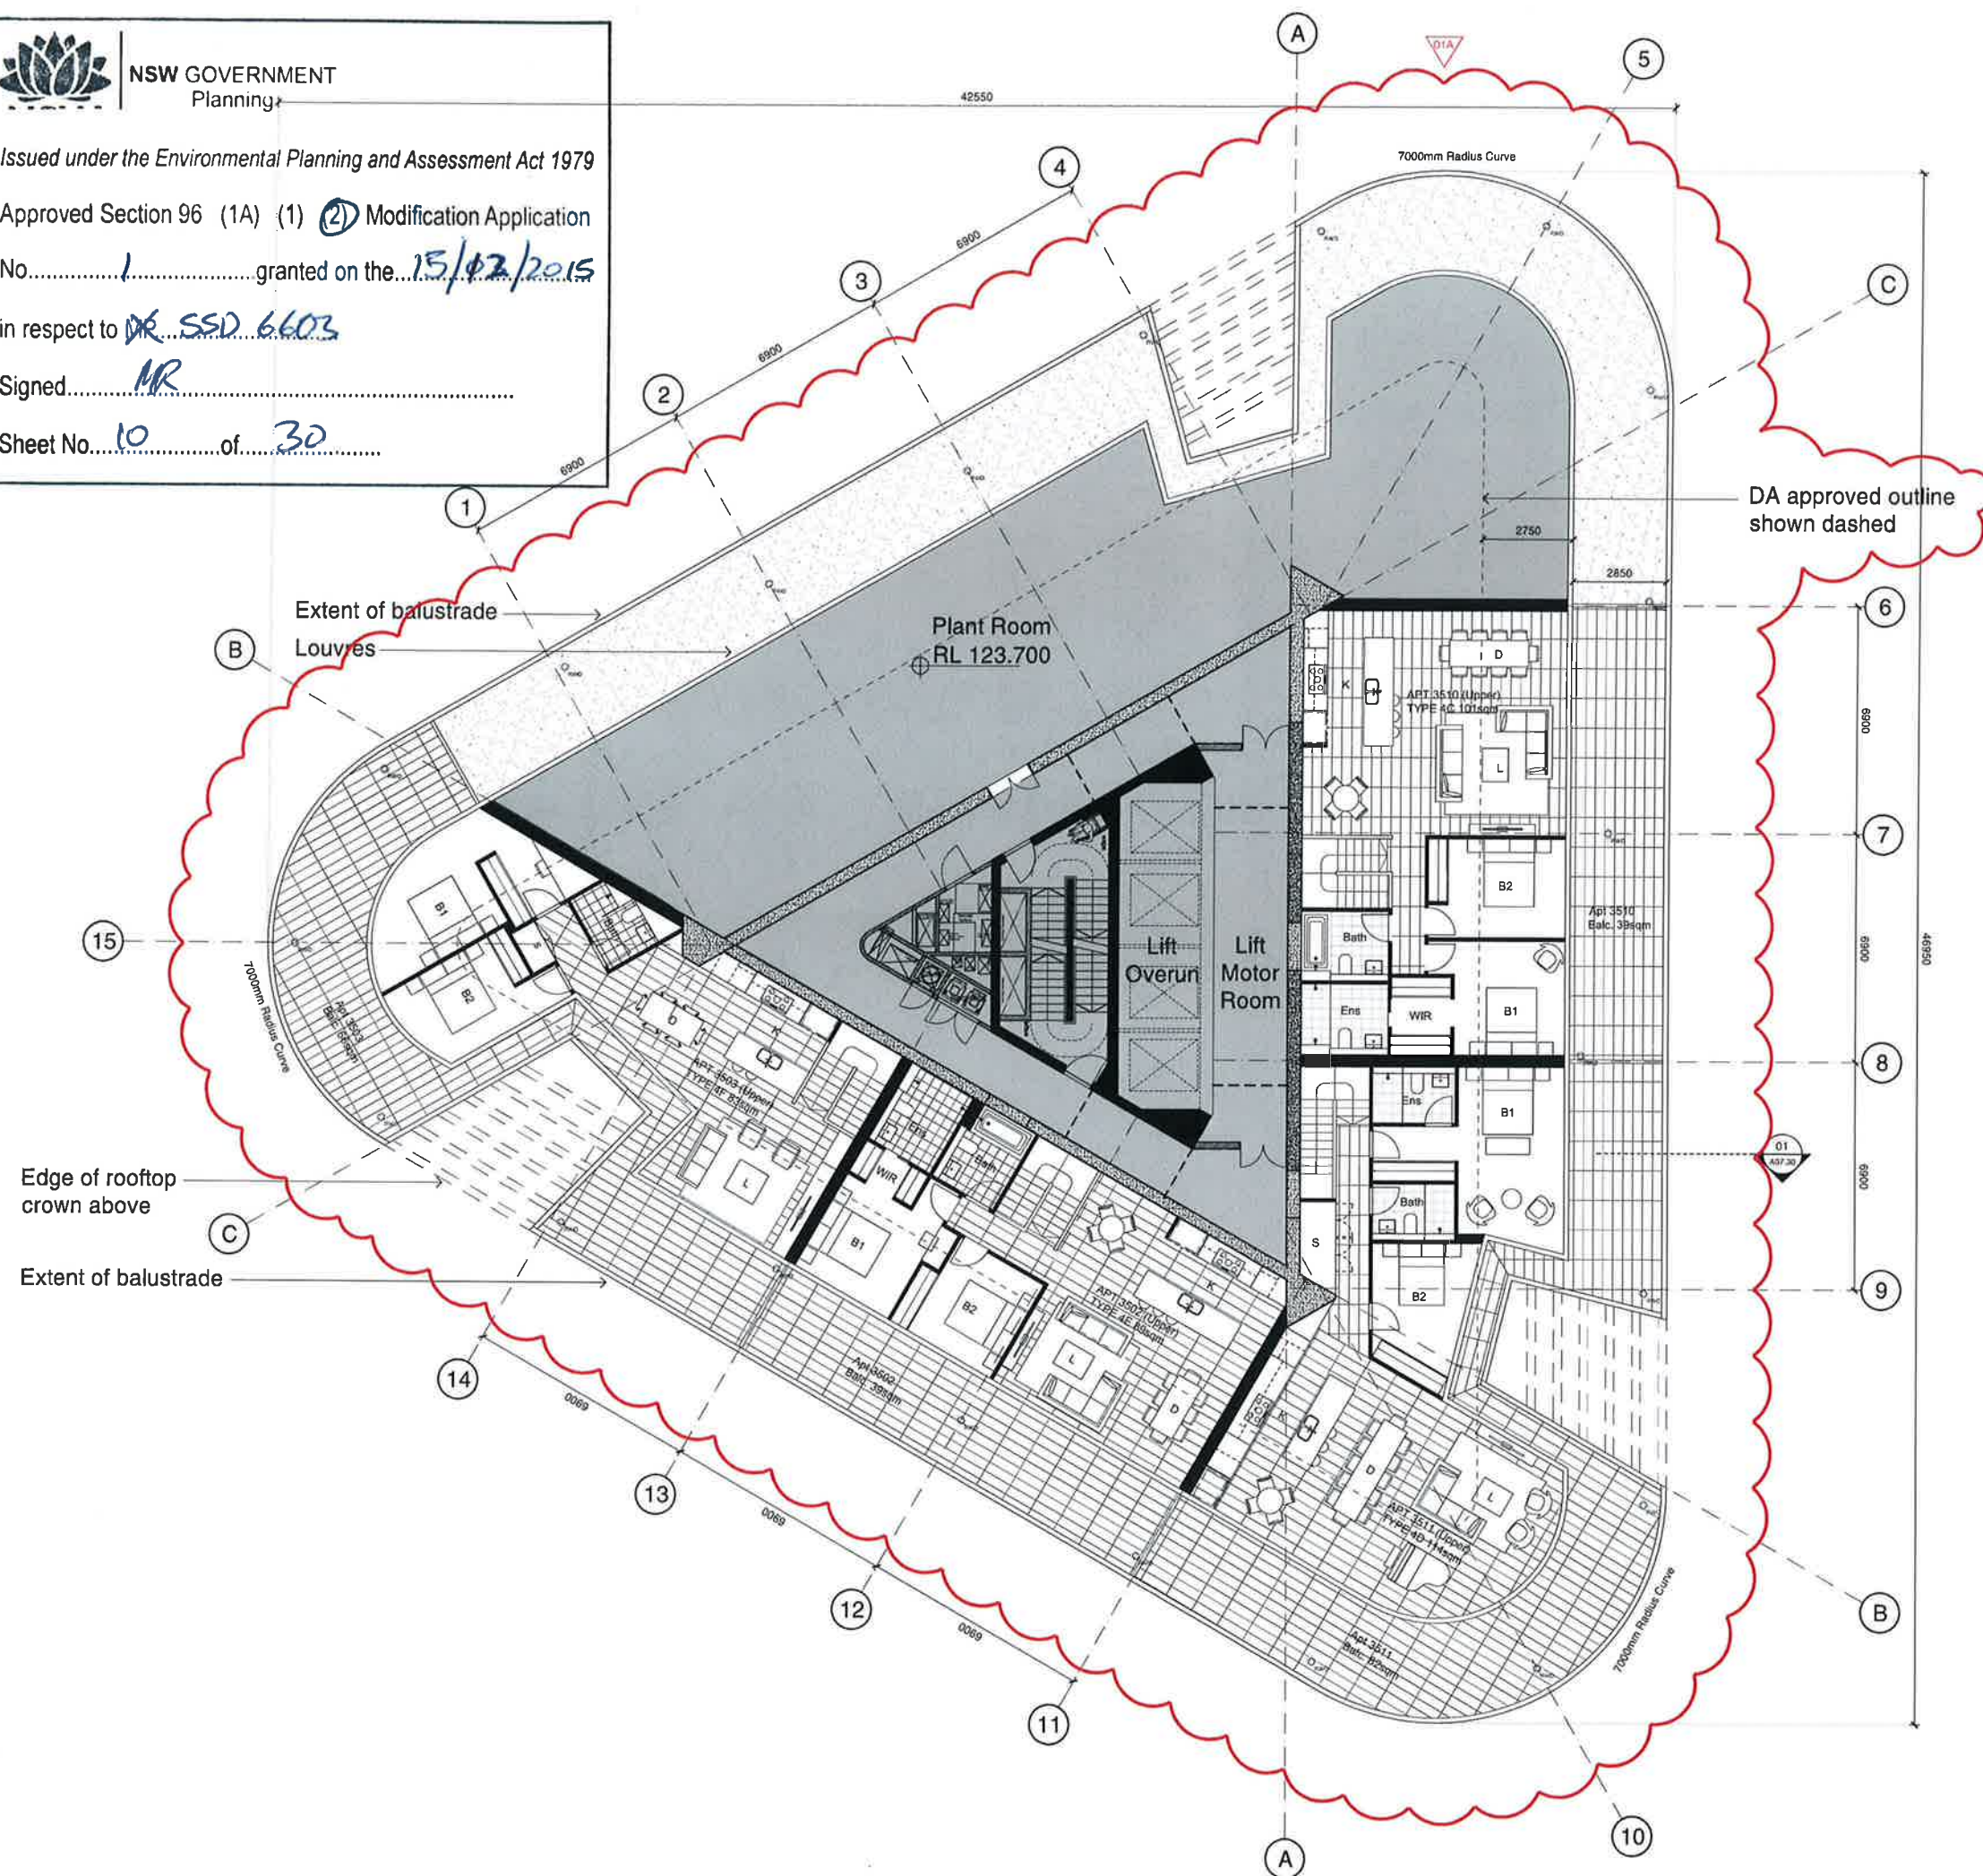[illegible]

Revision Summary:
Revision 01 - Section 96 Amendments

A - New drawing. Reduced plant extents, residential uses proposed to north & east frontages. Set back 2850mm from 'acade.

NOT FOR CONSTRUCTION

01	25.05.15	S96 Application	JC	MLS
Revision	Date	Description	Initial	Check

Site 68
Sydney Olympic Park

General Arrangement Plan
Level 36



Scale 1:100 @ A1, 1:200 @A3

Drawn	Checked
-------	---------

Project No. S11611

Status	s96 Application
--------	-----------------

Plot Date 23/6/2015 5:16 PM

Plot File S:\11600-11609\11611_across_acornfile600_main\acornfile600.DA

Drawing No. [Revision]

A02.36[01]

Melbourne 1 Nicholson Street
Melbourne VIC 3000 Australia
T 03 8664 6200 F 03 8664 6300
email melb@batesmart.com.au
<http://www.batesmart.com.au>

Sydney 43 Brisbane Street
Surry Hills NSW 2010 Australia
T 02 8354 5100 F 02 8354 5199
email syd@batesmart.com.au
<http://www.batesmart.com.au>

Bates Smart Architects Pty Ltd ABN 68 094 740 986

BATESSMART™