

# Modification of Development Consent

Section 96(1A) of the Environmental Planning and Assessment Act 1979

As delegate of the Minister for Planning under delegation dated 16 February 2015, I approve the modification application referred to in Schedule 1, subject to the conditions in Schedule 2.

Anthony Witherdin  
Acting Director  
Regional Assessments

Sydney 13 August 2015

## SCHEDULE 1

**Development Approval:** **SSD-6620** granted by the Minister for Planning on 26 November 2014

**For the following:** Construction and operation of a warehouse and distribution facility with ancillary office and showroom/factory outlet. The purpose-built facility would be used to store and distribute Lindt's range of packaged chocolates; for some chocolate making; and the baking of foods for Lindt's range of cafes and third party stores.

**Applicant:** Qanstruct (Aust.) Pty Ltd

**Consent Authority:** Minister for Planning

**The Land:** Lot 125 DP 1198296

**Modification:** **SSD 6620 MOD 2:** the modification includes:

- the addition of a two level internal office to service the packing area; and
- an increase to the size of the awning over the outdoor staff area to the western side of the building.

---

## SCHEDULE 2

The above approval is modified as follows:

- (a) Condition B2 is amended by the deletion of the ~~struck-out words~~ and the insertion of the **bold and underlined** words as follows:

### TERMS OF CONSENT


B2. The Applicant shall carry out the Development generally in accordance with the:


- (a) State Significant Development Application SSD 6620;
  - (b) Environmental Impact Statement prepared by PJEP Environmental Planning dated 20 August 2014;
  - (c) Response to Submissions Letter Report prepared by PJEP Environmental Planning dated 17 October 2014;
  - (d) Modification Application SSD 6620 MOD 1, Statement of Environmental Effects dated 7 May 2015 prepared by PJEP Environmental Planning Pty Ltd;
  - (e) **Modification Application SSD 6620 MOD 2, Statement of Environmental Effects dated 5 August 2015** and
  - (e) (f) The conditions of this consent.
- (b) Condition B7 is amended by the deletion of the ~~struck-out words~~ and the insertion of the **bold and underlined** words as follows:

### LIMITS OF CONSENT

B7. The Applicant must ensure that the total building area does not exceed:

- (a) 25,395m<sup>2</sup> **25,365m<sup>2</sup>** of warehouse manufacturing area; and
  - (b) 3,765m<sup>2</sup> **3,835m<sup>2</sup>** of ancillary office and showroom/factory outlet area.
- (c) Appendix 1 – Plan and Elevations are amended to include the following plans:

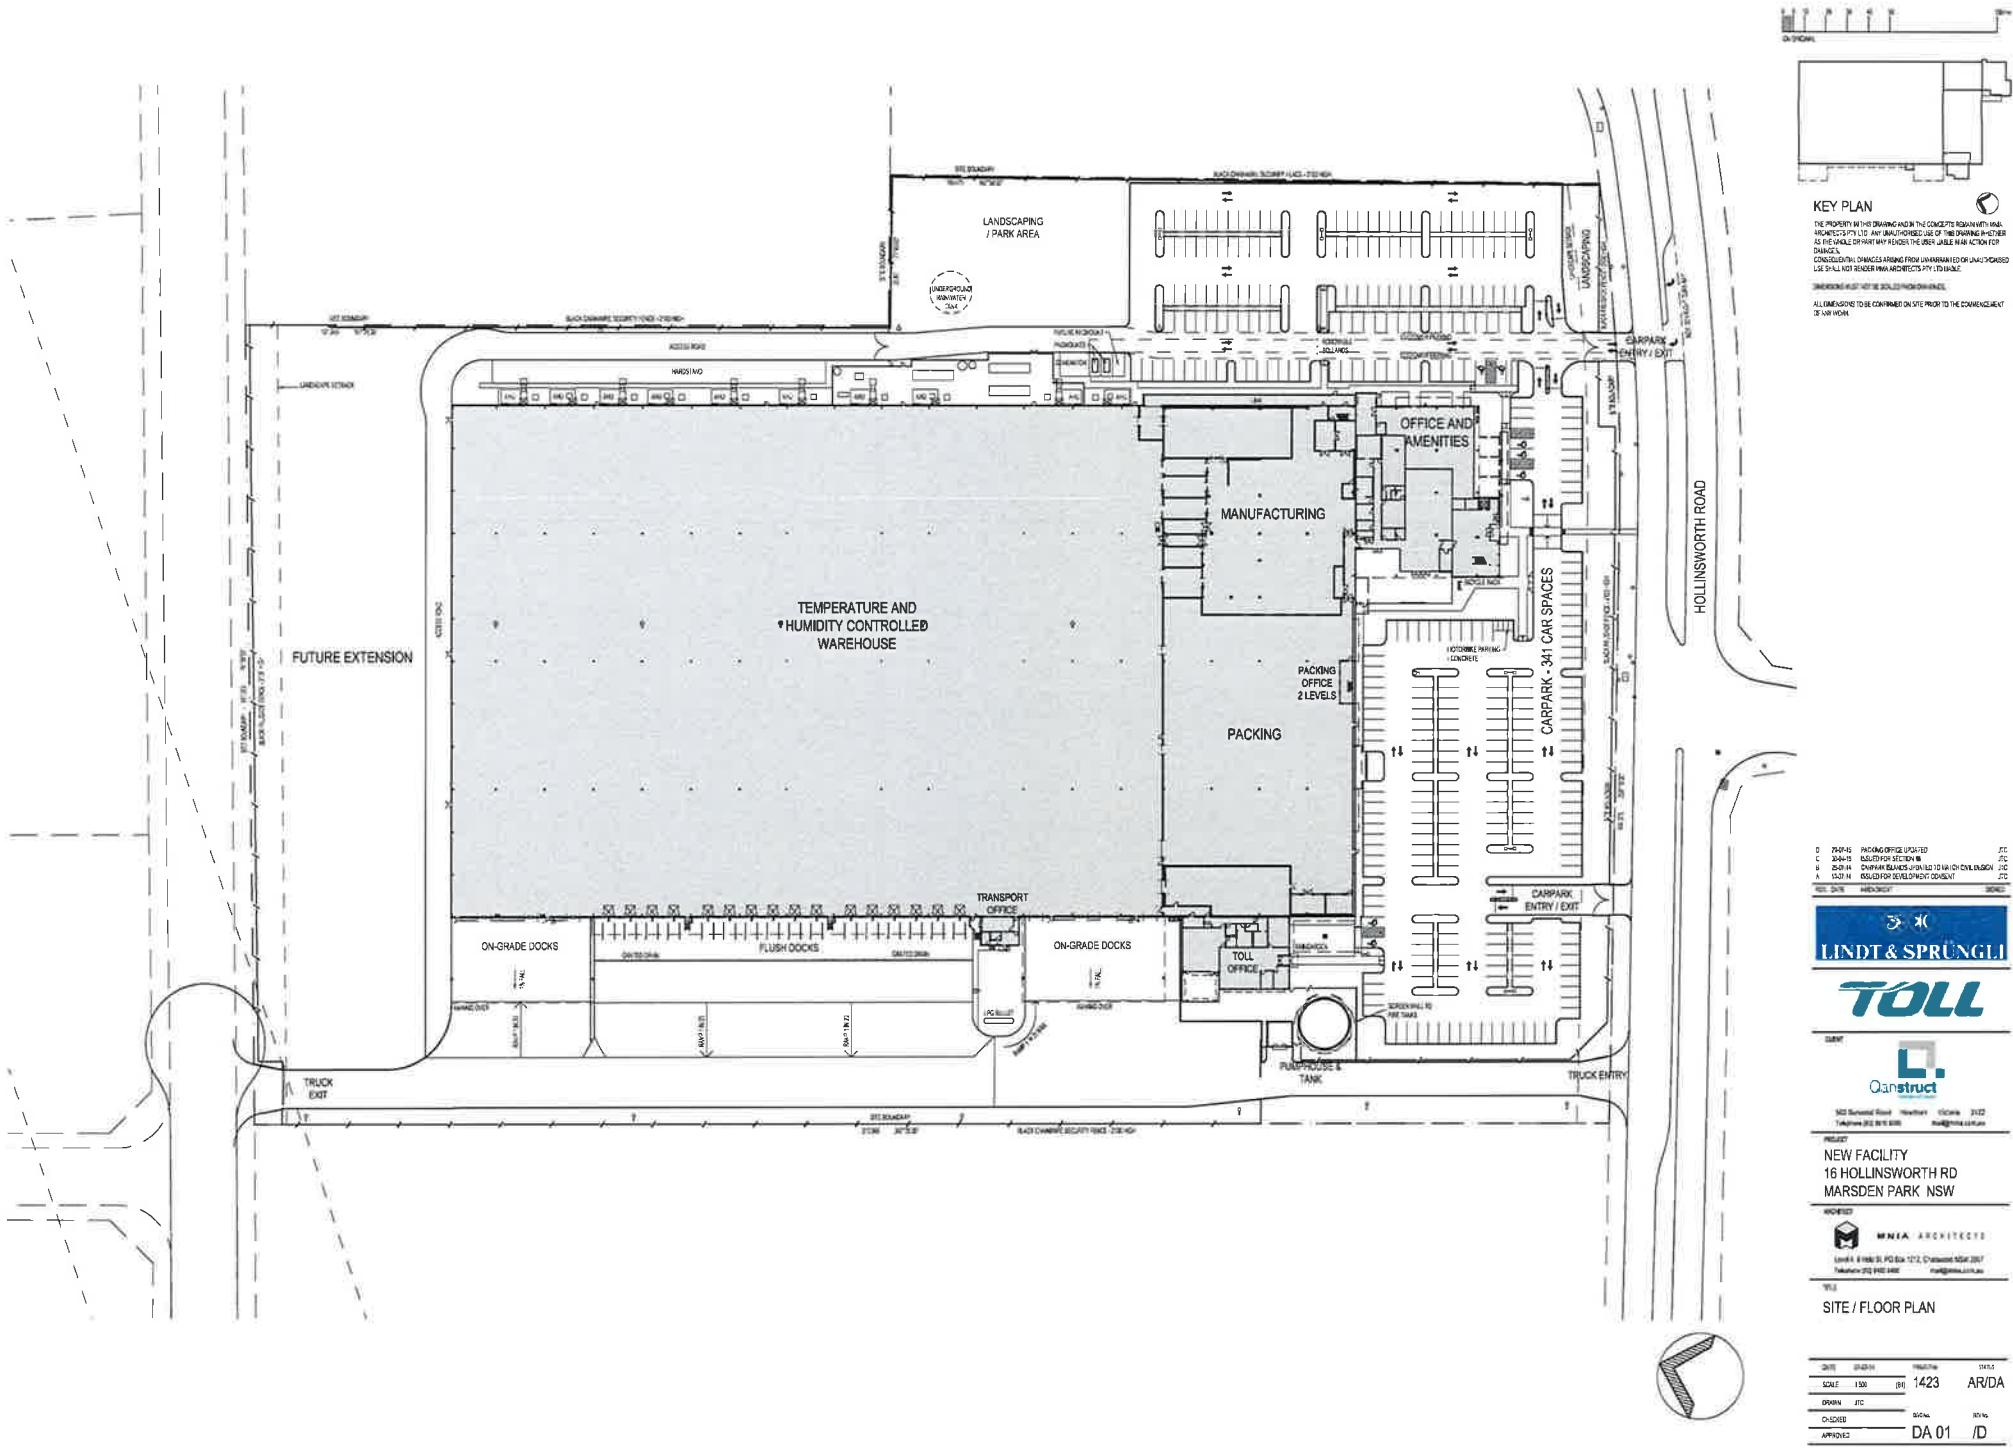

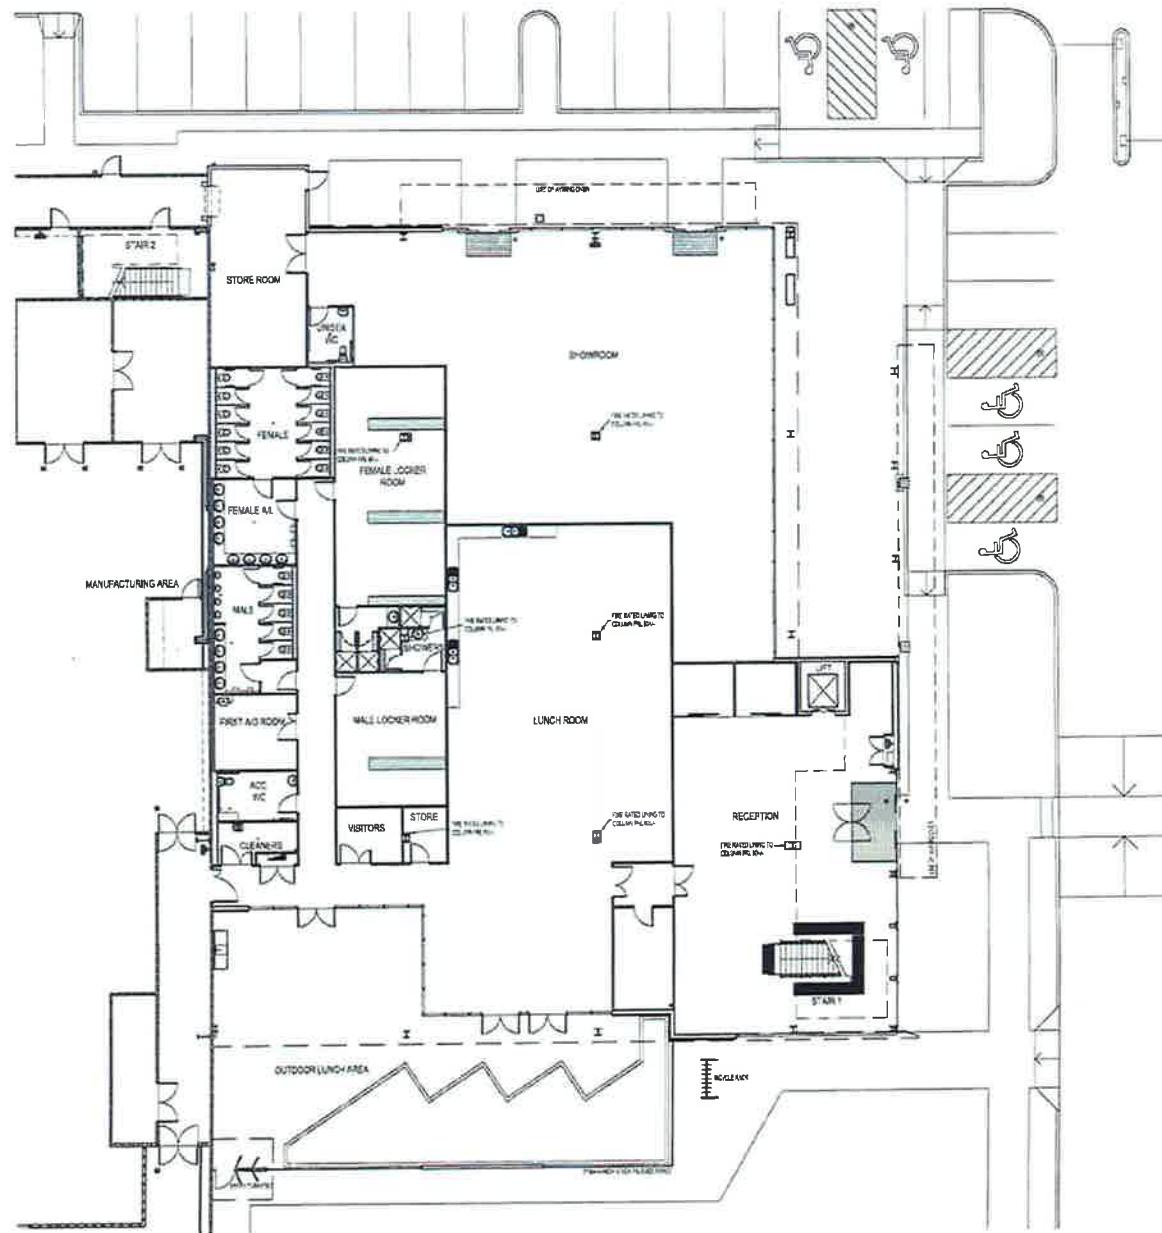

1. DA/02 GROUND FLOOR PLAN  
2. DA/02 ACCESSORY

LINDT & SPRÜNGLI  
**TOLL**



QANSTRUCT  
102 Burwood Rd, Burwood, Victoria 3128  
Telephone (03) 9416 1111 fax (03) 9416 1111

NEW FACILITY  
16 HOLLINSWORTH RD  
MARDEN PARK NSW


**MNIA ARCHITECTS**  
John McNeil & Associates Pty Ltd  
100 Pitt Street, Sydney NSW 2000  
Telephone (02) 251 1211 fax (02) 251 1211

OFFICE AND AMENITIES  
GROUND FLOOR PLAN

DA/02 1423 AR/DA



NAME JC

DA/02 DA 02 /B

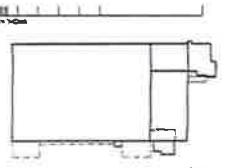

**KEY PLAN**  
THIS PLAN IS TO BE USED AS A GUIDE FOR INTERNAL  
REFURBISHMENT AND NOT FOR EXTERIOR USE.  
DO NOT USE THIS PLAN FOR EXTERIOR CONSTRUCTION  
PURPOSES.  
EXTERIOR CHANGES AND UPDATES MUST BE APPROVED  
BY THE LOCAL PLANNING AUTHORITY.  
DRAWN BY: [Signature]

ALL DIMENSIONS ARE IN MILLIMETRES  
OF THE FLOOR.

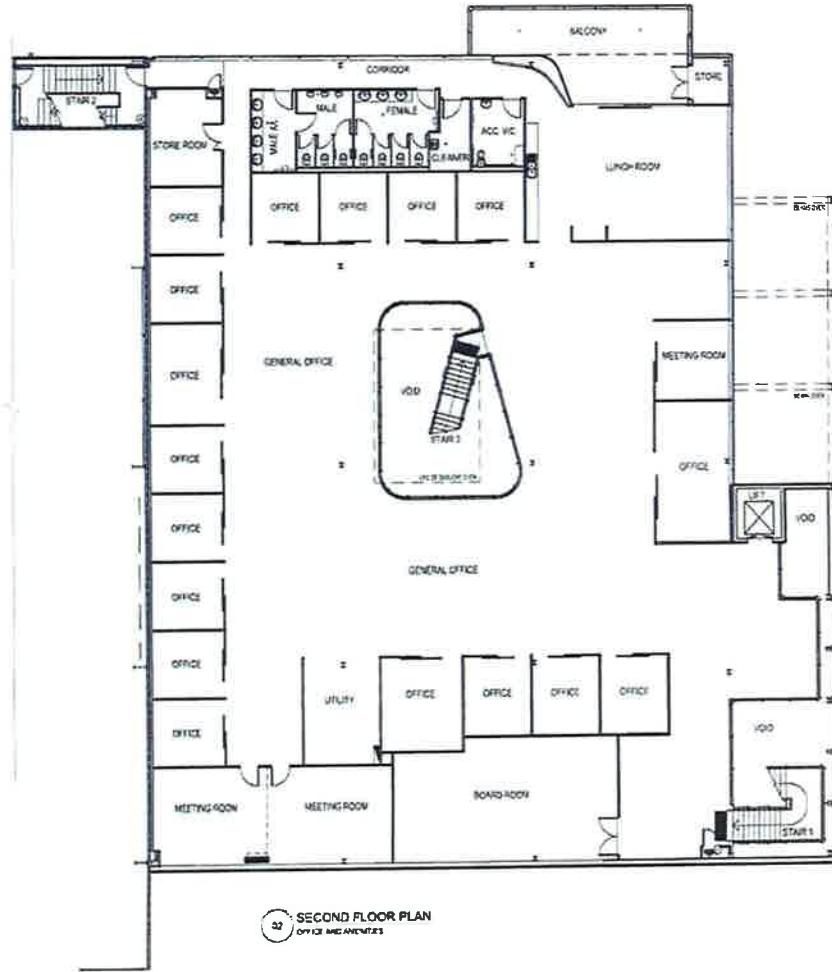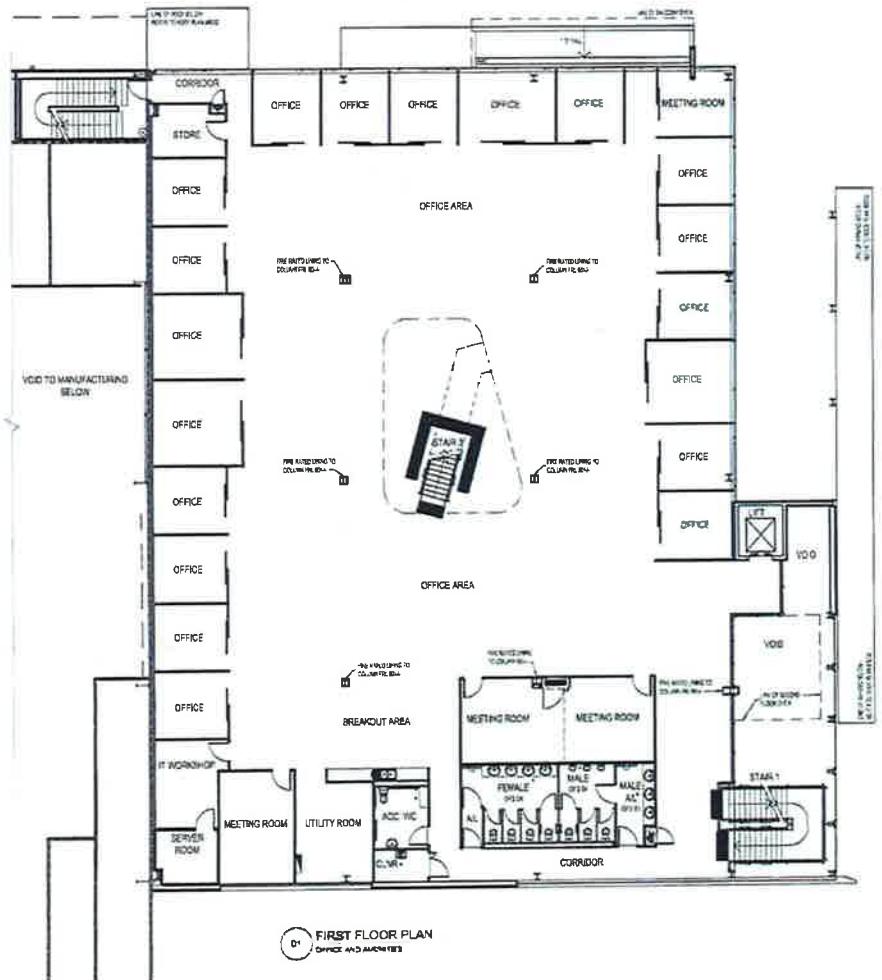

LINDT & SPRUNGLI  
TOLL

Qanstruct  
Unit 5/1000 Pitt St, Sydney NSW 2000  
Phone: (02) 8520 2800 Fax: (02) 8520 2801

**NOTE:**  
NEW FACILITY  
16 HOLLINSWORTH RD  
MARDEN PARK NSW


UNIT 5/1000 Pitt St, Sydney NSW 2000  
Phone: (02) 8520 2800 Fax: (02) 8520 2801

**OFFICE AND AMENITIES**  
FIRST AND SECOND  
FLOOR PLANS


DATE	10/03/03	VERSION	V2.0
SPUD	1423	AR/DA	
DESIGN		TYPE	
CONTRACT		STATUS	
APPROVAL	DA 03	PERIOD	/B

REF ID: DA 04 /B  
REF ID: DA 04  
REF ID: DA 04  
REF ID: DA 04  
REF ID: DA 04


ELEVATIONS AND SECTION

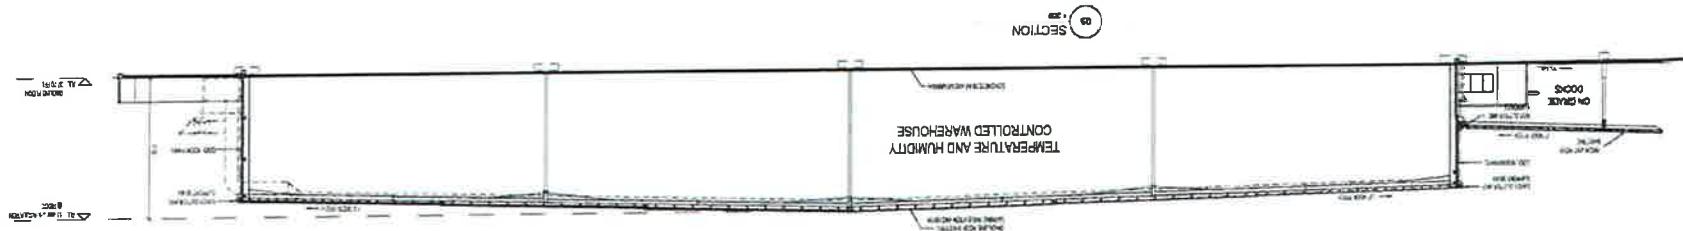

WEST ELEVATION

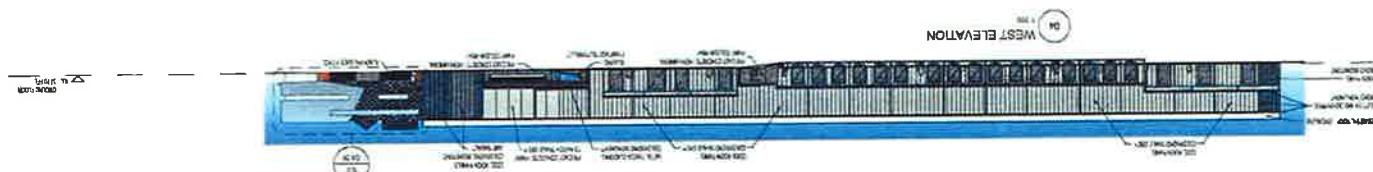

SOUTH ELEVATION

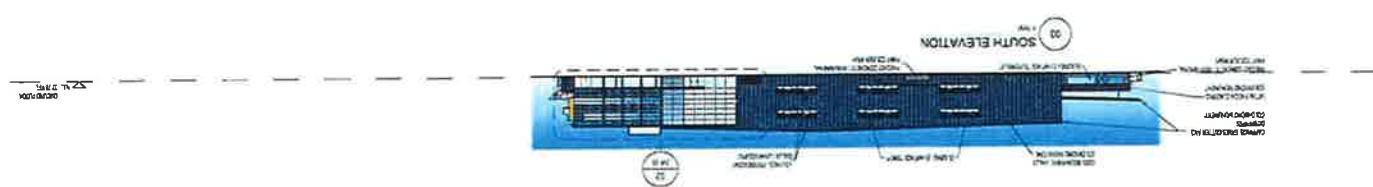

EAST ELEVATION



NORTH ELEVATION



