


STREET
ABERCROMBIE

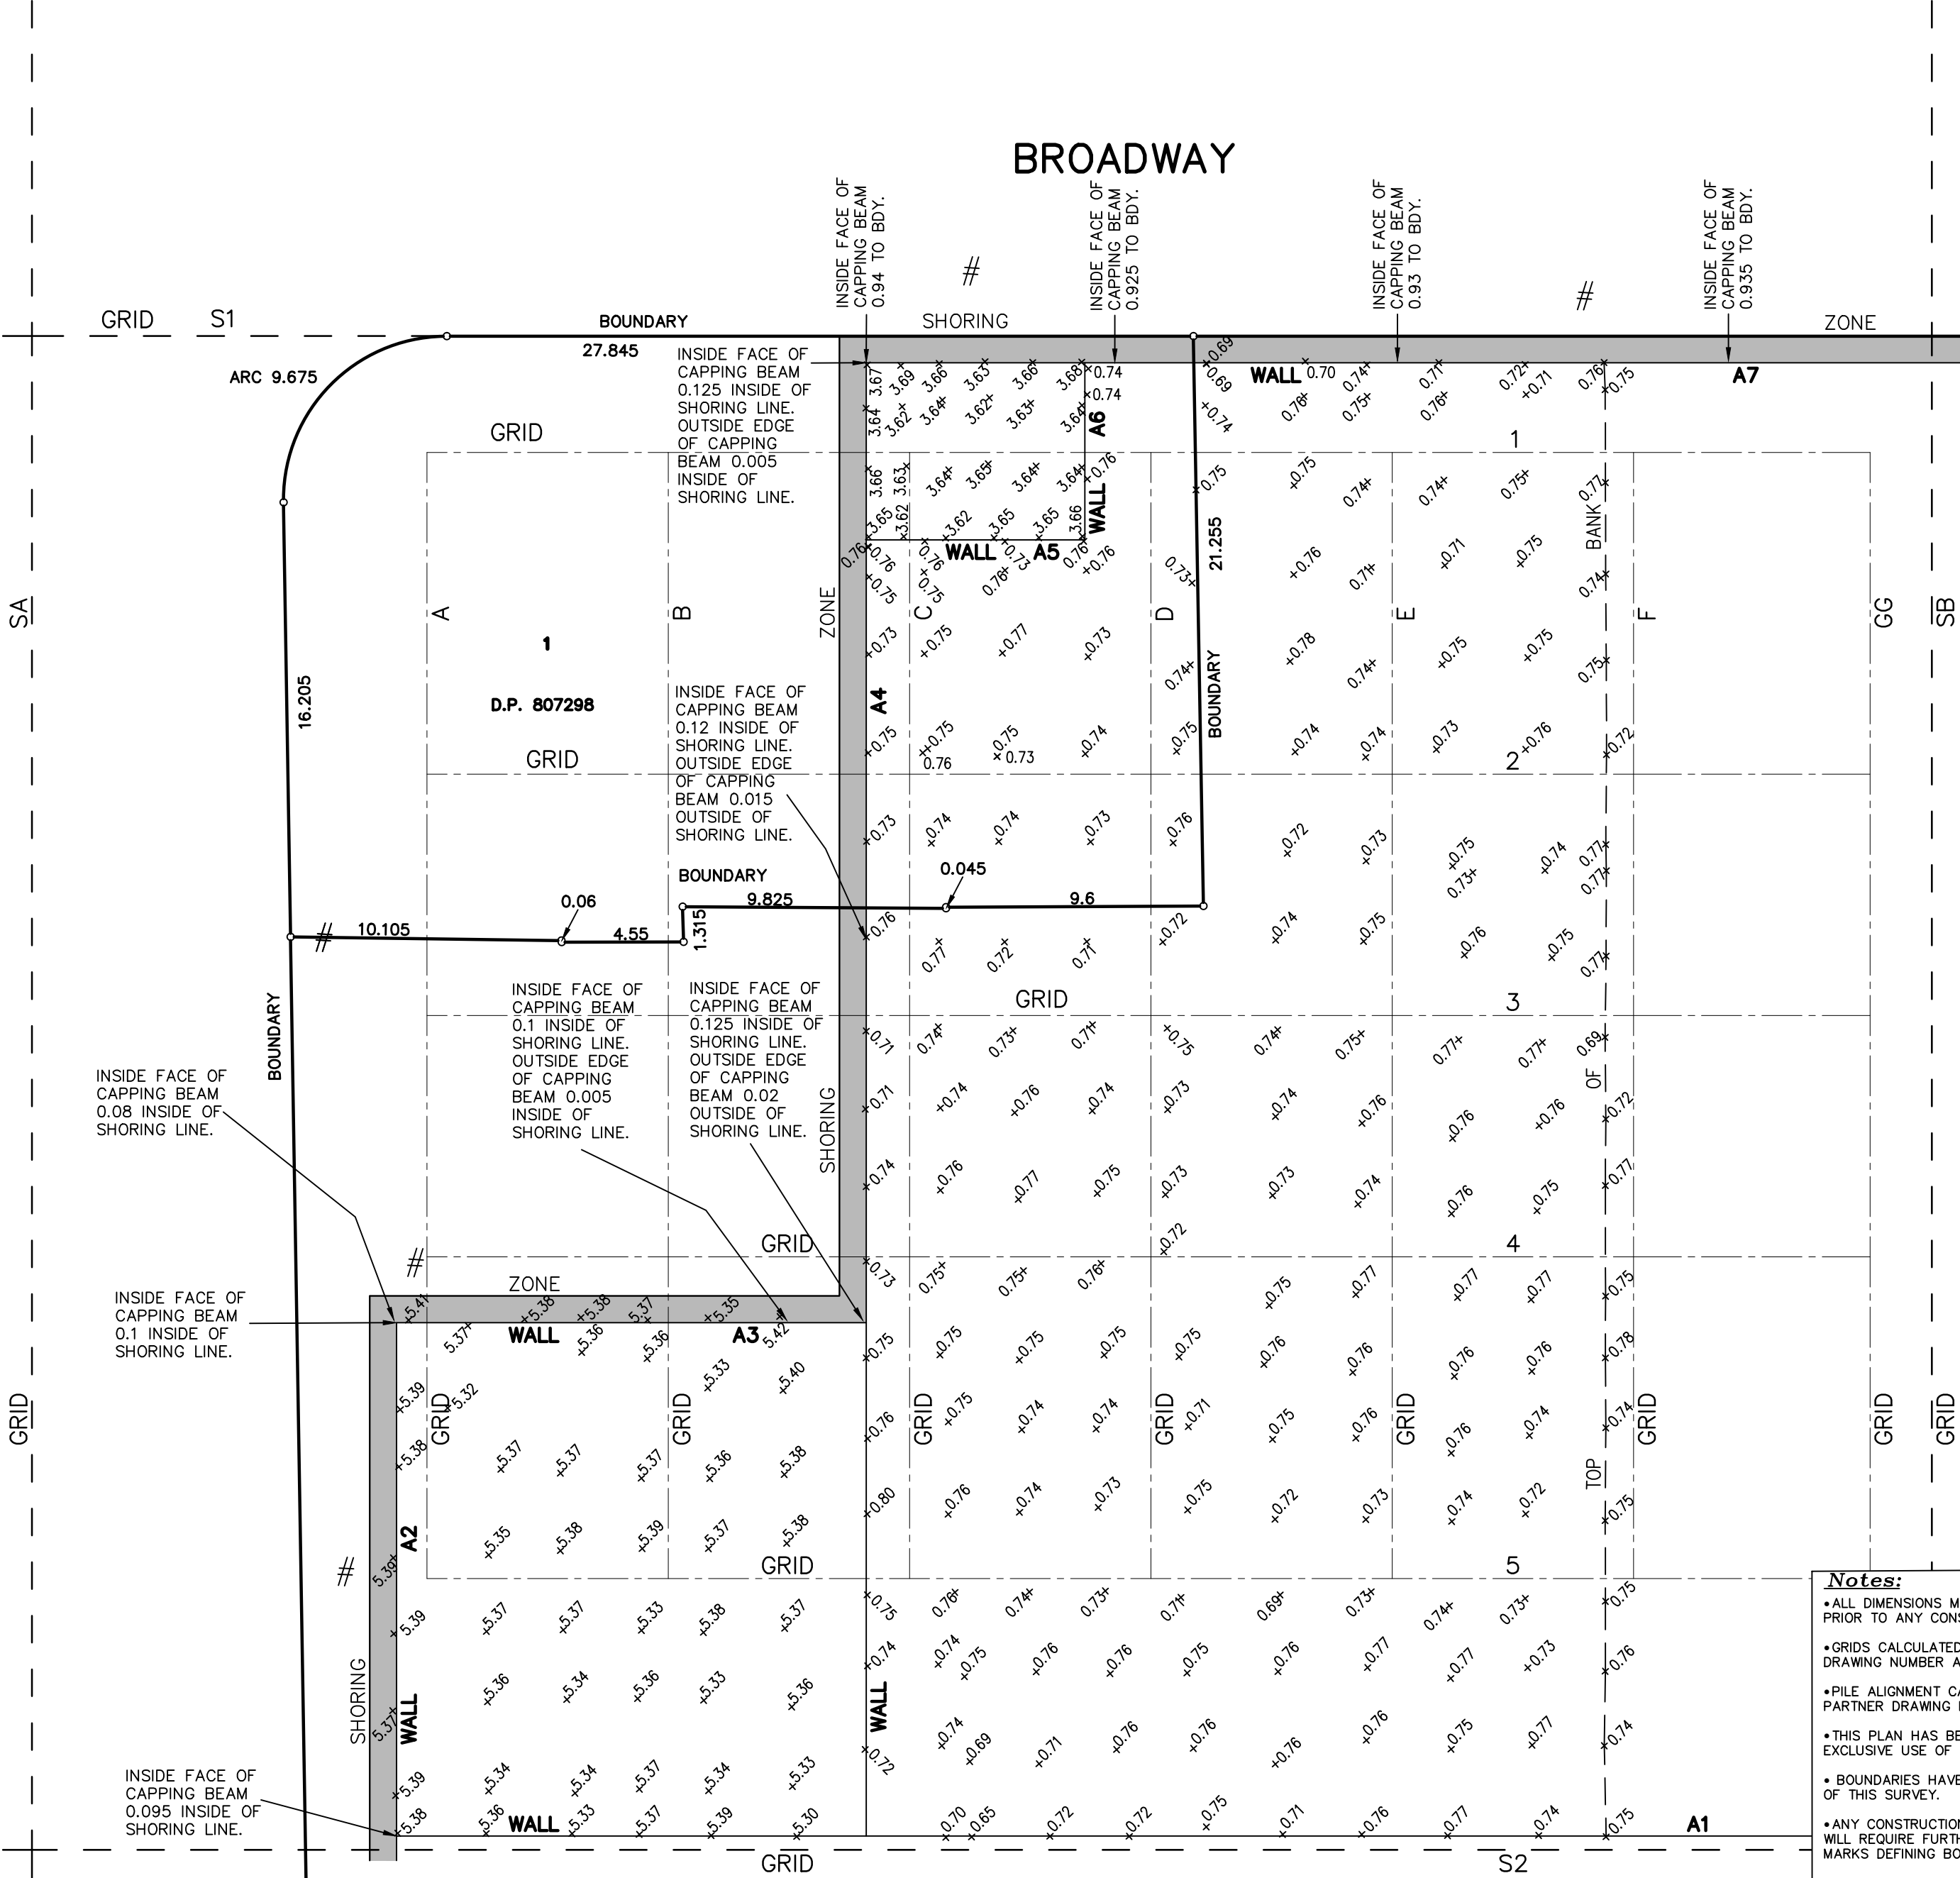

NOTES ON CAPPING BEAM:
DENOTES OUTSIDE EDGE OF CAPPING BEAM INACCESSIBLE.
—CAPPING BEAM GENERALLY 0.89 WIDE.

Notes:

- ALL DIMENSIONS MUST BE VERIFIED ON SITE PRIOR TO ANY CONSTRUCTION.
- GRIDS CALCULATED FROM FOSTER & PARTNER DRAWING NUMBER A-0A-011 REVISION M.
- PILE ALIGNMENT CALCULATED FROM FOSTER & PARTNER DRAWING NUMBER A-0A-011 REVISION M.
- THIS PLAN HAS BEEN PREPARED FOR THE EXCLUSIVE USE OF MAINLAND CIVIL.
- BOUNDARIES HAVE NOT BEEN DEFINED AS PART OF THIS SURVEY.
- ANY CONSTRUCTION ON OR NEAR BOUNDARIES WILL REQUIRE FURTHER SURVEY IN ORDER THAT MARKS DEFINING BOUNDARIES CAN BE PLACED.
- COPYRIGHT © DEGOTARDI SMITH & PARTNERS SURVEYORS 2013.

NO PART OF THIS SURVEY MAY BE REPRODUCED, STORED IN A RETRIEVAL SYSTEM OR TRANSMITTED IN ANY FORM, WITHOUT THE WRITTEN PERMISSION OF THE COPYRIGHT OWNER EXCEPT AS PERMITTED BY THE COPYRIGHT ACT 1968.

ANY PERMITTED DOWNLOADING, ELECTRONIC STORAGE, DISPLAY, PRINT, COPY OR REPRODUCTION OF THIS SURVEY SHOULD CONTAIN NO ALTERATION OR ADDITION TO THE ORIGINAL SURVEY.

THIS NOTICE MUST NOT BE ERASED.

HORIZONTAL DATUM:
CO-ORDINATE SYSTEM:
MARKS ADOPTED:

VERTICAL DATUM:
DATUM: A.H.D.
B.M. ADOPTED: P.M. 42338
R.L. 16.71
SOURCE: S.C.I.M.S.

B	PRELIMINARY	20/08/14
A	PRELIMINARY	04/08/14
REV.	AMENDMENTS	DATE

CLIENT:
MAINLAND CIVIL

PLAN
OF EXCAVATION AS BUILT
SURVEY OF BLOCK 1 + 4N




Degotardi Smith & Partners
CONSULTING SURVEYORS ESTABLISHED 1957


11/19-23 Bridge Street | Pymble
NSW 2073 | Australia
t. (+61) 2 9440 1100
f. (+61) 2 9440 1055
e. surveys@degotardi.com.au
w. www.degotardi.com.au




L.G.A. SYDNEY		SHEET 1 OF 3	
SURVEYED L.B.	DRAWN T.F.	CHECKED L.B.	APPROVED P.G.
SURVEY REFERENCE 33761		SCALE 1: 200	DATE 20/08/14
DRAWING NUMBER 33761WAE02.dwg			REV. B

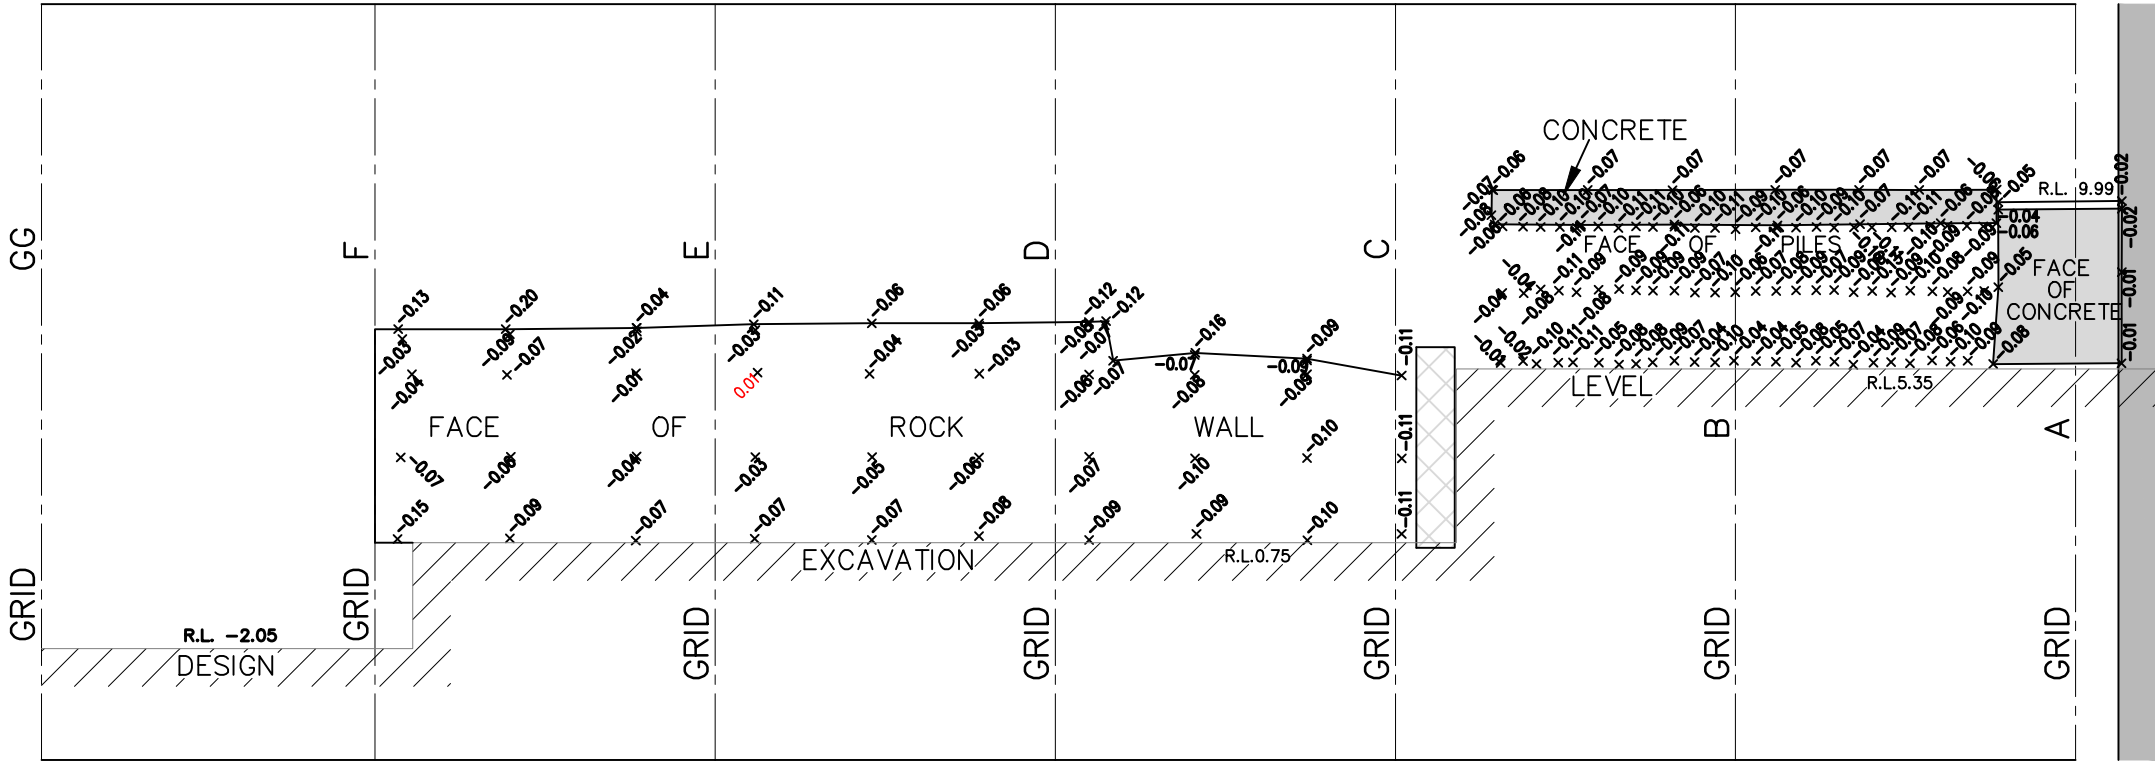

SOUTH ELEVATION – WALL A1

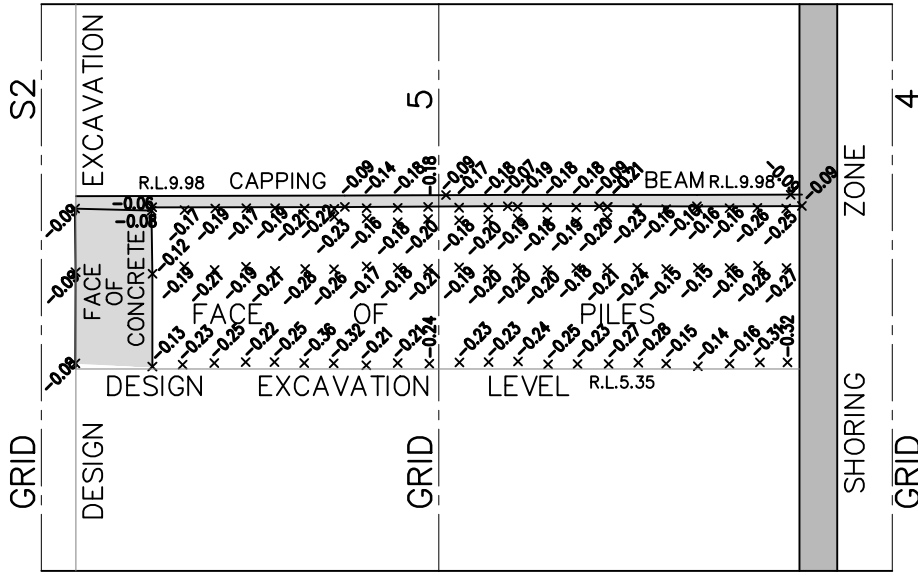

WEST ELEVATION – WALL A2

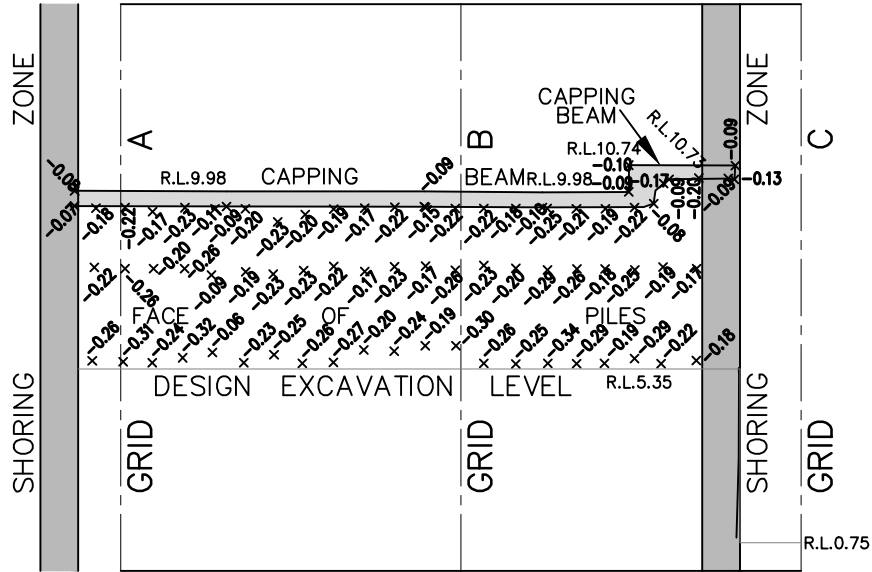


NORTH ELEVATION – WALL A3

DENOTES SCAFFOLDING

LEGEND

-0.04 DENOTES WALL IS 0.04m AWAY FROM THE EXCAVATION

0.04 DENOTES WALL IS 0.04m TOWARDS THE EXCAVATION

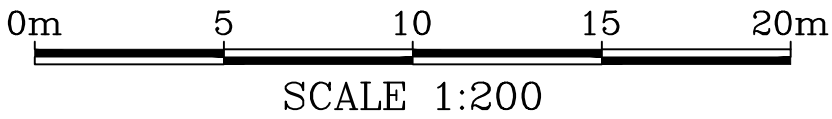

HORIZONTAL DATUM:
CO-ORDINATE SYSTEM:
MARKS ADOPTED:

VERTICAL DATUM:

DATUM: A.H.D.
B.M. ADOPTED: P.M. 42338
R.L. 16.71
SOURCE: S.C.I.M.S.

B	PRELIMINARY	20/08/14
A	PRELIMINARY	04/08/14
REV.	AMENDMENTS	DATE

CLIENT:

MAINLAND CIVIL

PLAN
OF EXCAVATION AS BUILT
SURVEY OF BLOCK 1 + 4N

D
S
&
P

Degotardi Smith & Partners

CONSULTING SURVEYORS ESTABLISHED 1957

11/19-23 Bridge Street | Pymble
NSW 2073 | Australia
t. (+61) 2 9440 1100
f. (+61) 2 9440 1055
e. surveys@degotardi.com.au
w. www.degotardi.com.au

L.G.A. SYDNEY		SHEET 2 OF 3	
SURVEYED L.B.	DRAWN T.F.	CHECKED L.B.	APPROVED P.G.
SURVEY REFERENCE 33761		SCALE 1: 200	DATE 20/08/14
DRAWING NUMBER 33761WAE02.dwg			REV. B

