



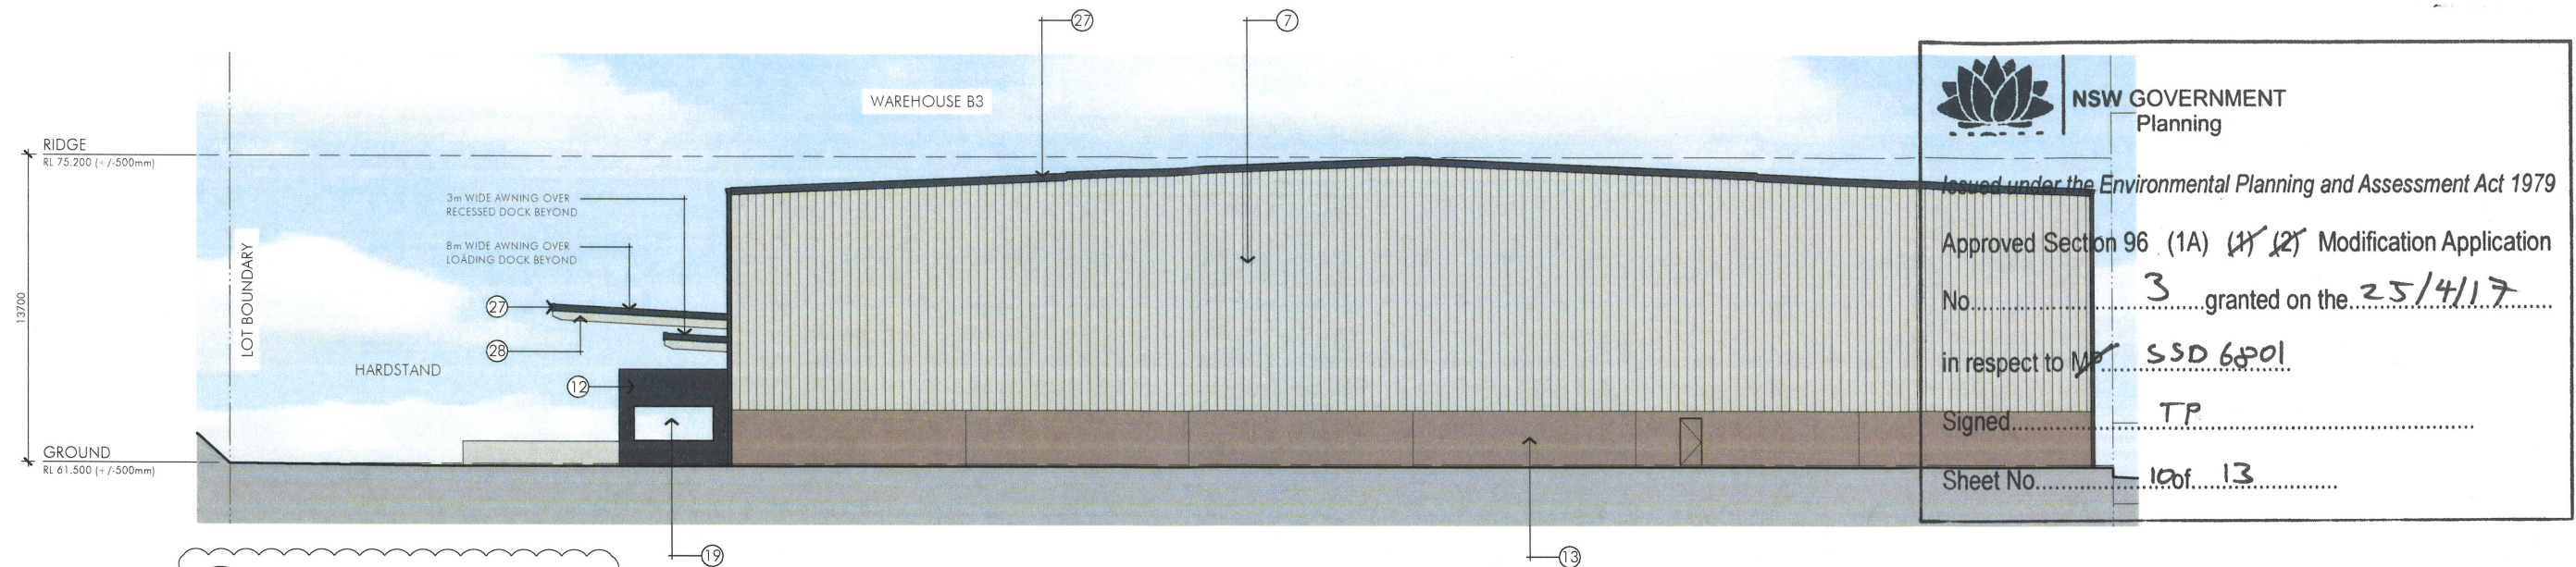

C WEST ELEVATION - WAREHOUSE B3
Scale 1:300

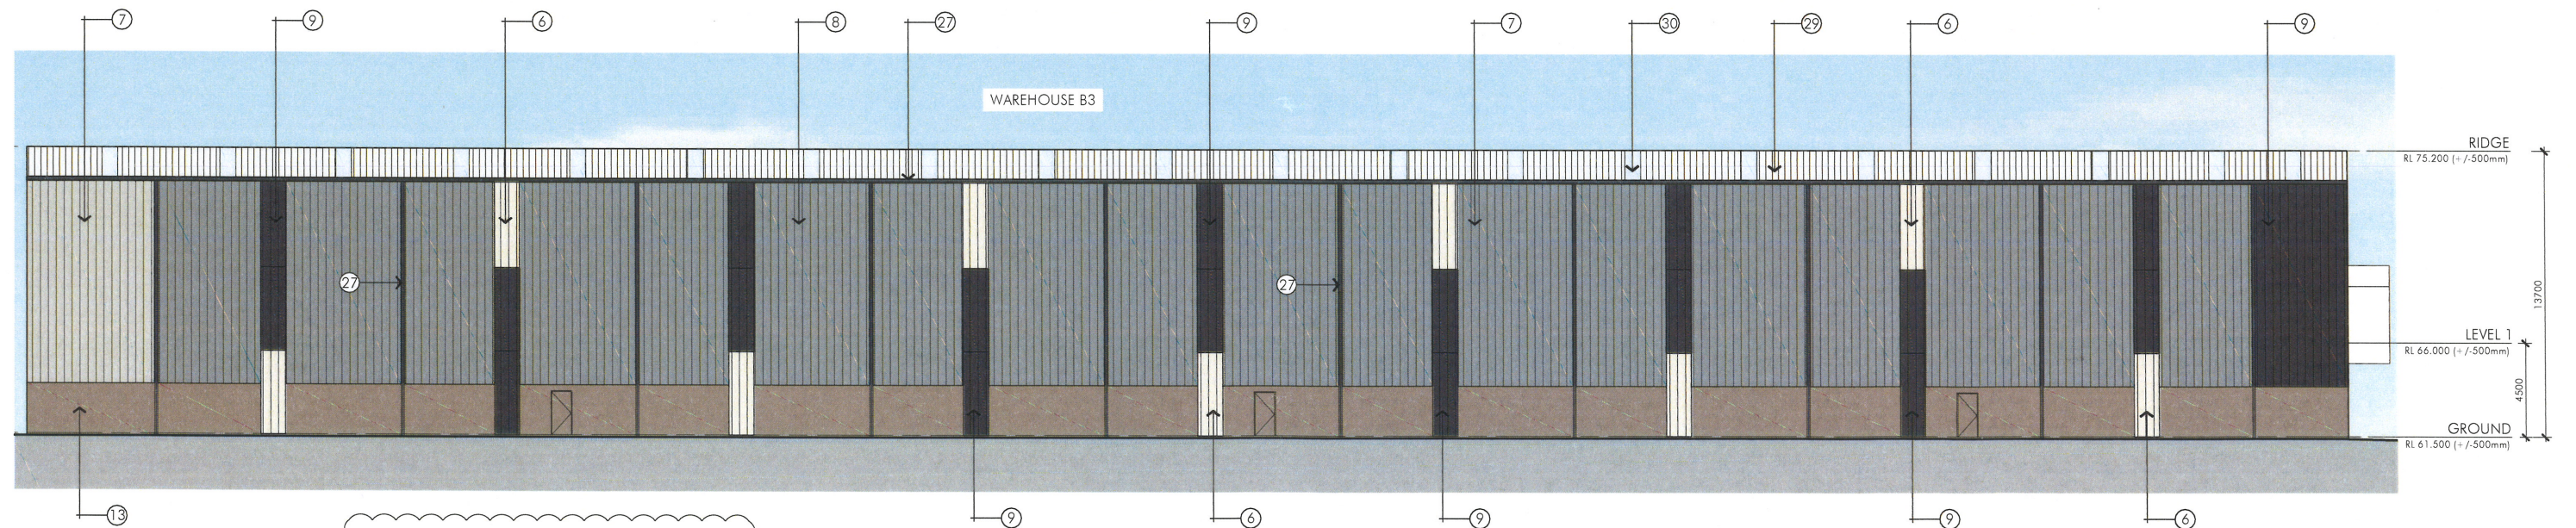

D SOUTH ELEVATION - WAREHOUSE B3
Scale 1:300

LEGEND FINISHES	1 INSULATED WALL PANEL 'OFF WHITE'	5 INSULATED WALL PANEL 'DAY-LITE WALL-LITE (TRANSLUCENT)'	9 PROFILED METAL SHEETING 'MONUMENT'	13 PAINTED PRECAST CONCRETE 'BOGART'	17 COMPOSITE ALUMINIUM CLADDING 'TEAK'	21 VERTICAL ALUMINIUM SUNSHADES 'MONUMENT'	25 PERFORATED MESH SCREEN	29 PROFILED ROOF SHEETING
	2 INSULATED WALL PANEL 'MATCH TO WINDSPRAY'	6 PROFILED METAL SHEETING 'SURFMIST'	10 PAINTED PRECAST CONCRETE 'SHALE GREY'	14 COMPOSITE ALUMINIUM CLADDING 'WHITE'	18 DANPALON POLYCARBONATE OPAQUE SHEETING 'ICE'	22 OUTDOOR RECREATION AREA SCREEN	26 GRAPHICS DECAL OVER INSULATED PANELS	30 PROFILED CLEARLITE SHEETING
	3 INSULATED WALL PANEL 'MATCH TO MONUMENT'	7 PROFILED METAL SHEETING 'SHALE GREY'	11 PAINTED PRECAST CONCRETE 'BASALT'	15 COMPOSITE ALUMINIUM CLADDING 'GREEN'	19 OFFICE WINDOW GLAZING - EVANTAGE GREY (VISION)	23 POWDERCOATED ROLLER DOORS 'SHALE GREY'	27 GUTTERS, CAPPINGS & DOWNPIPES 'MONUMNET'	
	4 INSULATED WALL PANEL 'GREEN'	8 PROFILED METAL SHEETING 'WINDSPRAY'	12 PAINTED PRECAST CONCRETE 'MONUMENT'	16 COMPOSITE ALUMINIUM CLADDING 'GREY METALLIC'	20 OFFICE WINDOW GLAZING - WOODLAND GREY (SPANDREL)	24 INSULATED PANEL DOORS 'SHALE GREY'	28 GALVANISED WAREHOUSE AWNING STRUCTURES	

ISSUED FOR MODIFICATION TO DA

© copyright nettleton tribe partnership pty ltd

quarry
at Greystanes

QUARRY WEST MASTERPLAN
GREYSTANES ESTATE

Developable Lot B Coloured Elevations_Sheet 8

Scale 1:300@A3


February 2017

3966_MP-026_8[C]




rt
nettletontribe

DEXUS
PROPERTY GROUP

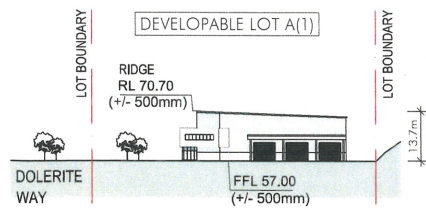

01 NORTH WEST ELEVATION
1:1000 @ A1

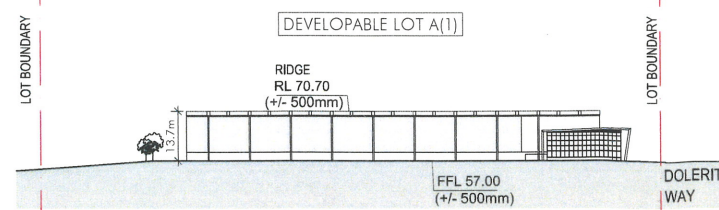

03 SOUTH EAST ELEVATION
1:1000 @ A1

NSW GOVERNMENT Planning

Issued under the Environmental Planning and Assessment Act 1979


Approved Section 96 (1A) ~~(1)~~ ~~(2)~~ Modification Application A(1)

No. 3 granted on the 25/4/17


in respect to MP SSD 6801

Signed TP


Sheet No. 11 of 13

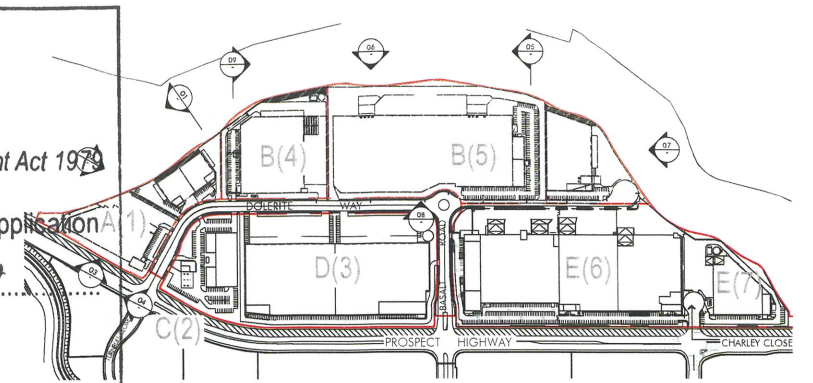


05 KEY PLAN
1:5000 @ A1

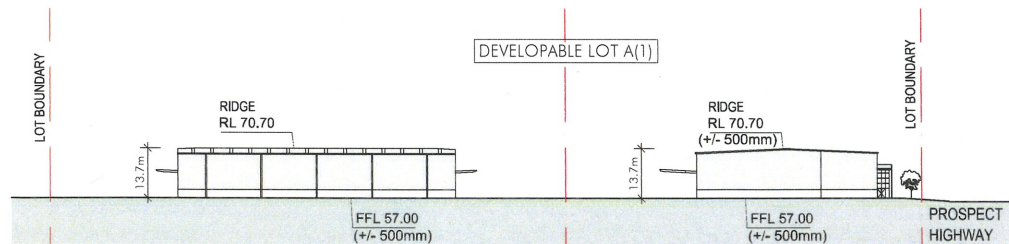


02 SOUTH WEST ELEVATION
1:1000 @ A1

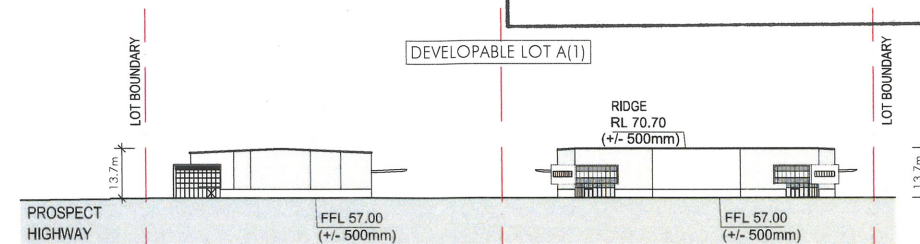



04 NORTH EAST ELEVATION
1:1000 @ A1

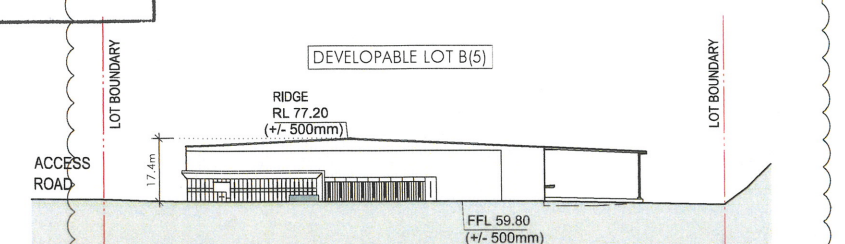


05 NORTH ELEVATION
1:1000 @ A1

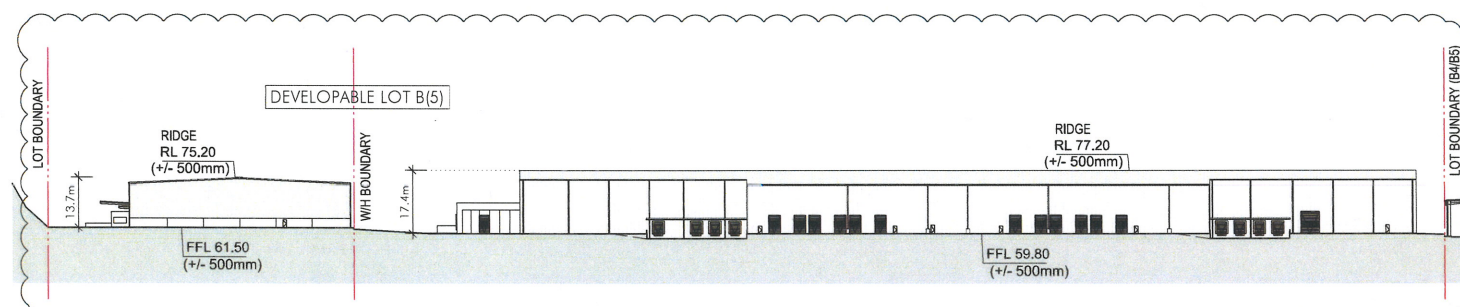


06 WEST ELEVATION
1:1000 @ A1

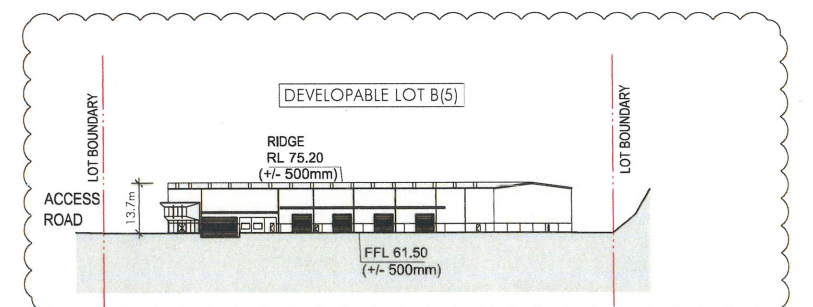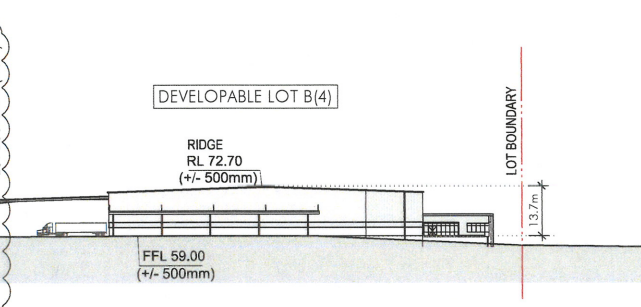

07 NORTH ELEVATION
1:1000 @ A1

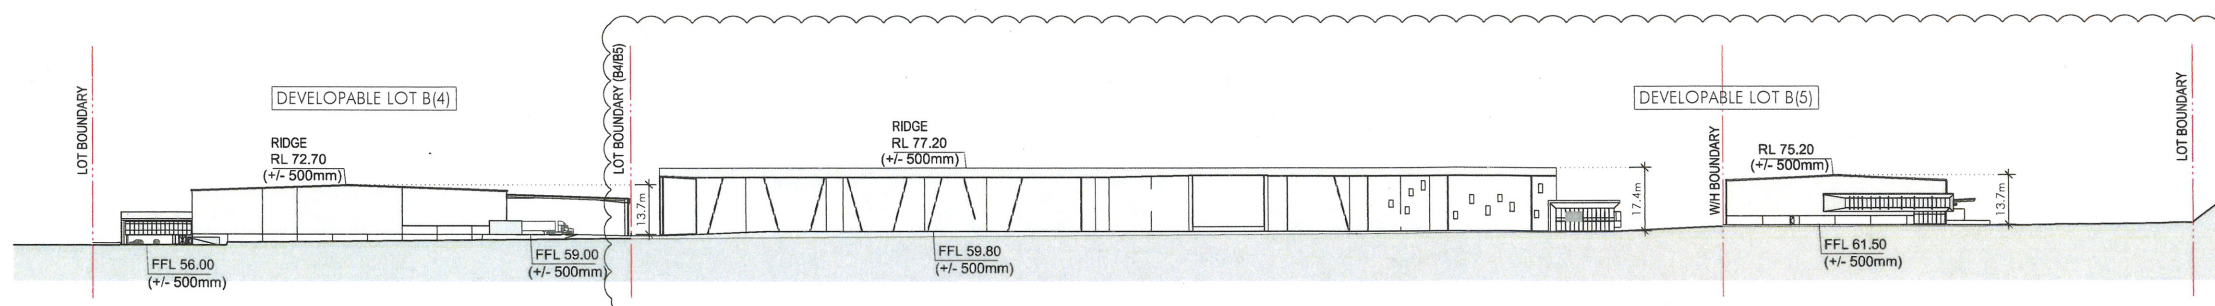

08 EAST ELEVATION
1:1000 @ A1

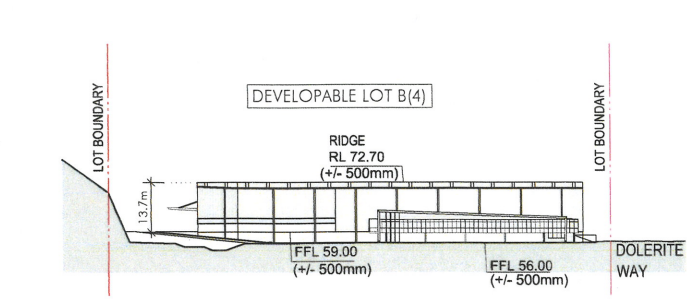

09 SOUTH ELEVATION
1:1000 @ A1

ISSUED FOR MODIFICATION TO DA

© copyright nettleton tribe partnership pty ltd

quarry
at Greystanes

QUARRY WEST MASTERPLAN
GREYSTANES ESTATE

Elevations - Developable Lots A & B

Scale 1:1000@A1 March 2017 3966_MP-021[F]



nettleton
tribe

DEXUS
PROPERTY GROUP