


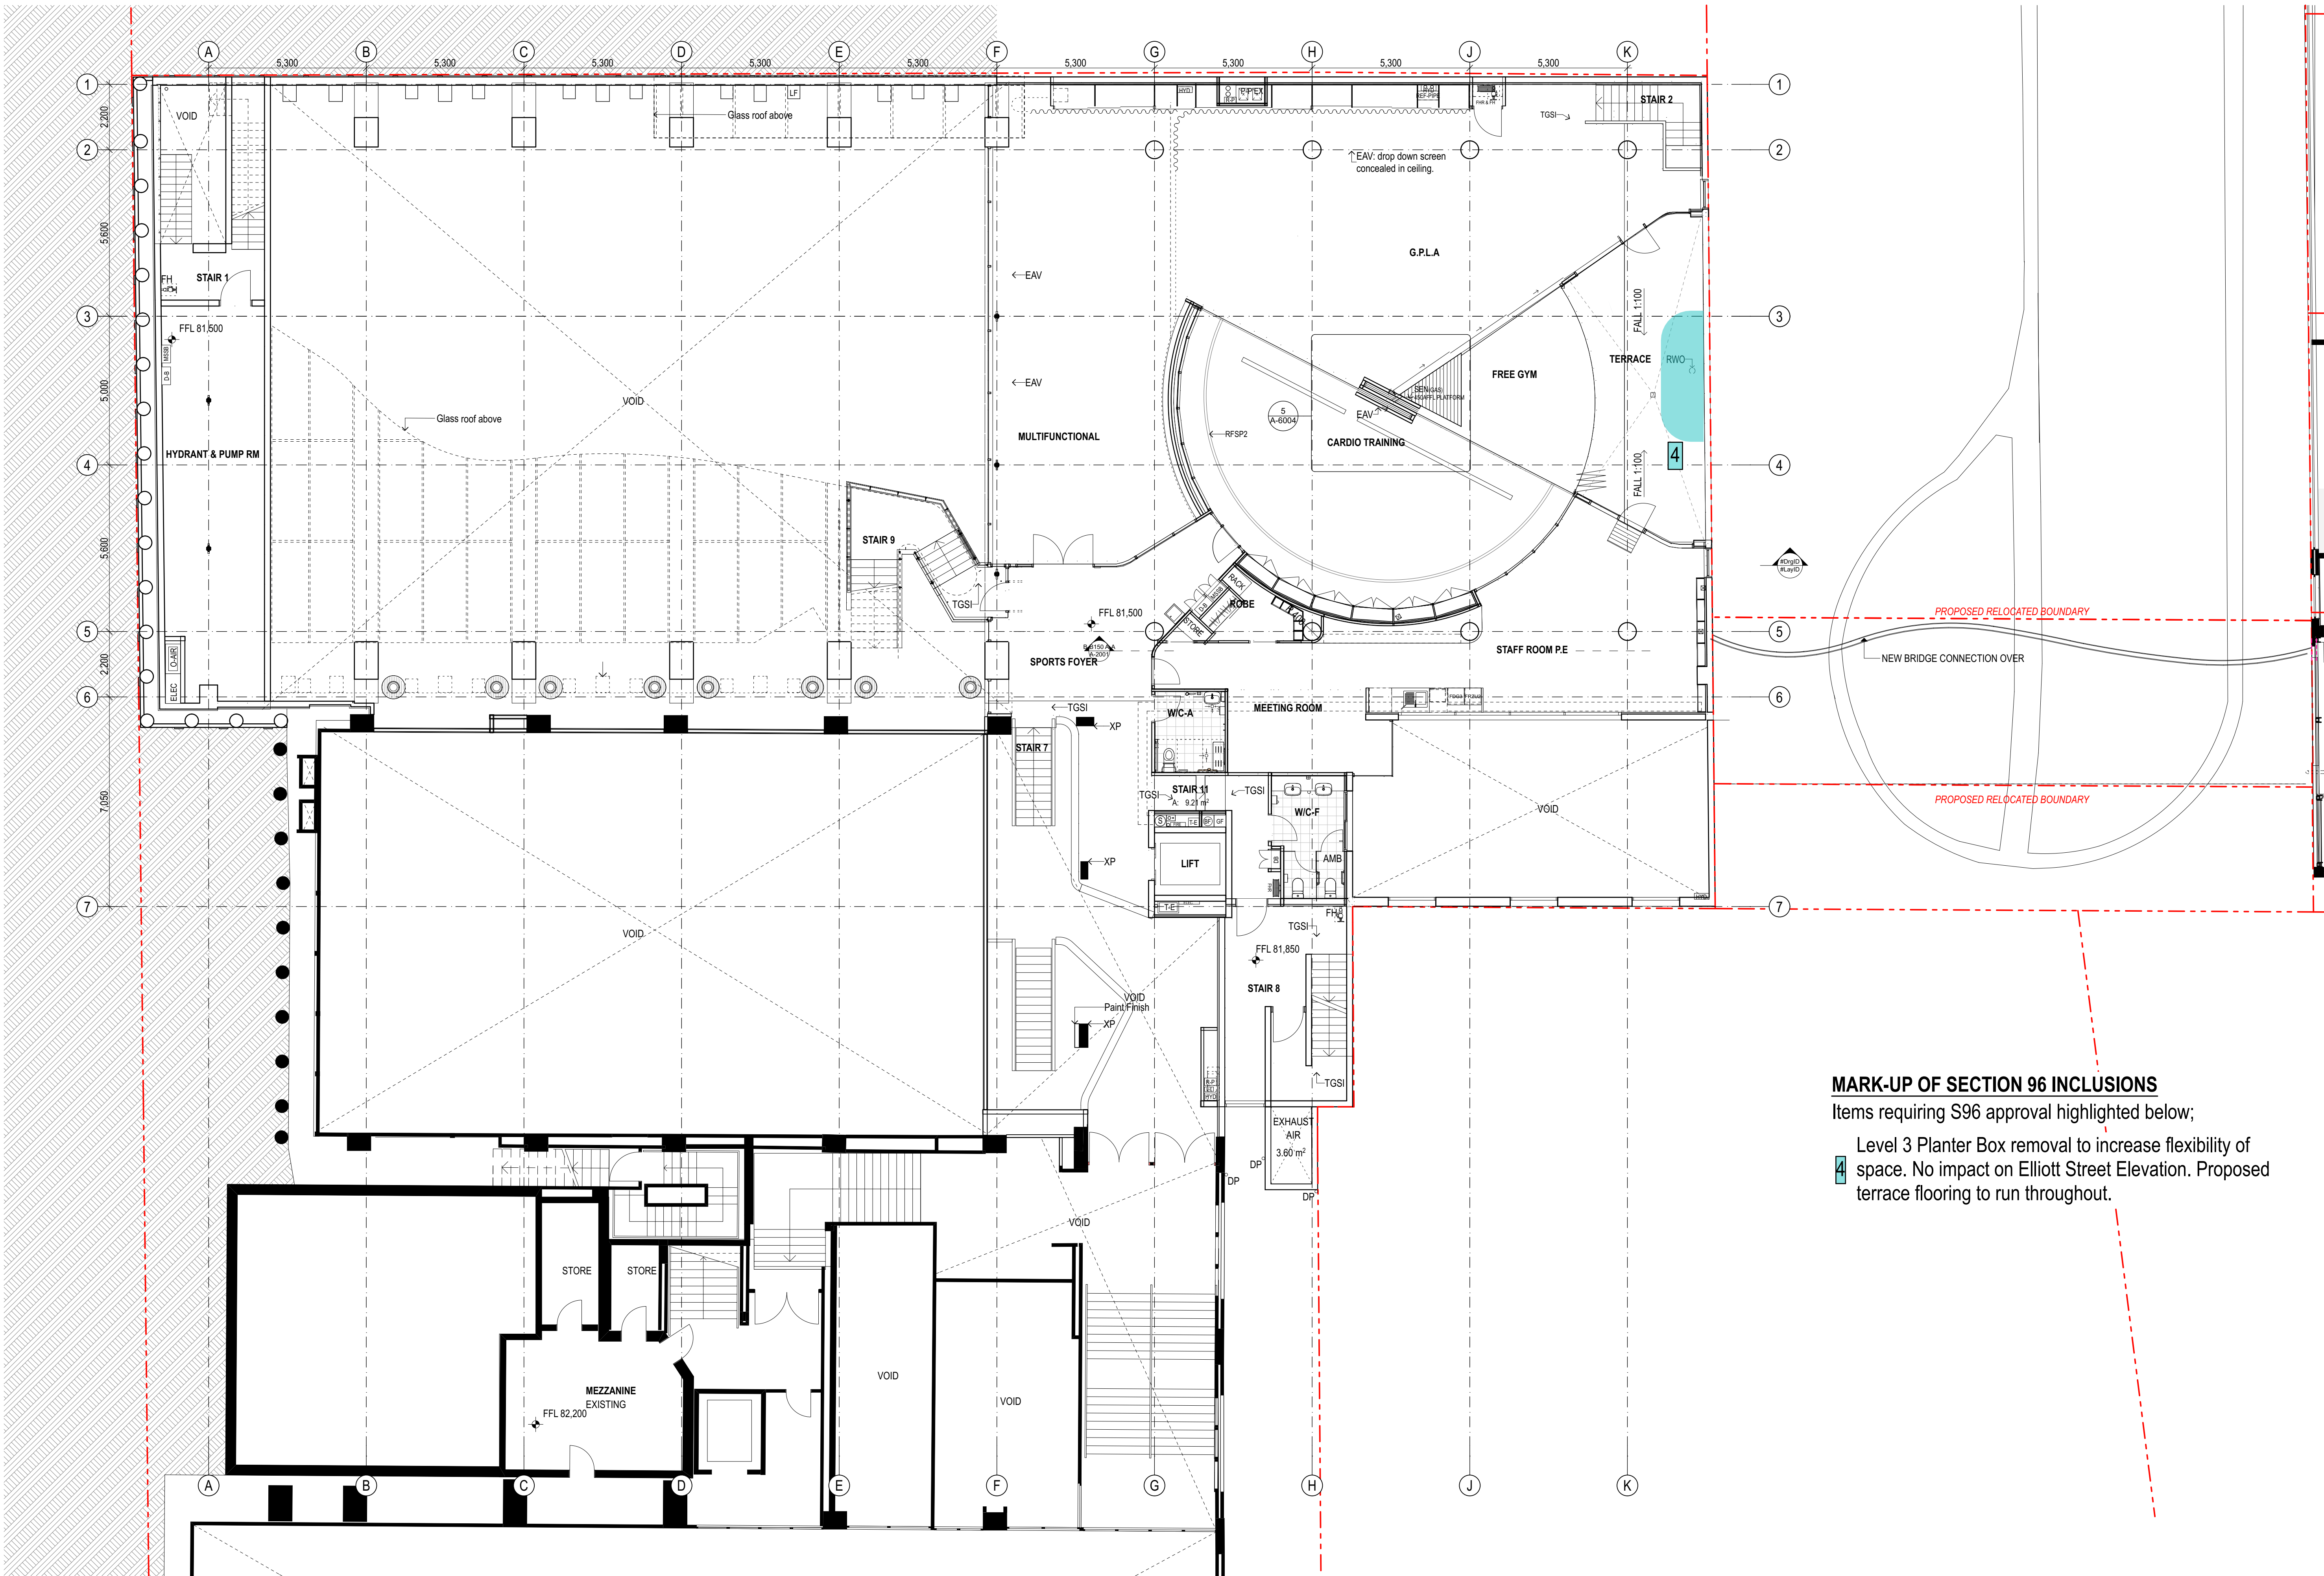


MARK-UP OF SECTION 96 INCLUSIONS

Items requiring S96 approval highlighted below;

4 Level 3 Planter Box removal to increase flexibility of space. No impact on Elliott Street Elevation. Proposed terrace flooring to run throughout.

NOTES: Do not scale off drawings. Use figured dimensions only. Report any discrepancies to the architect. These designs, plans, specifications and the copyright therein are the property of Tonkin Zulaikha Greer Architects Pty Ltd, and must not be reproduced or copied wholly or in part without written permission of Tonkin Zulaikha Greer Architects Pty Ltd.	ACCESSIBILITY Morris Goding MDA Australia Elisa Moehlar Phone: 9692 9322 Email: elisa@mgac.com.au	QUANTITY SURVEYOR MDA Australia Damon Bissell Phone: 9692 8000 Email: damon@mda-aust.com.au	ELEC / MECH / LIFT/SECURITY MEDLAND METROPOLIS Chris Medland Phone: 400 444 410 Email: cmedland@medlandmetropolis.com.au	ACOUSTIC ENGINEER WILKINSON MURRAY Brian Clarke Phone: 9437 4611 Email: brian@wilkinsonmurray.com.au	BCA / PCA CONSULTANT BM+G Tony Henslip Phone: 9211 7777 Email: tony@bmplusg.com.au	LANDSCAPE 360 Glenn Dixon Phone: 9332 3601 Email: glenn@360.net.au	CLIENT: WENONA SCHOOL 176 Walker Street, North Sydney NSW 2060 Phone: 9409 4406 Email: hmckenzie@wenona.nsw.edu.au	PROJECT: WENONA PROJECT ARCHIMEDES 255-265 Miller Street, North Sydney NSW 2060 PROJECT NO : 14010	ARCHITECT TONKIN ZULAIKHA GREER ARCHITECTS 117 Reservoir Street ABN: 4600272349 P: (02) 9215 4900 F: (02) 9215 4901 EMAIL: matilda@tzig.com.au WEB www.tzg.com.au	DRAWING TITLE LEVEL 3 PLAN		DRAWN BY ABN, AVDB, JH, MW, SB, CW, TS CHECKED PT
										SCALES 1:100 @A1	DRAWING NO A-1005	ISSUE A

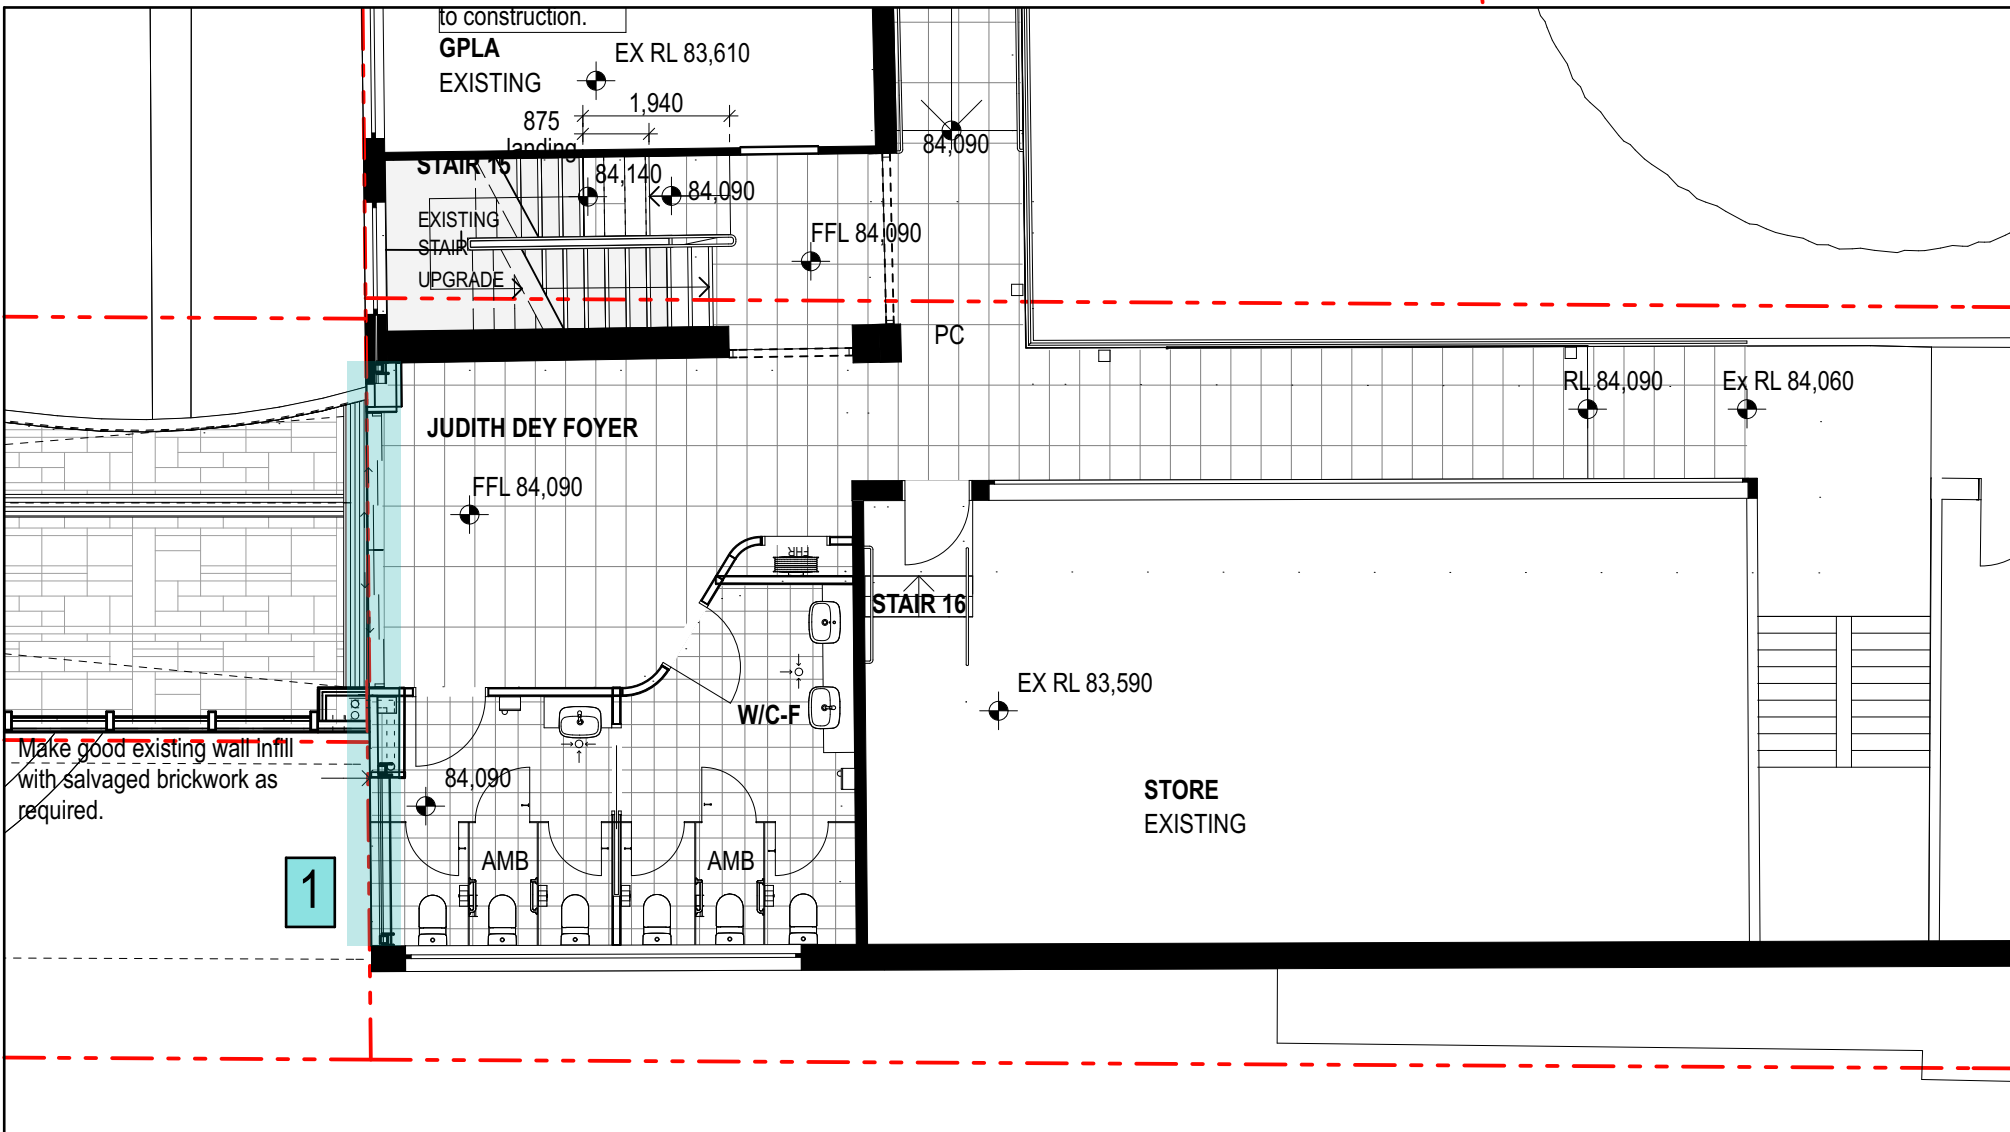

ARCHITECT
TONKIN ZULAIKHA GREER ARCHITECTS
 117 Reservoir Street
 ABN: 46002722349
 P: (02) 9215 4900
 F: (02) 9215 4901
 EMAIL matilda@tztg.com.au
 WEB www.tztg.com.au

greer
 ARCHITECTS

Print date: 26/6/18 File: RIM Server: tzn.him tzn rom all - RIM Server 20/14010 WFNONA WFNONA TAKE

ISSUE

A

ACCESSIBILITY
Morris Goding
Elisa Moehtar
 Phone: 9692 9322
 Email: elisa@mqac.com.au

QUANTITY SURVEYOR
MDA Australia
Damon Bissell
Phone: 9929 8000;
Email: damon@mda-aust.com.au

ELEC / MECH / LIFT/SECURITY
MEDLAND METROPOLIS
Chris Medland
Phone: 400 444 410
Email: cmedland@medlandmetropolis.com.au

ACOUSTIC ENGINEER
WILKINSON MURRAY
Brian Clarke
Phone: 9437 4611
Email: briano@wilkinsonmurray.co.uk

BCA / PCA CONSULTANT
BM+G
Tony Heaslip
Phone: 9211 7777
Email: tony@bmplusg.com.au

LANDSCAPE
360
Glenn Dixon
Phone: 9332 3601
Email: glenn@360.net.au

CLIENT:
WENONA SCHOOL
176 Walker Street, North Sydney
NSW, 2060

Phone: 9409 4406
Email: hmckenzie@wenona.nsw.edu.au

PROJECT :
WENONA
PROJECT ARCHIMEDES
255-265 Miller Street, North Sydney NSW 2060
PROJECT NO : 14010

MARK-UP OF SECTION 96 INCLUSIONS

Items requiring S96 approval highlighted below;

- 3 Miller centre elevation, air supple louvre integrated beside existing window.
- 5 Boundary Wall Height change to overcome aesthetic and functional issues; waterproofing against existing building.

LANDSCAPE NOTE:
Refer to LANDSCAPE
ARCHITECTS design for
details.

PROPOSED RELOCATED BOUNDARY

PROPOSED RELOCATED BOUNDARY

NOTES:
Do not scale off drawings. Use figured
dimensions only. Report any discrepancies to
the architect. These designs, plans,
specifications and the copyright therein are the
property of Tonkin Zulaikha Greer Architects Pty
Ltd, and must not be reproduced or copied
wholly or in part without written permission of
Tonkin Zulaikha Greer Architects Pty Ltd.

ACCESSIBILITY
Morris Goding
MDA Australia
Elisa Moechtar
Phone: 9529 8000
Email: damon@mda-aust.com.au
POOL
Collingridge Associates
Bob Collingridge
Phone: 9439 7288
Email: rcollingridge@collingridge.net.au

QUANTITY SURVEYOR
MDA Australia
Damon Bissell
Phone: 9529 8000
Email: dmedland@medlandmetropolis.com.au
STRUCTURAL/CIVIL/FACADE
TTW
Richard Green
Phone: 9299 1312
Email: Richard.Green@ttw.com.au


ELEC / MECH / LIFT/SECURITY
MEDLAND METROPOLIS
Chris Medland
Phone: 400 444 410
Email: cmedland@medlandmetropolis.com.au
HYDRAULIC / FIRE ENGINEER
Warren Smith
Grahame Barnes
Phone: 9767 1000
Email: grahame@warrensmith.com.au

ACOUSTIC ENGINEER
WILKINSON MURRAY
Brian Clarke
Phone: 9437 4611
Email: brian@wilkinsonmurray.com.au
FIRE SAFETY ENGINEER
Exova
James Dominguez
Phone: 9550 0566
Email: james.dominguez@exova.com

BCA / PCA CONSULTANT
BM+G
Tony Heaslip
Phone: 9211 7777
Email: tony@bmplusg.com.au
TOWN PLANNER
JBA
Kate Tudhope
Phone: 9556 6962
Email: KTudhope@jbaurban.com.au

LANDSCAPE
BM+G
Glenn Dixon
Phone: 9332 3601
Email: glenn@360.net.au
KITCHEN
THE MACK GROUP
Teresa Mack
Phone: 9550 0566
Email: -

CLIENT:
WENONA SCHOOL
176 Walker Street, North Sydney NSW
NSW, 2060
Phone: 9409 4406
Email: hmckenzie@wenona.nsw.edu.au

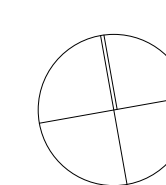

PROJECT:
WENONA
PROJECT ARCHEMEDES
255-265 Miller Street, North Sydney NSW 2060
PROJECT NO : 14010

ARCHITECT
TONKIN ZULAIKHA GREER ARCHITECTS
117 Reservoir Street
ABN: 4600272349
P: (02) 9215 4900
F: (02) 9215 4901
EMAIL: matilda@tzig.com.au
WEB: www.tzg.com.au

**tonkin
greer**
ARCHITECTS


DRAWING TITLE
LEVEL 5 PLAN
SCALES
1:100 @A1
PHASE
SECTION 96 - REV C
DRAWING NO
A-1007
ISSUE
A

DRAWN BY
ABN, AVDB, JH,
MW, SB, CW, TS
CHECKED PT


Plot date 7/5/18 File: RIM Server: tonkin.tzg.com.au - RIM Server 2018/01/10 WENONA WENONA TAKE 1

Items requiring S96 approval highlighted below;


7 Operable Gates

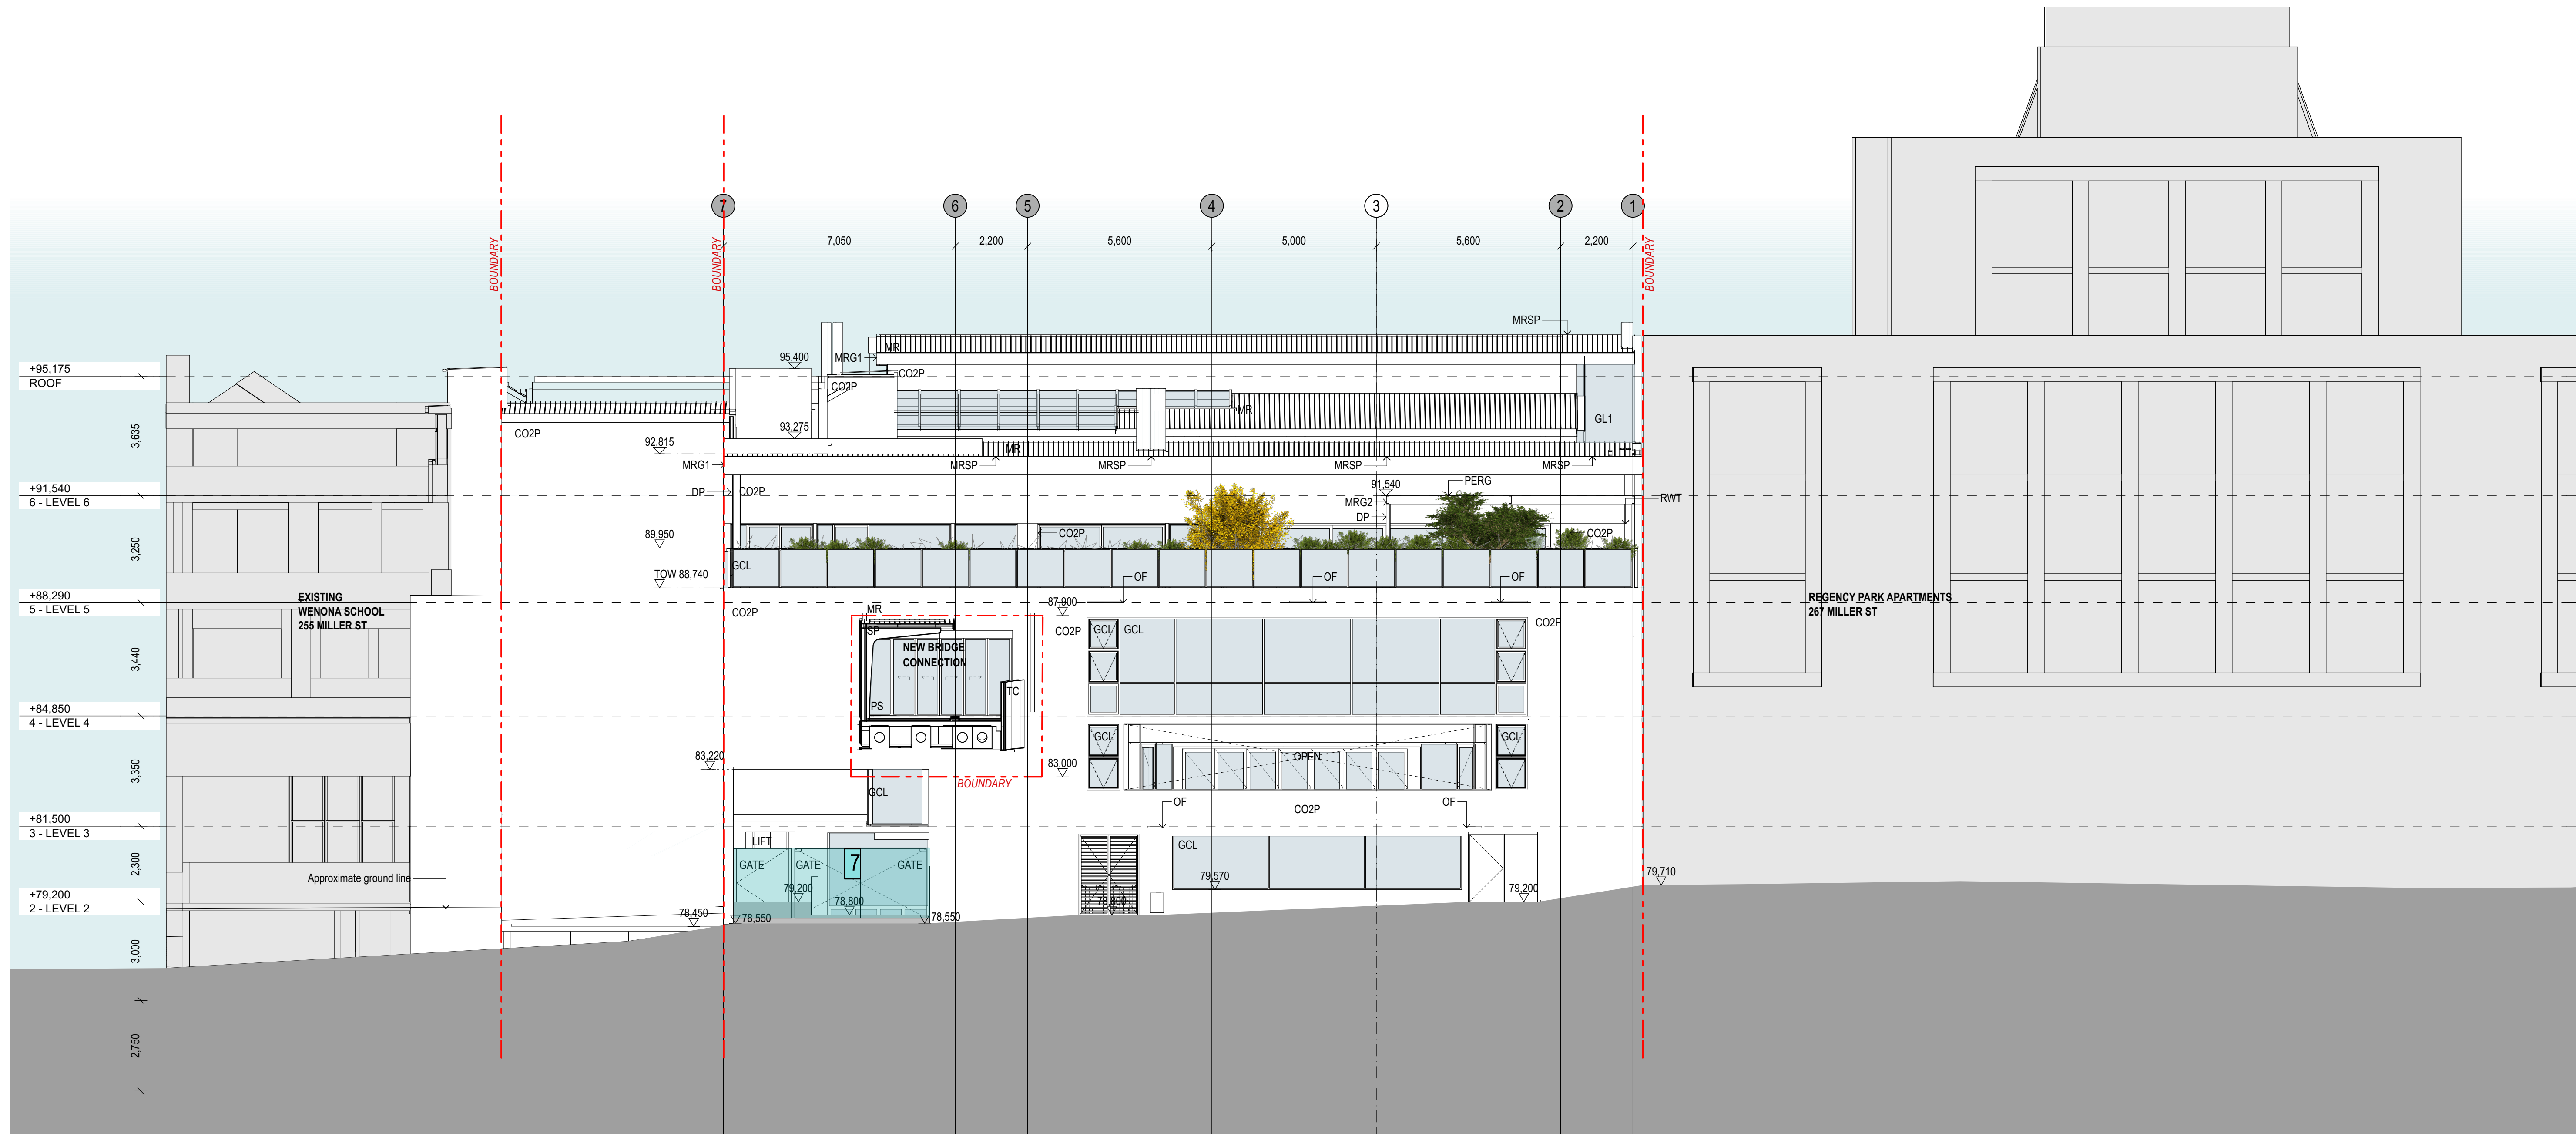

NOTES: Do not scale off drawings. Use figured dimensions only. Report any discrepancies to the architect. These designs, plans, specifications and the copyright therein are the property of Tonkin Zulaika Greer Architects Pty Ltd, and must not be reproduced or copied wholly or in part without written permission of Tonkin Zulaika Greer Architects Pty Ltd.	ACCESSIBILITY Morris Goding Elisa Moechar Phone: 9632 8322 Email: elisa@mgac.com.au	QUANTITY SURVEYOR MDA Australia Damon Bissell Phone: 9629 8000; Email: damon@mda-austr.com.au	ELEC / MECH / LIFT/SECURITY MEDLAND METROPOLIS Chris Medland Phone: 400 444 410 Email: chris@medlandmetropolis.com.au	ACOUSTIC ENGINEER WILKINSON MURRAY Brian Clarke Phone: 9532 4611 Email: brian@wilkinsonmurray.com.au	BCA / PCA CONSULTANT BM+G Tony Heslip Phone: 9211 7777 Email: tony@bm+g.com.au	LANDSCAPE 360 Glen Dixon Phone: 9532 3601 Email: glen@360.net.au	CLIENT: WENONA SCHOOL 176 Walker Street, North Sydney NSW, 2060 Phone: 9409 4406 Email: hmkzenzie@wenona.nsw.edu.au	PROJECT : WENONA PROJECT ARCHMEDES 255-265 Miller Street, North Sydney NSW 2060 PROJECT NO : 14010	ARCHITECT TONKIN ZULAIKA GREER ARCHITECTS 117 Reservoir Street ABN: 46002722349 P: (02) 9215 4900 F: (02) 9215 4901 EMAIL: mail@tztg.com.au WEB: www.tztg.com.au	DRAWING TITLE ELEVATION ELLIOTT STREET	DRAWN BY ABN, AVOB, JH, MW, SW, CW, TS CHECKED PT
	POOL Collingridge Associates Bob Collingridge Phone: 0412411616 Email: rcollingridge@collingridge.net.au	STRUCTURAL/CIVIL/FACADE TJW Richard Green Phone: 9429 7288 Email: Richard.Green@tjw.com.au	HYDRAULIC / FIRE ENGINEER Warren Smith Grahame Barnes Phone: 9787 1300 Email: graham@warrensmith.com.au	FIRE SAFETY ENGINEER Excova James Dominguez Phone: 9599 1312 Email: james.dominguez@excova.com	TOWN PLANNER JBA Kate Tudehope Phone: 9559 6952 Email: K.Tudehope@jbaurban.com.au	KITCHEN THE MACK GROUP Tereasa Mack Phone: 9550 0566 Email: -	ARCHITECT tonkin zulaika greer	DRAWING NO A-2002	ISSUE A		

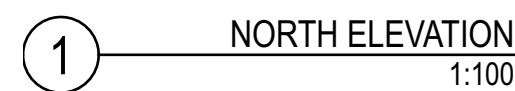


- 6 New Toilet Exhaust Vent, replacing removed existing contained within window.

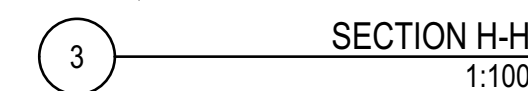

Items requiring S96 approval highlighted below;

- 5 Boundary Wall Height change to overcome aesthetic and functional issues; waterproofing against existing building.

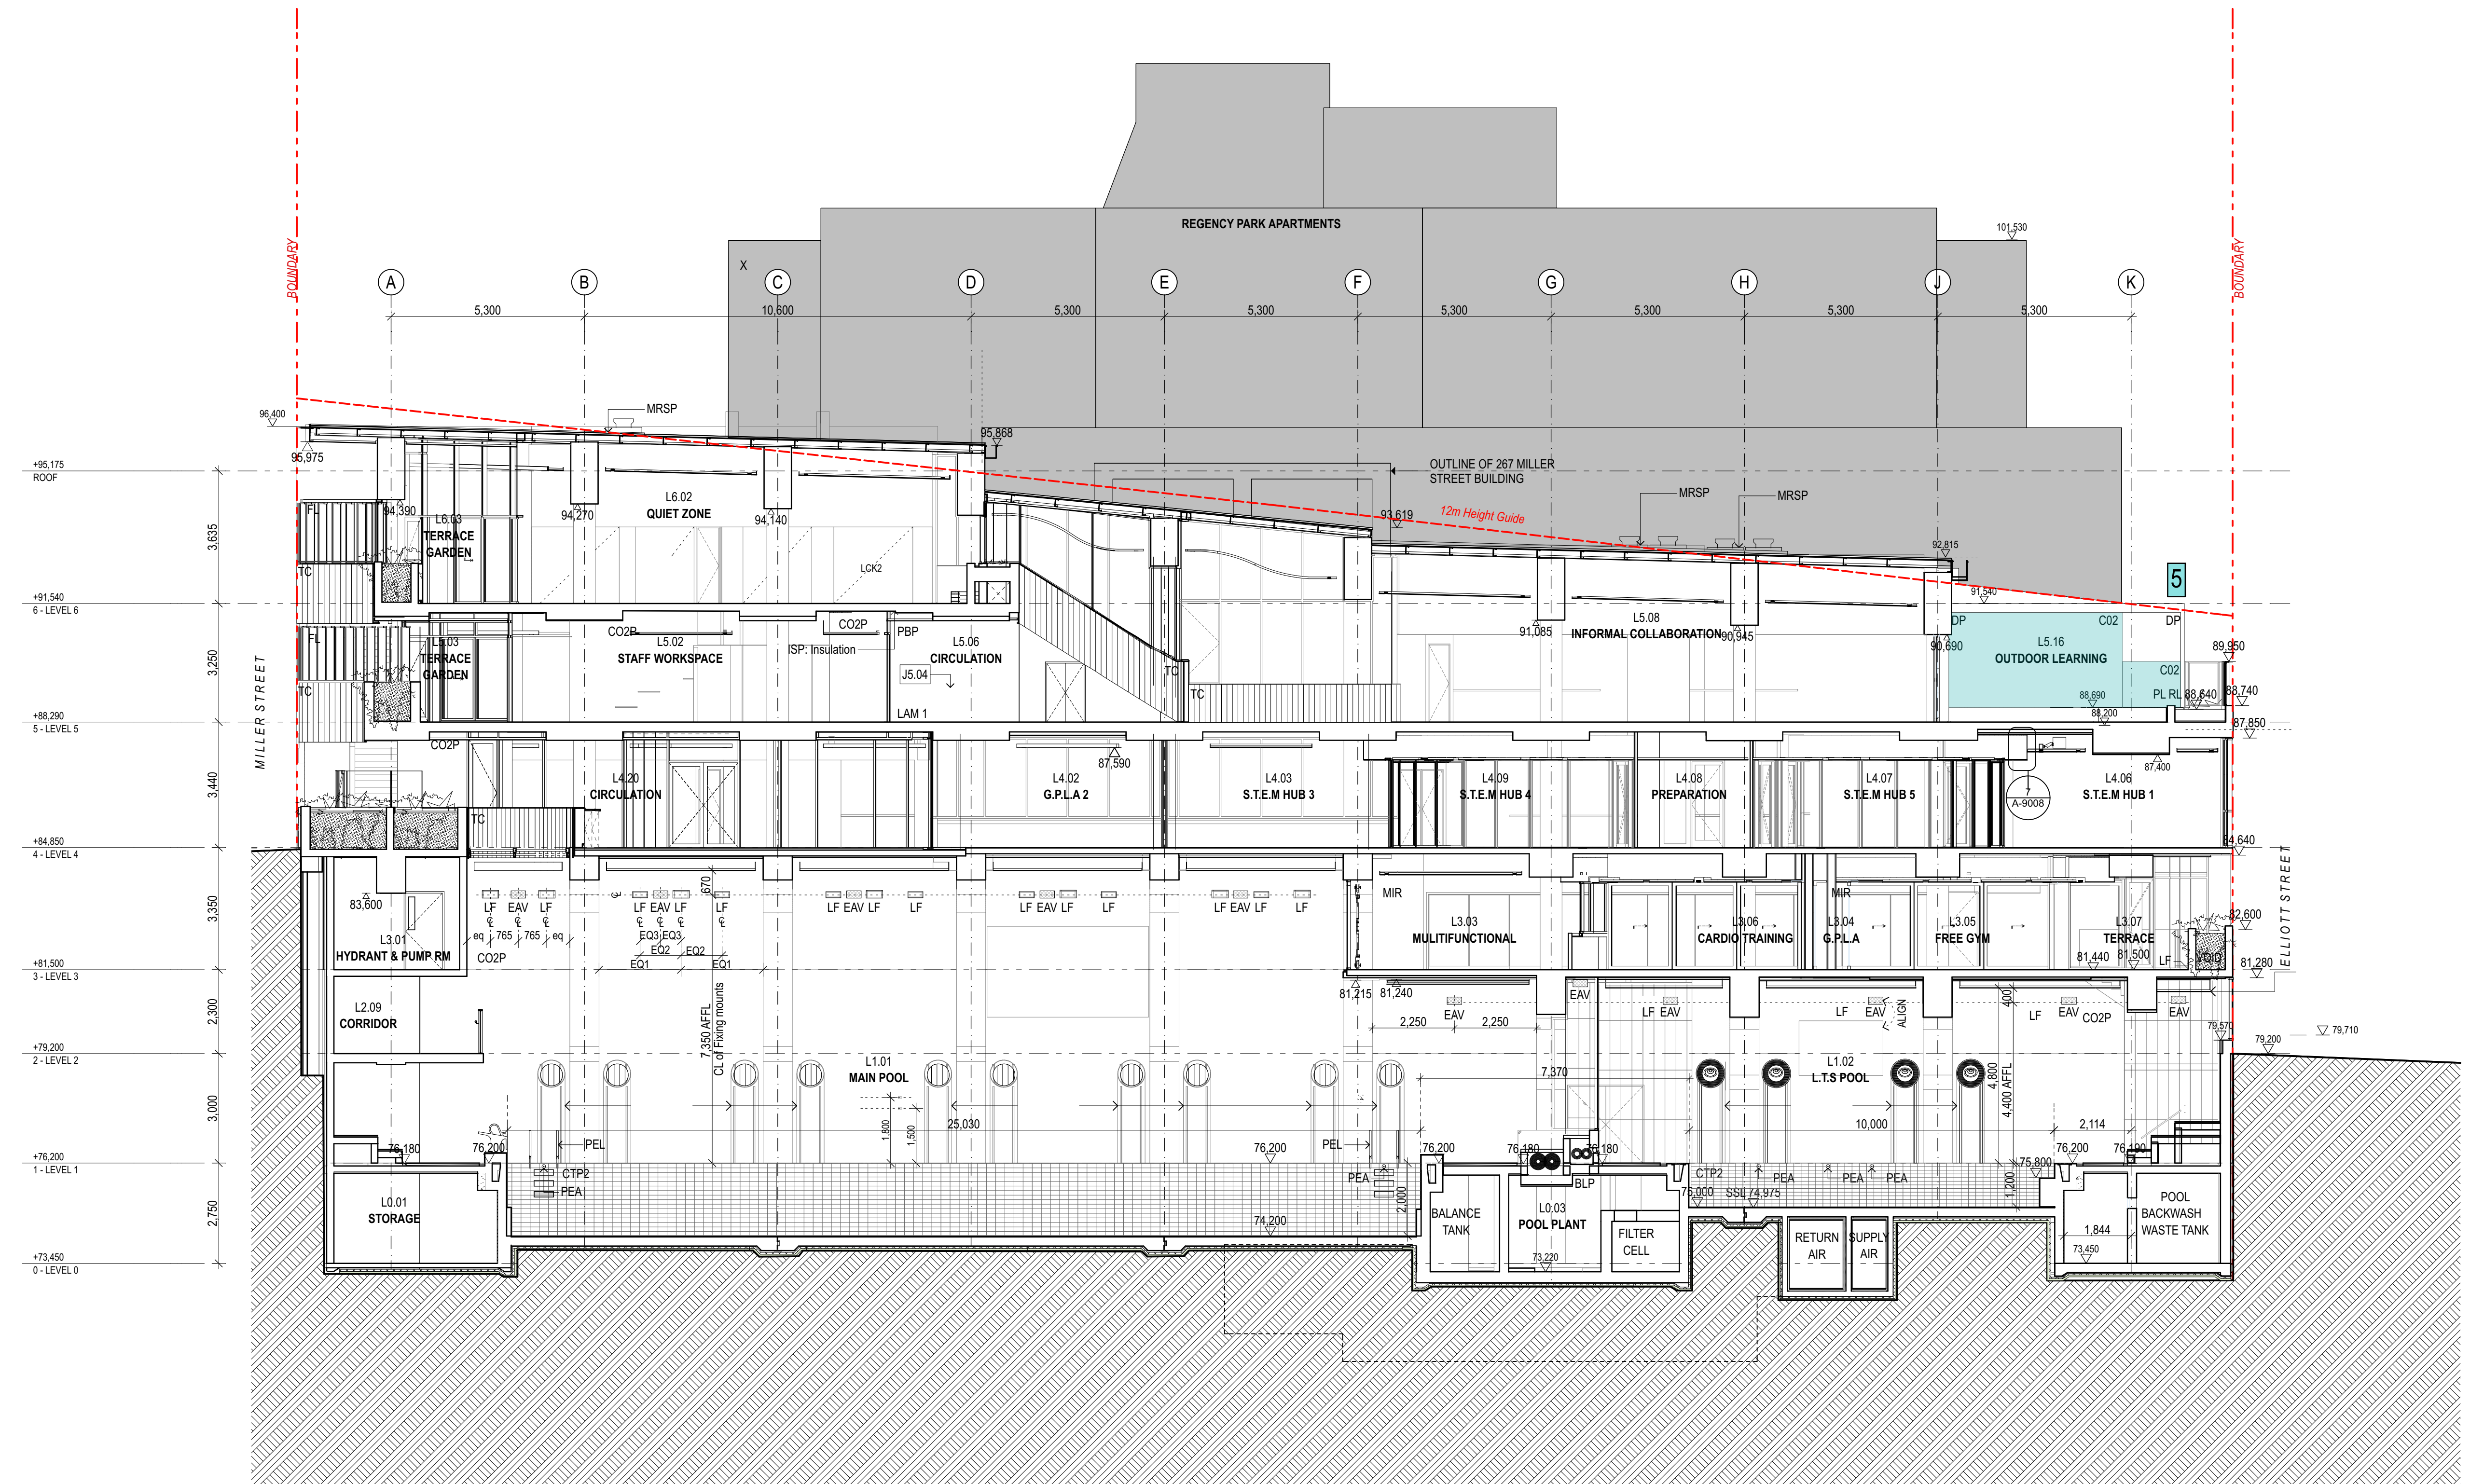

NOTES: Do not scale off drawings. Use figured dimensions only. Report any discrepancies to the architect. These designs, plans, specifications and the copyright therein are the property of Tonkin Zulaikha Greer Architects Pty Ltd, and must not be reproduced or copied wholly or in part without written permission of Tonkin Zulaikha Greer Architects Pty Ltd.	ACCESSIBILITY Morris Goding Elisa Moechar Phone: 9692 9322 Email: elisa@mgac.com.au	QUANTITY SURVEYOR MDA Australia Damon Bissell Phone: 9629 8000 Email: damon@mda-ast.com.au	ELEC / MECH / LIFT/SECURITY WILKINSON MURRAY Chris Medland Phone: 400 444 410 Email: cmedland@medlandmurray.com.au	ACOUSTIC ENGINEER WILKINSON MURRAY Brian Clarke Phone: 9437 4611 Email: brian@wilkinsonmurray.com.au	BCA / PCA CONSULTANT B-M-G Tony Hesliff Phone: 9211 7777 Email: tonv@bmjg.com.au	LANDSCAPE 360 Glen Dixon Phone: 9332 3601 Email: branae@360.net.au	CLIENT: WENONA SCHOOL 176 Walker Street, North Sydney NSW, 2060	PROJECT : WENONA PROJECT ARCHIEDES 255-265 Miller Street, North Sydney NSW 2060	ARCHITECT TONKIN ZULAIKHA GREER ARCHITECTS 117 Reservoir Street ABN: 4600272249 P: (02) 9215 4900 F: (02) 9215 4901 Email: malida@tzg.com.au WEB: www.tzg.com.au	DRAWING TITLE SECTION AA	DRAWN BY ABN, AVDB, JH, MW, SW, CW, TS, CHECKED PT
	POOL Collingridge Associates Bob Collingridge Phone: 0412418116 Email: collingridge@collingridge.net.au	STRUCTURAL/CIVIL/FACADE TTW Richard Green Phone: 9639 7288 Email: Richard.Green@ttw.com.au	HYDRAULIC / FIRE ENGINEER Warren Smith Grahame Barnes Phone: 9269 1312 Email: graham@warrensmith.com.au	FIRE SAFETY ENGINEER Exova James Dominguez Phone: 9167 1000 Email: James.dominguez@exova.com	TOWN PLANNER JBA Kate Tudehope Phone: 9656 6982 Email: KT.tudehope@jbaurban.com.au	KITCHEN THE MACK GROUP Teresa Mack Phone: 9550 0566 Email: -	Phone: 9409 4406 Email: hmkcniez@wenona.nsw.edu.au	PROJECT NO : 14010	SCALES 1:100 @A1	DRAWING NO A-3000	ISSUE A