



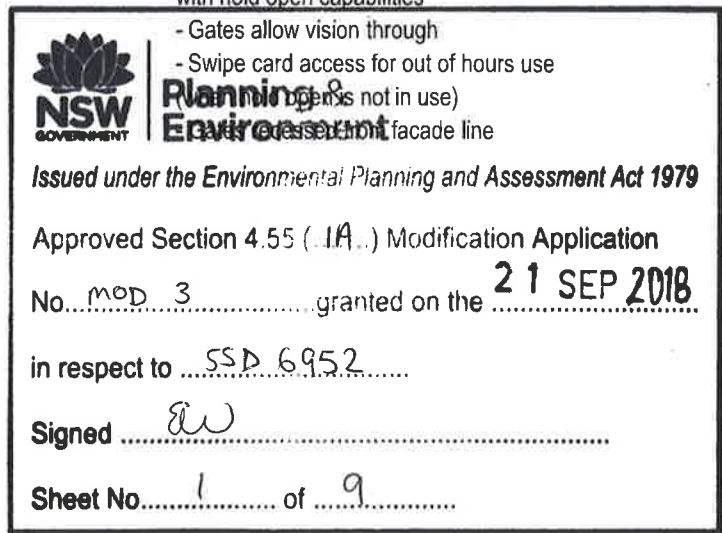

DRAWN BY ABN, AYDB, JH, MW, SB, CW, TS	
CHECKED PT	
1:100 @A1	
DRAWING NO A 1004	ISSUE A

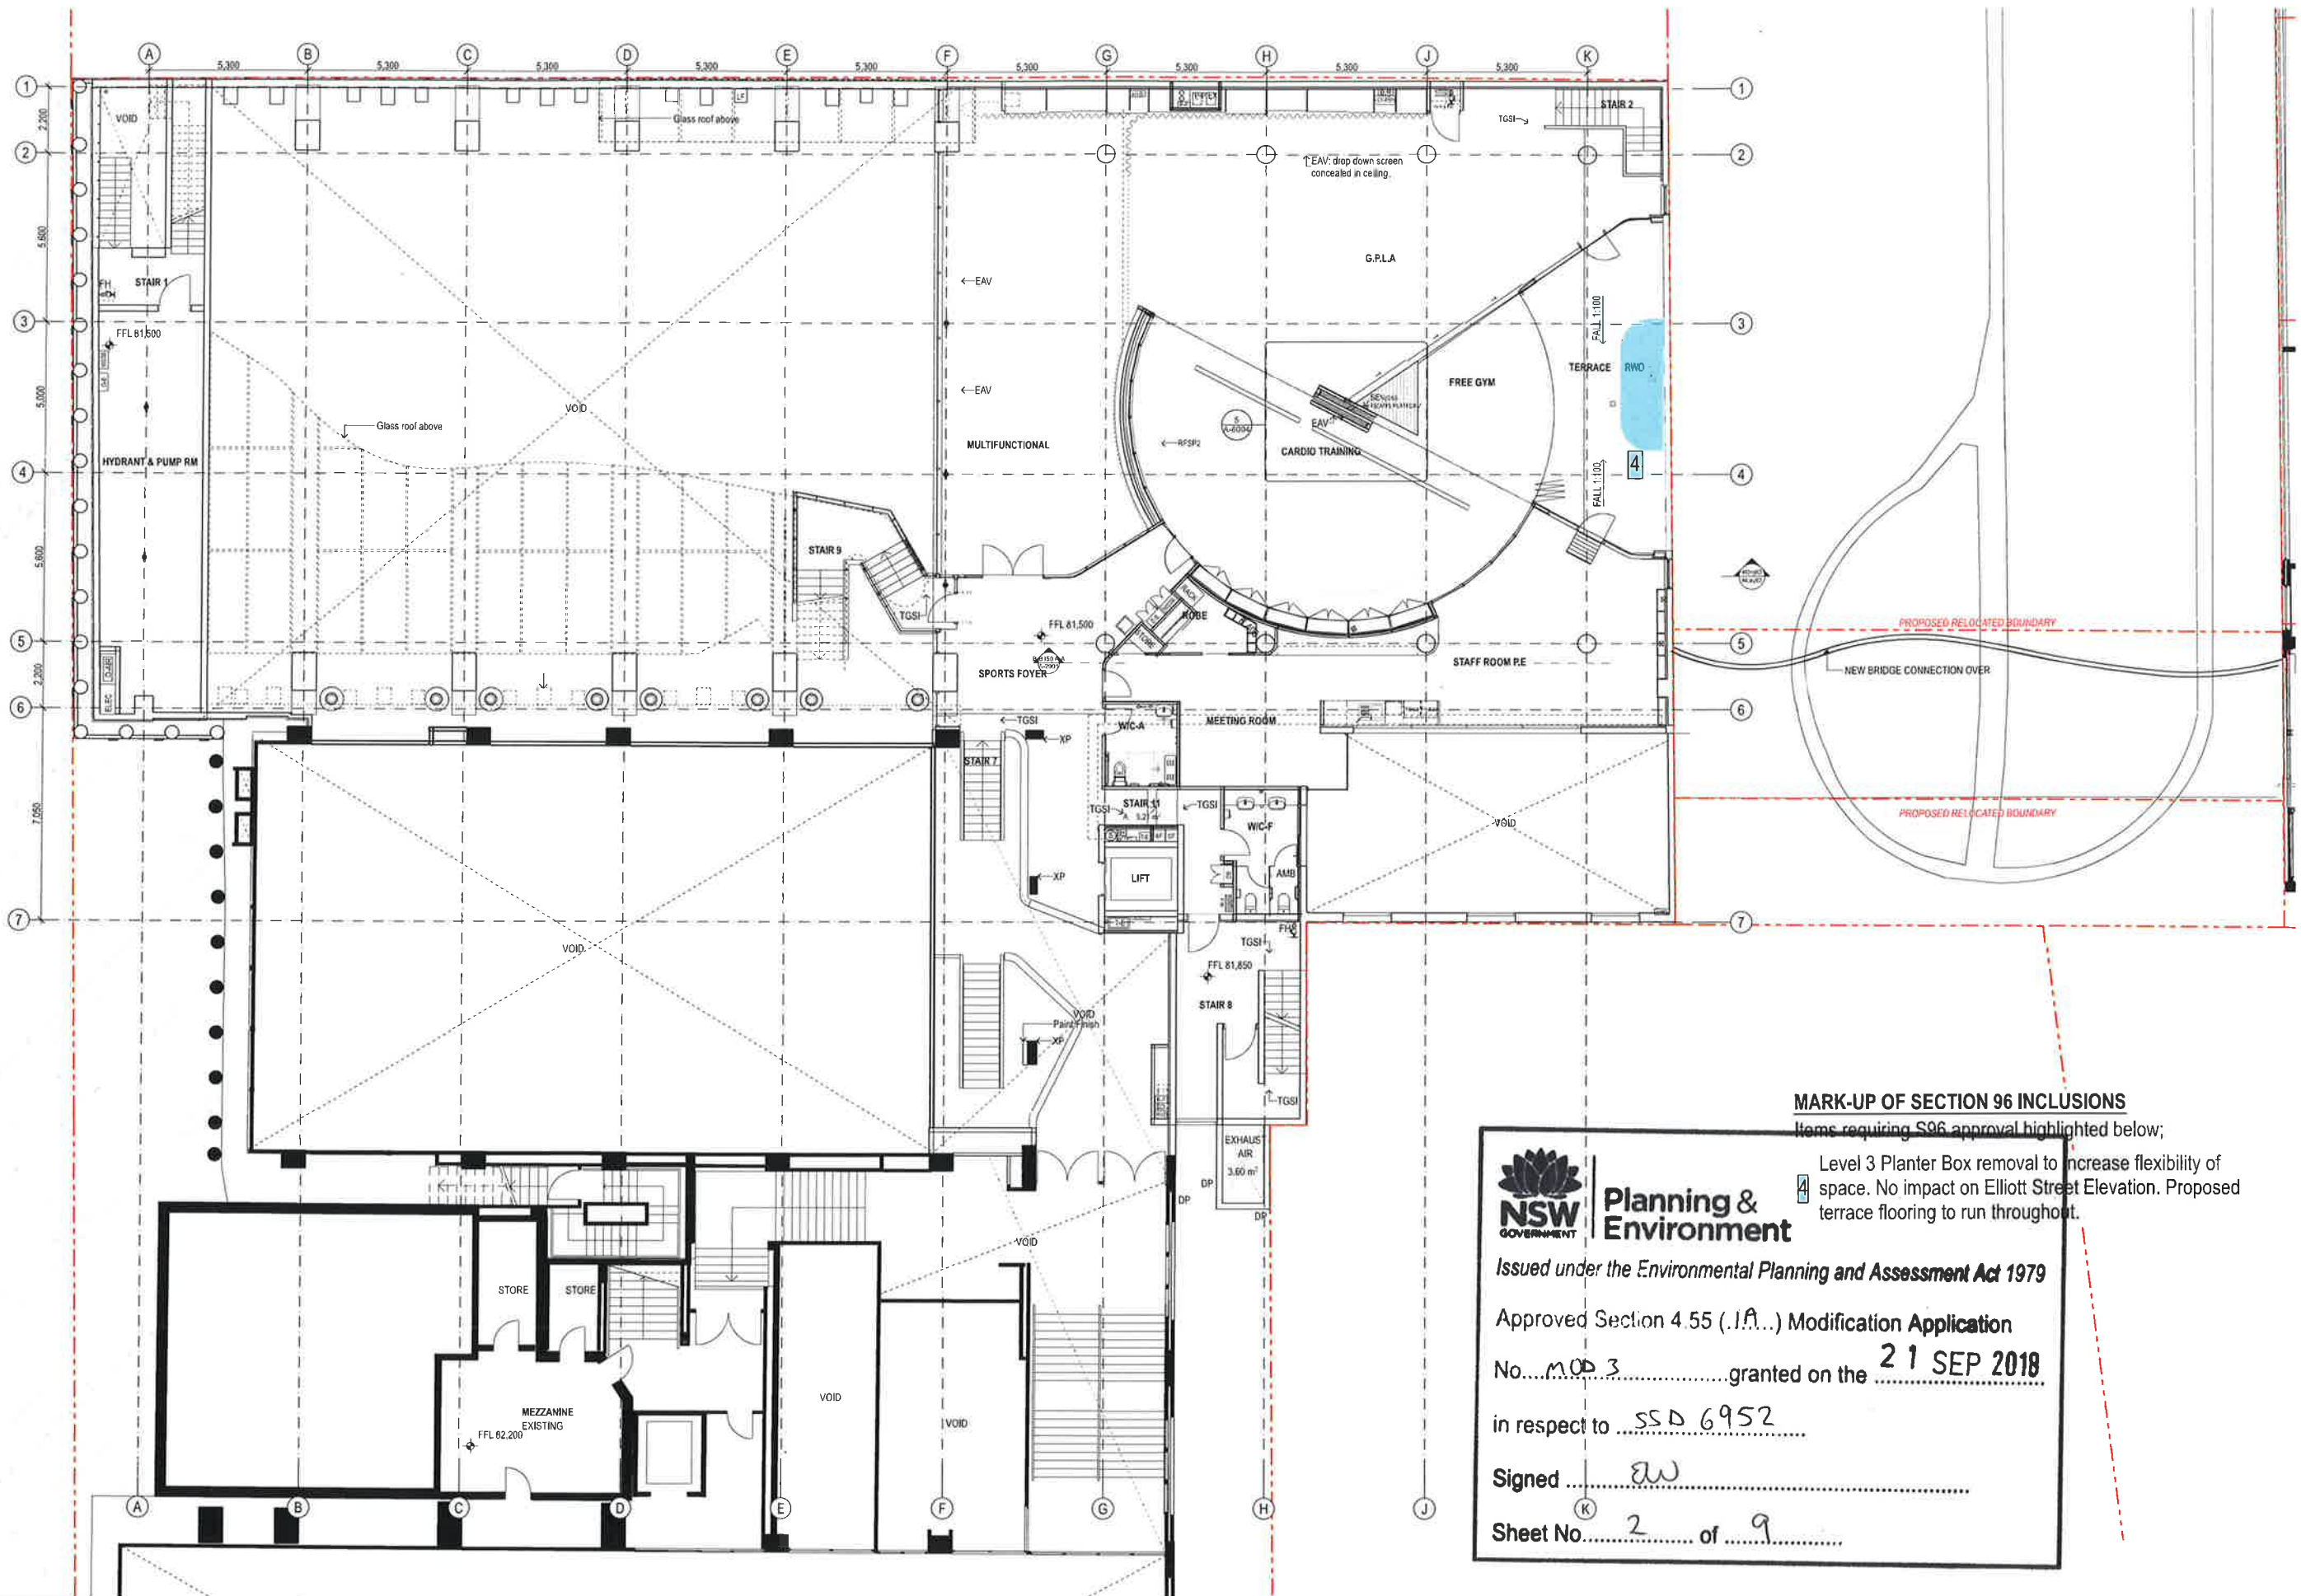

NOTES:
 Do not scale off drawings. Use figured dimensions only. Report any discrepancies to the architect. These designs, plans, specifications and the copyright therein are the property of Tonkin Zulaikha Greer Architects Pty Ltd, and must not be reproduced or copied wholly or in part without written permission of Tonkin Zulaikha Greer Architects Pty Ltd.

ACCESSIBILITY
 Munkie Gooling
 Phone: 9692 5322
 Email: mungie@mgac.com.au

QUANTITY SURVEYOR
 MDA Australia
 Damon Bissell
 Phone: 9929 8800
 Email: damon@mdo-aust.com.au

ELEC / MECH / LIFT/SECURITY
 MEDLAND METROPOLIS
 Chris Medland
 Phone: 403 444 410
 Email: cmedland@medlandmetropolis.com.au

ACOUSTIC ENGINEER
 WILKINSON MURRAY
 Brian Clarke
 Phone: 9437 4511
 Email: brian@wilkinsonmurray.com.au

BCA / PCA CONSULTANT
 BBA-G
 Tony Heaslop
 Phone: 9211 7777
 Email: tony@bba-plug.com.au

LANDSCAPE
 JBA
 Glenn Basso
 Phone: 9332 3001
 Email: glenn@jba.net.au

CLIENT:
 WENONA SCHOOL
 176 Walter Street North Sydney
 NSW, 2060
 Phone: 9405 4405
 Email: bmcpherson@wenona.nsw.edu.au

KITCHEN
 THE MACK GROUP
 JBA
 Kate Tuckhope
 Phone: 9550 6565
 Email: kate@themackgroup.com.au

PROJECT:
 WENONA
 PROJECT ARCHMEDES
 255-265 Miller Street, North Sydney NSW 2060
 PROJECT NO: 14010

ARCHITECT
 TONKIN ZULAIKHA GREER ARCHITECTS
 117 Reservoir Street
 ABN: 4600272349
 P: (02) 9215 4900
 F: (02) 9215 4901
 EMAIL: matilda@tbg.com.au
 WEB: www.tbg.com.au

DRAWING TITLE
 LEVEL 3 PLAN
 SCALES
 1:100 @A1
 PHASE
 SECTION 96 - REV C
 DRAWING NO
 A-1005
 ISSUE
 A

DRAWN BY
 ABN: AVO5, JH,
 MW, SB, CW, TS
 CHECKED PT



Planning & Environment

Issued under the Environmental Planning and Assessment Act 1979




Approved Section 4.55 (1A) Modification Application

No. MOD 3 granted on the 21 SEP 2018

in respect to SSD 6952

Signed Ew

Sheet No. 3 of 9

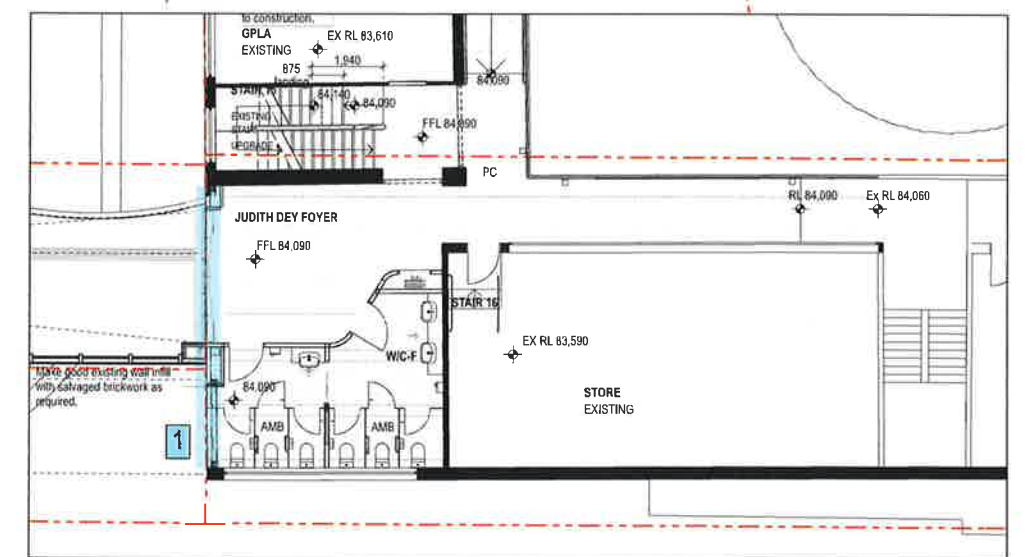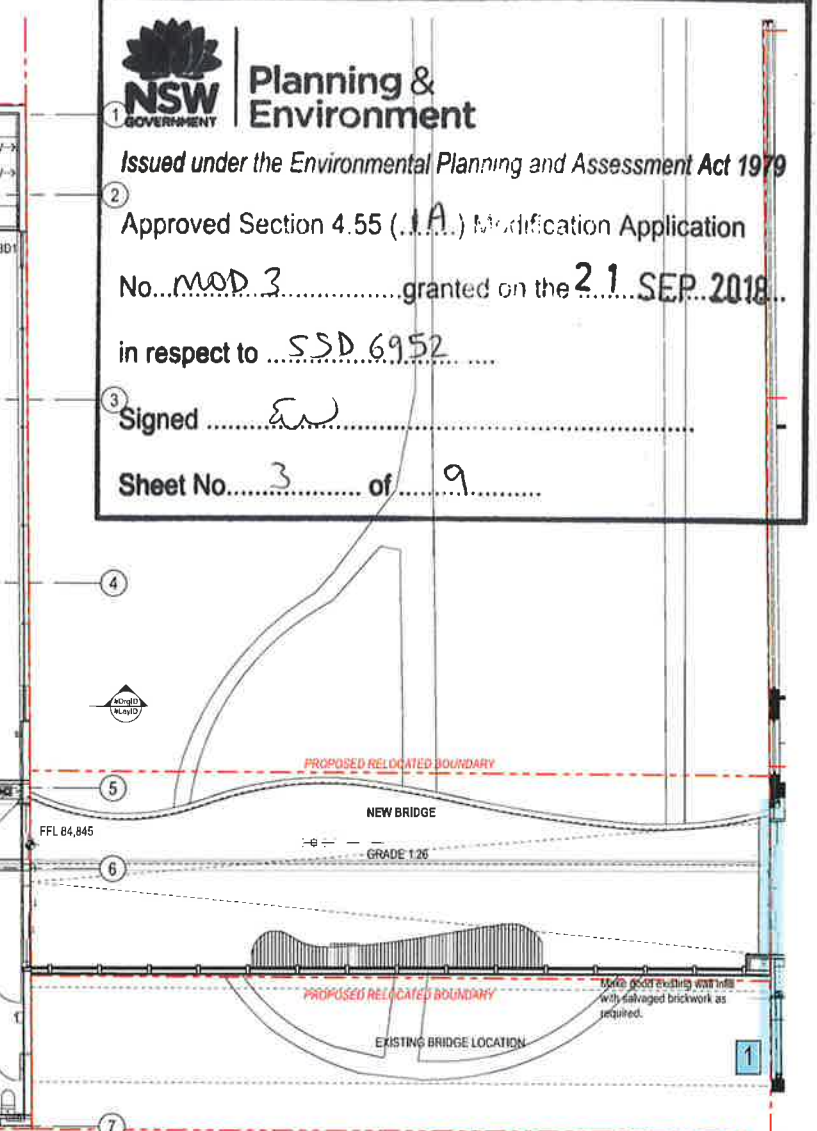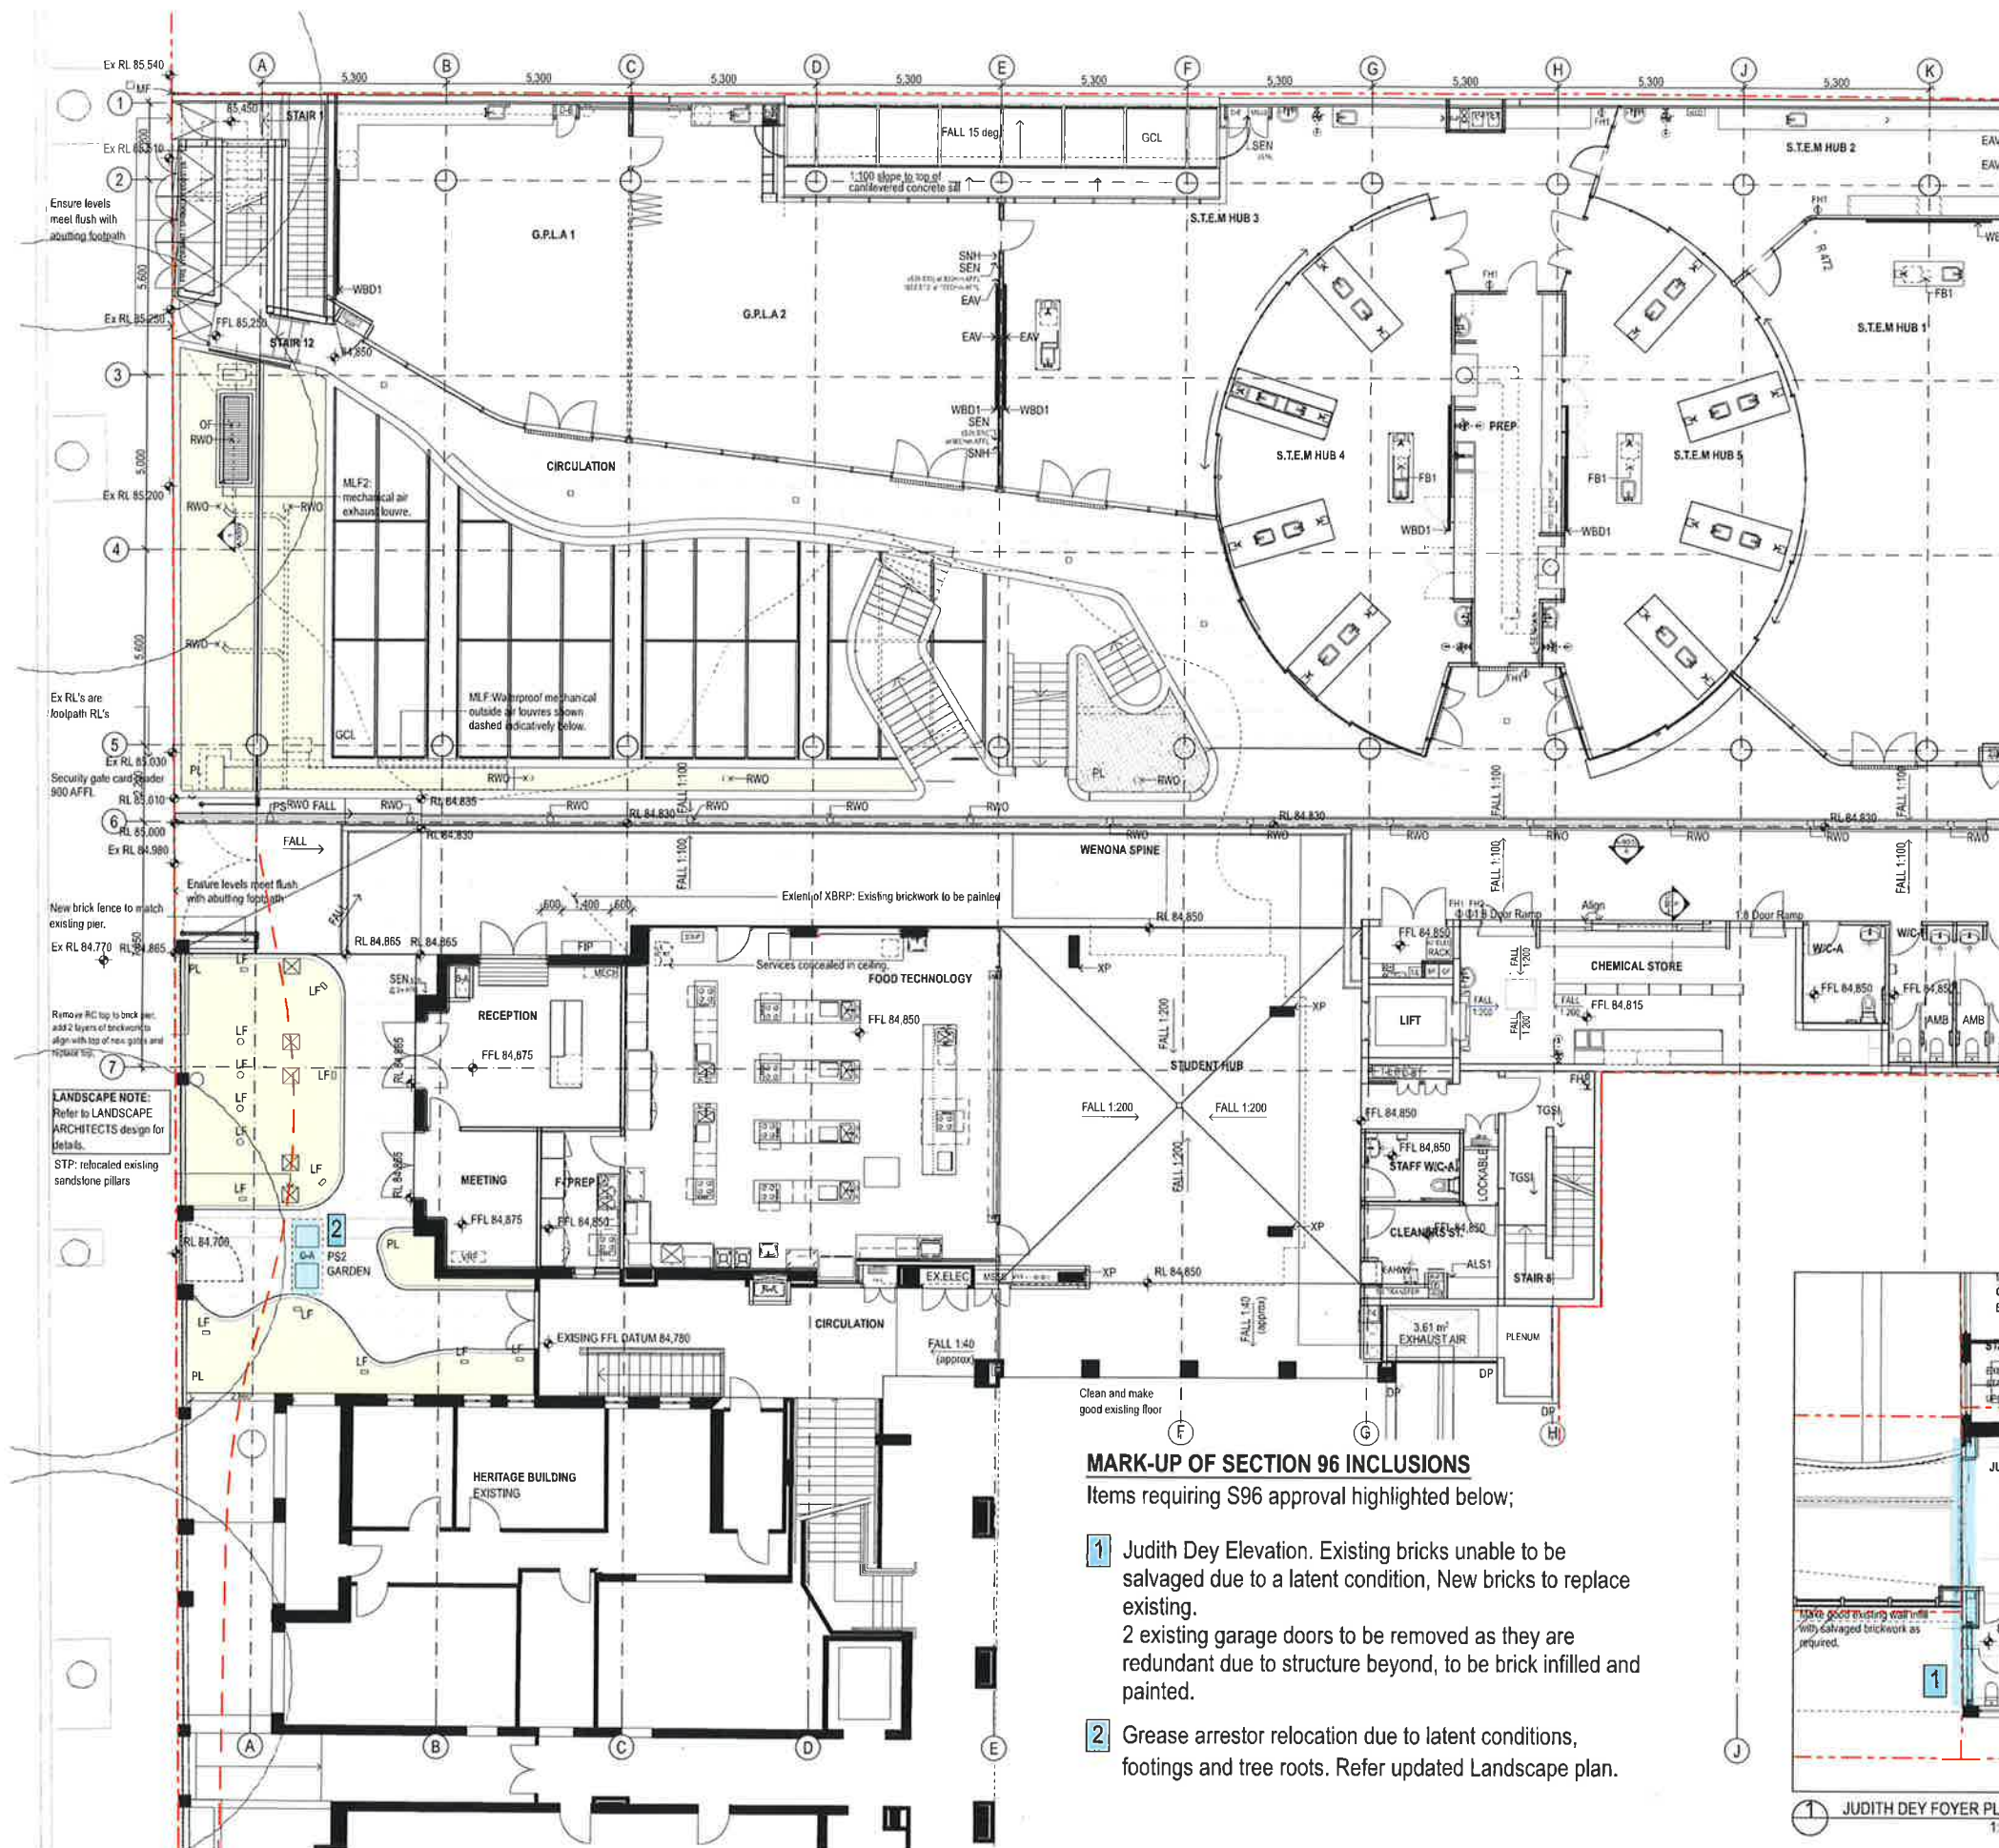

JUDITH DEY FOYER PLAN 1:100

NOTES:
Do not scale off drawings. Use figured dimensions only. Report any discrepancies to the architect. These designs, plans, specifications and the copyright therein are the property of Tonkin Zulaikha Greer Architects Pty Ltd, and must not be reproduced or copied wholly or in part without written permission of Tonkin Zulaikha Greer Architects Pty Ltd.

ACCESSIBILITY
Monika Geddy
Elena Meschter
Phone: 9692 9322
Email: elena@tongin.com.au

QUANTITY SURVEYOR
MDA Australia
Damon Bleasel
Phone: 9929 8000
Email: damon@mda-act.com.au

STRUCTURAL/CIVIL/FACADE
TTW
Richard Green
Phone: 9419 1288
Email: Richard.Green@ttw.com.au

ELEC / MECH / LIFT/SECURITY
MEDLAND METROPOLIS
Chris Clarke
Phone: 403 444 410
Email: chris@medlandmetropolis.com.au

ACOUSTIC ENGINEER
WILKINSON MURRAY
Brian Clarke
Phone: 9437 4511
Email: brian@wilkinsonmurray.com.au

IBCA / PCA CONSULTANT
BM+G
Tony Headup
Phone: 9211 7777
Email: tony@bmplus.com.au

LANDSCAPE
360
Gavin Dixon
Phone: 9332 3601
Email: gavin@360.net.au

KITCHEN
THE MACK GROUP
Teresa Mack
Phone: 9556 8566
Email: t.mack@themackgroup.com.au


CLIENT:
WENONA SCHOOL
176 Walker Street, North Sydney NSW 2060
Phone: 9409 4406
Email: hickens@wenona.nsw.edu.au

PROJECT:
WENONA
PROJECT ARCHIMEDES
255-265 Miller Street, North Sydney NSW 2060
PROJECT NO: 14010

ARCHITECT
TONKIN ZULAIKHA GREER ARCHITECTS
117 Reservoir Street
ABN: 4600272349
P: (02) 9215 4900
F: (02) 9215 4901
EMAIL: malinda@tongin.com.au
WEB: www.tongin.com.au

DRAWING TITLE
LEVEL 4 PLAN
SCALES
1:100 @A1
PHASE
SECTION 96 - REV C
DRAWING NO
A-1006
ISSUE
A

DRAWN BY
ABN, AVDB, JH,
MW, SE, CW, TS
CHECKED PT

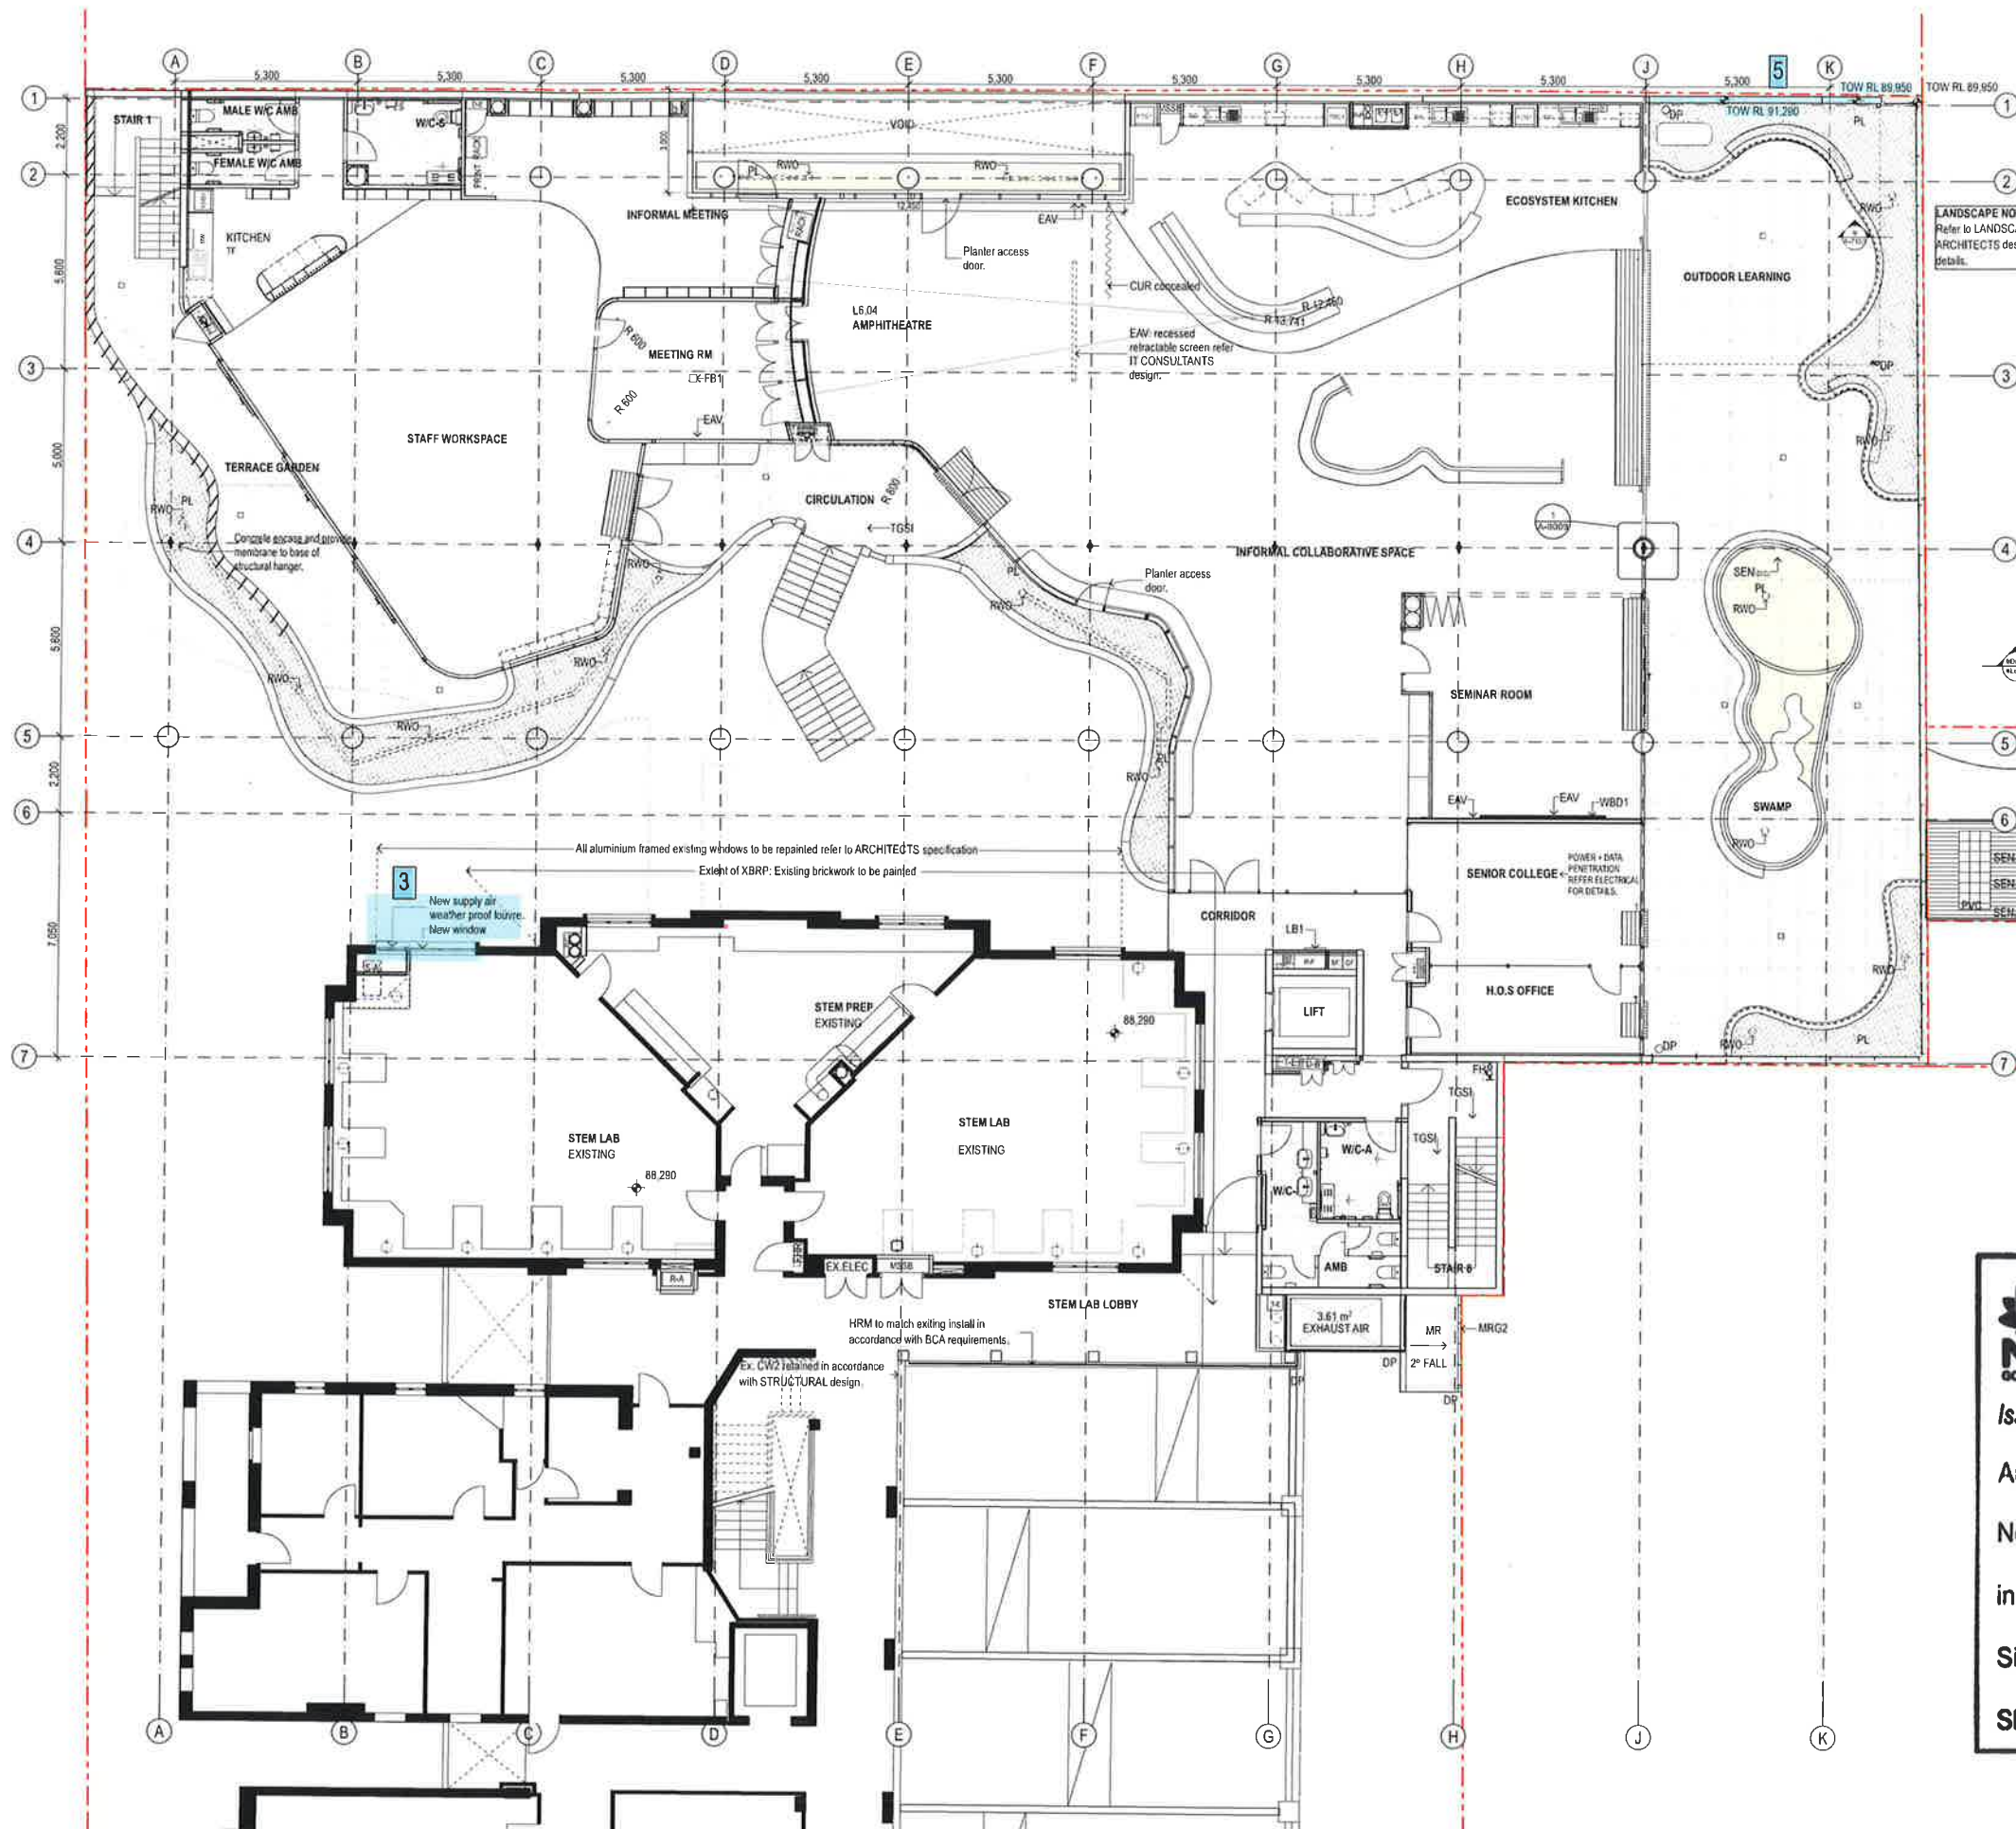

MARK-UP OF SECTION 96 INCLUSIONS

Items requiring S96 approval highlighted below;

- 3** Miller centre elevation, air supply louvre integrated beside existing window.
- 5** Boundary Wall Height change to overcome aesthetic and functional issues; waterproofing against existing building.

LANDSCAPE NOTE:
Refer to LANDSCAPE
ARCHITECTS design for
details.



Planning & Environment

Issued under the Environmental Planning and Assessment Act 1979

Approved Section 4.55 (1A...) Modification Application

No. MOD 3 granted on the **21 SEP 2018**

in respect to SSD 6952

Signed [Signature]

Sheet No. 4 of 9

NOTES:
Do not scale off drawings. Use figured dimensions only. Report any discrepancies to the architect. These designs, plans, specifications and the copyright therein are the property of Tonkin Zulaikha Greer Architects Pty Ltd, and must not be reproduced or copied wholly or in part without written permission of Tonkin Zulaikha Greer Architects Pty Ltd.

ACCESSIBILITY
Morris Godding
Barton Russell
Phone: 9929 2022
Email: mgodding@ngac.com.au

QUANTITY SURVEYOR
MDA Australia
Barton Russell
Phone: 9929 2020
Email: b.russell@mda-act.com.au

STRUCTURAL/CIVIL/FACADE
TTW
Richard Green
Phone: 9439 1288
Email: richard.green@ttw.com.au

ELEC / MECH / LIFT/SECURITY
MEDLAND METROPOLIS
Chris Medland
Phone: 403 444 410
Email: cmedland@medlandmetropolis.com.au

ACOUSTIC ENGINEER
WILKINSON MURRAY
Brian Clarke
Phone: 9437 4511
Email: brian.clarke@wilkinsonmurray.com.au

BCA / PCA CONSULTANT
BM+G
Tony Hoaglin
Phone: 9211 7777
Email: tony@bmplusg.com.au

LANDSCAPE
360
Glen Dixon
Phone: 9332 3601
Email: glenn@360.net.au

KITCHEN
THE MACK GROUP
Teresa Mack
Phone: 9350 9558
Email: t.mack@thehackgroup.com.au

CLIENT:
WENONA SCHOOL
176 Walker Street, North Sydney NSW 2060
Phone: 9409 4405
Email: hmcenroe@wenona.nsw.edu.au

PROJECT:
WENONA
PROJECT ARCHIMEDES
255-265 Miller Street, North Sydney NSW 2060
PROJECT NO: 14010


ARCHITECT
TONKIN ZULAIKHA GREER ARCHITECTS
117 Reservoir Street
ABN: 4600272349
P: (02) 9215 4900
F: (02) 9215 4901
EMAIL: malinda@tzg.com.au
WEB: www.tzg.com.au

DRAWING TITLE
LEVEL 5 PLAN
SCALES
1:100 @A1
PHASE
SECTION 96 - REV C
DRAWING NO
A-1007
ISSUE
A

DRAWN BY
ABN, AVDB, JH,
MW, SB, CW, TS
CHECKED PT

MARK-UP OF SECTION 96 INCLUSIONS
Items requiring S96 approval highlighted below;

Operable Gates

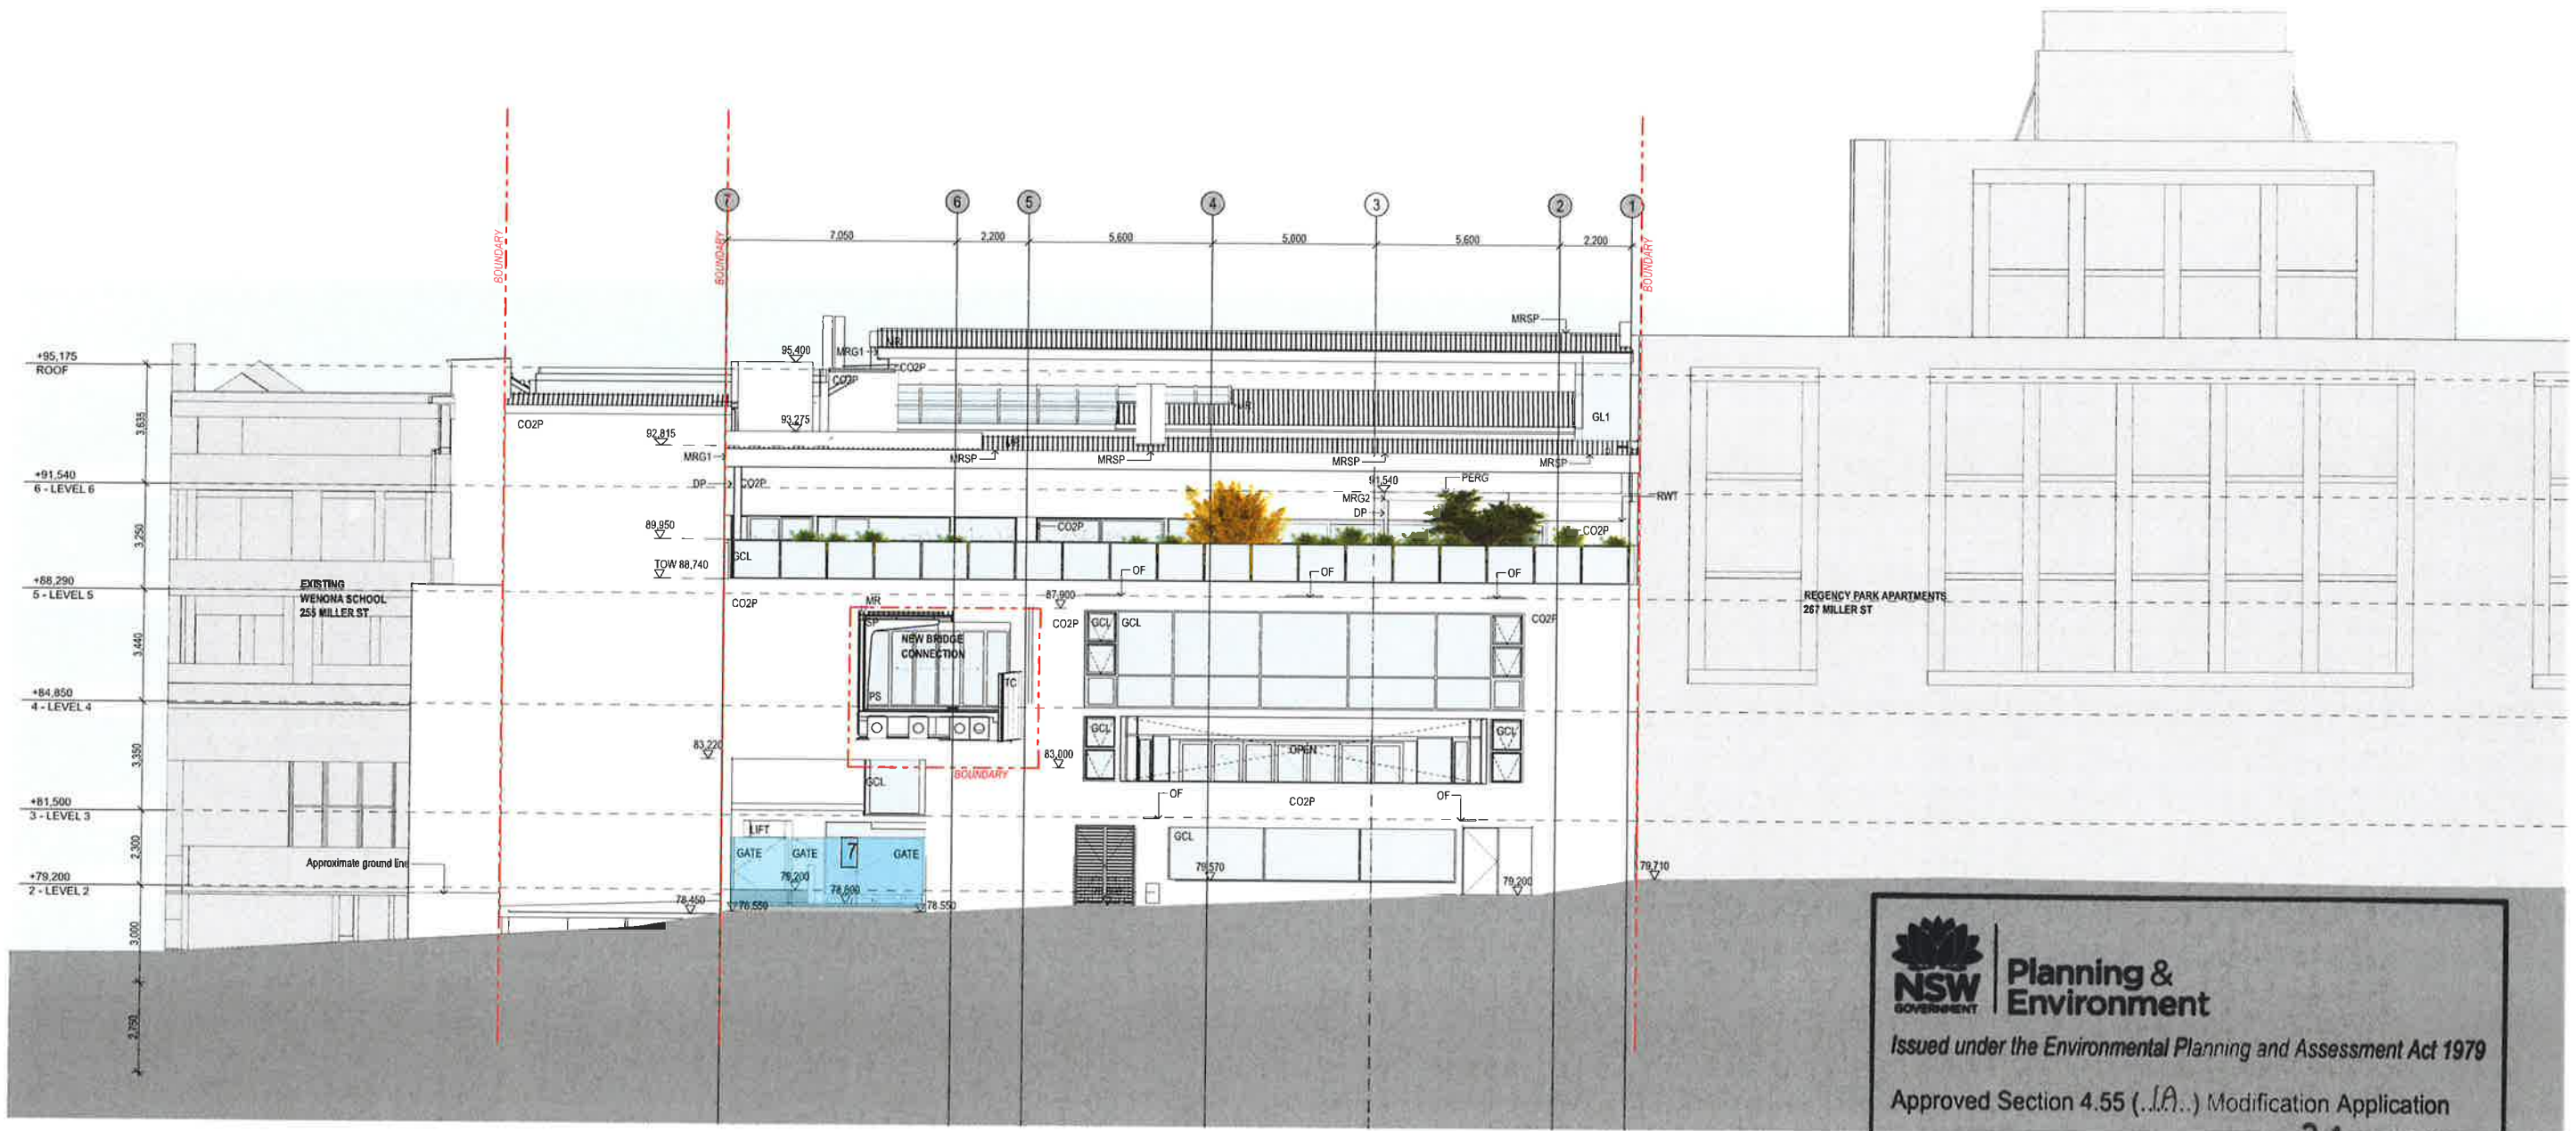

Planning & Environment

Issued under the Environmental Planning and Assessment Act 1979

Approved Section 4.55 (A) Modification Application




No. mod 3 granted on the 21 SEP 2018

in respect to SSD 6952

Signed EW

Sheet No. 5 of 9

NOTES: Do not scale off drawings. Use figured dimensions only. Report any discrepancies to the architect. These designs, plans, specifications and the copyright therein are the property of Tonkin Zulaikha Greer Architects Pty Ltd, and must not be reproduced or copied wholly or in part without written permission of Tonkin Zulaikha Greer Architects Pty Ltd.	ACCESSIBILITY Morris Goding Elisa Moechler Phone: 9592 5022 Email: elisa@tongin.com.au	QUANTITY SURVEYOR MDA Australia Damen Bisset Phone: 9592 5000 Email: damen@mda.com.au	ELEC / MECH / LIFT/SECURITY MEDLAND METROPOLIS Chris Medland Phone: 400 444 410 Email: cmedland@medlandmetropolis.com.au	ACOUSTIC ENGINEER WILKINSON MURRAY Brian Clarke Phone: 9437 4511 Email: brian@wilkinsonmurray.com.au	BCA / PCA CONSULTANT BM-G Tory Heaslip Phone: 9211 7777 Email: tony@bmplang.com.au	LANDSCAPE 348 Glenn Dixon Phone: 9332 3801 Email: glenn@348.net.au	CLIENT: WENONA SCHOOL 176 Walker Street, North Sydney NSW 2060 Phone: 9409 4405 Email: bmcpherson@wenona.nsw.edu.au	PROJECT: WENONA PROJECT ARCHIMEDES 255-265 Miller Street, North Sydney NSW 2060 PROJECT NO: 14010	ARCHITECT TONKIN ZULAIKHA GREER ARCHITECTS 117 Reserve Street ABN: 46002722349 P: (02) 9215 4900 F: (02) 9215 4901 EMAIL: mail@tongin.com.au WEB: www.tongin.com.au	DRAWING TITLE ELEVATION ELLIOTT STREET	DRAWN BY ABN, AVDB, JH, MW, SB, CW, TS CHECKED PT
	POOL Collingridge Associates Bob Collingridge Phone: 9472 4511 Email: bob@collingridge.net.au	STRUCTURAL/CIVIL/FACADE TTW Richard Green Phone: 9439 7266 Email: Richard.Green@ttw.com.au	HYDRAULIC / FIRE ENGINEER Warren Smith Grahame Barnes Phone: 9269 1312 Email: graham@warrensmith.com.au	FIRE SAFETY ENGINEER Exiva James Dominguez Phone: 9267 1000 Email: james.dominguez@exiva.com	TOWN PLANNER JBA Kala Tudehope Phone: 9556 6662 Email: Ktudehope@jurban.com.au	KITCHEN THE MACK GROUP Teresa Mack Phone: 5550 0565 Email: -	tonkin greer 4601 14010	SCALES 1:100 @A1	DRAWING NO A-2002	ISSUE A	

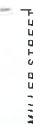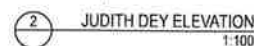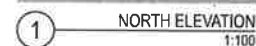

- 6 New Toilet Exhaust Vent, replacing removed existing contained within window.



TERN	DRAWN BY ABN, AYDB, JH, MW, SB, CW, TS
00 @A1	CHECKED PT
WING NO	ISSUE

MARK-UP OF SECTION 96 INCLUSIONS

Items requiring S96 approval highlighted below;

- 5 Boundary Wall Height change to overcome aesthetic and functional issues; waterproofing against existing building.



Planning & Environment

Issued under the Environmental Planning and Assessment Act 1979


Approved Section 4 55 (1A) Modification Application

No. MSD 3 granted on the 21 SEP 2018

in respect to SSD 6952

Signed EW

Sheet No. 7 of 9

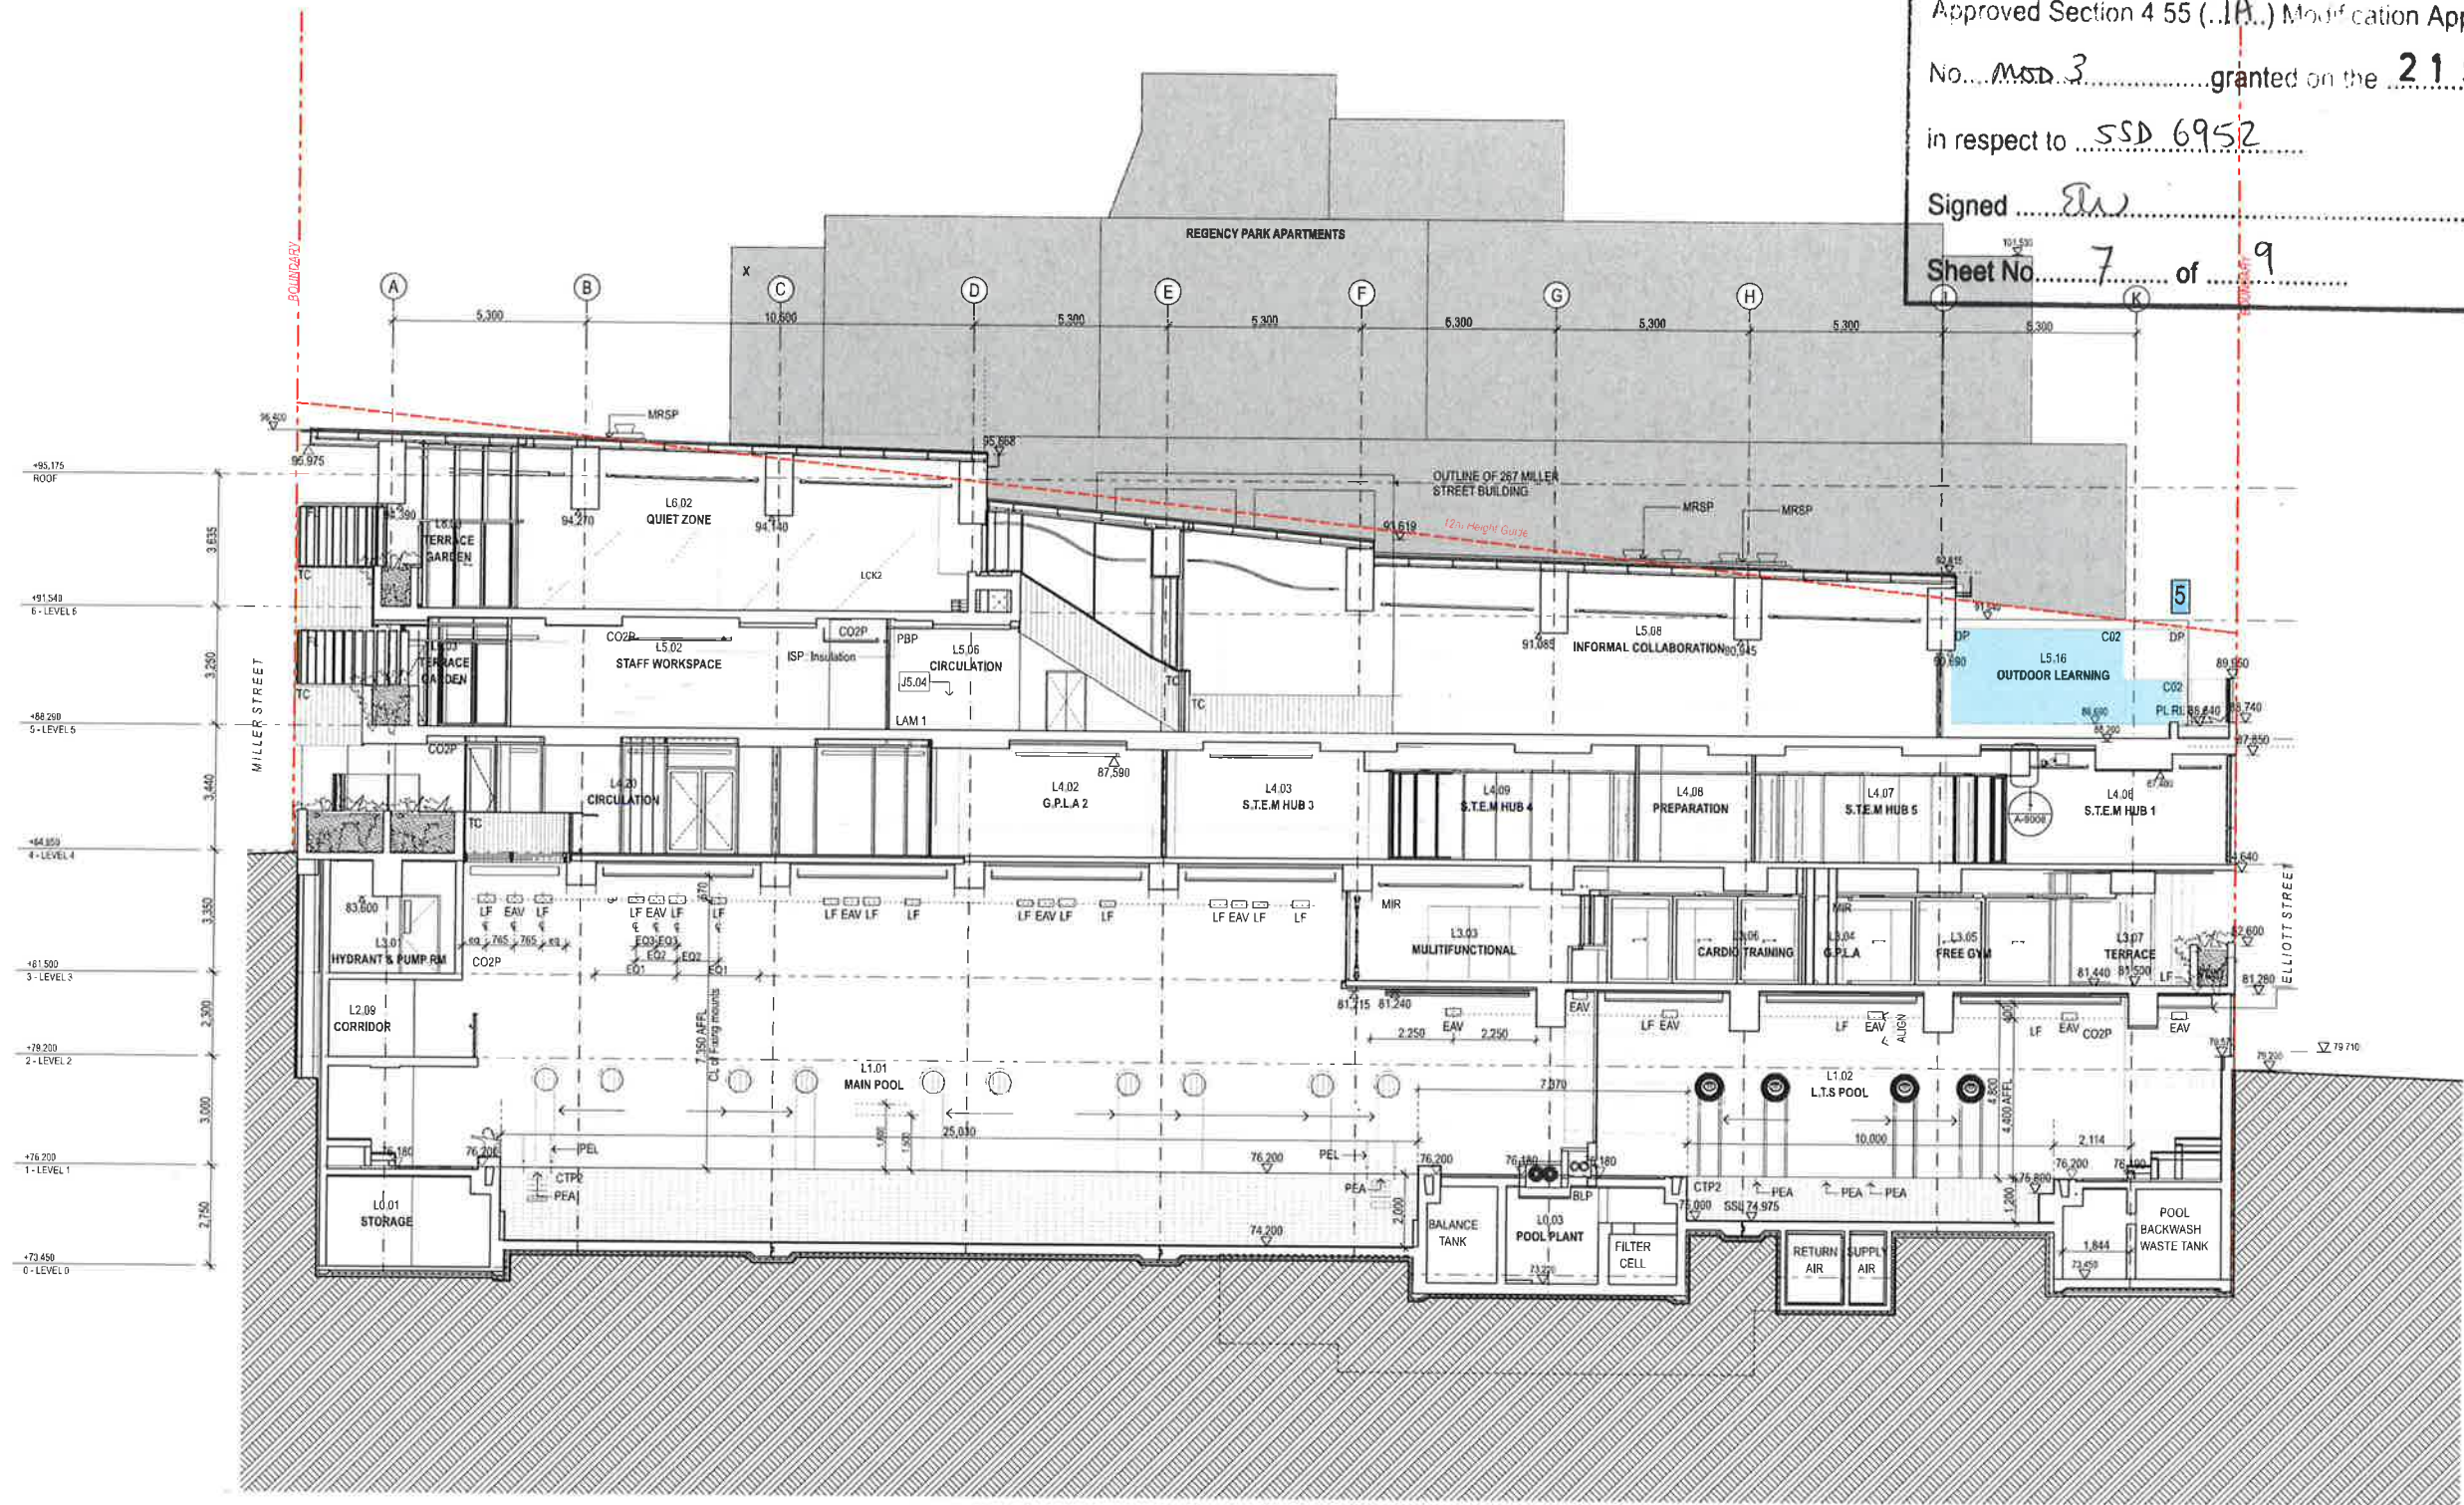

NOTES:
Do not scale off drawings. Use figured dimensions only. Report any discrepancies to the architect. These designs, plans, specifications and the copyright therein are the property of Tonkin Zulaikha Greer Architects Pty Ltd. and must not be reproduced or copied wholly or in part without written permission of Tonkin Zulaikha Greer Architects Pty Ltd.

ACCESSIBILITY
Manda Goding
Phone: 9592 9322
Email: mnda@mgac.com.au

POOL
Collingridge Associates
Bob Collingridge
Phone: 9432 1811
Email: rcollingridge@collingridge.net.au

QUANTITY SURVEYOR
MDA Australia
Damen Bissell
Phone: 9929 8000
Email: damen@mda-aus.com.au

STRUCTURAL/CIVIL/FACADE
TTW
Richard Green
Phone: 9433 7288
Email: richard.green@ttw.com.au

ELEC / MECH / LIFT/SECURITY
MEDLAND METROPOLIS
Chris Medland
Phone: 400 444 410
Email: cmedland@medlandmetropolis.com.au

HYDRAULIC / FIRE ENGINEER
Warren Smith
Graham Smith
Phone: 9599 1312
Email: graham@warrensmith.com.au

ACOUSTIC ENGINEER
WILKINSON MURRAY
Brian Clarke
Phone: 9437 4511
Email: brian@wilkinsonmurray.com.au

FIRE SAFETY ENGINEER
Exova
James Dominguez
Phone: 9187 1900
Email: james.dominguez@exova.com

BCA / PCA CONSULTANT
BMH
Tony Heslop
Phone: 9211 7777
Email: tony@bmhplg.com.au

TOWN PLANNER
JBA
Kala Todorova
Phone: 9559 6962
Email: ktodorova@jbaurban.com.au

LANDSCAPE
368
Glenn Dixon
Phone: 9332 3801
Email: glenn@368.net.au

KITCHEN
THE MACK GROUP
Teresa Mack
Phone: 9550 0556
Email: -


CLIENT:
WENONA SCHOOL
176 Walter Street, North Sydney NSW 2060
Phone: 9459 4405
Email: hmckenzie@wenona.nsw.edu.au

PROJECT:
WENONA
PROJECT ARCHIMEDES
255-265 Miller Street, North Sydney NSW 2060
PROJECT NO : 14010

ARCHITECT
TONKIN ZULAIKHA GREER ARCHITECTS
117 Reservoir Street
ABN: 46007272349
P: (02) 9215 4900
F: (02) 9215 4901
EMAIL: malida@tzg.com.au
WEB: www.tzg.com.au


DRAWING TITLE
SECTION AA
SCALES
1:100 @A1
PHASE
SECTION 96 - REV C
DRAWING NO
A-3000
ISSUE
A

DRAWN BY
ASN, ADB, JH,
MW, SB, CW, TS
CHECKED PT

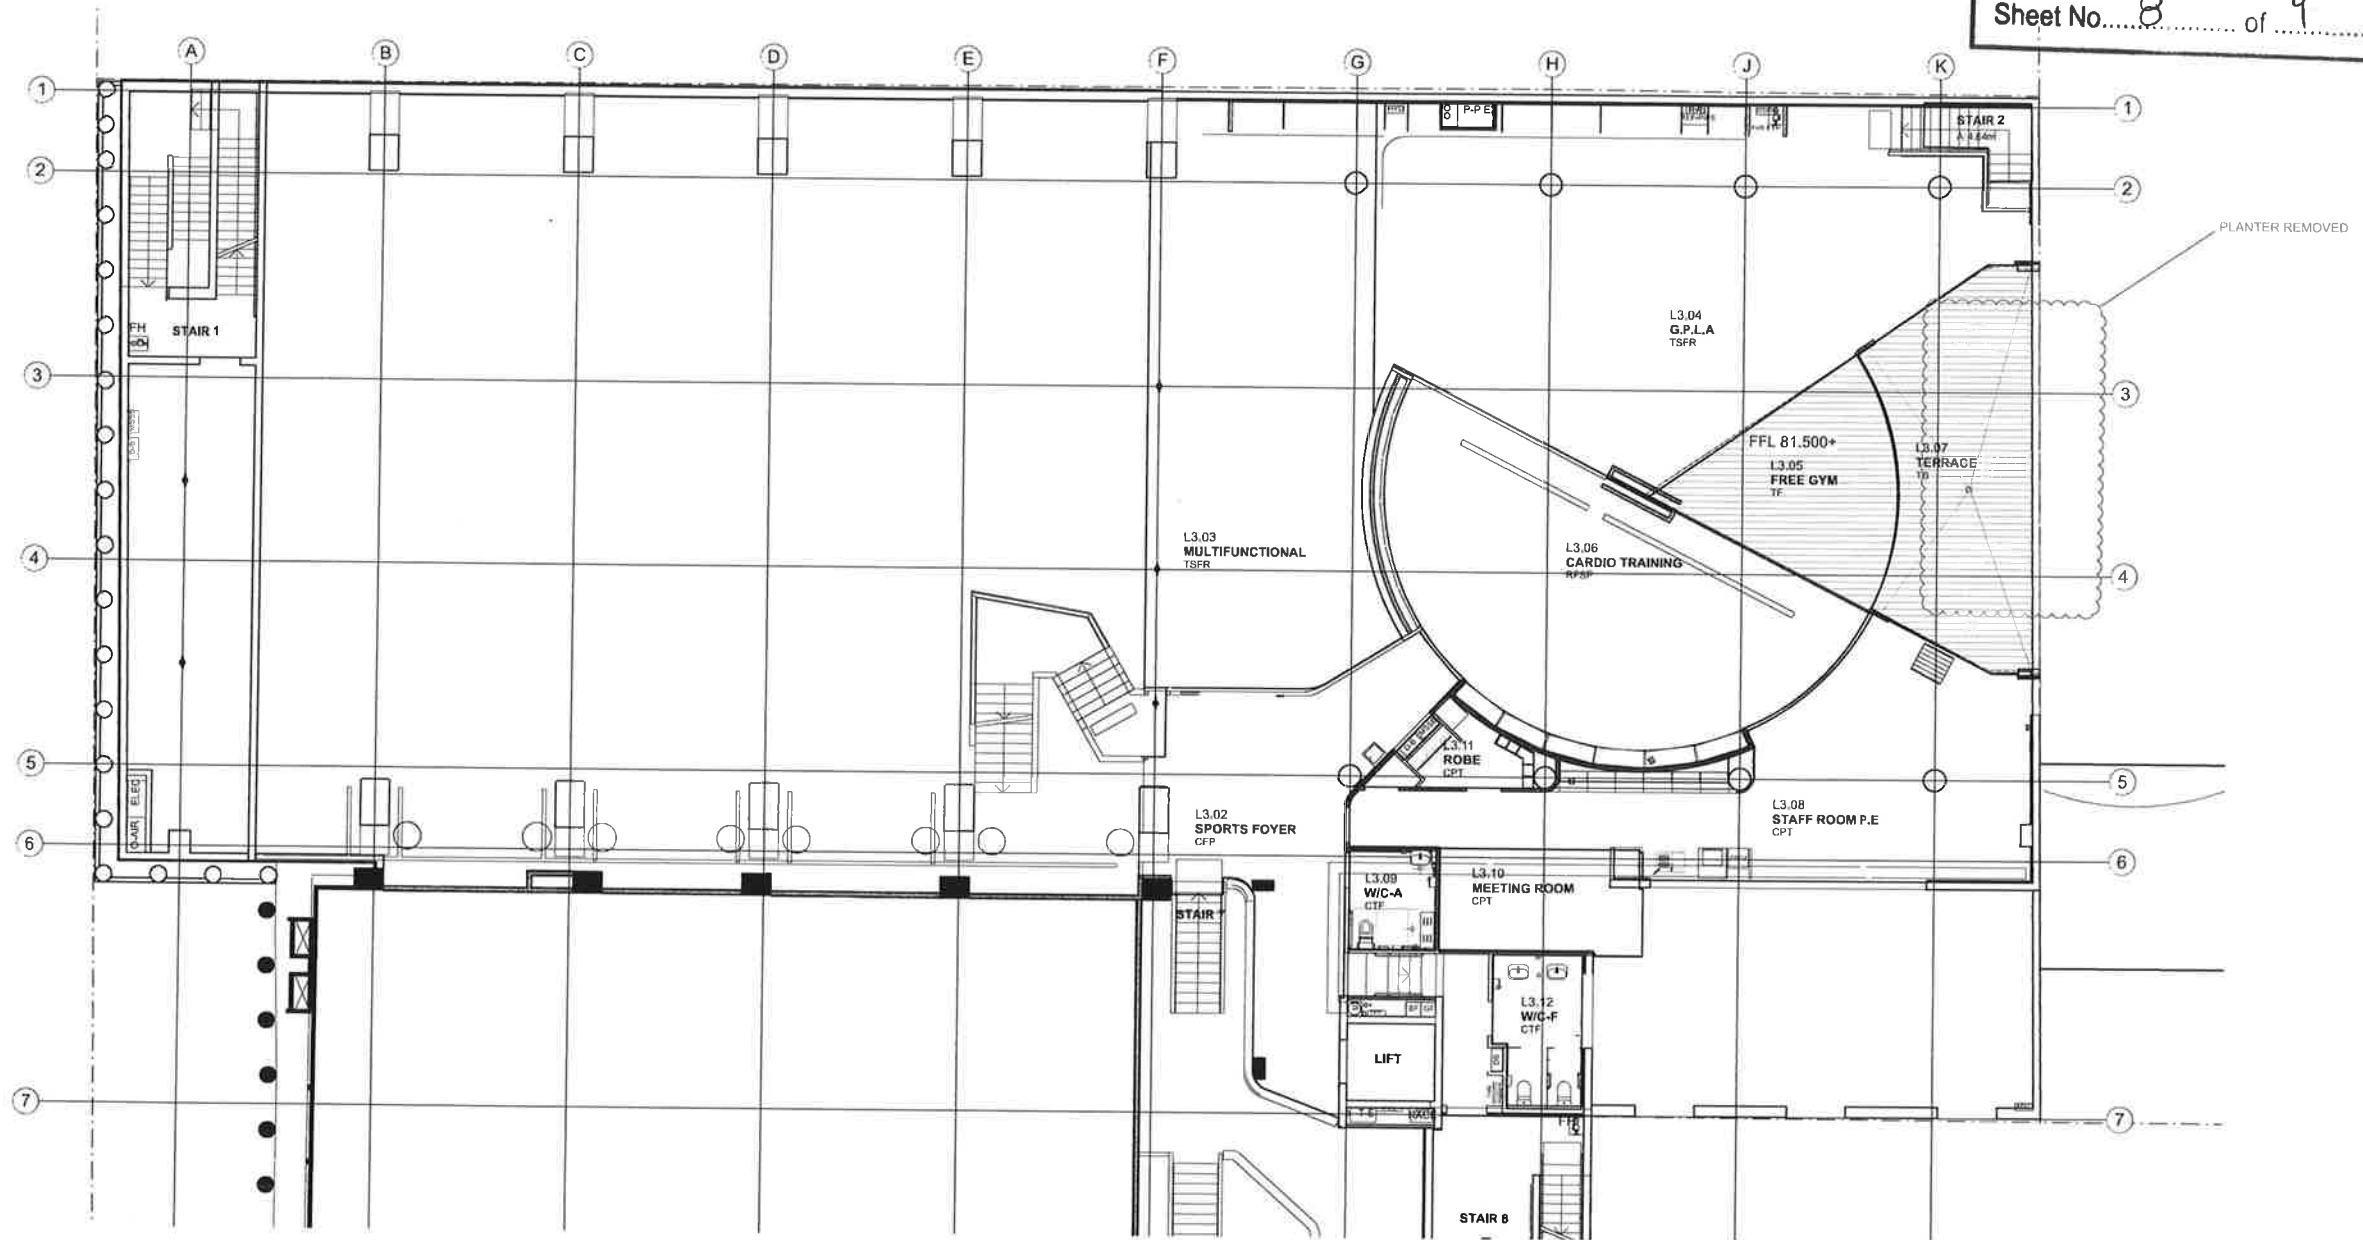

Note:
Irrigation to be installed
in all garden beds

Rev	Amendment	Date	By
A	Client Presentation	08/04/16	BP
B	Section 96	14/06/16	GD
C	Section 96- planter removed (draft)	09/04/18	GD
D	Section 96- planter removed	02/05/18	GD

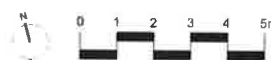

IMPORTANT NOTES
1. All works shall be completed by the date specified in the contract.
2. The contractor shall be responsible for obtaining all necessary permits and approvals.
3. The contractor shall ensure that all work is completed in accordance with the approved plans and specifications.
4. The contractor shall maintain access to all services and facilities at all times.
5. The contractor shall ensure that all work is completed in a safe and sound manner.
6. The contractor shall ensure that all work is completed in a timely manner.
7. The contractor shall ensure that all work is completed in a professional manner.
8. The contractor shall ensure that all work is completed in a cost-effective manner.
9. The contractor shall ensure that all work is completed in a sustainable manner.
10. The contractor shall ensure that all work is completed in a responsible manner.

CLIENT
Wenona School

CHECKED
GD

DRAWN
BP

STAGE
S96

SCALE
1:100 @ A1

DWG. TITLE
Level 3 Landscape Plan

PROJECT
Wenona Project Archimedes

360°
Studio 1, 1 Mary's Place
Sunnyvale, NSW 2150
P 02 9533 3501
W 360° real live
ABN 60 146 901 322

LA-S96-02

