


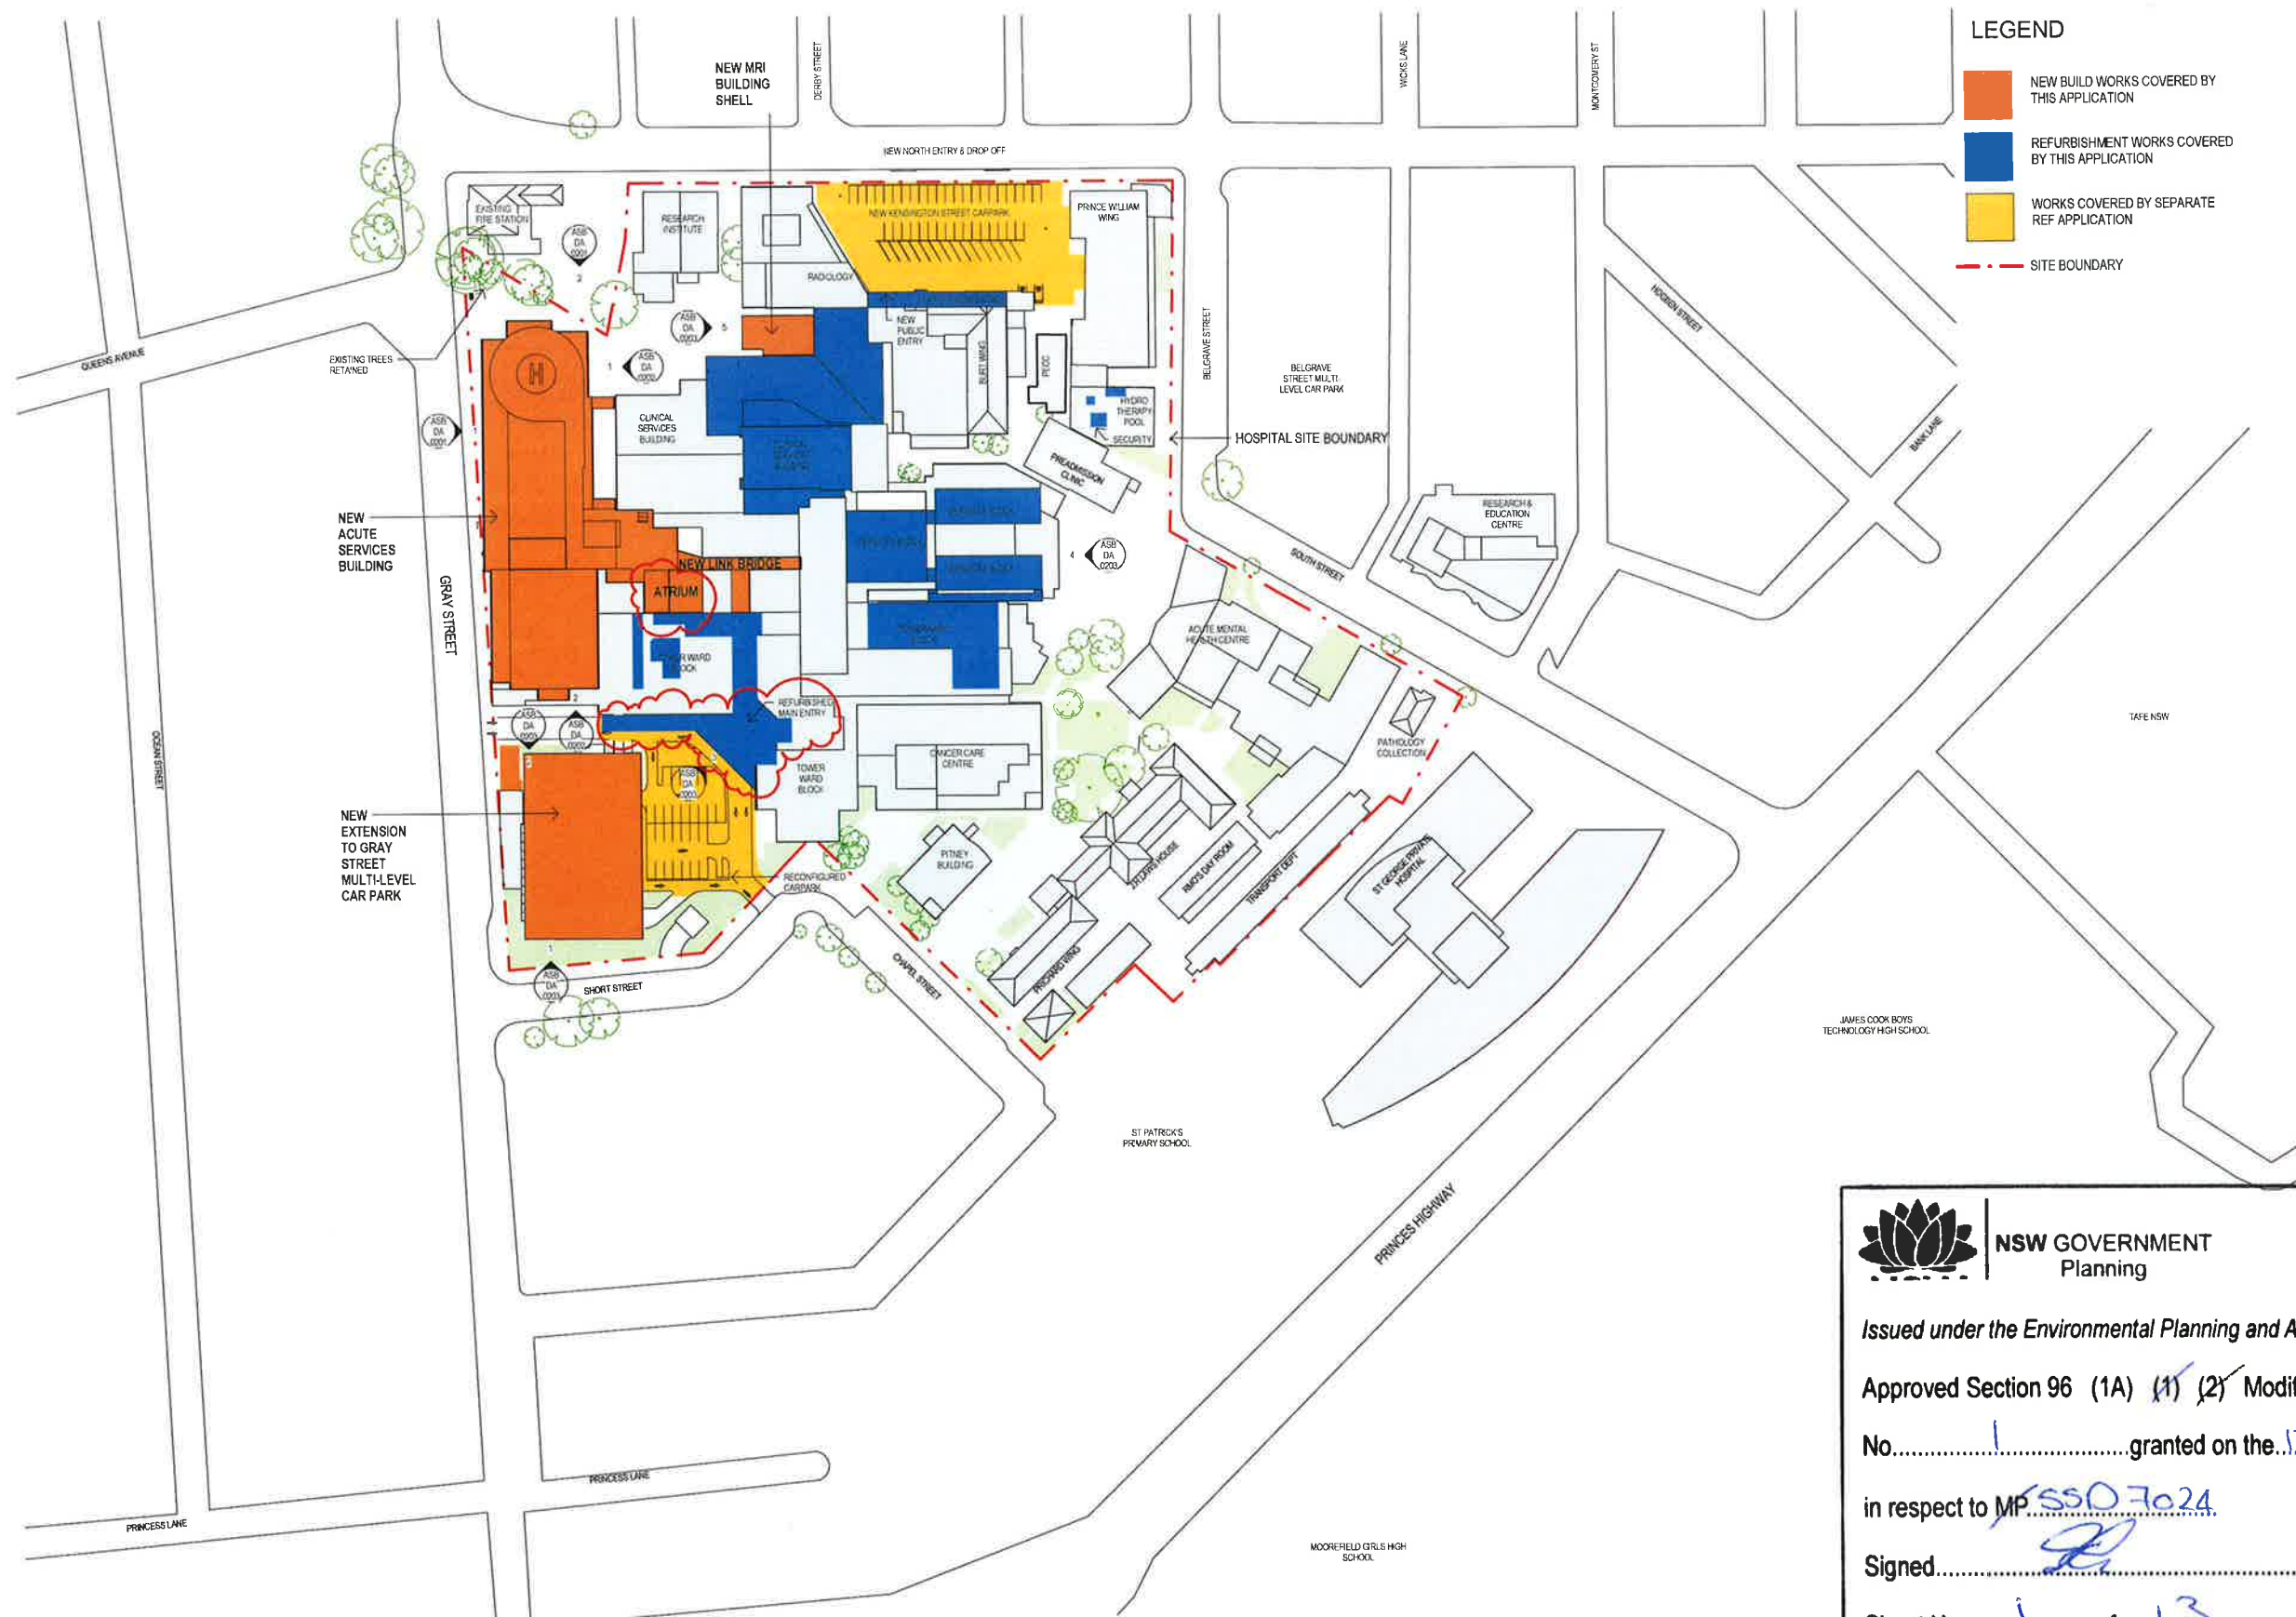

- LEGEND**
- NEW BUILD WORKS COVERED BY THIS APPLICATION
 - REFURBISHMENT WORKS COVERED BY THIS APPLICATION
 - WORKS COVERED BY SEPARATE REF APPLICATION
 - SITE BOUNDARY

1 Proposed Site Plan
1 : 1000

NSW GOVERNMENT Planning

Issued under the Environmental Planning and Assessment Act 1979

Approved Section 96 (1A) (1) (2) Modification Application

No.1..... granted on the 17/12/2015

in respect to MP SS07024

Signed.....

Sheet No. 1 of 13

24/11/2015 12:15:15 PM


0 10m 30m 60m 100m



ASB DA 0102
Ground Floor Plan
Scale: 1:500
Date: 23.11.15 Rev: 6

NOTE: INTERNAL LAYOUT INDICATIVE ONLY

0 5m 15m 30m 50m

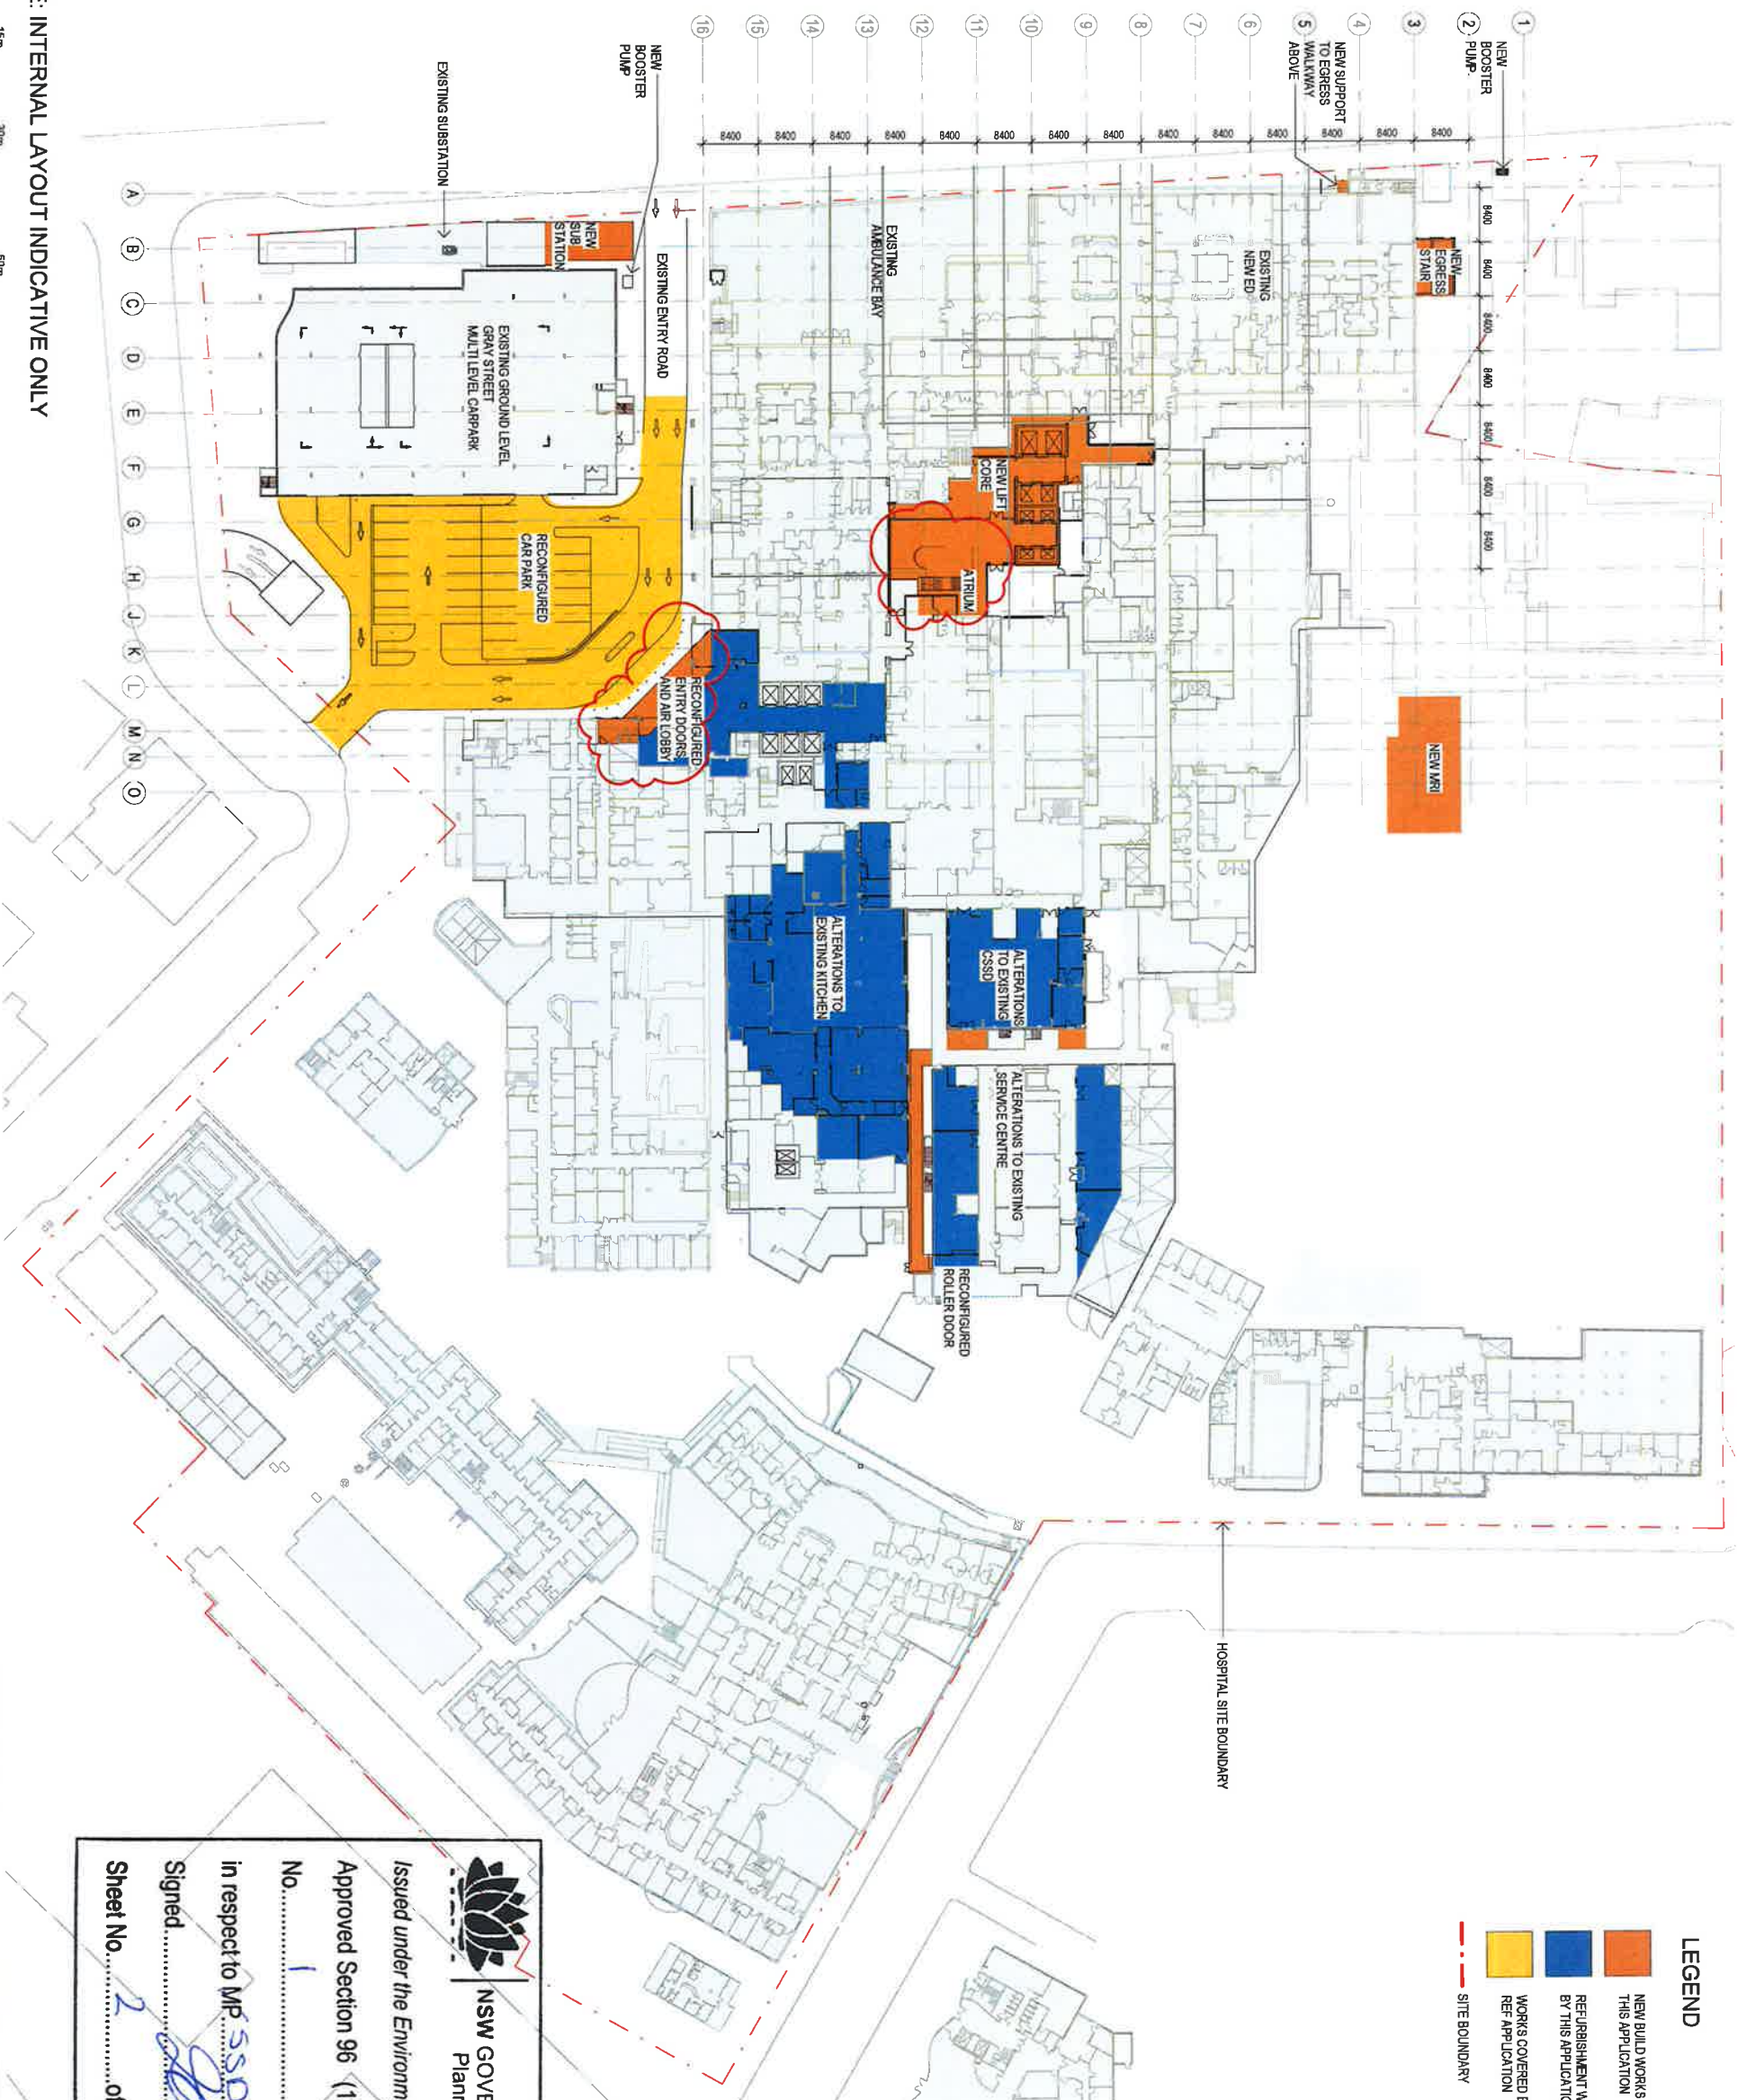


LEGEND

- NEW BUILD WORKS COVERED BY THIS APPLICATION
- REFURBISHMENT WORKS COVERED BY THIS APPLICATION
- WORKS COVERED BY SEPARATE REF APPLICATION
- SITE BOUNDARY



NSW GOVERNMENT
Planning

Issued under the Environmental Planning and Assessment Act 1979
Approved Section 96 (1A) (1) (2) Modification Application
No. 1 granted on the 13/12/2015
in respect to MP 550 7024
Signed: [Signature]
Sheet No. 2 of 13

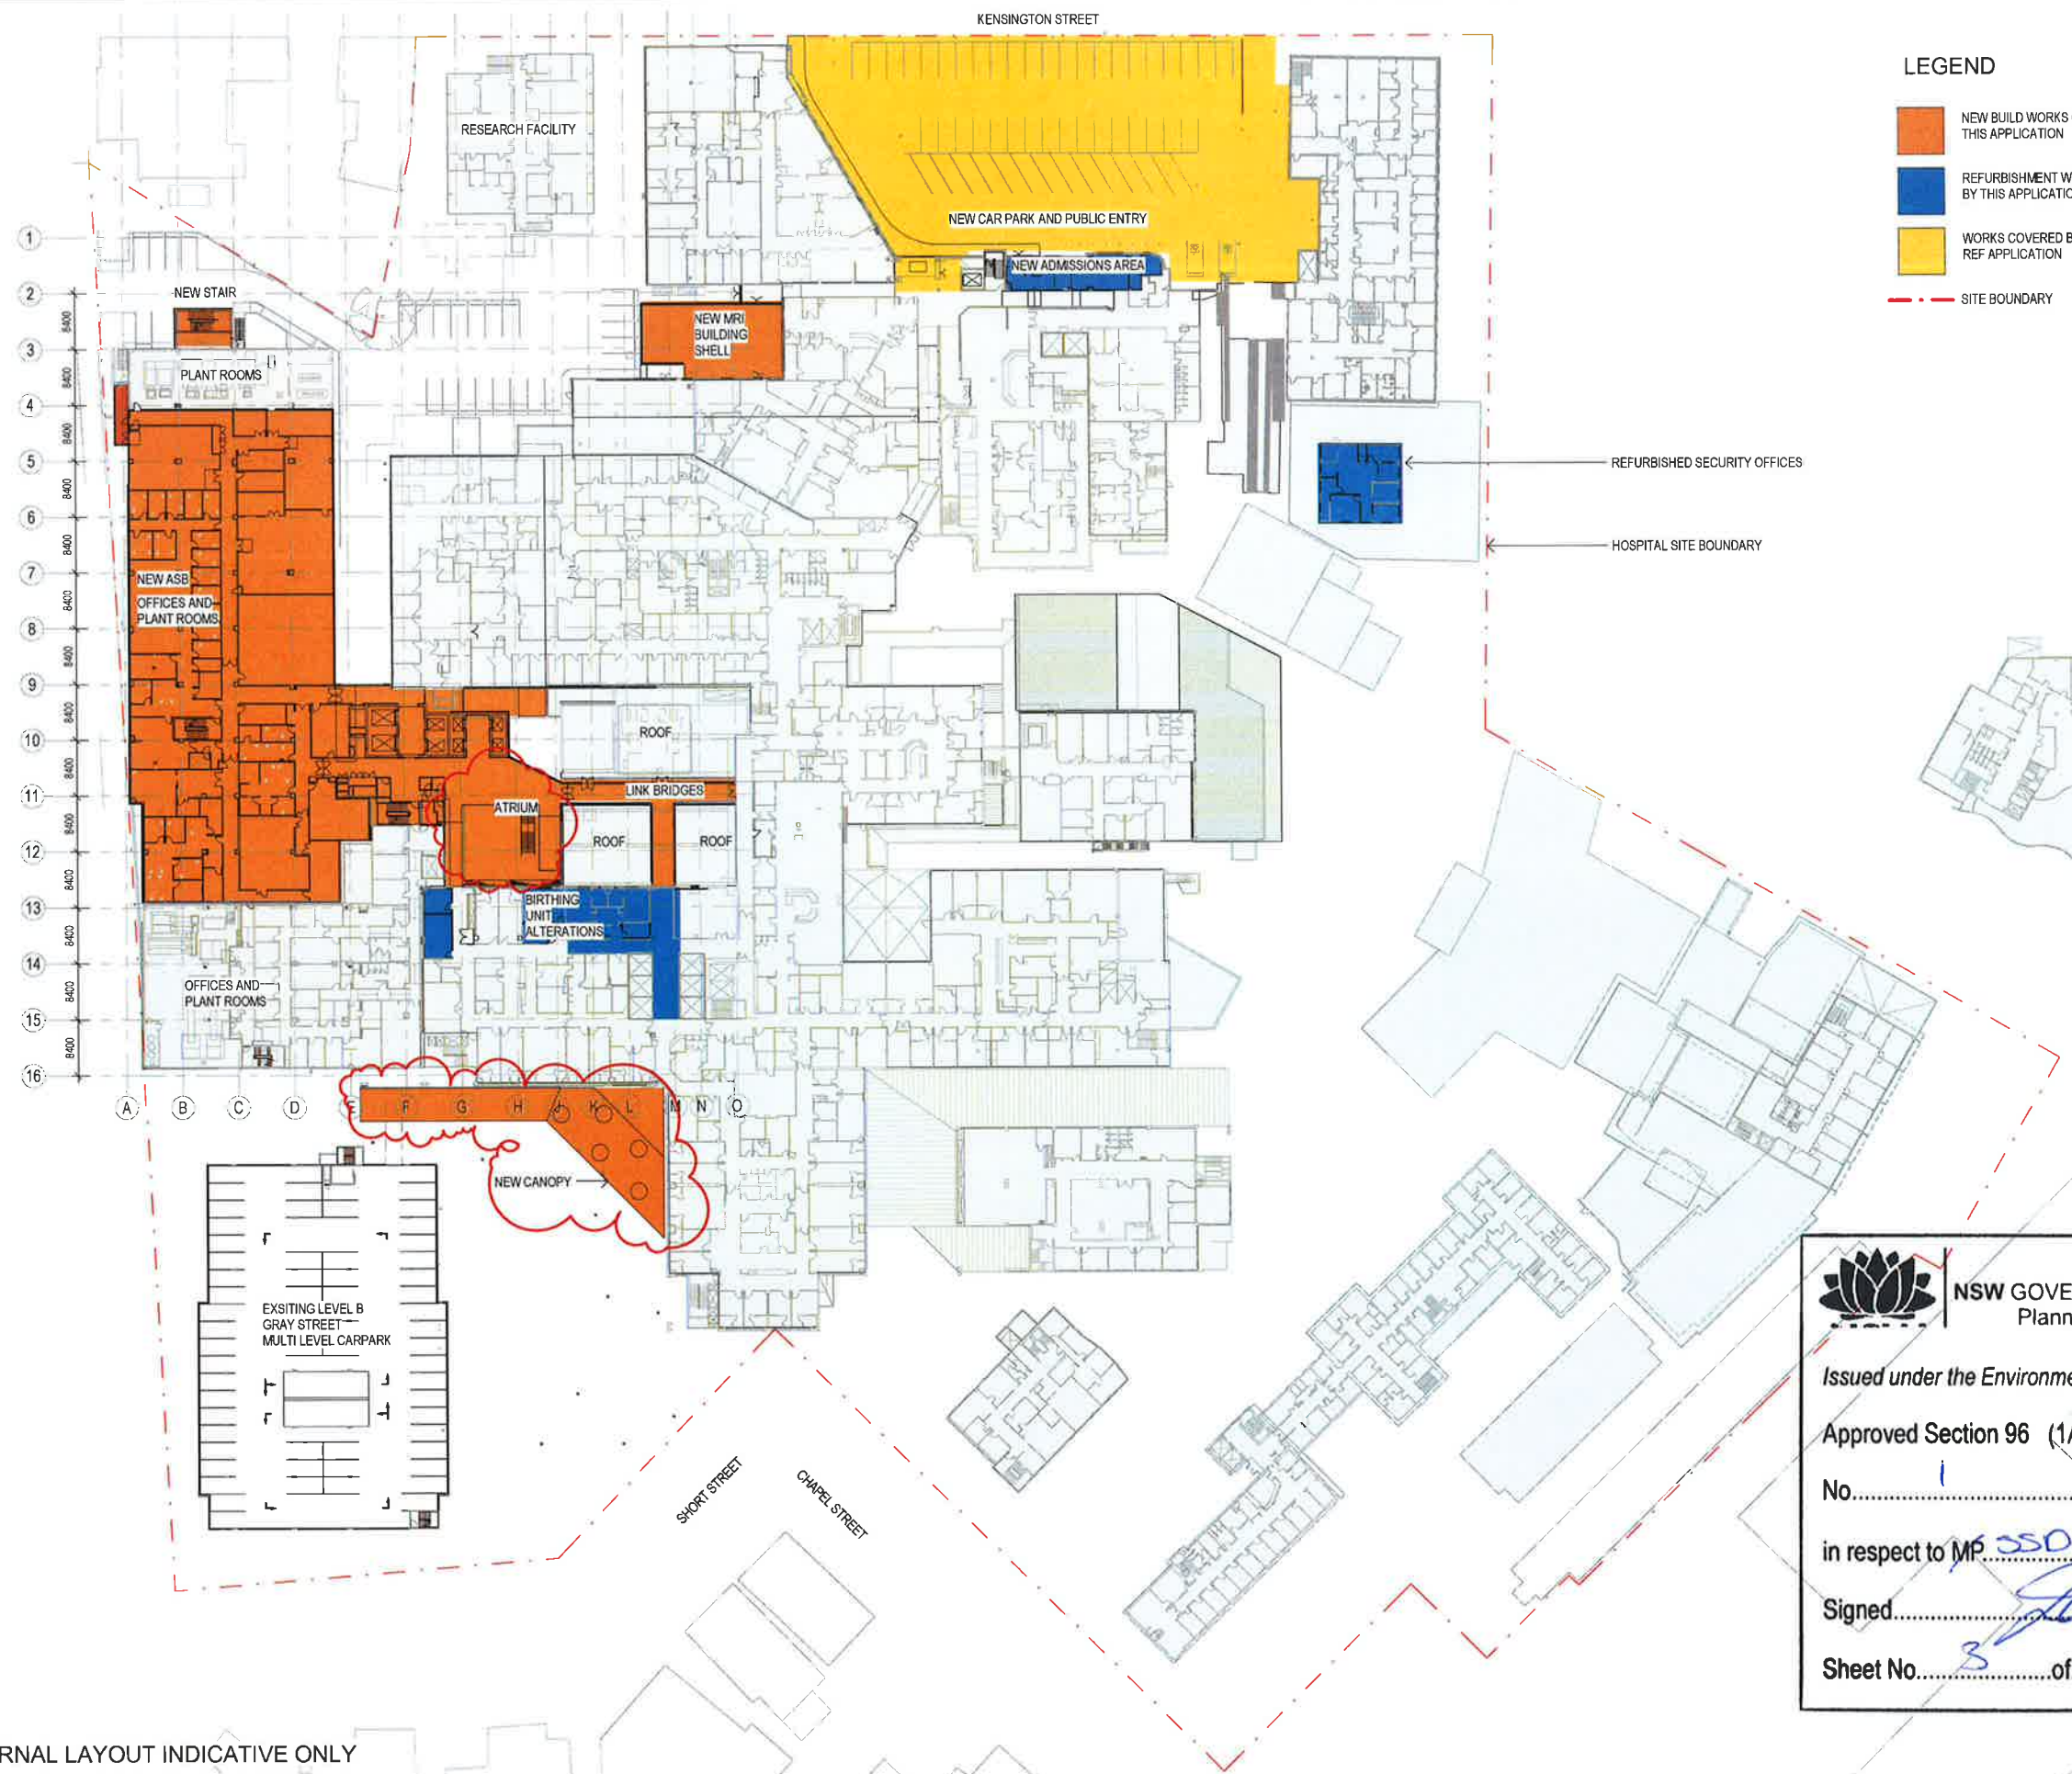

LEGEND

- NEW BUILD WORKS COVERED BY THIS APPLICATION
- REFURBISHMENT WORKS COVERED BY THIS APPLICATION
- WORKS COVERED BY SEPARATE REF APPLICATION
- SITE BOUNDARY



NSW GOVERNMENT
Planning

Issued under the Environmental Planning and Assessment Act 1979

Approved Section 96 (1A) (1) (2) Modification Application

No. 1 granted on the 17/12/2015

in respect to MP 5507024

Signed [Signature]

Sheet No. 3 of 13

NOTE: INTERNAL LAYOUT INDICATIVE ONLY

0 5m 15m 30m 50m

ASB DA 0103

Level 1

Scale: 1:500 Date: 23.11.15 Rev: 6

JACOBS

aurora

NSW Health
Infrastructure

ST GEORGE HOSPITAL
ACUTE SERVICES
BUILDING AND
REDEVELOPMENT



LEGEND

- NEW BUILD WORKS COVERED BY THIS APPLICATION
- REFURBISHMENT WORKS COVERED BY THIS APPLICATION
- WORKS COVERED BY SEPARATE REF APPLICATION
- SITE BOUNDARY



NSW GOVERNMENT
Planning

Issued under the Environmental Planning and Assessment Act 1979

Approved Section 96 (1A) (1) (2) Modification Application

No. 1 granted on the 17/12/2015

in respect to MP/SSD 7024

Signed [Signature]

Sheet No. 4 of 13

NOTE: INTERNAL LAYOUT INDICATIVE ONLY

0 5m 15m 30m 50m

ASB DA 0104
Level 2

Scale: 1:500 Date: 23.11.15 Rev: 6

JACOBS

aurora

NSW Health Infrastructure

ST GEORGE HOSPITAL
ACUTE SERVICES
BUILDING AND
REDEVELOPMENT



LEGEND

- NEW BUILD WORKS COVERED BY THIS APPLICATION
- REFURBISHMENT WORKS COVERED BY THIS APPLICATION
- WORKS COVERED BY SEPARATE REF APPLICATION
- SITE BOUNDARY



NSW GOVERNMENT
Planning

Issued under the Environmental Planning and Assessment Act 1979

Approved Section 96 (1A) (1) (2) Modification Application

No. 1 granted on the 17/12/2015

in respect to MP 5507024

Signed [Signature]

Sheet No. 7 of 13

NOTE: INTERNAL LAYOUT INDICATIVE ONLY

0 5m 15m 30m 50m

ASB DA 0107
Level 5

Scale: 1:500 Date: 23.11.15 Rev:5



ST GEORGE HOSPITAL
ACUTE SERVICES
BUILDING AND
REDEVELOPMENT



- LEGEND**
- NEW BUILD WORKS COVERED BY THIS APPLICATION
 - REFURBISHMENT WORKS COVERED BY THIS APPLICATION
 - WORKS COVERED BY SEPARATE REF APPLICATION
 - SITE BOUNDARY

NSW GOVERNMENT
Planning

Issued under the Environmental Planning and Assessment Act 1979

Approved Section 96 (1A) ~~(1)~~ ~~(2)~~ Modification Application

No. 1 granted on the 17/12/2015

in respect to MP SS07024


Signed [Signature]

Sheet No. 8 of 13

NOTE: INTERNAL LAYOUT INDICATIVE ONLY




ASB DA 0110
Level 8
Scale : 1 : 500 Date : 23.11.15 Rev:5

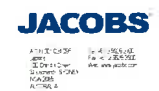

ST GEORGE HOSPITAL
ACUTE SERVICES
BUILDING AND
REDEVELOPMENT

24/12/2015 12:37:57 PM

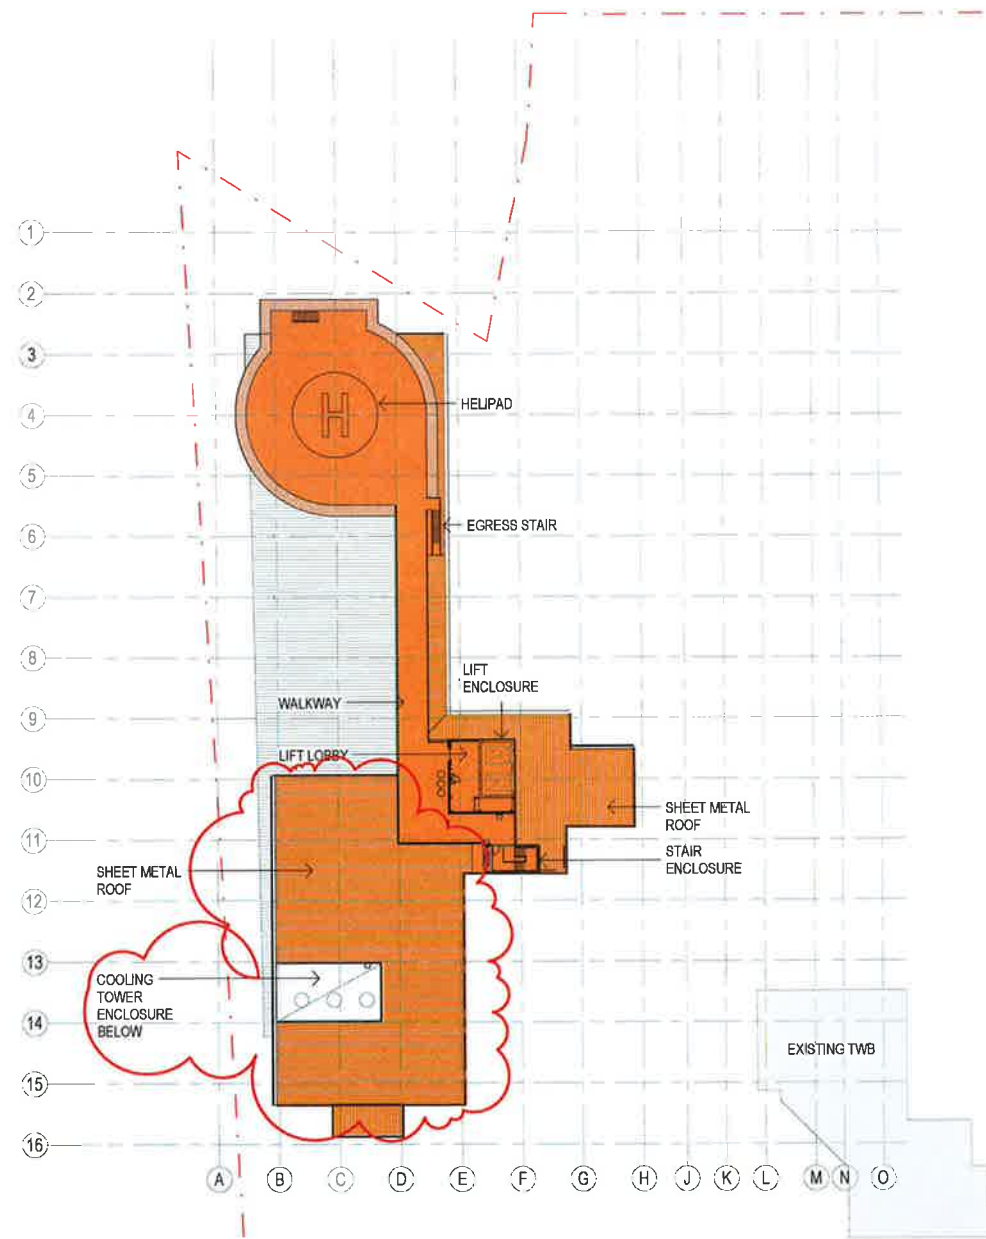

LEGEND

- NEW BUILD WORKS COVERED BY THIS APPLICATION
- REFURBISHMENT WORKS COVERED BY THIS APPLICATION
- WORKS COVERED BY SEPARATE REF APPLICATION
- SITE BOUNDARY

HOSPITAL SITE BOUNDARY



NSW GOVERNMENT
Planning

Issued under the Environmental Planning and Assessment Act 1979

Approved Section 96 (1A) (1) (2) Modification Application

No. 1 granted on the 17/12/2015

in respect to MP 5807024

Signed [Signature]

Sheet No. 9 of 13

NOTE: INTERNAL LAYOUT INDICATIVE ONLY

0 5m 15m 30m 50m

ASB DA 0111

Level 9

Scale : 1 : 500 Date : 23.11.15 Rev : 5


JACOBS
170 Lonsdale Street
Melbourne VIC 3000
Australia
Tel: +61 (0)3 9592 9000
Fax: +61 (0)3 9592 9001
Web: www.jacobs.com.au

aurora

NSW Health
Infrastructure

ST GEORGE HOSPITAL
ACUTE SERVICES
BUILDING AND
REDEVELOPMENT

24/11/2015 12:33:38 PM

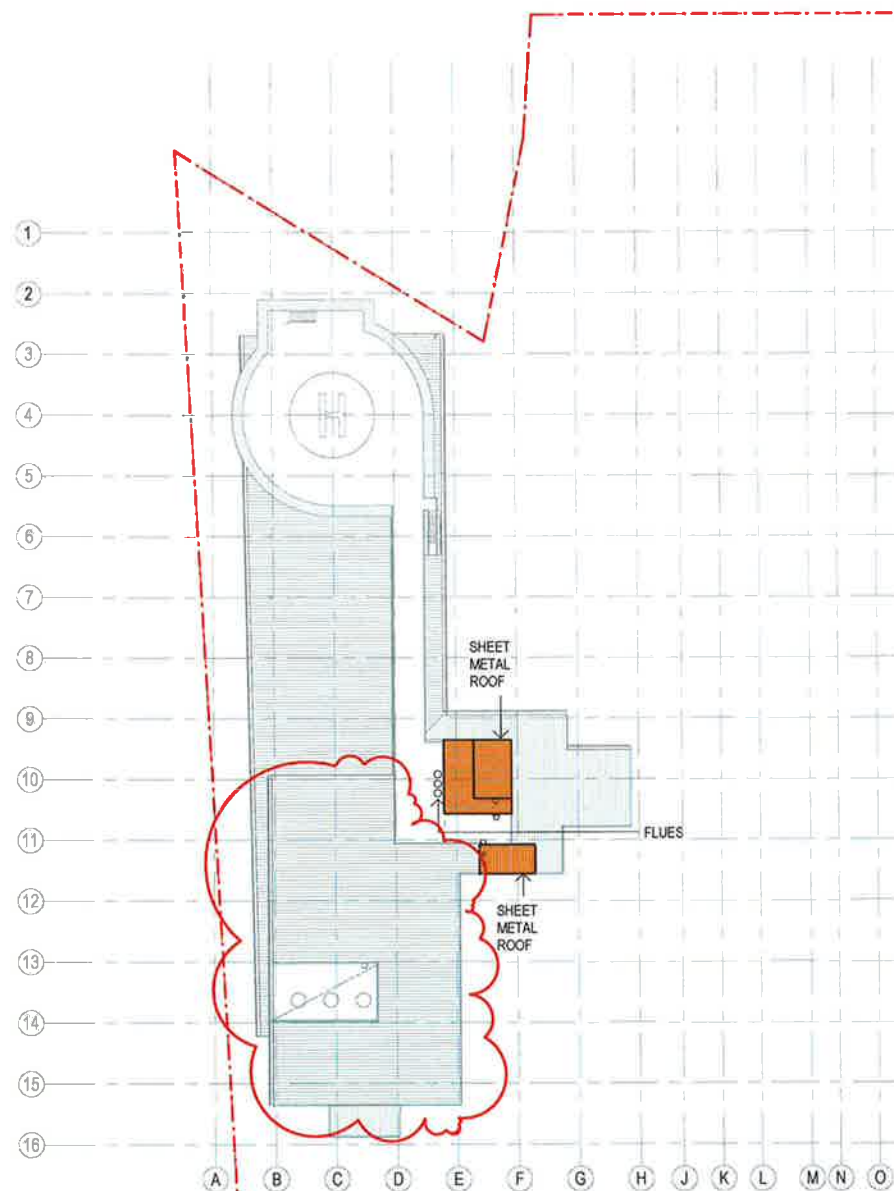

LEGEND

- NEW BUILD WORKS COVERED BY THIS APPLICATION
- REFURBISHMENT WORKS COVERED BY THIS APPLICATION
- WORKS COVERED BY SEPARATE REF APPLICATION
- SITE BOUNDARY

HOSPITAL SITE BOUNDARY



NSW GOVERNMENT
Planning

Issued under the Environmental Planning and Assessment Act 1979

Approved Section 96 (1A) (1) (2) Modification Application

No. 1 granted on the 17/12/2015

in respect to MP 5507024

Signed [Signature]

Sheet No. 10 of 13

NOTE: FLUE LAYOUT INDICATIVE ONLY

0 5m 15m 30m 50m

ASB DA 0112
Roof Plan
Scale : 1 : 500

Date : 23.11.15 Rev:5



ST GEORGE HOSPITAL
ACUTE SERVICES
BUILDING AND
REDEVELOPMENT


FINISHES LEGEND	
CODE	DESCRIPTION
FAC-01	COMPOSITE PREFINISHED METAL CLADDING - DARK GREY
FAC-02	COMPOSITE PREFINISHED METAL CLADDING - OFF WHITE
FAC-10	COMPOSITE PREFINISHED METAL CLADDING - COPPER COLOURED
FAC-11	COMPOSITE WOOD LAMINATE SOFFIT CLADDING
LVR-01	HORIZONTAL METAL LOUVERES - DARK GREY
GL-01	TRANSPARENT GLASS WITH GREY TINT
GL-02	COLOURBACKED GLASS - DARK GREY
DP	DOWNPIPES - COLOUR TO MATCH CLADDING




NSW GOVERNMENT
Planning

Issued under the Environmental Planning and Assessment Act 1979
 Approved Section 96 (1A) (1) (2) Modification Application
 No. 1 granted on the 17/12/2015
 in respect to MP 5507024
 Signed. 
 Sheet No. 11 of 13

2 North Elevation
 1 : 250

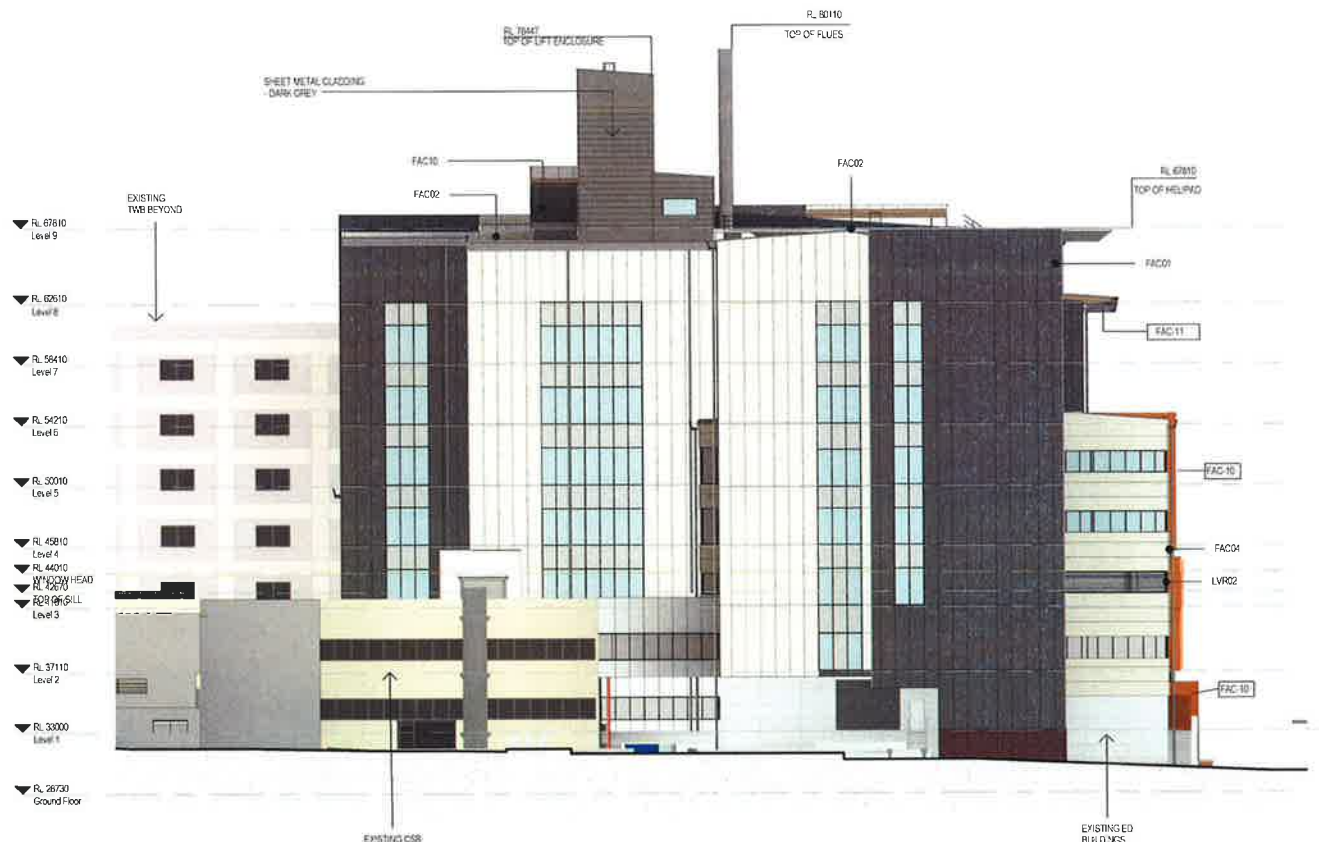

1 West Elevation
 1 : 250

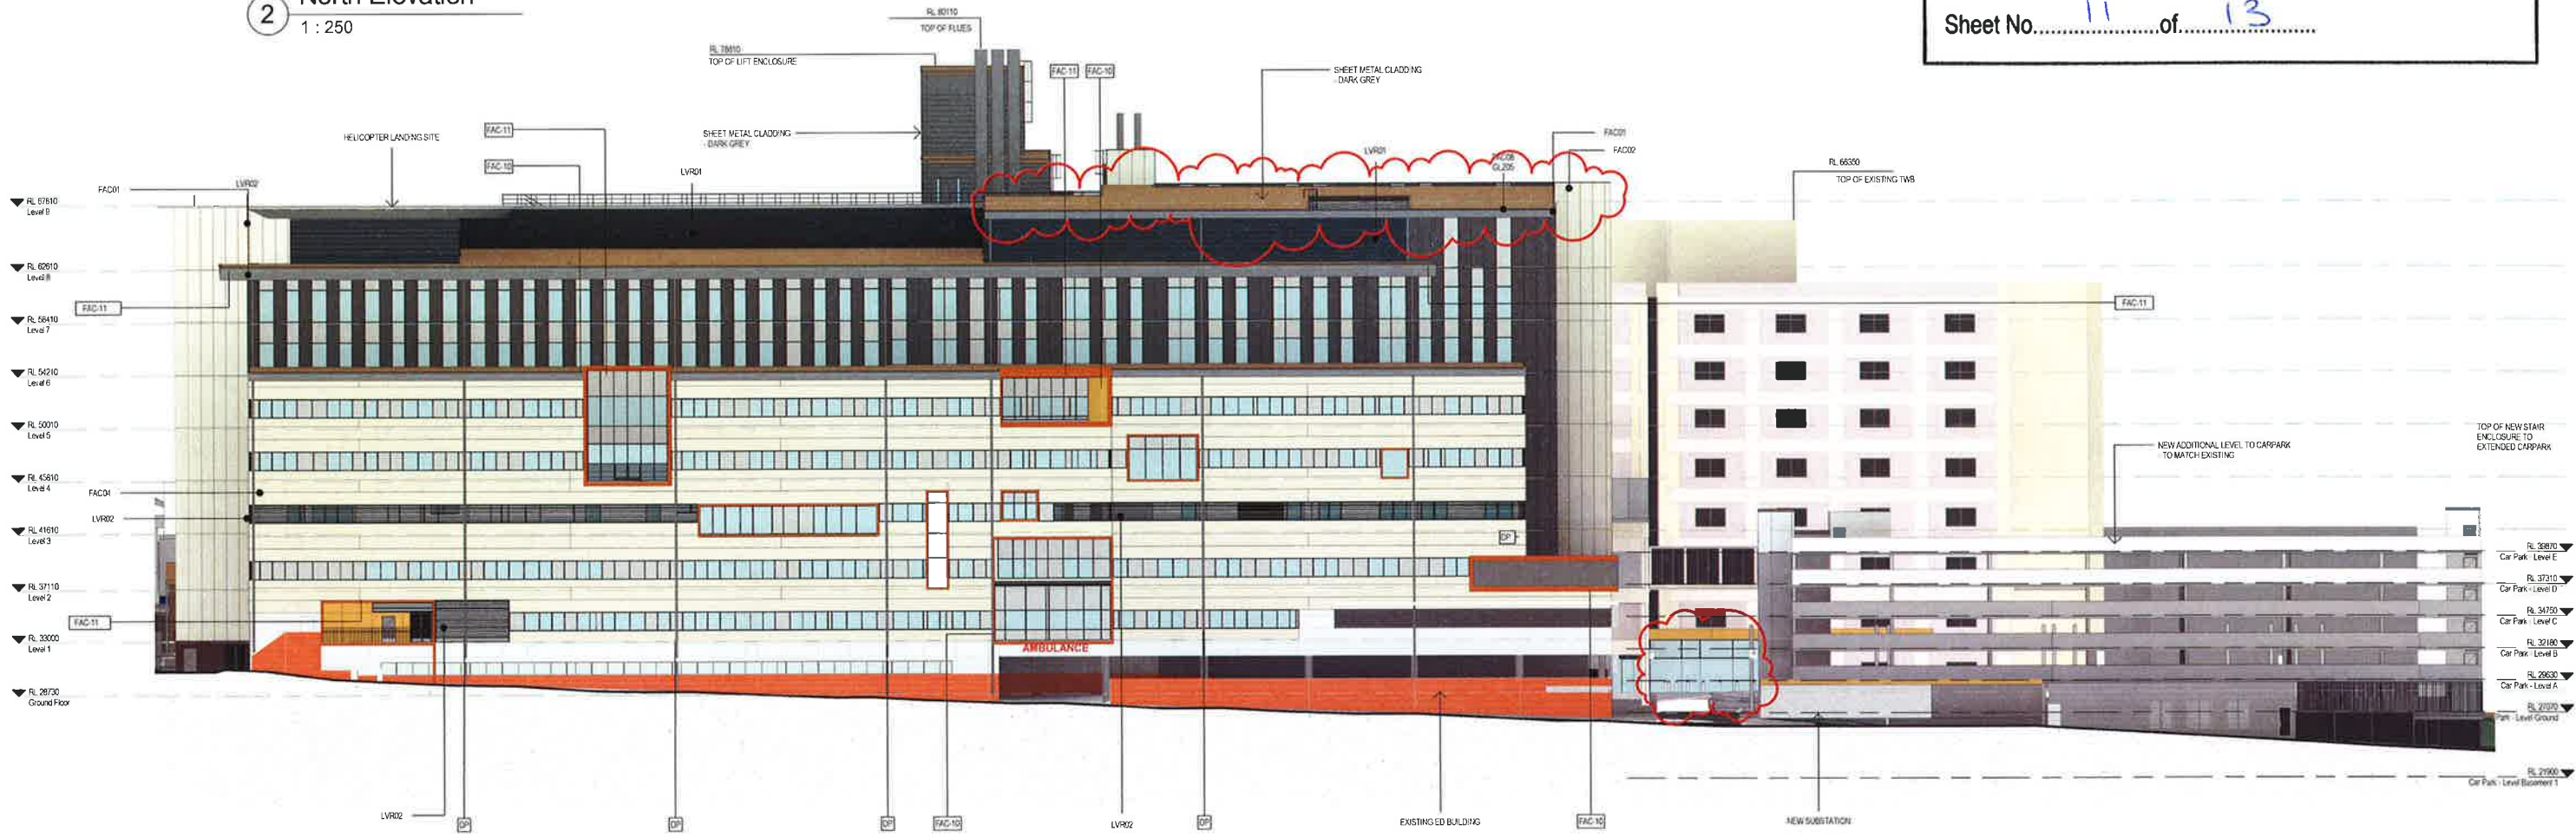

NOTE: LOCATION OF FLUES INDICATIVE ONLY
 EXTERNAL DOWNPIPES INDICATIVE ONLY
 SIGNAGE WORDING INDICATIVE ONLY

CODE	DESCRIPTION
FAC-01	COMPOSITE PREFINISHED METAL CLADDING - DARK GREY
FAC-02	COMPOSITE PREFINISHED METAL CLADDING - OFF WHITE
FAC-10	COMPOSITE PREFINISHED METAL CLADDING - COPPER COLOURED
FAC-11	COMPOSITE WOOD LAMINATE SOFT T1 CLADDING
LVR-01	HORIZONTAL METAL LOUVRES - DARK GREY
GL-01	TRANSPARENT GLASS WITH GREY TINT
GL-02	COLOURBACKED GLASS - DARK GREY
DP	DOWNPipes - COLOUR TO MATCH CLADDING

NSW GOVERNMENT
Planning

Issued under the Environmental Planning and Assessment Act 1979

Approved Section 96 (1A) (1) (2) Modification Application


No. 1 granted on the 17/12/2015

in respect to MP S507024


Signed [Signature]

Sheet No. 12 of 13

2 South Elevation
1 : 250

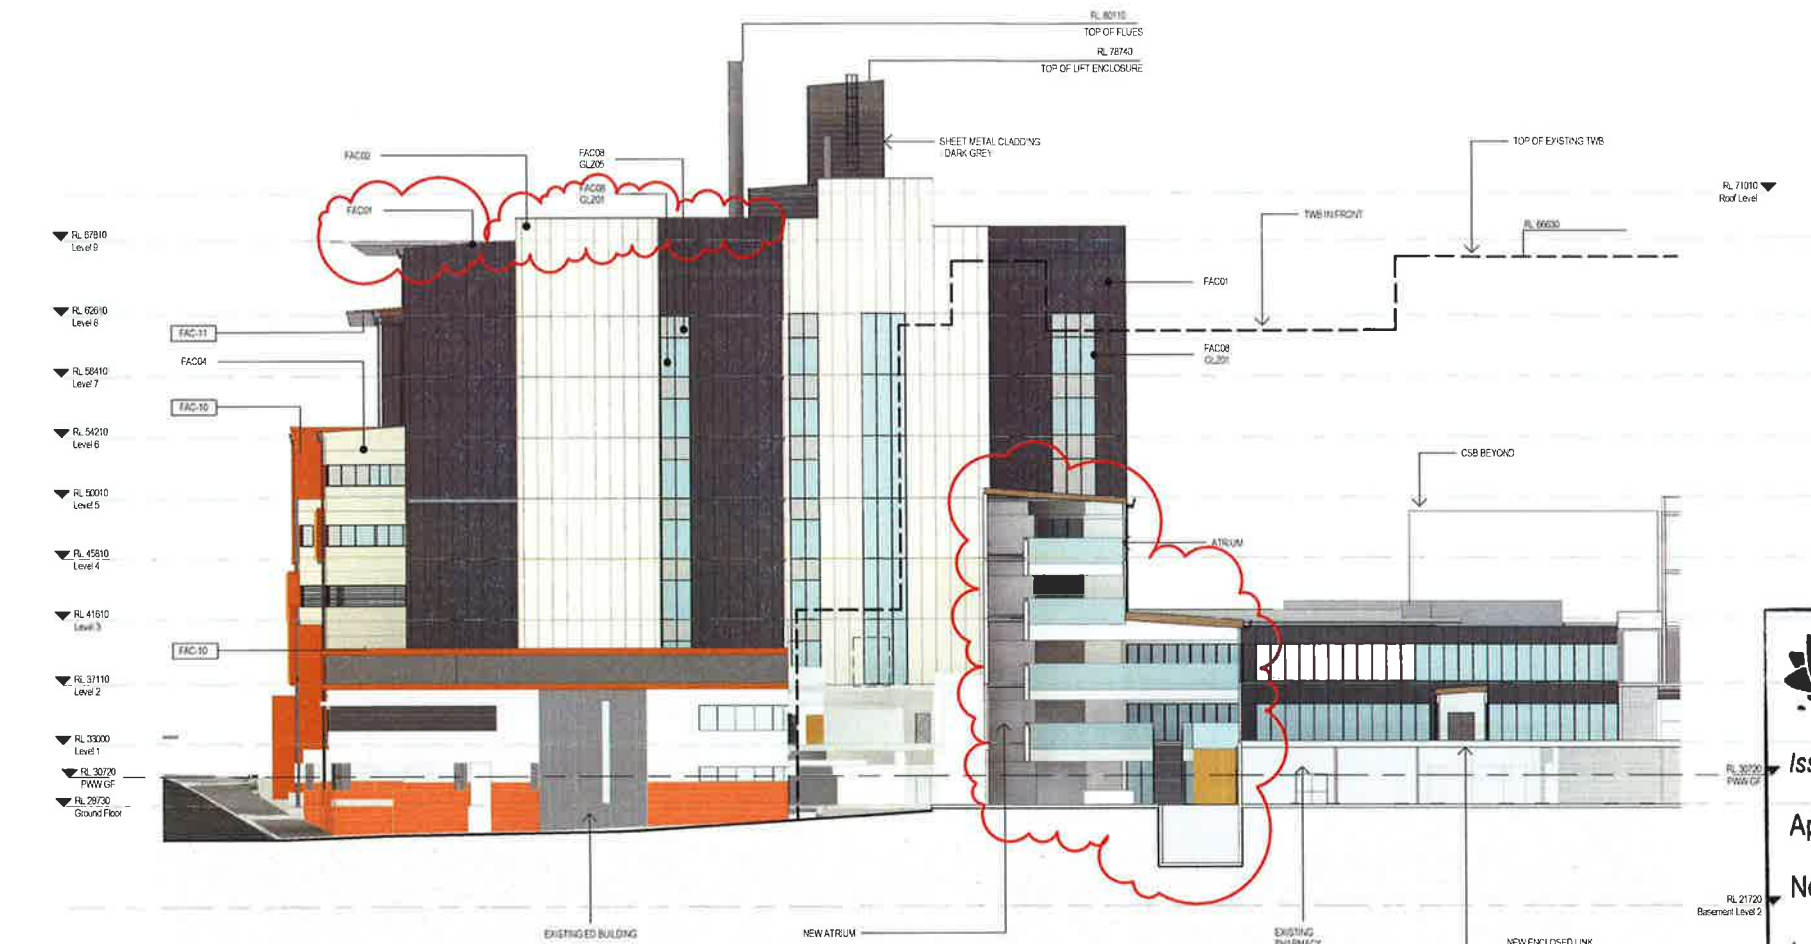


1 East Elevation
1 : 250

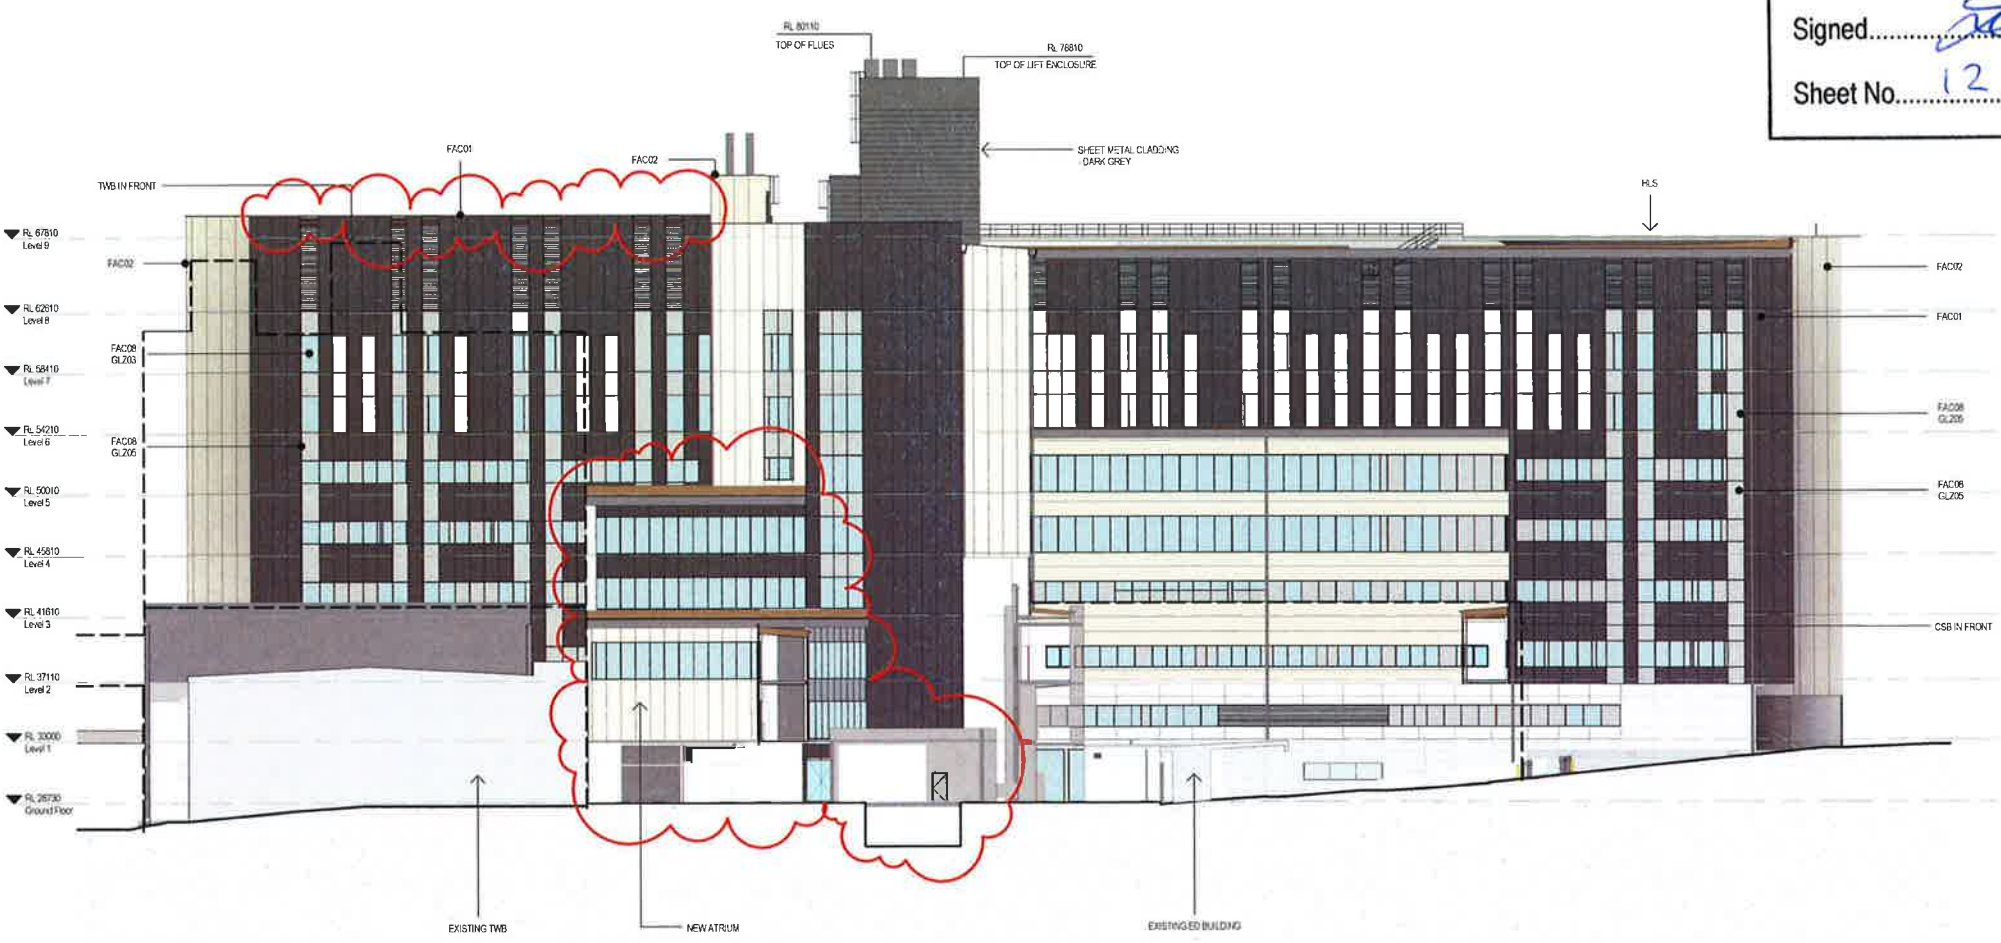

NOTE: LOCATION OF FLUES INDICATIVE ONLY
EXTERNAL DOWNPIPES INDICATIVE ONLY
SIGNAGE WORDING INDICATIVE ONLY

24/11/2015 12:51:10 PM


FINISHES LEGEND	
CODE	DESCRIPTION
FAC 01	COMPOSITE PREFINISHED METAL CLADDING - DARK GREY
FAC 02	COMPOSITE PREFINISHED METAL CLADDING - OFF WHITE
FAC 10	COMPOSITE PREFINISHED METAL CLADDING - COPPER COLOURED
FAC 11	COMPOSITE WOOD LAMINATE SOFT CLADDING
LVR 01	HORIZONTAL METAL LOUVRES - DARK GREY
GL 01	TRANSPARENT GLASS WITH GREY TINT
GL 02	COLOURED GLASS - DARK GREY
DP	DOWNPIPES - COLOUR TO MATCH CLADDING

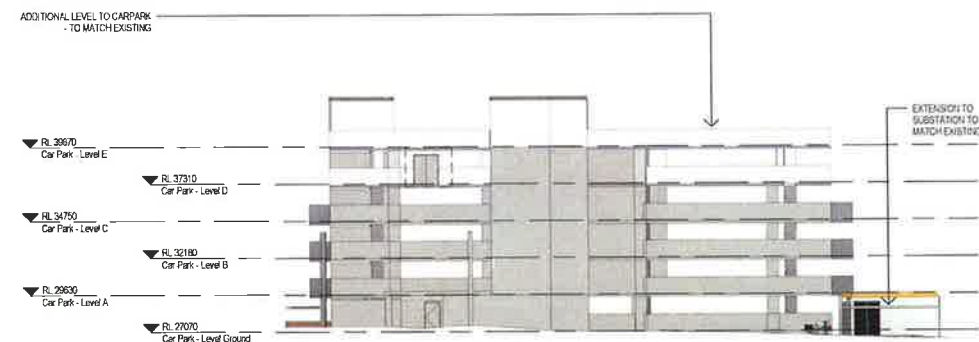


2 Gray St Car Park - North Elevation
1 : 250




3 Proposed Elevation - Main Entry
1 : 200

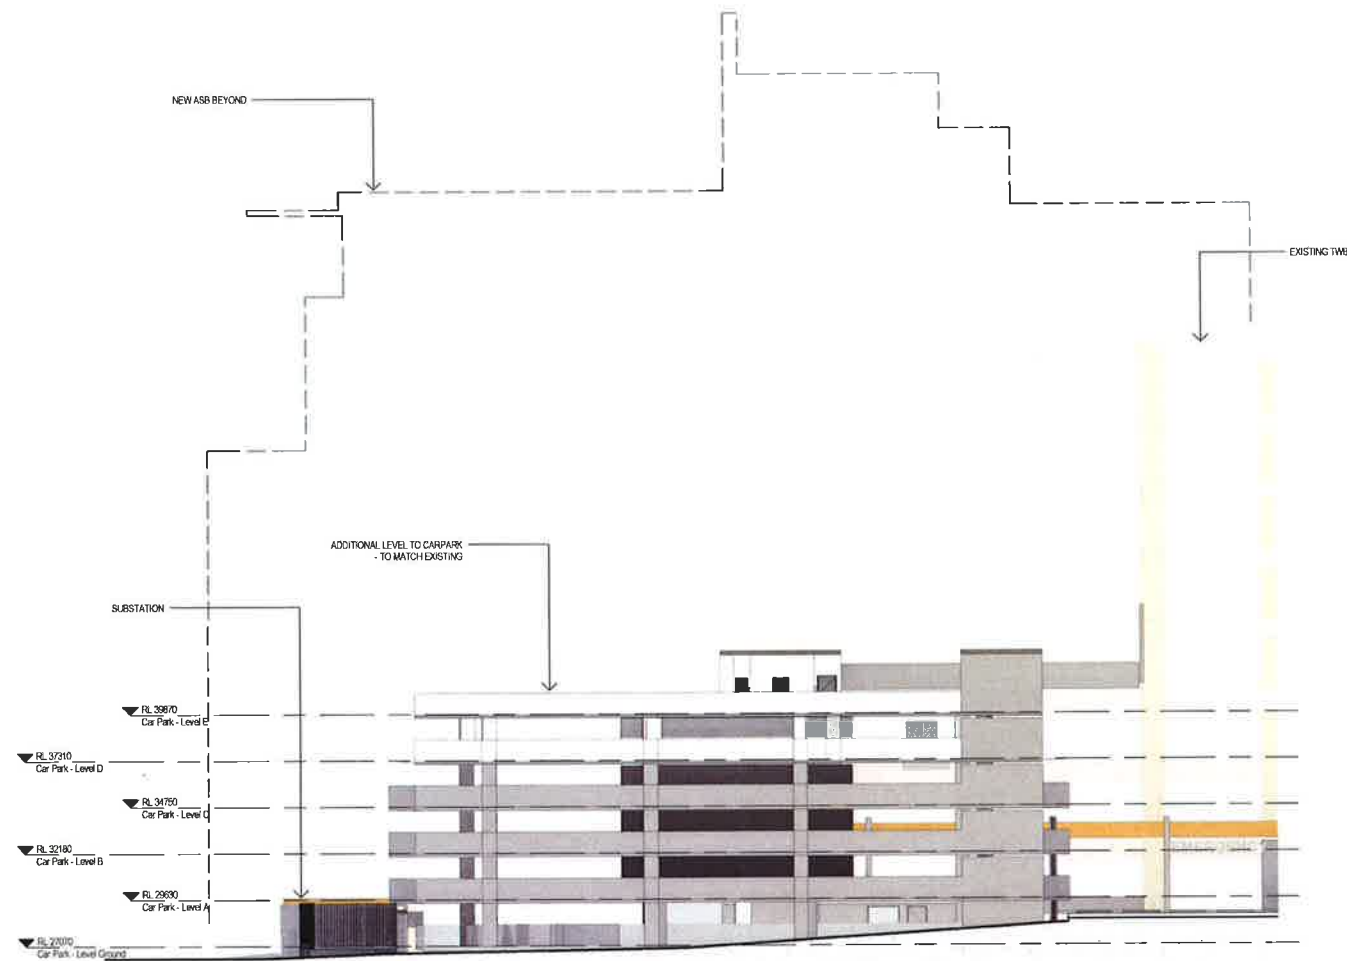

1 Gray St Car Park - South Elevation
1 : 200

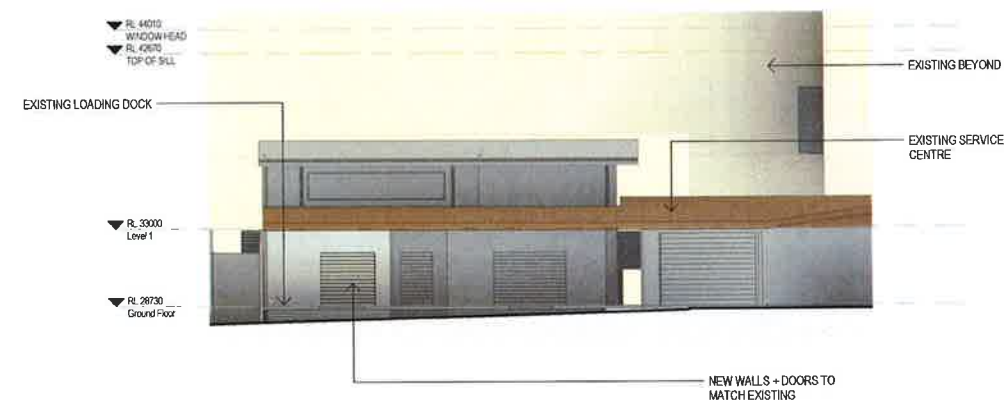

4 Service Centre - East Elevation
1 : 200

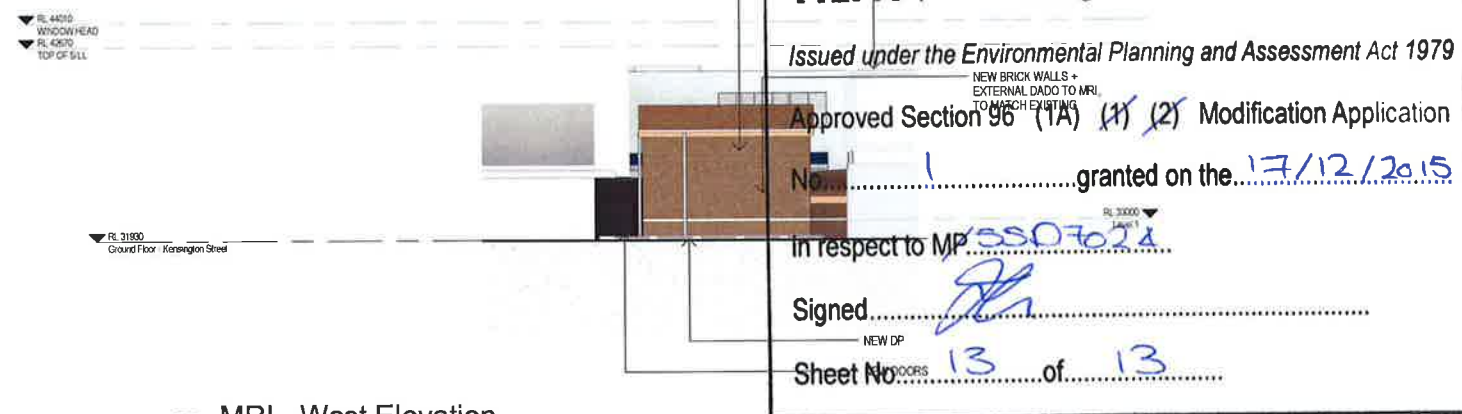

5 MRI - West Elevation
1 : 200

NSW GOVERNMENT Planning

Issued under the Environmental Planning and Assessment Act 1979

Approved Section 96 (1A) (1) (2) Modification Application

No. 1 granted on the 17/12/2015

In respect to MP 3507024

Signed [Signature]

Sheet No. 13 of 13

24/11/2015 12:24:29 PM