

BOUNDARIES HAVE NOT BEEN DETERMINED BY SURVEY AND ARE DIAGRAMMATIC ONLY. ALL DIMENSIONS AND AREAS HAVE BEEN COMPILED FROM THE RECORD PLANS AND FIELD MEASUREMENTS. ALL BEARINGS RELATE TO MEA NORTH.

LEVEL DATUM IS AN ORIGINATING FROM SSM 67124.

L 7.288 LOCATED AT HICKSON ROAD.

VISIBLE, ACCESSIBLE SERVICES ONLY HAVE BEEN LOCATED. THIS PLAN DOES NOT PURPORT TO SHOW THE EXISTENCE OF UNDERGROUND SERVICES HAS NOT BEEN ESTABLISHED.

EXISTENCE OF SERVICES MUST BE VERIFIED BY CONTACTING THE AGENCY YOU DIG DEDICATED 1100.COM.AU

NEIGHBORING HOUSES, WINDOWS AND ROOF POSITIONS ARE APPROXIMATIVE ONLY.

FLOOR LEVELS GENERALLY SURVEYED AT DOOR THRESHOLDS. INTERNAL ROOMS NOT SURVEYED.

SPILL LEVELS SHOULD TAKE PRECEDENCE.

PARTIAL SURVEY INFORMATION SHOWN IN GREY HAS BEEN COMPILED FROM SURVEY BY RIGATE & WEST.

REFER TO PAGE OF PLAN FOR SUBJECT TITLE NOTATIONS.

THIS TITLEBLOCK IS AN INTERNAL PART OF THIS DRAWING AND SHOULD NOT BE REMOVED.



WM - WATER METER

APPROVAL IS STRICTLY PROHIBITED

REV	AMENDMENTS	DATE
-----	------------	------

SHEET 1 OF 2 - DETAIL SURVEY

CLIENT: ALIUS PAGE KIRKLAND

REDUCTION RATIO : 1:150

7-2/ CIRCULAR QUAY WEST
TILE DOCKS

BEING: LOT IN DP

SITE LEVELS


COUNCIL SUBMISSION

MACQUARIE PARK

email: office@projectsurveyors.com.au




Professional Innovative... Results.

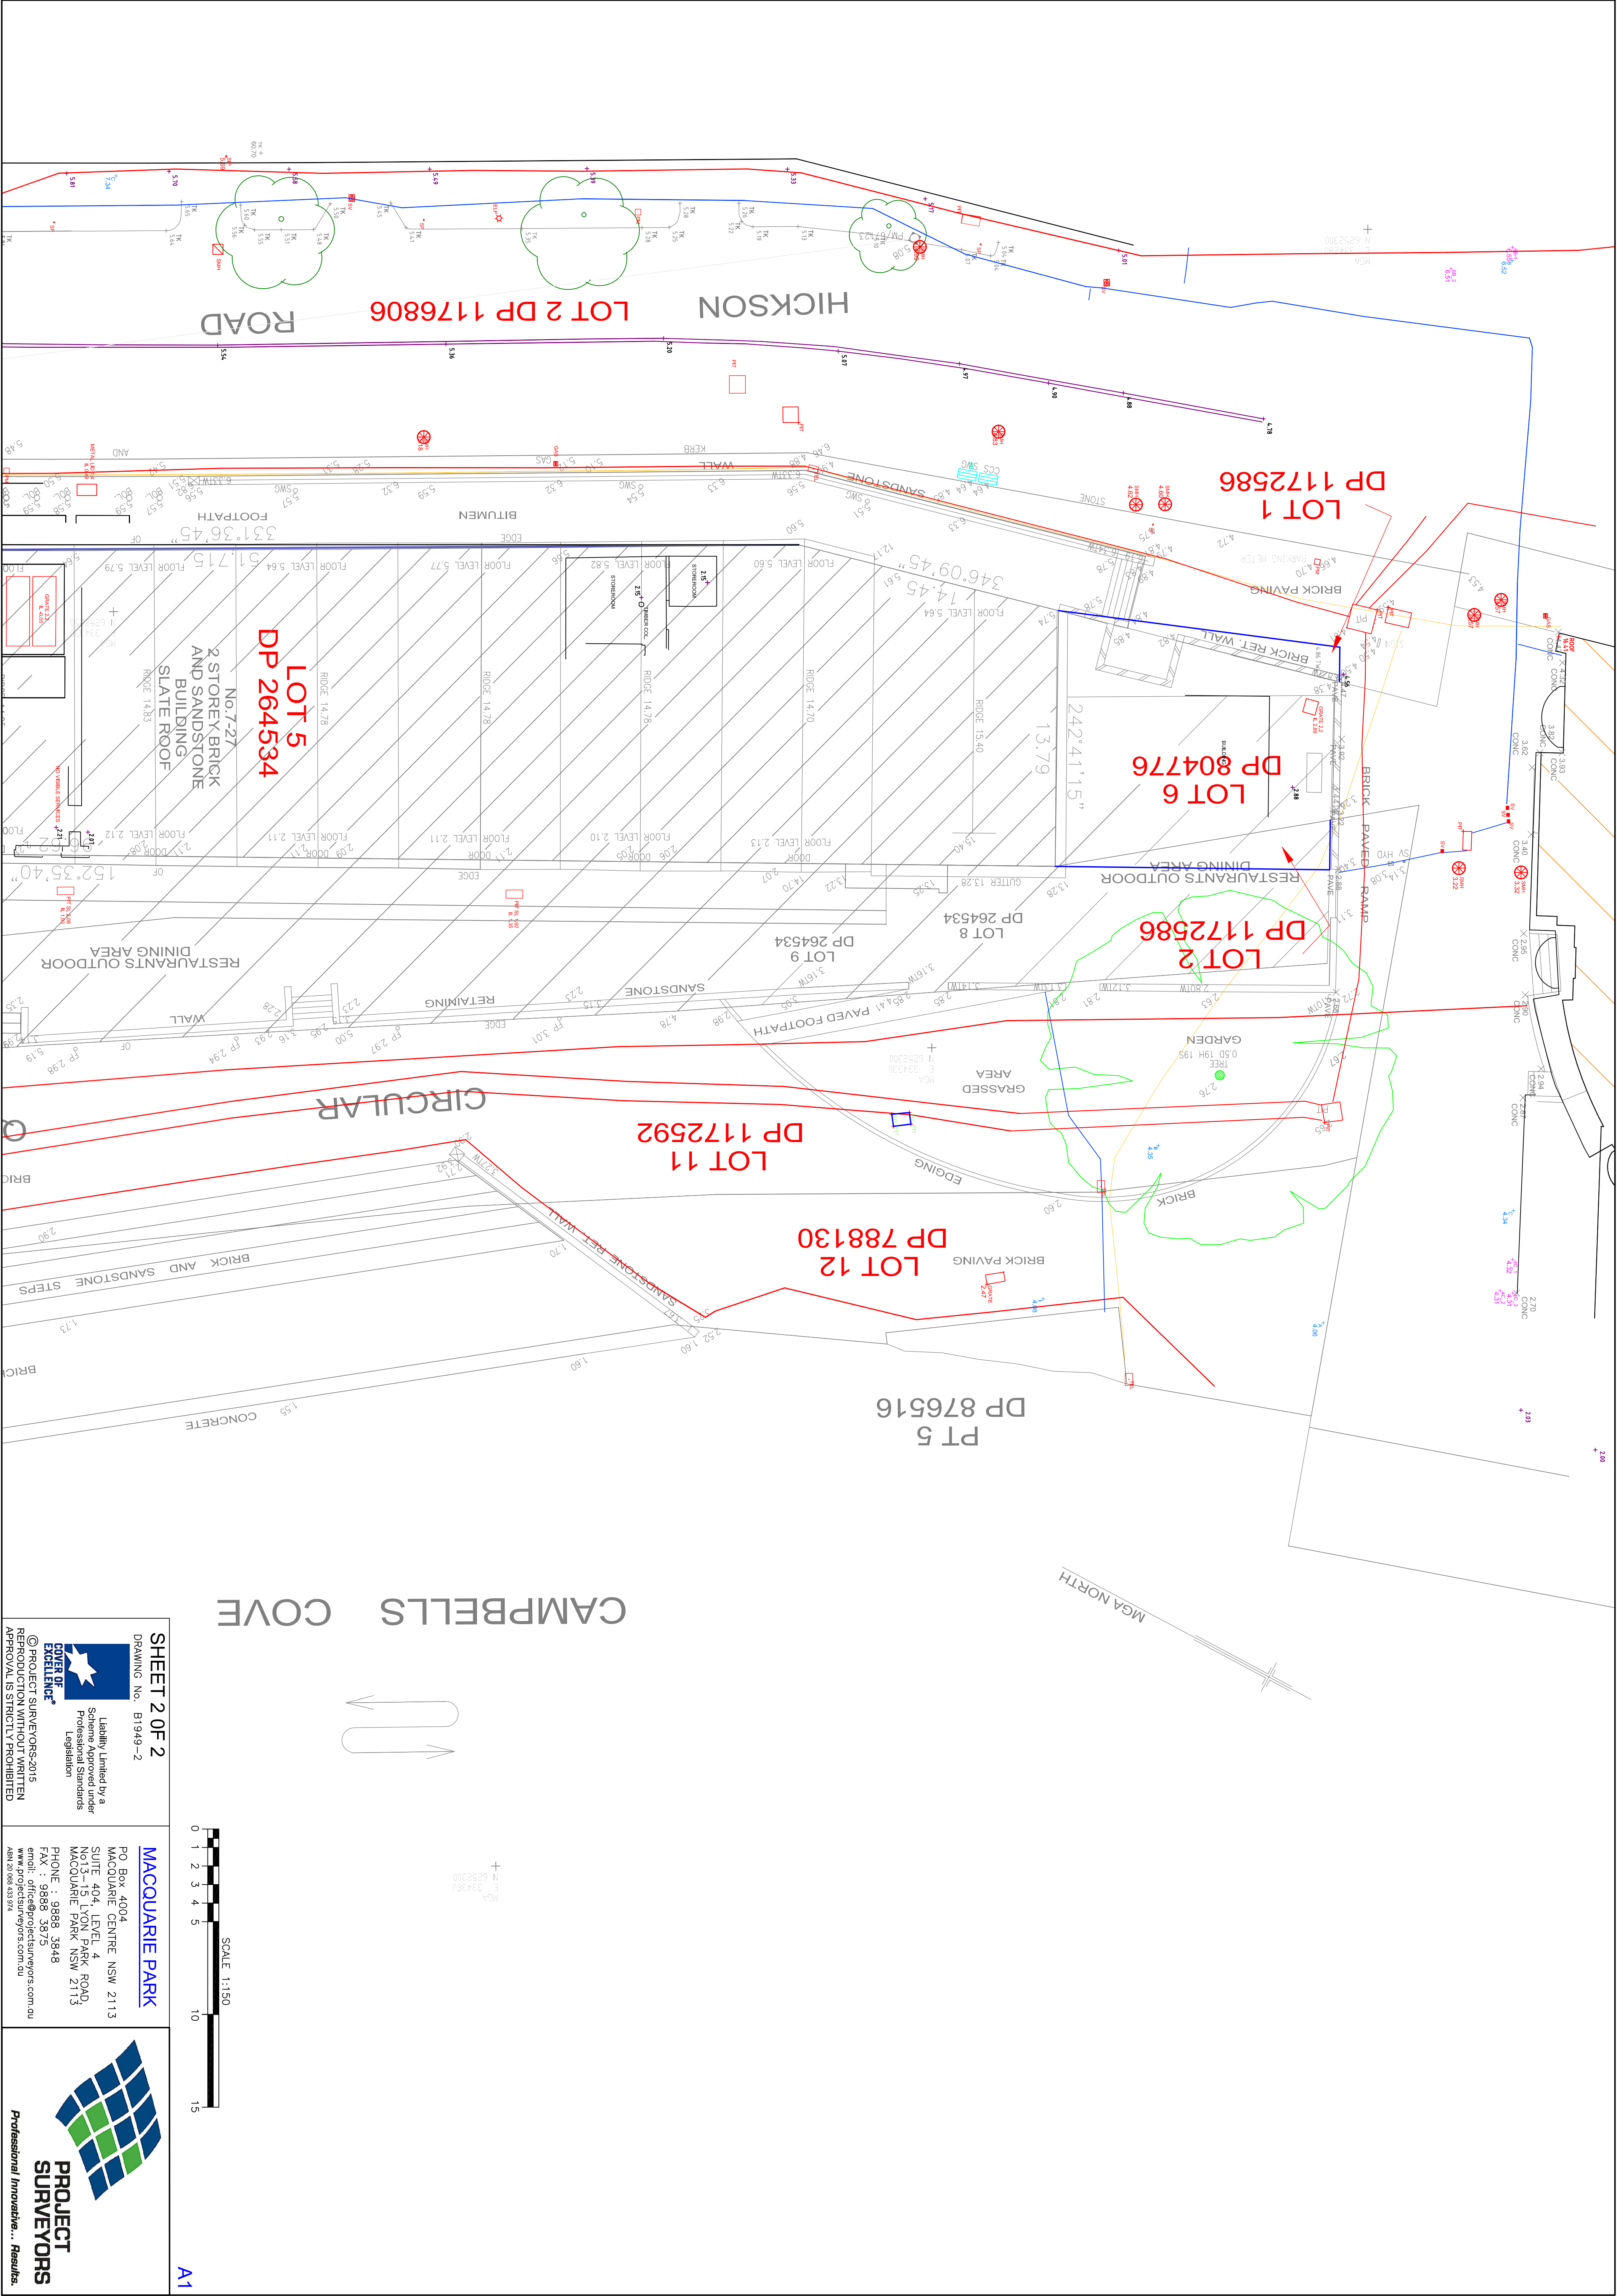

CAMPBELLS COVE

SHEET 2 OF 2
DRAWING No. B1949-2

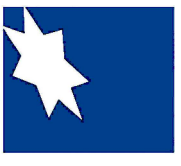


Liability Limited by a
Scheme Approved under
Professional Standards
Legislation

COVER OF
EXCELLENCE®
© PROJECT SURVEYORS 2015
REPRODUCTION WITHOUT WRITTEN
APPROVAL IS STRICTLY PROHIBITED

MACQUARIE PARK
PO Box 4004
MACQUARIE CENTRE NSW 2113
SUITE 404, LEVEL 4
NO 15, LYON PARK ROAD
MACQUARIE PARK NSW 2113
PHONE : 9888 3848
FAX : 9888 3873
www.projectsurveyors.com.au
ABN 20 068 433 974



PROJECT
SURVEYORS
Professional Innovative... Results.

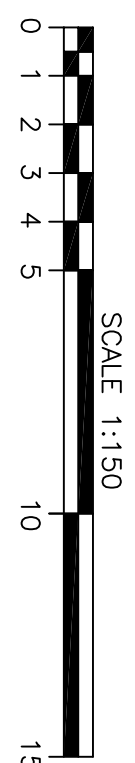

A1