

- Legend:**
- Existing Building - No Works
 - Existing Building to be refurbished
 - Proposed Works
 - Proposed Walls
 - Existing walls and structure



NSW GOVERNMENT
Planning

Issued under the Environmental Planning and Assessment Act 1979




Approved Section 96 (1A) ~~1st~~ ~~2nd~~ Modification Application

No. 2 granted on the 19 JUNE '18

in respect to MP SSD 7140

Signed [Signature]

Sheet No. 1 of 7

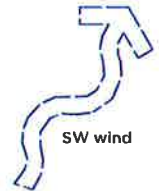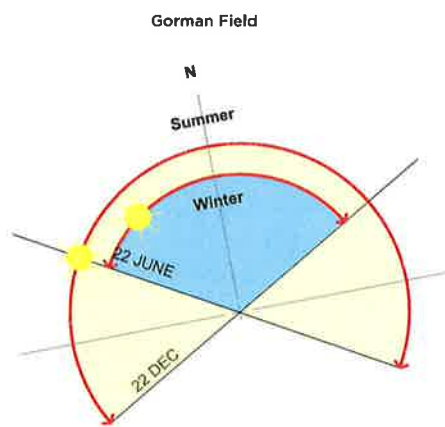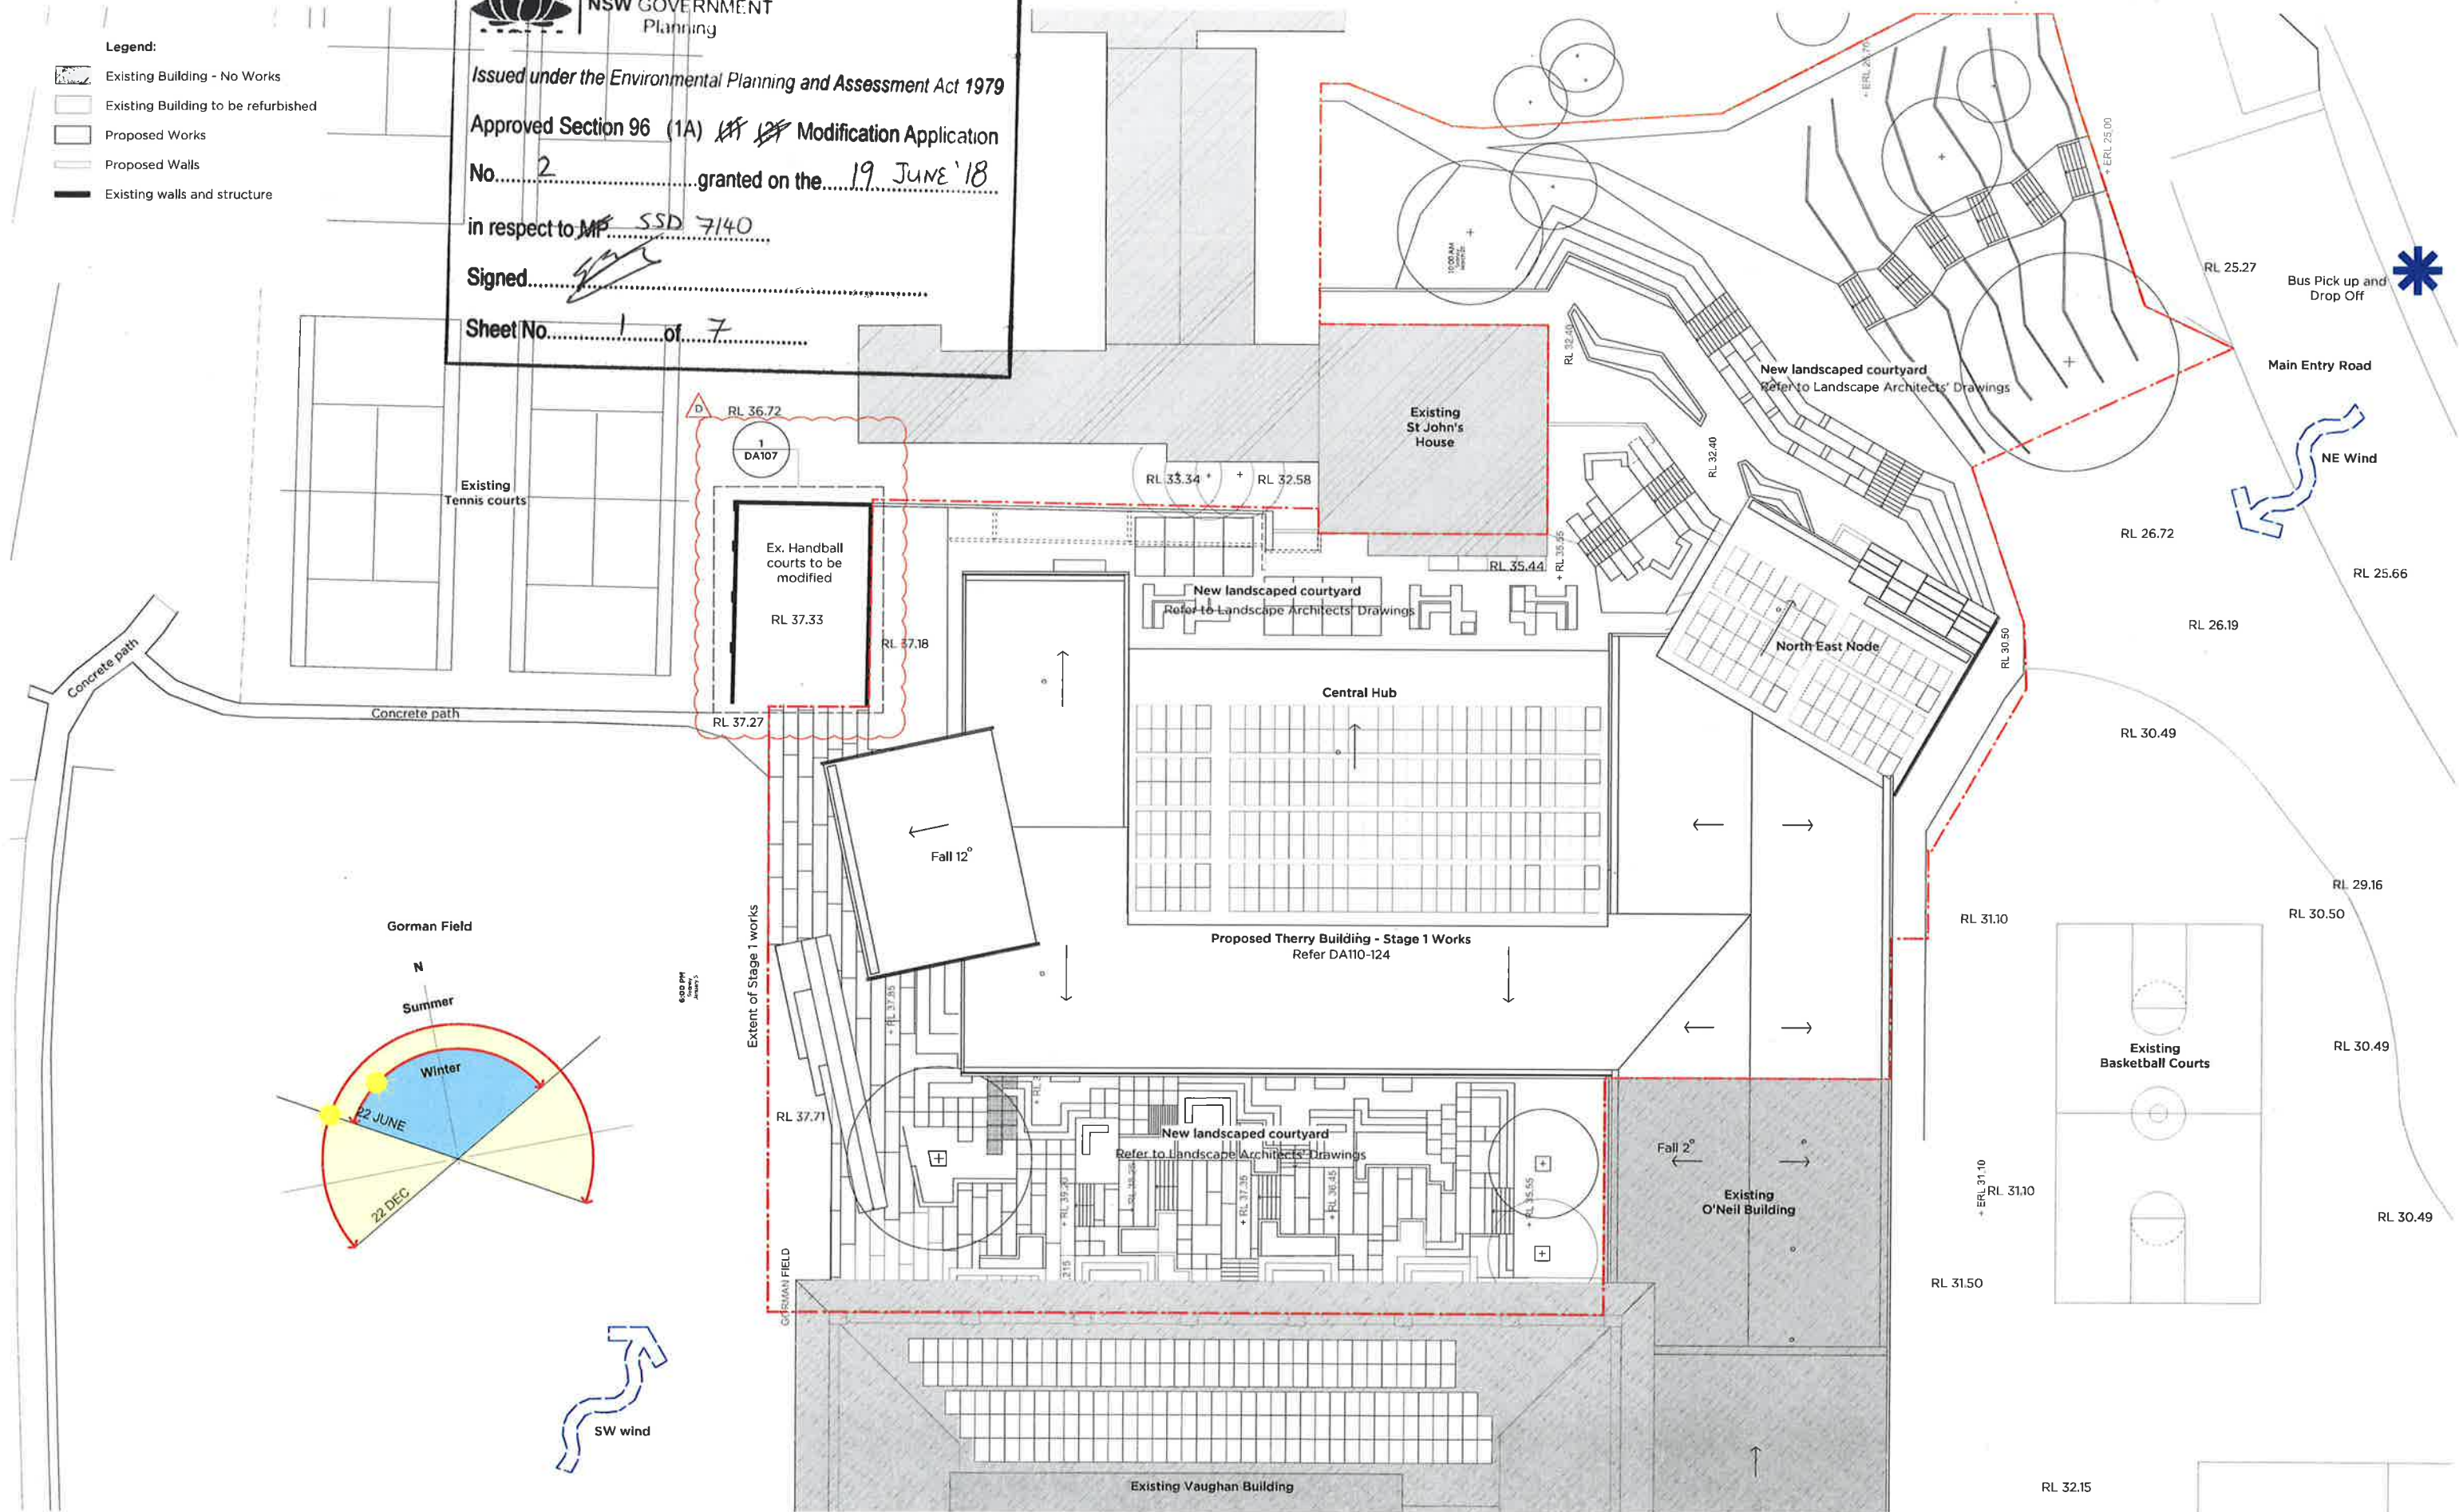

1 Site Analysis
DA100



PMDL

pmdl.com.au

**ARCHITECTURE
INTERIORS
MASTERPLANNING**

NEW HAWKESBURY ARCHITECTS AND INTERIORS
10/10/2018 10:10 AM 10/10/2018 10:10 AM 10/10/2018 10:10 AM

16/5/18		Section 4.55 Application - Handball Court Modification	
ISSUE	DATE	REVISION	
0mm		50mm	100mm
DO NOT SCALE FROM DRAWING, USE PROVIDED DIMENSIONS ONLY © 2018 PMDL ARCHITECTURE AND INTERIORS. ALL RIGHTS RESERVED.			
Masterplan Stage 1		2496	
Saint Ignatius College		DA100	
Site Plan and Analysis		DA100	
Riverview		10/10/2018	10/10/2018



NSW GOVERNMENT
Planning

Issued under the Environmental Planning and Assessment Act 1979

Approved Section 96 (1A) ~~1A~~ Modification Application

No. 2 granted on the 19 JUNE '18

in respect to MP SSD 7140

Signed [Signature]

Sheet No. 2 of 7

Note: Section 4.55 Handball Court Modification

- (A) Existing wall to be demolished shown hatched
- (B) Portion of existing wall to be retained

RL 36.72

4

Existing Handball courts to be modified.
Refer to Landscape Architect's plan for proposed landscaping layout.

RL 37.33



RL 37.18

3

RL 37.27

2

1 Plan
DA107 Scale: 1:100

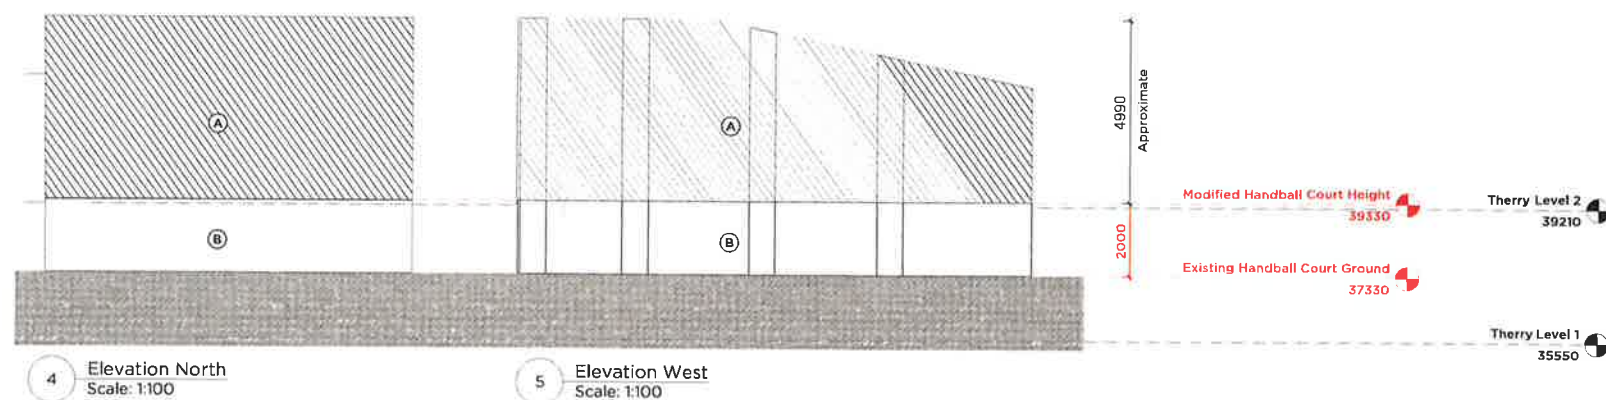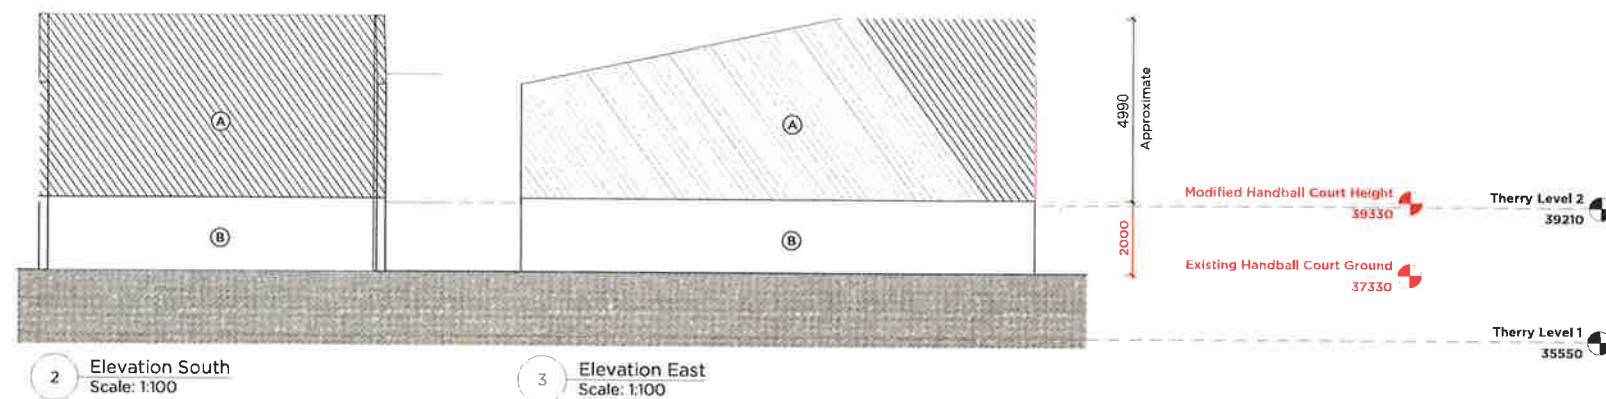

PMDL

ARCHITECTURE
INTERIORS
MASTERPLANNING


pmdl.com.au

16/05/18 Section 4.55 Application - Handball Court Modification

DATE	REVISION	BY	DATE
16/05/18	1	DA107	2496
16/05/18	2	DA107	2496
16/05/18	3	DA107	2496
16/05/18	100	DA107	2496

Legend:

-  Existing Building - No Works
-  Existing Building to be refurbished
-  Proposed Works
-  Proposed Walls
-  Existing walls and structure

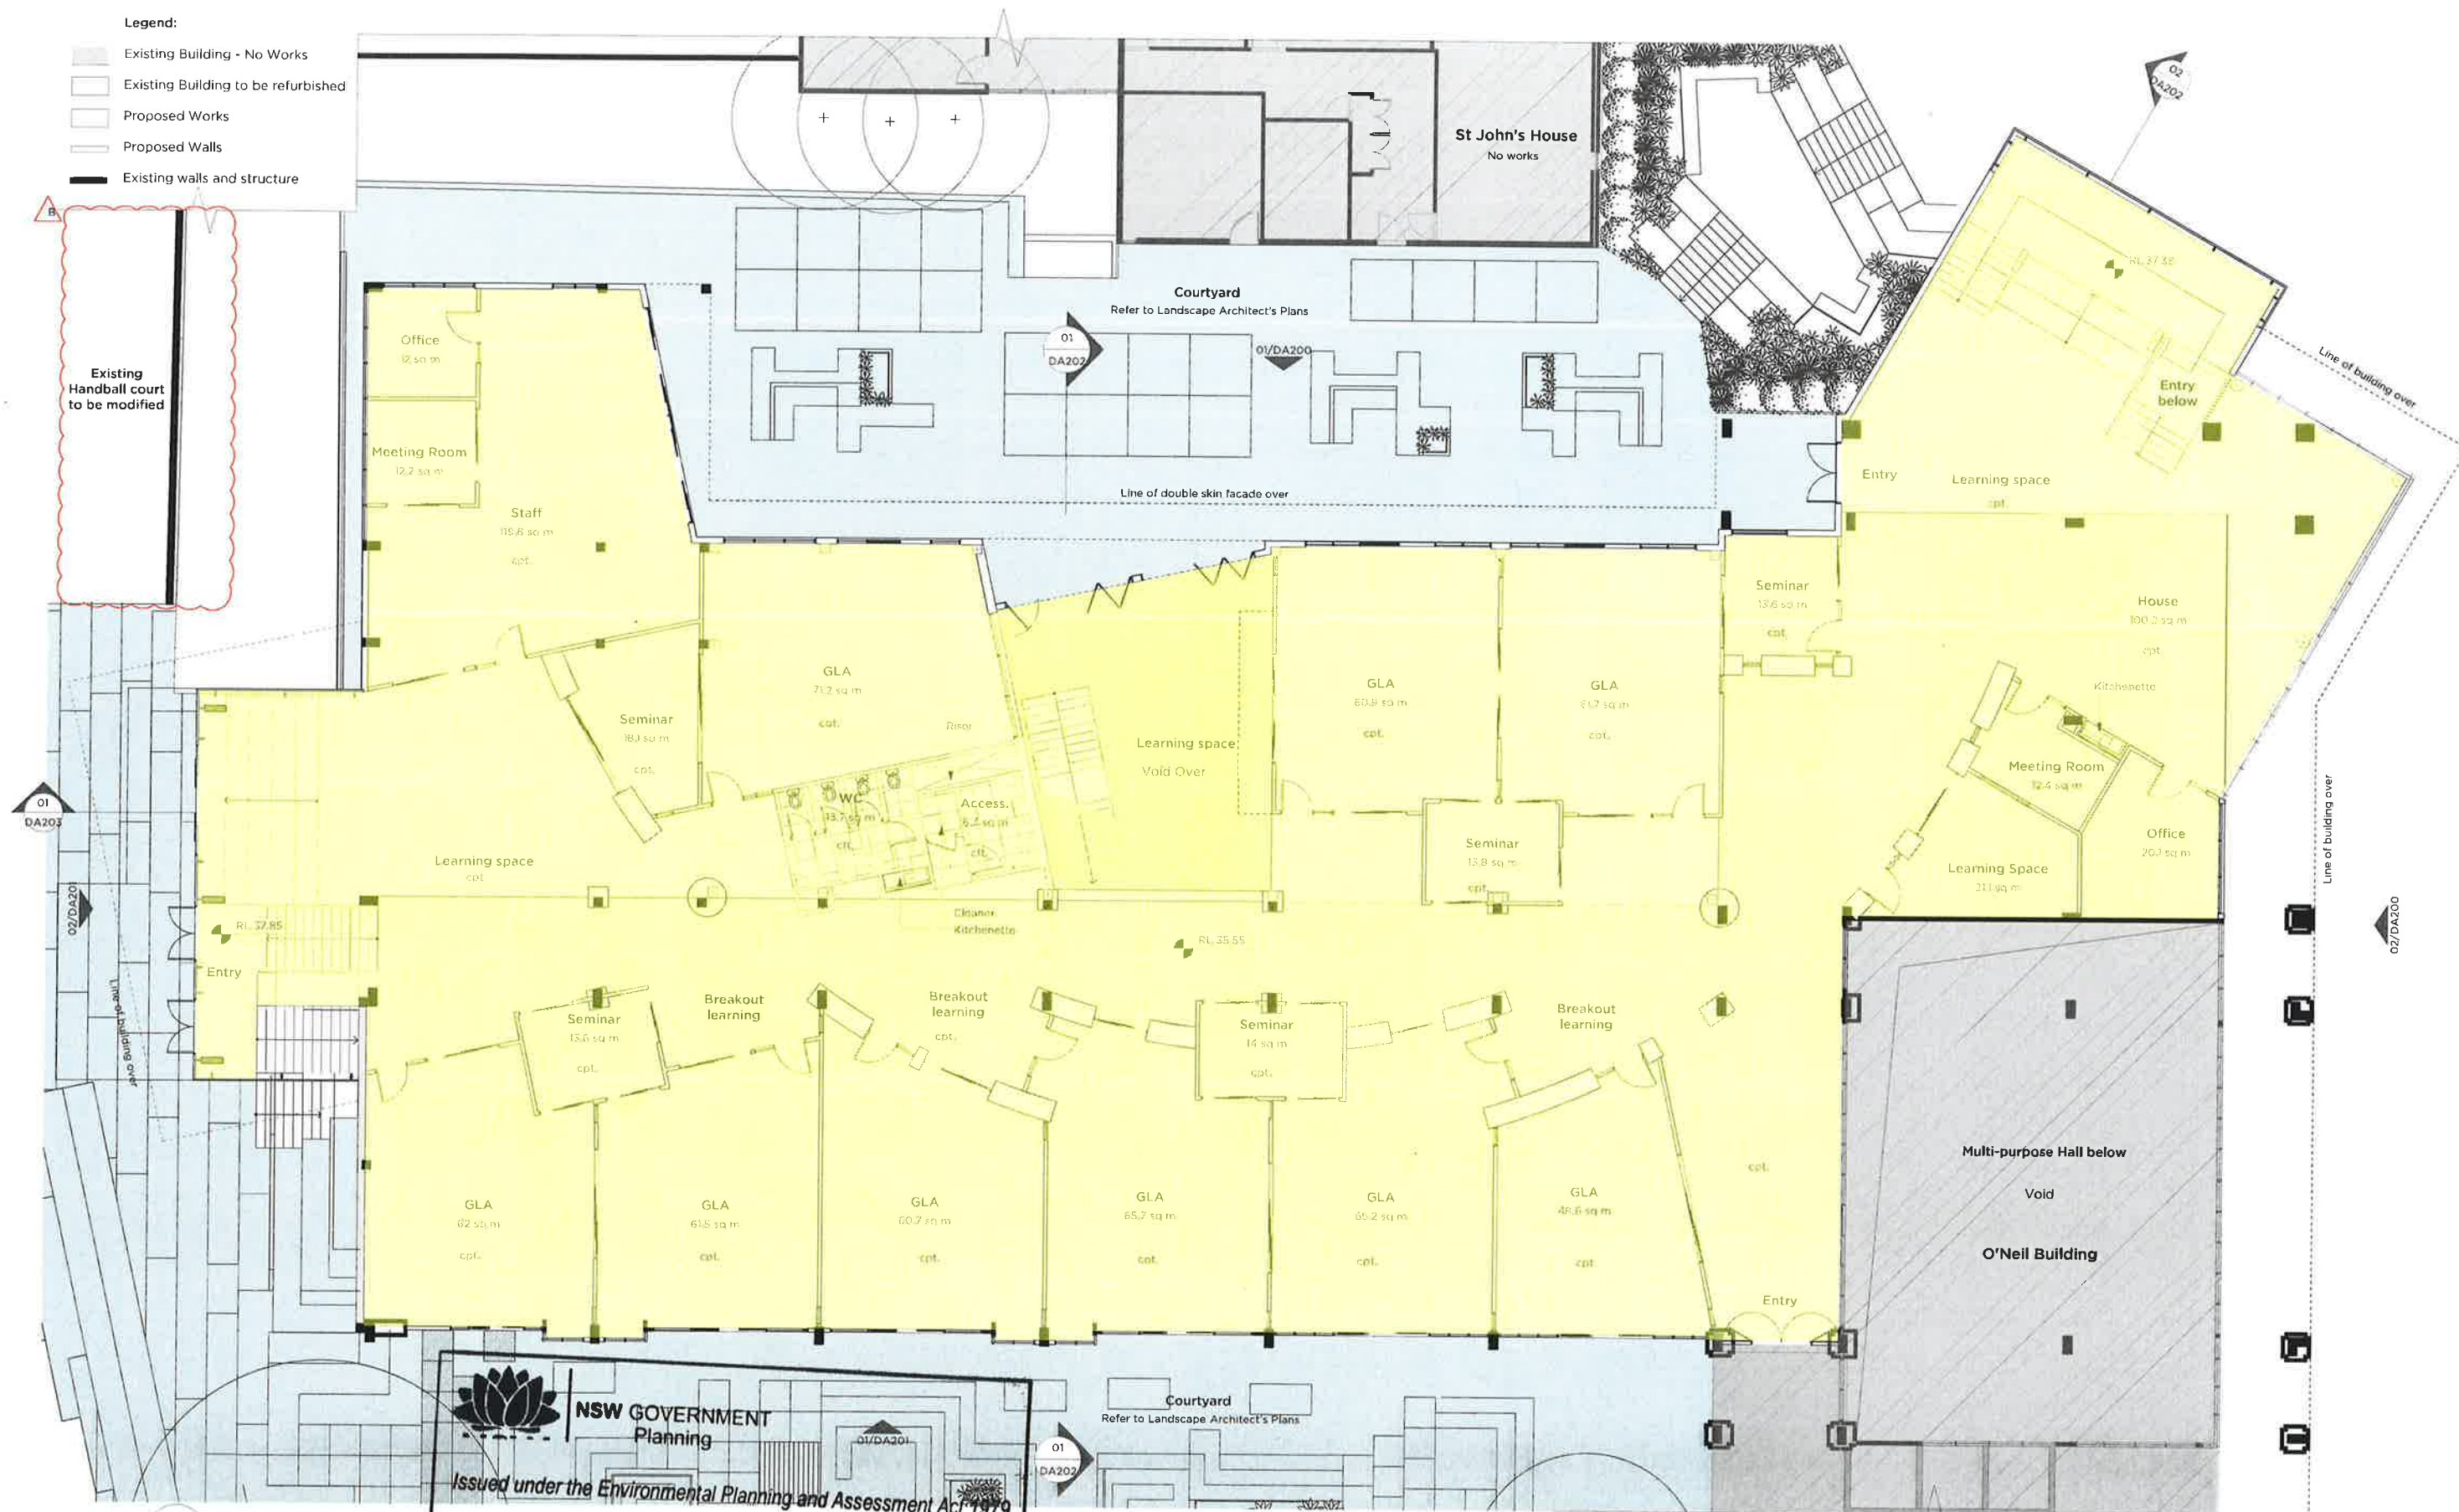

 **NSW GOVERNMENT Planning**

Issued under the Environmental Planning and Assessment Act 1979

Approved Section 96 (1A) ~~1A~~ ~~1A~~ Modification Application
 No. 2 granted on the 19 June 18
 in respect to MP SSD 7140
 Signed [Signature]
 Sheet No. 3 of 7



PMDL

pmdl.com.au

ARCHITECTURE
INTERIORS
MASTERPLANNING

10/5/18 Section 4.55 Application- Handball Court Modification		
ISSUED	DATE	REVISION
0mm	50mm	100mm
DO NOT SCALE FROM THIS DRAWING. USE DIMENSIONS SHOWN ON DRAWING. CHECK ALL DIMENSIONS ON SITE BEFORE HANDING OVER FOR CONSTRUCTION.		
Masterplan Stage 1		2496
Saint Ignatius' College		
Level 1 Plan RL 35.55		DA-121
Revised	Scale	1:100 (A1)
Revised	Scale	1:100 (A1)

Legend:

-  Existing Building - No Works
-  Existing Building to be refurbished
-  Proposed Works
-  Proposed Walls
-  Existing walls and structure

Existing Handball court modified (reduced in height shown dotted below)



**NSW GOVERNMENT
Planning**

Issued under the Environmental Planning and Assessment Act 1979

Approved Section 96 (1A) ~~1A~~ Modification Application

No. 2 granted on the 19 JUNE '18

in respect to MP SSD 7140

Signed [Signature]

Sheet No. 4 of 7

01 Level 2 Plan RL 39.215
DA-122



PMDL

**ARCHITECTURE
INTERIORS
MASTERPLANNING**

pmdl.com.au

NSW GOVERNMENT ARCHITECTURE AND INTERIORS

ISSUE	DATE	REVISION	BY	CHKD
1	10/5/18	Section 4 55 Application- Handball Court Modification		
2				
3				
4				
5				
6				
7				
8				
9				
10				

Masterplan Stage 1 2496

Saint Ignatius' College

Level 2 Plan RL 39.215 DA-122

B



NSW GOVERNMENT
Planning

Issued under the Environmental Planning and Assessment Act 1979

Approved Section 96 (1A) ~~MP~~ ~~MP~~ Modification Application

No. 2 granted on the 19 JUNE 18


in respect to MP SSD 7140

Signed [Signature]

Sheet No. 6 of 7

Legend:

- Existing Building - No Works
- Existing Building to be refurbished
- Existing Walls to be demolished
- Existing walls and structure

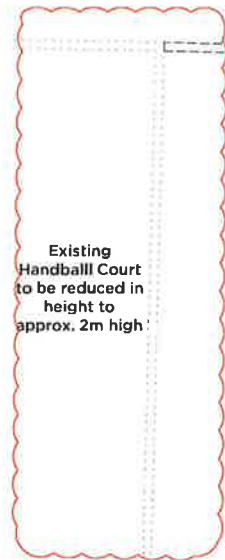

Demolish remnant handball court walls.
Refer to Heritage Consultant report.

St John's House below
No works


Demolish
existing stair,
landing and
balustrades

Demolish existing
balustrade

Demolish
existing stair,
landing and
balustrades

Demolish existing
balustrade

Demolish
existing brick
balustrade shown
dashed.

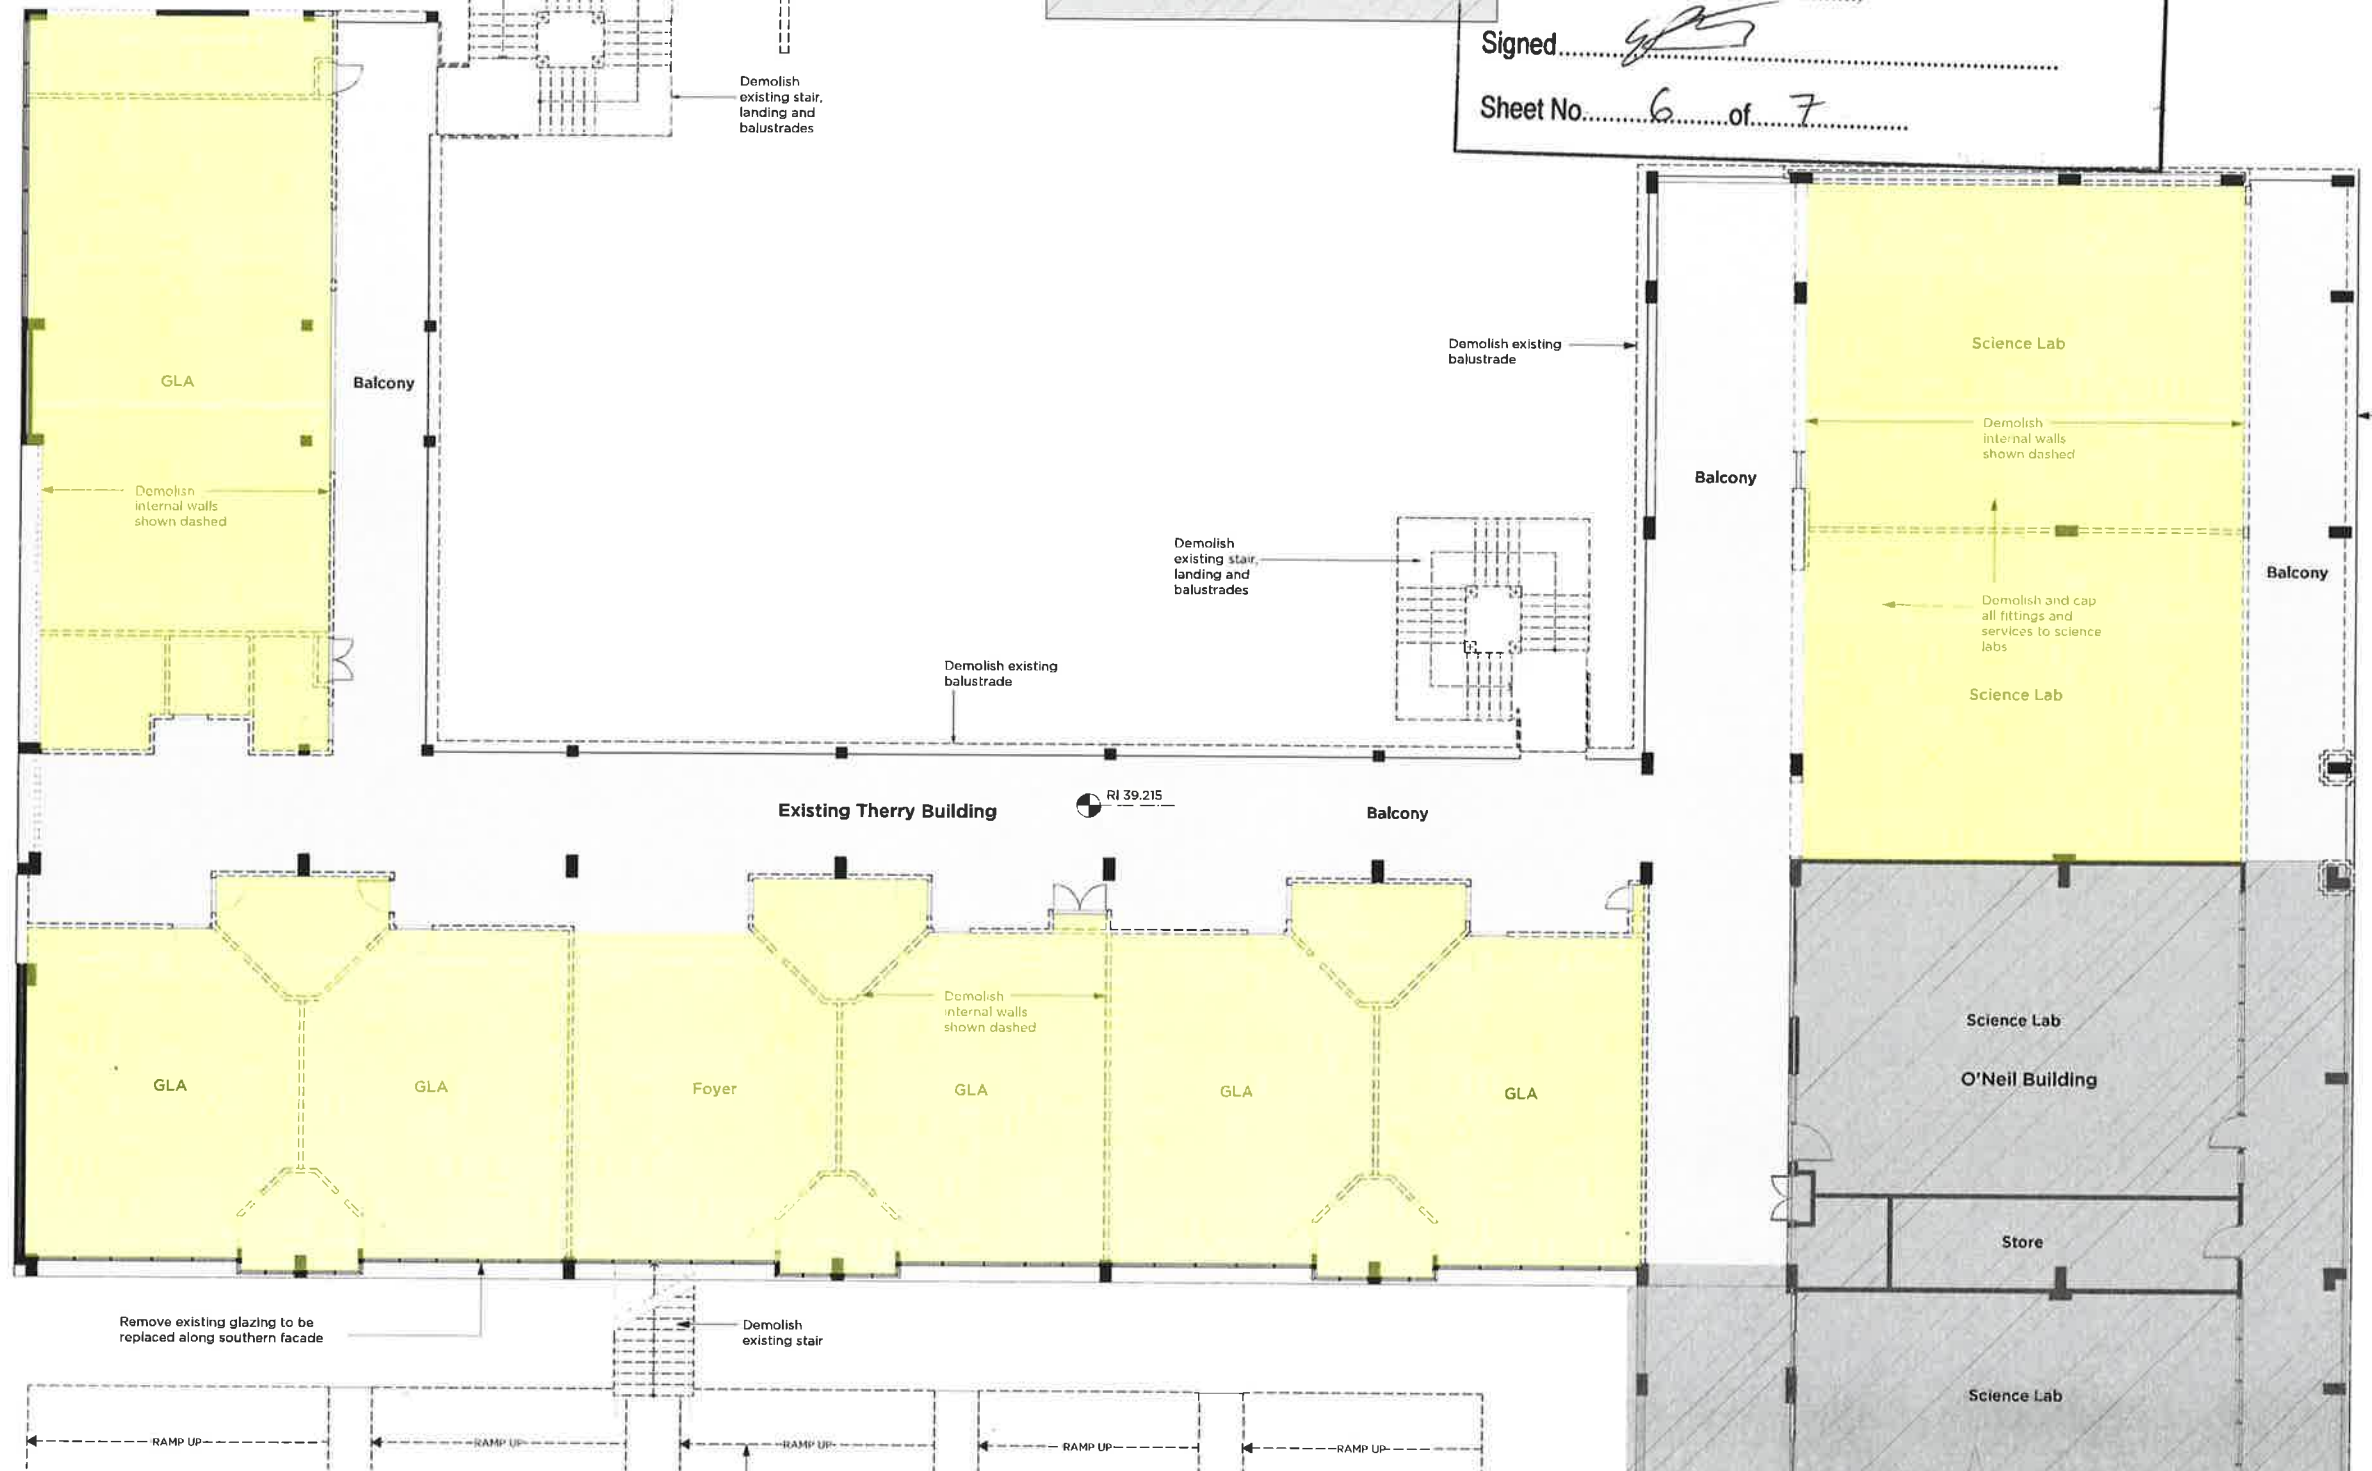

2 Level 2 Demolition Plan RL 39.215
DA-132



PMDL

ARCHITECTURE
INTERIORS
MASTERPLANNING

pmdl.com.au

PMIA, ARCHITECTURE, INTERIORS, MASTERPLANNING
PMDL ARCHITECTURE, INTERIORS, MASTERPLANNING
PMDL ARCHITECTURE, INTERIORS, MASTERPLANNING

ISSUE	DATE	REVISION	BY	APP'D
1	10/5/18	Section 4.55 Application-Handball Court Modification		
2				
3				
