

unauthorised use of this document is an infringement of Ridley's and Make's rights and is at the user's sole risk and liability. KEYPLAN BUILDING BENT STREET GENERAL ARRANGEMENT GENERAL NOTES DIMENSIONS ARE IN MILLIMETERS UNO.
 DO NOT SCALE OFF DRAWING.
 ALL DIMENSIONS TO BE VERIFIED ON SITE BEFORE 4. ALL DISCREPANCIES TO BE VERIFIED ON SITE BEFORE
4. ALL DISCREPANCIES TO BE NOTIFIED IN WRITING TO RIDLEY CONSOLIDATED GROUP PTY LIMITED
("RIDLEY" AND MAKE) LEGEND: SITE BOUNDARY PRIMARY ENTRANCE SECONDARY ENTRANCE STAFF ENTRANCE (A)ACCESSIBLE ROOM WASTE W RECYCLING EDUCATION BUILDING KEY COUNT: 22 m mm mm

INTELLECTUAL PROPERTY

03 SECTION 4.55 SUBMISSION -AMENDMENT 02 SECTION 4.55 SUBMISSION01 DEVELOPMENT APPLICATION 00 DRAFT DA APPLICATION ISSUE DESCRIPTION DESIGN ARCHITECT make EXECUTIVE ARCHITECT

Ridley INTERIOR DESIGNER BAR CLIENT

PONTIAC LAND (AUSTRALIA) PTY. LTD.

PROJECT


SANDSTONE PRECINCT 23-39 BRIDGE STREET, SYDNEY 2000, AUSTRALIA

PROJECT NUMBER SCALE 1 : 200@B<sup>·</sup> STATUS


FOR APPROVAL DRAWING PROPOSED PLANS

LANDS BUILDING - LEVEL 09, EDUCATION BUILDING -LEVEL 08

DRAWING NUMBER SP-DA-G-2508

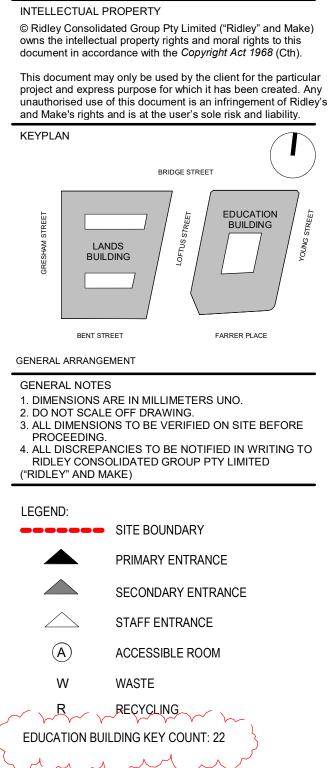




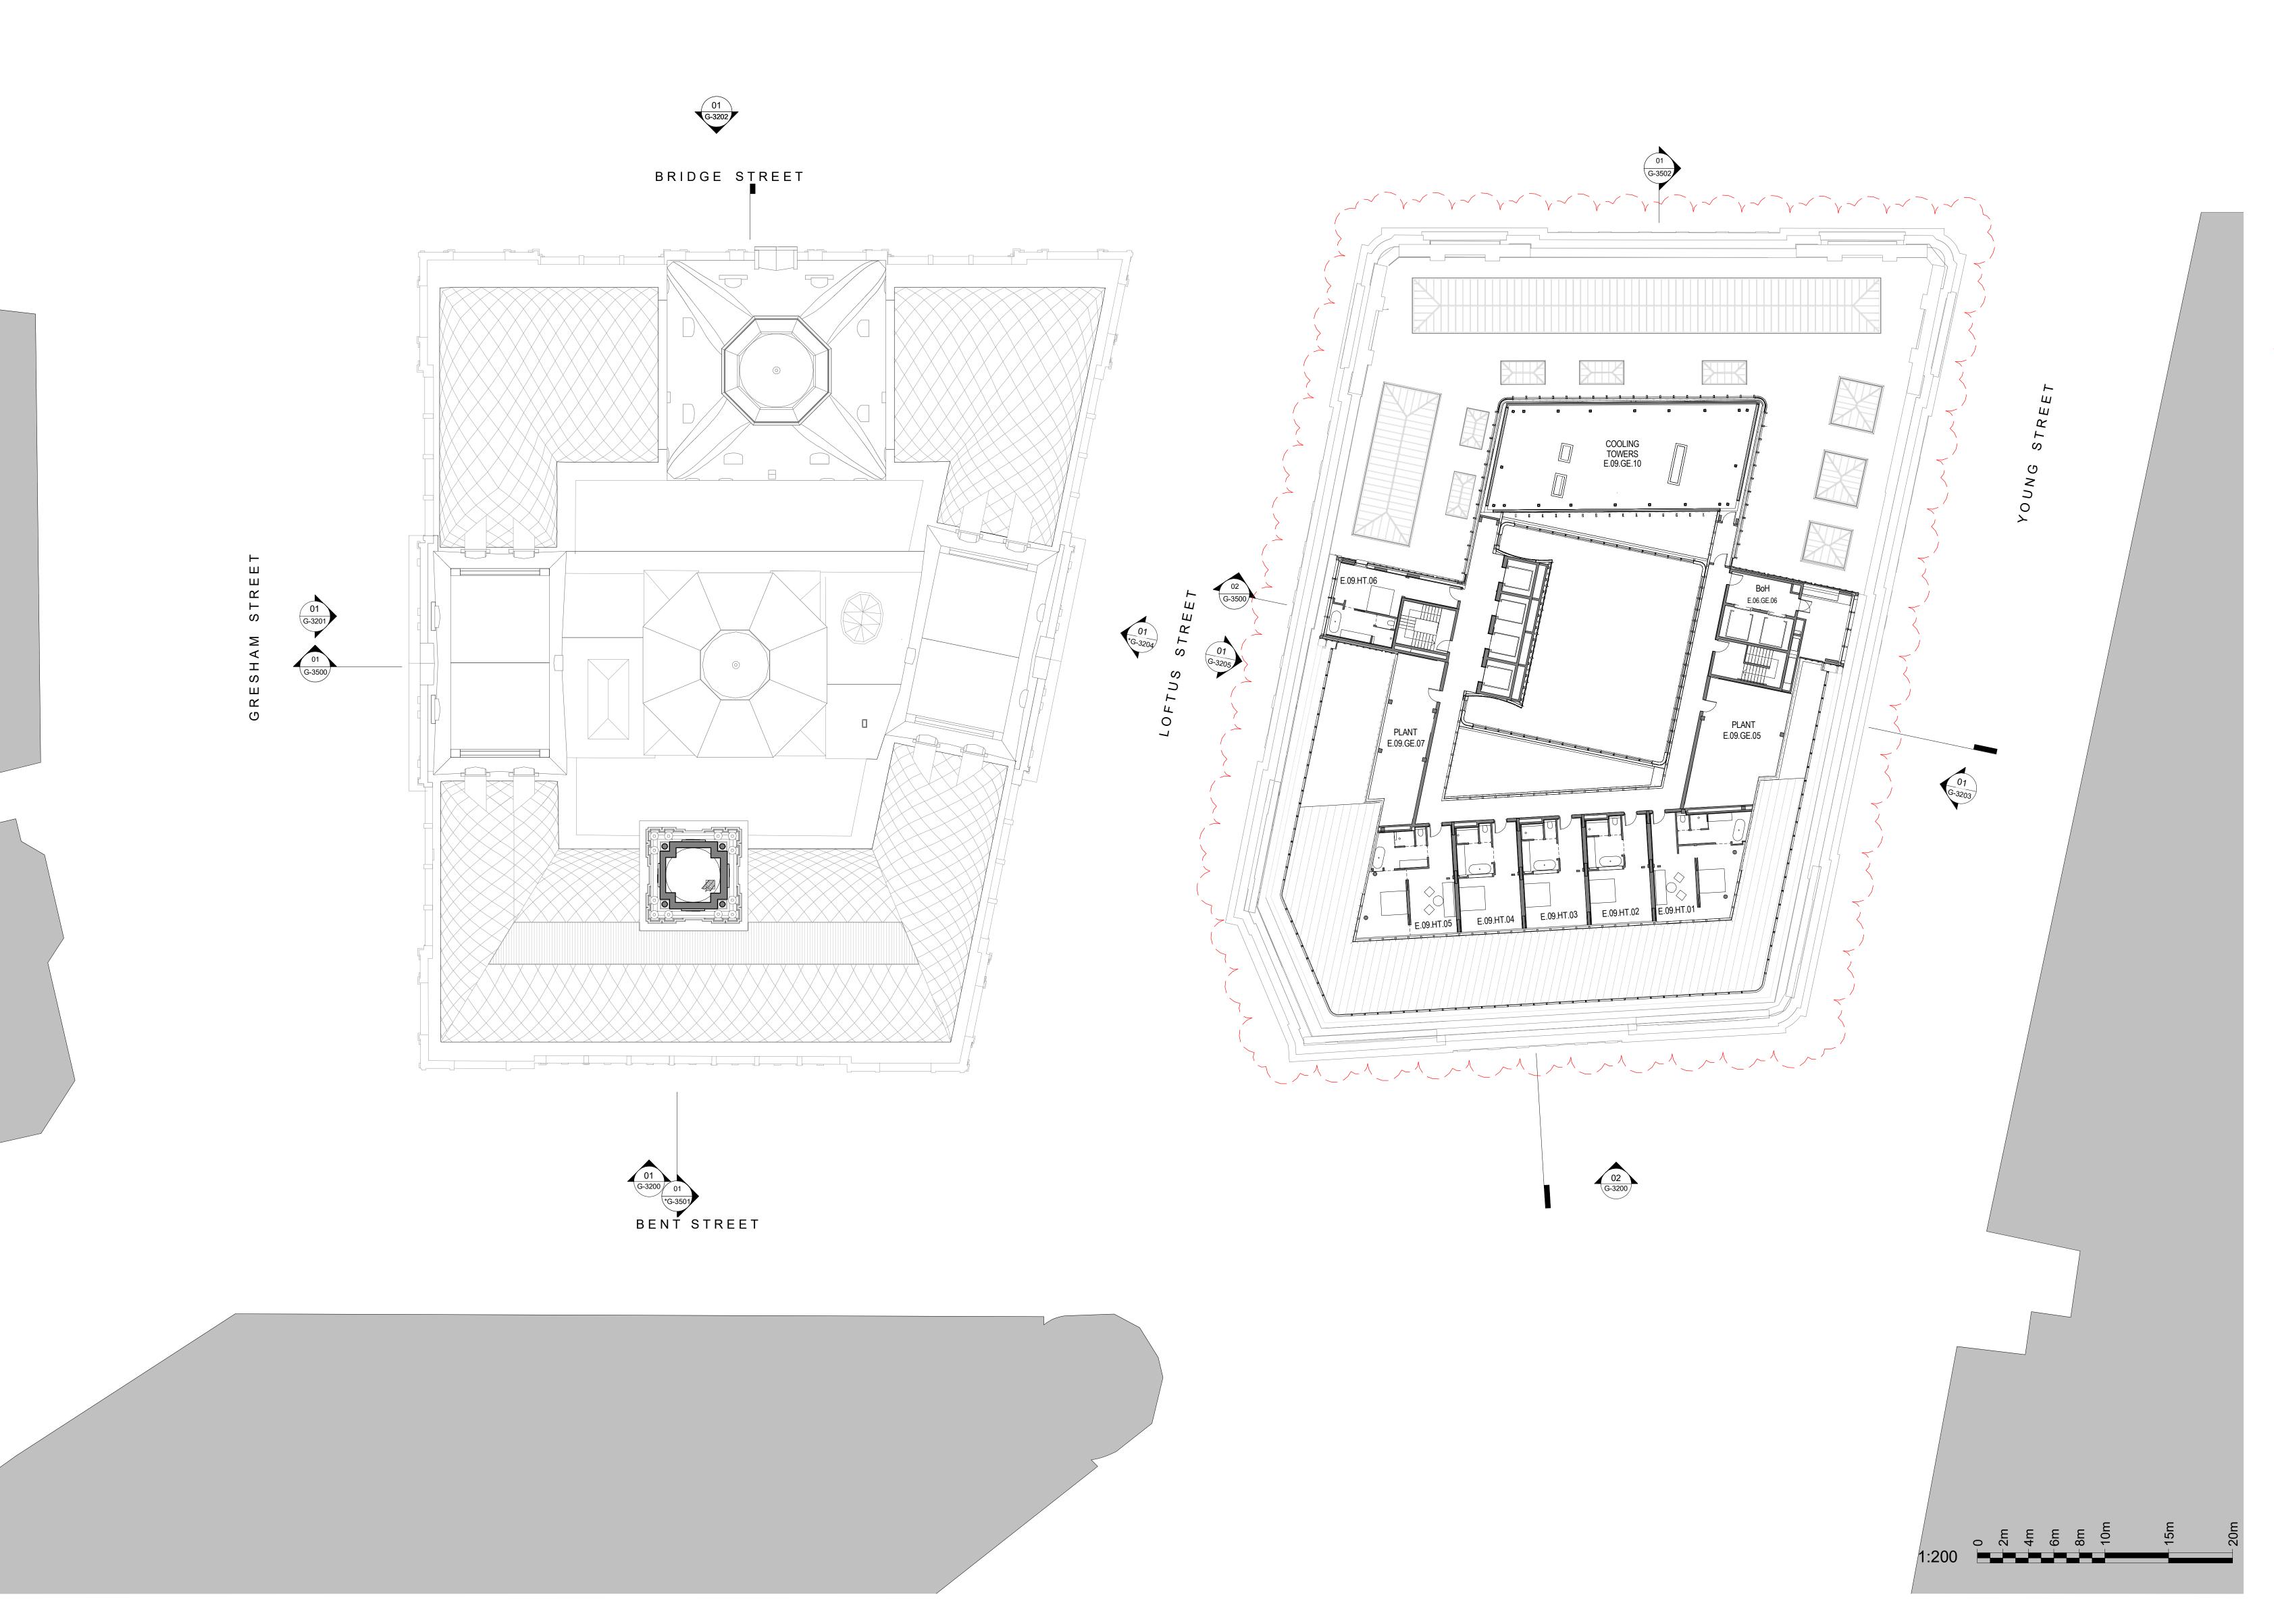


### This document may only be used by the client for the particular project and express purpose for which it has been created. Any unauthorised use of this document is an infringement of Ridley's and Make's rights and is at the user's sole risk and liability. KEYPLAN BUILDING BENT STREET GENERAL ARRANGEMENT GENERAL NOTES DIMENSIONS ARE IN MILLIMETERS UNO. DO NOT SCALE OFF DRAWING. ALL DIMENSIONS TO BE VERIFIED ON SITE BEFORE 4. ALL DISCREPANCIES TO BE VERIFIED ON SITE BEFORE 4. ALL DISCREPANCIES TO BE NOTIFIED IN WRITING TO RIDLEY CONSOLIDATED GROUP PTY LIMITED ("RIDLEY" AND MAKE) LEGEND: SITE BOUNDARY PRIMARY ENTRANCE $\bigtriangleup$ STAFF ENTRANCE (A)WASTE W RECYCLING EDUCATION BUILDING KEY COUNT: 6 m m m m m

DRAWING NUMBER SP-DA-G-2509 03

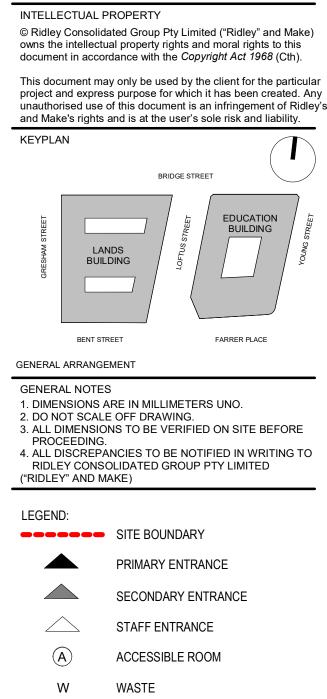

	′EL 10, -
<b>IS</b>	
AL	
JG	CZ
	CHECKED
)00, AUSTRA	LIA
-	
TD.	
,	
	DATE
N	06.10.16 02.09.16
	19.09.18
	TD. 166 DRAWN JG AL

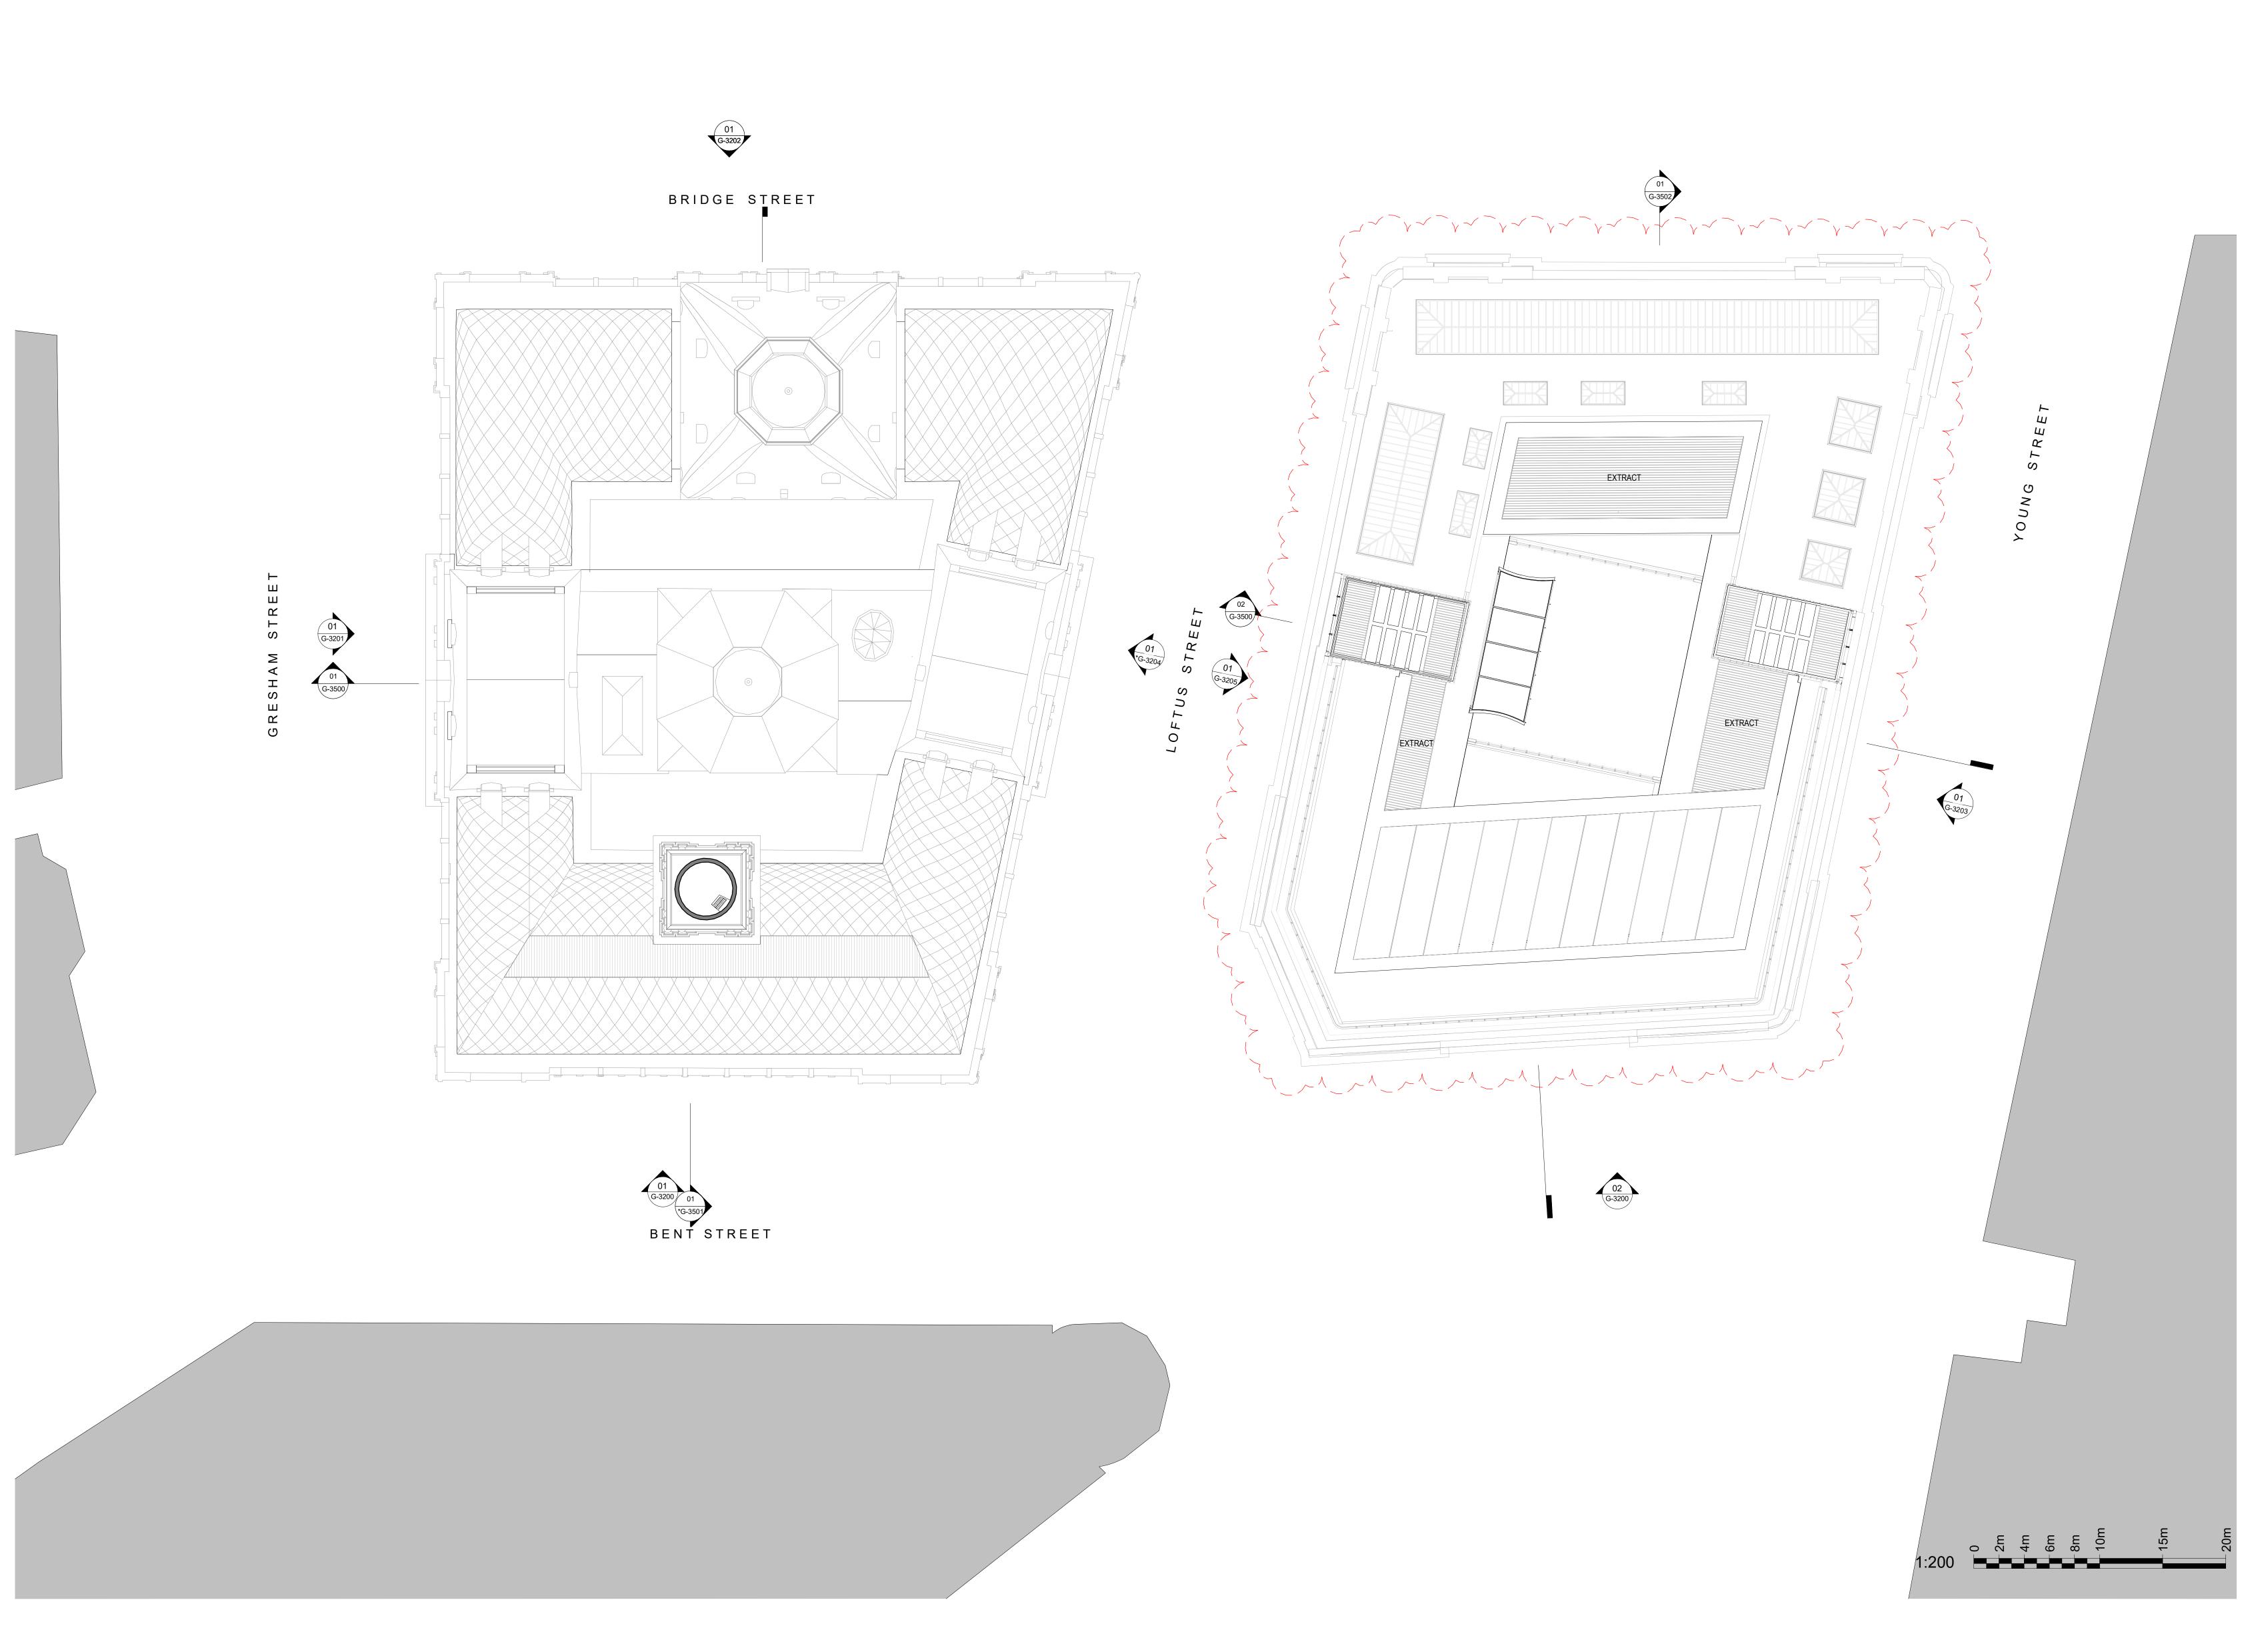

### This document may only be used by the client for the particular project and express purpose for which it has been created. Any unauthorised use of this document is an infringement of Ridley's and Make's rights and is at the user's sole risk and liability. KEYPLAN BUILDING BENT STREET GENERAL ARRANGEMENT GENERAL NOTES 1. DIMENSIONS ARE IN MILLIMETERS UNO. 2. DO NOT SCALE OFF DRAWING. 3. ALL DIMENSIONS TO BE VERIFIED ON SITE BEFORE 9. ALL DIVIENSIONS TO BE VERY THE ON OTHER BEFORE PROCEEDING. 4. ALL DISCREPANCIES TO BE NOTIFIED IN WRITING TO RIDLEY CONSOLIDATED GROUP PTY LIMITED ("RIDLEY" AND MAKE) LEGEND: SITE BOUNDARY PRIMARY ENTRANCE STAFF ENTRANCE (A)ACCESSIBLE ROOM WASTE W RECYCLING R

INTELLECTUAL PROPERTY

02 SECTION 4.55 SUBMISSION
01 DEVELOPMENT APPLICATION
00 DRAFT DA APPLICATION ISSUE DESCRIPTION DESIGN ARCHITECT make EXECUTIVE ARCHITECT Ridley INTERIOR DESIGNER

BAR CLIENT PONTIAC LAND (AUSTRALIA) PTY. LTD.


PROJECT

SANDSTONE PRECINCT 23-39 BRIDGE STREET, SYDNEY 2000, AUSTRALIA


PROJECT NUMBER SCALE 1 : 200@B<sup>·</sup>


STATUS FOR APPROVAL DRAWING PROPOSED PLANS


DRAWING NUMBER SP-DA-G-2510 03

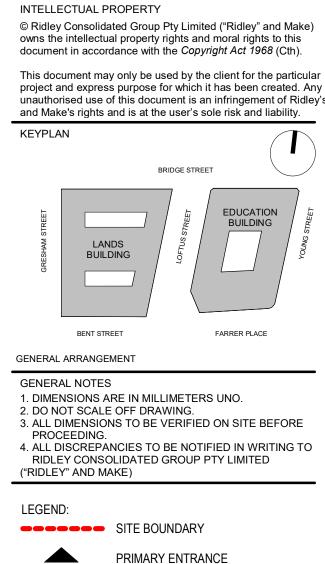

SECONDARY ENTRANCE

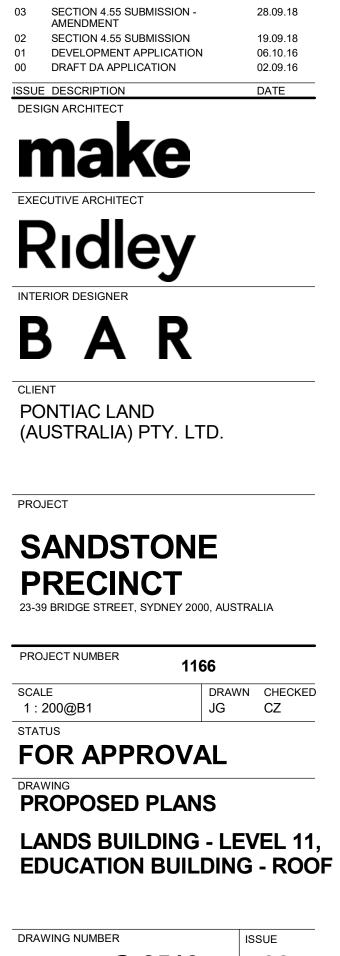

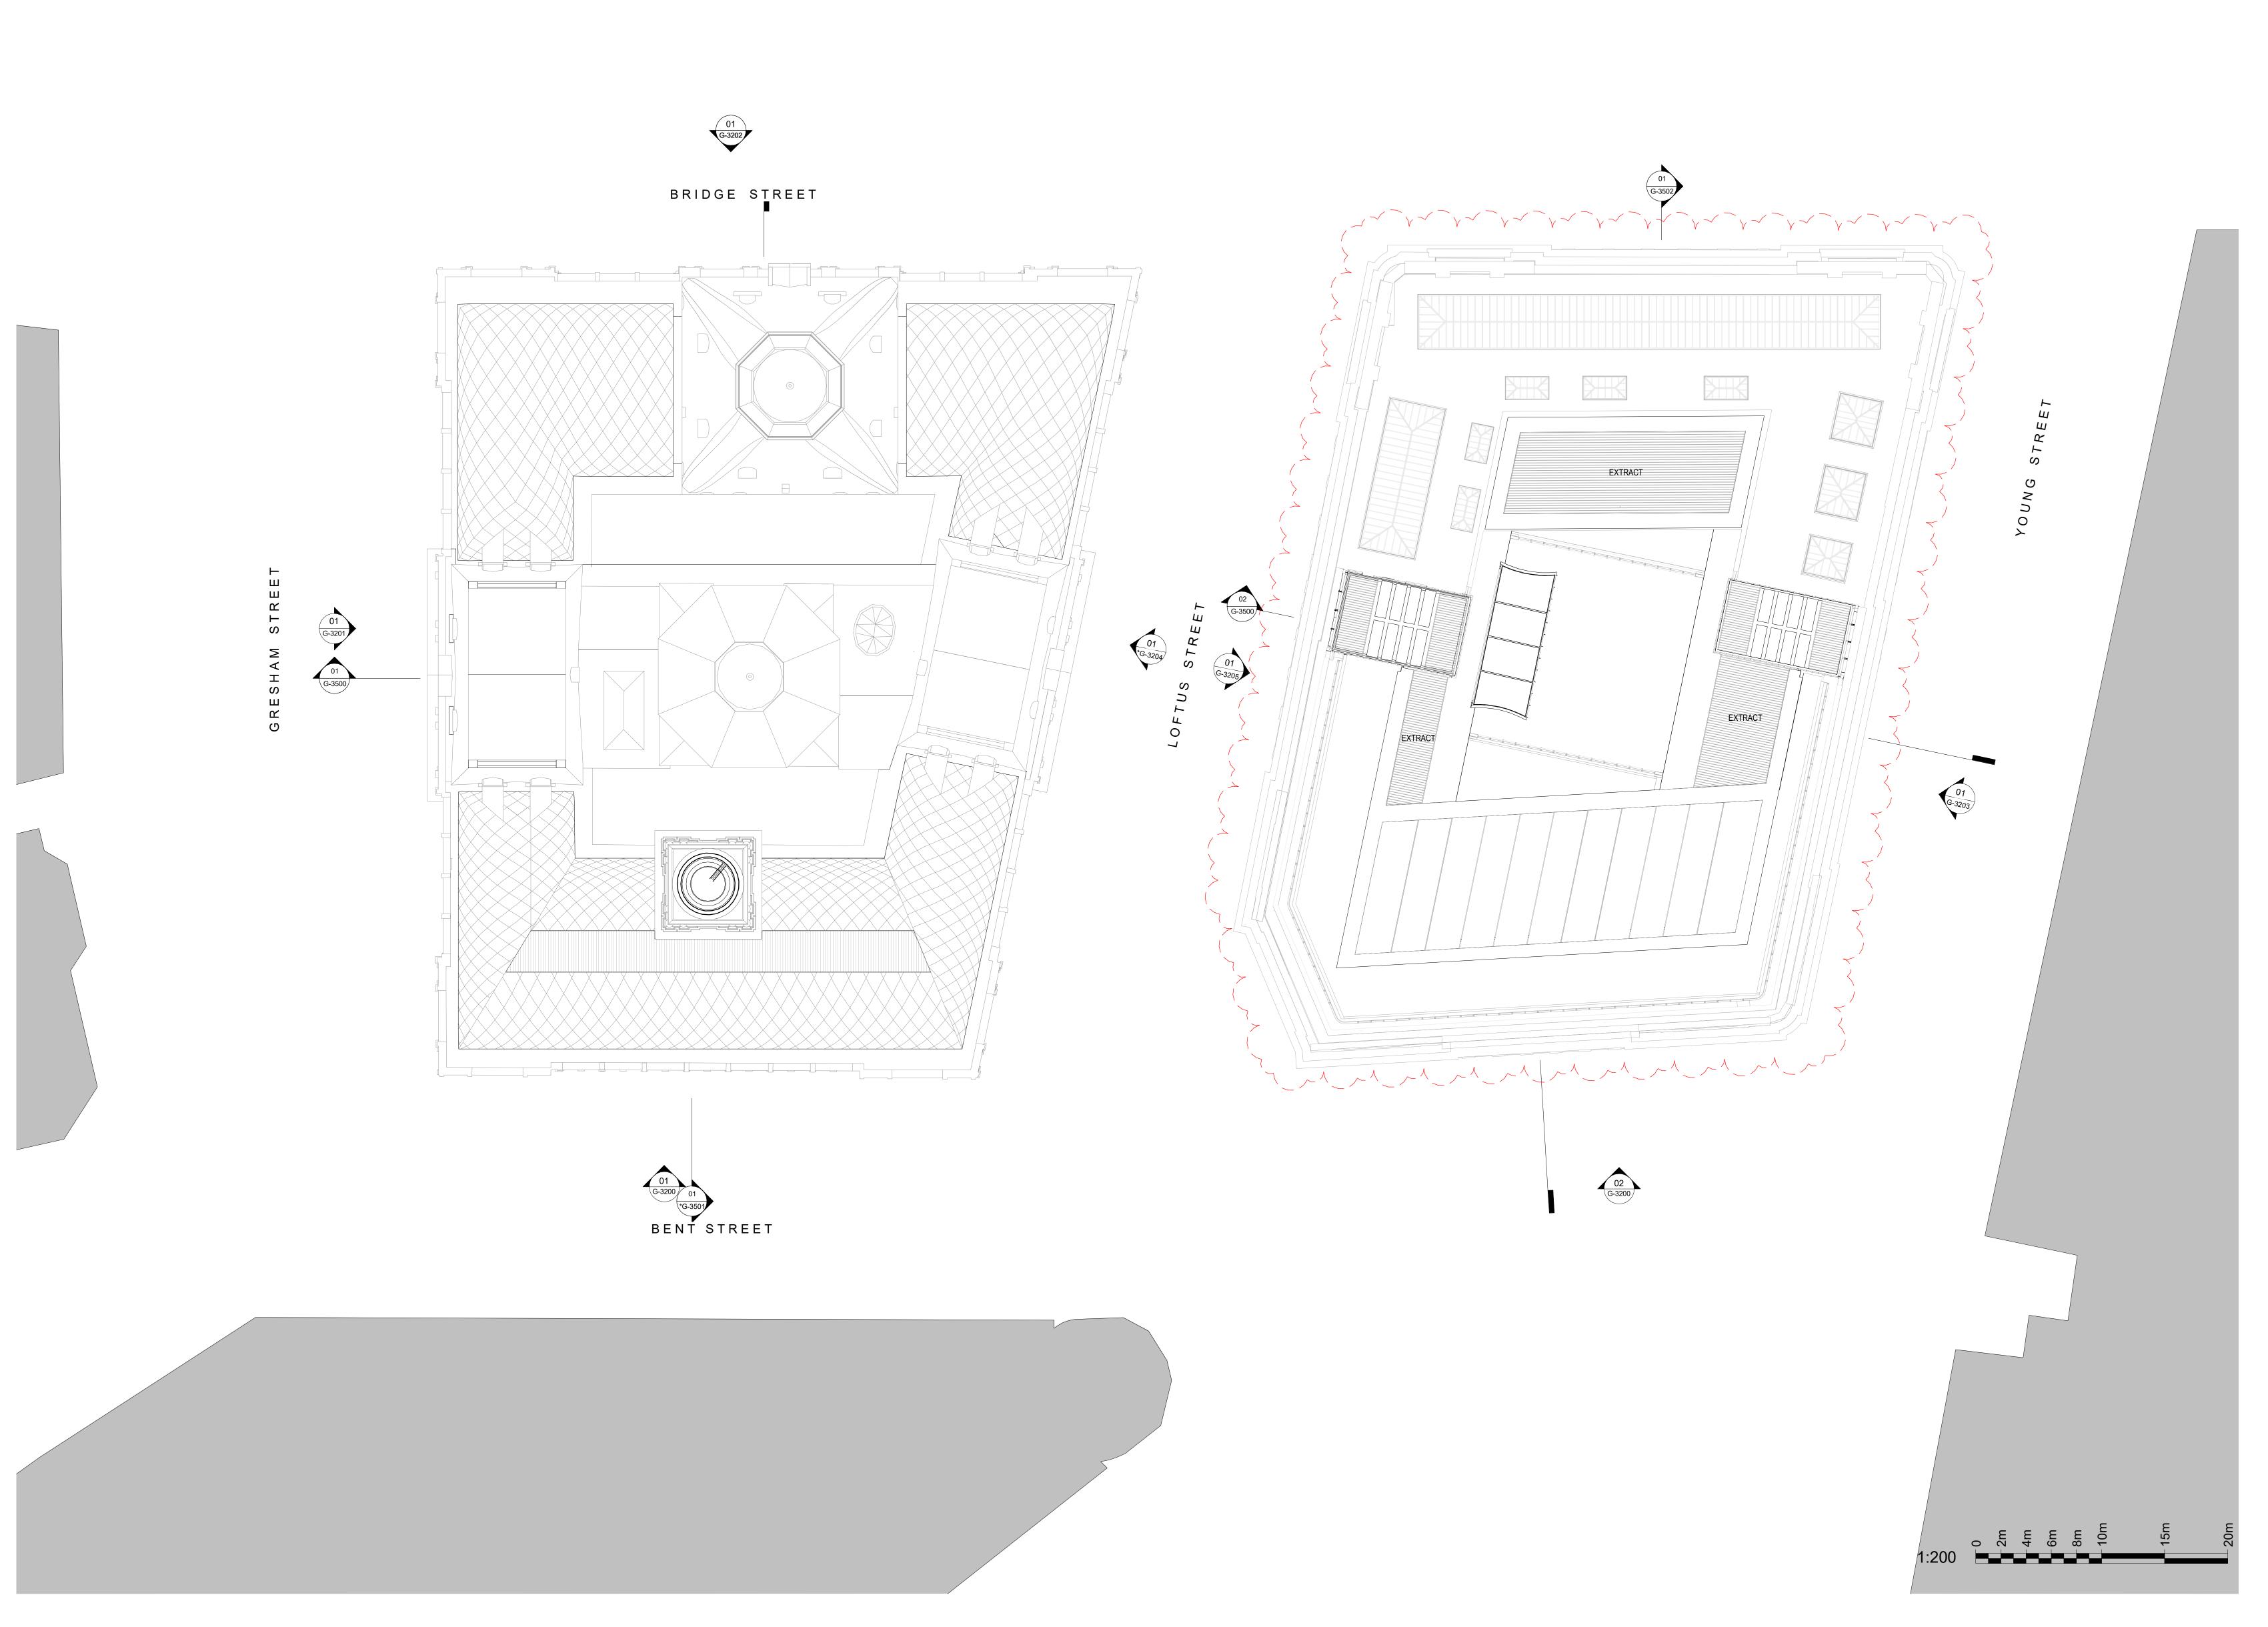

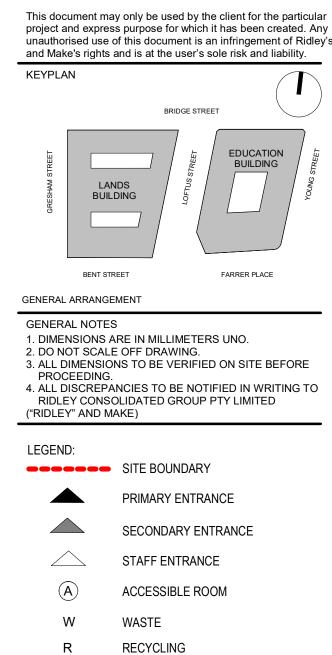





03 SECTION 4.55 SUBMISSION -AMENDMENT 02 SECTION 4.55 SUBMISSION01 DEVELOPMENT APPLICATION 19.09.18 06.10.16 02.09.16 00 DRAFT DA APPLICATION DATE make Ridley INTERIOR DESIGNER BAR CLIENT PONTIAC LAND (AUSTRALIA) PTY. LTD. PROJECT SANDSTONE PRECINCT 23-39 BRIDGE STREET, SYDNEY 2000, AUSTRALIA PROJECT NUMBER 1166 DRAWN CHECKED JG CZ SCALE 1 : 200@B<sup>·</sup> STATUS FOR APPROVAL DRAWING PROPOSED PLANS LANDS BUILDING - LEVEL 12, EDUCATION BUILDING - ROOF ISSUE

28.09.18


DRAWING NUMBER SP-DA-G-2511 03

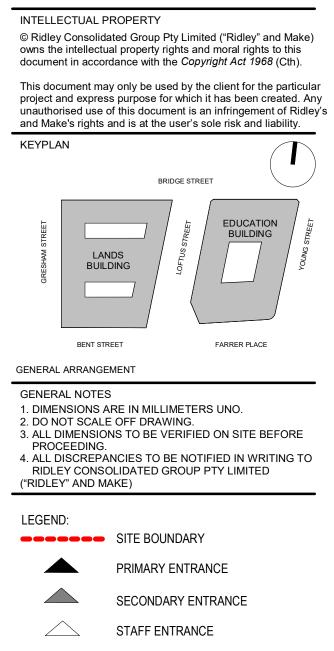

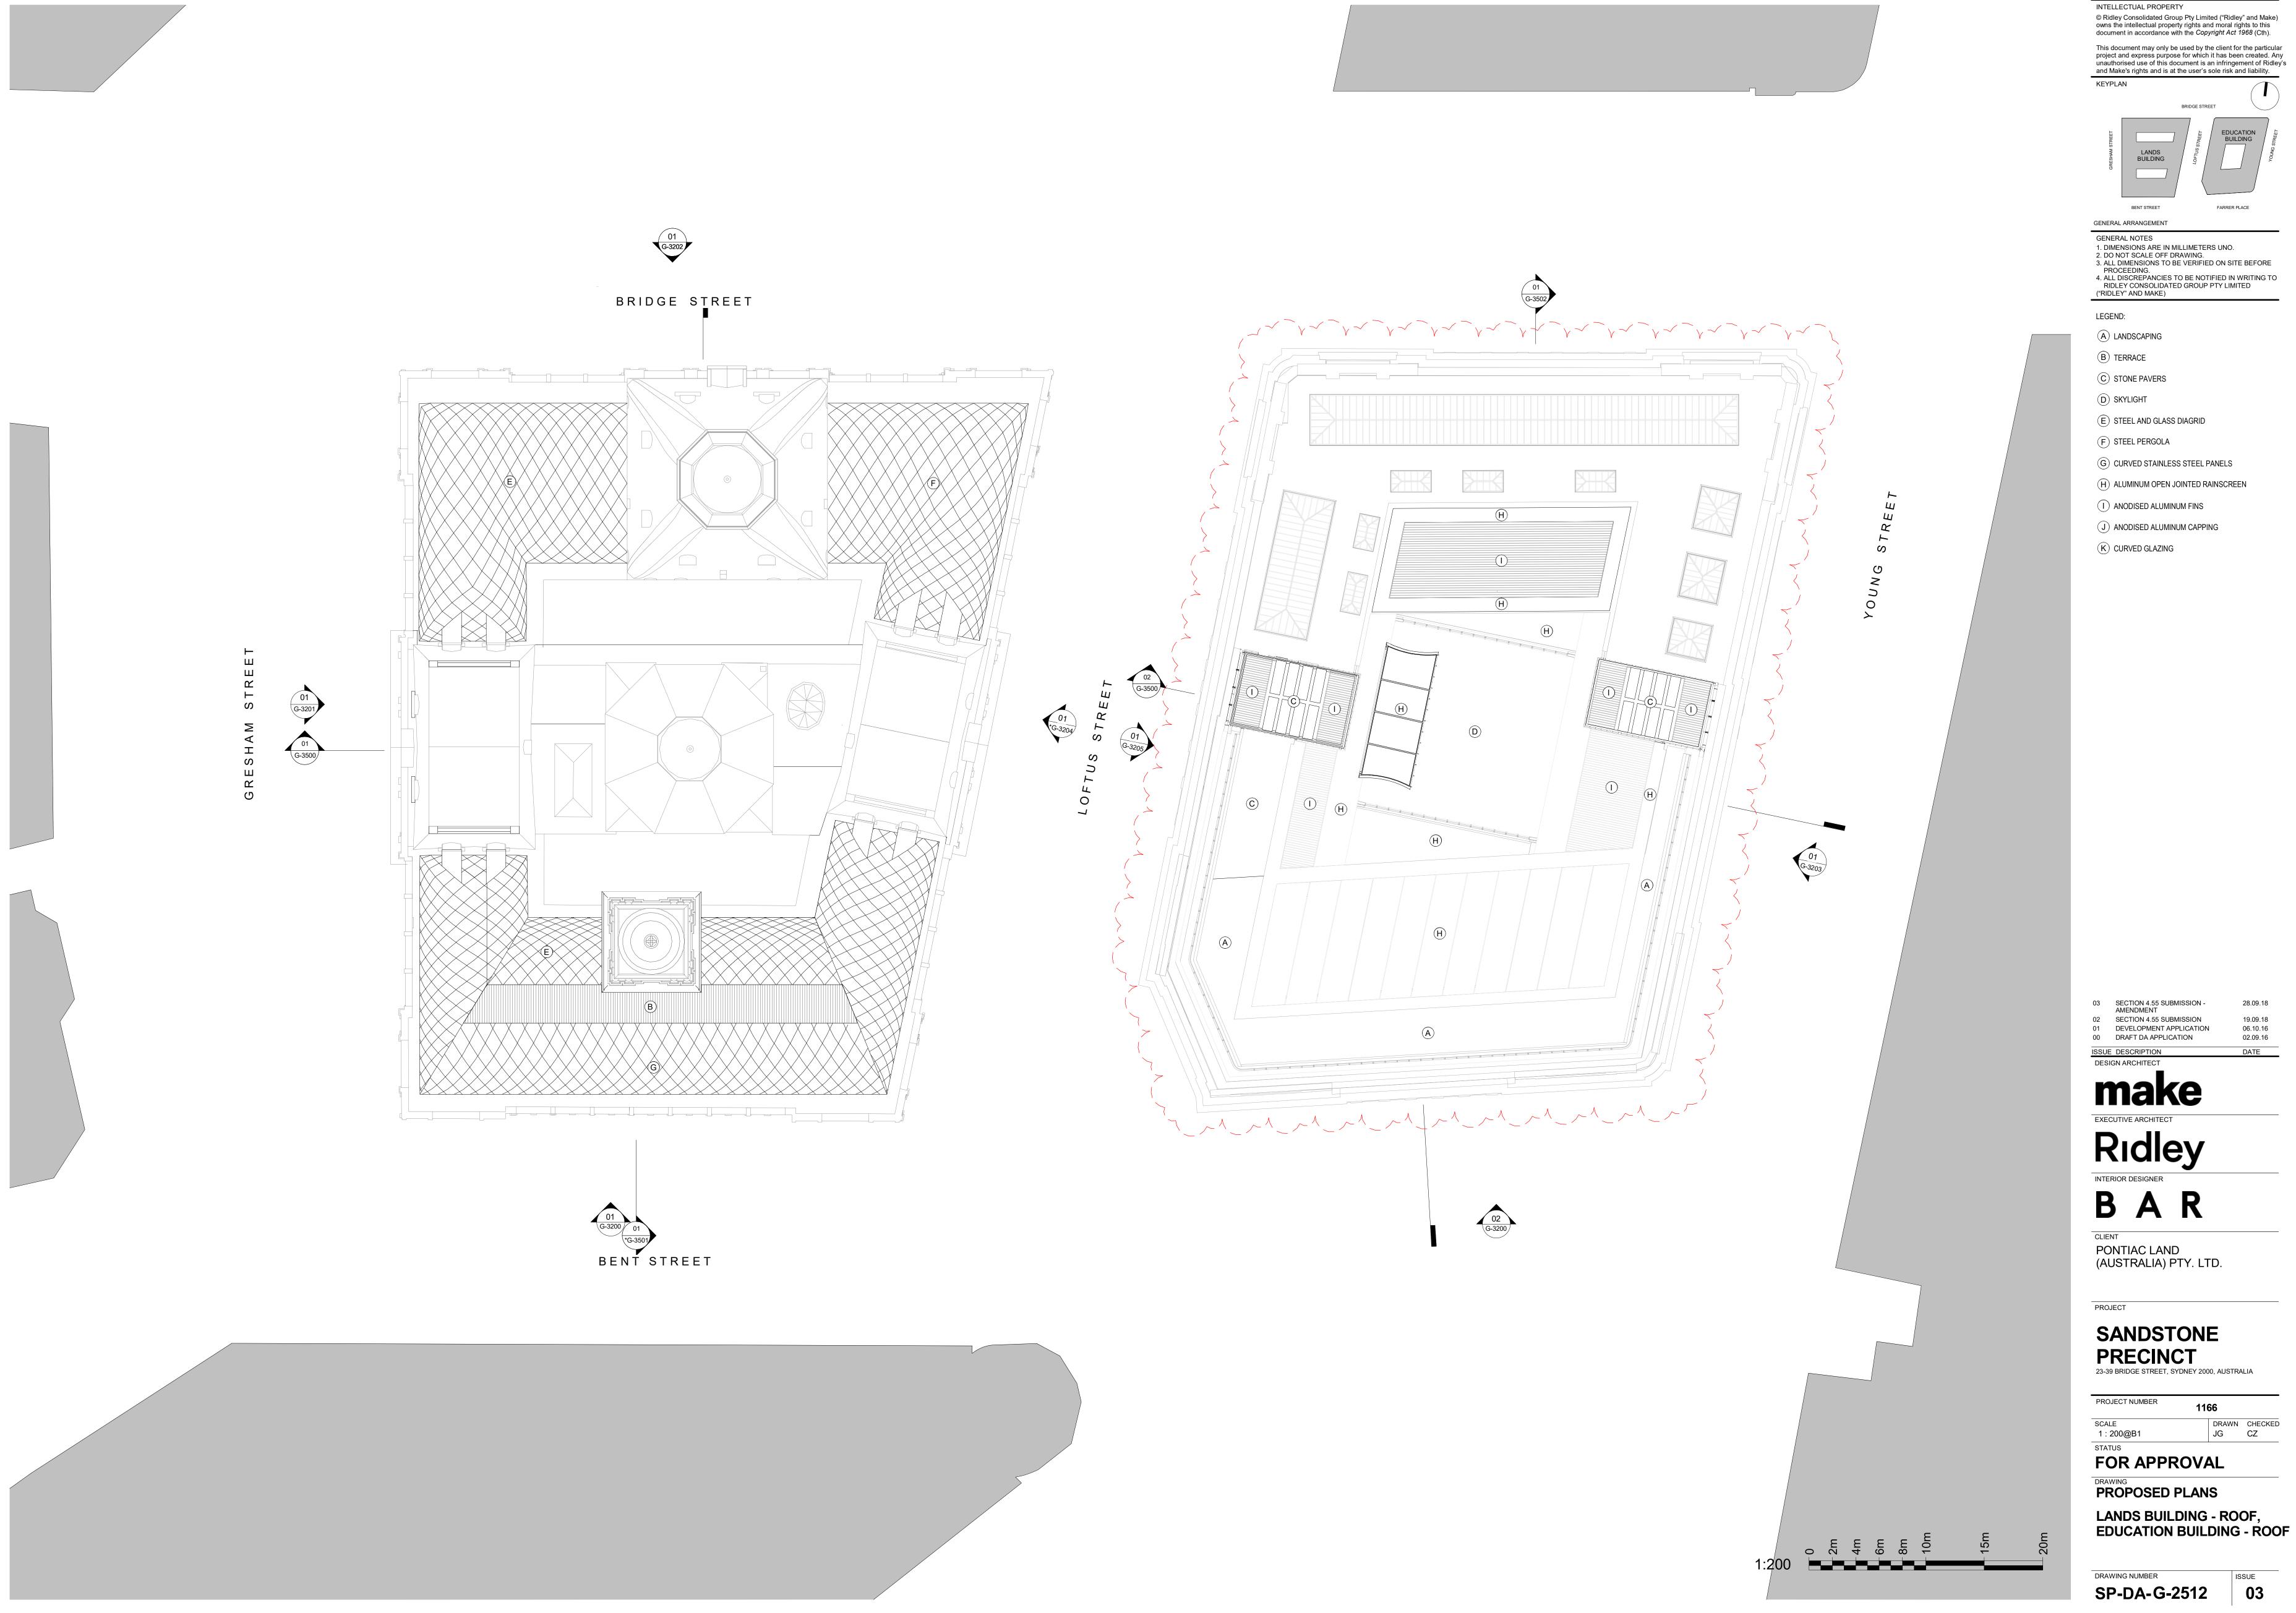






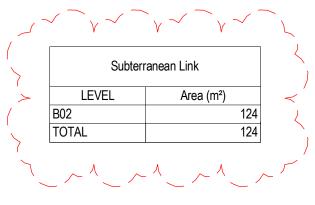

### Caveat

Any decisions to be made on the basis of these, whether as to project viability, pre-letting, lease agreements or the like, should include due allowance for the increases and decreases inherent in the design development and building processes.

We do not employ chartered surveyors and although we will measure areas for the purposes of interpreting your brief, these are solely for our use. We cannot be held responsible for any loss or damage arising from any use that you or any third party might make of the areas measured by us.

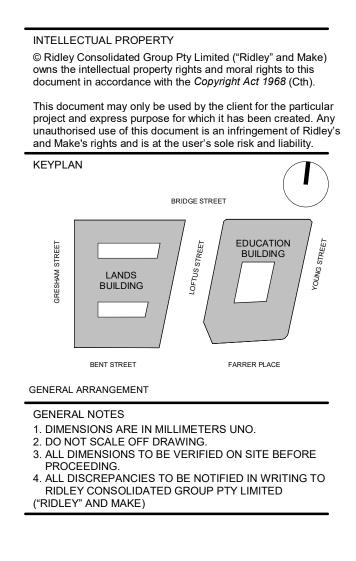






**GFA SCHEDULE** 


DRAWING NUMBER SP-DA-G-2720



# 01 LANDS BUILDING - PROPOSED SOUTH ELEVATION

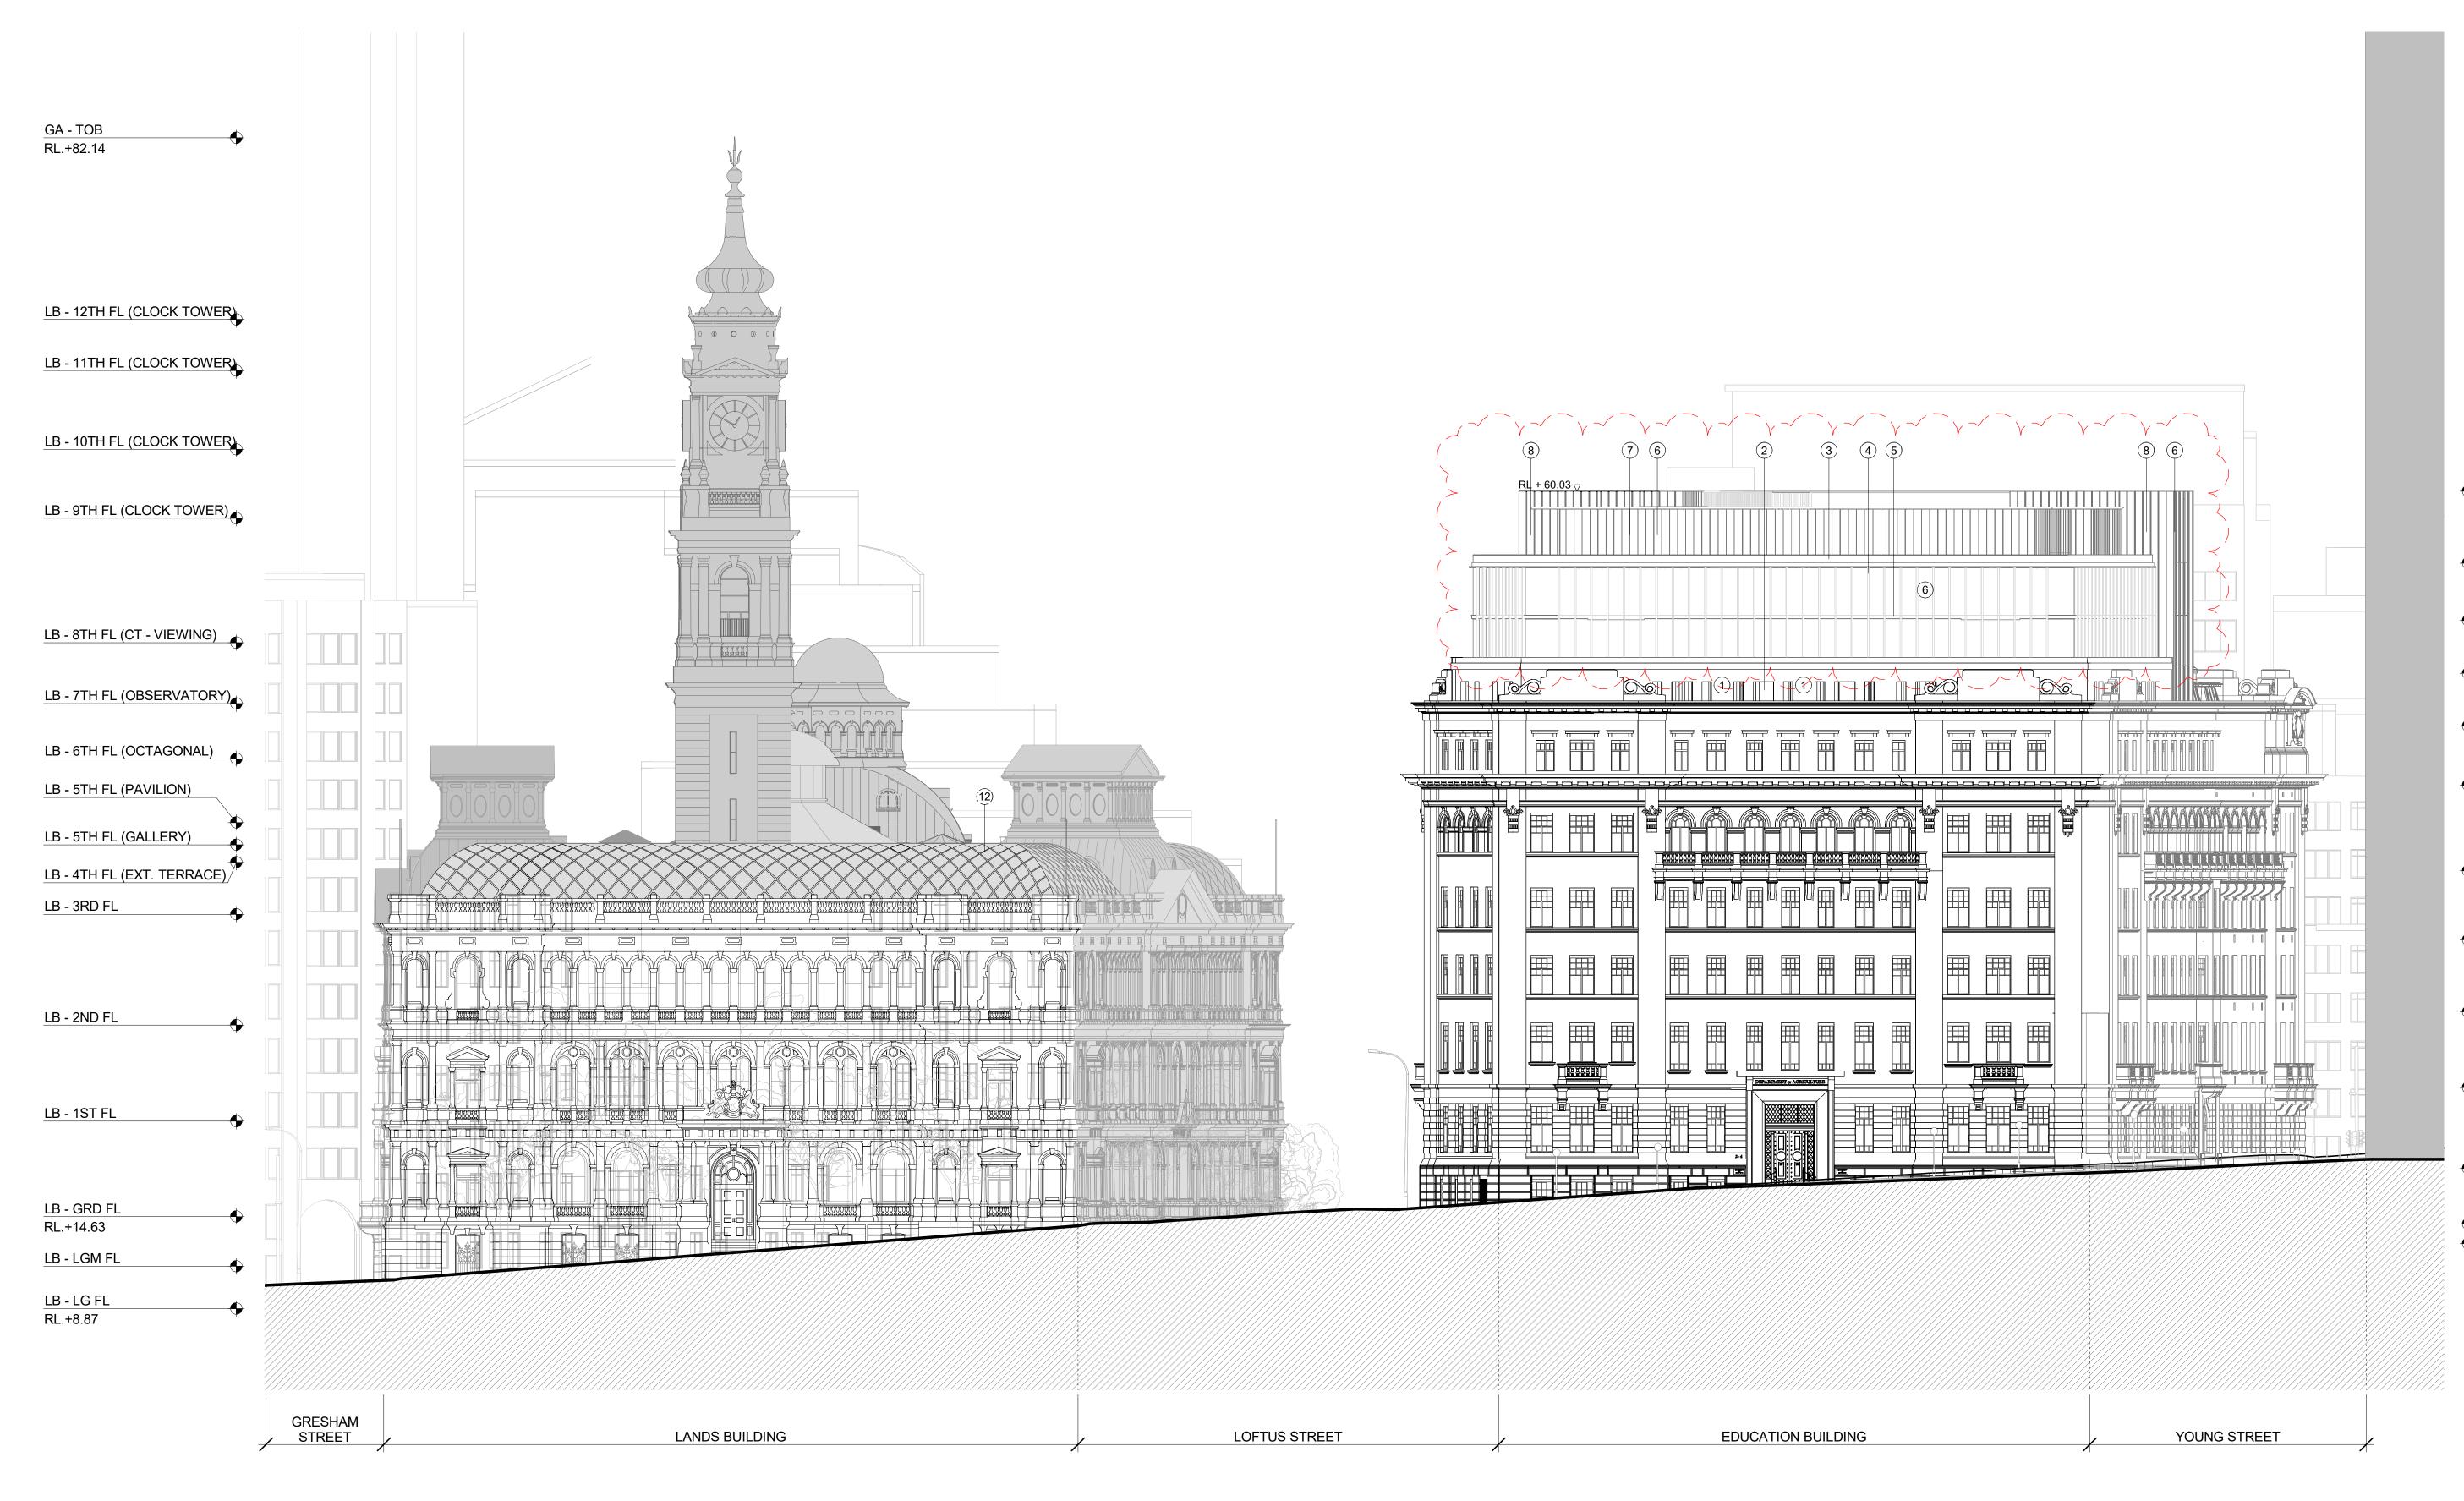


02 EDUCATION BUILDING - PROPOSED SOUTH ELEVATION

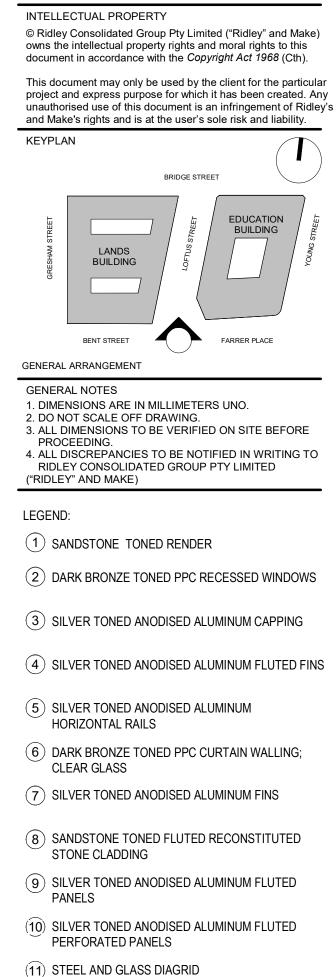

- (12) CURVED STAINLESS STEEL PANELS
- (13) OPEN STEEL PERGOLA

04	SECTION 4.55 SUBMISS
	AMENDMENT
03	SECTION 4.55 SUBMISS
02	DEVELOPMENT
	APPLICATION-AMENDM
01	DEVELOPMENT APPLIC
00	DA ELEVATIONS & SECT
ISSUE	DESCRIPTION
DESIC	<b>GN ARCHITECT</b>

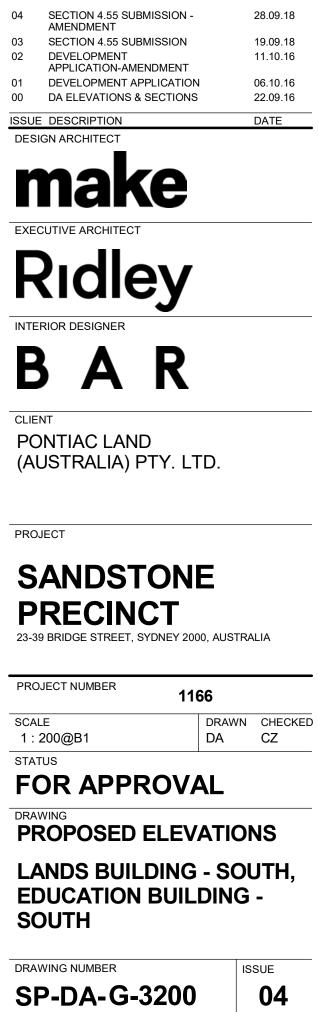


•	EB - TOB (NEW) RL.+60.03
<del>•</del>	EB - 9th FL (NEW)
<b>•</b>	EB - 8th FL (NEW)
•	EB - 7th FL (NEW)
•	EB - 6th FL (NEW)
<b>•</b>	EB - 5th FL (NEW) UPPER
<del>•</del>	EB - 4th FL
•	EB - 3rd FL (NEW)
<b>•</b>	EB - 2nd FL (NEW)
•	EB - 1st FL (NEW)
•	<u>EB - GRD FL</u> RL.+17.64
<b>_</b>	EB - LG FL (Bridge St) UPPER

EB - LG FL (Bridge St) UPPER -EB - LG FL (Bridge St.) LOWER




## 01 LANDS BUILDING - PROPOSED WEST ELEVATION

BRIDGE STREET

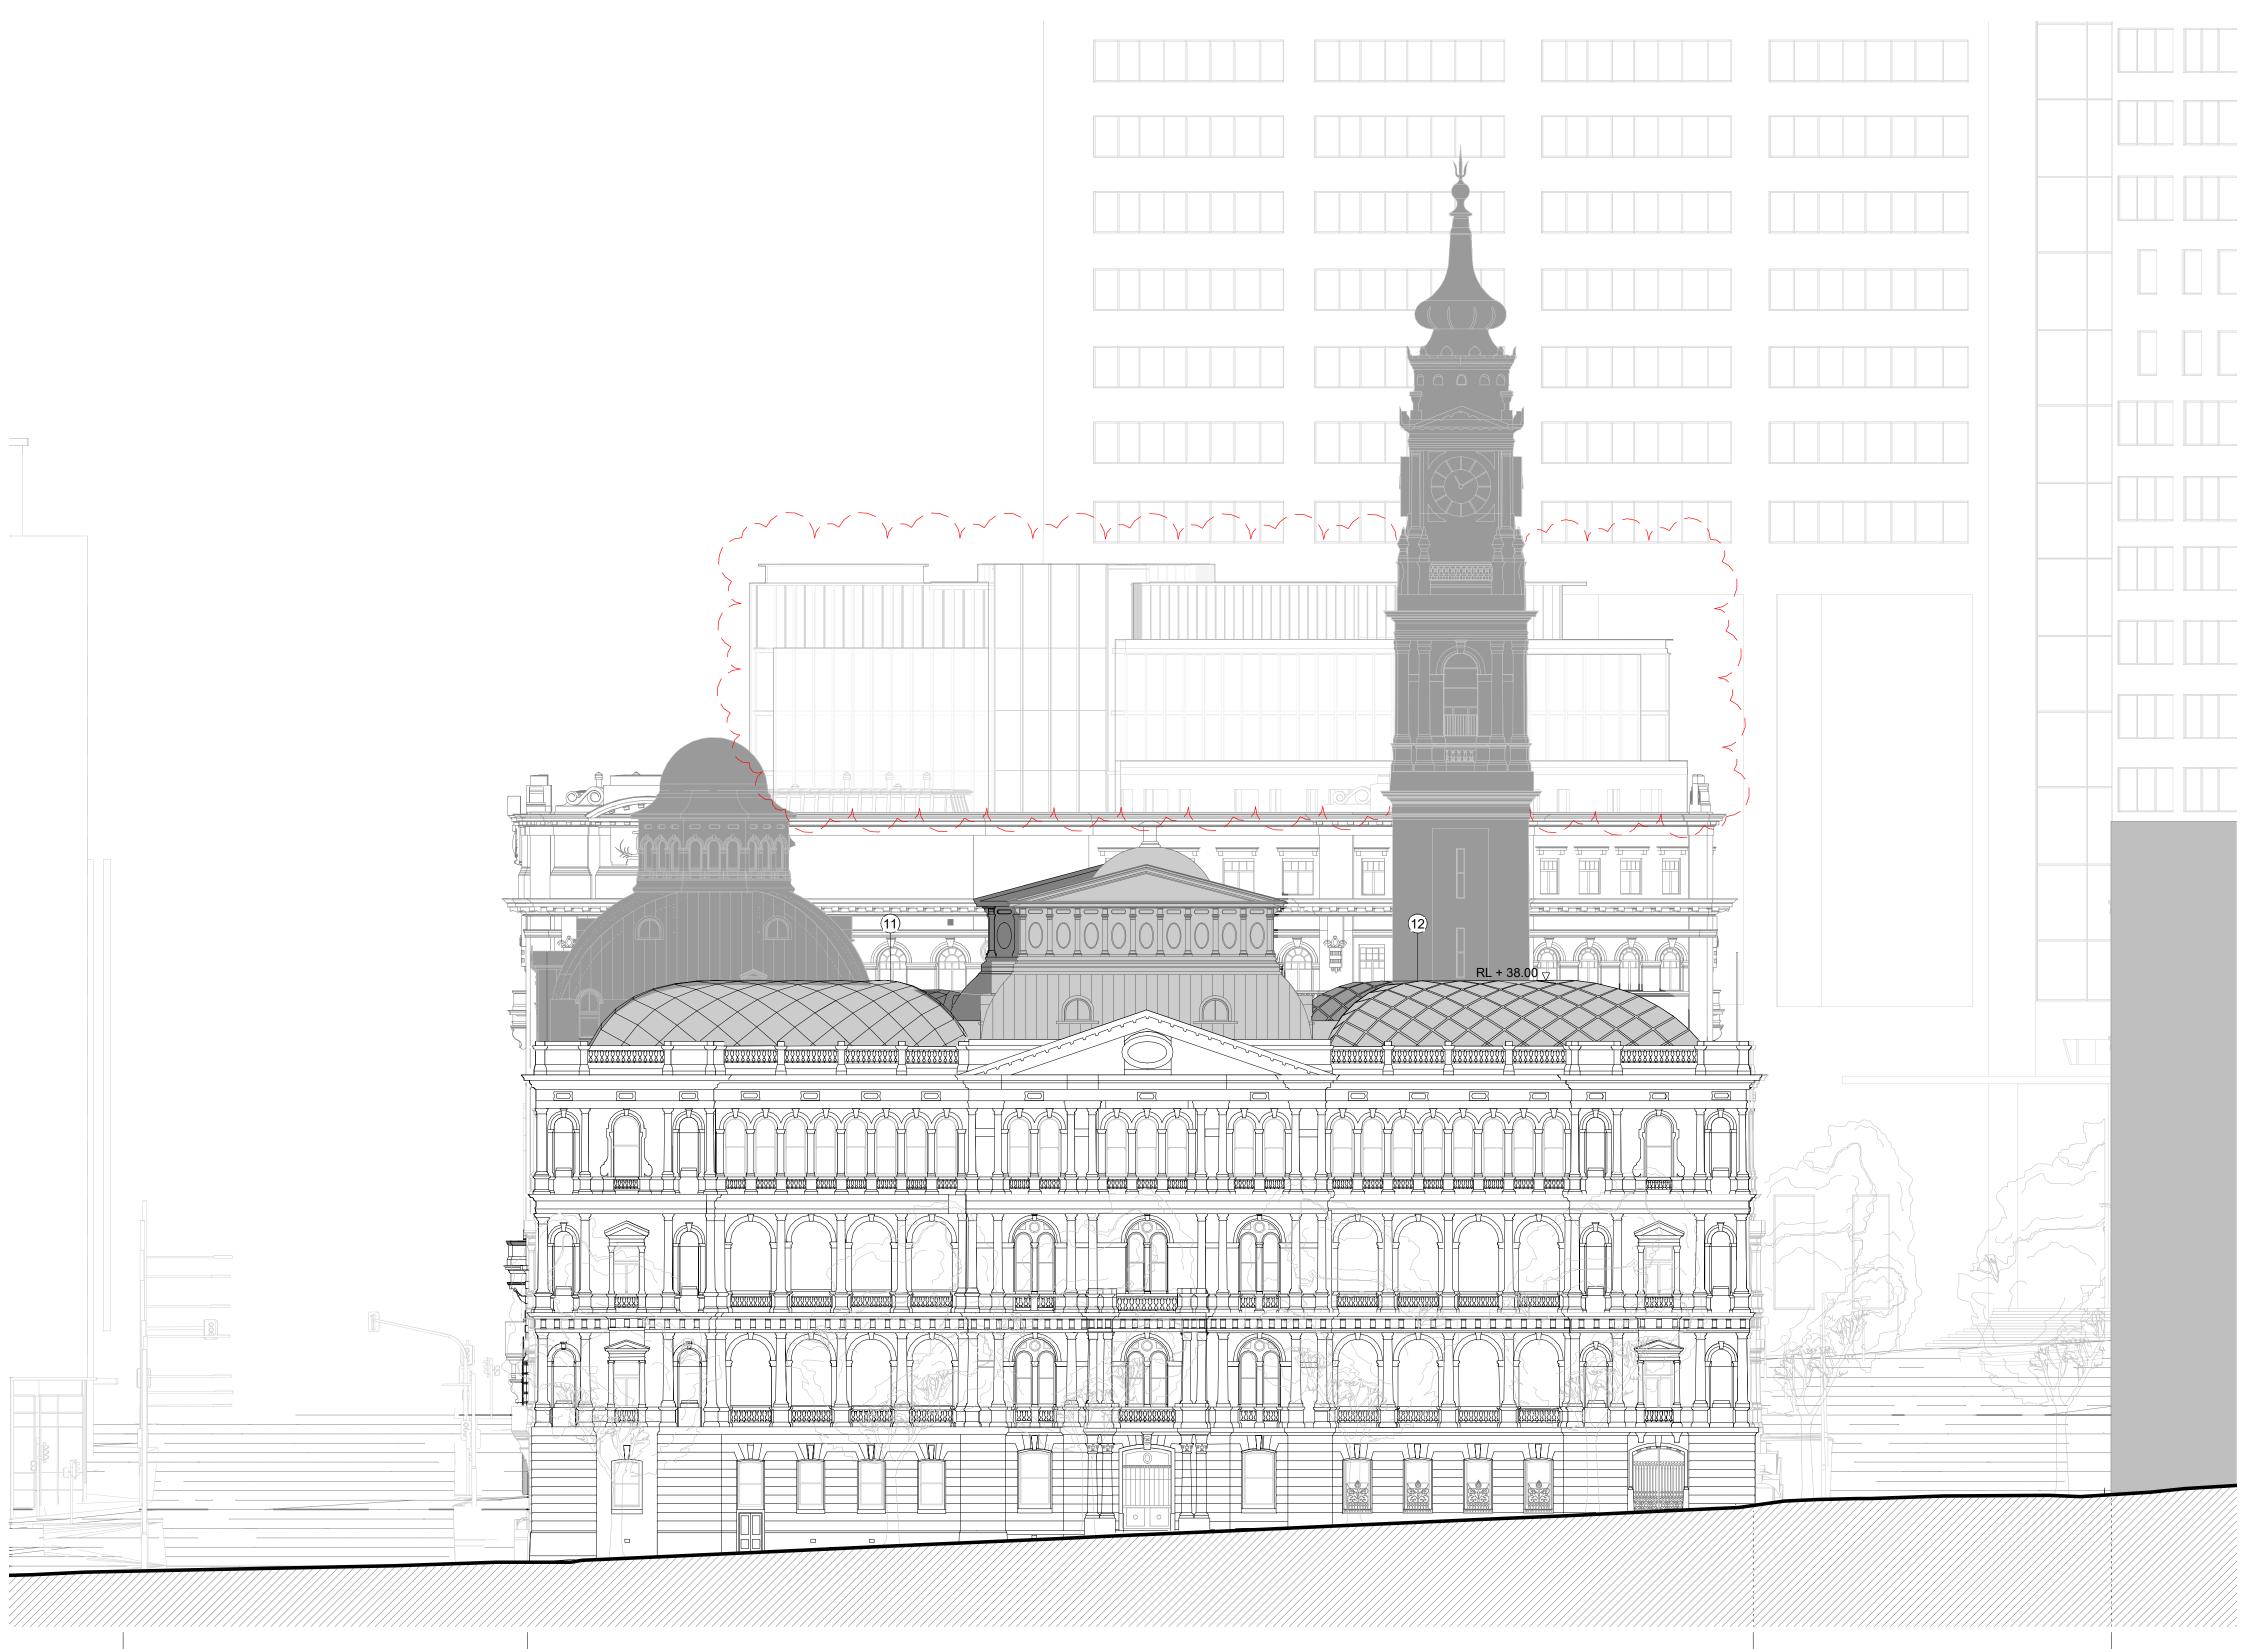

LANDS BUILDING

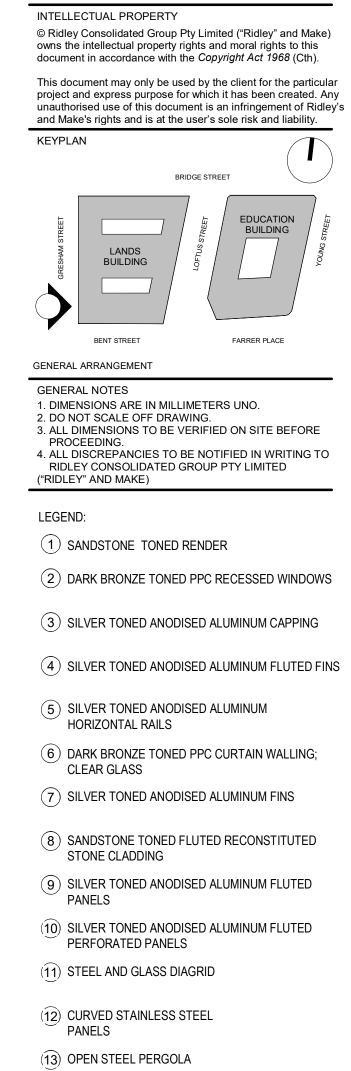


04	SECTION 4.5 AMENDMENT	
03	SECTION 4.5	5 SUBMISS
02	DEVELOPME APPLICATION	
01	DEVELOPME	NT APPLIC
00	DA ELEVATIO	ONS & SECT
ISSUE	DESCRIPTIO	N
DESIC	<b>SN ARCHITEC</b>	Т




20

SP-DA-G-3201

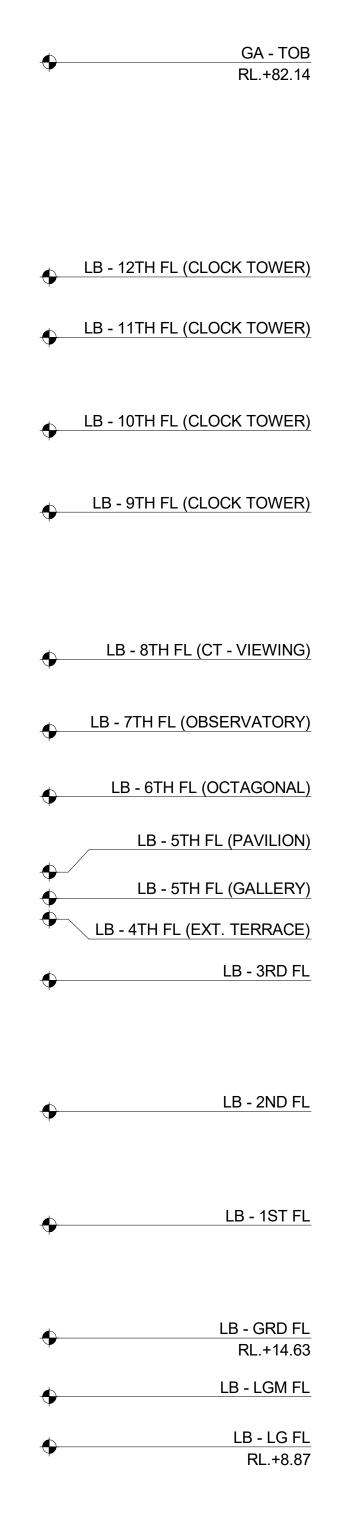

BENT STREET

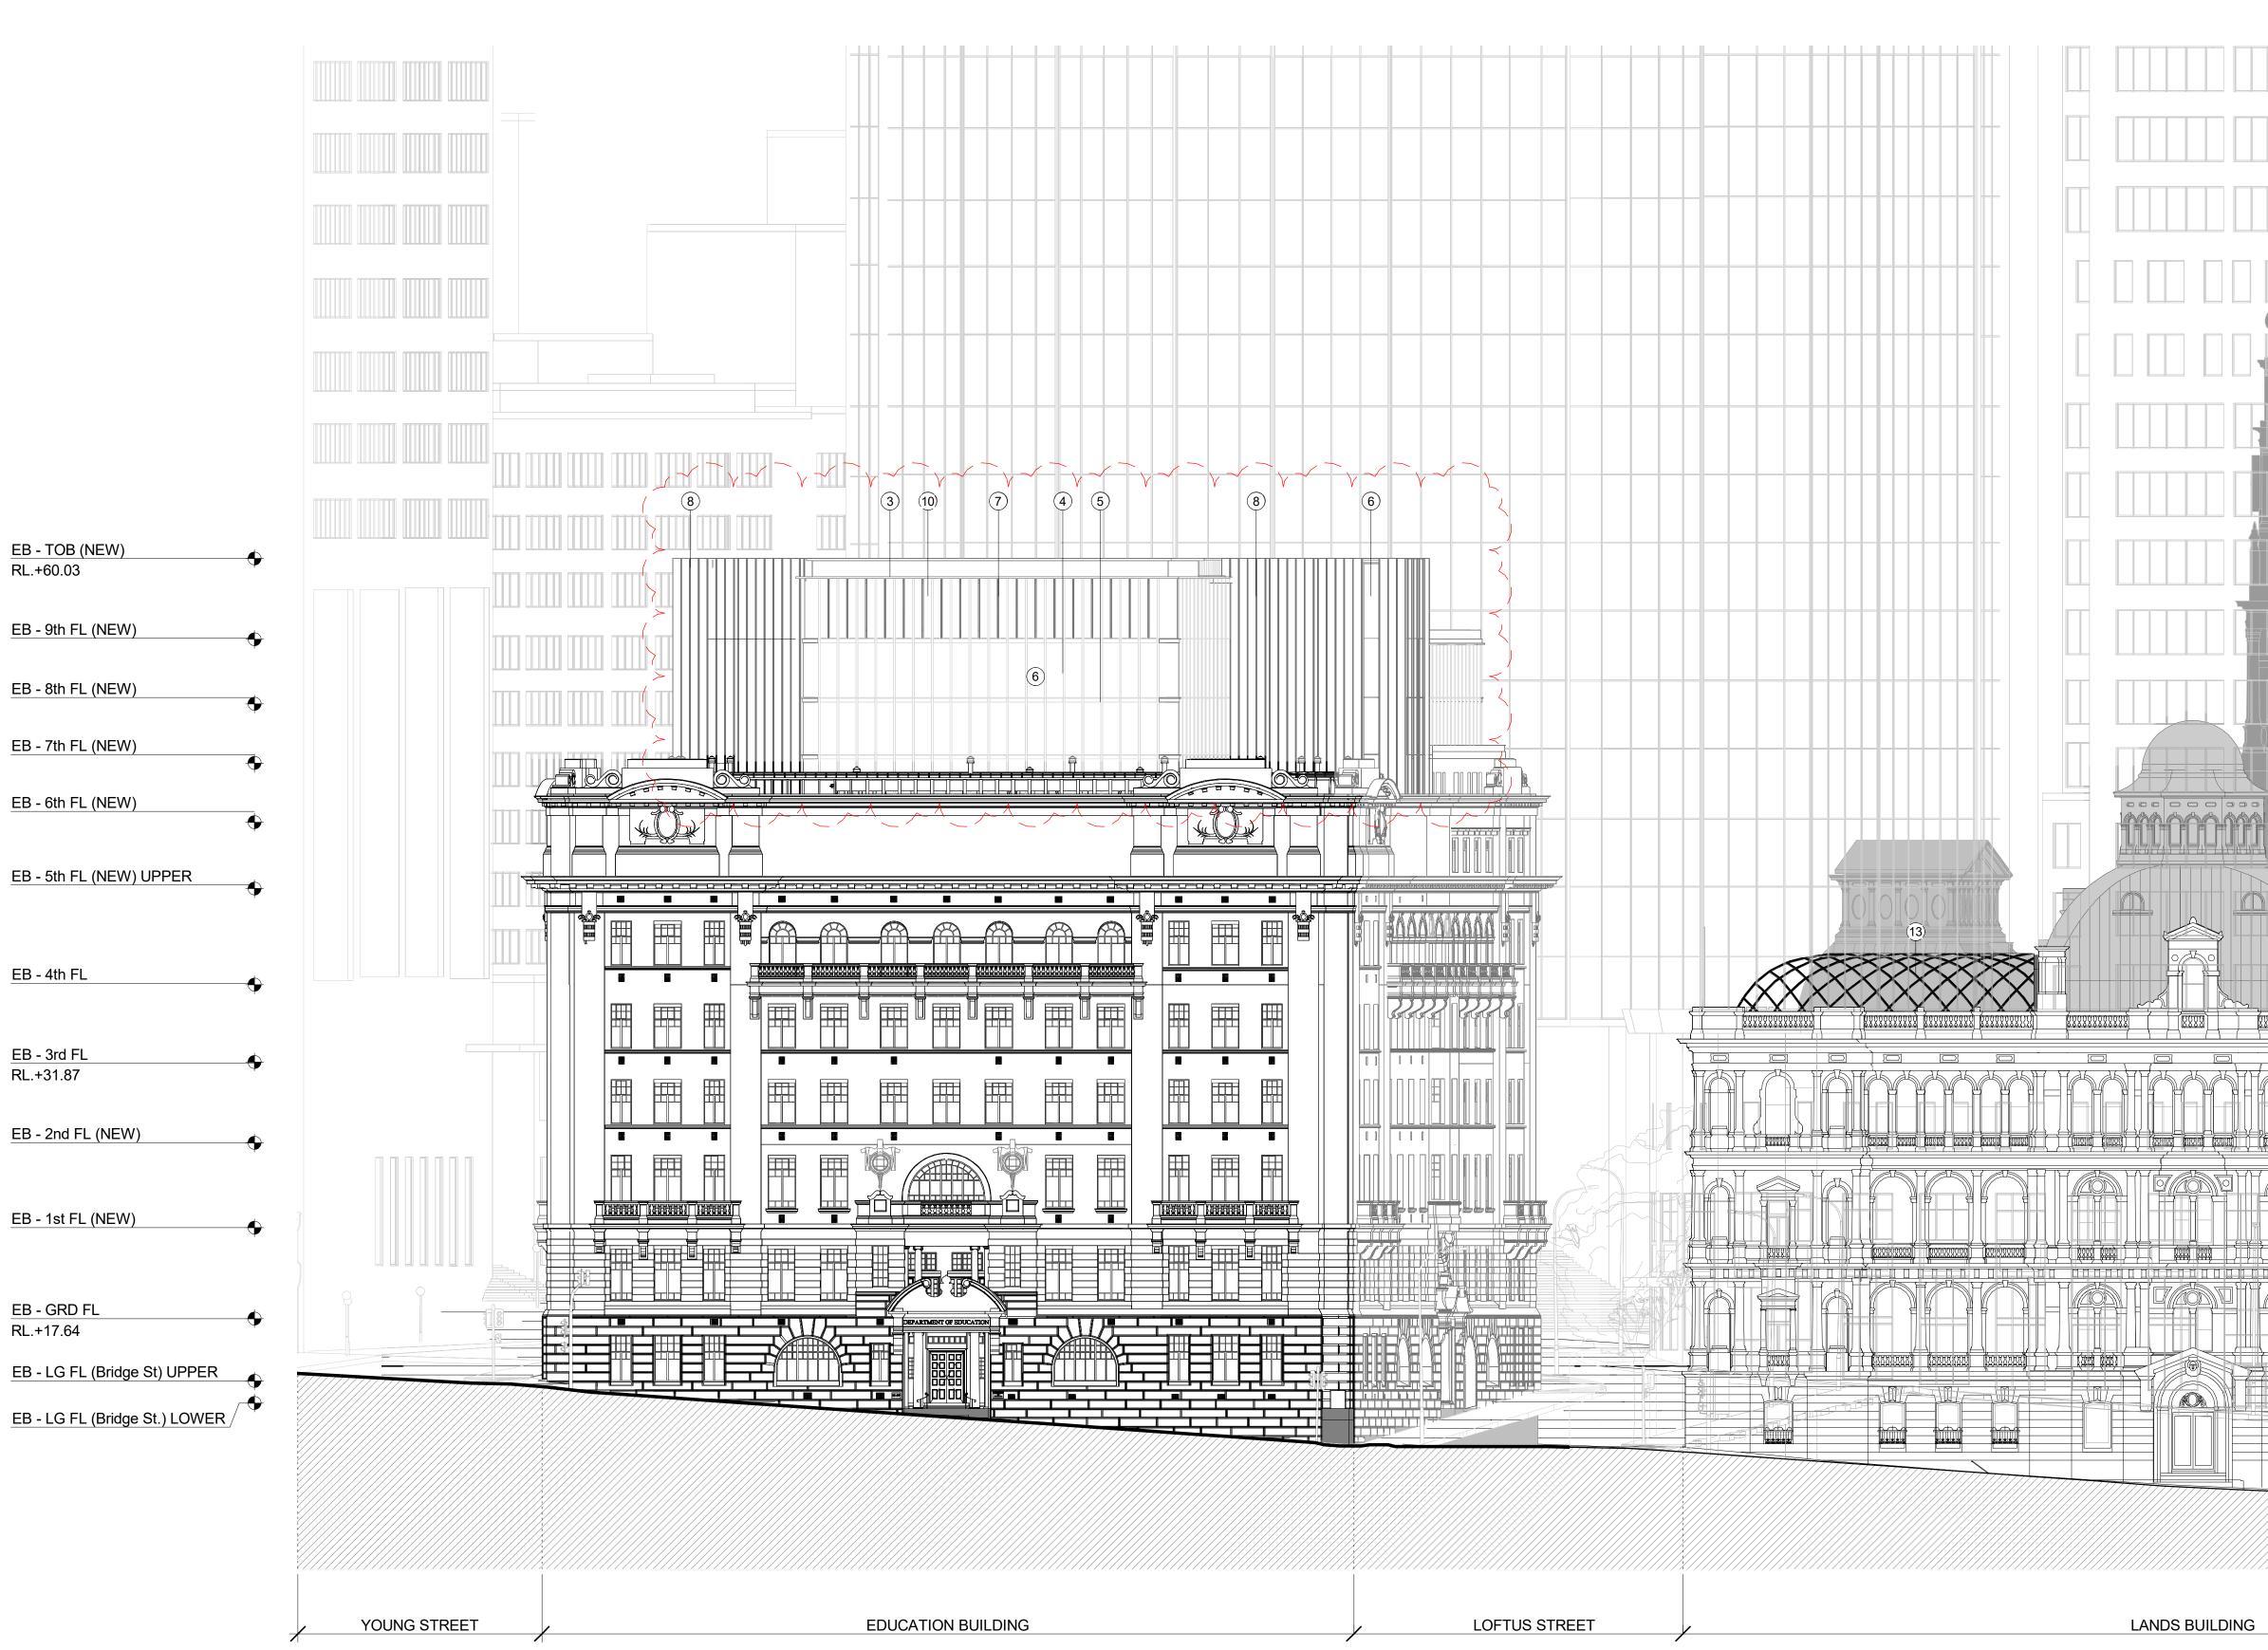


EDUCATION BUILDING - PROPOSED NORTH ELEVATION (01)1:200

LANDS BUILDING - PROPOSED NORTH ELEVATION (02) 1:200

GA - TOB RL.+82.14
B - 12TH FL (CLOCK TOWER)
B - 11TH FL (CLOCK TOWER)
B - 10TH FL (CLOCK TOWER)
LB - 9TH FL (CLOCK TOWER)
LB - 7TH FL (OBSERVATORY)
LB - 6TH FL (OCTAGONAL)
LB - 5TH FL (PAVILION)
LB - 5TH FL (GALLERY)
LB - 4TH FL (EXT. TERRACE)
EB - 3rd FL (NEW)
LB - 2ND FL
LB - 1ST FL
LB - GRD FL RL.+14.63
LB - LGM FL
LB - LG FL RL.+8.87
GRESHAM STREET

0 2m 6m 8m 10m 201 1:200

DRAWING NUMBER SP-DA-G-3202

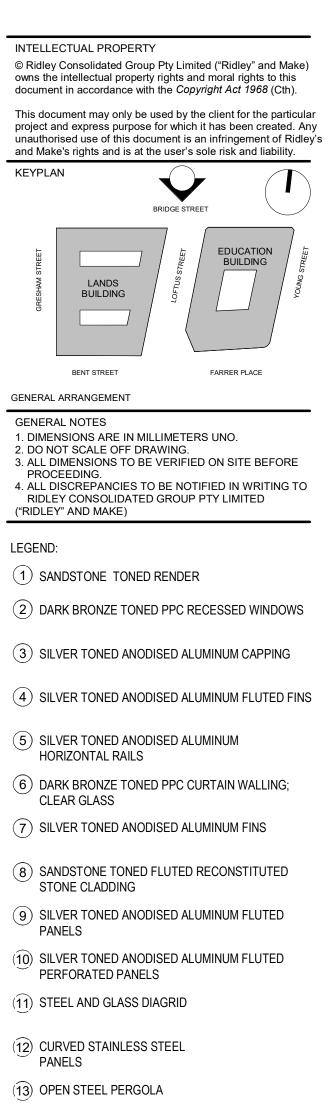

KEYPLAN

BUILDING

BENT STREET

GENERAL ARRANGEMENT GENERAL NOTES

PROCEEDING.

LEGEND:

("RIDLEY" AND MAKE)

HORIZONTAL RAILS

CLEAR GLASS

STONE CLADDING

PANELS

PANELS

04

02

ISSUE DESCRIPTION DESIGN ARCHITECT

EXECUTIVE ARCHITECT

INTERIOR DESIGNER

PONTIAC LAND

B

CLIENT

PROJECT

PROJECT NUMBER


SCALE

1 : 200@B1 STATUS

DRAWING

NORTH



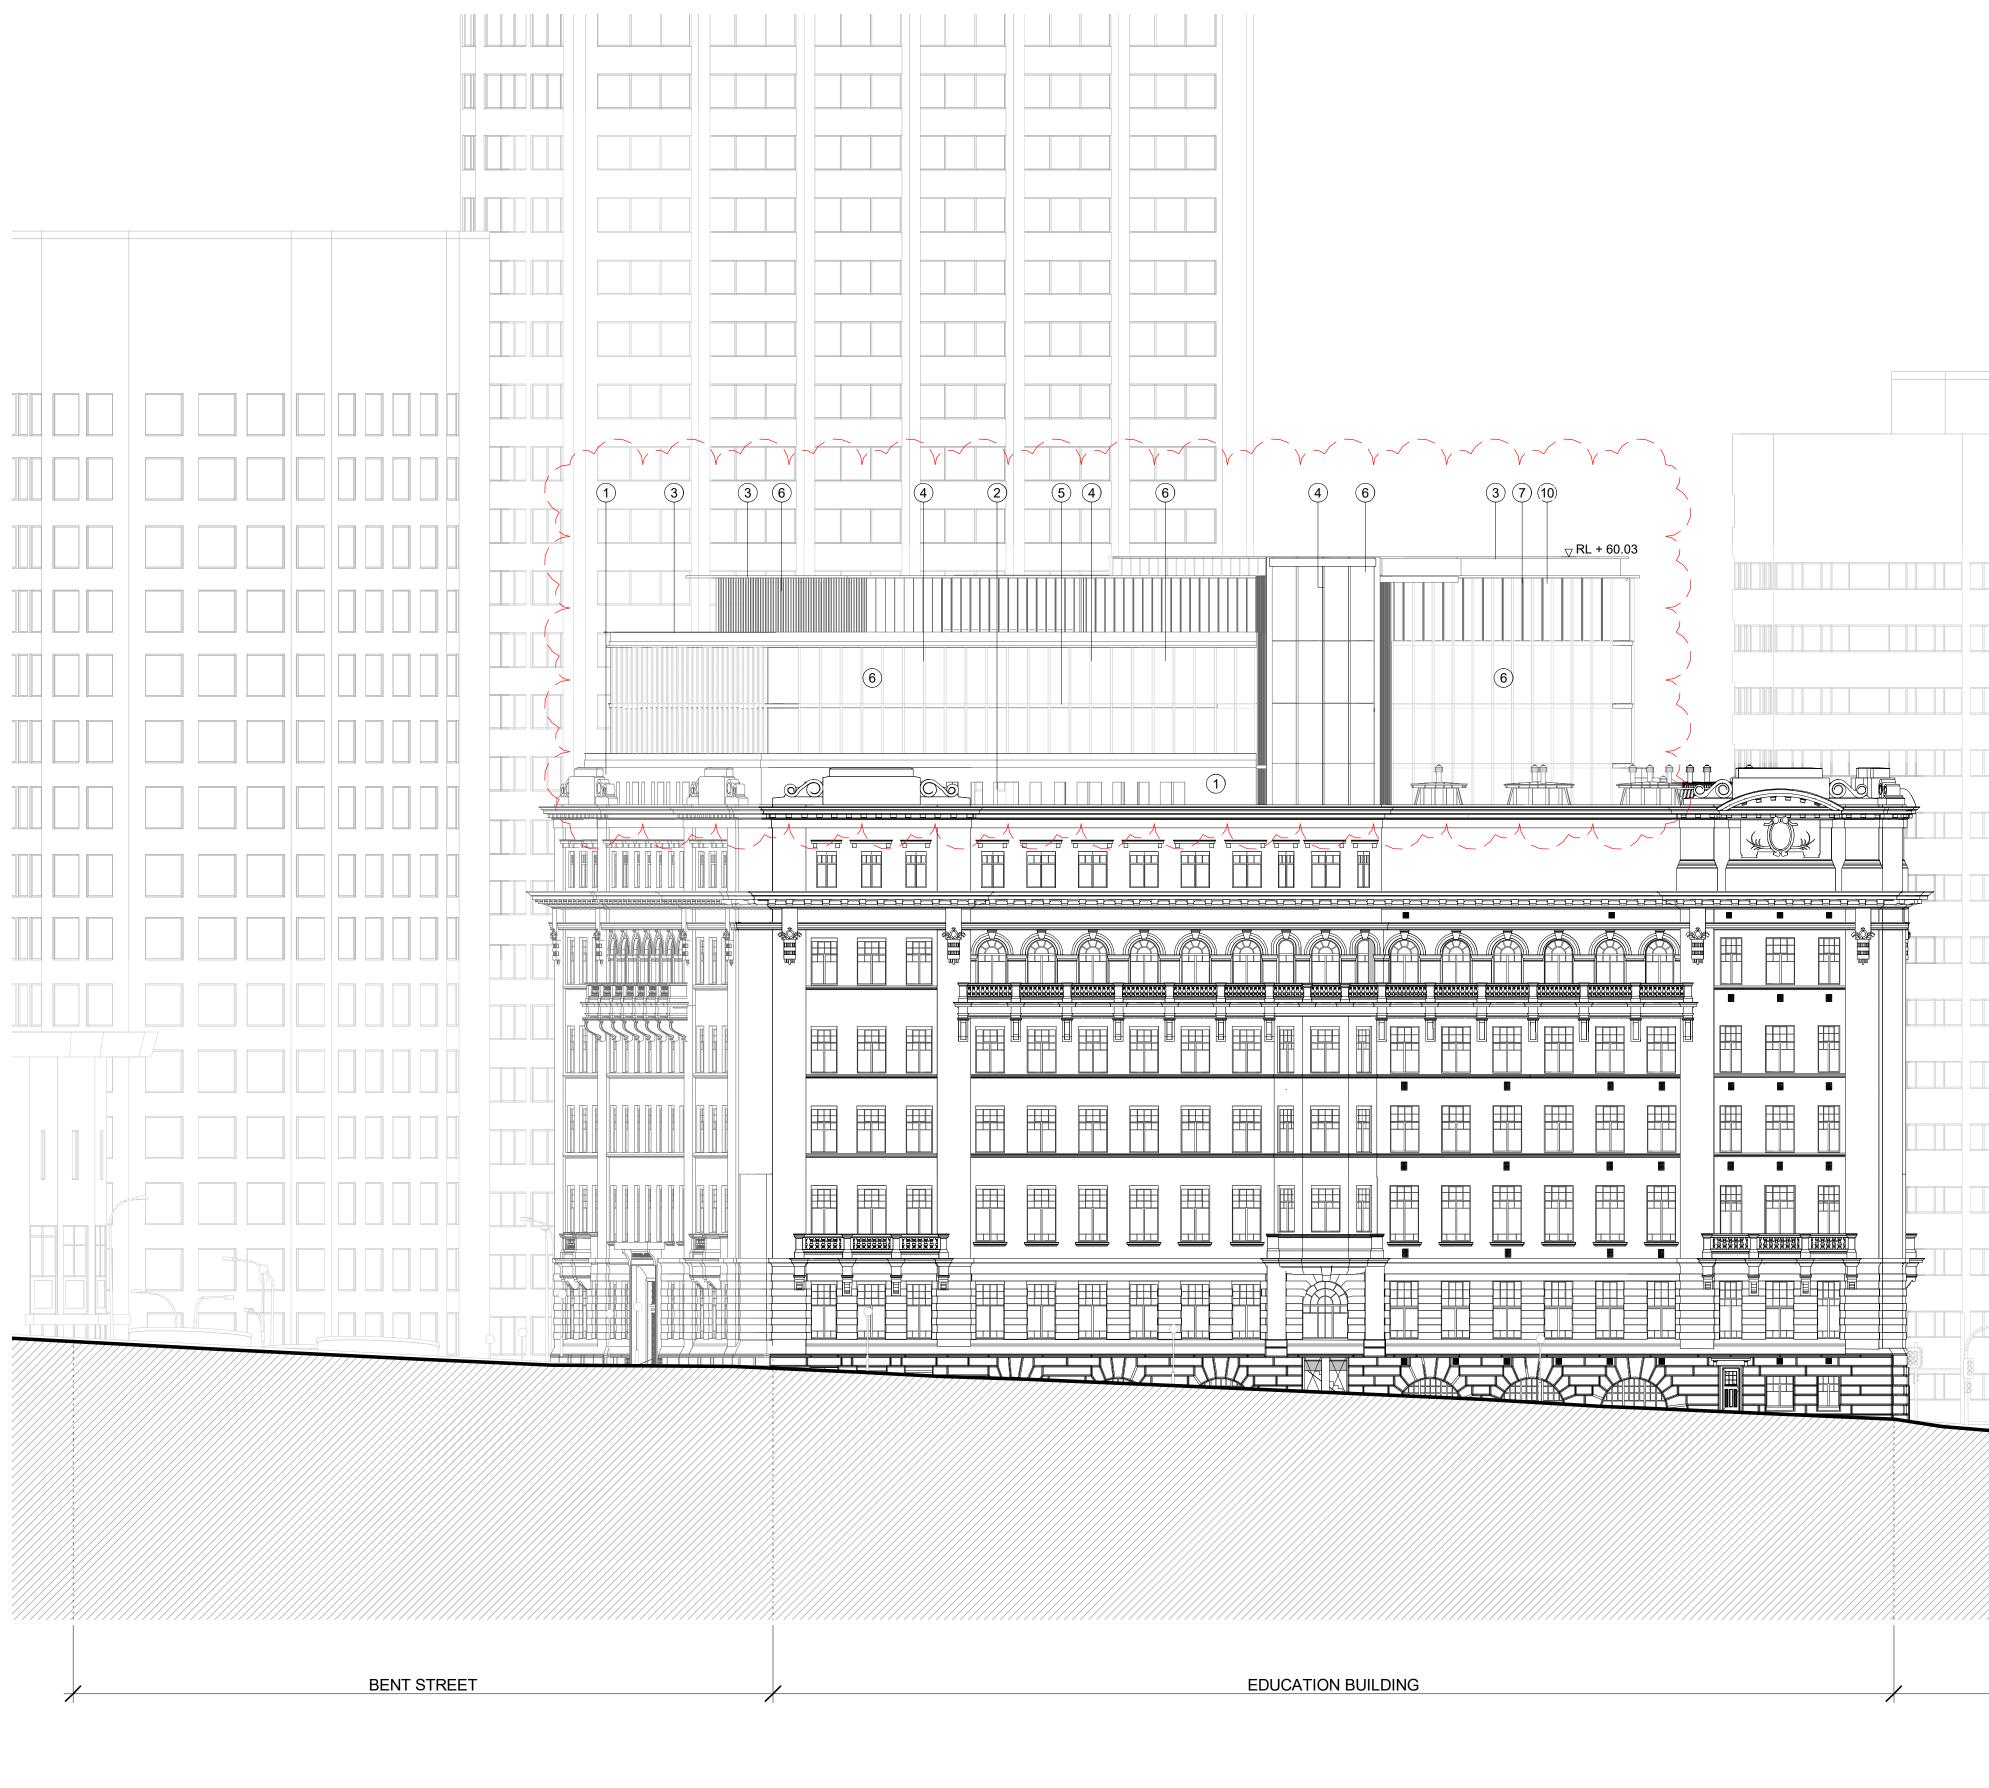


01 EDL 1:200 EDUCATION BUILDING - PROPOSED EAST ELEVATION

### KEYPLAN LANDS BUILDING BENT STREET GENERAL ARRANGEMENT GENERAL NOTES 1. DIMENSIONS ARE IN MILLIMETERS UNO. 2. DO NOT SCALE OFF DRAWING. 3. ALL DIMENSIONS TO BE VERIFIED ON SITE BEFORE PROCEEDING. 4. ALL DISCREPANCIES TO BE NOTIFIED IN WRITING TO RIDLEY CONSOLIDATED GROUP PTY LIMITED ("RIDLEY" AND MAKE)

INTELLECTUAL PROPERTY

### LEGEND: 1 SANDSTONE TONED RENDER

- 2 DARK BRONZE TONED PPC RECESSED WINDOWS
- (5) SILVER TONED ANODISED ALUMINUM
- HORIZONTAL RAILS (6) DARK BRONZE TONED PPC CURTAIN WALLING;
- CLEAR GLASS (7) SILVER TONED ANODISED ALUMINUM FINS
- (8) SANDSTONE TONED FLUTED RECONSTITUTED
- STONE CLADDING (9) SILVER TONED ANODISED ALUMINUM FLUTED PANELS
- (10) SILVER TONED ANODISED ALUMINUM FLUTED PERFORATED PANELS
- (11) STEEL AND GLASS DIAGRID (12) CURVED STAINLESS STEEL
- PANELS (13) OPEN STEEL PERGOLA

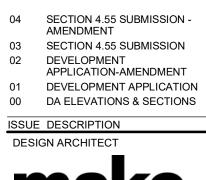




Ridley BAR CLIENT PONTIAC LAND (AUSTRALIA) PTY. LTD. PROJECT SANDSTONE PRECINCT 23-39 BRIDGE STREET, SYDNEY 2000, AUSTRALIA PROJECT NUMBER 1166 DRAWN CHECKED SCALE 1 : 200@B1 STATUS FOR APPROVAL DRAWING PROPOSED ELEVATIONS **EDUCATION BUILDING - EAST** 


DRAWING NUMBER SP-DA-G-3203

•	RL.+60.03
	NE. 100.00
•	EB - 9th FL (NEW)
<b>.</b>	EB - 8th FL (NEW)
<b>•</b>	
•	EB - 7th FL (NEW)
	EB - 6th FL (NEW)
<b>•</b>	
•	EB - 5th FL (NEW) UPPER
•	EB - 4th FL
<b>\</b>	
•	EB - 3rd FL
Ψ	RL.+31.87
•	EB - 2nd FL (NEW)
Ŧ	
•	EB - 1st FL (NEW)
Ψ	
÷	EB - GRD FL
•	RL.+17.64
•	EB - LG FL (Bridge St) UPPER
•	EB - LG FL (Bridge St.) LOWER

EB - TOB (NEW)


BRIDGE STREET

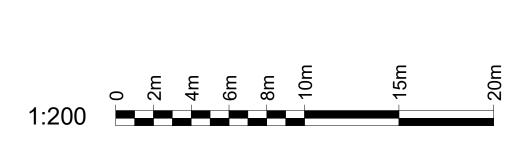

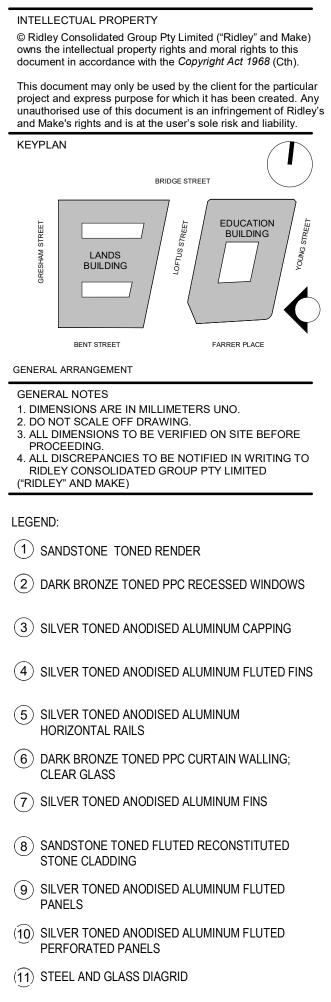

28.09.18 19.09.18 11.10.16 06.10.16 22.09.16 DATE

> ISSUE 04

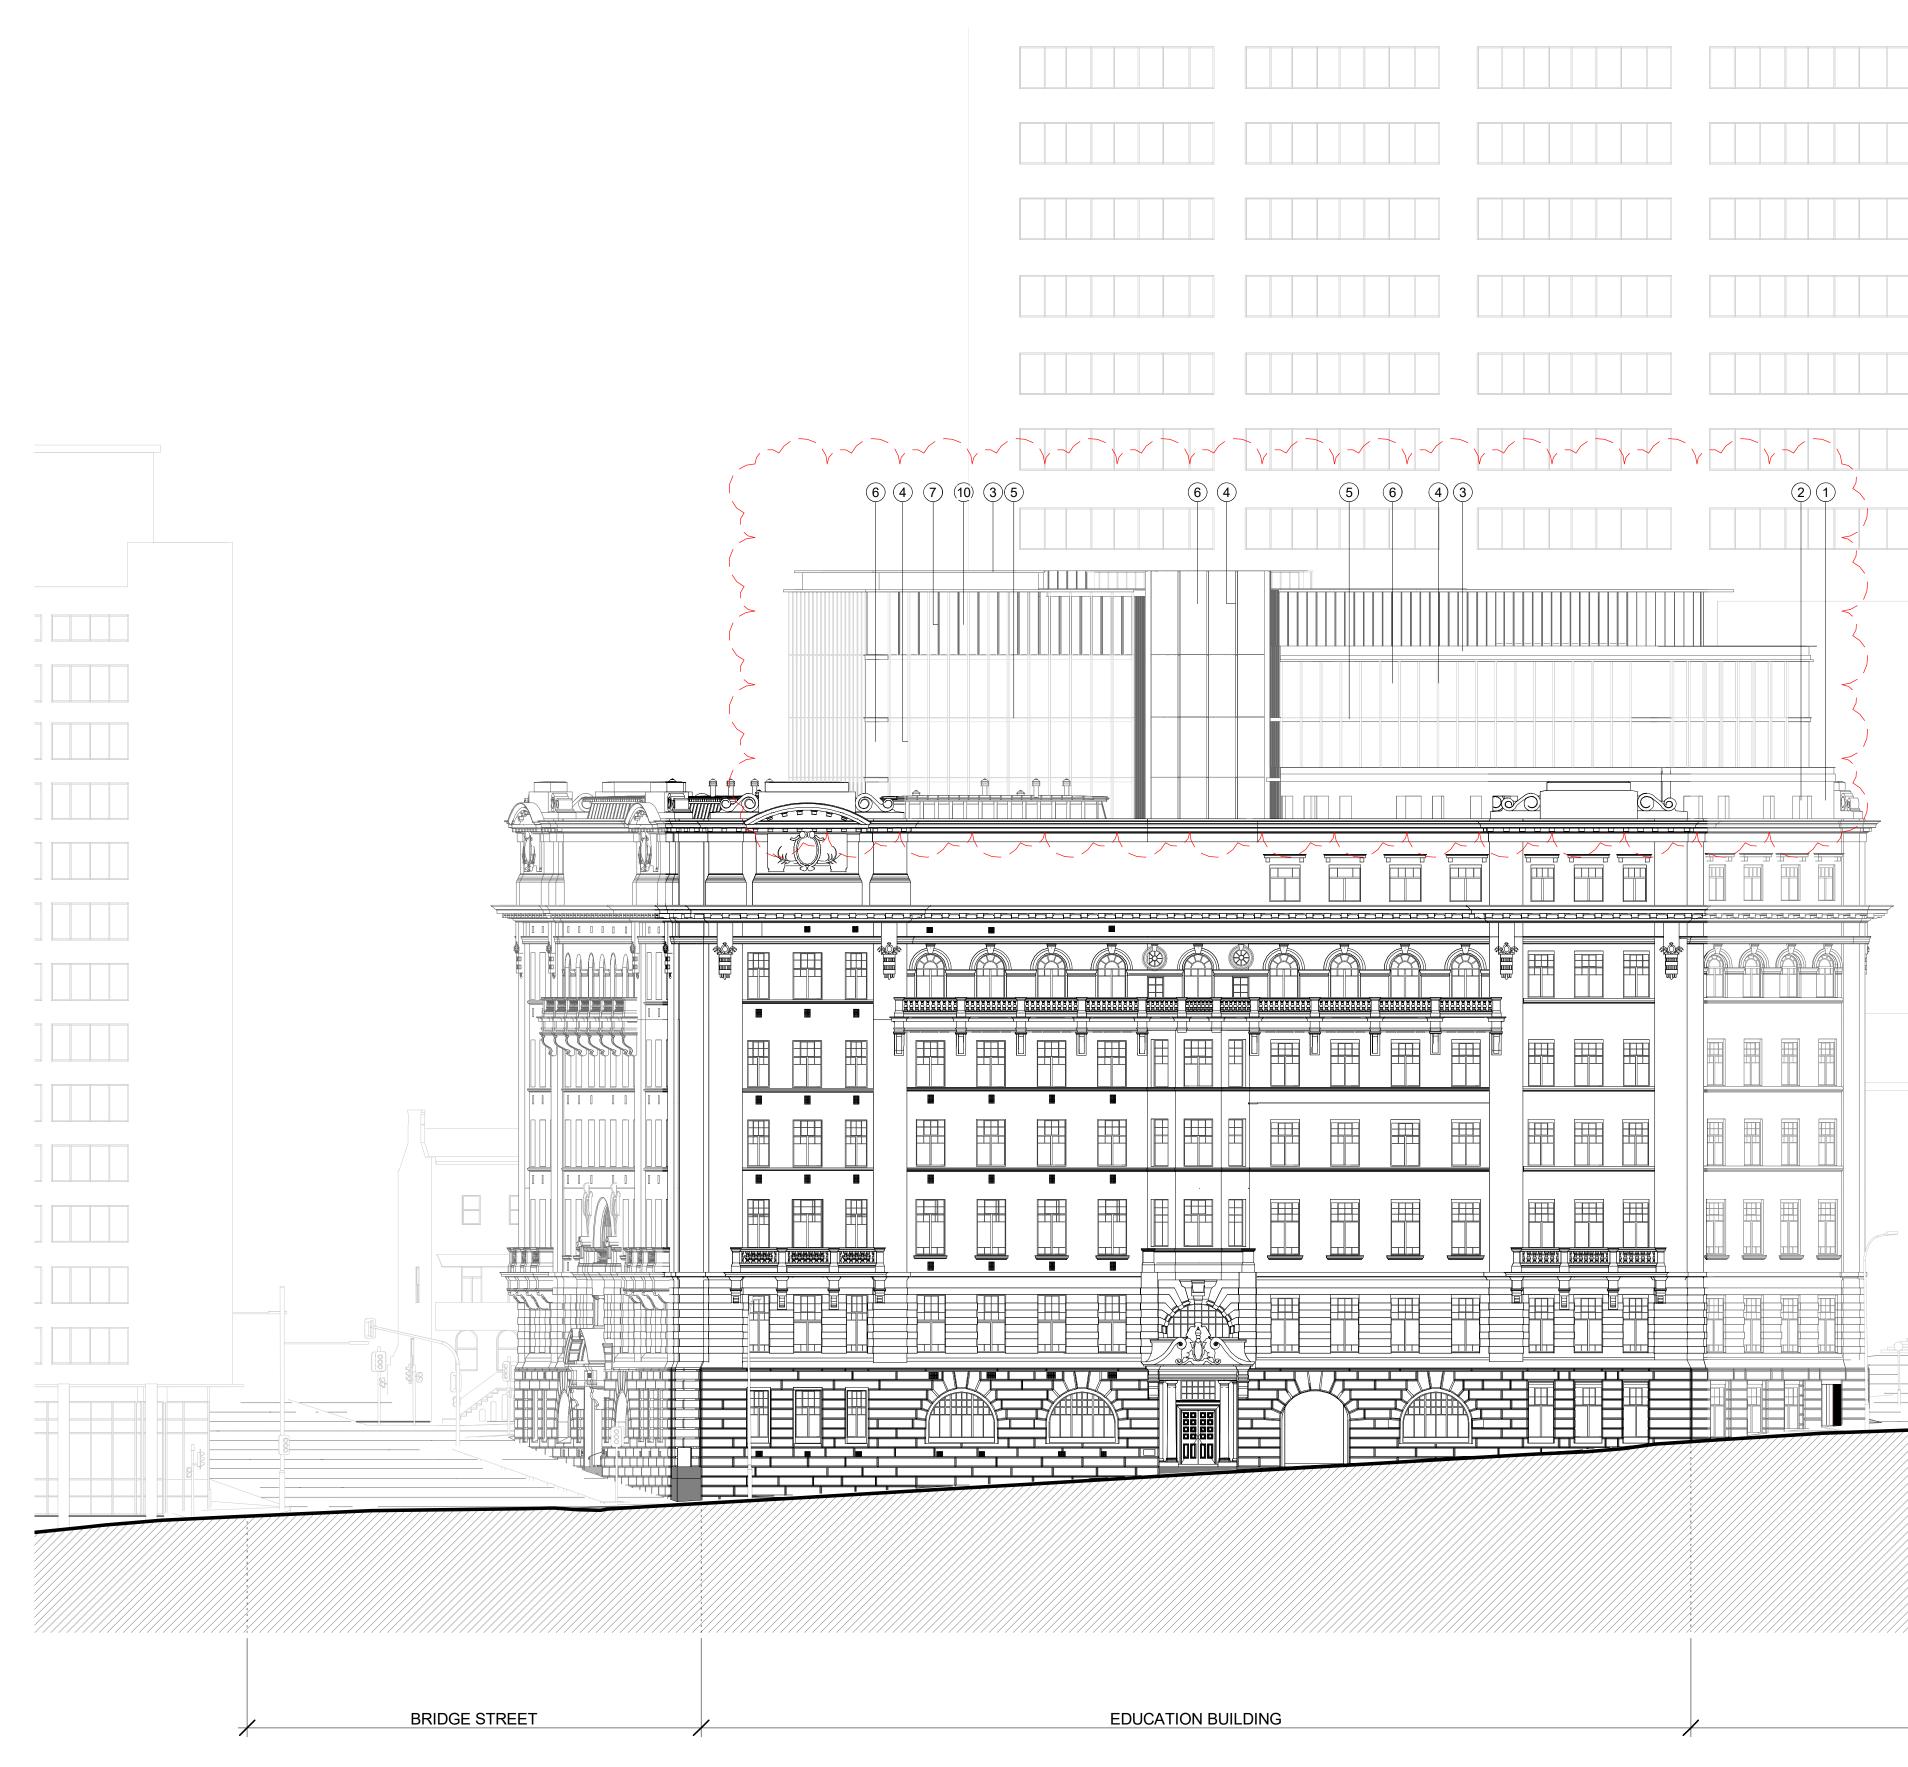



 $\smile$ 

unauthorised use and Make's right	
KEYPLAN	
	BRI
	ANDS ILDING
BENT S	TREET
GENERAL ARRANG	
GENERAL NOTE 1. DIMENSIONS 2. DO NOT SCAI 3. ALL DIMENSI PROCEEDING 4. ALL DISCREF RIDLEY CONS ("RIDLEY" AND I	ARE IN MILLI LE OFF DRAW ONS TO BE VE 3. PANCIES TO B SOLIDATED G
LEGEND:	
1 SANDSTON	IE TONED RE
2 DARK BRO	NZE TONED P
3 SILVER TO	NED ANODISE
(4) SILVER TO	NED ANODISE
5 SILVER TO HORIZONT	
(6) DARK BROU CLEAR GLA	
(7) SILVER TO	NED ANODISE
(8) SANDSTON STONE CLA	IE TONED FLU ADDING
(9) SILVER TO PANELS	NED ANODISE
	NED ANODISE ED PANELS
$(\widehat{11})$ steel and	GLASS DIAG
$(\widehat{12})$ CURVED S PANELS	TAINLESS STE
$(\widehat{13})$ Open stee	EL PERGOLA

\_\_\_\_\_

INTELLECTUAL PROPERTY

04	SECTION 4.55 SUBMISS AMENDMENT
03	SECTION 4.55 SUBMISS
02	DEVELOPMENT APPLICATION-AMENDM
01	DEVELOPMENT APPLIC
00	DA ELEVATIONS & SEC
ISSUE	DESCRIPTION
DESIC	<b>SN ARCHITECT</b>



DRAWING NUMBER SP-DA-G-3205

BENT STREET




EB - TOB (NEW)


RL.+60.03

<b>\$</b>	EB - 4th FL
<b>•</b>	EB - 3rd FL RL.+31.87
<b>•</b>	EB - 2nd FL (NEW)
•	EB - 1st FL (NEW)


	EB - GRD F
Ψ	RL.+17.6
	EB - LG FL (Bridge St) UPPEF
$\mathbf{\Phi}$	
*	EB - LG FL (Bridge St.) LOWE

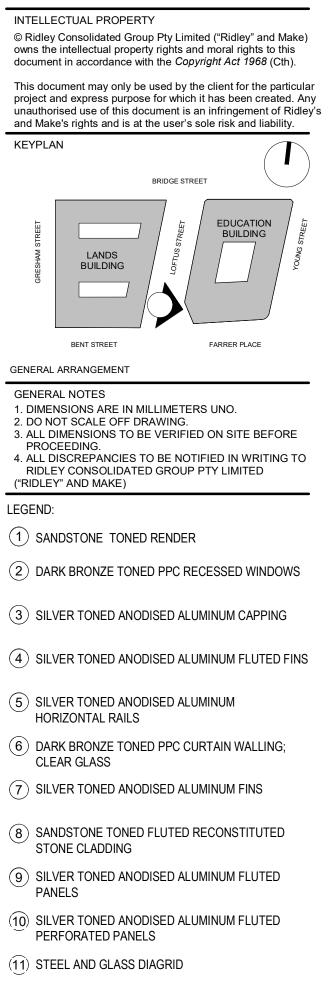



EEL

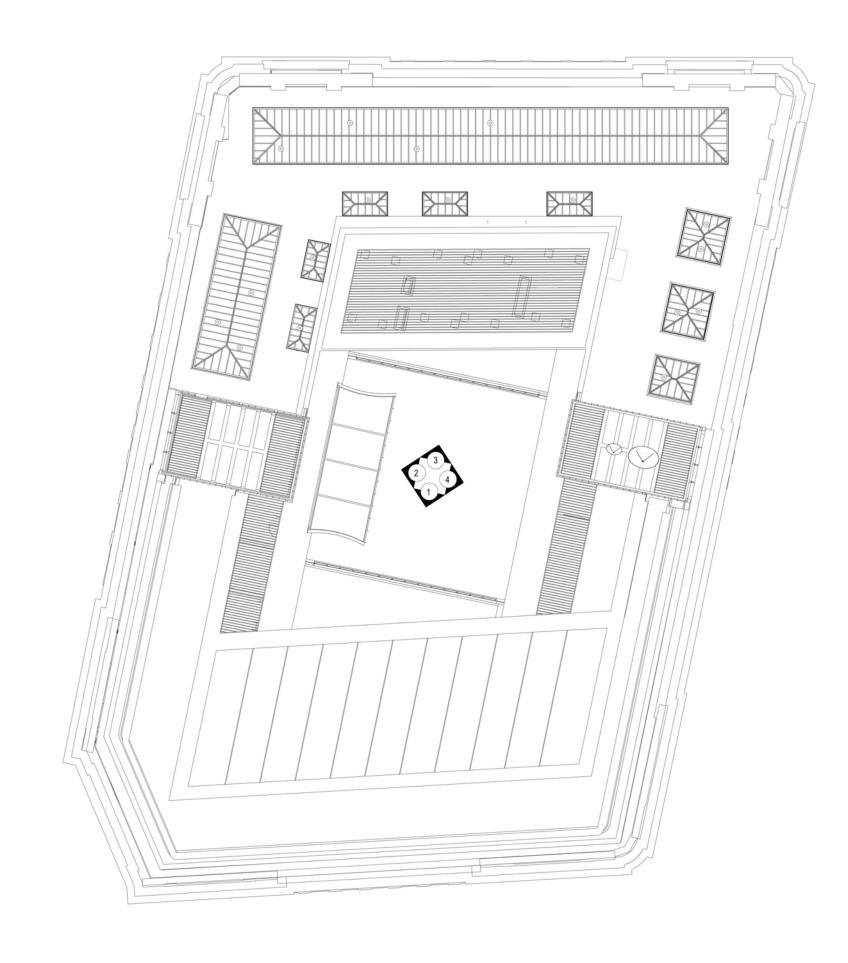

00 KEY PLAN 1:200

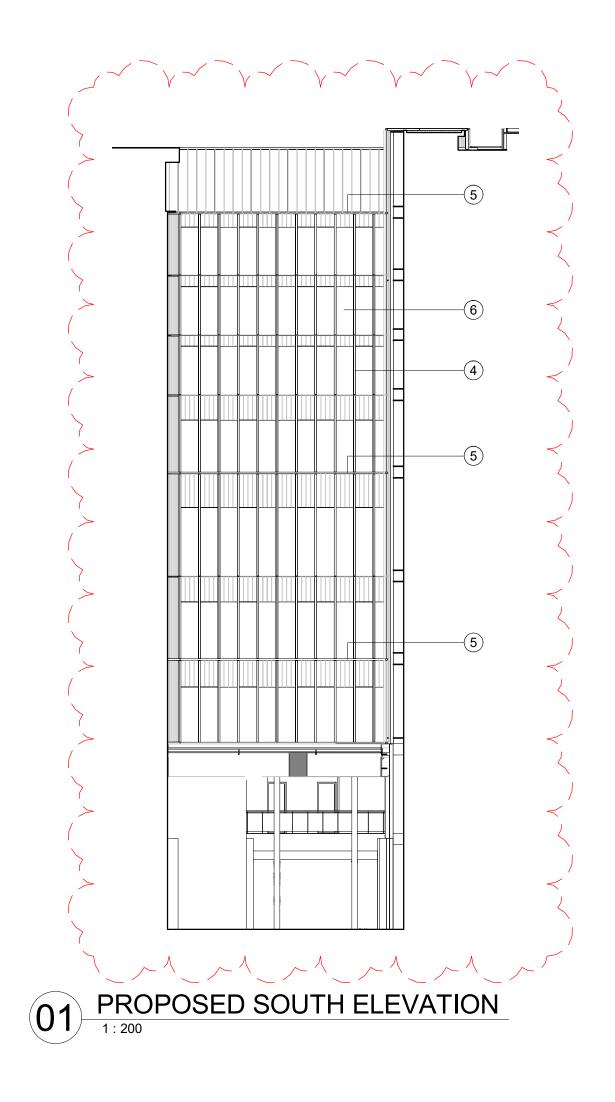


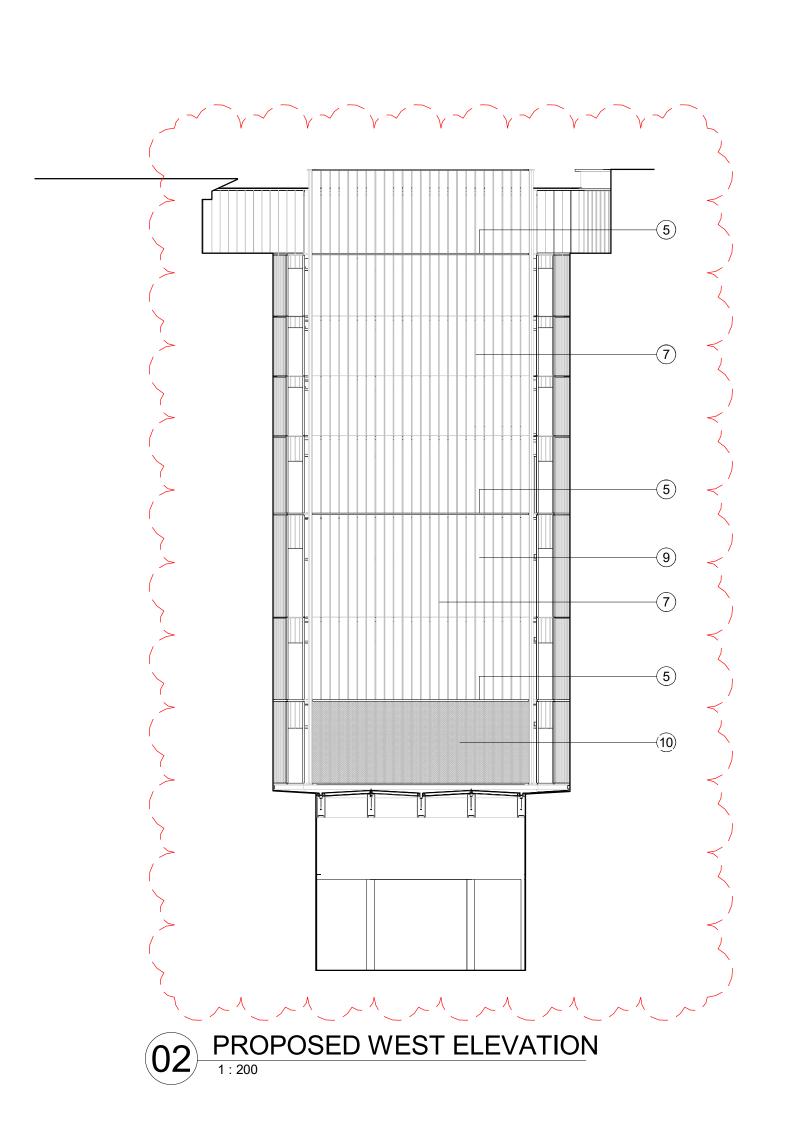


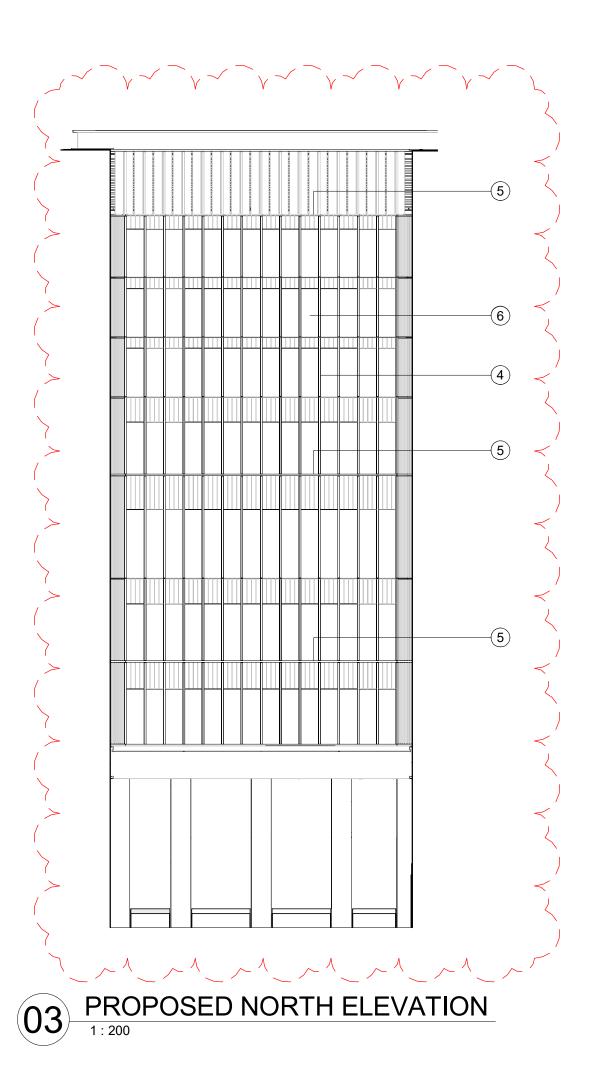

© Ridley Consolidated Group Pt owns the intellectual property rig document in accordance with the
This document may only be use project and express purpose for unauthorised use of this docume and Make's rights and is at the u
KEYPLAN
BRID
LANDS BUILDING
BENT STREET
GENERAL ARRANGEMENT
GENERAL NOTES 1. DIMENSIONS ARE IN MILLIM 2. DO NOT SCALE OFF DRAW 3. ALL DIMENSIONS TO BE VE PROCEEDING. 4. ALL DISCREPANCIES TO BE RIDLEY CONSOLIDATED GE ("RIDLEY" AND MAKE)
LEGEND:
(1) SANDSTONE TONED REI
2 DARK BRONZE TONED P
(3) SILVER TONED ANODISE
(4) SILVER TONED ANODISE
5 SILVER TONED ANODISE HORIZONTAL RAILS
6 DARK BRONZE TONED PL CLEAR GLASS
(7) SILVER TONED ANODISE
8 SANDSTONE TONED FLU STONE CLADDING
(9) SILVER TONED ANODISE PANELS
$(\widehat{10}) SILVER TONED ANODISE PERFORATED PANELS$
$(\widehat{11})$ STEEL AND GLASS DIAGE
(12) CURVED STAINLESS STE PANELS
(13) OPEN STEEL PERGOLA

INTELLECTUAL PROPERTY

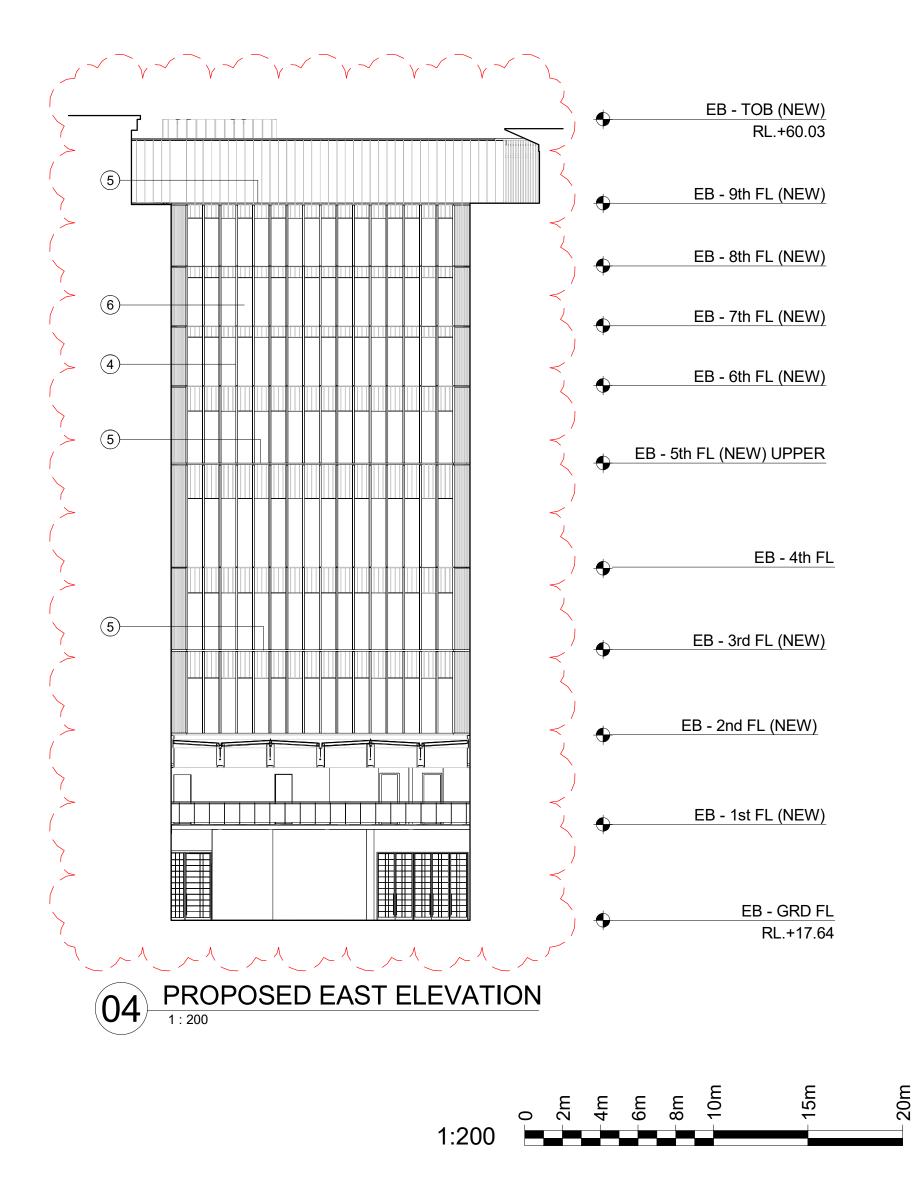

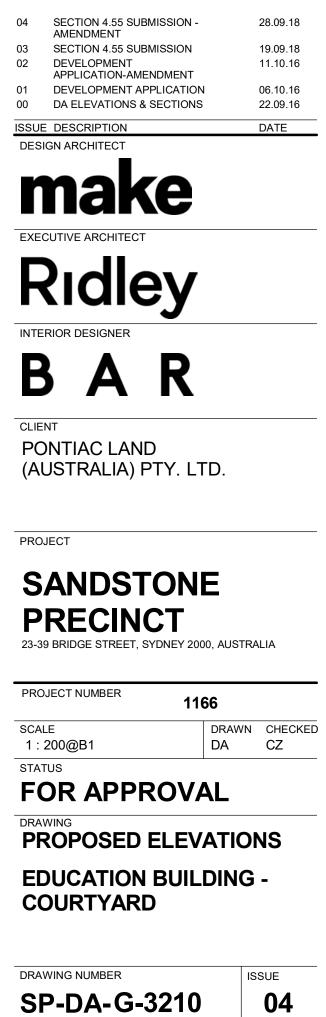



SP-DA-G-3210

