
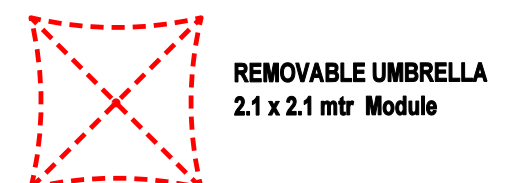


george street

EXISTING OUTDOOR SEATING PLAN DA-166-06 TO BE REPLACED BY NEW ARRANGEMENT SHOWN IN RED

LEGEND OUTDOOR FURNITURE SCALE 1 : 100

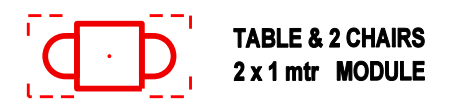

PROPOSED SEATING :
 6 x tables
 24 x chairs
 5 x umbrellas
 2 x partitions (EITHER ENDS)
 10 X planters

1 OUTDOOR SEATING PLAN

No.	Date	AMENDMENT
A	15-6-2009	DA-OUTDOOR SEATING