



ABN 48 612 666 172

Sydney | Brisbane | Melbourne

Level 20, 2 Market St
Sydney NSW 2000

PO Box Q453
Queen Victoria Building
NSW 1230

Ph (02) 9437 1000

31 August 2023

TSA

Level 4, 25 Watt Street

Newcastle NSW 2300

Attention: N.Babik

Dear Nora,

**RE: National Construction Code (NCC) 2019 Volume One
Amendment 1 Section J Part J1 Statement of Compliance**

JOB NO.: 210296

REV. NO.: FINAL B

SUBJECT PREMISE: Uniting Charlestown

This NCC Section J Part J1 statement has been prepared to demonstrate design compliance for the proposed Uniting Charlestown Building A development located at 27 Tiral Street, Charlestown.

The proposed development is located in climate **Zone 5** as defined by the NCC.

The table below shows the areas assessed, NCC building classification and the method of compliance.

Building Area Description	NCC Classification	Method of Compliance
Building A Office (LG+UG)	5	DTS
Building A Multi-purpose rooms	9b	DTS
Building A RACF (L1-L3)	9C	DTS

The assessment is based on the architectural drawings listed below.

Architectural Drawings

Plus Architecture
Project no. 20456
Issued 18/08/2023

Building	Title	Drawing No	Revision
Building A	FLOOR PLAN - BASEMENT	00100	[05]
	FLOOR PLAN - LOWER GROUND	00101	[05]
	FLOOR PLAN - UPPER GROUND	00102	[05]
	FLOOR PLAN - LEVEL 01	00103	[05]
	FLOOR PLAN - LEVEL 02-03	00104	[05]
	FLOOR PLAN - LEVEL 04	00105	[05]
	FLOOR PLAN - LEVEL 05-06	00106	[05]
	FLOOR PLAN - LEVEL 07	00107	[05]
	FLOOR PLAN - LEVEL 08	00108	[05]
	FLOOR PLAN - LEVEL 09	00109	[05]
	FLOOR PLAN - LEVEL 10	00110	[05]
	FLOOR PLAN - LEVEL 11	00111	[05]
	FLOOR PLAN - LEVEL 12	00112	[05]
	ROOF PLAN	00113	[05]
	NORTH ELEVATION JAMES ST	00200	[05]
	SOUTH ELEVATION TIRAL ST	00201	[05]
	BUILDING A EAST & WEST ELEVATION	00202	[05]
	BUILDING B EAST & WEST ELEVATION	00203	[05]
	BUILDING C EAST & WEST ELEVATION	00204	[05]
	BUILDING D EAST & WEST ELEVATION	00205	[05]

As per the Deemed-to-Satisfy Provisions of **NCC 2019 Volume One Amendment 1**, design compliance with Part J1 can be met subject to the following specifications:

Part J1 Building Fabric

Required **total R-value** including allowance for **thermal bridging**:

Elements	Total Construction R-value	Notes
All Roof	R3.7 (Downward, SA < 0.45)	<ul style="list-style-type: none"> It is a total system performance value and NOT the insulation. The impact of Thermal Bridging must be included in the building envelope total system R-value calculations. Building A Ground Floor Slab on ground expected to achieve R2.4 as per Specification J1.6 Sub-floor thermal performance, hence no additional insulation required.
Envelope Walls	R1.4	
Envelope Suspended External Floors	R2.0 (Downward)	

Required total system **U-value** and **SHGC**:

Location	Azimuth	Window Assembly (Glass & Frame)		Description
		U-value	SHGC	
A Office	All	6.2	0.70	Single Clear Glazing
A RAC	All	4.6	0.36	Double Low-e Tinted Glazing

Please refer to Attachment A for the facade calculator demonstrating compliance, and Attachment B for the mark-ups of the building fabrics thermal construction requirements.

Additional Section J Compliance Notes

Note project needs to adhere to the following NCC2019 Section J construction requirements as applicable:

- J1.2 (a-d) Thermal Construction – general installation requirements for insulations
- J1.2 (e) – The required total R-value and total system U-value, including thermal bridging calculation.

JHA recommend the following general construction requirements from Section J of the NCC 2019 be included in the architectural specification and drawings to ensure compliance.

Part J3 – Building Sealing

- J3.2 Chimneys and flues
- J3.3 Roof lights
- J3.4 Windows and doors
- J3.5 Exhaust fans
- J3.6 Construction of ceilings, walls and floors
- J3.7 Evaporative coolers

Full Name of Designer: Ivan Miao
Qualifications: B. Mechanical Eng (Honours)
Address of Designer: JHA
Level 23, 101 Miller Street,
NORTH SYDNEY NSW 2060
Business Telephone No: (02) 9437 1000
Name of Employer: JHA

Yours sincerely,



Ivan Miao
Sustainability Engineer

Disclaimer

This statement is prepared for the nominated recipient only and relates to the specific scope of work and agreement between JHA and the client (the recipient). It is not to be used or relied upon by any third party for any purpose.

Revision History

REV	DATE	Amendment
Draft V1	16/08/22	
Final A	24/08/22	
Final B	31/08/23	Final Doc for CC drawings

Attachment A – Facade Calculator:

The total representative Air-Conditioning energy value of the proposed building is 142.91 (less than 171.32) and total System U-value is 2.00 (equal to 2.00). Therefore, the proposed building façade complies with Part J1 via *Method 2*.

Project 210296 - LG & UG

Climate Zone	CZ 5
Class	Other
Azimuth	18

Display glazing			
Window Exposure	U-Value	SHGC	Area [m ²]
N	0.5	0.80	
E	0.5	0.80	
S	0.5	0.80	
W	0.5	0.80	

Exposure	Total Wall-Glazing Area				Walls		Windows				
	Reference Wall Type	External Envelope	Internal Envelope	Excluded Area	Sum	R-Value	A*U-Value	Exposure	U-Value	SHGC	A*U-Value
North	1	266.2	0.0	2.7	263.5	1.40	145.0	N1	6.2	0.7	375.2
	1				0.0		0.0	N2			0.0
	1				0.0		0.0	N3			0.0
	1				0.0		0.0	N4			0.0
East	1	338.8	0.0	5.2	333.5	1.40	196.1	E1	6.2	0.7	365.4
	1				0.0		0.0	E2			0.0
	1				0.0		0.0	E3			0.0
	1				0.0		0.0	E4			0.0
South	1	227.1	0.0	6.8	220.2	1.40	143.4	S1	6.2	0.7	120.8
	1				0.0		0.0	S2			0.0
	1				0.0		0.0	S3			0.0
	1				0.0		0.0	S4			0.0
West	1	416.2	0.0	6.5	409.7	1.40	186.8	W1	6.2	0.7	919.4
	1				0.0		0.0	W2			0.0
	1				0.0		0.0	W3			0.0
	1				0.0		0.0	W4			0.0

Exposure	Façade Area				Solar Admittance				U-value		R-value	
	Total [m ²]	Wall [m ²]	Window [m ²]	Wall Glazing Ratio	Max SA	Achieved SA	Max Er	Achieved Er	Max. U-Value	Achieved U-Value	Min. R-Value	Achieved R-Value
N	263.5	203.0	60.5	77%	0.13	0.10	78.11	60.74	2.0	1.97	1.0	1.40
E	333.5	274.6	58.9	82%	0.13	0.11	0.00	0.00	2.0	1.68	1.4	1.40
S	220.2	200.8	19.5	91%	0.13	0.04	0.00	0.00	2.0	1.20	1.4	1.40
W	409.7	261.5	148.3	64%	0.13	0.11	93.21	82.17	2.0	2.70	1.0	1.40
						SUM	171.32	142.91	2.0	2.00		

Description	Level	Window Exposure	Reference Wall Type	Window			P [m]	H [m]	P/H	G/H	Shading Multiplier	A*S*SHGC
				Height [m]	Width [m]	Area [m ²]						
L1		W1	1	3.20	6.10	19.5			-	-	1.00	13.66
L2		W1	1	3.10	1.96	6.1			-	-	1.00	4.25
L2.1		W1	1	2.70	2.10	5.7			-	-	1.00	3.97
L3		W1	1	3.00	4.90	14.7			-	-		
L4		N1	1			9.9			-	-	1.00	6.93
L5		N1	1	3.00	4.70	14.1	4.92	3.10	1.59	0.03	0.35	3.45
L6		W1	1	3.00	4.60	13.8	6.80	3.20	2.13	0.06	0.35	3.38
L7		W1	1	3.20	21.50	68.8	3.26	3.20	1.02	0.00	0.35	16.86
L8		N1	1	0.70	7.50	5.3	3.05	3.15	0.97	0.78	0.83	3.05
L9		N1	1	3.20	1.70	5.4	1.16	3.20	0.36	0.00		
1		E1	1	3.20	3.20	10.2	2.88	3.20	0.90	0.00	0.38	2.72
2		N1	1	3.20	1.90	6.1	1.90	3.20	0.59	0.00	0.57	2.43
3		N1	1	2.90	3.50	10.2	2.20	3.40	0.65	0.15	0.59	4.19
4		N1	1	2.00	4.80	9.6	0.50	2.60	0.19	0.23	0.98	6.59
5		E1	1	2.00	14.95	29.9	0.20	2.60	0.08	0.23	1.00	20.93
6		E1	1	2.00	9.40	18.8	0.20	2.60	0.08	0.23	1.00	13.16
7		S1	1	2.45	1.90	4.7	0.50	2.90	0.17	0.16	0.97	3.16
7.5		S1	1	2.45	2.45	6.0	3.50	2.90	1.21	0.16	0.62	2.61
8		S1	1	2.45	3.60	8.8	3.50	2.90	1.21	0.16	0.62	3.83
9		W1	1	2.90	3.50	10.2	4.60	2.90	1.59	0.00	0.35	2.49
10		W1	1	2.90	3.30	9.6	5.35	2.90	1.84	0.00	0.35	2.34

The total representative Air-Conditioning energy value of the proposed building is 416.80 (less than 425.72) and total System U-value is 1.97 (less than 2.00). Therefore, the proposed building façade complies with Part J1 via Method 2.

Project 210296 - RAC

Climate Zone	CZ 3
CHST	3c
Asbestos	0

Exposure	Total Wall-Glazing Area				Walls		Windows				
	Reference Wall Type	External Envelope	Internal Envelope	Excluded Area	Sum	R-Value	A1U-Value	Exposure	U-Value	SHGC	A1U-Value
North	1	834.8		0.0	834.8	1.40	541.0	N1	4.6	0.36	1001.1
	1			0.0	0.0	0.0	0.0	N2			0.0
	1			0.0	0.0	0.0	0.0	N3			0.0
	1			0.0	0.0	0.0	0.0	N4			0.0
East	1	676.3		18.7	657.6	1.40	364.1	E1	4.6	0.36	680.4
	1			0.0	0.0	0.0	0.0	E2			0.0
	1			0.0	0.0	0.0	0.0	E3			0.0
	1			0.0	0.0	0.0	0.0	E4			0.0
South	1	648.0		16.7	629.3	1.40	388.2	S1	4.6	0.36	1038.9
	1			0.0	0.0	0.0	0.0	S2			0.0
	1			0.0	0.0	0.0	0.0	S3			0.0
	1			0.0	0.0	0.0	0.0	S4			0.0
West	1	714.0		0.0	714.0	1.40	278.3	W1	4.6	0.36	1493.3
	1			0.0	0.0	0.0	0.0	W2			0.0
	1			0.0	0.0	0.0	0.0	W3			0.0
	1			0.0	0.0	0.0	0.0	W4			0.0

Exposure	Façade Area				Method 1		Method 2		U-value		R-value	
	Total (m²)	Wall (m²)	Window (m²)	Wall Glazing Ratio	Max SA	Achieved SA	Max U	Achieved U	Max U-Value	Achieved U-Value	Min. R-Value	Achieved R-Value
N	834.8	836.1	258.8	30.9%	0.10	0.06	154.95	32.41	2.0	1.71	1.0	1.40
E	676.3	489.2	186.4	27%	0.10	0.08	91.32	73.46	2.0	1.59	1.0	1.40
S	629.3	399.3	230.0	36.6%	0.10	0.13	62.93	79.41	2.0	2.11	1.0	1.40
W	714.0	399.9	314.1	43%	0.10	0.16	108.52	169.52	2.0	2.48	1.0	1.40
SUM							425.72	416.80	2.0	1.97		

Description	Level	Window Exposure	Reference Wall Type	Window			P	H	F/H	G/H	Shading Multiplier	A1U*SHGC
				Height (m)	Width (m)	Area (m²)						
N1		N1		2.70	1.00	2.70	1.60	2.90	1.24	0.07	0.33	1.02
N2		N1		2.70	1.30	3.51	1.60	2.90	1.24	0.07	0.33	1.05
N3		N1		2.70	1.65	4.45	2.20	2.40	0.92	0.00	0.38	0.95
N4		N1		2.70	1.25	3.38	1.60	2.40	1.50	0.00	0.33	1.11
N5		E1		2.70	1.40	3.78					1.00	1.59
N6		E1		2.20	1.20	2.64					1.00	1.53
N7		E1		2.20	1.75	3.85	0.20	2.00	0.09	0.00	1.00	2.07
N8		E1		2.40	1.20	2.88					1.00	1.04
N9		S1		2.70	1.30	3.51					1.00	3.21
N10		S1		2.70	1.65	4.45					1.00	3.81
N11		S1		2.70	1.00	2.70					1.00	0.97
N12		S1		2.70	1.30	3.51					1.00	1.04
N13		S1		2.70	1.65	4.45	0.20	2.00	1.10	0.00	0.58	0.93
N14		S1		2.70	1.20	3.24	0.20	2.00	0.09	0.00	1.00	1.90
N15		S1		2.20	1.20	2.64					1.00	0.84
N16		S1		1.30	1.30	1.69					1.00	1.45
N17		S1		2.20	1.60	3.52					1.00	4.44
N18		S1		2.20	1.40	3.08					1.00	4.44
N19		S1		2.20	1.40	3.08					1.00	1.45
N20		S1		2.20	1.60	3.52					1.00	4.44
N21		S1		2.20	1.80	3.96					1.00	4.44
N22		S1		1.30	1.30	1.69					1.00	1.45
N23		S1		2.20	1.60	3.52					1.00	4.44
N24		S1		2.20	1.40	3.08					1.00	1.45
N25		S1		2.20	1.40	3.08					1.00	4.44
N26		W1		2.20	0.90	1.98	0.20	2.30	0.09	0.00	1.00	0.71
N27		W1		2.70	1.20	3.24	2.90	2.70	1.07	0.00	0.33	0.58
N28		S1		2.70	1.30	3.51					1.00	2.74
N29		W1		2.70	1.60	4.32					1.00	2.13
N30		W1		2.70	1.60	4.32					1.00	0.95
N31		W1		2.20	0.90	1.98	0.20	2.20	0.09	0.00	1.00	0.48
N32		W1		2.20	1.20	2.64					1.00	0.66
N33		W1		2.20	1.20	2.64					1.00	1.11
N34		W1		2.20	1.80	3.96					1.00	3.01
N35		W1		2.20	1.80	3.96					1.00	4.59
N36		W1		2.20	1.80	3.96	0.20	2.00	0.09	0.00	1.00	0.71
N37		W1		2.20	2.20	4.84					1.00	2.74
N38		W1		2.70	0.80	2.16					1.00	0.78
N39		W1		2.20	0.90	1.98	0.20	2.20	0.09	0.00	1.00	0.71
N40		W1		2.20	1.20	2.64					1.00	0.94
N41		W1		2.20	1.20	2.64					1.00	1.50
N42		W1		2.20	1.20	2.64					1.00	0.85
N43		W1		2.20	1.20	2.64					1.00	0.71
N44		W1		2.20	1.80	3.96					1.00	2.85
N45		W1		2.20	1.80	3.96					1.00	4.86
N46		W1		2.20	1.80	3.96	0.20	2.20	0.09	0.00	1.00	0.71
N47		W1		2.20	1.80	3.96					1.00	2.85
N48		W1		2.20	1.20	2.64	2.90	2.80	1.04	0.00	0.33	0.60
N49		W1		2.20	1.20	2.64					1.00	0.87
N50		W1		2.20	1.80	3.96					1.00	3.40
N51		W1		2.20	1.80	3.96					1.00	5.40
N52		W1		2.20	1.80	3.96					1.00	1.50
N53		W1		2.20	1.80	3.96	0.20	2.00	0.09	0.00	1.00	0.71

Attachment B – Building Fabric Requirements

DRAWING TO BE READ IN CONJUNCTION WITH A0000 LEGEND, RELEVANT SCHEDULES AND PROJECT SPECIFICATION.



NCC 2019 Section J1 D13 Building Fabric Required U-value R-Values

Roof & Ceiling	Ri 3.7 (Downward)
Envelope Floors	Ri 2.2 (Downward)
Envelope Walls	Ri 1.4


Note

- All R-values must account for the impact of Thermal Bridging.
- The R-value is a total system performance value and NOT U-value.
- The above construction are only to be applied to non-glazed portions of the envelope and glazed panels, glazing must be installed as per the architectural layout with its thermal performance pursuant to the respective glazing specifications stated in the Section J1 report.

Glazing (Glass + Frame) requirements:

- (E.G. and IG level) performance glazing with U-value $U \le 2.2$ SHGC 0.70
- $U \le 1.4$ for IG level performance glazing with U-value $U \le 2.2$ SHGC 0.70

JHA
MANUFACTURER
DOCUMENT NO. 22020-01-01-01-01-01-01
DOCUMENT TITLE Uniting Charlestown - Section J D13
DOCUMENT REV. Draft 02
DOCUMENT BY JHA
DATE 18/08/2023

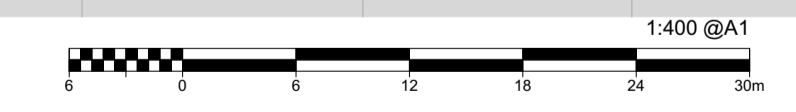

FOR APPROVAL

DATE	REVISION	BY	CHK	NO.
10/06/2021	FOR INFORMATION	AC	GD	C
18/09/2021	ISSUE	AC	GD	D
12/11/2021	ISSUE	AC	GD	E
10/12/2021	FOR INFORMATION	AC	GD	F
27/05/2022	FOR INFORMATION	AC	GD	K
7/06/2022	FOR INFORMATION	AC	GD	L
17/06/2022	FOR INFORMATION	AC	GD	N
29/06/2022	FOR INFORMATION	AC	GD	P
21/07/2022	FOR INFORMATION	AC	GD	S
26/07/2022	FOR INFORMATION	AC	GD	T

DATE	REVISION	BY	CHK	NO.
2/08/2022	FOR INFORMATION	AC	GD	U
5/08/2022	FOR INFORMATION	AC	GD	V
18/08/2022	FOR INFORMATION	AC	GD	X
19/08/2022	FOR APPROVAL	SH	GD	01
26/08/2022	FOR APPROVAL	SH	GD	02
26/08/2022	FOR APPROVAL	SH	GD	03
20/07/2023	FOR COORDINATION	MA	GD	AA
31/07/2023	FOR COORDINATION	MA	GD	AB
15/08/2023	FOR COORDINATION	MA	GD	AC
18/08/2023	FOR APPROVAL	MA	GD	05

CONSULTANTS			
CIVIL ENGINEER	<input type="checkbox"/>	MPC	T (02) 4927 5566
STRUCTURAL ENGINEER	<input type="checkbox"/>	NORTHROP	T (02) 9241 4188
LANDSCAPE ARCHITECT	<input type="checkbox"/>	ARCADIA	T (02) 8571 2900
QUANTITY SURVEYOR	<input type="checkbox"/>	WT GROUP	T (02) 9929 7422
TRAFFIC CONSULTANT	<input type="checkbox"/>	WARGA TRAFFIC PLANNING	T (02) 9904 3224

CONSULTANTS			
GEOTECHNICAL ENGINEER	<input type="checkbox"/>	DOUGLAS PARTNERS	T (02) 9800 0666

Uniting



Level 4, 222 Clarence Street
 Sydney, NSW 2000 Australia
 Plus Architecture Pty. Ltd.
 ACN 600596303
 Nominated Architect (NSW):
 Amit Julka 10002 | Rido Pin 11286


plus
 architecture
 Melbourne Brisbane
 Sydney Western Australia
 Perth
 Telephone +61 2 8823 7000
 Instagram #plusarchitecture
 arch@plusarchitecture.com.au
 www.plusarchitecture.com.au

PROJECT
**27 TIRAL STREET,
 CHARLESTOWN**

DRAWING TITLE
**FLOOR PLAN - LOWER
 GROUND**

SCALE
1:400 @A1
 DATE
18/08/2023
 DRAWN
MA
 JOB NO.
20456

REVISION
05
 PLOT DATE
18/08/2023
 CHECKED
GD
 DRAWING NO.
PLA-CT-MP-DWG-AR-P4-00101

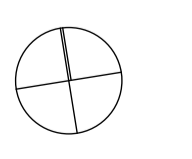

DRAWING TO BE READ IN CONJUNCTION WITH A0000 LEGEND, RELEVANT SCHEDULES AND PROJECT SPECIFICATION.



DATE	REVISION	BY	CHK	NO.
10/06/2021	FOR INFORMATION	AC	GD	C
19/09/2021	ISSUE	AC	GD	D
12/11/2021	ISSUE	AC	GD	E
10/12/2021	FOR INFORMATION	AC	GD	F
27/05/2022	FOR INFORMATION	AC	GD	K
7/06/2022	FOR INFORMATION	AC	GD	L
17/06/2022	FOR INFORMATION	AC	GD	N
29/06/2022	FOR INFORMATION	AC	GD	P
21/07/2022	FOR INFORMATION	AC	GD	S
26/07/2022	FOR INFORMATION	AC	GD	T

DATE	REVISION	BY	CHK	NO.
2/08/2022	FOR INFORMATION	AC	GD	U
5/08/2022	FOR INFORMATION	AC	GD	V
18/08/2022	FOR INFORMATION	AC	GD	X
19/08/2022	FOR APPROVAL	SH	GD	01
26/08/2022	FOR APPROVAL	SH	GD	02
26/08/2022	FOR APPROVAL	SH	GD	03
20/07/2023	FOR COORDINATION	MA	GD	AA
31/07/2023	FOR COORDINATION	MA	GD	AB
15/08/2023	FOR COORDINATION	MA	GD	AC
18/08/2023	FOR APPROVAL	MA	GD	05

CONSULTANTS			
CIVIL ENGINEER	<input type="checkbox"/>	MPC	T (02) 4927 5566
STRUCTURAL ENGINEER	<input type="checkbox"/>	NORTHROP	T (02) 9241 4188
LANDSCAPE ARCHITECT	<input type="checkbox"/>	ARCADIA	T (02) 8571 2900
QUANTITY SURVEYOR	<input type="checkbox"/>	WT GROUP	T (02) 9929 7422
TRAFFIC CONSULTANT	<input type="checkbox"/>	VARGA TRAFFIC PLANNING	T (02) 9904 3224

CONSULTANTS			
GEOTECHNICAL ENGINEER	<input type="checkbox"/>	DOUGLAS PARTNERS	T (02) 9800 0666

Uniting



plus
architecture
Melbourne
Brisbane
Christchurch
Sydney
Western Australia
Auckland
Telephone
+61 2 8823 7000
Instagram
@plusarchitecture
arch@plusarchitecture.com.au
www.plusarchitecture.com.au

PROJECT
**27 TIRAL STREET,
CHARLESTOWN**

DRAWING TITLE
**FLOOR PLAN - UPPER
GROUND**

SCALE
1:400 @A1
DATE
18/08/2023
DRAWN
MA
JOB NO.
20456

REVISION
05
PLOT DATE
18/08/2023
CHECKED
GD
DRAWING NO.
PLA-CT-MP-DWG-AR-P4-00102

FOR APPROVAL

DRAWING TO BE READ IN CONJUNCTION WITH A0000 LEGEND, RELEVANT SCHEDULES AND PROJECT SPECIFICATION.



FOR APPROVAL

DATE	REVISION	BY	CHK	NO.
18/09/2021	ISSUE	AC	GD	C
12/11/2021	ISSUE	AC	GD	D
10/12/2021	FOR INFORMATION	AC	GD	E
27/05/2022	FOR INFORMATION	AC	GD	K
7/06/2022	FOR INFORMATION	AC	GD	L
17/06/2022	FOR INFORMATION	AC	GD	N
29/06/2022	FOR INFORMATION	AC	GD	P
21/07/2022	FOR INFORMATION	AC	GD	S
26/07/2022	FOR INFORMATION	AC	GD	T
2/08/2022	FOR INFORMATION	AC	GD	U

DATE	REVISION	BY	CHK	NO.
5/08/2022	FOR INFORMATION	AC	GD	V
18/08/2022	FOR INFORMATION	AC	GD	X
19/08/2022	FOR APPROVAL	SH	GD	01
26/08/2022	FOR APPROVAL	SH	GD	02
26/08/2022	FOR APPROVAL	SH	GD	03
12/10/2022	FOR APPROVAL - RFI	SH	GD	04
20/07/2023	FOR COORDINATION	MA	GD	AA
31/07/2023	FOR COORDINATION	MA	GD	AB
15/08/2023	FOR COORDINATION	MA	GD	AC
18/08/2023	FOR APPROVAL	MA	GD	05

CONSULTANTS			
CIVIL ENGINEER	<input type="checkbox"/>	MPC	T (02) 4927 5566
STRUCTURAL ENGINEER	<input type="checkbox"/>	NORTHROP	T (02) 9241 4188
LANDSCAPE ARCHITECT	<input type="checkbox"/>	ARCADIA	T (02) 8571 2900
QUANTITY SURVEYOR	<input type="checkbox"/>	WT GROUP	T (02) 9929 7422
TRAFFIC CONSULTANT	<input type="checkbox"/>	VARGA TRAFFIC PLANNING	T (02) 9004 3224

CONSULTANTS			
GEOTECHNICAL ENGINEER	<input type="checkbox"/>	DOUGLAS PARTNERS	T (02) 9800 0666

Uniting



Level 4, 222 Clarence Street
 Sydney, NSW 2000 Australia
 Plus Architecture Pty. Ltd.
 ACN 600596303
 Nominated Architect (NSW):
 Amit Julka 10002 | Rido Pin 11286

plus
 architecture
 Melbourne
 Brisbane
 Christchurch
 Sydney
 Western Australia
 Auckland


Telephone
 +61 2 8823 7000
 Instagram
 #plusarchitecture
 arch@plusarchitecture.com.au
 www.plusarchitecture.com.au

PROJECT
**27 TIRAL STREET,
 CHARLESTOWN**

DRAWING TITLE
FLOOR PLAN - LEVEL 01

SCALE
1:400 @A1
 DATE
18/08/2023
 DRAWN
MA
 JOB NO.
20456

REVISION
05
 PLOT DATE
18/08/2023
 CHECKED
GD
 DRAWING NO.
PLA-CT-MP-DWG-AR-P4-00103

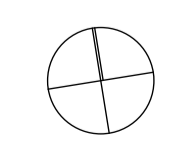

DRAWING TO BE READ IN CONJUNCTION WITH A0000 LEGEND, RELEVANT SCHEDULES AND PROJECT SPECIFICATION.



NCC 2019 Section J1 D13 Building Fabric Required U-value R-Values

Roof & Ceiling	Ri 3.7 (Downward)
Envelope Floors	Ri 2.2 (Downward)
Envelope Walls	Ri 1.4

Note

- All R-values must account for the impact of Thermal Bridging.
- The R-value is a total system performance value and NOT insulation.
- The above construction are only to be applied to non-glazed portions of the envelope and glazed panels, glazing must be installed as per the architectural layouts with its thermal performance pursuant to the respective glazing specifications stated in the Section J1 report.

Glazing (Glass + Frame) requirements:

- (U.G and U.G level) performance glazing with U-value ≤ 2.5W/m² K.
- U.G level performance glazing with U-value ≤ 2.5W/m² K.

JCA
ARCHITECT
Plus Architecture Pty. Ltd.
Level 4, 222 Clarence Street Sydney, NSW 2000 Australia
ACN 600596303
Phone: +61 2 8823 7000
Instagram: @plusarchitecture
arch@plusarchitecture.com.au
www.plusarchitecture.com.au



FOR APPROVAL

DATE	REVISION	BY	CHK	NO.
3/06/2021	FOR INFORMATION	AC	GD	B
19/09/2021	ISSUE	AC	GD	C
12/11/2021	ISSUE	AC	GD	D
10/12/2021	FOR INFORMATION	AC	GD	E
27/05/2022	FOR INFORMATION	AC	GD	K
7/06/2022	FOR INFORMATION	AC	GD	L
17/06/2022	FOR INFORMATION	AC	GD	N
21/07/2022	FOR INFORMATION	AC	GD	S
26/07/2022	FOR INFORMATION	AC	GD	T
5/08/2022	FOR INFORMATION	AC	GD	V

DATE	REVISION	BY	CHK	NO.
19/08/2022	FOR APPROVAL	SH	GD	01
26/08/2022	FOR APPROVAL	SH	GD	02
26/08/2022	FOR APPROVAL	SH	GD	03
20/07/2023	FOR COORDINATION	MA	GD	AA
31/07/2023	FOR COORDINATION	MA	GD	AB
15/08/2023	FOR COORDINATION	MA	GD	AC
18/08/2023	FOR APPROVAL	MA	GD	05

CONSULTANTS			
CIVIL ENGINEER	<input type="checkbox"/>	MPC	T (02) 4927 5566
STRUCTURAL ENGINEER	<input type="checkbox"/>	NORTHROP	T (02) 9241 4188
LANDSCAPE ARCHITECT	<input type="checkbox"/>	ARCADIA	T (02) 8571 2900
QUANTITY SURVEYOR	<input type="checkbox"/>	WT GROUP	T (02) 9929 7422
TRAFFIC CONSULTANT	<input type="checkbox"/>	VARGA TRAFFIC PLANNING	T (02) 9004 3224

CONSULTANTS			
GEOTECHNICAL ENGINEER	<input type="checkbox"/>	DOUGLAS PARTNERS	T (02) 9800 0666

Uniting



Level 4, 222 Clarence Street
 Sydney, NSW 2000 Australia
 Plus Architecture Pty. Ltd.
 ACN 600596303
 Nominated Architect (NSW):
 Amit Julka 10002 | Rido Pin 11286

plus
 architecture

Melbourne
 Brisbane
 Christchurch
 Sydney
 Western Australia
 Auckland

PROJECT
**27 TIRAL STREET,
 CHARLESTOWN**

DRAWING TITLE
FLOOR PLAN - LEVEL 02-03

In copying and utilizing this document the recipient agrees that Plus Architecture Pty. Ltd. ACN 600596303, retain all common law, statutory law and other rights including copyright and intellectual property rights. The recipient agrees not to use this document for any purpose other than its intended use, to waive all claims against Plus Architecture resulting from unauthorised changes, or to reuse the document on other projects without the prior written consent of Plus Architecture. Under no circumstances shall transfer of this document be deemed a sale. Plus Architecture makes no warranties of fitness for any purpose. The Builder/Contractor shall verify job dimensions prior to any work commencing. Figured dimensions shall take precedence over scaled work.

SCALE	REVISION	
1:400 @A1	05	
DATE	PLOT DATE	
18/08/2023	18/08/2023	
DRAWN	CHECKED	
MA	GD	
JOB NO.	DRAWING NO.	
20456	PLA-CT-MP-DWG-AR-P4-00104	

