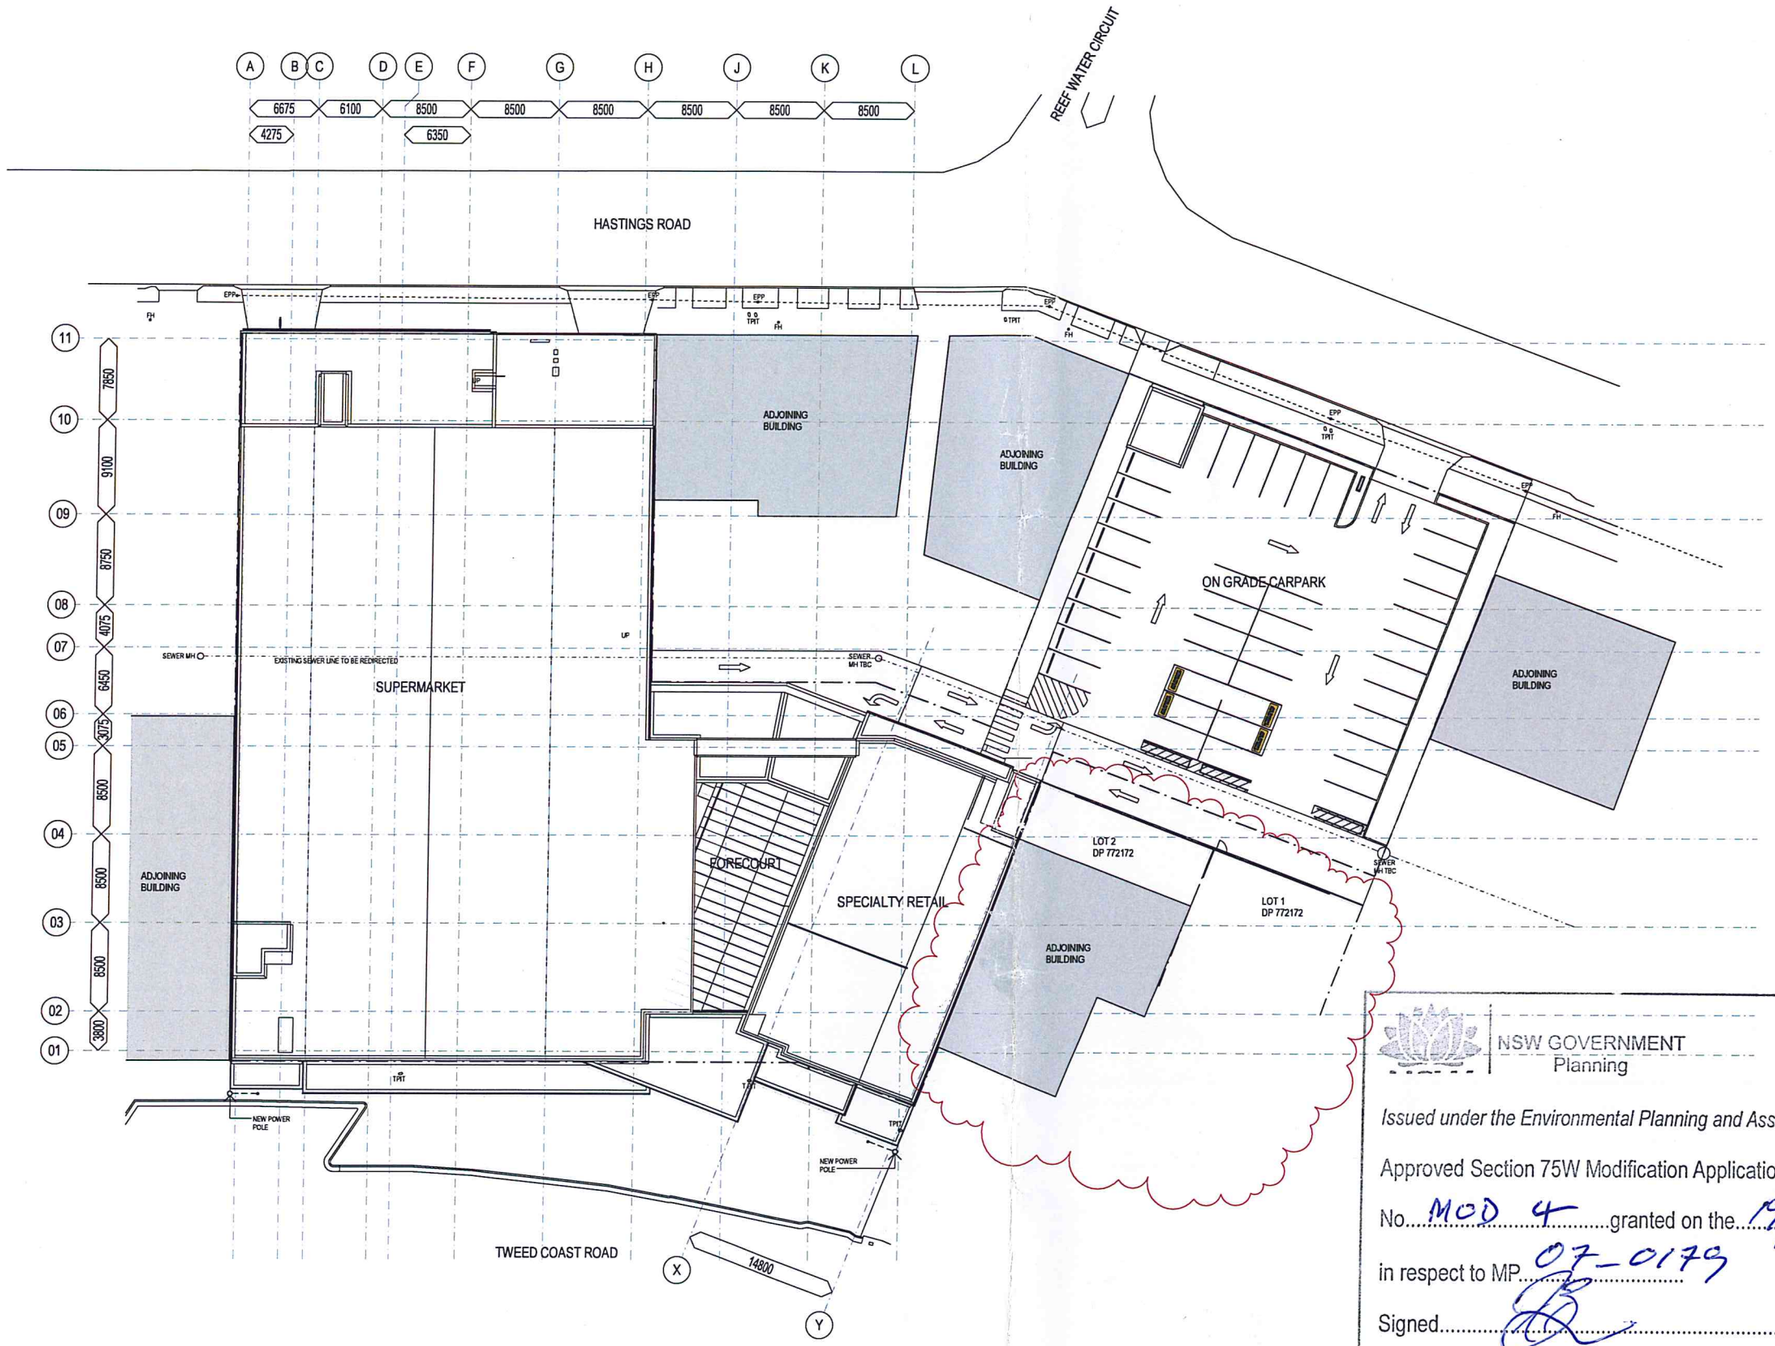

NOTES
Only use figured dimensions. Do not scale from drawings.

ABBREVIATIONS

AP	ACCESS PANEL
B	BASIN
BCT	BABY CHANGE TABLE
BKR	BACKREST
BR	SS BUMP RAIL
BT	BALUSTRADE TYPE
CH	COAT HOOK
COS	CHECK ON SITE
CS	CLEANERS SINK
CT	CEILING TYPE: SEE SCHEDULE
D	DOOR
DP	DOWN PIPE
FF	FLOOR FINISH TYPE: SEE SCHEDULE
FFL	FINISHED FLOOR LEVEL
FG	FIXED GLASS
FP	FIXED PANEL
FS	FOLDING SHOWER SEAT
FW	FLOOR WASTE
GR	GRAE RAIL TO AS 1428
GT	GREASE TRAP
HC	HOSE COCK
HD	HAND DRYER
HT	HANDRAIL TYPE
L	LOUVRE
M	MIRROR
MH	MANHOLE
MT	MIXER TAP
NC	NO CEILING
PJ	PANEL JOINT
PTD	PAPER TOWEL DISPENSER
R	REVEAL
RL	RELATIVE LEVEL
RWO	RAIN WATER OUTLET
SD	SOAP DISPENSER
SF	SHELF
SH	SOAP HOLDER
SHW	SHOWER
SL	STRUCTURAL LEVEL
SRH	SHOWER RAIL & HEAD
TS	TROLLEY BAY
TBC	TO BE CONFIRMED
TPH	TOILET PAPER HOLDER
UR	URINAL
VB	VANITY BASIN
W	WINDOW
WC	TOILET
WF	WALL FINISH TYPE: SEE SCHEDULE
WT	WALL TYPE: SEE SCHEDULE

date	rev	revision history	check
29.01.14	E	DRAWINGS UPDATED	TF
17.01.13	C	AS CONSTRUCTED	TF
15.01.13	B	ARRANGE ADJUSTED	TF
28.02.12	A	FOR CONSTRUCTION	TF

key plan

north

NSW GOVERNMENT
Planning

Issued under the Environmental Planning and Assessment Act 1979

Approved Section 75W Modification Application

No. MOD 4 granted on the 19/12/2014

in respect to MP 07_0179

Signed.....

Sheet No. 1 of 2

AS CONSTRUCTED

0 2000 4000 6000 8000 10000 20000 40000

proponent
WOOLWORTHS CABARITA

TWEED COAST RD, CABARITA

FOR MAINBRACE CONSTRUCTIONS

Cameron Chisholm & Nicol
618 Kiewa Street
Milton QLD 4064
GPO Box 2727
Brisbane QLD 4001
Telephone (07) 3367 7000
Facsimile (07) 3367 0942
nlq@cnnetwork.com.au

drawing title
SITE PLAN

project no.		scale	
Q1201		1 : 200	@A0
discipline	stage	drg no	rev no
A	AB	0001	D

CCN: NCN
Model: P:\Q1201 Cabarita Woolworths\Revit\Site Plan.rvt
Sheet: 0001 - Site Plan
2012/06/14 9:12:16 AM

REFER TO LANDSCAPE ARCHITECT'S DRAWINGS FOR SCOPE OF WORK BEYOND BOUNDARY

HASTINGS ROAD

REFER TO 1202 FOR CONTINUATION

ON GRADE CARPARK

AFTER HOURS LOADING BAY

ACCESS EASEMENT

PEDESTRIAN ACCESS

SITE BOUNDARY

REFUSE AREA

LOT 2 DP772172

LOT 1 DP772172

MOVING WALKWAY LOBBY

MOVING WALKWAYS

LIFT LOBBY

LIFT No1

CLEANER'S STORE

TAXI / LOADING BAY

CONC SLAB TO TOP OF WATER TANK UNDER

WHEEL STOPS 800mm FROM FLUSH KERB

KERB

LANDSCAPING

75mm ROLLOVER CONC EDGE

SLIDING GATE

RESI WASTE BIN

RESI RECYCLE BIN

GAS BOTTLES

SLIDING CHAINLINK GATE

PUMP CONTROL PANEL

RETAIL WASTE BIN

SKIP COLS

RETAIL RECYCLE BIN

LETTERBOXES 16 OFF

GAS PIPE RISER

ELEC RISER

CARPARK EXH RISER

STAIR NOSE

DESK BY OTHERS

TAXI PHONE & GPO

VOID BELOW MOVING WALKWAYS

RAMP UP 1:20

SPEED RAMP

14800

8500

7650

9100

8750

4075

6450

3075

6500

3600

WALL TYPES

WT001	400mm DIA SECANT PILES WITH 125 mm CONC LINING
WT005	170mm SHEET PILING W 125mm CONC LINING
WT006	170mm SHEET PILING W 150mm CONC LINING
WT007	170mm SHEET PILING W 350mm CONC LINING
WT008	320mm SHEET PILING W 125mm CONC LINING
WT009	320mm SHEET PILING W 350mm CONC LINING
WT012	125mm CAST IN SITU CONCRETE
WT013	150mm CAST IN SITU CONCRETE
WT015	200mm CAST IN SITU CONCRETE
WT017	300mm CAST IN SITU CONCRETE
WT023	150mm TILT-UP CONCRETE PANEL
WT100	190mm CONCRETE BLOCKS
WT107	190mm CONCRETE BLOCK REINFORCED & CORE FILLED
WT202	64mm STEEL STUD WITH 15mm WATER RESISTANT PLASTERBOARD TO ONE SIDE
WT203	64mm STEEL STUDS WITH 10mm PLASTERBOARD TO ONE SIDE
WT206	64mm STEEL STUDS WITH 2 LAYERS 16mm FIRE RATED PLASTERBOARD TO ONE SIDE
WT207	64mm STEEL STUDS WITH 3 LAYERS 16mm FIRE RATED PLASTERBOARD TO ONE SIDE
WT221	64mm STEEL STUDS WITH 10mm PLASTERBOARD TO BOTH SIDES
WT251	92mm STEEL STUD WITH 6mm FIBRE CEMENT TO ONE SIDE
WT251a	92mm STEEL STUD WITH 9mm FIBRE CEMENT TO ONE SIDE
WT264	92mm STEEL STUDS WITH 13mm PLASTERBOARD TO ONE SIDE
WT271a	92mm STEEL STUDS WITH 9mm FIBRE CEMENT TO BOTH SIDES
WT272	92mm STEEL STUDS WITH 6mm FIBRE CEMENT TO ONE SIDE & 10mm PLASTERBOARD TO ONE SIDE
WT281	92mm STEEL STUDS WITH 10mm PLASTERBOARD TO BOTH SIDES
WT411	PERFORATED METAL WITH 50mm BRADFORD ULTRATEL INSULATION & ULTRAPHON FACING
WT501	30mm LAMINATED TOILET PARTITION
WT521	10mm PLASTERBOARD BAHEAD ON STEEL FRAMING
WT522	13mm PLASTERBOARD BAHEAD ON STEEL FRAMING
WT543	12mm PLYWOOD PANEL ON 22mm FURRING CHANNELS
WT702	9mm FIBRE CEMENT
WT725	9mm FIBRE CEMENT ON 22mm FURRING CHANNELS
WT726	9mm COMPRESSED FIBRE CEMENT ON 22mm FURRING CHANNELS
WT728	9mm COMPRESSED FIBRE CEMENT ON 35mm FURRING CHANNELS
WT743	10mm PLASTERBOARD ON 22mm FURRING CHANNELS

WALL FINISH TYPES

WF114	CERAMIC TILES
WF116	CERAMIC TILES
WF201	6mm GLASS MIRROR
WF421	10mm CEMENT RENDER

NOTES
Only use figured dimensions. Do not scale from drawings.

ABBREVIATIONS

AP	ACCESS PANEL
B	BASIN
BCT	BABY CHANGE TABLE
BKR	BACKREST
BR	SS BUMP RAIL
BT	BALUSTRADE TYPE
CH	COAT HOOK
CDS	CHECK ON SITE
CS	CLEANERS SINK
CT	CEILING TYPE: SEE SCHEDULE
D	DOOR
DP	DOWN PIPE
FF	FLOOR FINISH TYPE: SEE SCHEDULE
FFL	FINISHED FLOOR LEVEL
FG	FIXED GLASS
FP	FIXED PANEL
FS	FOLDING SHOWER SEAT
FW	FLOOR WASTE
GR	GRAB RAIL TO AS 1428
GT	GREASE TRAP
HC	HOSE COCK
HD	HAND DRYER
HT	HANDRAIL TYPE
L	LOUVRE
M	MIRROR
MH	MANHOLE
MT	MIXER TAP
NC	NO CEILING
PJ	PANEL JOINT
PTD	PAPER TOWEL DISPENSER
R	REVEAL
RL	RELATIVE LEVEL
RWO	RAIN WATER OUTLET
SD	SOAP DISPENSER
SF	SHELF
SH	SOAP HOLDER
SHW	SHOWER
SL	STRUCTURAL LEVEL
SRH	SHOWER RAIL & HEAD
TR	TROLLEY BAY
TBC	TO BE CONFIRMED
TPH	TOILET PAPER HOLDER
UR	URINAL
VB	VANITY BASIN
W	WINDOW
WC	TOILET
WF	WALL FINISH TYPE: SEE SCHEDULE
WT	WALL TYPE: SEE SCHEDULE

18.09.14	F	DRAWING UPDATED	TF
27.05.13	E	AS CONSTRUCTED	TF
17.10.12	D	DOOR Nos & RLs ADDED	TF
23.08.12	C	ACCESS DRIVEWAY CHANGES	TF
18.05.12	B	REFUSE AREA DETAILS ADDED	TF
12.04.12	A	FOR CONSTRUCTION ISSUE	TF
date	rev	revision history	drawn

NSW GOVERNMENT
Planning

Issued under the Environmental Planning and Assessment Act 1979

Approved Section 75W Modification Application

No. MOD 4 granted on the 19/12/2014

in respect to MP 07_0179

Signed.....

Sheet No. 2 of 2

WOOLWORTHS CABARITA

TWEED COAST RD, CABARITA

FOR MAINBRACE CONSTRUCTIONS

Cameron Chisholm & Nicol

LOWER GROUND LEVEL PART B FLOOR PLAN

project no. Q1201 | scale 1:100 @A0

discipline A | drawn AB | drawing no. 1203 | rev no. F

A WEST ELEVATION
B NORTH ELEVATION
C EAST ELEVATION
D SOUTH ELEVATION
E SECTION
REFUSE AREA

AS CONSTRUCTED