


**IMPORTED SCREENED CRUSHED ROCK SPECIFICATION (LEACHATE DRAINAGE MEDIA)**

- THE DRAINAGE MEDIA SHOULD BE SELECTED TO HAVE SUFFICIENTLY LARGE PORE SPACE TO PREVENT ENCRUSTATION.
- THE GRAVEL SELECTED SHALL BE:
  - OF GRAIN SIZE GREATER THAN 20 MILLIMETRES
  - SMOOTH-SURFACED
  - NON-REACTIVE IN MILDLY ACIDIC CONDITIONS AND LOW NET ACID GENERATING POTENTIAL
  - FREE OF CARBONATES THAT COULD FORM ENCRUSTATIONS AROUND THE COLLECTOR PIPES ( < 15% CALCIUM CARBONATE BY VOLUME )
  - FREE FROM FOREIGN MATTER ( < 1% )
  - FREE FROM VEGETATIVE MATTER ( < 1% )
  - PERMEABILITY > 1 x 10<sup>-1</sup> m/s

DETAIL A 541

Before commencing work, all controlling dimensions on the drawings must be verified on the site, particularly those relative to property alignments, other structures, and services.  
Figured dimensions take preference over scaled. If in doubt, ask.

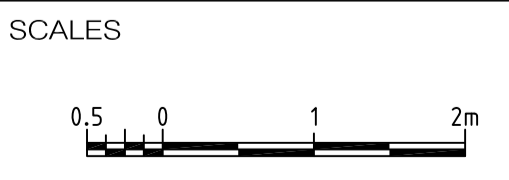

DESIGN	PREPARED	CHECKED	PASSED
DRAFTING	SRH	RBY	Original signed by M.D BROWN
	AJC	NG	DATE 7.06.02



WOODLAWN BIOREACTOR  
BASAL LINER SYSTEM  
COLLECTOR ROAD, TARAGO


10407001-542 Z

Last modified: 29 Oct 04 - 08:24  
Cad ref: J:\MMP\110407001\Cad\Mine Site & Infra\dwgs\10407001-542.dwg

No.	BY	DATE	DESCRIPTION	APPD
Z	LT	13.04.16	REDUNDANT DRAINAGE DETAILS REMOVED	
B	SGG	18.03.04	BENTONITE ADDED	
A	SGG	29.1.04	AS BUILT	RBY



<p>36 Montague Street Goulburn NSW 2580 p: (02) 4821 1033 f: (02) 4821 7238 e: goulburn@landteam.com.au</p>	<p>HEIGHT DATUM : AHD CONTOUR INTERVAL : 5m</p>	<p><b>PLAN</b></p>	<p>Sheet No. 1</p>
	<p>0 15 30 45 60 METRES SCALE 1:1250</p>	<p><b>WOODLAWN BIOREACTOR CLAY LINING MARCH 2011</b></p>	<p>No. of Sheets: 1 Date: 22/11/2011 Ref. No: 16700 Drawing No. 35   Issue A</p>

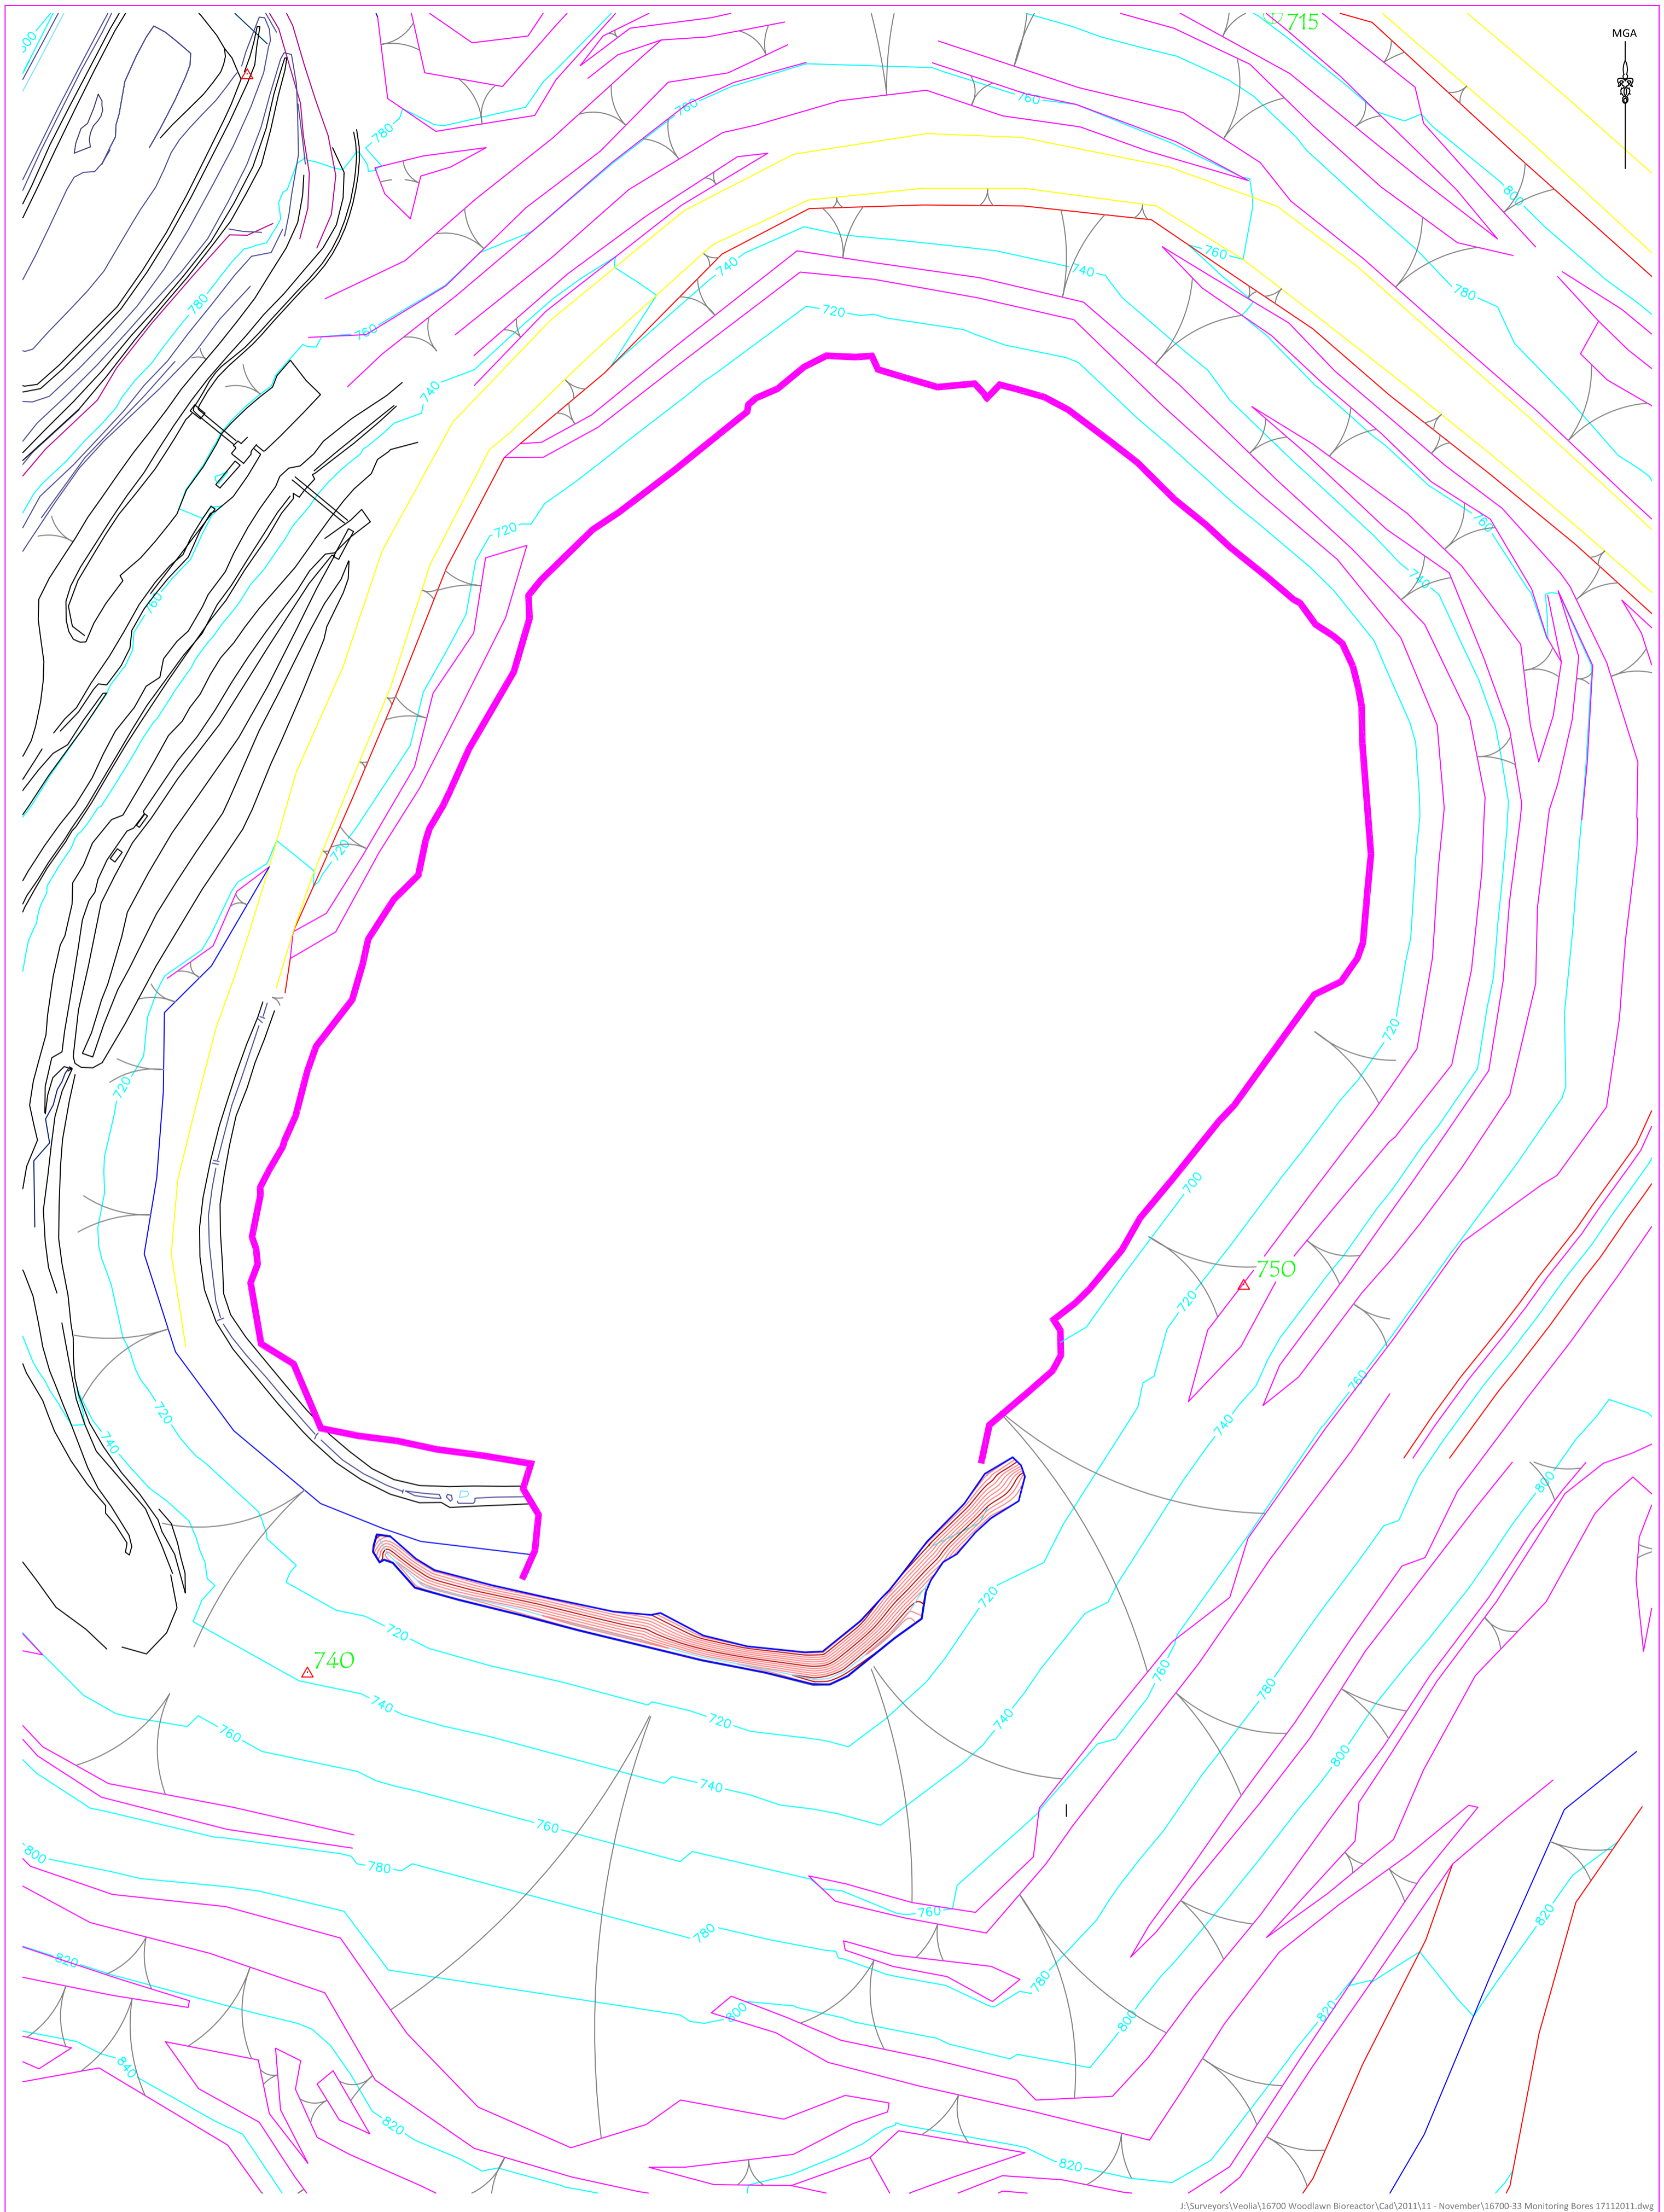

J:\Surveyors\Veolia\16700 Woodlawn Bioreactor\Cad\2011\11 - November\16700-33 Monitoring Bores 17112011.dwg

ISSUE	AMENDMENT	DATE
A	INITIAL ISSUE	30/01/2012

SCALE 1:1250

Metres

Liability limited by a scheme approved under Professional Standards Legislation.

**A2**  
SHEET

**VEOLIA**  
ENVIRONMENTAL SERVICES

**LandTeam**  
LandTeam Australia Pty Ltd  
Goulburn Office  
36 Montague Street  
Goulburn NSW 2580  
p: (02) 4821 1033  
f: (02) 4821 7238  
e: goulburn@landteam.com.au

VEOLIA ENVIRONMENTAL SERVICES

WOODLAWN BIOREACTOR  
CLAY LINING LOCATION  
JANUARY 2012

DATUM: AHD    ORIGIN: PILLAR 713    CONTOUR INTERVAL: 20m


DATE: 30/01/2012

SURVEYED: S McD    ISSUE

DRAWN: S McD    **A**

CHECKED: MK

DRAWING No. **16700-41**

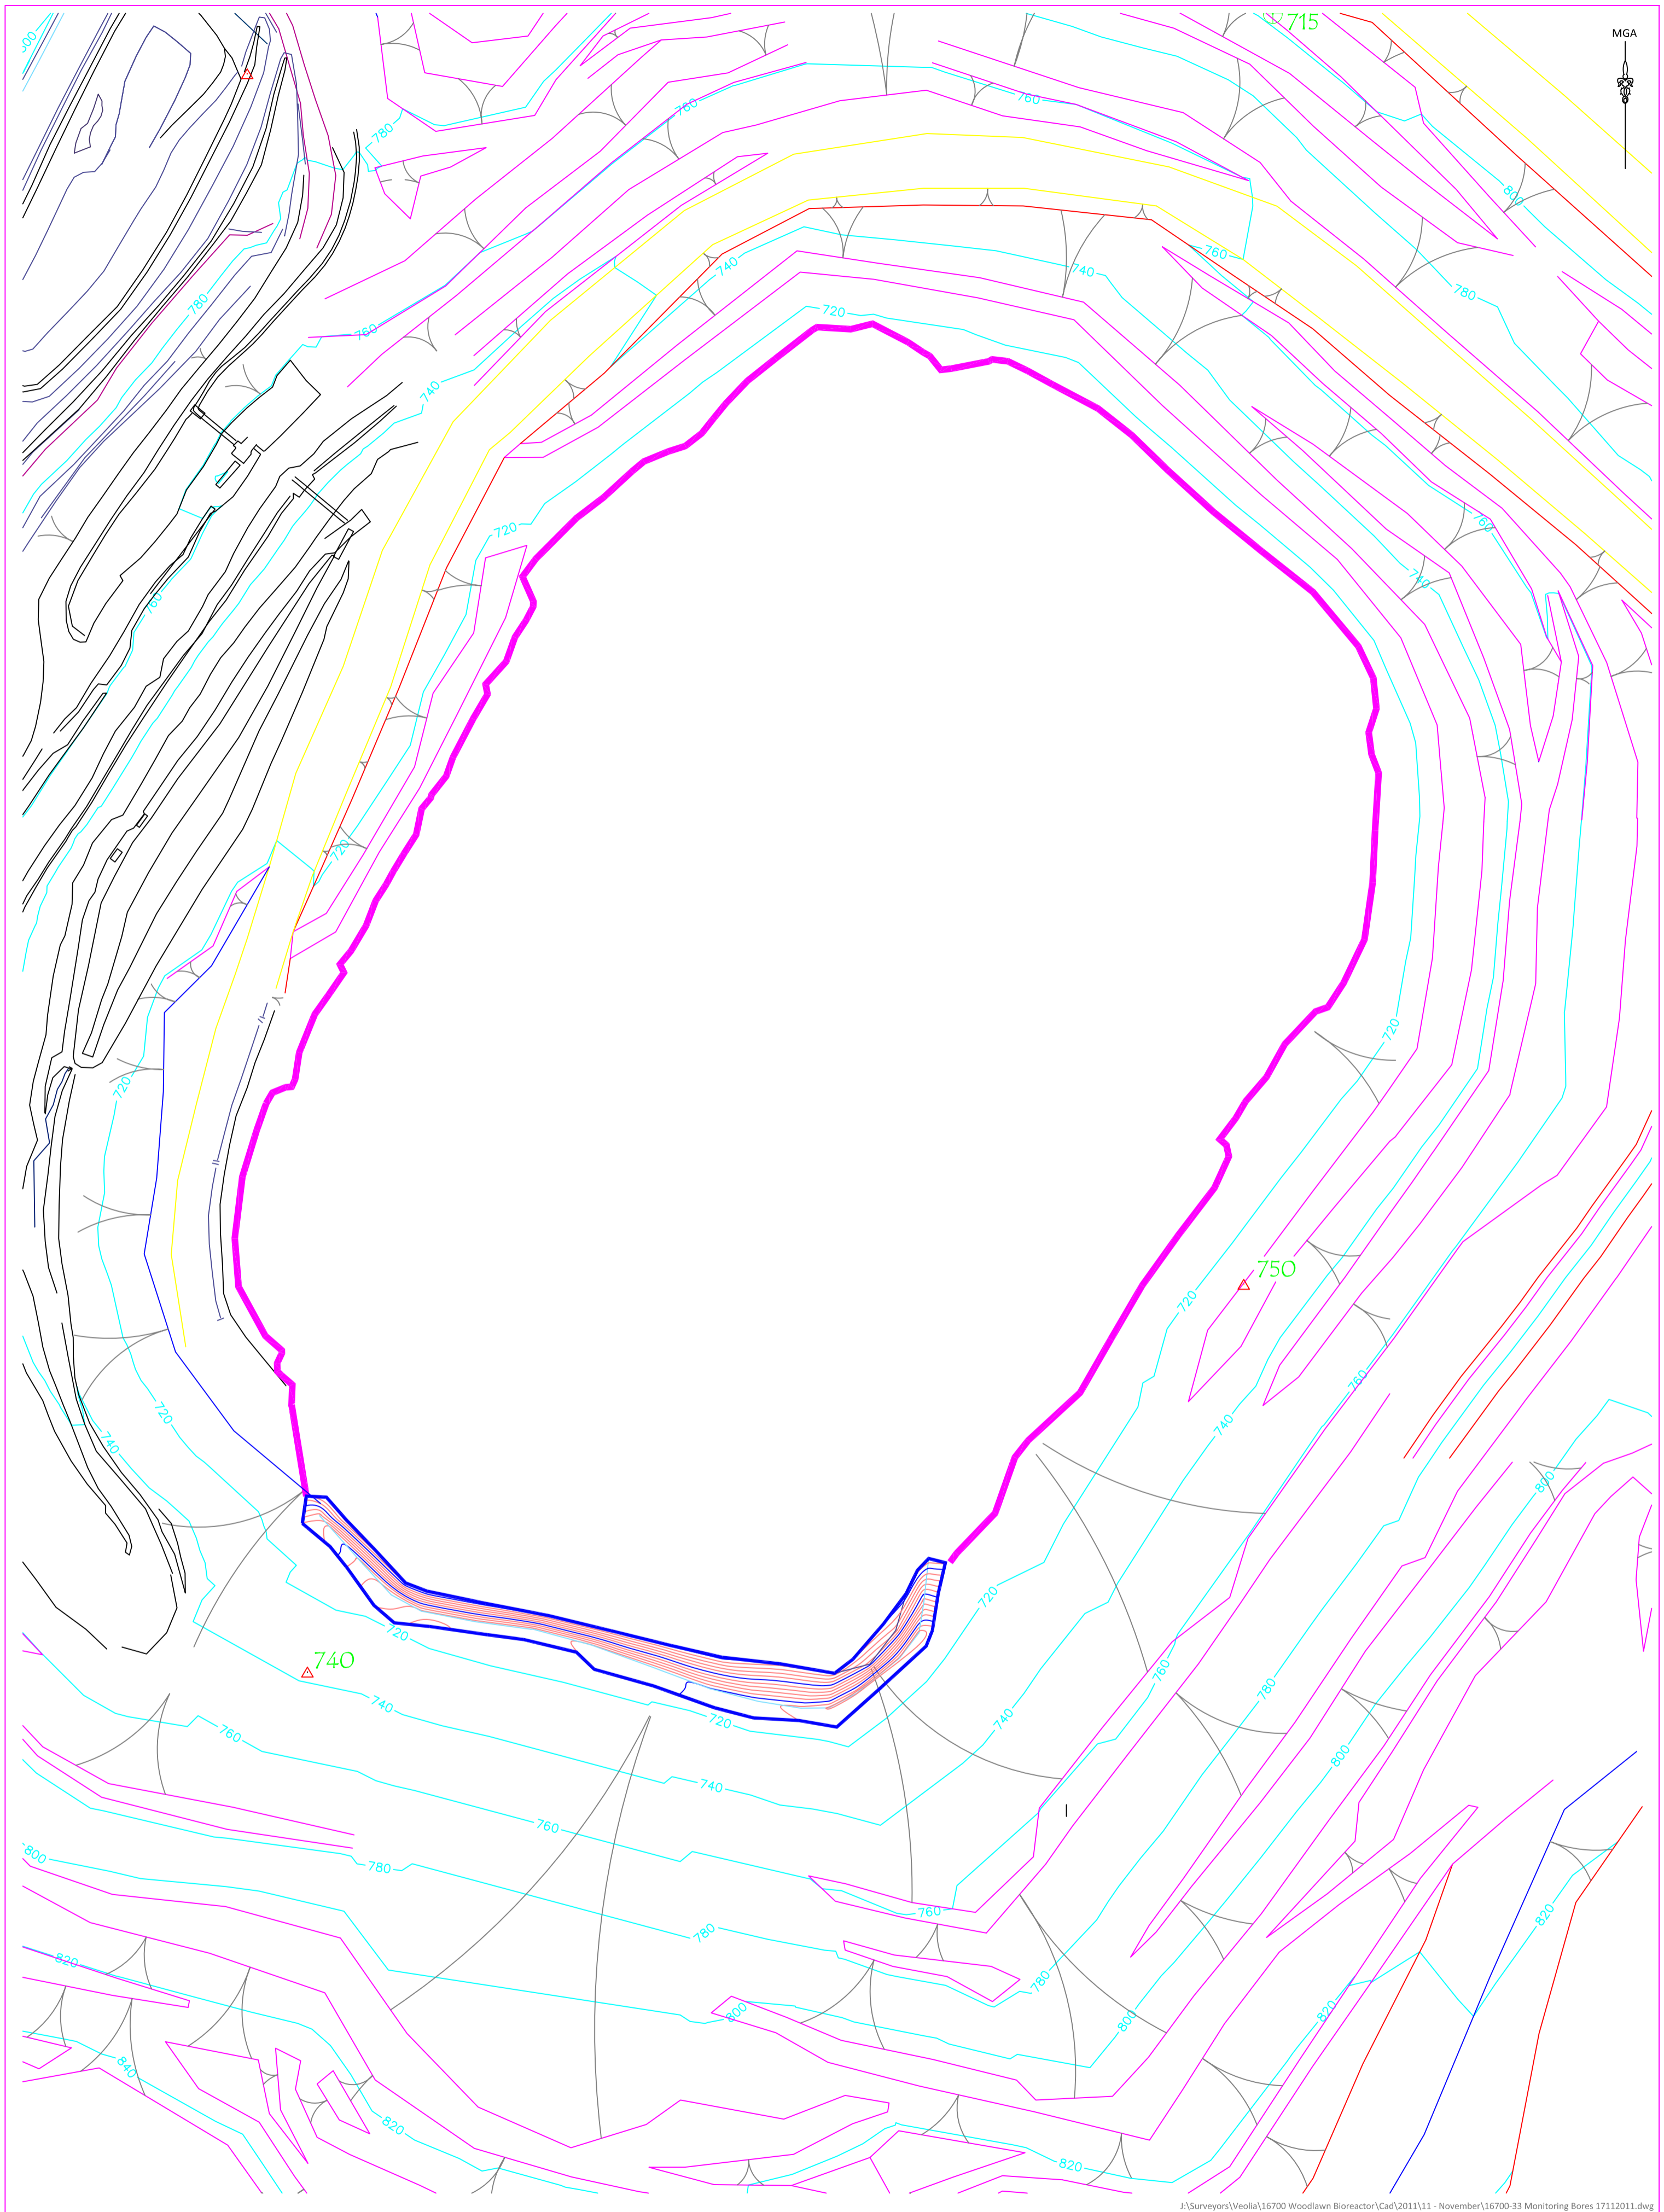

J:\Surveyors\Veolia\16700 Woodlawn Bioreactor\Cad\2011\11 - November\16700-33 Monitoring Bores 17112011.dwg

ISSUE	AMENDMENT	DATE
A	INITIAL ISSUE	29/10/2012

SCALE 1:1250

Metres

Liability limited by a scheme approved under Professional Standards Legislation.

**A2**  
SHEET

**VEOLIA**  
ENVIRONMENTAL SERVICES

**LandTeam**

LandTeam Australia Pty Ltd  
Goulburn Office  
36 Montague Street  
Goulburn NSW 2580  
p: (02) 4821 1033  
f: (02) 4821 7238  
e: goulburn@landteam.com.au

VEOLIA ENVIRONMENTAL SERVICES

WOODLAWN BIOREACTOR  
CLAY LINING LOCATION  
OCTOBER 2012

DATUM: AHD | ORIGIN: PILLAR 713 | CONTOUR INTERVAL: 20m

DATE: 29/10/2012


SURVEYED: S McD

DRAWN: S McD


CHECKED: MK

DRAWING No. **16700-60**

ISSUE **A**

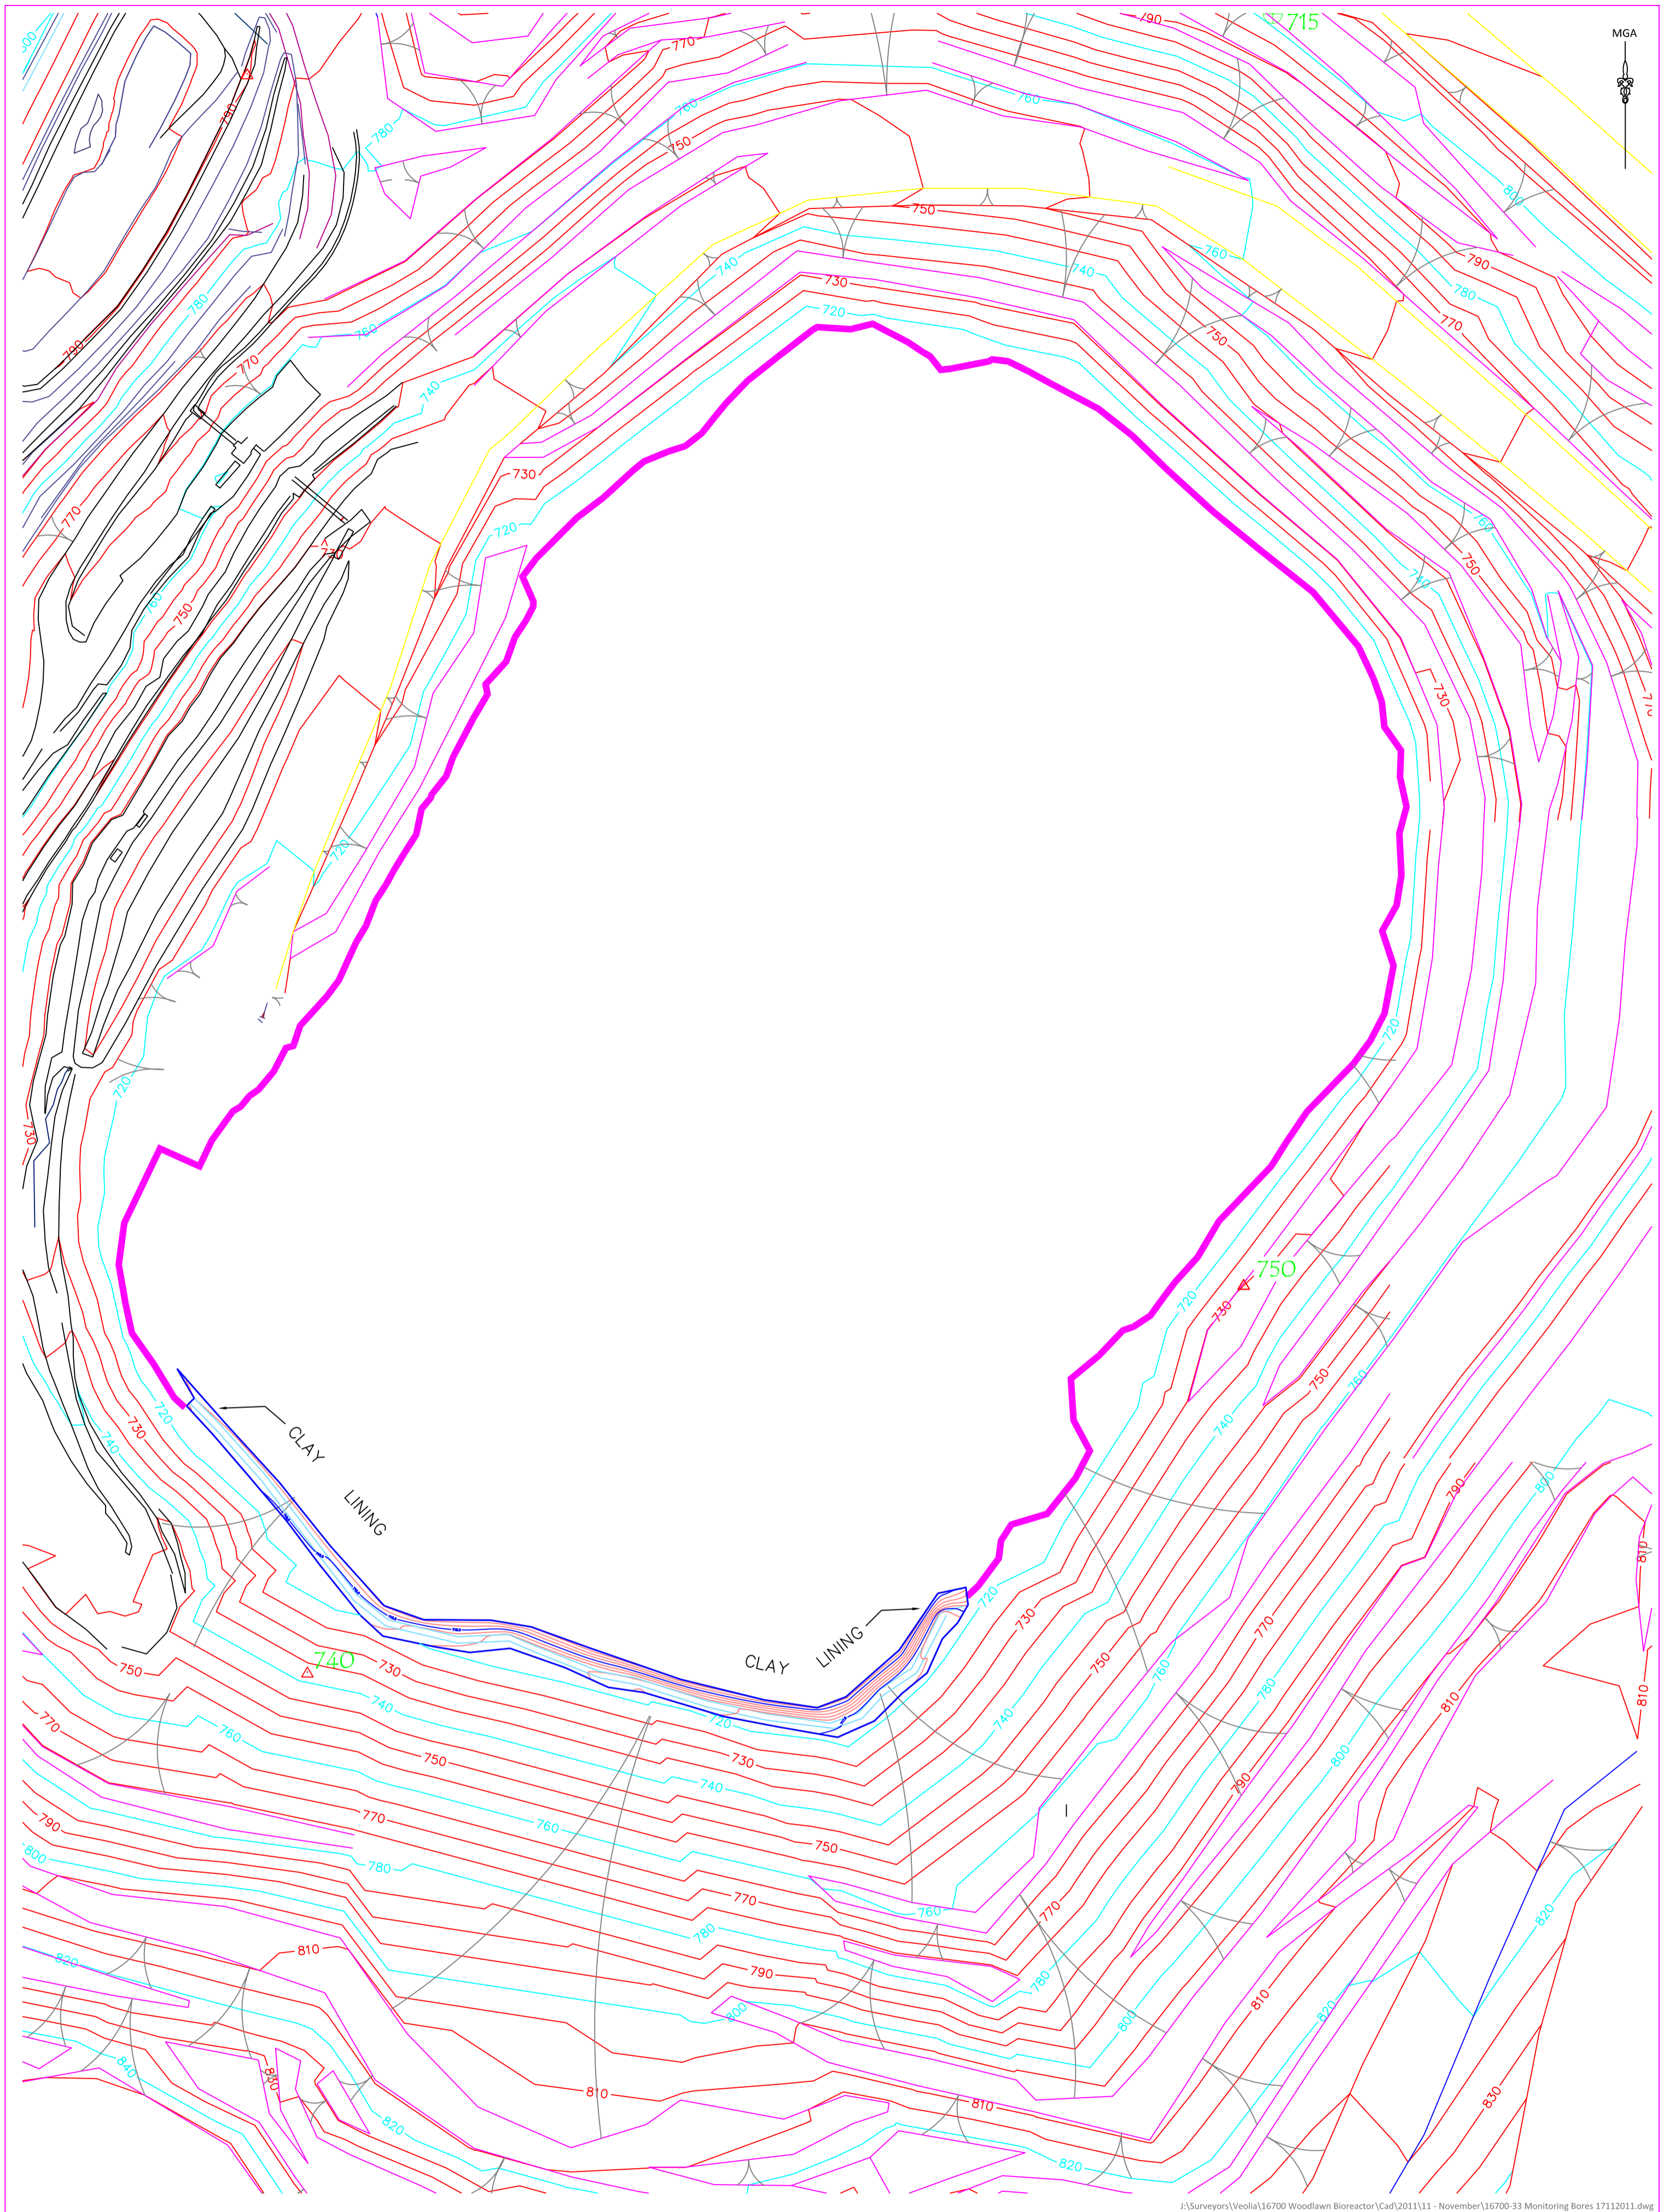

ISSUE	AMENDMENT	DATE
A	INITIAL ISSUE	03/11/2013

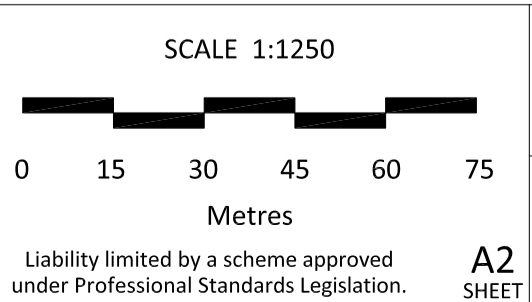

**VEOLIA**  
ENVIRONMENTAL SERVICES


**LandTeam**  
LandTeam Australia Pty Ltd  
Goulburn Office  
36 Montague Street  
Goulburn NSW 2580  
p: (02) 4821 1033  
f: (02) 4821 7238  
e: goulburn@landteam.com.au

VEOLIA ENVIRONMENTAL SERVICES

WOODLAWN BIOREACTOR  
CLAY LINING LOCATION  
OCTOBER 2013

DATUM: AHD    ORIGIN: PILLAR 713    CONTOUR INTERVAL: 20m

DATE: 03/11/2013	ISSUE
SURVEYED: S McD	<b>A</b>
DRAWN: S McD	
CHECKED: MK	
DRAWING No.	
<b>16700-93</b>	

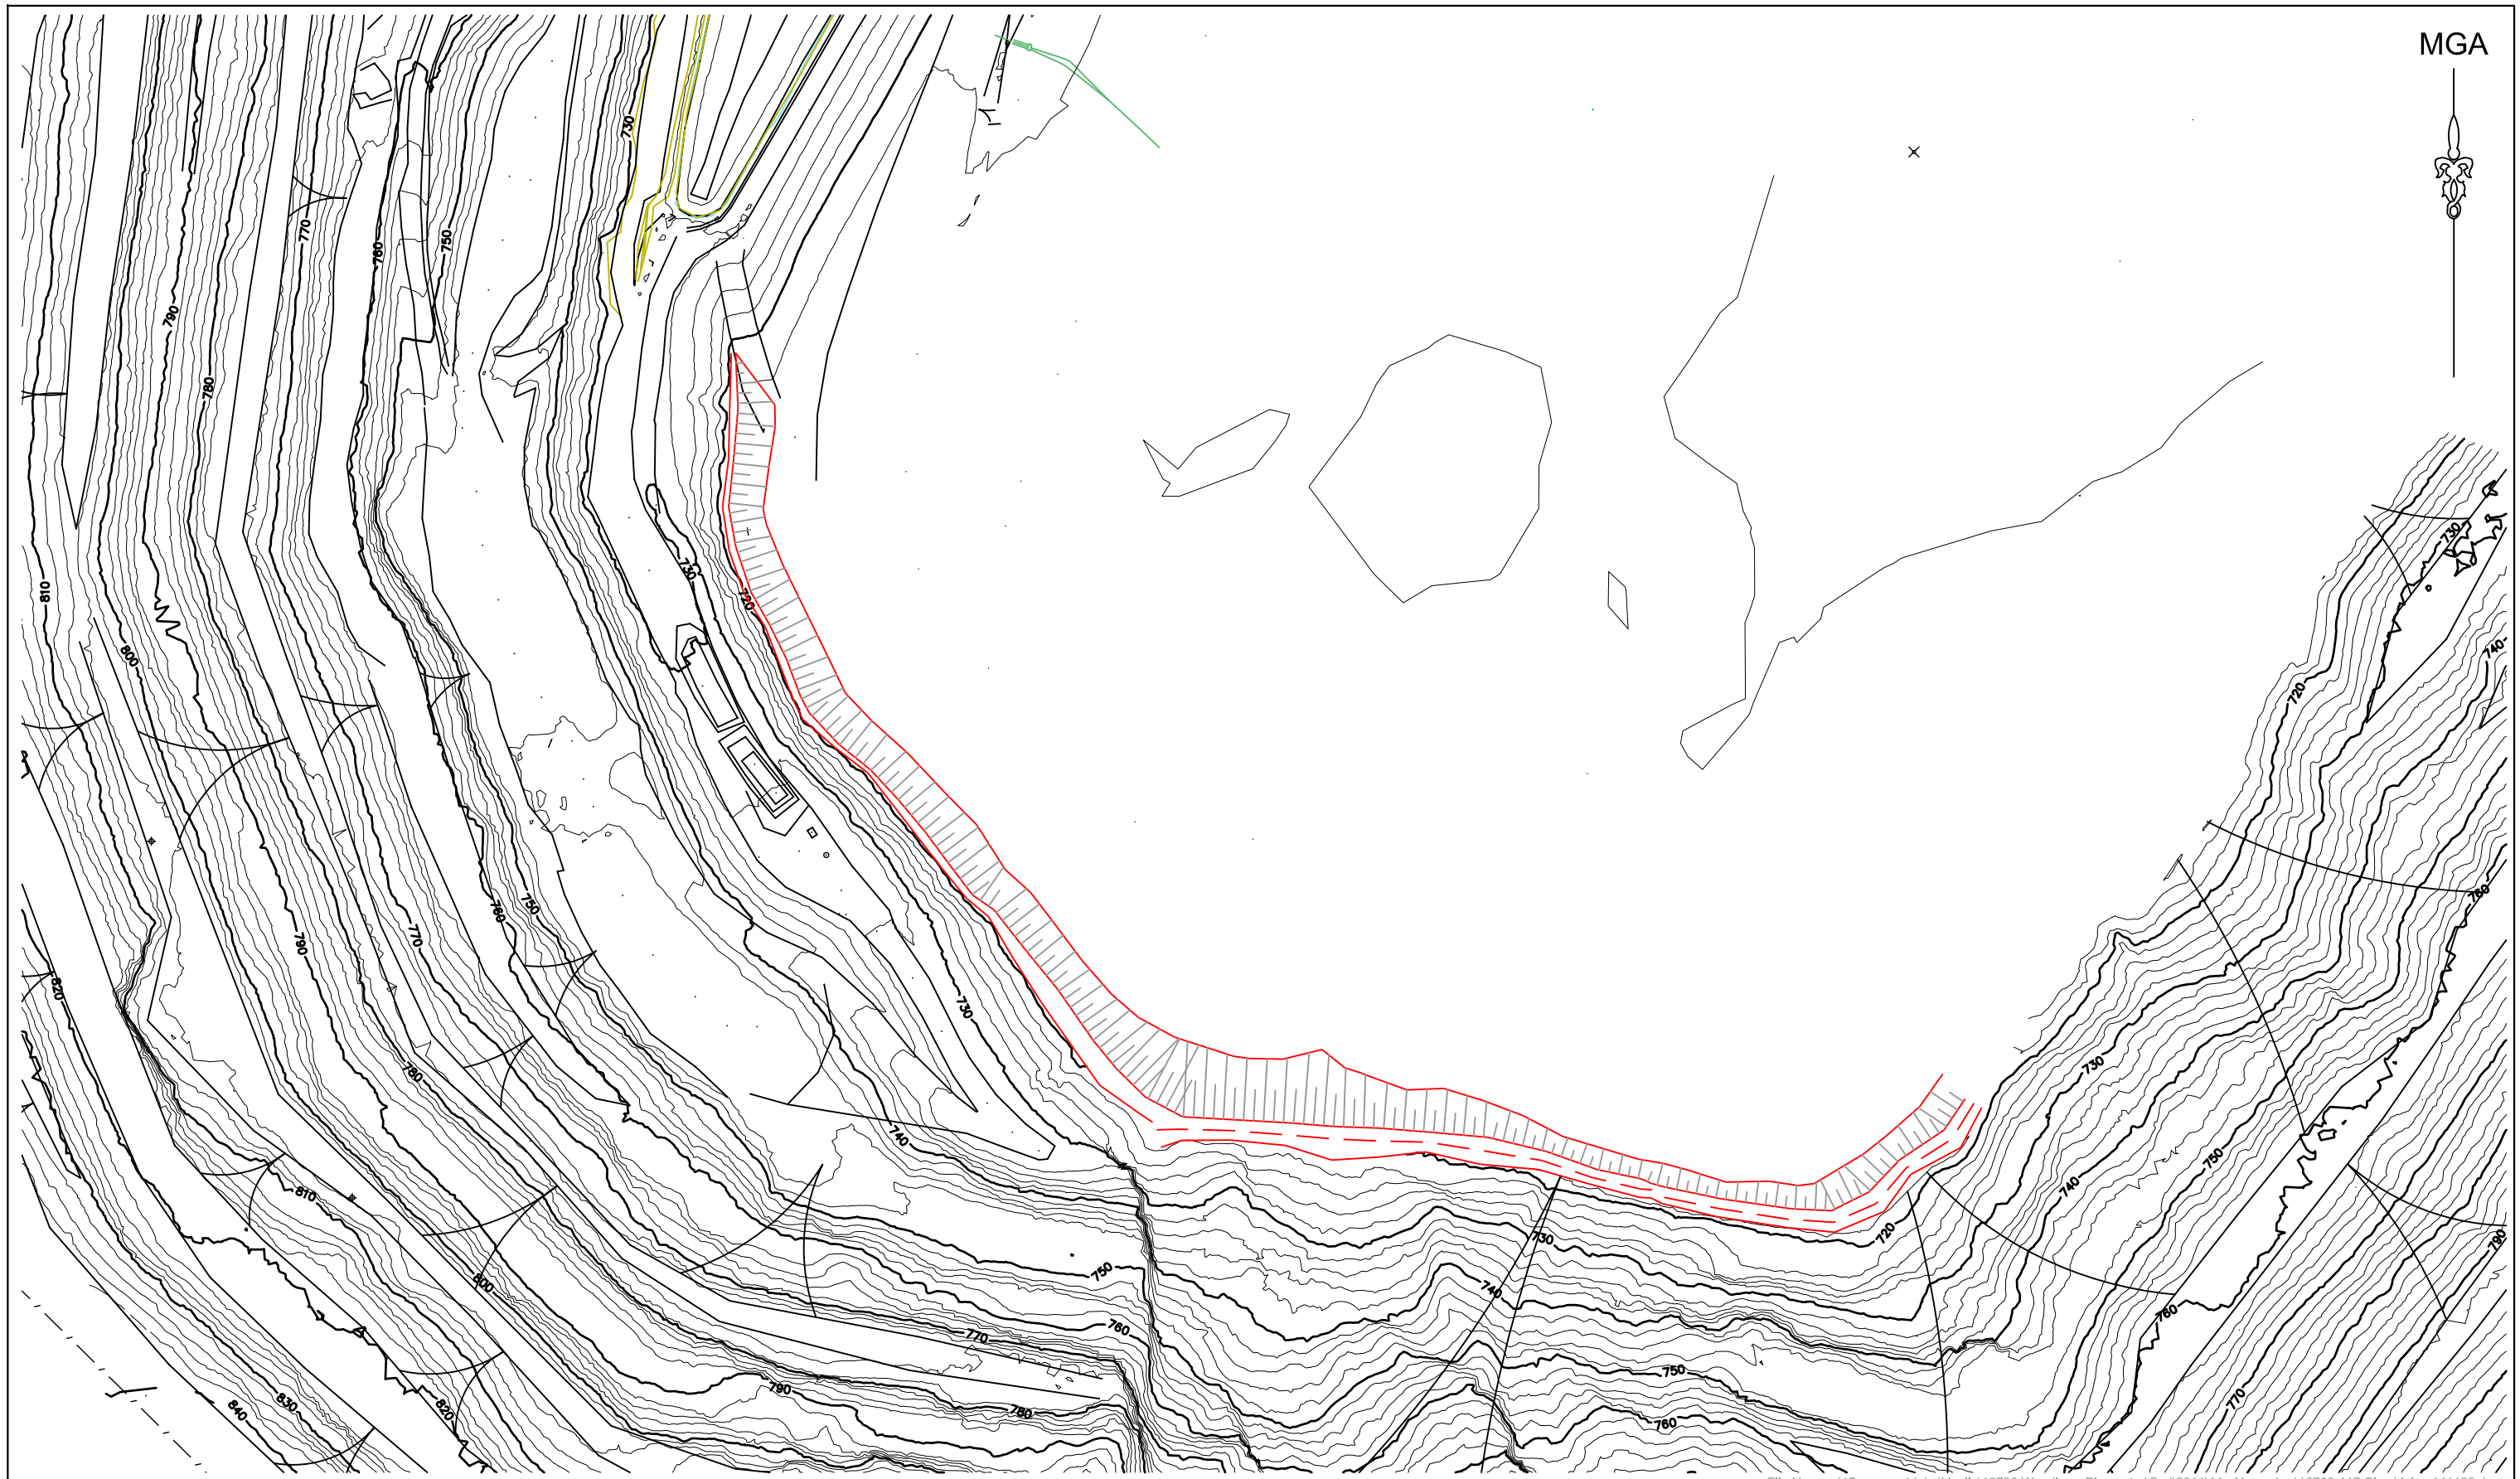

File Name: J:\Surveyors\Jobs\Veolia\16700 Woodlawn Bioreactor\Cad\2014\11 - November\16700-117 Clay Lining 141106.dwg

ISSUE	AMENDMENT	DATE
A	INITIAL ISSUE	12/11/2014

SCALE 1:1250

0 15 30 45 60 75  
Metres

Liability limited by a scheme approved under Professional Standards Legislation. **A3** SHEET


**VEOLIA**  
ENVIRONMENTAL SERVICES

LandTeam Australia Pty Ltd  
ABN 35 300 283 592  
Goulburn Office p: (02) 4821 1033  
36 Montague Street f: (02) 4821 7238  
Postal: PO Box 1040 e: goulburn@landteam.com.au  
GOULBURN NSW 2580 w: www.landteam.com.au

Bentley  
Integrated Management System

VEOLIA ENVIRONMENTAL SERVICES			
PLAN SHOWING LOCATION OF NEW CLAY LINER AT SOUTHERN SECTION OF VOID WOODLAWN BIOREACTOR COLLECTOR ROAD, TARAGO			
DATUM	N/A	CONTOUR INTERVAL	N/A

SURVEY DATE: 06/11/2014	
SURVEYED: MK	ISSUE
DRAWN: MK	<b>A</b>
CHECKED: JK	
DRAWING No.	
<b>16700-117</b>	

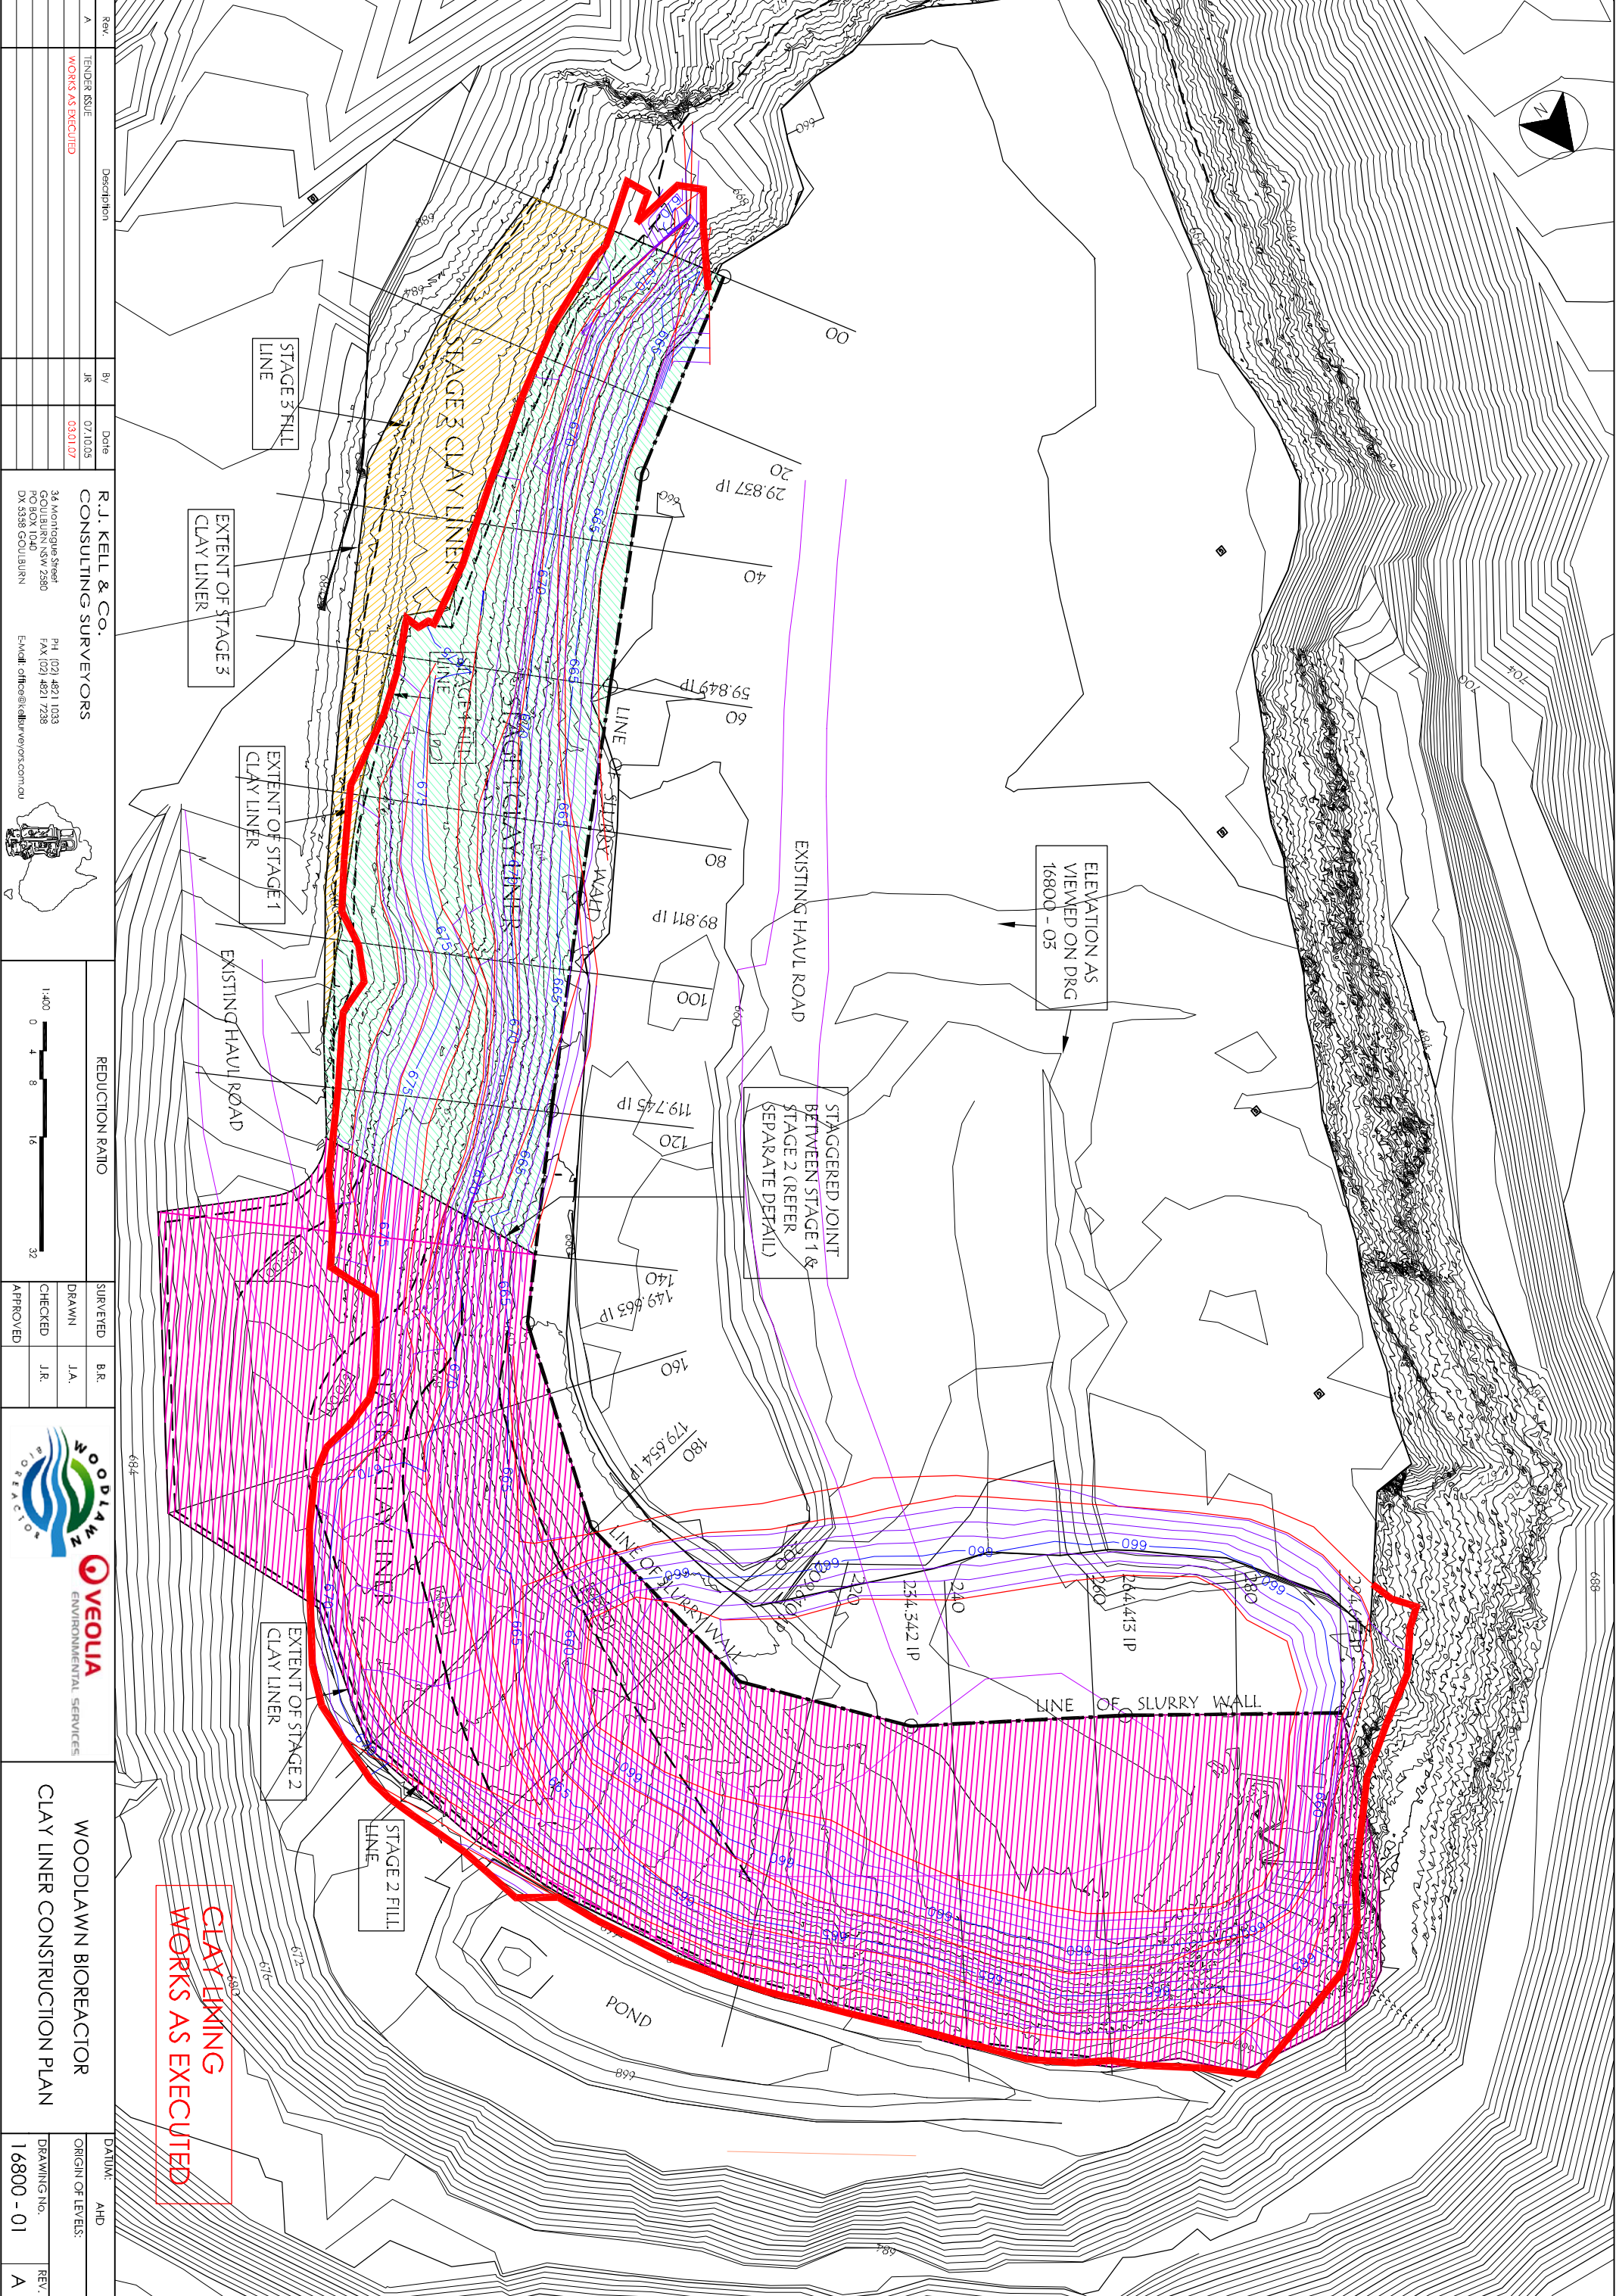

ELEVATION AS VIEWED ON DRG 16800 - 03

STAGGERED JOINT BETWEEN STAGE 1 & STAGE 2 (REFER SEPARATE DETAIL)

CLAY LINING WORKS AS EXECUTED

Rev.	Description	By	Date
A	TENDER ISSUE WORKS AS EXECUTED	JR	07/10/03 03/01/07

R. J. KELL & CO.  
CONSULTING SURVEYORS

34 Montague Street  
Goulburn NSW 2580  
PO BOX 104  
DN 5358 GOULBURN


Ph (02) 4821 1033  
Fax (02) 4821 7288  
E-mail: office@rkcsurveyors.com.au

REDUCTION RATIO	
1:400	0 4 8 16 32


SURVEYED	
DRAWN	J.A.
CHECKED	J.R.
APPROVED	

WOODLAWN BIOREACTOR CLAY LINER CONSTRUCTION PLAN	
DATUM:	AHD
ORIGIN OF LEVELS:	
DRAWING NO.	16800 - 01
REV.	A




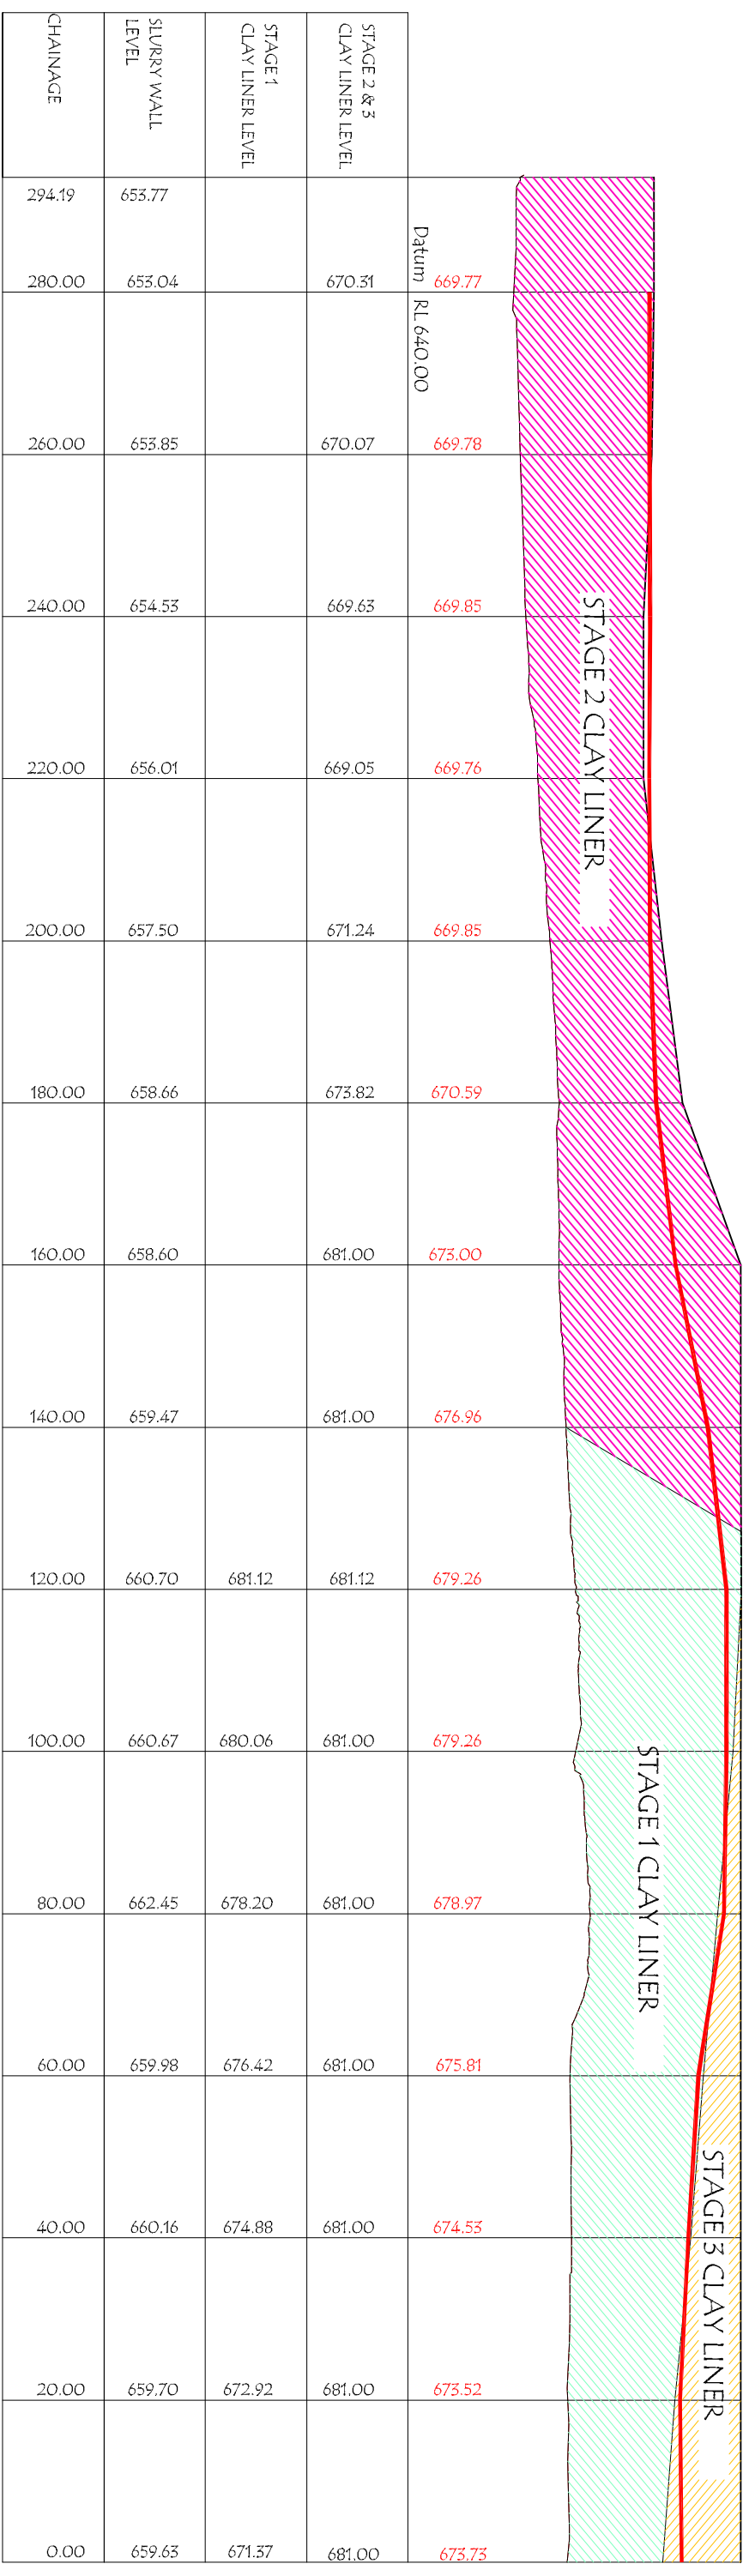

CLAY LINER ELEVATION

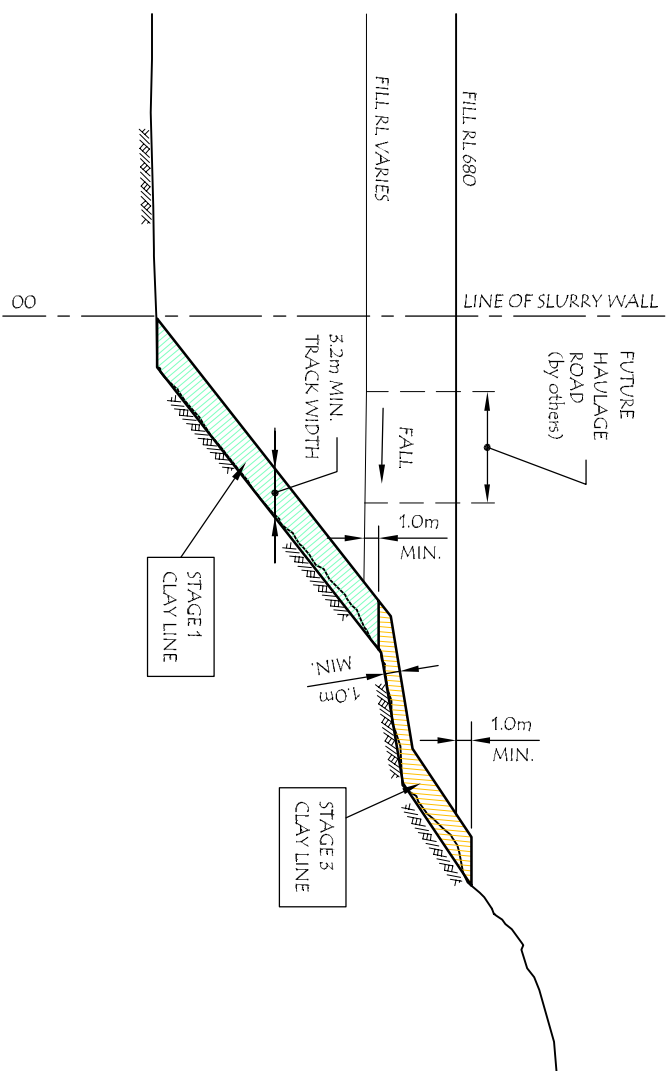

TYPICAL SECTION THROUGH STAGE 1 & 3 LINER

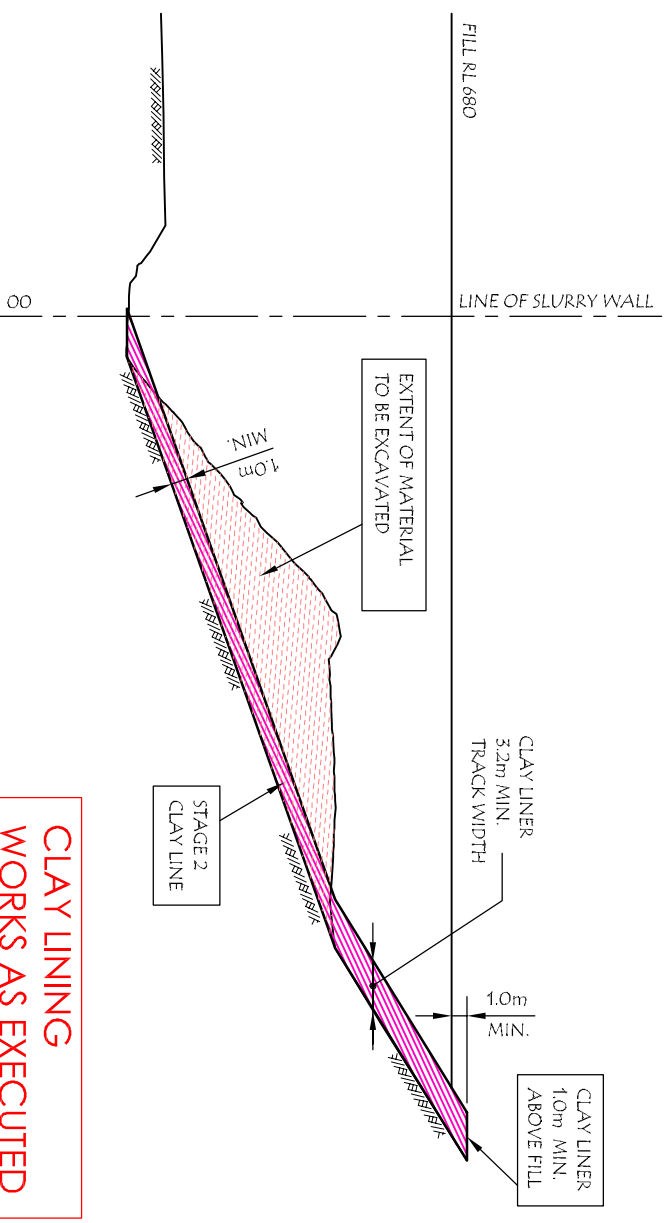

TYPICAL SECTION THROUGH STAGE 2 LINER

**CLAY LINING WORKS AS EXECUTED**

Rev.	Description	By	Date
A	TENDER ISSUE WORKS AS EXECUTED	JR	07/10/05 03/01/07


  

<b>R.J. KELL &amp; Co.</b> CONSULTING SURVEYORS 34 Montague Street GOULBURN NSW 2580 DX 5358 GOULBURN Ph: (02) 4821 1033 Fax: (02) 4821 7288 E-mail: <a href="mailto:offices@kellurveyors.com.au">offices@kellurveyors.com.au</a>			
--	--	--	--


  

REDUCTION RATIO 1:400 0 4 8 16 32 1:250 0 2.5 5 10 20	SURVEYED: J.A. DRAWN: J.A. CHECKED: JR APPROVED:	B.R. J.A. JR		WOODLAWN BIOREACTOR CLAY LINER ELEVATION AND TYPICAL CROSS SECTIONS	DATE: AHD ORIGIN OF LEVELS: DRAWING No. 16800 - 03 REV. A
---	---	--------------------	--	---	--




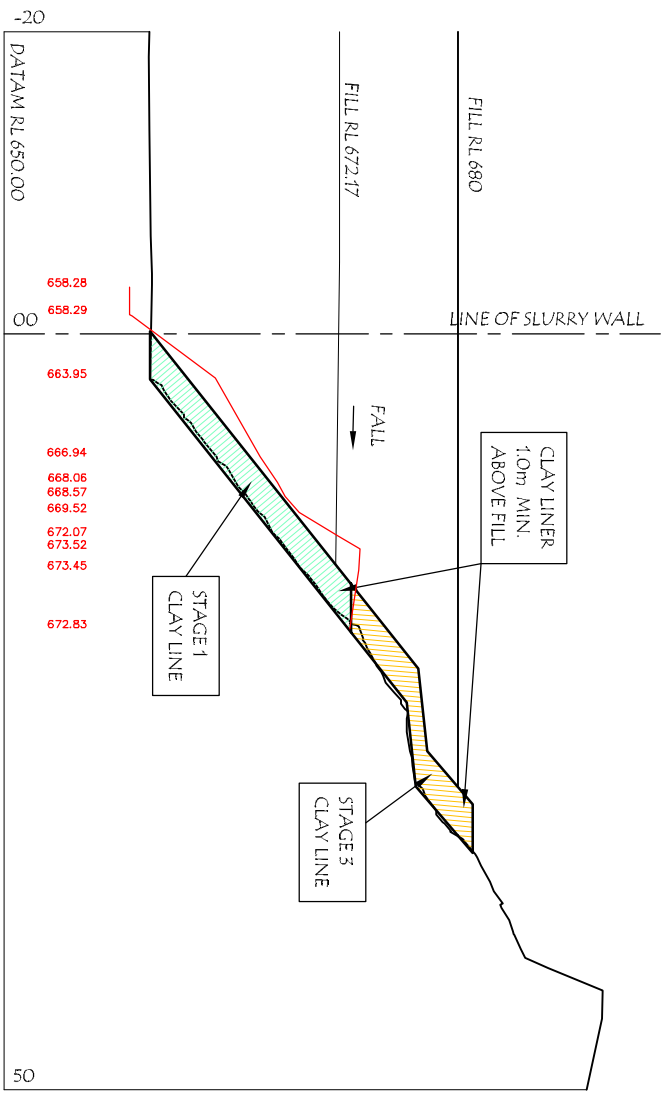


CH 20

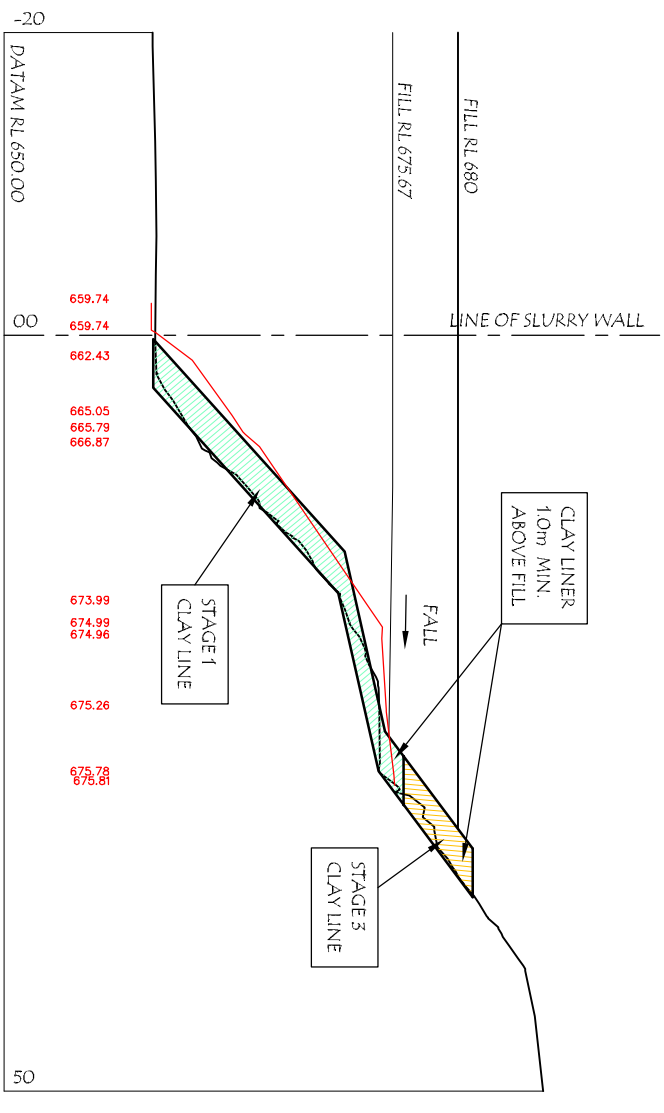

CH 60

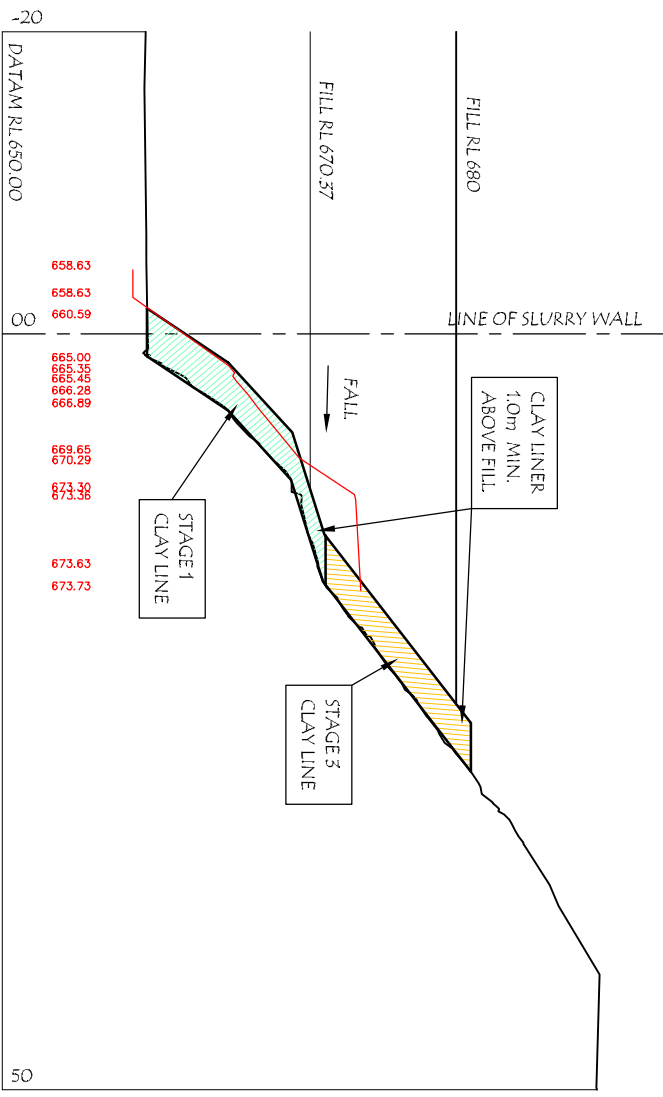

CH 00

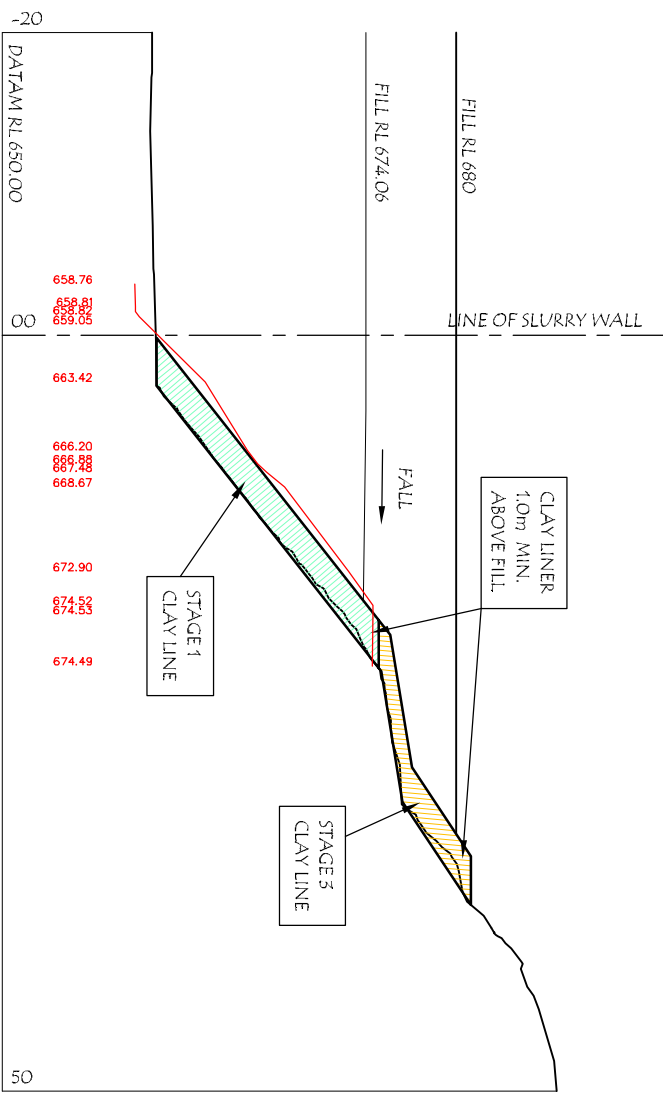

CH 40

CLAY LINING WORKS AS EXECUTED

Rev.	Description	By	Date
A	TENDER ISSUE	JR	07/10/05
	WORKS AS EXECUTED		03/01/07

REDUCTION RATIO

SURVEYED	B.R.
DRAWN	J.A.
CHECKED	J.R.
APPROVED	







WOODLAWN BIOREACTOR  
CLAY LINER CROSS SECTIONS  
SHEET 1 OF 4

DATUM:	AHD
ORIGIN OF LEVELS:	
DRAWING NO.:	16800 - 04
REV.:	A

R. J. KELL & CO.  
CONSULTING SURVEYORS

36 Montague Street  
Goulburn NSW 2580  
PO BOX 1040  
DX 5358 Goulburn


Ph (02) 4821 1033  
Fax (02) 4821 7288  
E-mail: office@rkcsurveyors.com.au

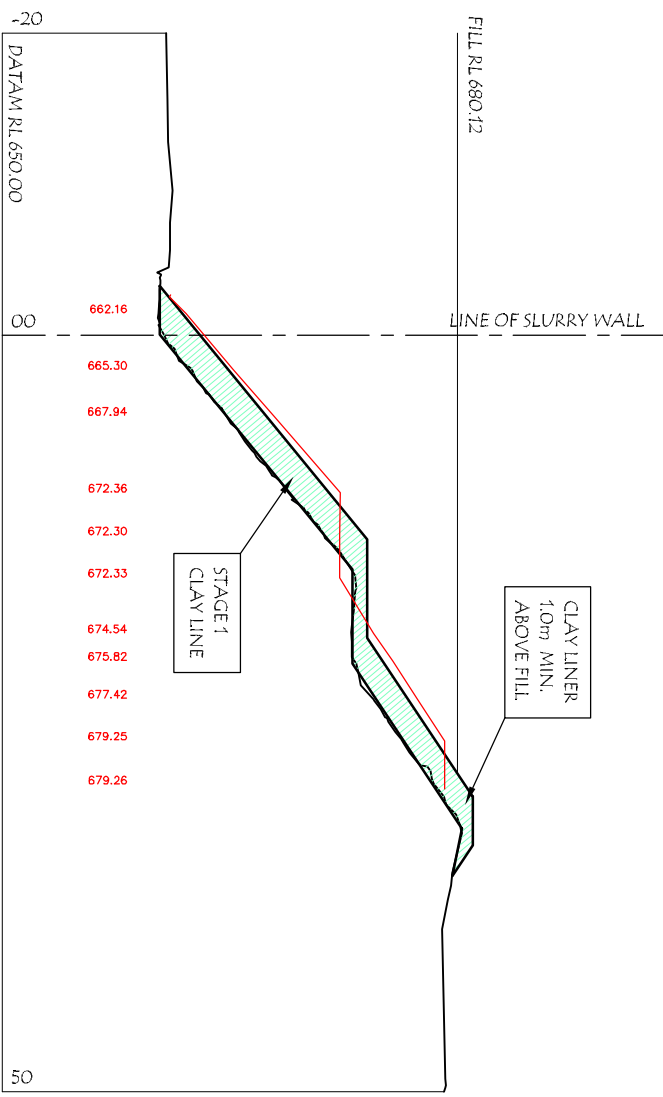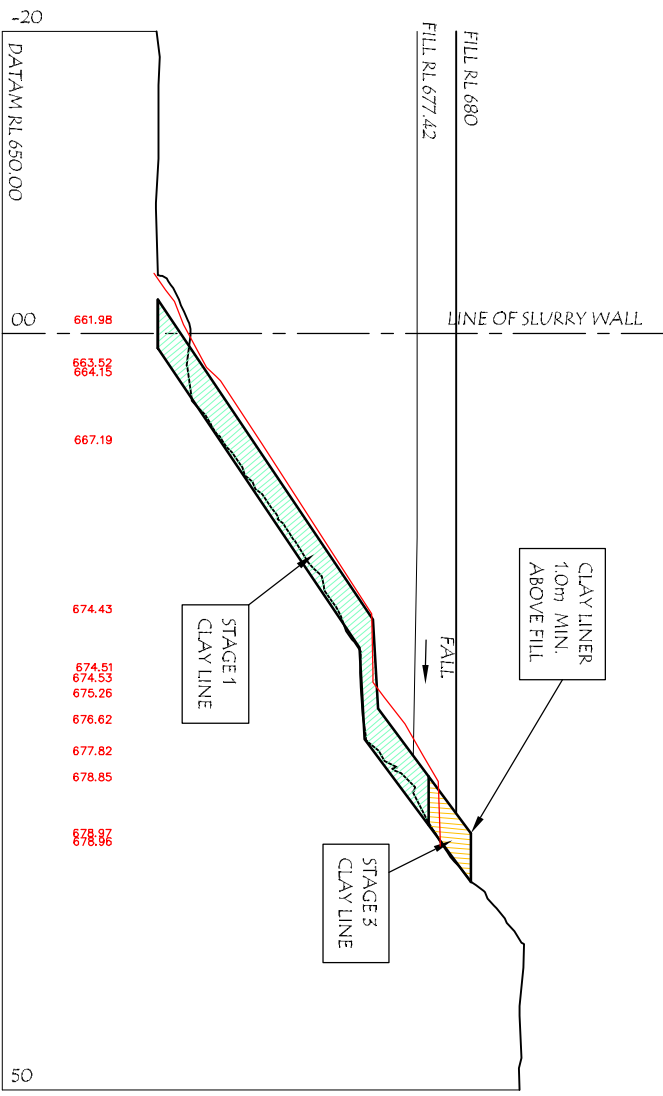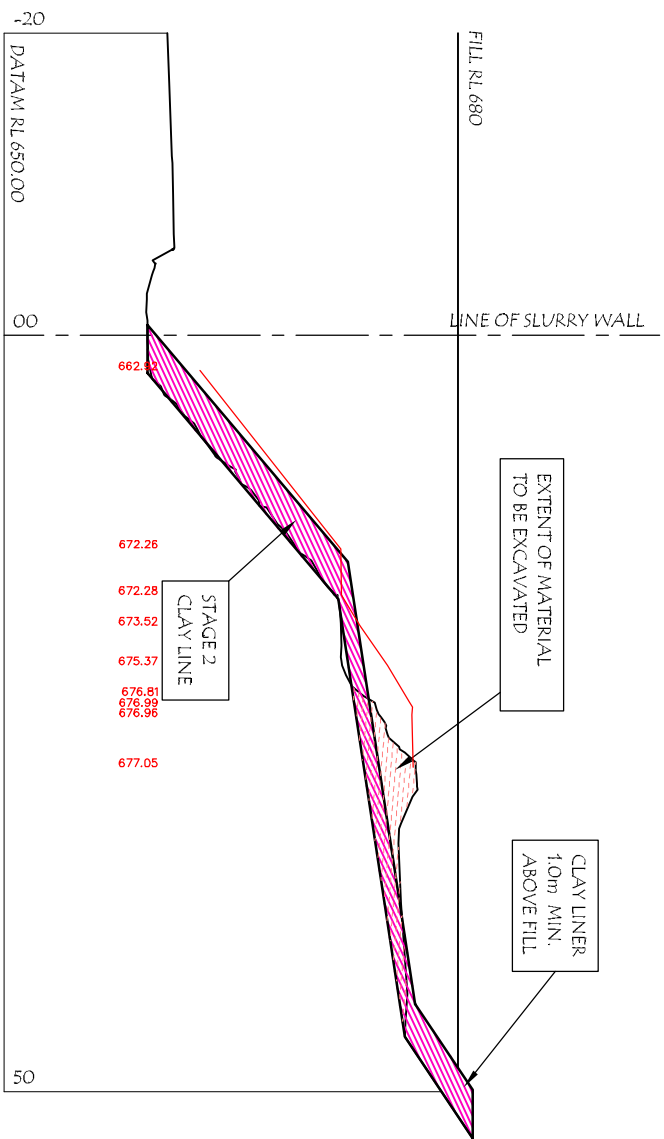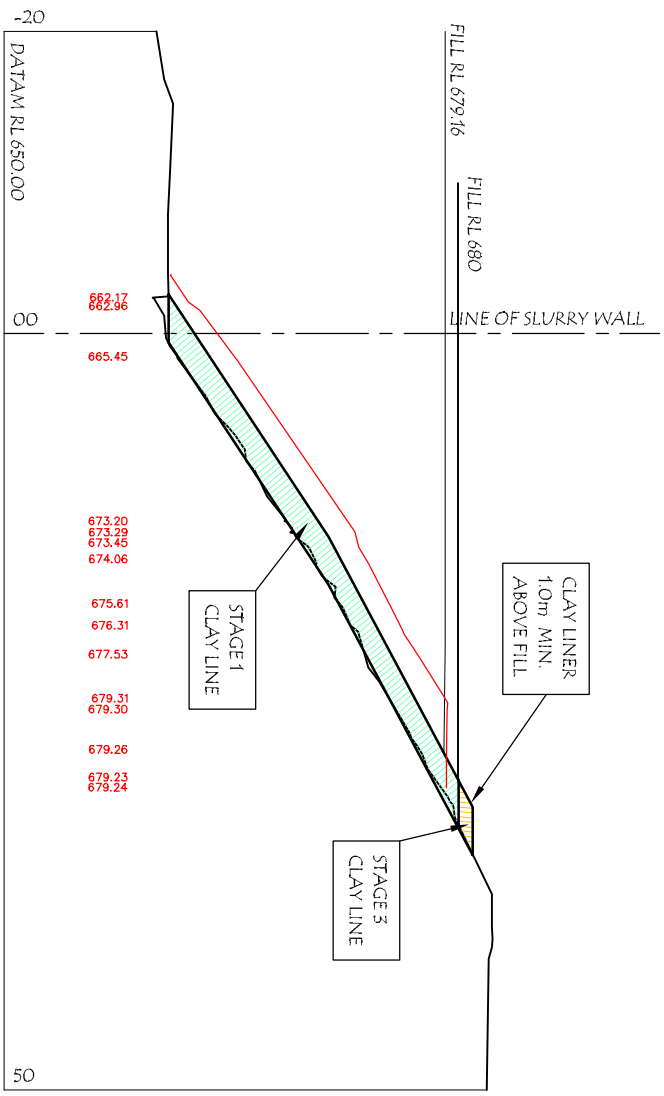

CLAY LINING WORKS AS EXECUTED

Rev.	Description	By	Date
A	TENDER ISSUE	JR	07/10/05
	WORKS AS EXECUTED	JR	03/01/07

**R. J. KELL & CO.**  
CONSULTING SURVEYORS  
36 Montague Street  
Goulburn NSW 2580  
PO BOX 1040  
DX 5338 Goulburn  
Ph (02) 4821 1033  
FAX (02) 4821 7288  
E-mail: office@rkcsurveyors.com.au




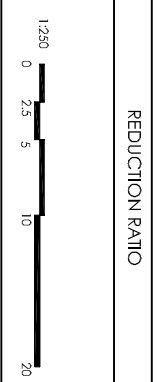


SURVEYED	B.R.
DRAWN	J.A.
CHECKED	J.R.
APPROVED	



WOODLAWN BIOREACTOR  
CLAY LINER CROSS SECTIONS  
SHEET 2 OF 4

DATUM:	AHD
ORIGIN OF LEVELS:	
DRAWING NO.:	16800 - 05
REV.:	A

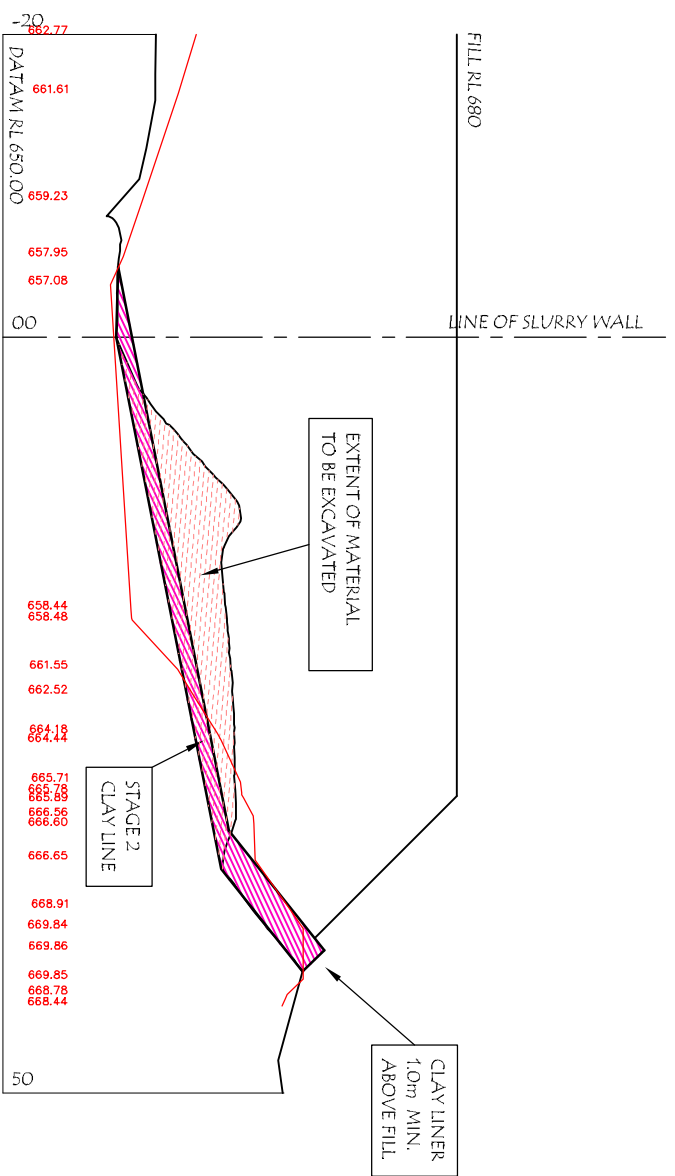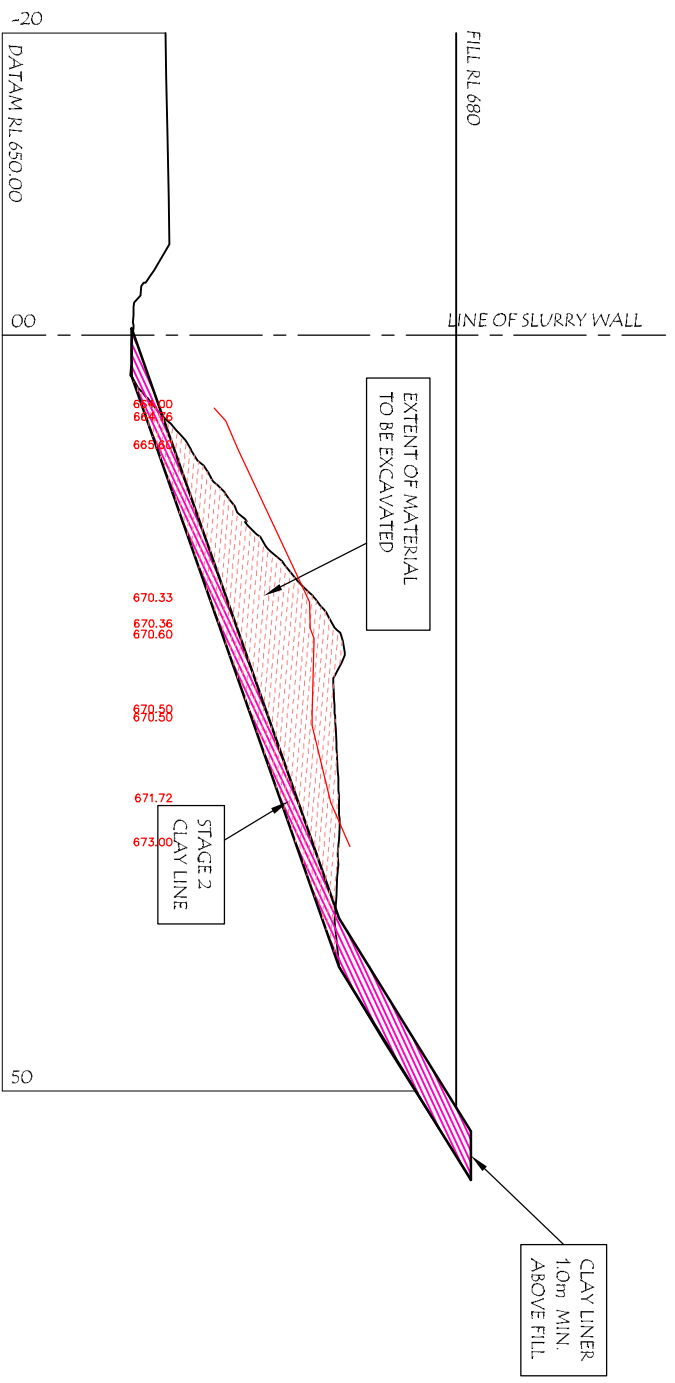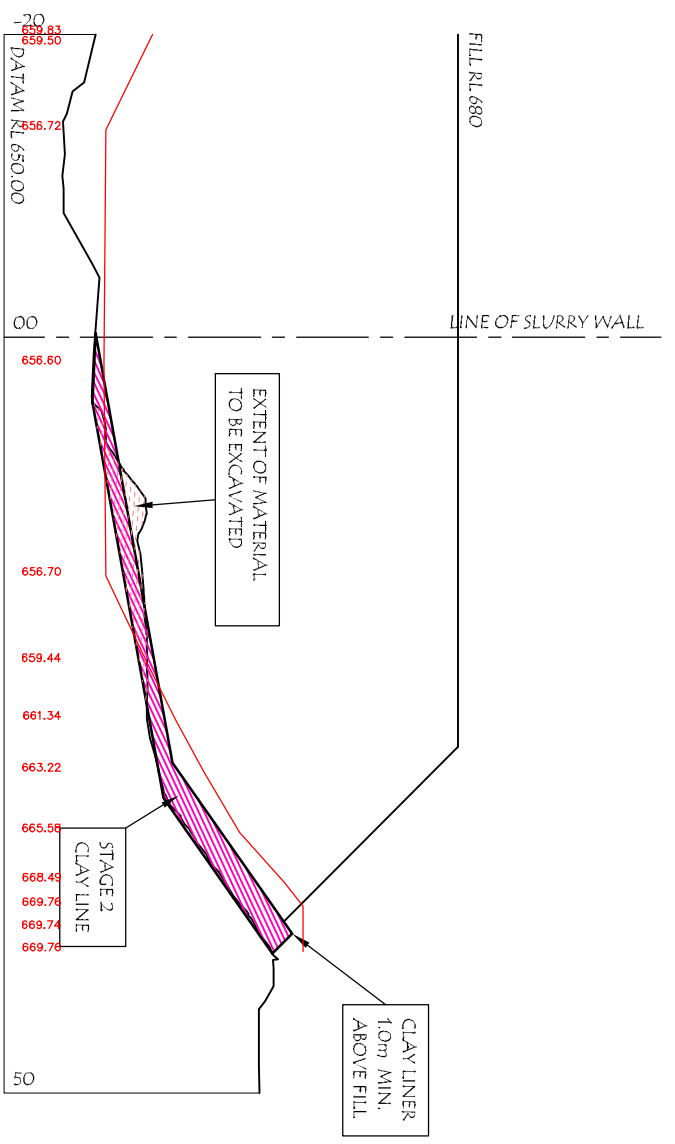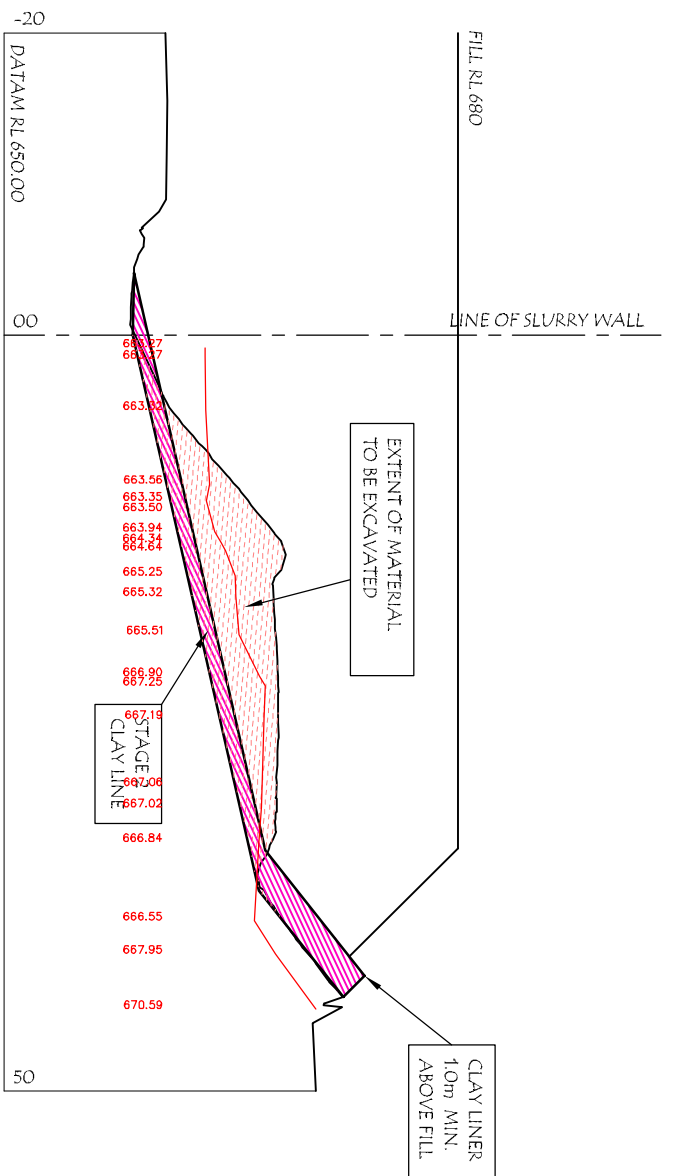


**CLAY LINING WORKS AS EXECUTED**

Rev.	Description	By	Date
A	TENDER ISSUE WORKS AS EXECUTED	JR	07/10/05 03/01/07

R. J. KELL & CO.  
CONSULTING SURVEYORS

36 Montague Street  
Goulburn NSW 2580  
PO BOX 1040  
DN 5338 GOULBURN

Ph (02) 4821 1033  
Fax (02) 4821 7238  
E-mail: office@rkcsurveyors.com.au

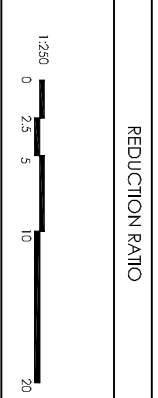


SURVEYED	B.R.
DRAWN	J.A.
CHECKED	J.R.
APPROVED	




WOODLAWN BIOREACTOR  
CLAY LINER CROSS SECTIONS  
SHEET 3 OF 4


DATUM:	AHD
ORIGIN OF LEVELS:	
DRAWING NO.	16800 - 06
REV.	A

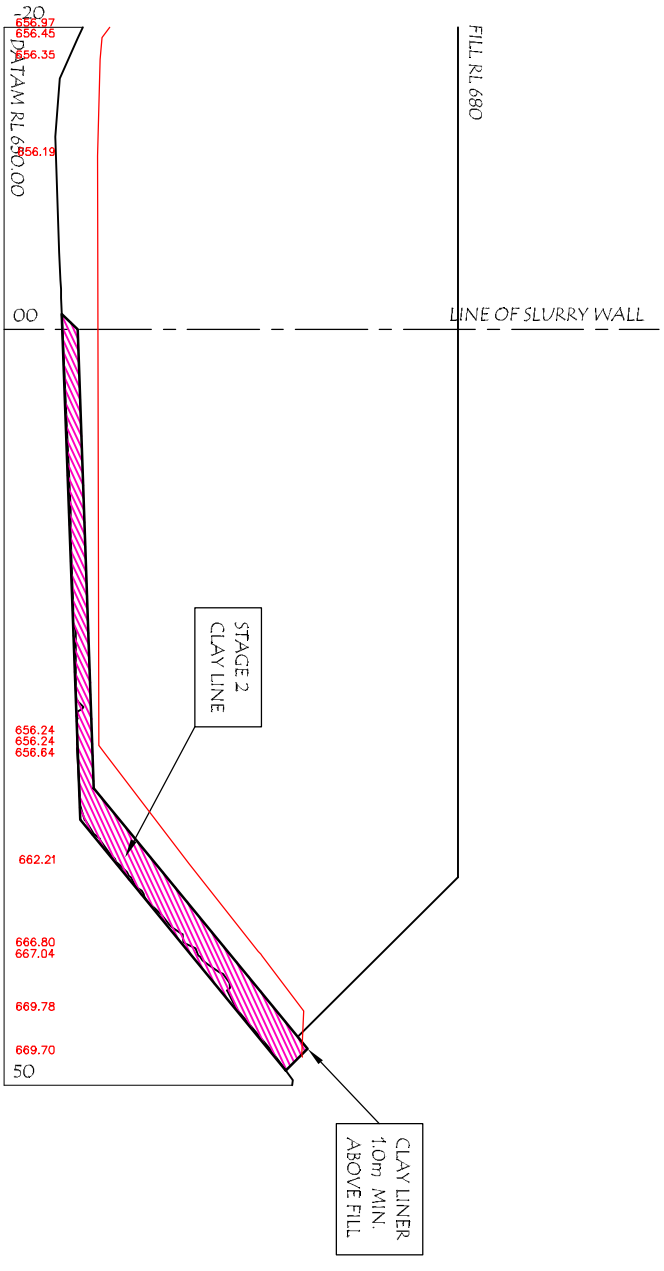

CH 260

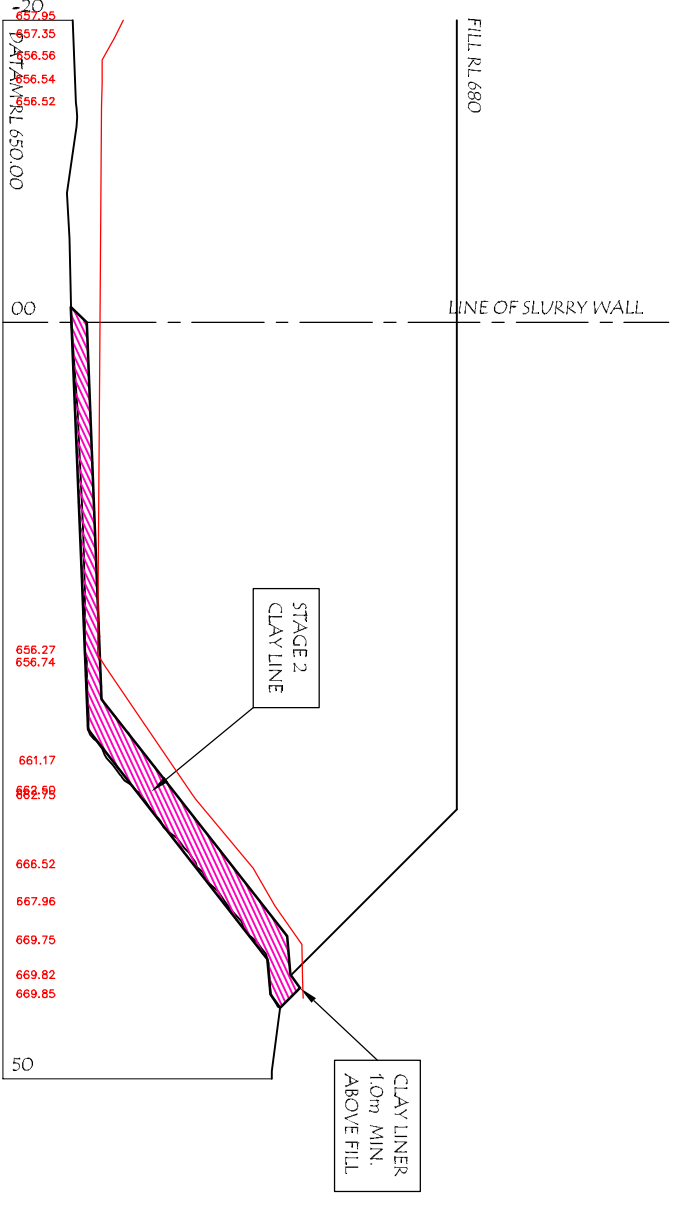

CH 240

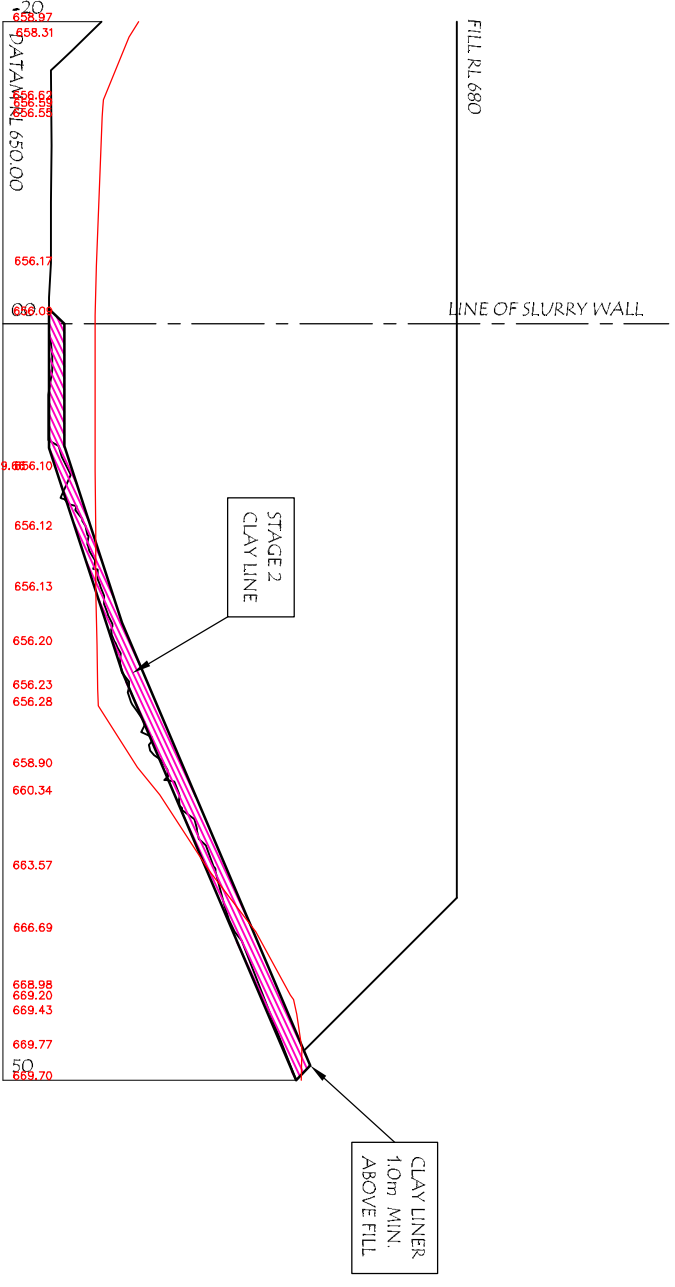

CH 280


CLAY LINING WORKS AS EXECUTED

Rev.	Description	By	Date
A	TENDER ISSUE	JR	07/10/05
	WORKS AS EXECUTED		03/01/07

**R. J. KELL & CO.**  
CONSULTING SURVEYORS

36 Montague Street  
Goulburn NSW 2580  
PO BOX 1040  
DX 5338 Goulburn

Ph (02) 4821 1033  
Fax (02) 4821 7288  
E-mail: office@rkcsurveyors.com.au

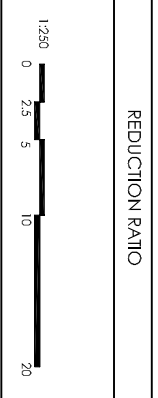

SURVEYED	B.R.
DRAWN	J.A.
CHECKED	J.R.
APPROVED	



WOODLAWN BIOREACTOR  
CLAY LINER CROSS SECTIONS  
SHEET 4 OF 4

DATUM:	AHD
ORIGIN OF LEVELS:	
DRAWING NO.	16800 - 07
REV.	A



LEGEND	
+	FLOOR LEVEL OBSERVATIONS
- - -	BREAKLINES (MISCELLANEOUS)
- - -	FACE OF FORMWORK STRUCTURE
- - -	FACE OF SHOTCRETE WALL
- - -	EXCAVATED KEY IN ROCK FLOOR
- - -	EXTENT OF SHOTCRETE WALL
- - -	EXTENT OF WASTEROCK FILL
- - -	EXTENT OF DOLERITE FILL
- - -	EXISTING BRICK WALL

**GOLDBURN**  
Incorporating Keils Land Surveyors



36 Montague Street  
Postal: PO Box 1040  
GOLDBURN NSW 2580  
p: (02) 4821 1033  
f: (02) 4821 7238  
e: goldburn@landteam.com.au



ENVIRONMENTAL SERVICES

SCALE 1:150



DRAWN BY: M KADZIELA

DATUM: MGA & AHD

ORIGIN OF LEVELS: PILLAR 740

CONTOUR INTERVAL: N/A

NOTE : DIMENSIONS AND AREAS  
ARE SUBJECT TO SURVEY

**NORTHERN PORTAL PROJECT**

PLAN VIEW  
OF NORTHERN PORTAL FILLING COMPONENTS  
WOODLAWN BIOREACTOR  
COLLECTOR ROAD, TARAGO  
PARISH OF WERRIWA  
COUNTY OF MURRAY

Sheet No. 1


No. of Sheets: 4

Date: 3/06/2009

Ref. No.: 16700

Dwg No. NP01 Rev. A

LEVELS OF EXISTING ROOF STRUCTURE

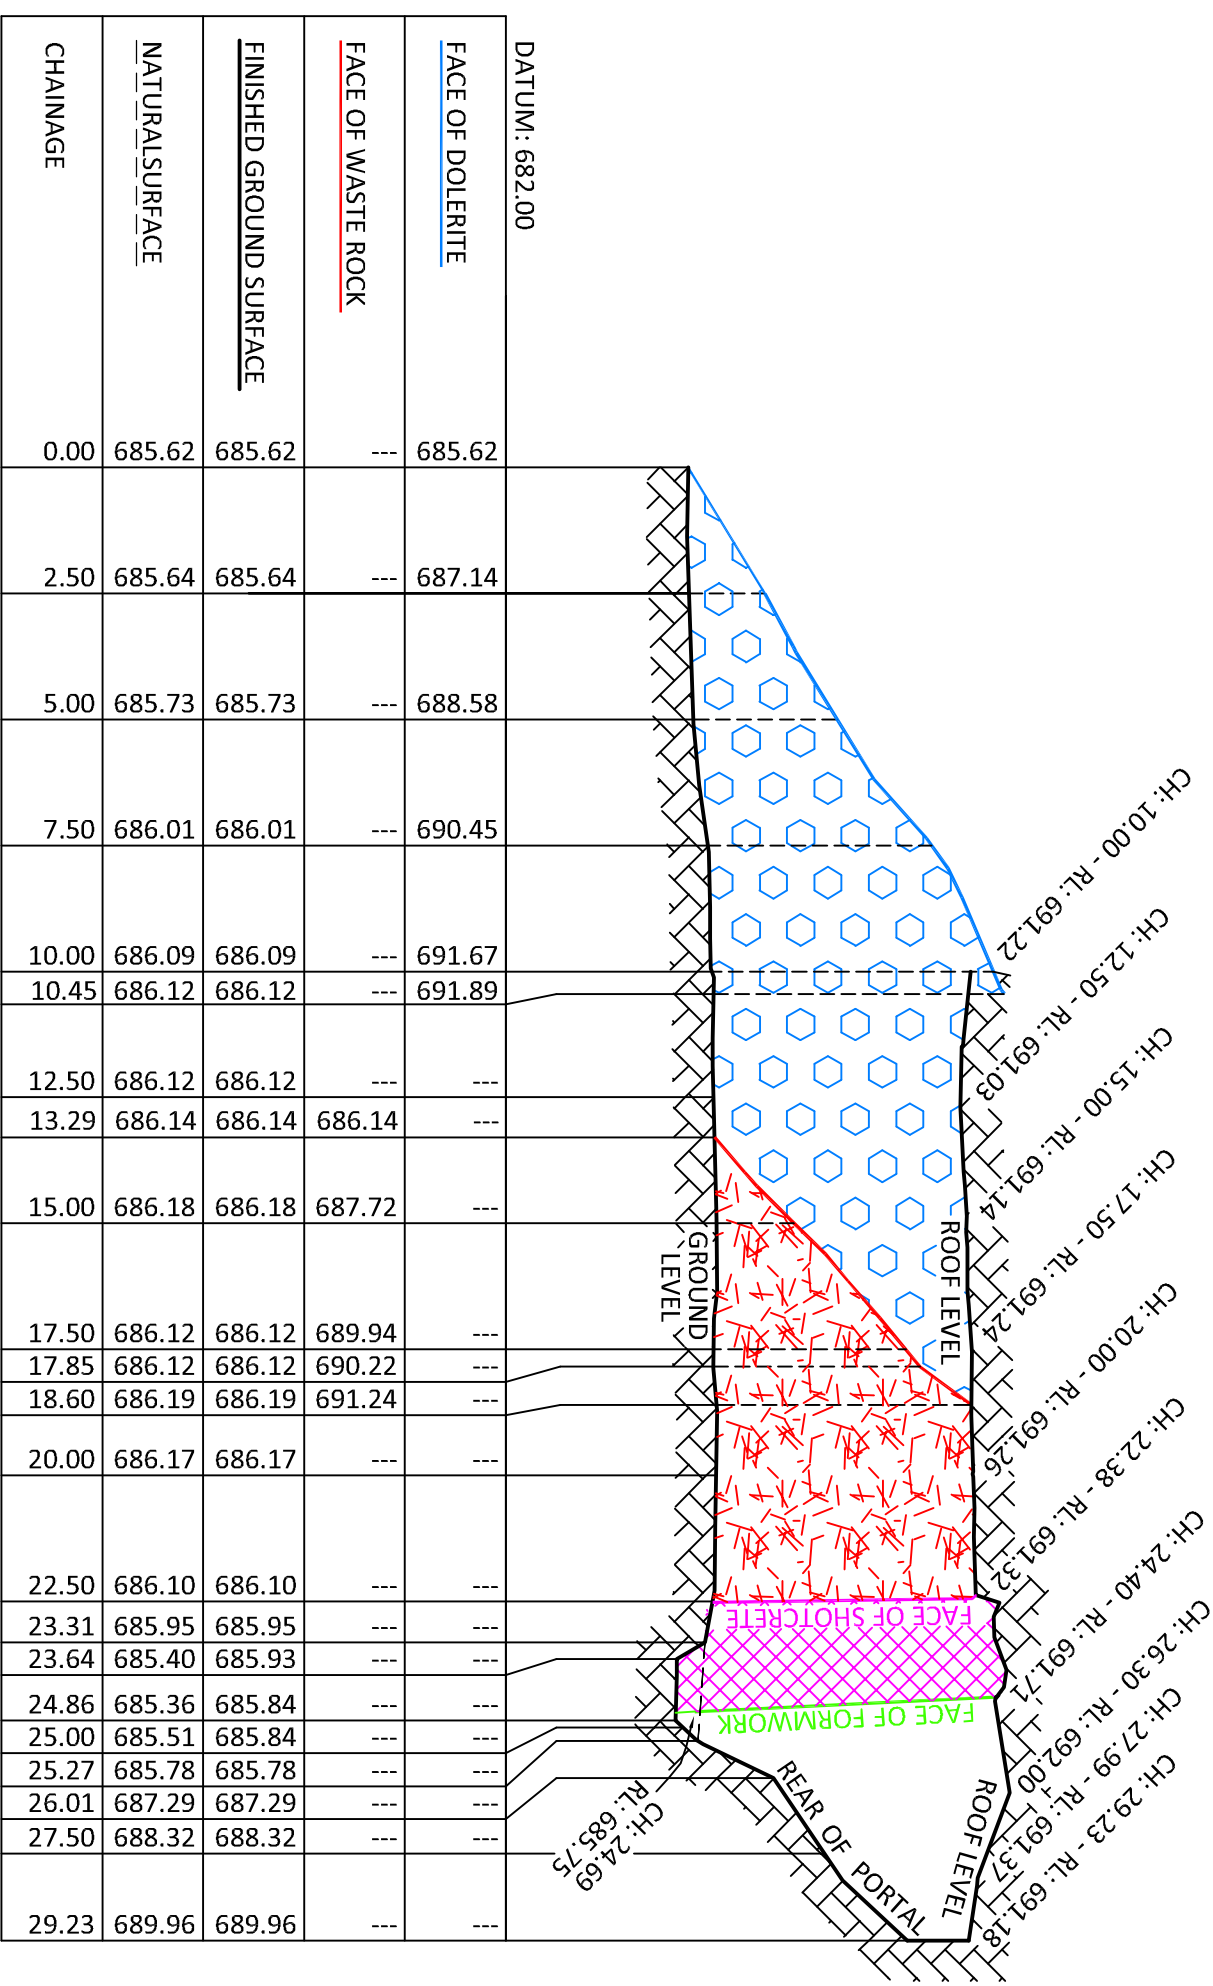

CHAINAGE	NATURALSURFACE	FINISHED GROUND SURFACE	FACE OF WASTE ROCK	FACE OF DOLERITE	DATUM: 682.00
0.00	685.62	685.62	---	685.62	
2.50	685.64	685.64	---	687.14	
5.00	685.73	685.73	---	688.58	
7.50	686.01	686.01	---	690.45	
10.00	686.09	686.09	---	691.67	
10.45	686.12	686.12	---	691.89	
12.50	686.12	686.12	---	---	
13.29	686.14	686.14	686.14	---	
15.00	686.18	686.18	687.72	---	
17.50	686.12	686.12	689.94	---	
17.85	686.12	686.12	690.22	---	
18.60	686.19	686.19	691.24	---	
20.00	686.17	686.17	---	---	
22.50	686.10	686.10	---	---	
23.31	685.95	685.95	---	---	
23.64	685.40	685.93	---	---	
24.86	685.36	685.84	---	---	
25.00	685.51	685.84	---	---	
25.27	685.78	685.78	---	---	
26.01	687.29	687.29	---	---	
27.50	688.32	688.32	---	---	
29.23	689.96	689.96	---	---	

LEGEND	
	SHOTCRETE WALL
	WASTEROCK FILL
	DOLERITE FILL

**GOLDBURN**  
Incorporating Keils Land Surveyors  
36 Montague Street  
Postal: PO Box 1040  
GOLDBURN NSW 2580  
e: goldburn@landteam.com.au



p: (02) 4821 1033  
f: (02) 4821 7238



SCALE 1:150



DRAWN BY: M KADZIELA

DATUM: AHD  
ORIGIN OF LEVELS: PILLAR 740  
CONTOUR INTERVAL: N/A  
NOTE : DIMENSIONS AND AREAS ARE SUBJECT TO SURVEY







**NORTHERN PORTAL PROJECT**

LONGITUDINAL SECTION  
OF NORTHERN PORTAL FILLING COMPONENTS  
WOODLAWN BIOREACTOR  
COLLECTOR ROAD, TARAGO  
PARISH OF WERRIWA  
COUNTY OF MURRAY

Sheet No. 2

No. of Sheets: 4  
Date: 3/06/2009  
Ref. No.: 16700  
Dwg No. NP02  
Rev. A

	SHOTCRETE WALL
	WASTEROCK FILL
	DOLERITE FILL

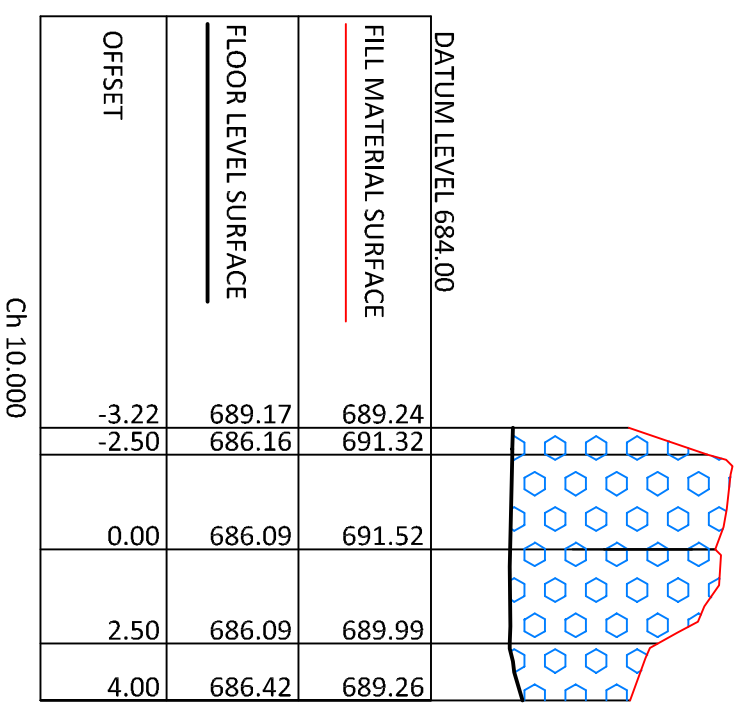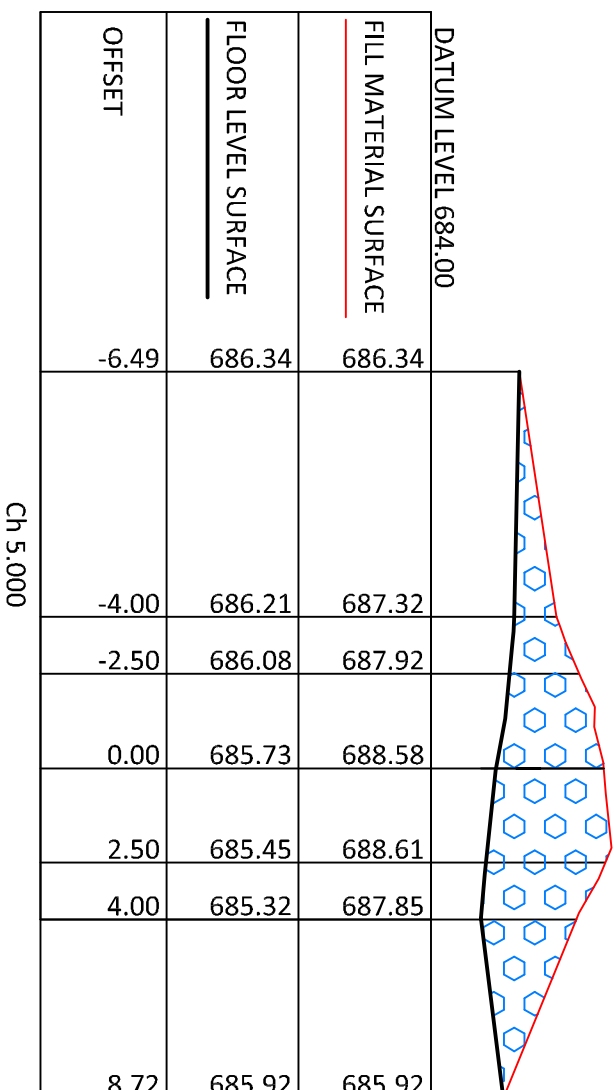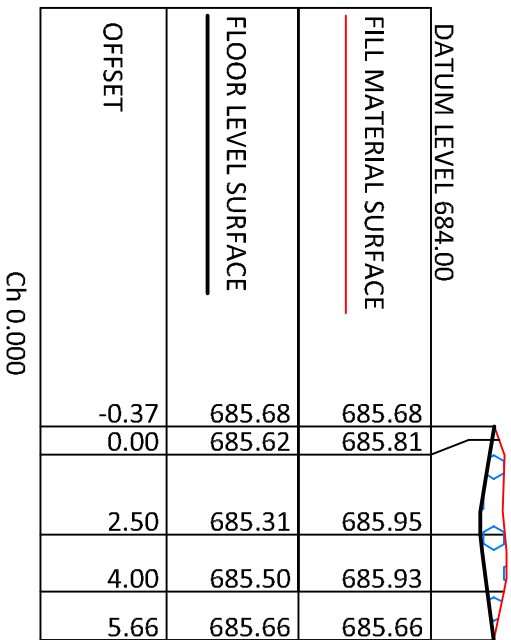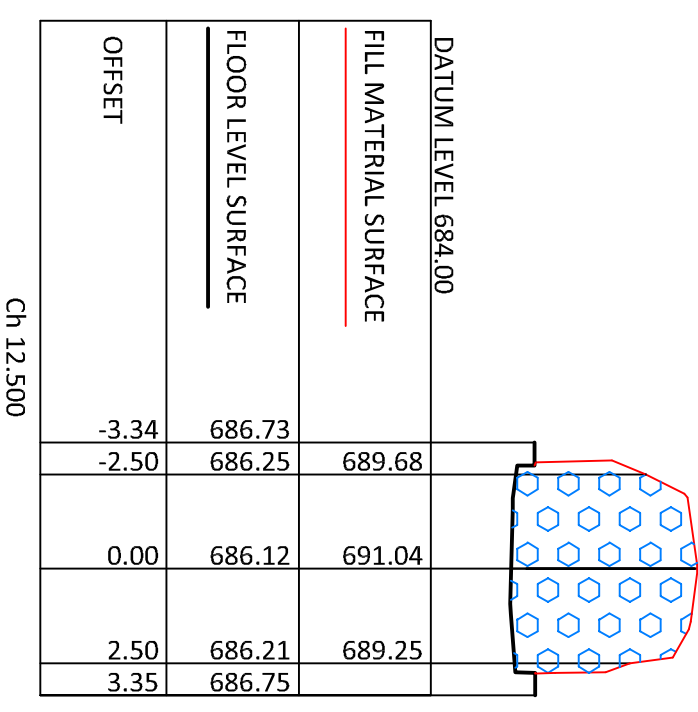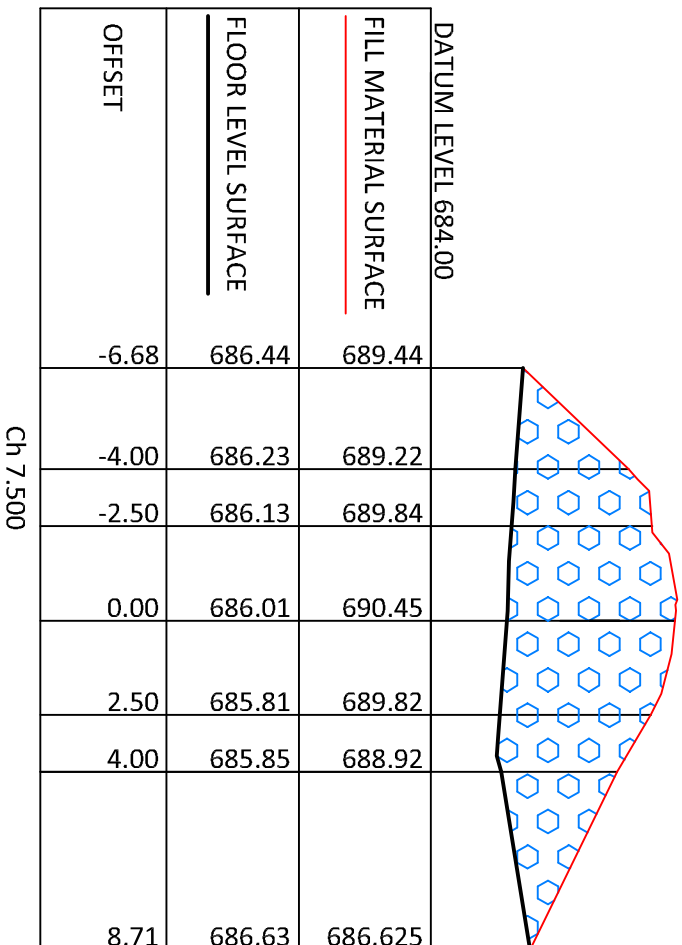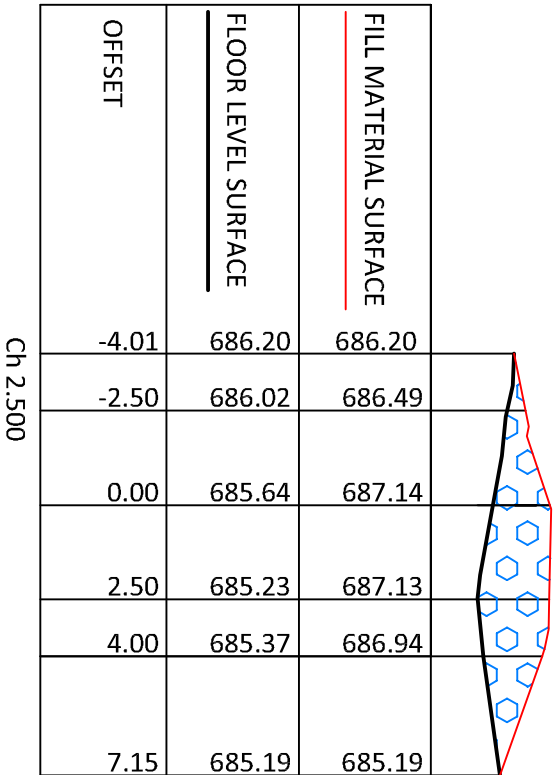


**GOLDBURN**  
*Incorporating Keils Land Surveyors*  
 36 Montague Street  
 Postal: PO Box 1040  
 GOLDBURN NSW 2580  
 e: goldburn@landteam.com.au

p: (02) 4821 1033  
 f: (02) 4821 7238



SCALE 1:200

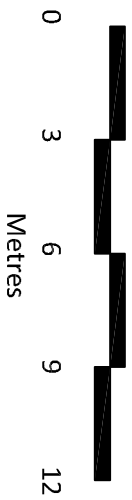

DRAWN BY: M KADZIELA


DATUM: AHD  
 ORIGIN OF LEVELS: PILLAR 740  
 CONTOUR INTERVAL: N/A  
 NOTE : DIMENSIONS AND AREAS  
 ARE SUBJECT TO SURVEY

**NORTHERN PORTAL PROJECT**


CROSS SECTIONS: CH 0.00 TO CH 12.50  
 OF NORTHERN PORTAL FILLING COMPONENTS  
 WOODLAWN BIOREACTOR  
 COLLECTOR ROAD, TARAGO  
 PARISH OF WERRIWA  
 COUNTY OF MURRAY

Sheet No. 3


No. of Sheets: 4  
 Date: 3/06/2009  
 Ref. No.: 16700  
 Dwg No. NP03  
 Rev. A

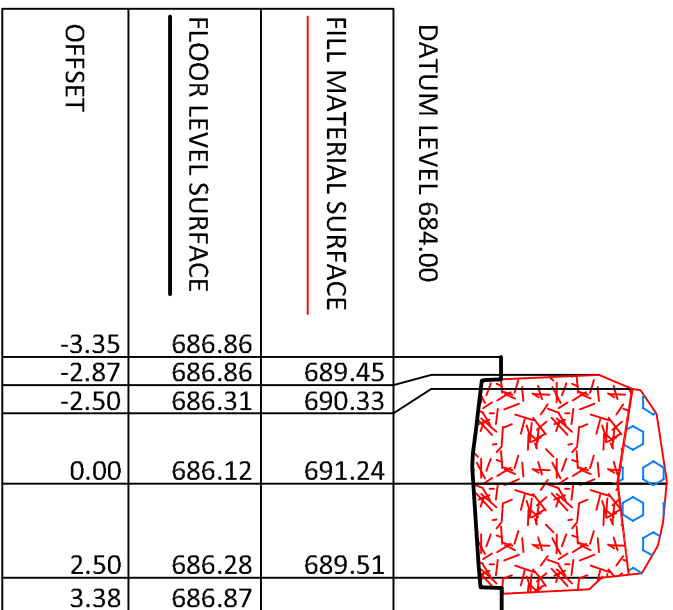

Ch 17.500

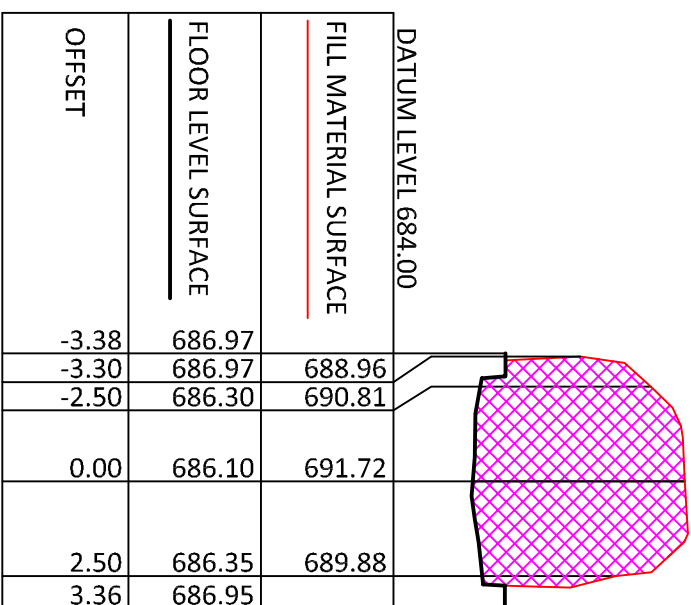


Ch 22.500

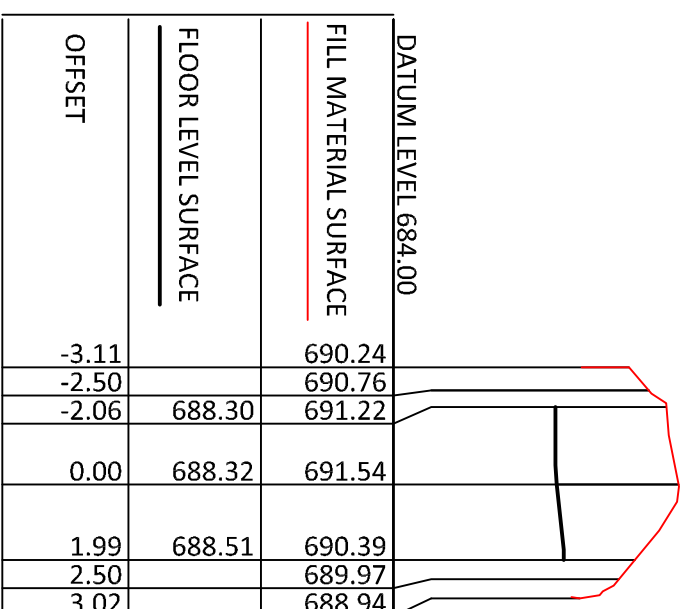


Ch 27.500


LEGEND	
	SHOTCRETE WALL
	WASTEROCK FILL
	DOLERITE FILL

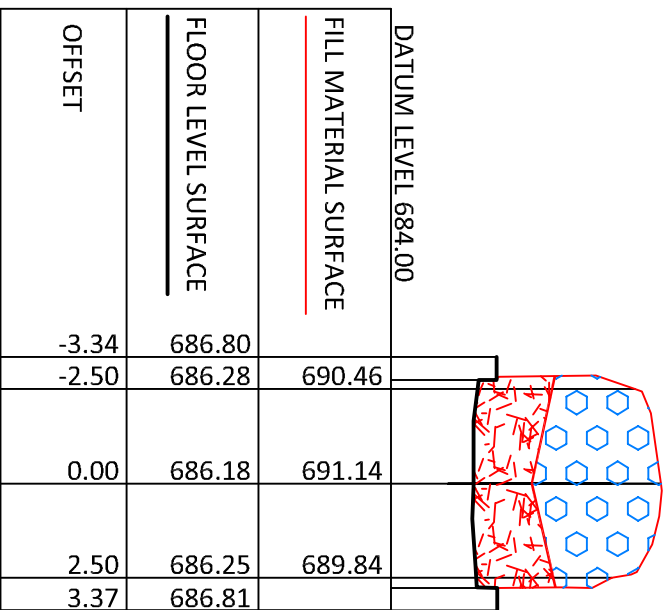


Ch 15.000

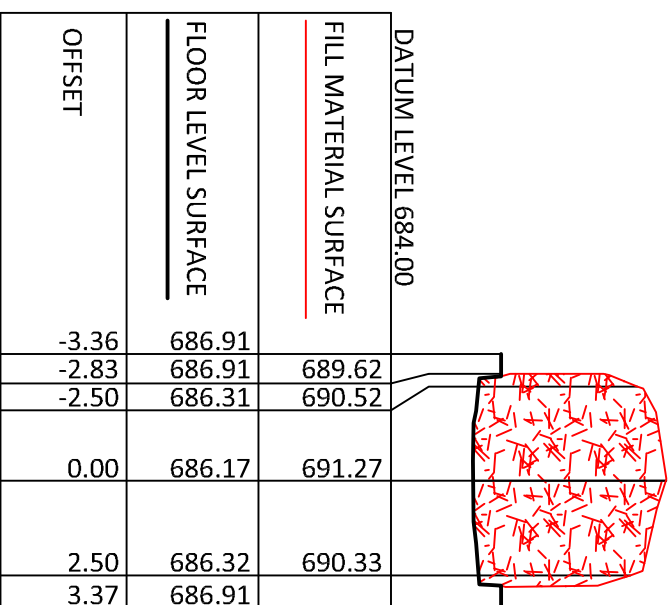

Ch 20.000

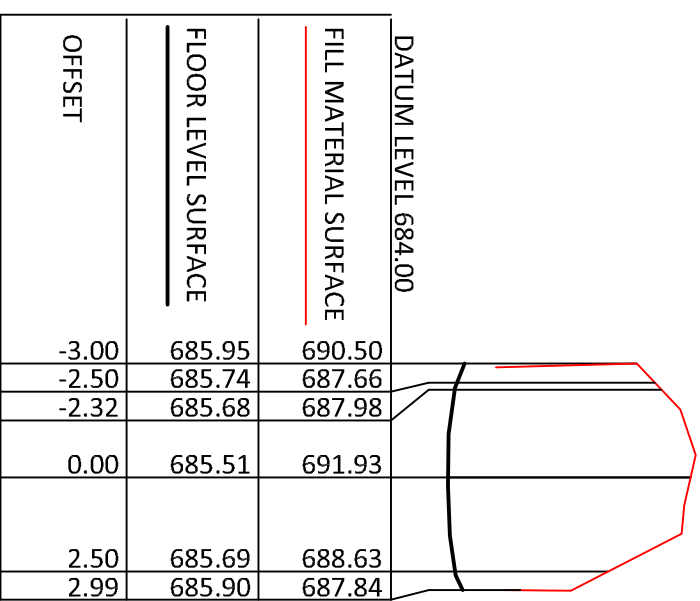

Ch 25.000

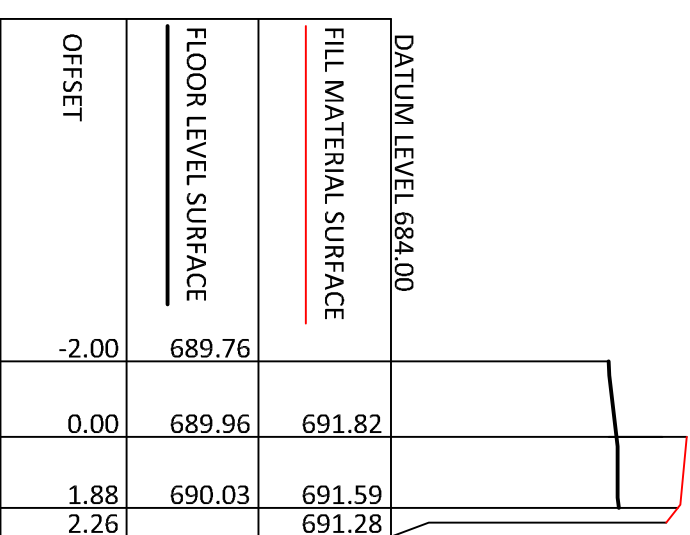


Ch 29.228

**GOLDBURN**  
Incorporating Keils Land Surveyors



36 Montague Street  
Postal: PO Box 1040  
GOLDBURN NSW 2580  
p: (02) 4821 1033  
f: (02) 4821 7238  
e: goldburn@landteam.com.au

SCALE 1:200

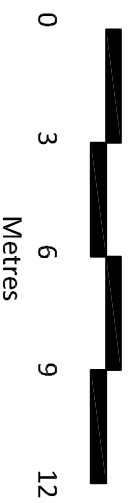

DRAWN BY: M KADZIELA

DATUM: AHD  
ORIGIN OF LEVELS: PILLAR 740  
CONTOUR INTERVAL: N/A  
NOTE : DIMENSIONS AND AREAS  
ARE SUBJECT TO SURVEY

**NORTHERN PORTAL PROJECT**

CROSS SECTIONS: CH 15.00 TO CH 29.228  
OF NORTHERN PORTAL FILLING COMPONENTS  
WOODLAWN BIOREACTOR  
COLLECTOR ROAD, TARAGO  
PARISH OF WERRIWA  
COUNTY OF MURRAY

Sheet No. 4

No. of Sheets: 4  
Date: 3/06/2009  
Ref. No.: 16700  
Dwg No. NP04  
Rev. A






# LANDTEAM

36 Montague Street  
GOULBURN NSW 2580

p: (02) 4821 1033

f: (02) 4821 7238

e: goulburn@landteam.com.au

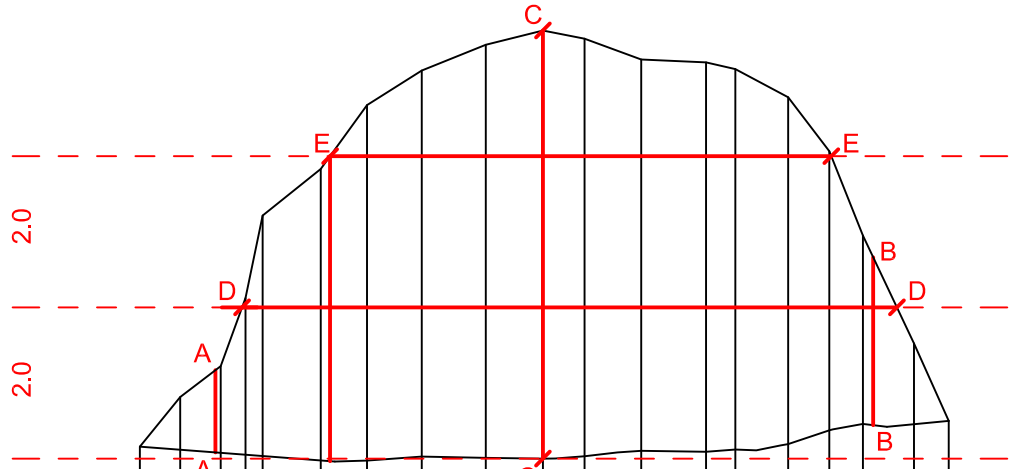

Datum 706.210m

Cut/Fill	ROCK_KEY_PROPOSED	PORTAL_FLOOR	Chainage
	708.16		0.00
	708.81		0.53
	709.22		1.07
	710.12		1.40
	711.21		1.62
	711.83		2.39
4.702	712.67	707.97	3.00
5.105	713.13	708.03	3.73
5.462	713.47	708.01	4.57
5.663	713.66	708.00	5.33
5.522	713.55	708.03	5.88
5.174	713.28	708.10	6.63
5.151	713.24	708.09	7.49
5.033	713.15	708.12	7.87
4.588	712.78	708.19	8.57
3.691	712.06	708.37	9.12
2.489	710.95	708.46	9.56
	709.52		10.24
	708.50		10.70

## SECTION DIMENSIONS:

A - A: 1.09

B - B: 2.22

C - C: 5.66



D - D: 8.66

E - E: 6.63

Scale 1:100


Ref. No: 16700

Date: 31 May 2013

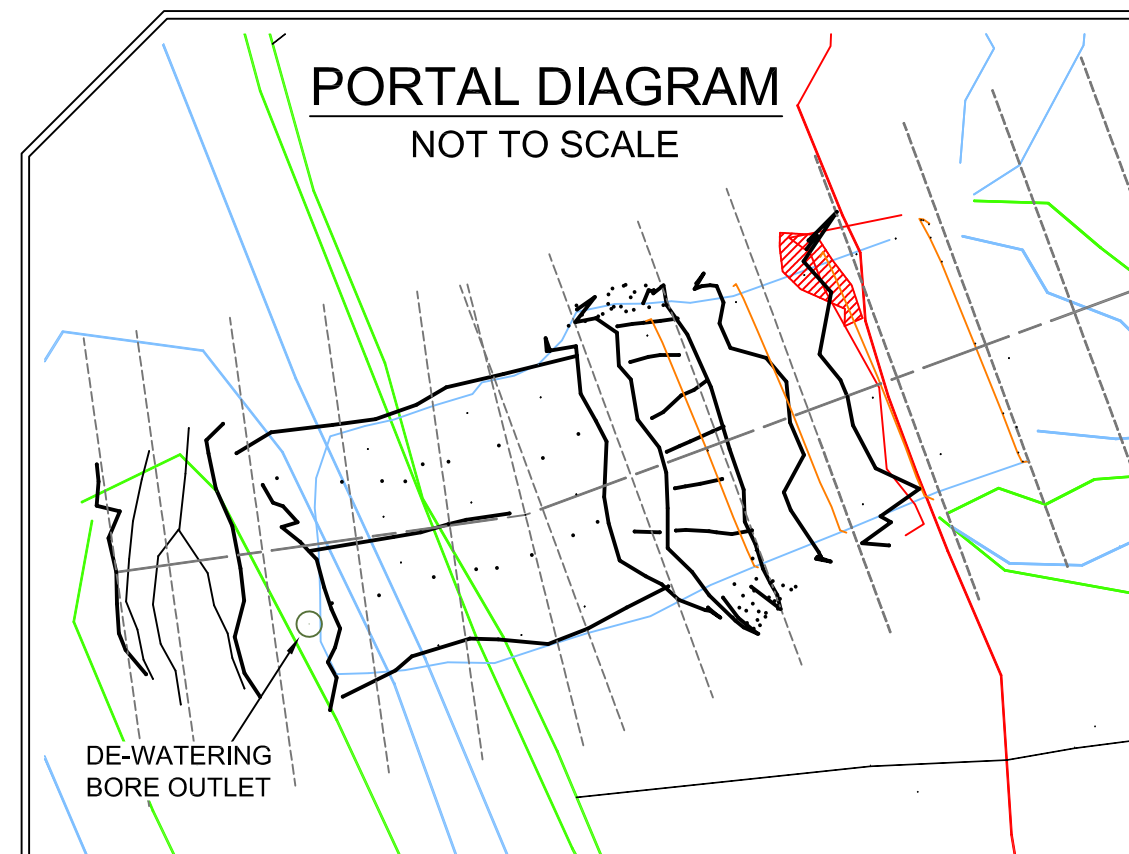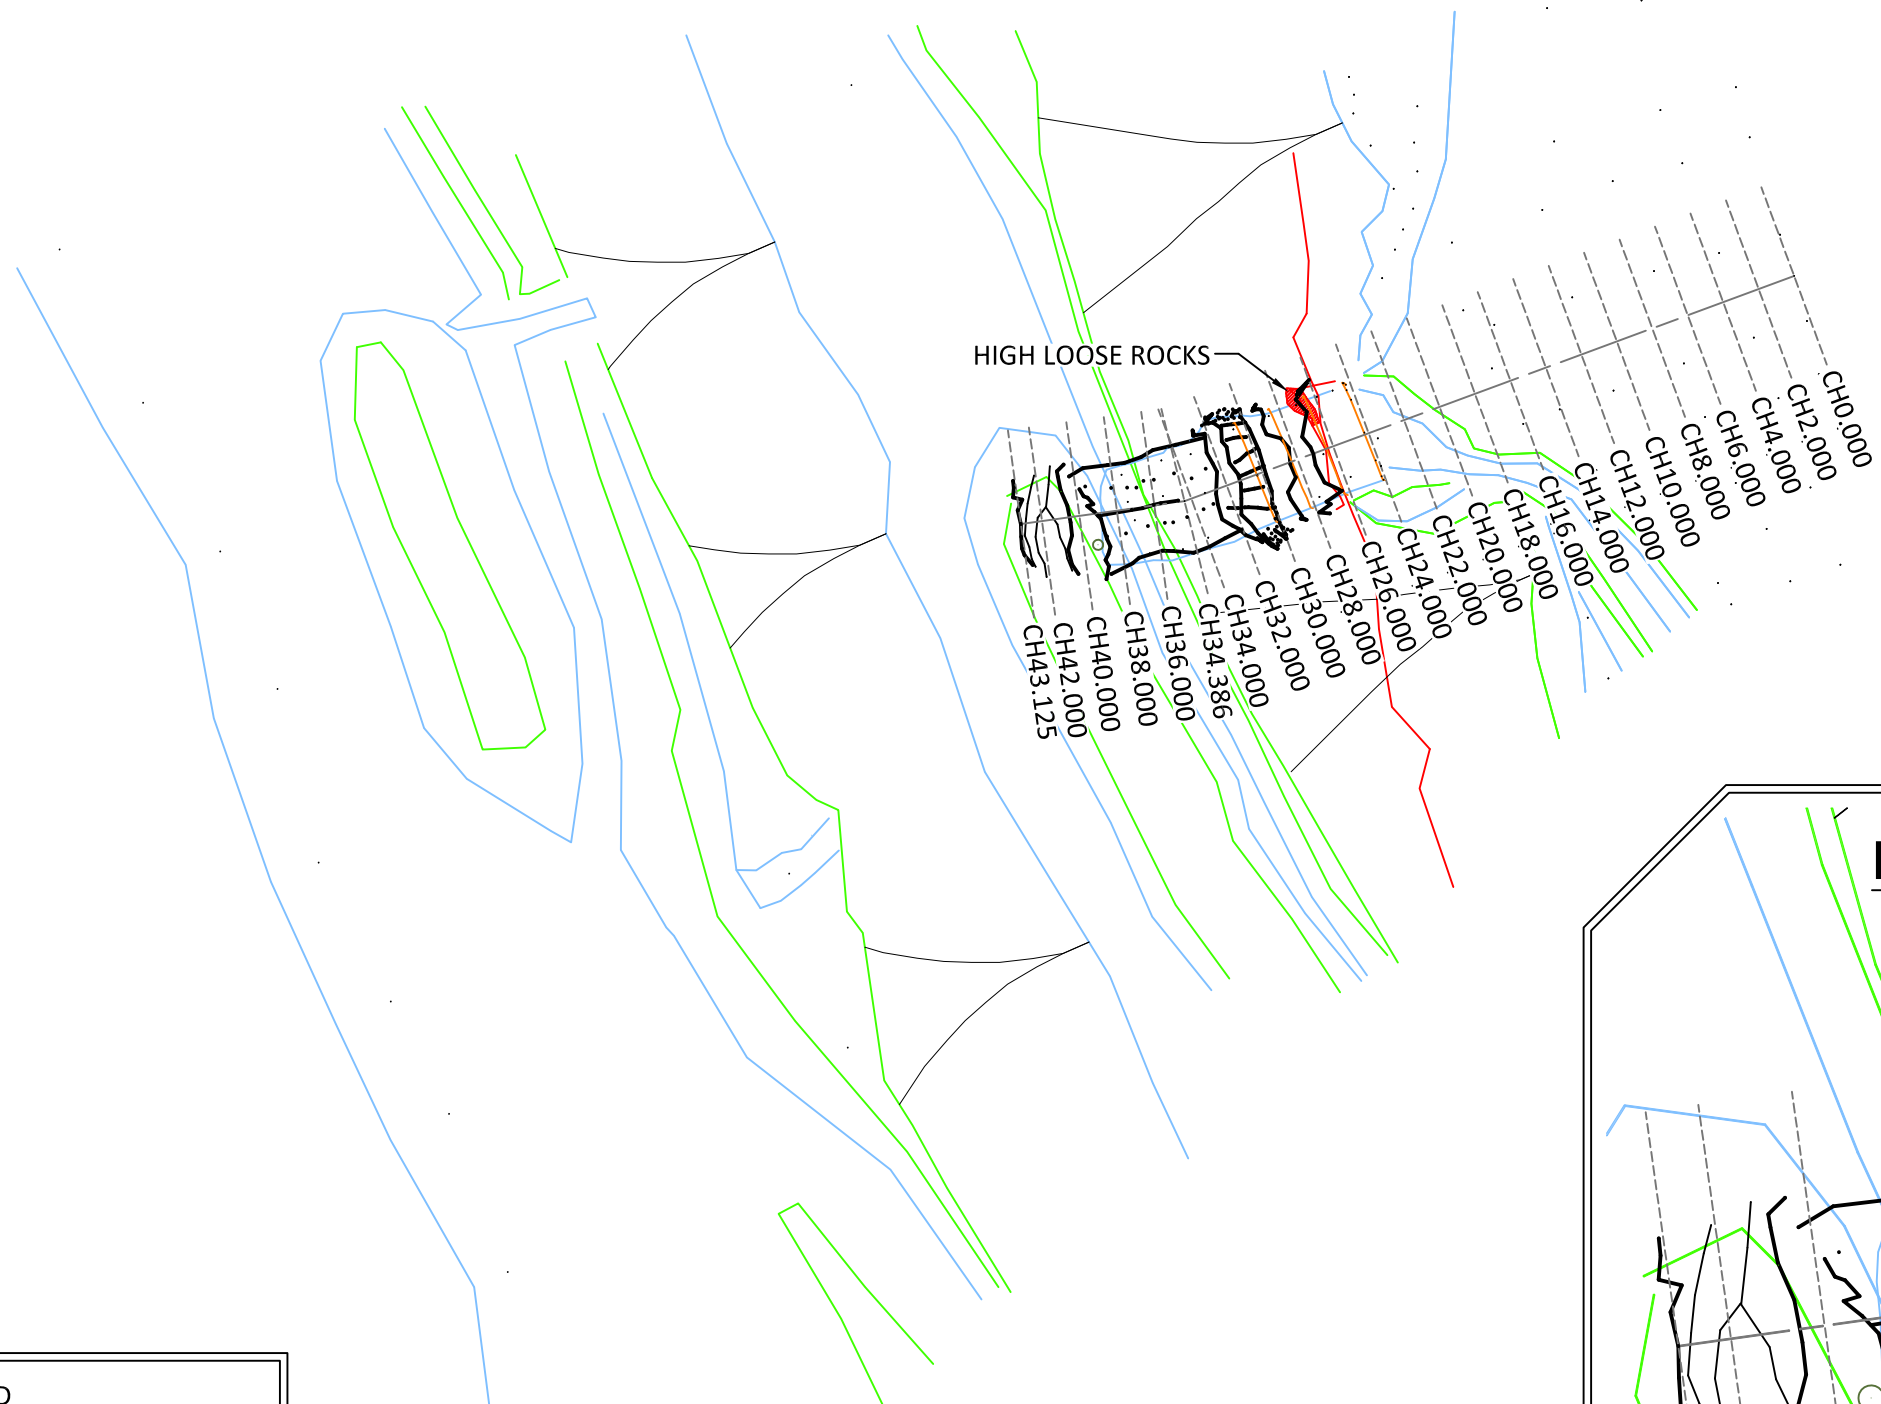

LEGEND	
	TOP OF BANK
	TOE OF BANK
	FACE OF ROCK
	UNDERSIDE OF ROCK
	PORTAL IRON FRAMES

ISSUE	AMENDMENT	DATE
A	INITIAL ISSUE	3/06/2013

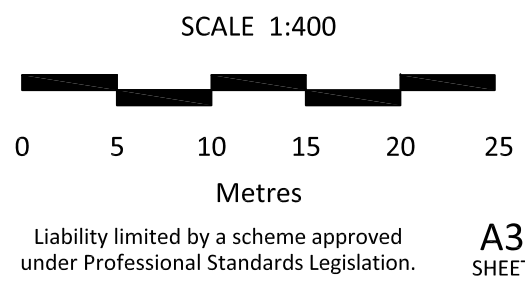


**VEOLIA**  
ENVIRONMENTAL SERVICES

LandTeam Australia Pty Ltd  
ABN 35 300 283 592  
Goulburn Office  
36 Montague Street p: (02) 4821 1033  
Postal: PO Box 1040 f: (02) 4821 7238  
GOULBURN NSW 2580 e: goulburn@landteam.com.au FS550318

SOUTHERN PORTAL SEALING PROJECT		
PLAN VIEW SURVEY OF EXISTING SOUTHERN PORTAL WOODLAWN BIOREACTOR COLLECTOR ROAD TARAGO		
DATUM: AHD	ORIGIN: PILLAR 715	CONTOUR INTERVAL: N/A

DATE: 3/06/2013	<b>A</b>
SURVEYED: MK	
DRAWN: MK	
CHECKED: JK	
DRAWING No.	<b>16700-SP01</b>

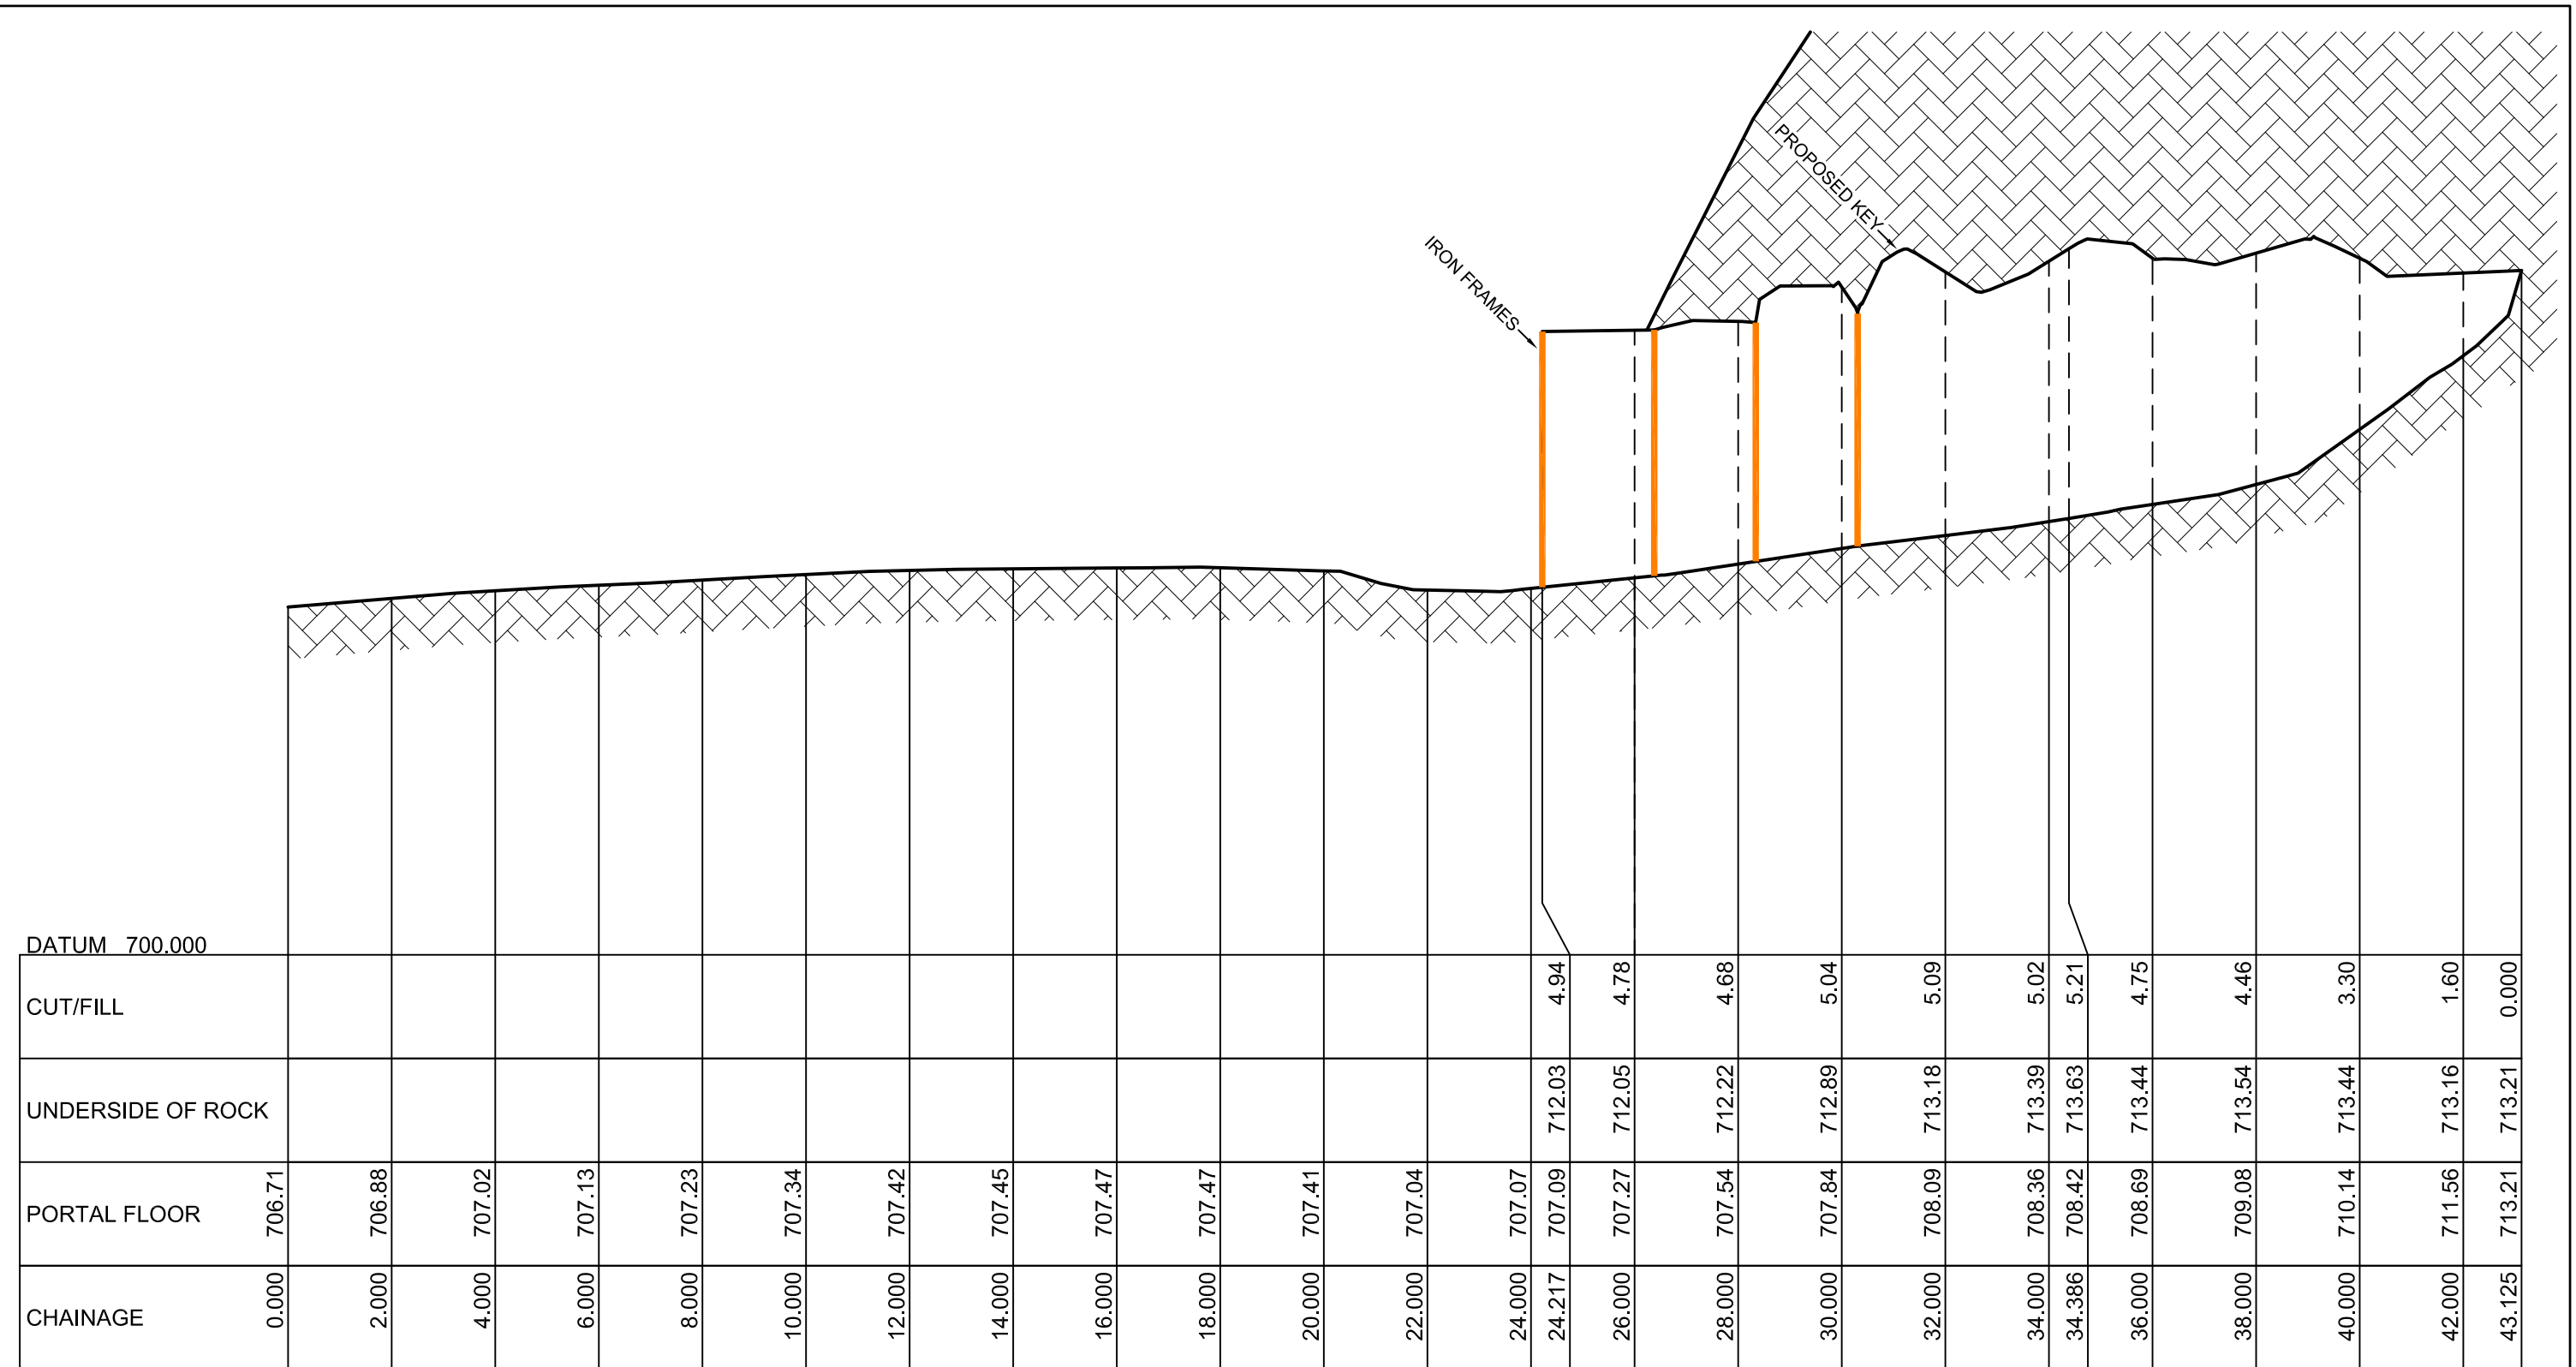

J:\Surveyors\Jobs\Veolia\16700 Woodlawn Bioreactor\Veolia Southern Portal\Cad\16700-SP2.Plans.dwg

ISSUE	AMENDMENT	DATE	<p>SCALE 1:400</p>		SOUTHERN PORTAL SEALING PROJECT			DATE: 3/06/2013
A	INITIAL ISSUE	3/06/2013			<p>LONGITUDINAL SECTION SURVEY OF EXISTING SOUTHERN PORTAL WOODLAWN BIOREACTOR COLLECTOR ROAD TARAGO</p>			SURVEYED: MK
								DRAWN: MK
						CHECKED: JK		
			<p>Liability limited by a scheme approved under Professional Standards Legislation.</p>			DRAWING No.		
			A3 SHEET	<p>LandTeam Australia Pty Ltd ABN 35 300 283 592 Goulburn Office 36 Montague Street p: (02) 4821 1033 Postal: PO Box 1040 f: (02) 4821 7238 GOULBURN NSW 2580 e: goulburn@landteam.com.au FS550318</p>	<p>DATUM: AHD   ORIGIN: PILLAR 715   CONTOUR INTERVAL: N/A</p>			16700-SP02

DATUM 705.41

PORTAL FLOOR	706.67	706.74	706.80	706.87	706.95	707.02	707.10	707.17	707.25	707.33	707.41
OFFSET	-5.00	-4.00	-3.00	-2.00	-1.00	0.00	1.00	2.00	3.00	4.00	5.00

CH4.000

DATUM 705.81

PORTAL FLOOR	707.05	707.10	707.16	707.21	707.28	707.34	707.40	707.46	707.52	707.58	707.64
OFFSET	-5.00	-4.00	-3.00	-2.00	-1.00	0.00	1.00	2.00	3.00	4.00	5.00

CH10.000

DATUM 705.26

PORTAL FLOOR	706.49	706.56	706.64	706.73	706.80	706.88	706.95	707.03	707.11	707.20	707.29
OFFSET	-5.00	-4.00	-3.00	-2.00	-1.00	0.00	1.00	2.00	3.00	4.00	5.00

CH2.000

DATUM 705.68

PORTAL FLOOR	706.92	706.98	707.04	707.10	707.17	707.23	707.30	707.36	707.42	707.48	707.54
OFFSET	-5.00	-4.00	-3.00	-2.00	-1.00	0.00	1.00	2.00	3.00	4.00	5.00

CH8.000

DATUM 705.80

PORTAL FLOOR	706.80	706.86	706.95	707.04	707.13	707.21	707.30	707.39	707.47	707.55
OFFSET	1.19	2.00	3.00	4.00	5.00	6.00	7.00	8.00	9.00	10.00

CH0.000

DATUM 705.55

PORTAL FLOOR	706.79	706.86	706.92	706.99	707.07	707.13	707.20	707.26	707.33	707.41	707.48
OFFSET	-5.00	-4.00	-3.00	-2.00	-1.00	0.00	1.00	2.00	3.00	4.00	5.00

CH6.000

J:\Surveyors\Jobs\Veolia\16700 Woodlawn Bioreactor\Veolia Southern Portal\Cad\16700-SP2.Plans.dwg

ISSUE	AMENDMENT	DATE
A	INITIAL ISSUE	3/06/2013

SCALE 1:200

0 3 6 9 12  
Metres

Liability limited by a scheme approved under Professional Standards Legislation.

A3 SHEET

LandTeam Australia Pty Ltd  
 36 Montague Street p: (02) 4821 1033  
 Goulburn Office Postal: PO Box 1040 f: (02) 4821 7238  
 GOULBURN NSW 2580 e: goulburn@landteam.com.au FS550318

SOUTHERN PORTAL SEALING PROJECT

CROSS SECTIONS: CH0.000 - CH10.000  
 SURVEY OF EXISTING SOUTHERN PORTAL  
 WOODLAWN BIOREACTOR  
 COLLECTOR ROAD  
 TARAGO

DATUM: AHD | ORIGIN: PILLAR 715 | CONTOUR INTERVAL: N/A


DATE: 3/06/2013

SURVEYED: MK | ISSUE


DRAWN: MK | **A**

CHECKED: JK


DRAWING No.  
**16700-SP03**

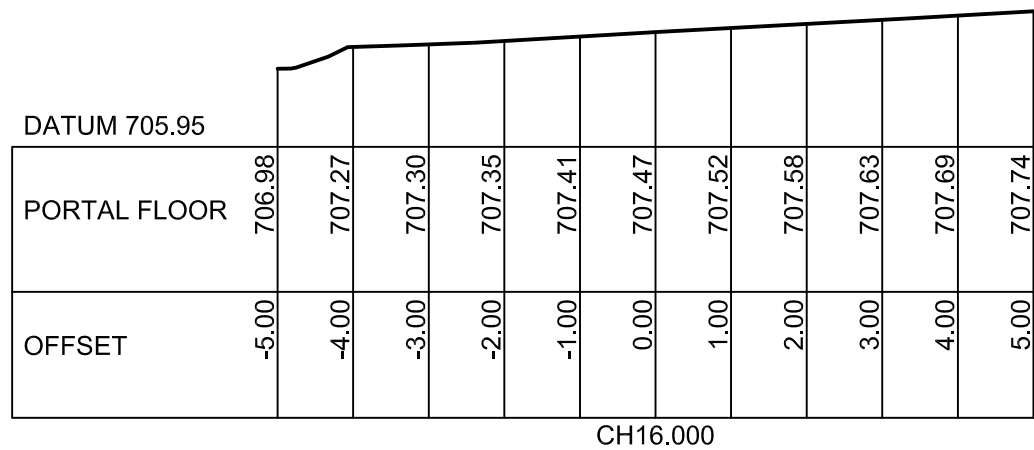


CH16.000

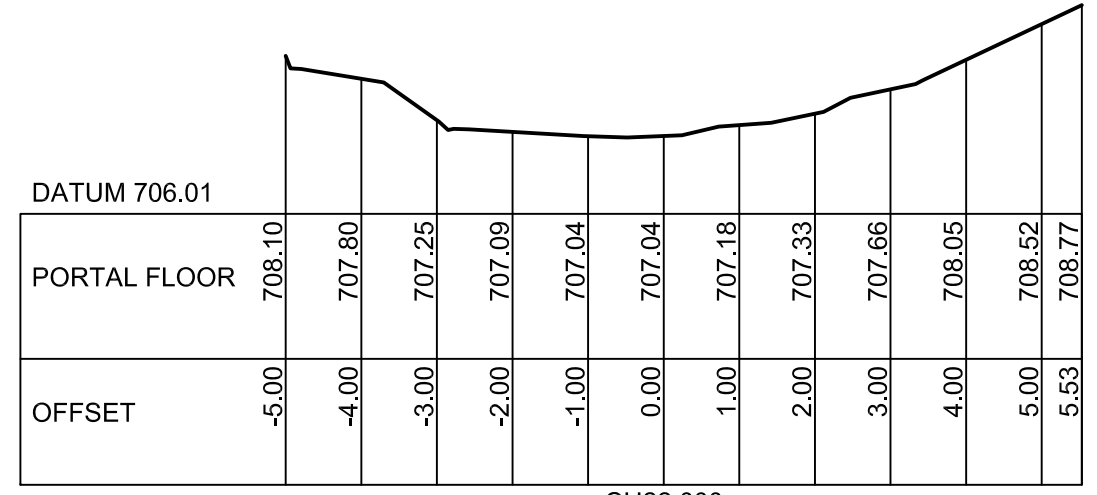


CH22.000

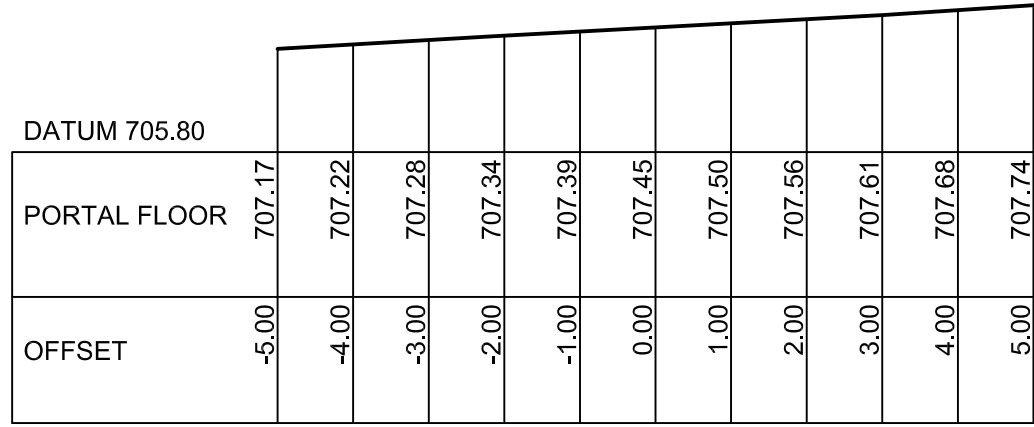


CH14.000

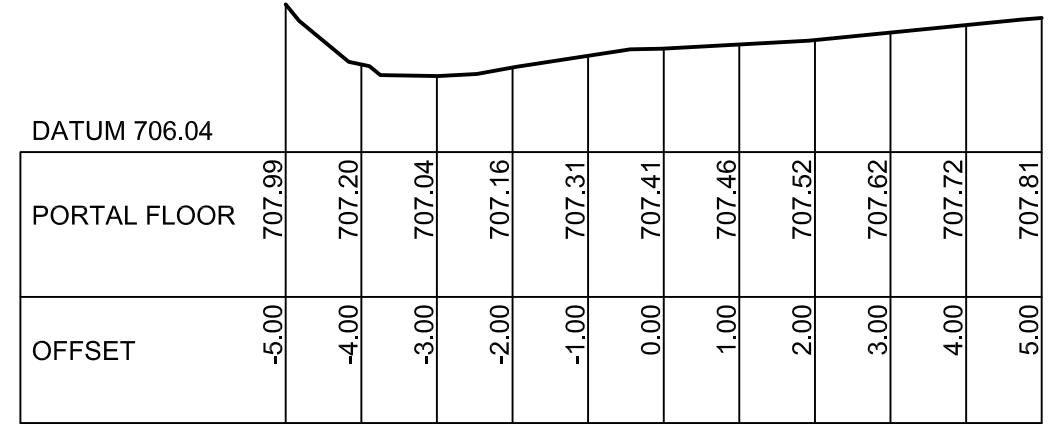

CH20.000

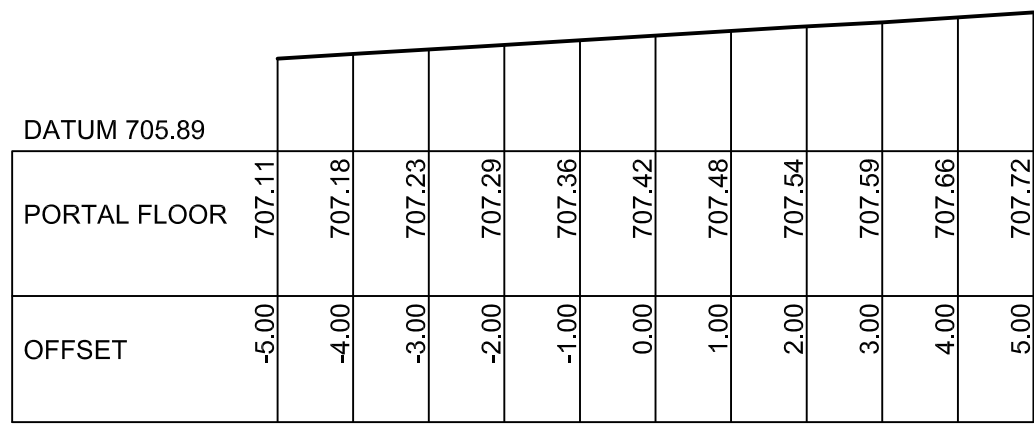


CH12.000

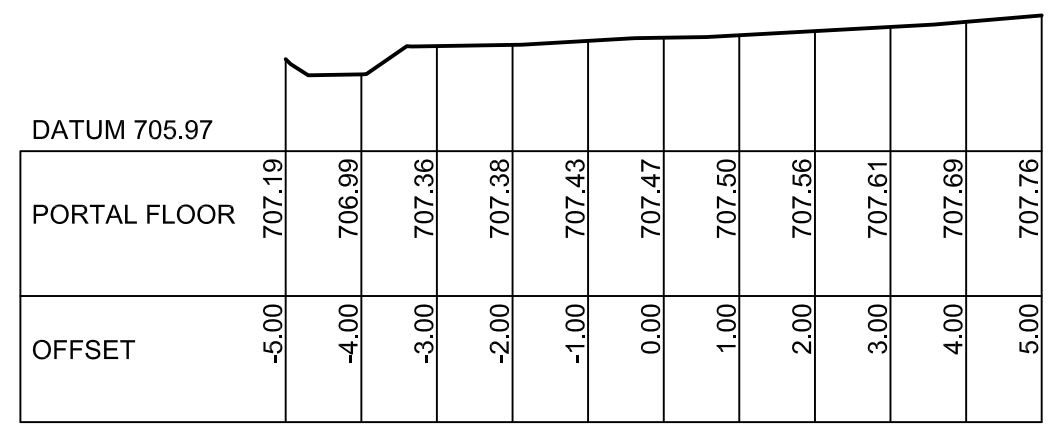

CH18.000

J:\Surveyors\Jobs\Veolia\16700 Woodlawn Bioreactor\Veolia Southern Portal\Cad\16700-SP2 Plans.dwg

ISSUE	AMENDMENT	DATE
A	INITIAL ISSUE	3/06/2013

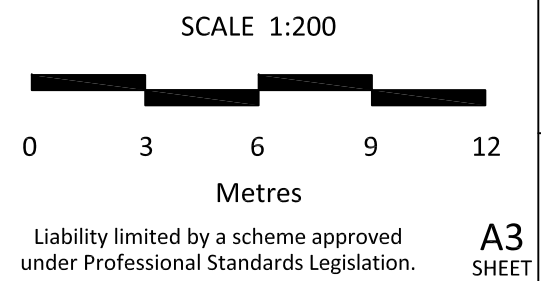

**VEOLIA**  
ENVIRONMENTAL SERVICES

**LandTeam**




LandTeam Australia Pty Ltd  
ABN 35 300 283 592  
Goulburn Office  
36 Montague Street p: (02) 4821 1033  
Postal: PO Box 1040 f: (02) 4821 7238  
GOULBURN NSW 2580 e: goulburn@landteam.com.au FS550318

**SOUTHERN PORTAL SEALING PROJECT**

CROSS SECTIONS: CH12.000 - CH22.000  
SURVEY OF EXISTING SOUTHERN PORTAL  
WOODLAWN BIOREACTOR  
COLLECTOR ROAD  
TARAGO


DATUM: AHD    ORIGIN: PILLAR 715    CONTOUR INTERVAL: N/A

DATE:	3/06/2013	
SURVEYED:	MK	ISSUE
DRAWN:	MK	<b>A</b>
CHECKED:	JK	
DRAWING No.	<b>16700-SP04</b>	

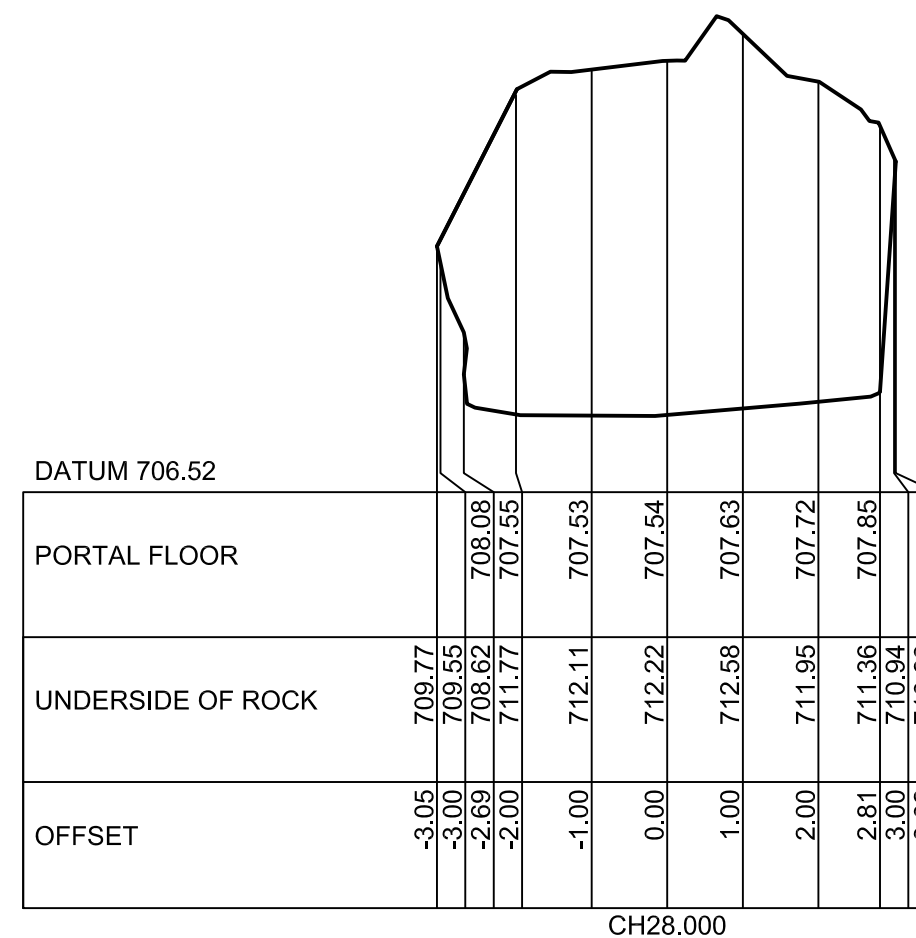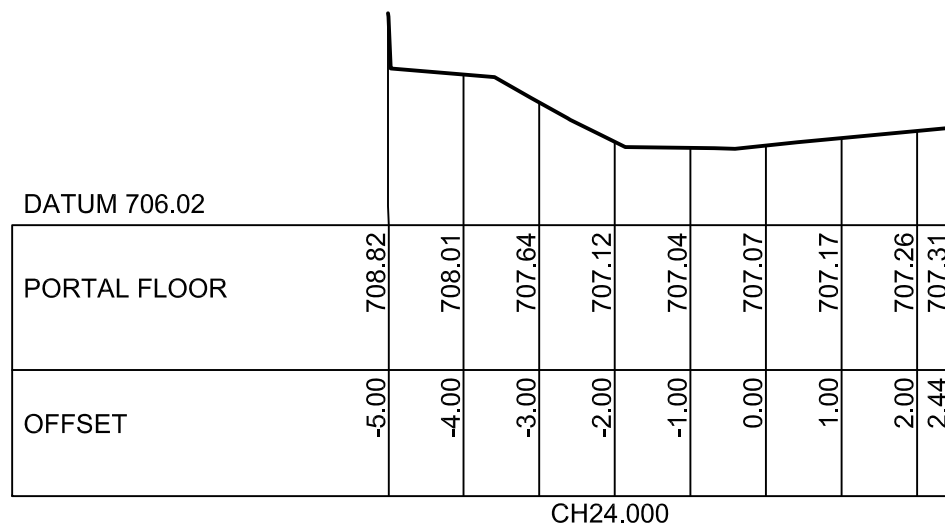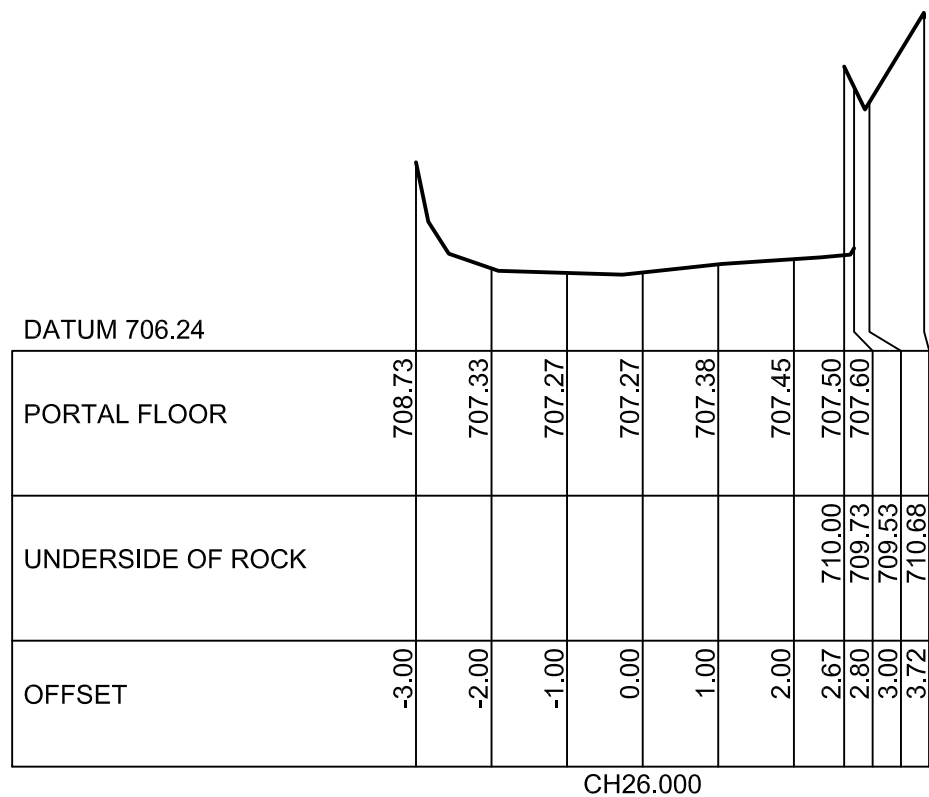

J:\Surveyors\Jobs\Veolia\16700 Woodlawn Bioreactor\Veolia Southern Portal\Cad\16700-SP2 Plans.dwg

ISSUE	AMENDMENT	DATE
A	INITIAL ISSUE	3/06/2013

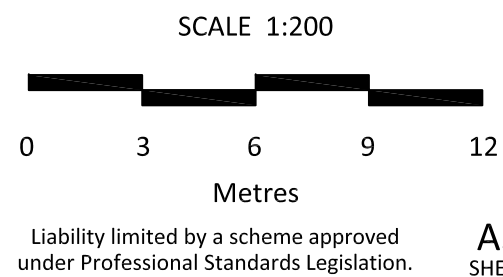

LandTeam Australia Pty Ltd  
 ABN 35 300 283 592  
 Goulburn Office  
 36 Montague Street p: (02) 4821 1033  
 Postal: PO Box 1040 f: (02) 4821 7238  
 GOULBURN NSW 2580 e: goulburn@landteam.com.au FS550318



SOUTHERN PORTAL SEALING PROJECT

CROSS SECTIONS: CH24.000 - CH28.000  
 SURVEY OF EXISTING SOUTHERN PORTAL  
 WOODLAWN BIOREACTOR  
 COLLECTOR ROAD  
 TARAGO

DATUM: AHD | ORIGIN: PILLAR 715 | CONTOUR INTERVAL: N/A


DATE:	3/06/2013
SURVEYED:	MK
DRAWN:	MK
CHECKED:	JK
DRAWING No.	16700-SP05

ISSUE  
**A**

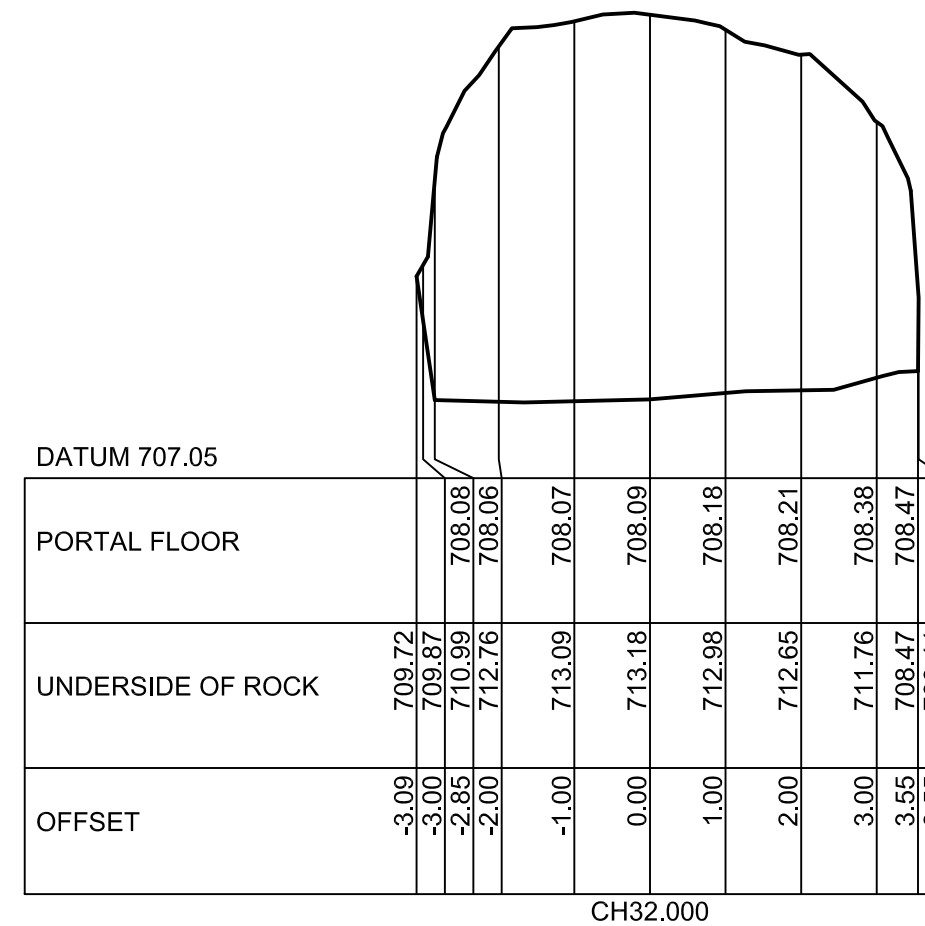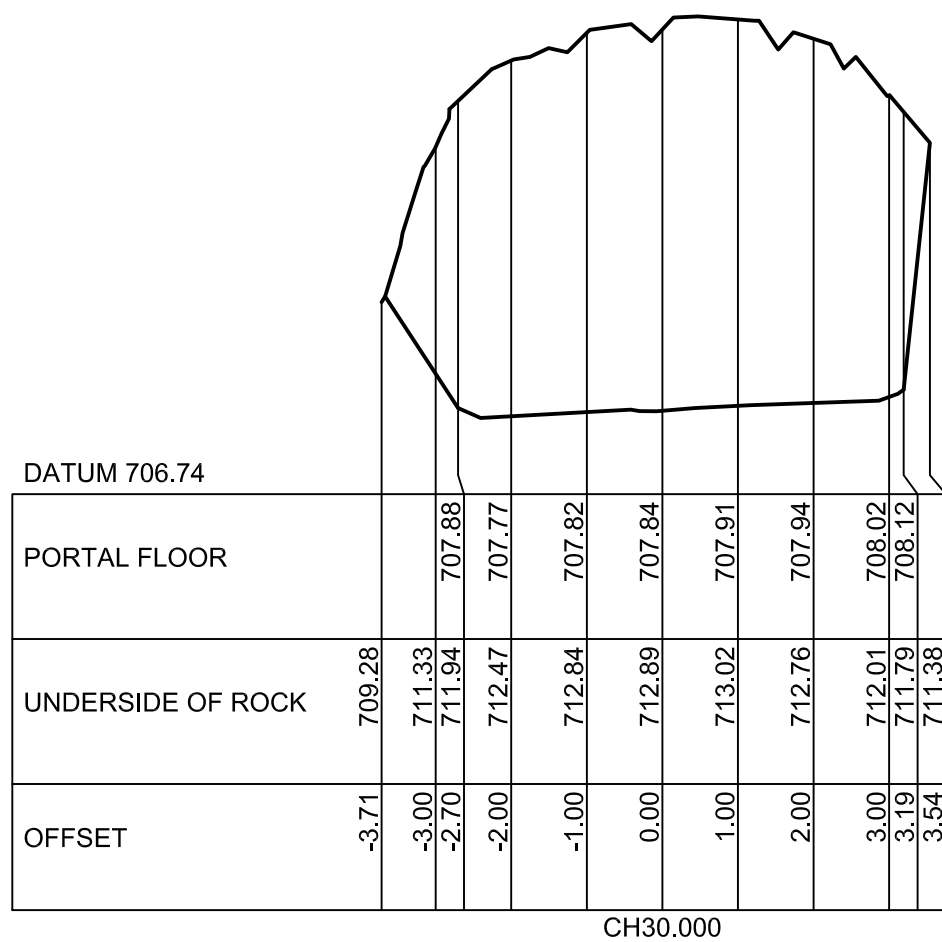

J:\Surveyors\Jobs\Veolia\16700 Woodlawn Bioreactor\Veolia Southern Portal\Cad\16700-SP2 Plans.dwg

ISSUE	AMENDMENT	DATE
A	INITIAL ISSUE	3/06/2013

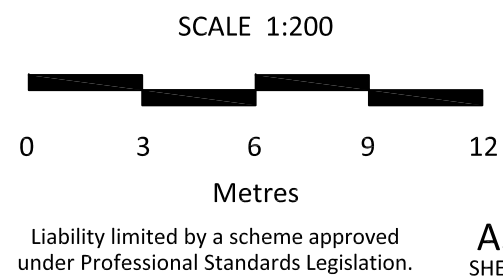

**VEOLIA**  
ENVIRONMENTAL SERVICES




LandTeam Australia Pty Ltd  
ABN 35 300 283 592  
Goulburn Office  
36 Montague Street p: (02) 4821 1033  
Postal: PO Box 1040 f: (02) 4821 7238  
GOULBURN NSW 2580 e: goulburn@landteam.com.au FS550318

**SOUTHERN PORTAL SEALING PROJECT**

CROSS SECTIONS: CH30.000 - CH32.000  
SURVEY OF EXISTING SOUTHERN PORTAL  
WOODLAWN BIOREACTOR  
COLLECTOR ROAD  
TARAGO


DATUM: AHD    ORIGIN: PILLAR 715    CONTOUR INTERVAL: N/A

DATE:	3/06/2013
SURVEYED:	MK
DRAWN:	MK
CHECKED:	JK
DRAWING No.	<b>16700-SP06</b>
ISSUE	<b>A</b>

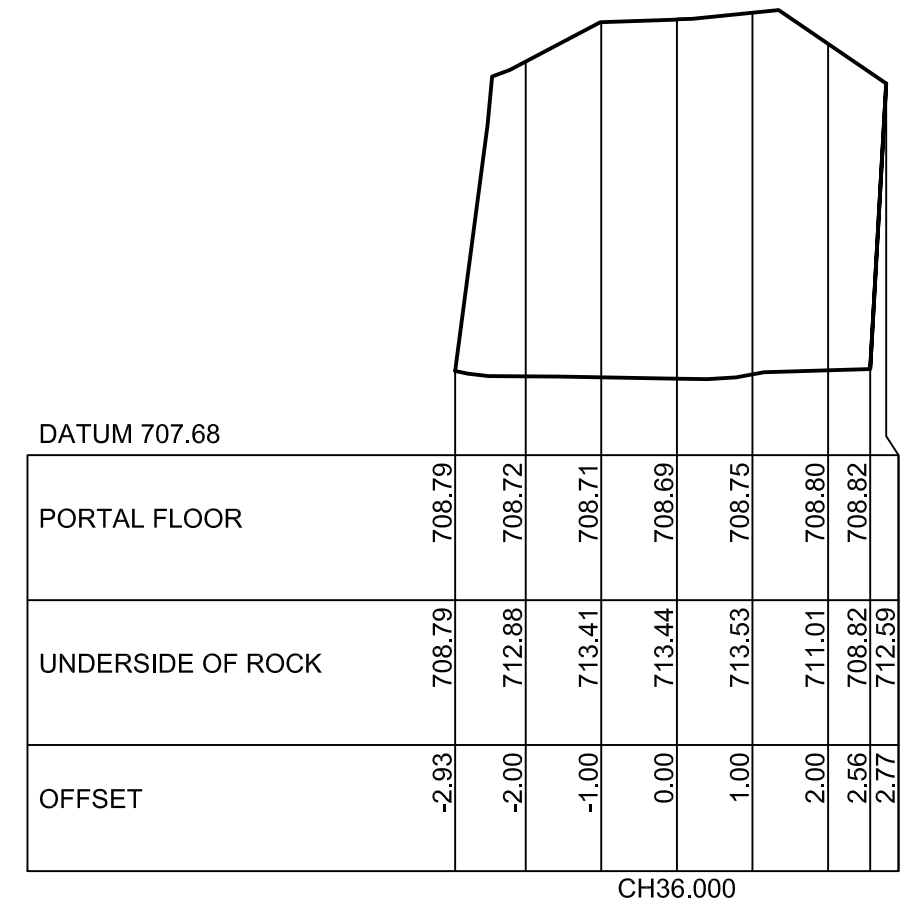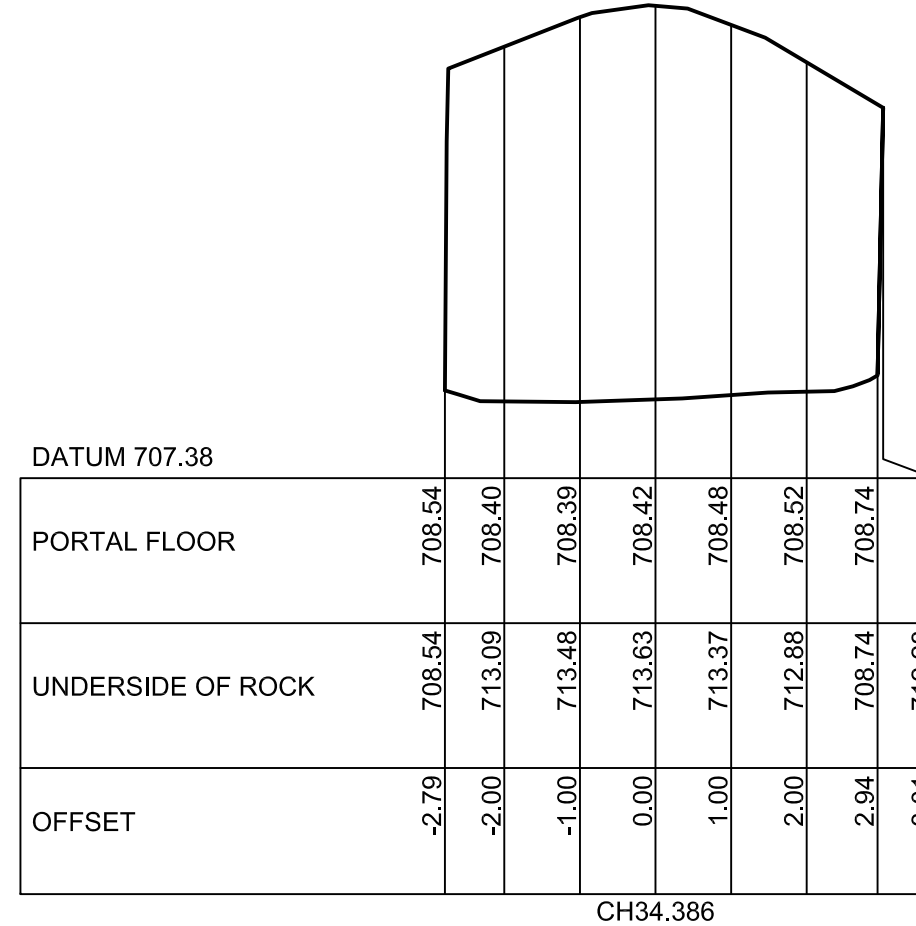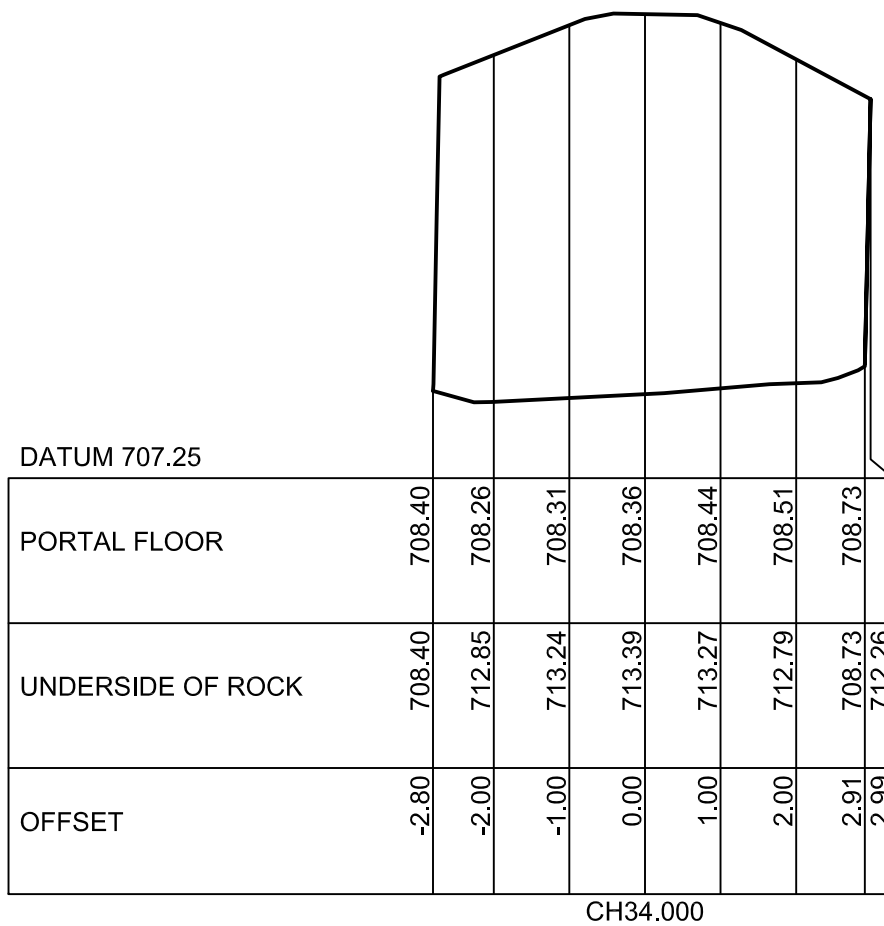

J:\Surveyors\Jobs\Veolia\16700 Woodlawn Bioreactor\Veolia Southern Portal\Cad\16700-SP2 Plans.dwg

ISSUE	AMENDMENT	DATE
A	INITIAL ISSUE	3/06/2013

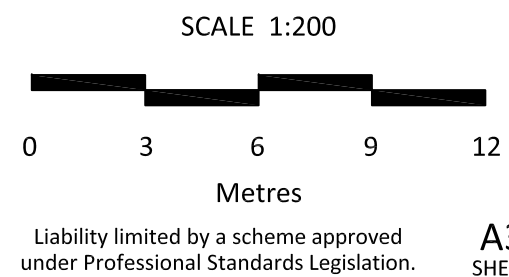





**VEOLIA**  
ENVIRONMENTAL SERVICES

LandTeam Australia Pty Ltd  
ABN 35 300 283 592  
Goulburn Office  
36 Montague Street p: (02) 4821 1033  
Postal: PO Box 1040 f: (02) 4821 7238  
GOULBURN NSW 2580 e: goulburn@landteam.com.au FS550318

SOUTHERN PORTAL SEALING PROJECT		
CROSS SECTIONS: CH34.000 - CH36.000 SURVEY OF EXISTING SOUTHERN PORTAL WOODLAWN BIOREACTOR COLLECTOR ROAD TARAGO		
DATUM: AHD	ORIGIN: PILLAR 715	CONTOUR INTERVAL: N/A


DATE: 3/06/2013	<b>A</b>
SURVEYED: MK	
DRAWN: MK	
CHECKED: JK	
DRAWING No.	
<b>16700-SP07</b>	



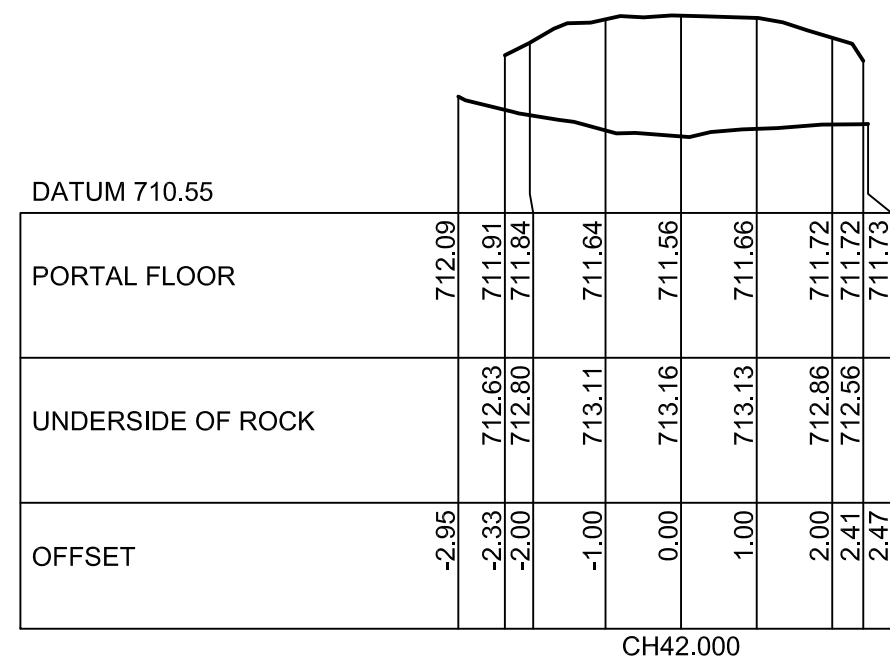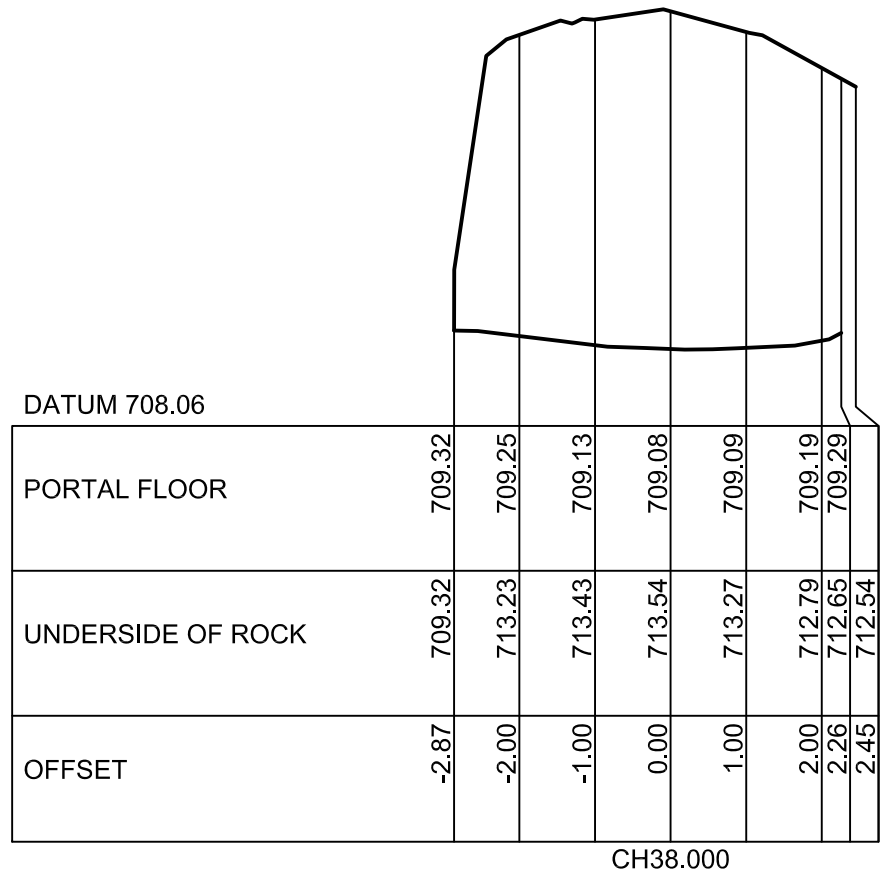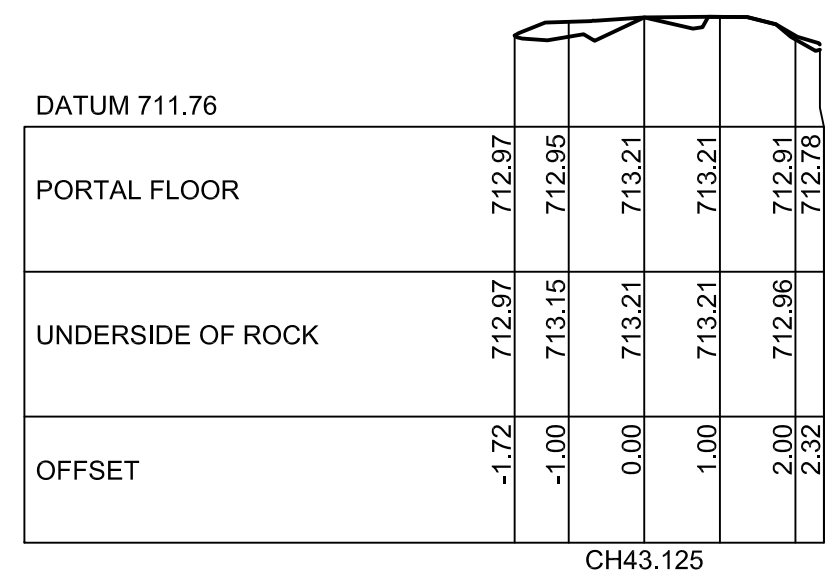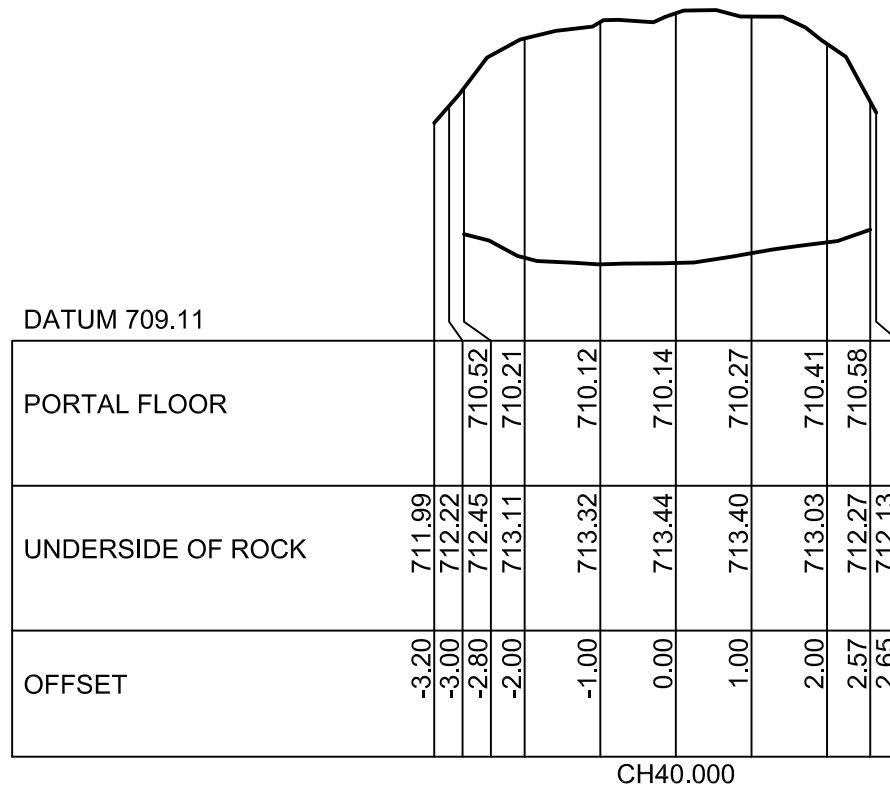

J:\Surveyors\Jobs\Veolia\16700 Woodlawn Bioreactor\Veolia Southern Portal\Cad\16700-SP2 Plans.dwg

ISSUE	AMENDMENT	DATE
A	INITIAL ISSUE	3/06/2013

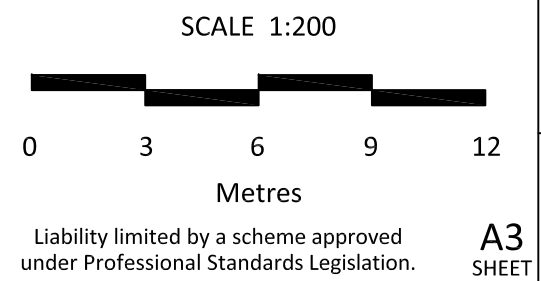

**VEOLIA**  
ENVIRONMENTAL SERVICES

LandTeam Australia Pty Ltd  
ABN 35 300 283 592  
Goulburn Office  
36 Montague Street p: (02) 4821 1033  
Postal: PO Box 1040 f: (02) 4821 7238  
GOULBURN NSW 2580 e: goulburn@landteam.com.au FS550318

**SOUTHERN PORTAL SEALING PROJECT**


CROSS SECTIONS: CH38.000 - CH43.125  
SURVEY OF EXISTING SOUTHERN PORTAL  
WOODLAWN BIOREACTOR  
COLLECTOR ROAD  
TARAGO

DATUM: AHD | ORIGIN: PILLAR 715 | CONTOUR INTERVAL: N/A

DATE:	3/06/2013
SURVEYED:	MK
DRAWN:	MK
CHECKED:	JK
DRAWING No.	16700-SP08

A

MGA

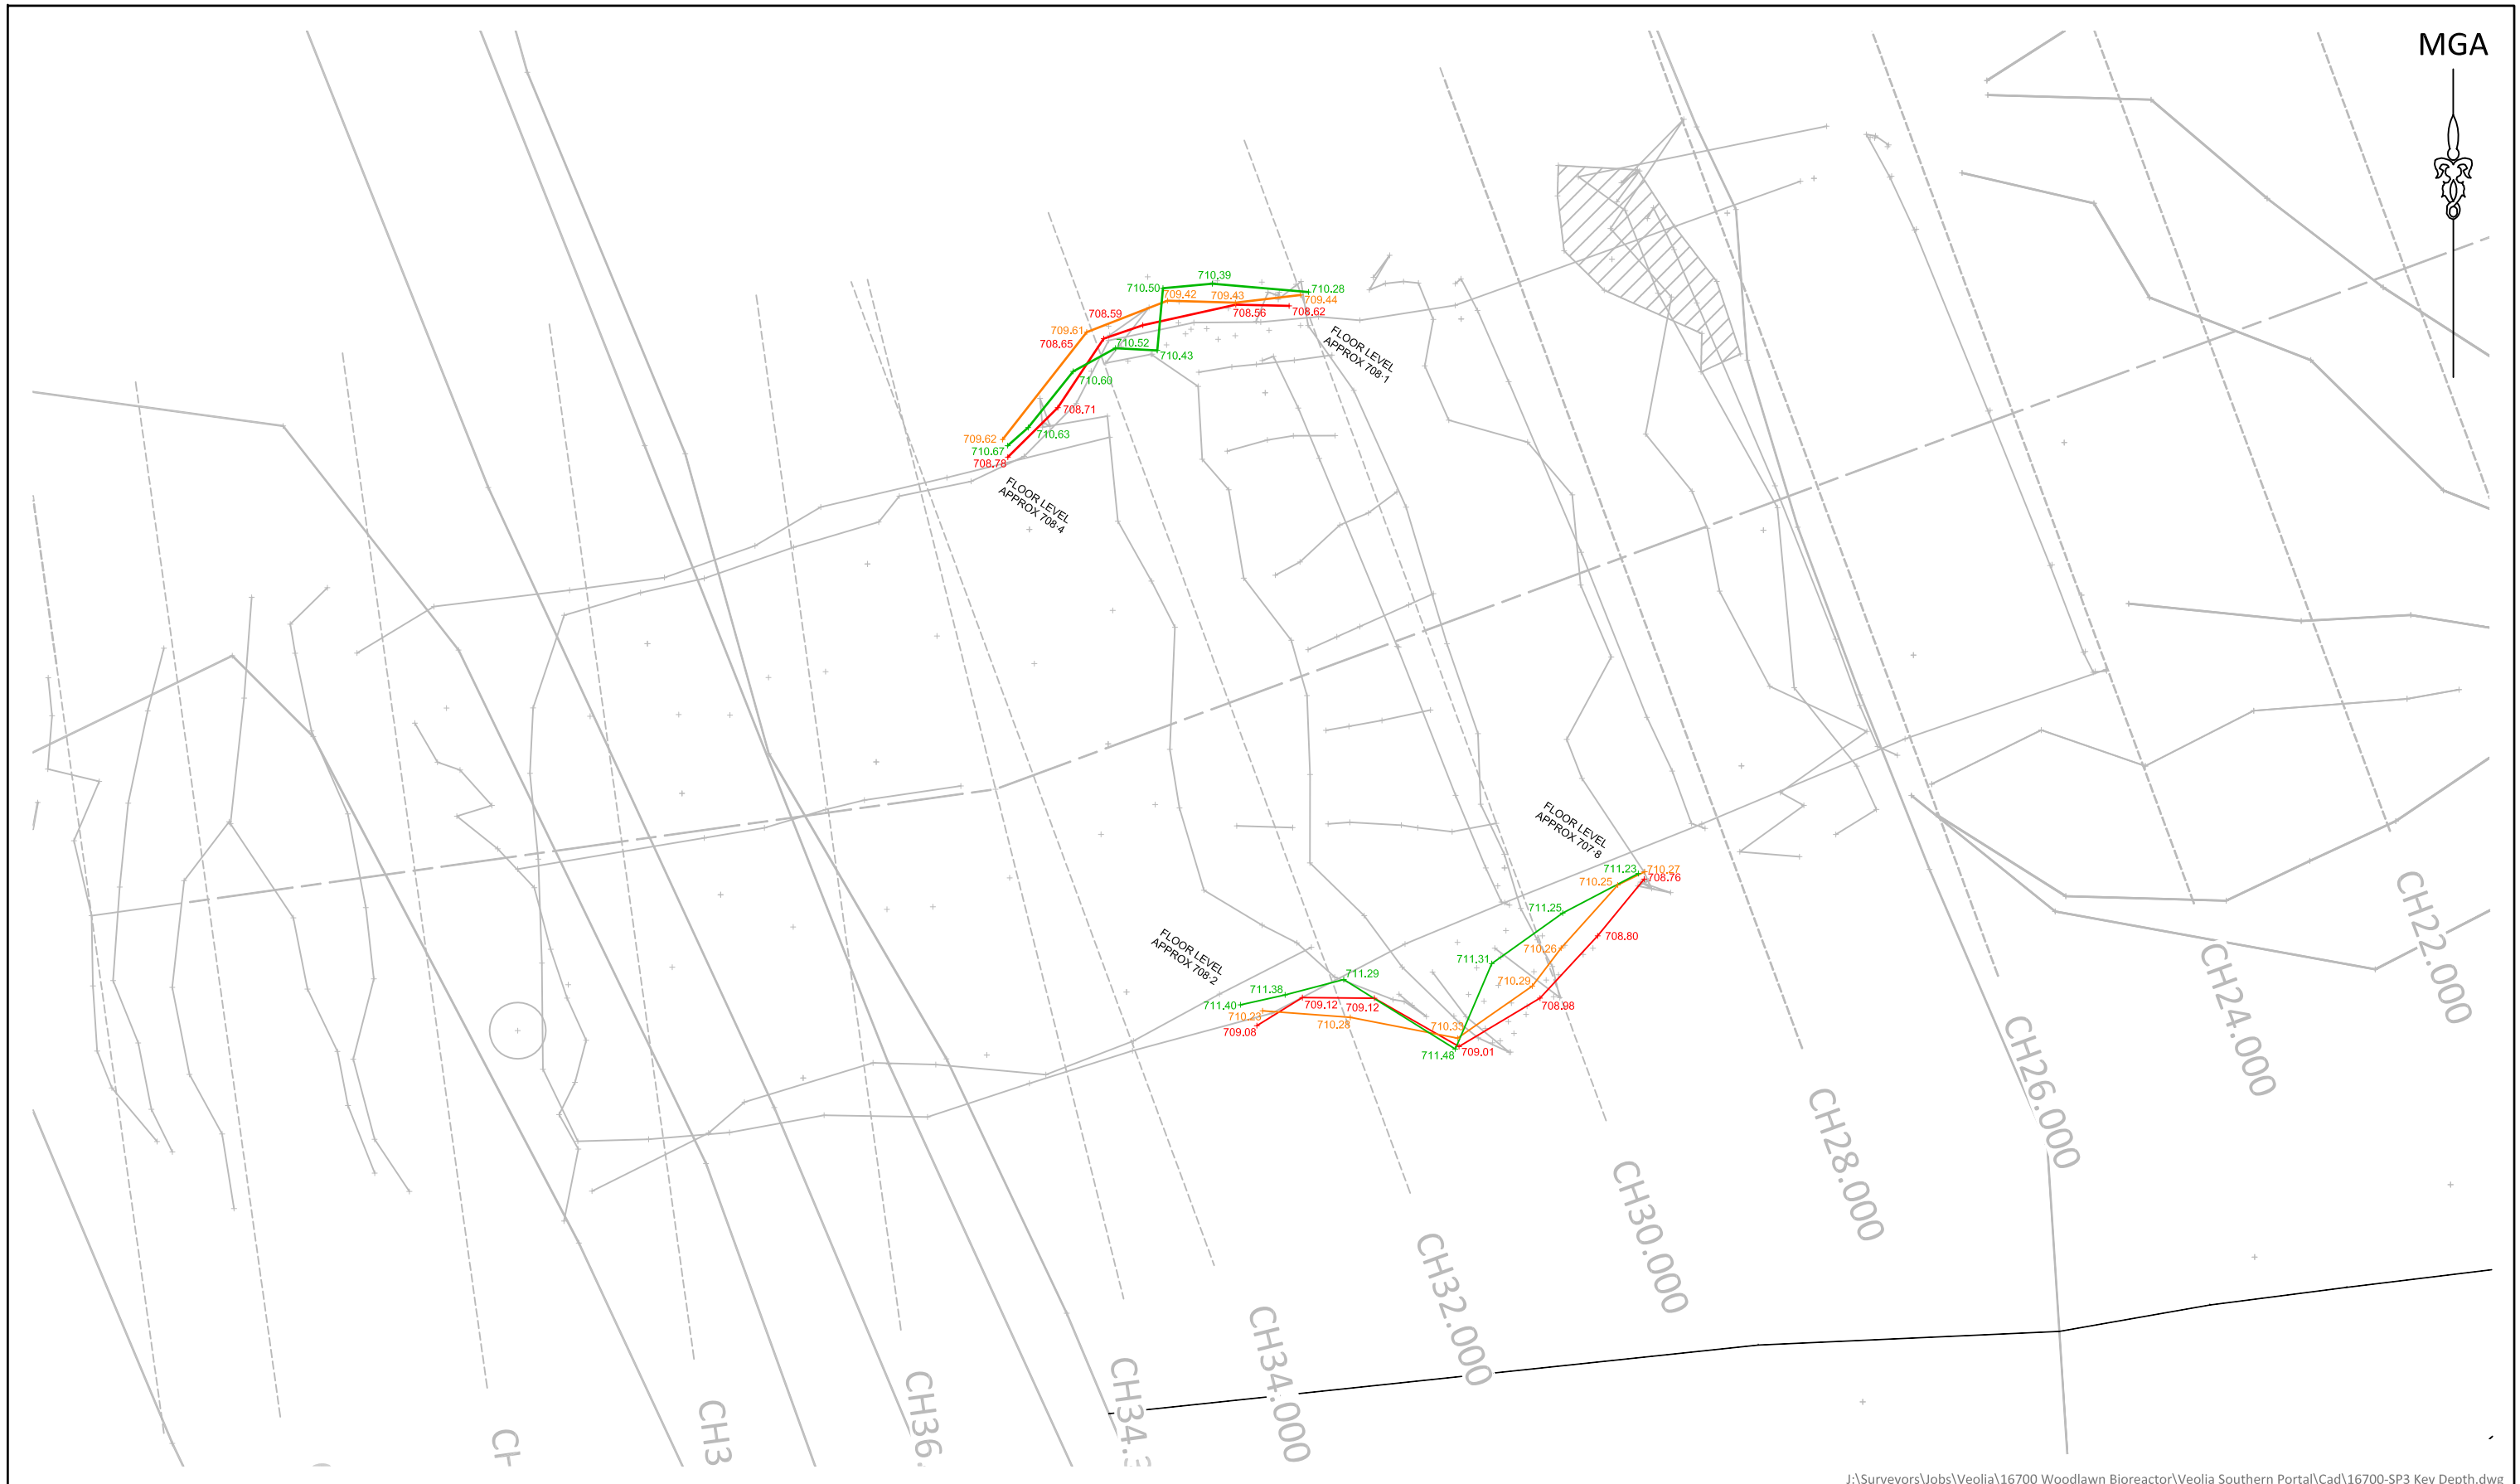

J:\Surveyors\Jobs\Veolia\16700 Woodlawn Bioreactor\Veolia Southern Portal\Cad\16700-SP3 Key Depth.dwg

ISSUE	AMENDMENT	DATE
A	INITIAL ISSUE	2/08/2013

SCALE 1:60

0 1 2 3 4  
Metres

Liability limited by a scheme approved under Professional Standards Legislation.

**A3**  
SHEET

LandTeam Australia Pty Ltd  
 ABN 35 300 283 592  
 Goulburn Office  
 36 Montague Street p: (02) 4821 1033  
 Postal: PO Box 1040 f: (02) 4821 7238  
 GOULBURN NSW 2580 e: goulburn@landteam.com.au FS550318

**SOUTHERN PORTAL SEALING PROJECT**

PLAN VIEW  
 SHOWING SOUTHERN PORTAL SIDE WALL KEYS  
 WOODLAWN BIOREACTOR  
 COLLECTOR ROAD  
 TARAGO

DATUM: AHD    ORIGIN: PILLAR 715    CONTOUR INTERVAL: N/A



DATE: 2/08/2013

SURVEYED: SM    ISSUE


DRAWN: MK    **A**

CHECKED: JK


DRAWING No.  
**16700-SP3-1**

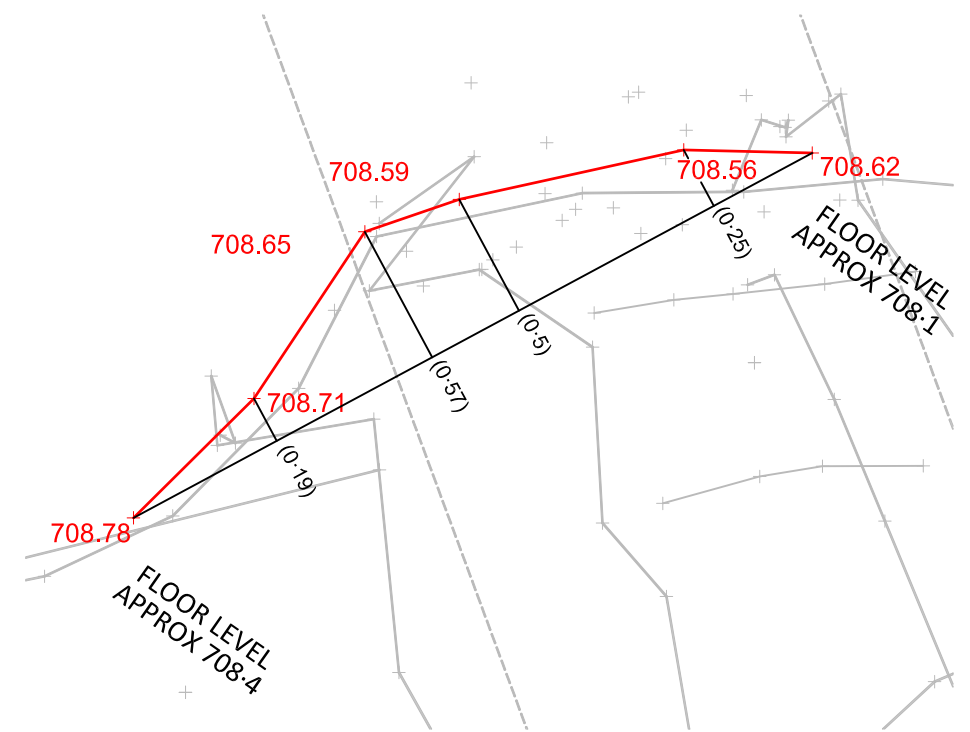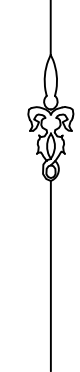


NORTHERN SIDE - LOWER SECTION

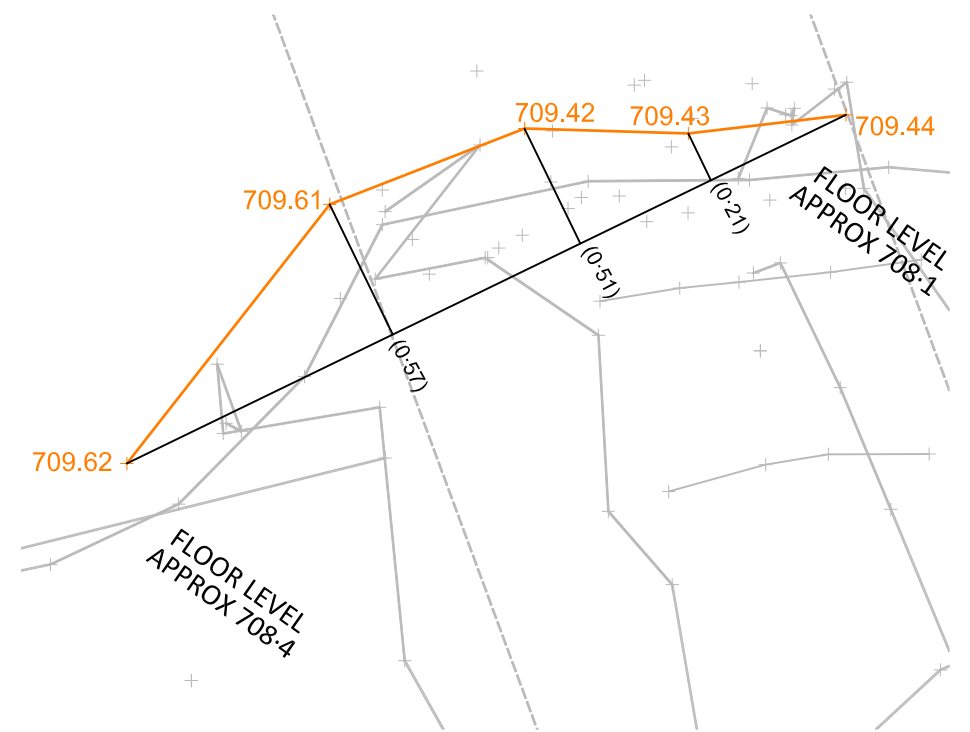


NORTHERN SIDE - MID SECTION

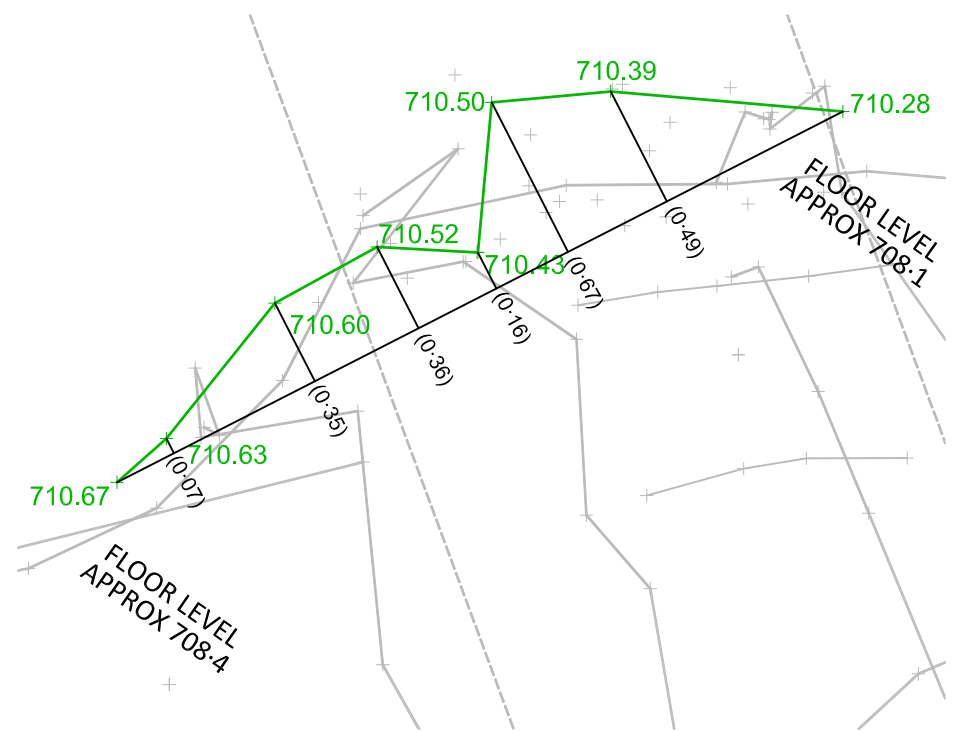


NORTHERN SIDE - HIGHER SECTION

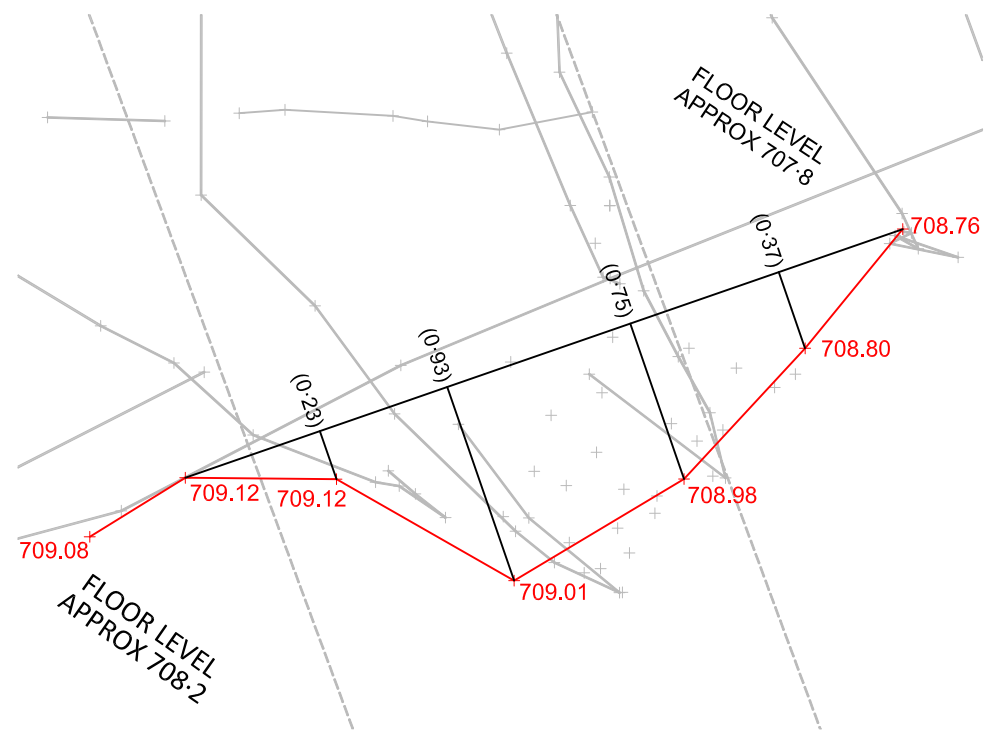

SOUTHERN SIDE - LOWER SECTION

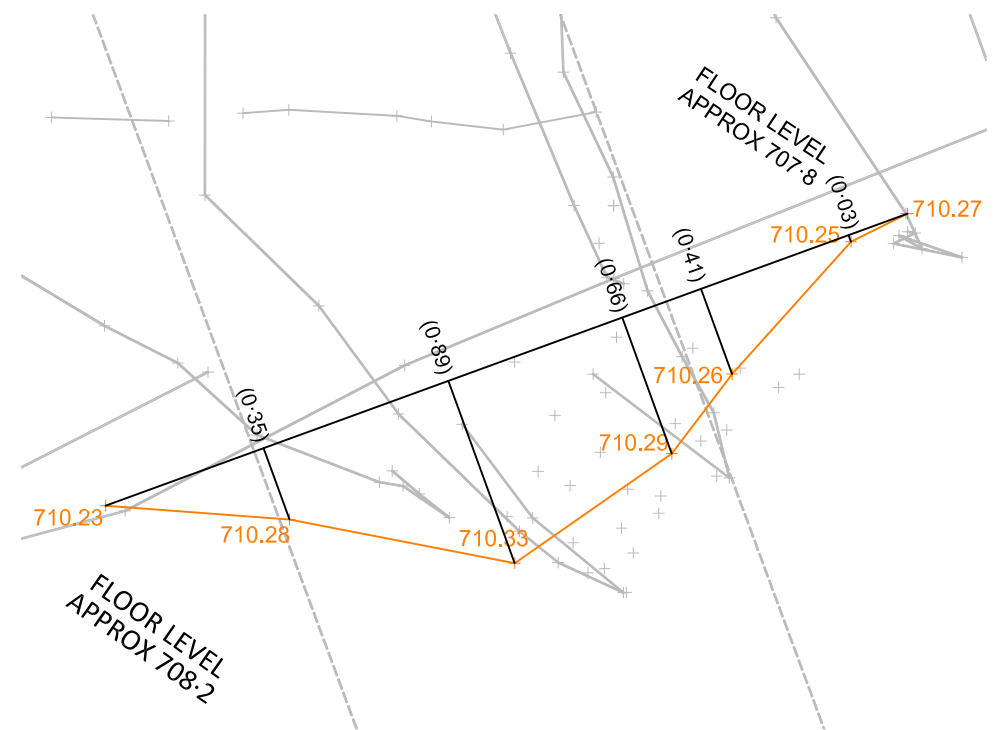

SOUTHERN SIDE - MID SECTION

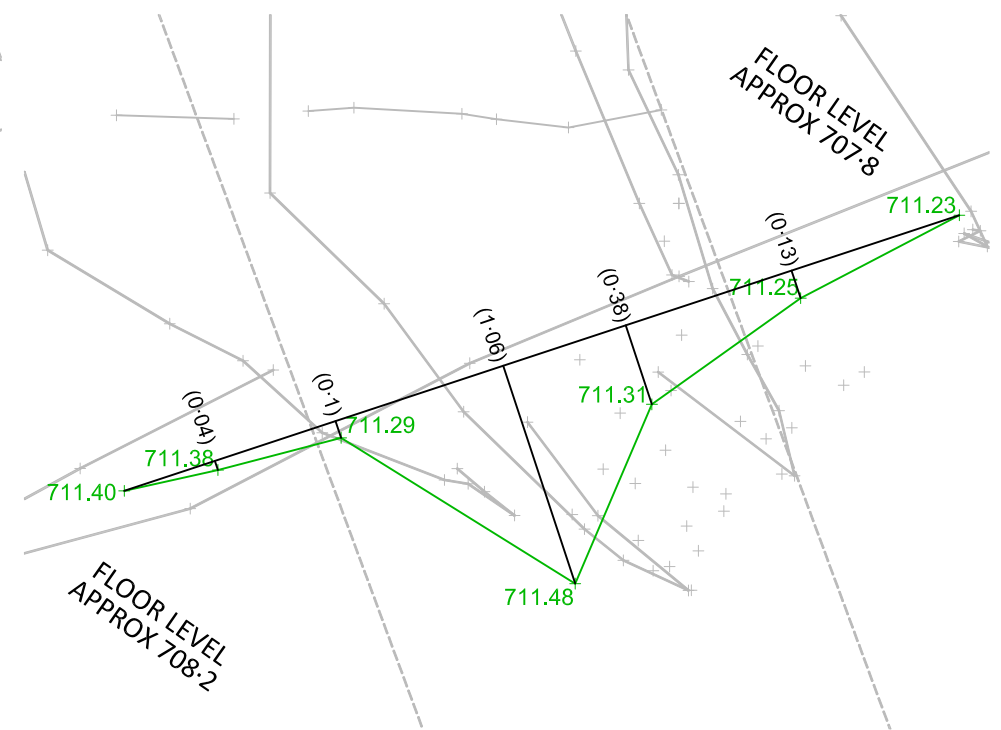

SOUTHERN SIDE - HIGHER SECTION

J:\Surveyors\Jobs\Veolia\16700 Woodlawn Bioreactor\Veolia Southern Portal\Cad\16700-SP3 Key Depth.dwg

ISSUE	AMENDMENT	DATE
A	INITIAL ISSUE	2/08/2013

NOT TO SCALE

Liability limited by a scheme approved under Professional Standards Legislation.

A3 SHEET



LandTeam Australia Pty Ltd  
 ABN 35 300 283 592  
 Goulburn Office  
 36 Montague Street p: (02) 4821 1033  
 Postal: PO Box 1040 f: (02) 4821 7238  
 GOULBURN NSW 2580 e: goulburn@landteam.com.au FS550318

SOUTHERN PORTAL SEALING PROJECT

PLAN VIEW  
 SHOWING SOUTHERN PORTAL SIDE WALL KEYS  
 WOODLAWN BIOREACTOR  
 COLLECTOR ROAD  
 TARAGO


DATUM: AHD | ORIGIN: PILLAR 715 | CONTOUR INTERVAL: N/A

DATE:	2/08/2013
SURVEYED:	SM
DRAWN:	MK
CHECKED:	JK
DRAWING No.	16700-SP3-2
ISSUE	

MGA



Ch 6.978  
 Ch 6.500  
 Ch 6.000  
 Ch 5.500  
 Ch 5.000  
 Ch 4.500  
 Ch 4.000  
 Ch 3.500  
 Ch 3.000  
 Ch 2.500  
 Ch 2.000  
 Ch 1.500  
 Ch 1.000  
 Ch 0.500  
 Ch 0.000

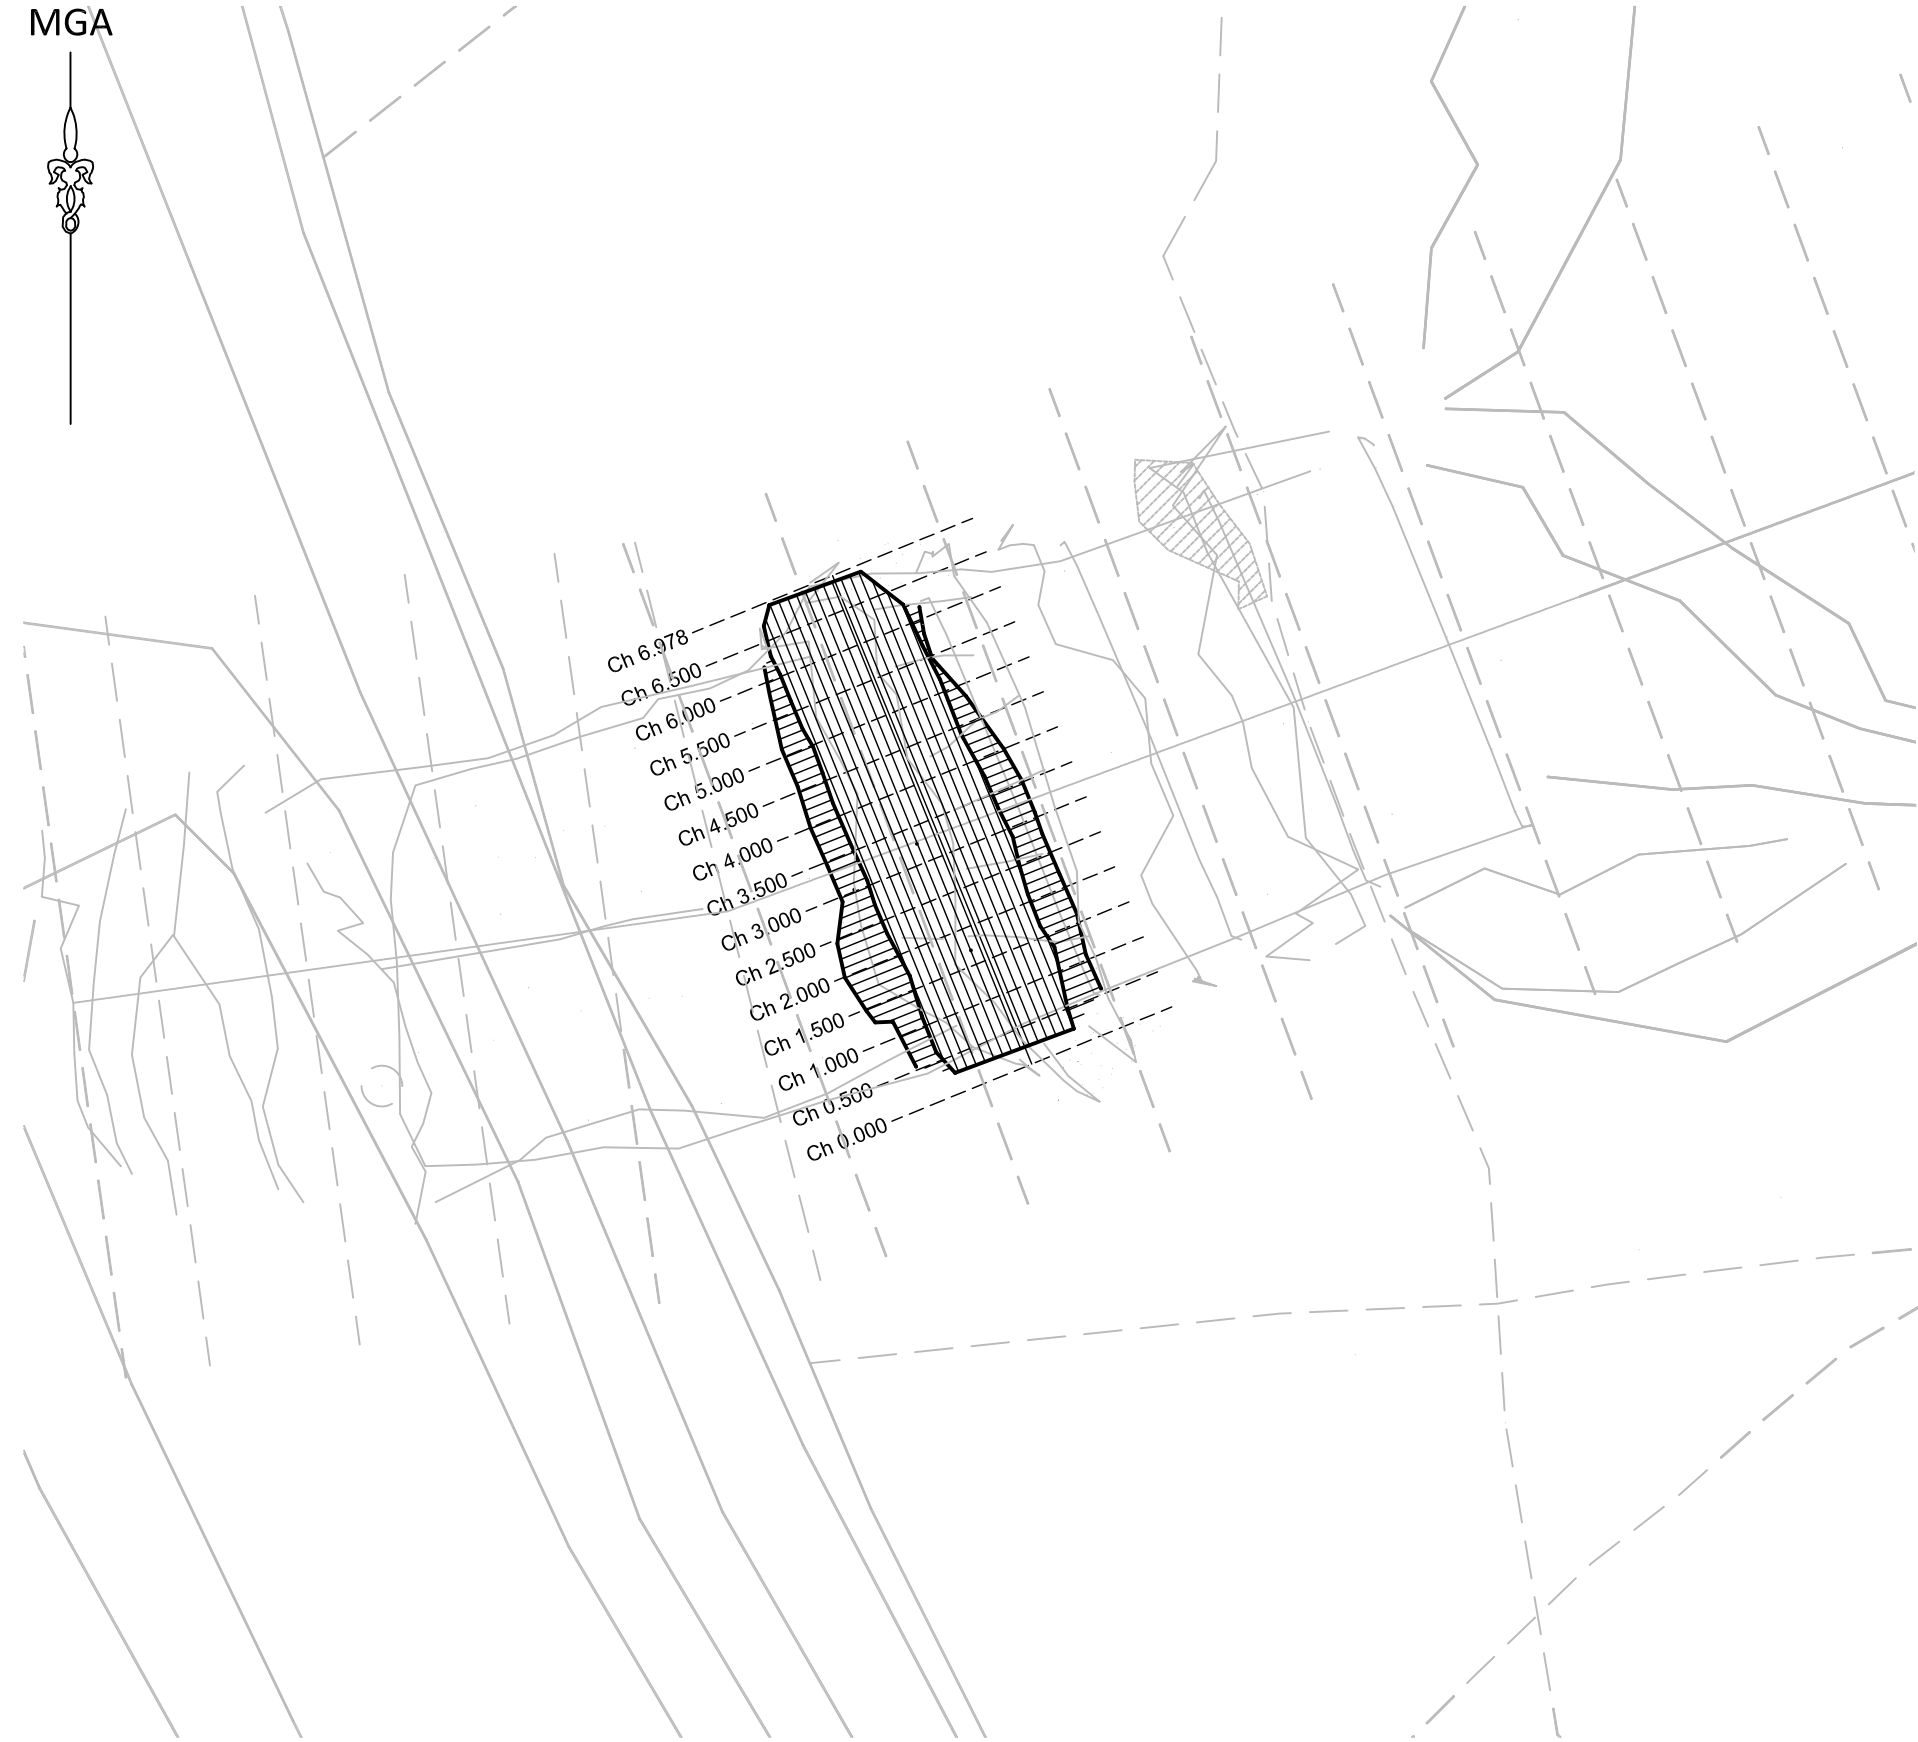

SOUTH EASTERN WALL  
 NORTH WESTERN WALL

DATUM 706.500


KEY IN FLOOR	706.984	706.984	706.951	706.919	706.922	706.923	706.923	706.916	706.923	706.942	706.922	706.911	706.937	707.004	707.013
CHAINAGE	0.245	0.500	1.000	1.500	2.000	2.500	3.000	3.500	4.000	4.500	5.000	5.500	6.000	6.500	6.558

**LONGITUDINAL SECTION OF FLOOR KEY**

SCALE 1:100 HORIZONTAL  
 SCALE 1:10 VERTICAL

J:\Surveyors\Jobs\Veolia\16700 Woodlawn Bioreactor\Veolia Southern Portal\Cad\16700-SP4 - Final Key.dwg

ISSUE	AMENDMENT	DATE
A	INITIAL ISSUE	15/08/2013

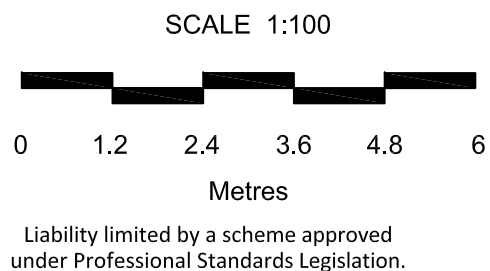

LandTeam Australia Pty Ltd  
 ABN 35 300 283 592  
 Goulburn Office  
 36 Montague Street p: (02) 4821 1033  
 Postal: PO Box 1040 f: (02) 4821 7238  
 GOULBURN NSW 2580 e: goulburn@landteam.com.au FS550318

SOUTHERN PORTAL SEALING PROJECT













PLAN SHOWING  
 CONSTRUCTED KEY IN FLOOR  
 WOODLAWN BIOREACTOR  
 COLLECTOR ROAD, TARAGO

DATUM: AHD | ORIGIN: PILLAR 715 | CONTOUR INTERVAL: N/A

DATE:	15/08/2013
SURVEYED:	MK
DRAWN:	MK
CHECKED:	JK
DRAWING No.	<b>16700-SP4-1</b>


ISSUE  
**A**

 DENOTES AREA OF SOLID ROCK EXCAVATION

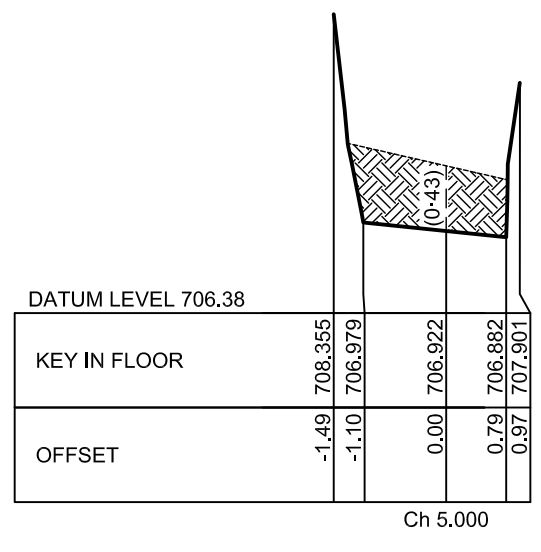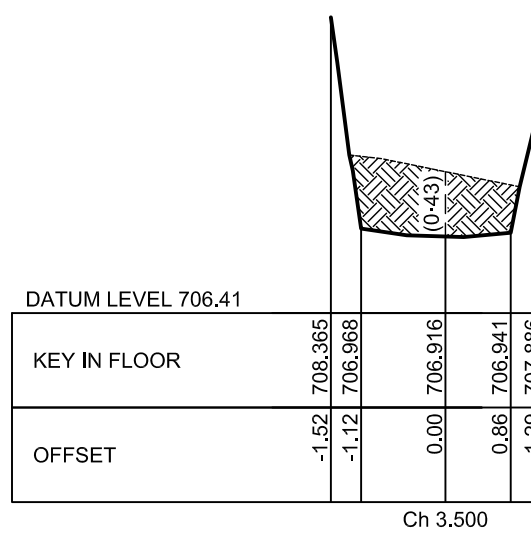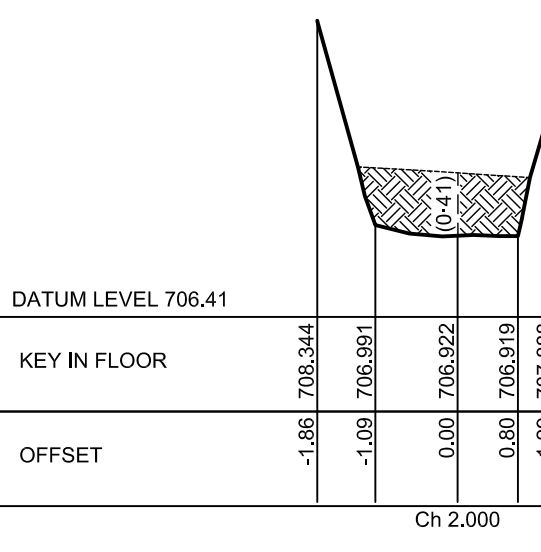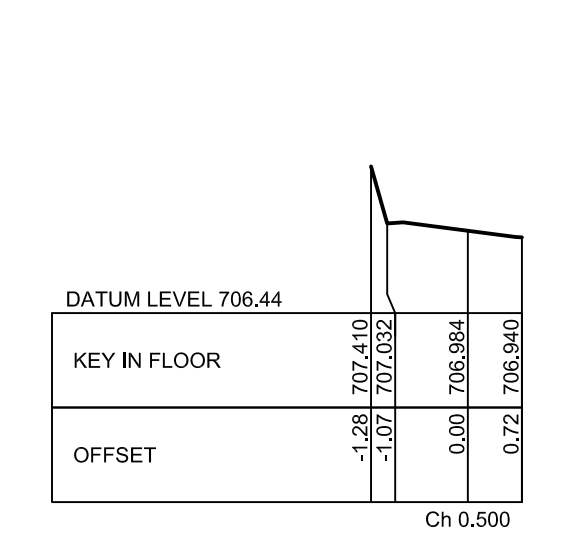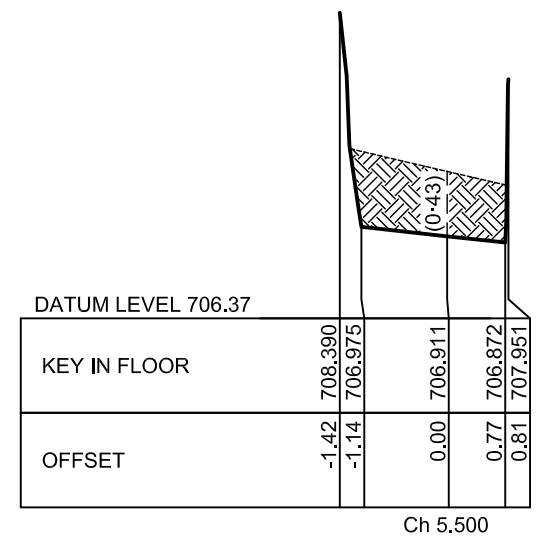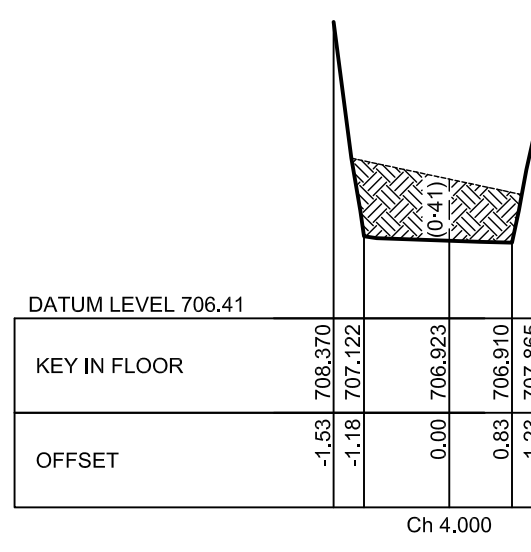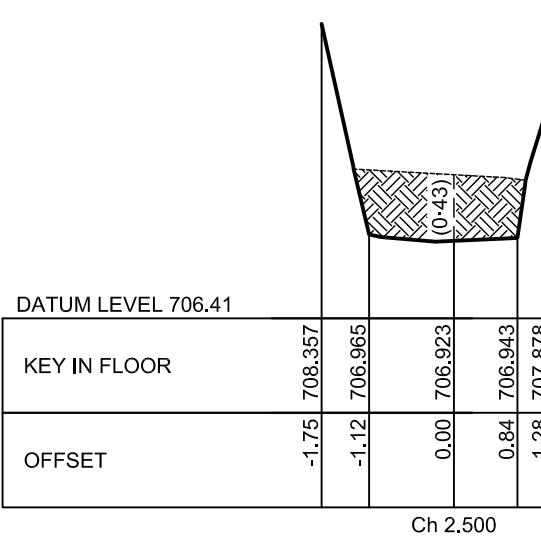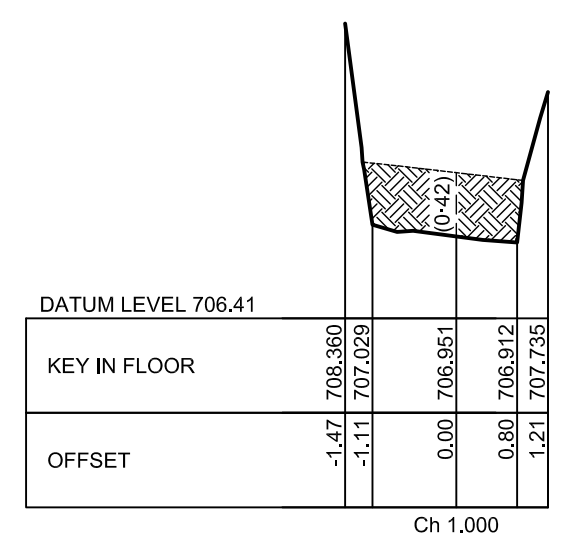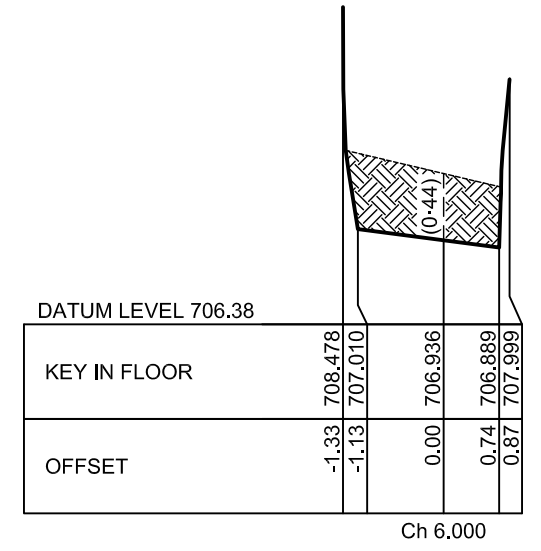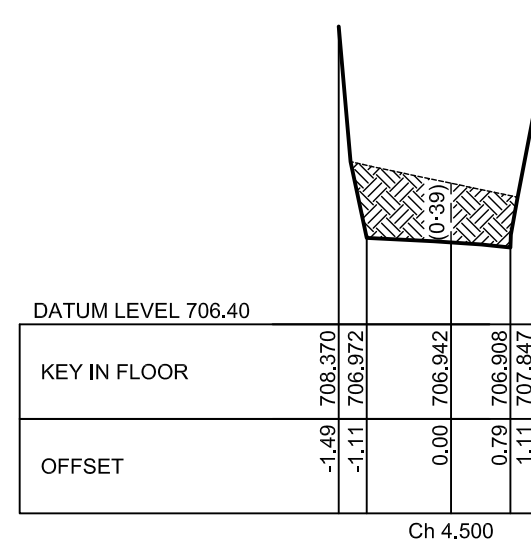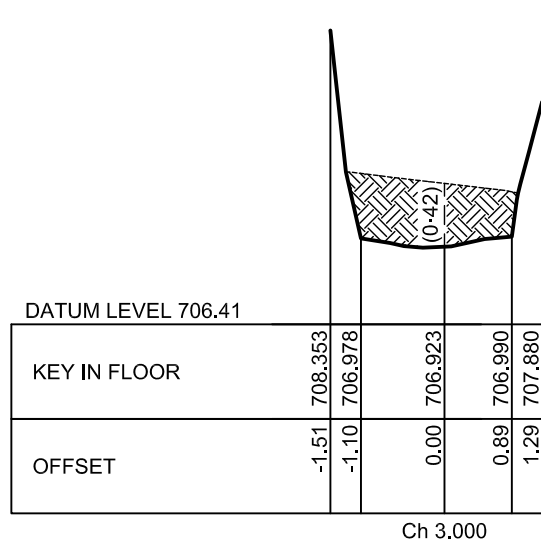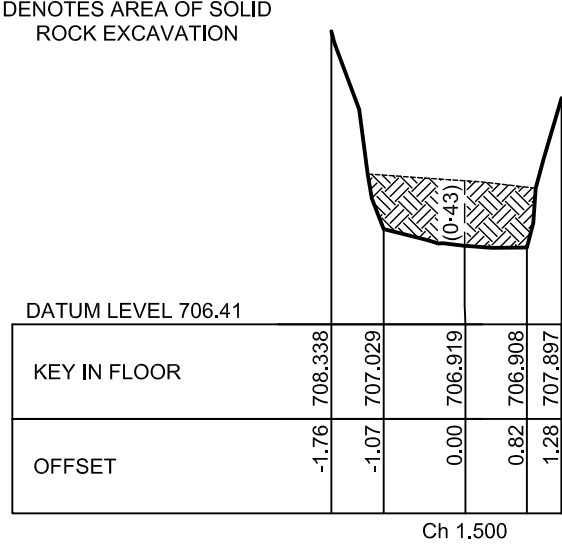

J:\Surveyors\Jobs\Veolia\16700 Woodlawn Bioreactor\Veolia Southern Portal\Cad\16700-SP4 - Final Key.dwg

ISSUE	AMENDMENT	DATE
A	INITIAL ISSUE	15/08/2013

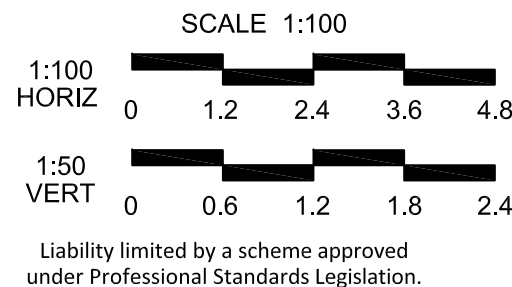














LandTeam Australia Pty Ltd  
 36 Montague Street p: (02) 4821 1033  
 Postal: PO Box 1040 f: (02) 4821 7238  
 GOULBURN NSW 2580 e: goulburn@landteam.com.au FS550318

SOUTHERN PORTAL SEALING PROJECT

PLAN SHOWING  
 CROSS SECTIONS OF CONSTRUCTED KEY IN FLOOR  
 WOODLAWN BIOREACTOR  
 COLLECTOR ROAD, TARAGO

DATUM: AHD | ORIGIN: PILLAR 715 | CONTOUR INTERVAL: N/A

DATE:	15/08/2013	
SURVEYED:	MK	ISSUE
DRAWN:	MK	
CHECKED:	JK	A
DRAWING No.	16700-SP4-2	

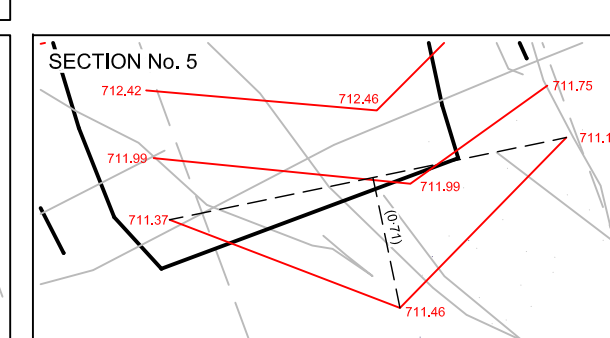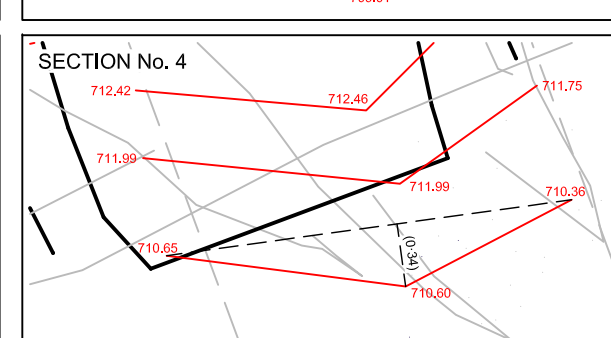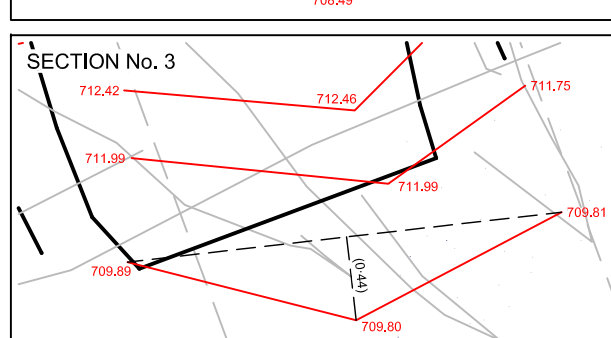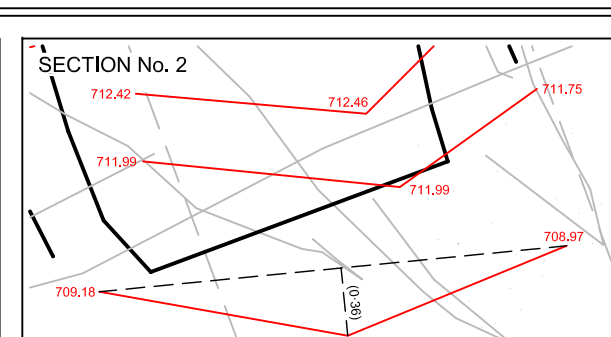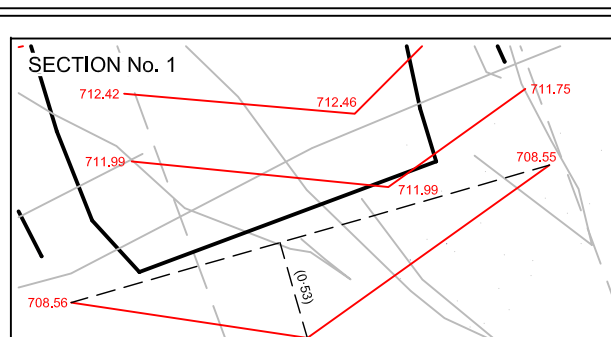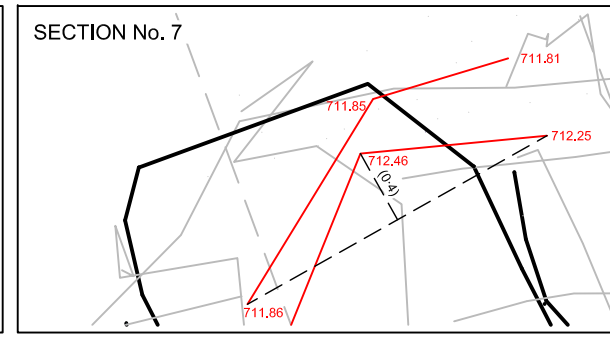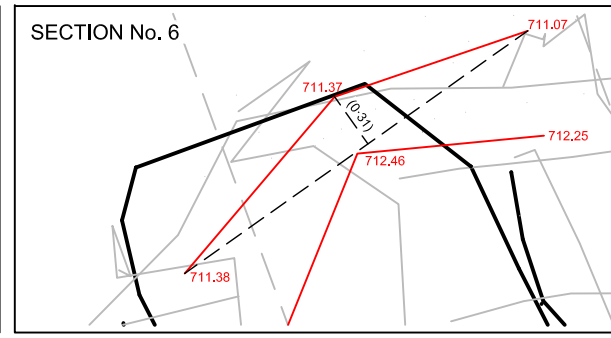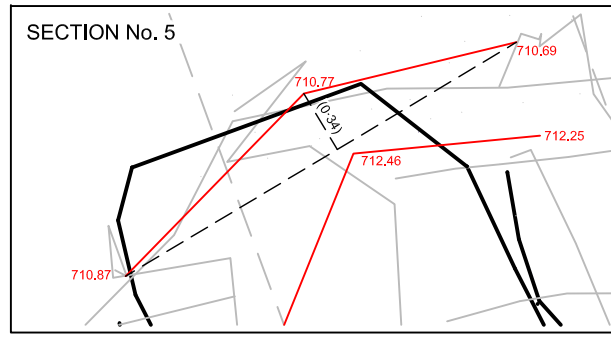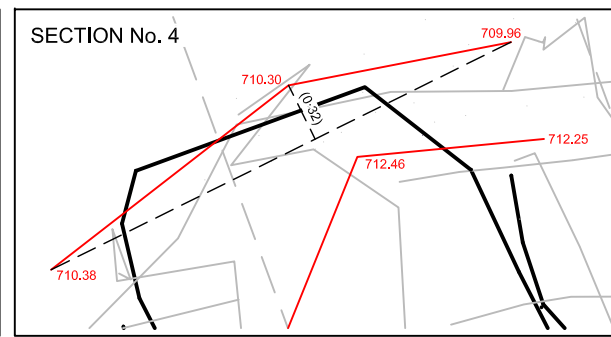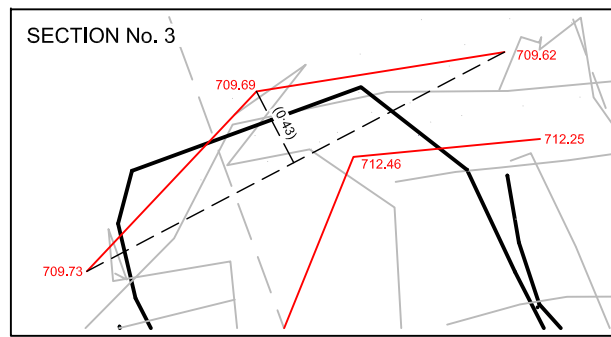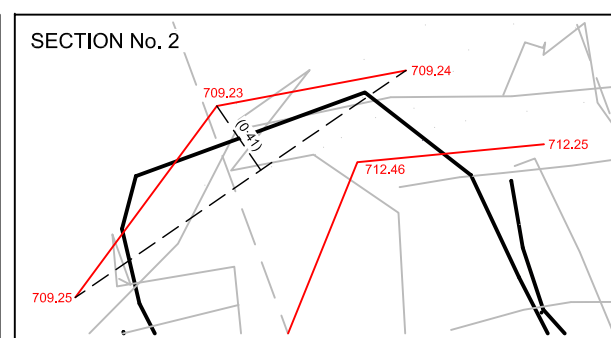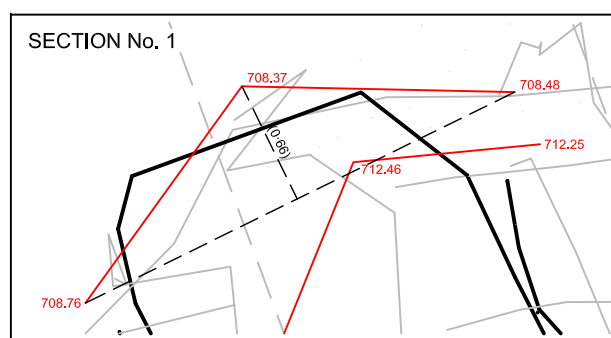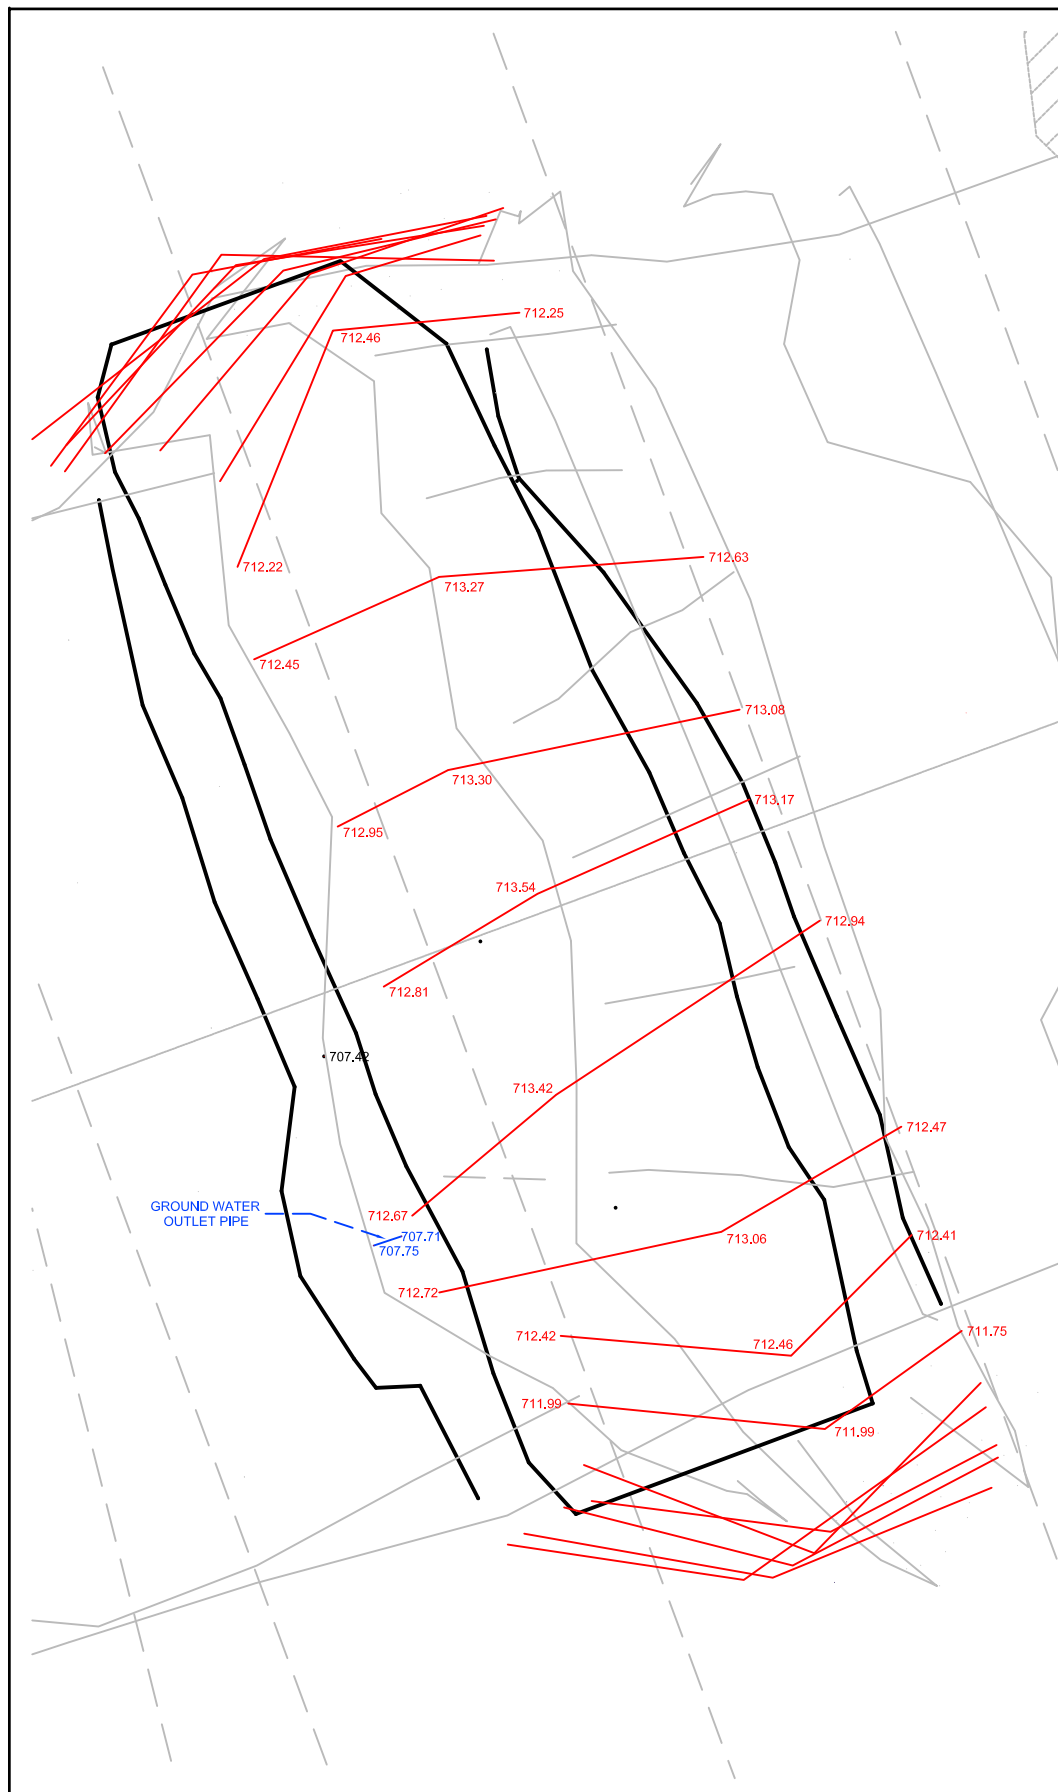

J:\Surveyors\Jobs\Veolia\16700 Woodlawn Bioreactor\Veolia Southern Portal\Cad\16700-SP4 - Final Key.dwg


### NORTH WESTERN WALL SECTIONS

LOWER SECTION No. 1  
HIGHER SECTION No. 7

### SOUTH EASTERN WALL SECTIONS

LOWER SECTION No. 1  
HIGHER SECTION No. 5



ISSUE	AMENDMENT	DATE
A	INITIAL ISSUE	15/08/2013

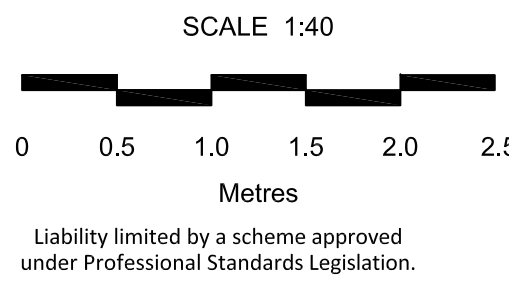

LandTeam Australia Pty Ltd  
ABN 35 300 283 592  
Goulburn Office  
36 Montague Street p: (02) 4821 1033  
Postal: PO Box 1040 f: (02) 4821 7238  
GOULBURN NSW 2580 e: goulburn@landteam.com.au FS550318

SOUTHERN PORTAL SEALING PROJECT		
PLAN SHOWING DETAILS OF KEY IN WALLS & CEILING WOODLAWN BIOREACTOR COLLECTOR ROAD, TARAGO		
DATUM: AHD	ORIGIN: PILLAR 715	CONTOUR INTERVAL: N/A

DATE:	15/08/2013
SURVEYED:	MK
DRAWN:	MK
CHECKED:	JK
DRAWING No.	16700-SP4-3

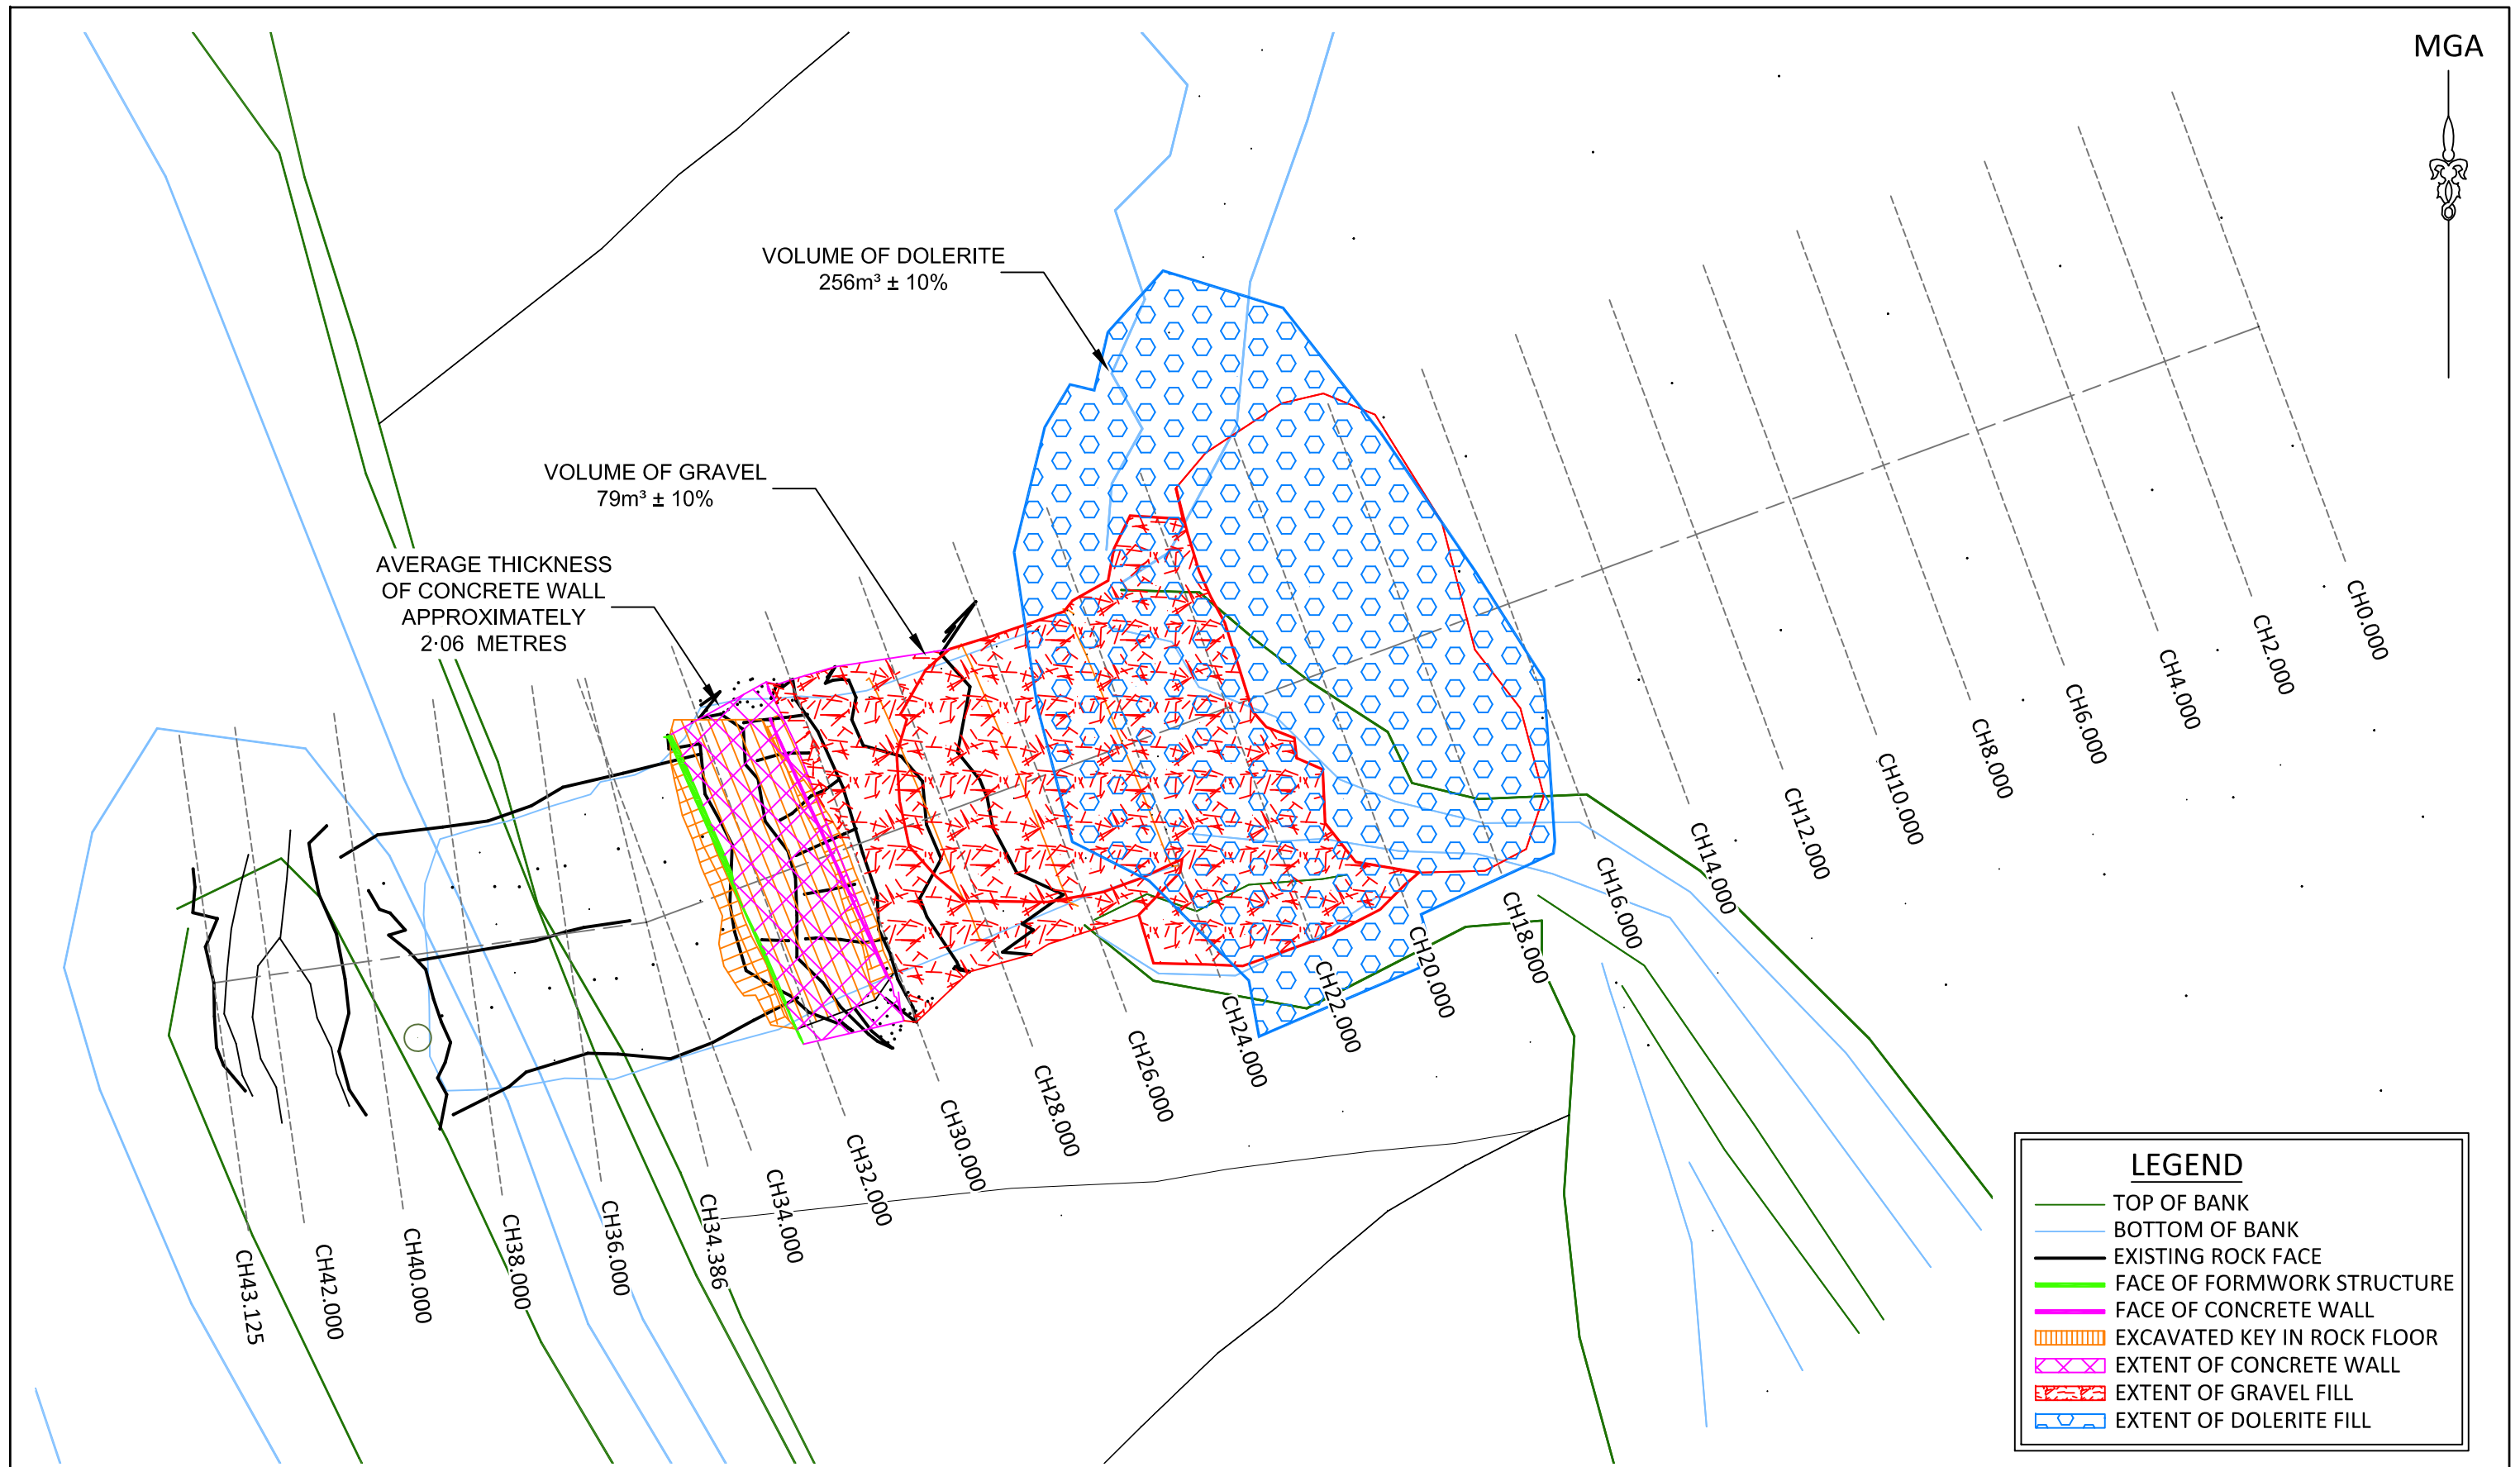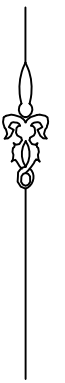

J:\Surveyors\Jobs\Veolia\16700 Woodlawn Bioreactor\Veolia Southern Portal\Cad\16700-SP5 Final Plans.dwg

ISSUE	AMENDMENT	DATE
A	INITIAL ISSUE	18/09/2013

SCALE 1:125

0 2 4 6 8  
Metres

Liability limited by a scheme approved under Professional Standards Legislation.

**A3**  
SHEET

**VEOLIA**  
ENVIRONMENTAL SERVICES

LandTeam Australia Pty Ltd  
ABN 35 300 283 592  
Goulburn Office  
36 Montague Street p: (02) 4821 1033  
Postal: PO Box 1040 f: (02) 4821 7238  
GOULBURN NSW 2580 e: goulburn@landteam.com.au FS550318

**SOUTHERN PORTAL SEALING PROJECT**

PLAN VIEW  
COMPLETED SEALING WORKS OF SOUTHERN PORTAL  
WOODLAWN BIOREACTOR  
COLLECTOR ROAD  
TARAGO

DATUM: AHD | ORIGIN: PILLAR 715 | CONTOUR INTERVAL: N/A

DATE: 18/09/2013


SURVEYED: MK/SH | ISSUE

DRAWN: MK | **A**

CHECKED: JK


DRAWING No.

**16700-SP5-1**

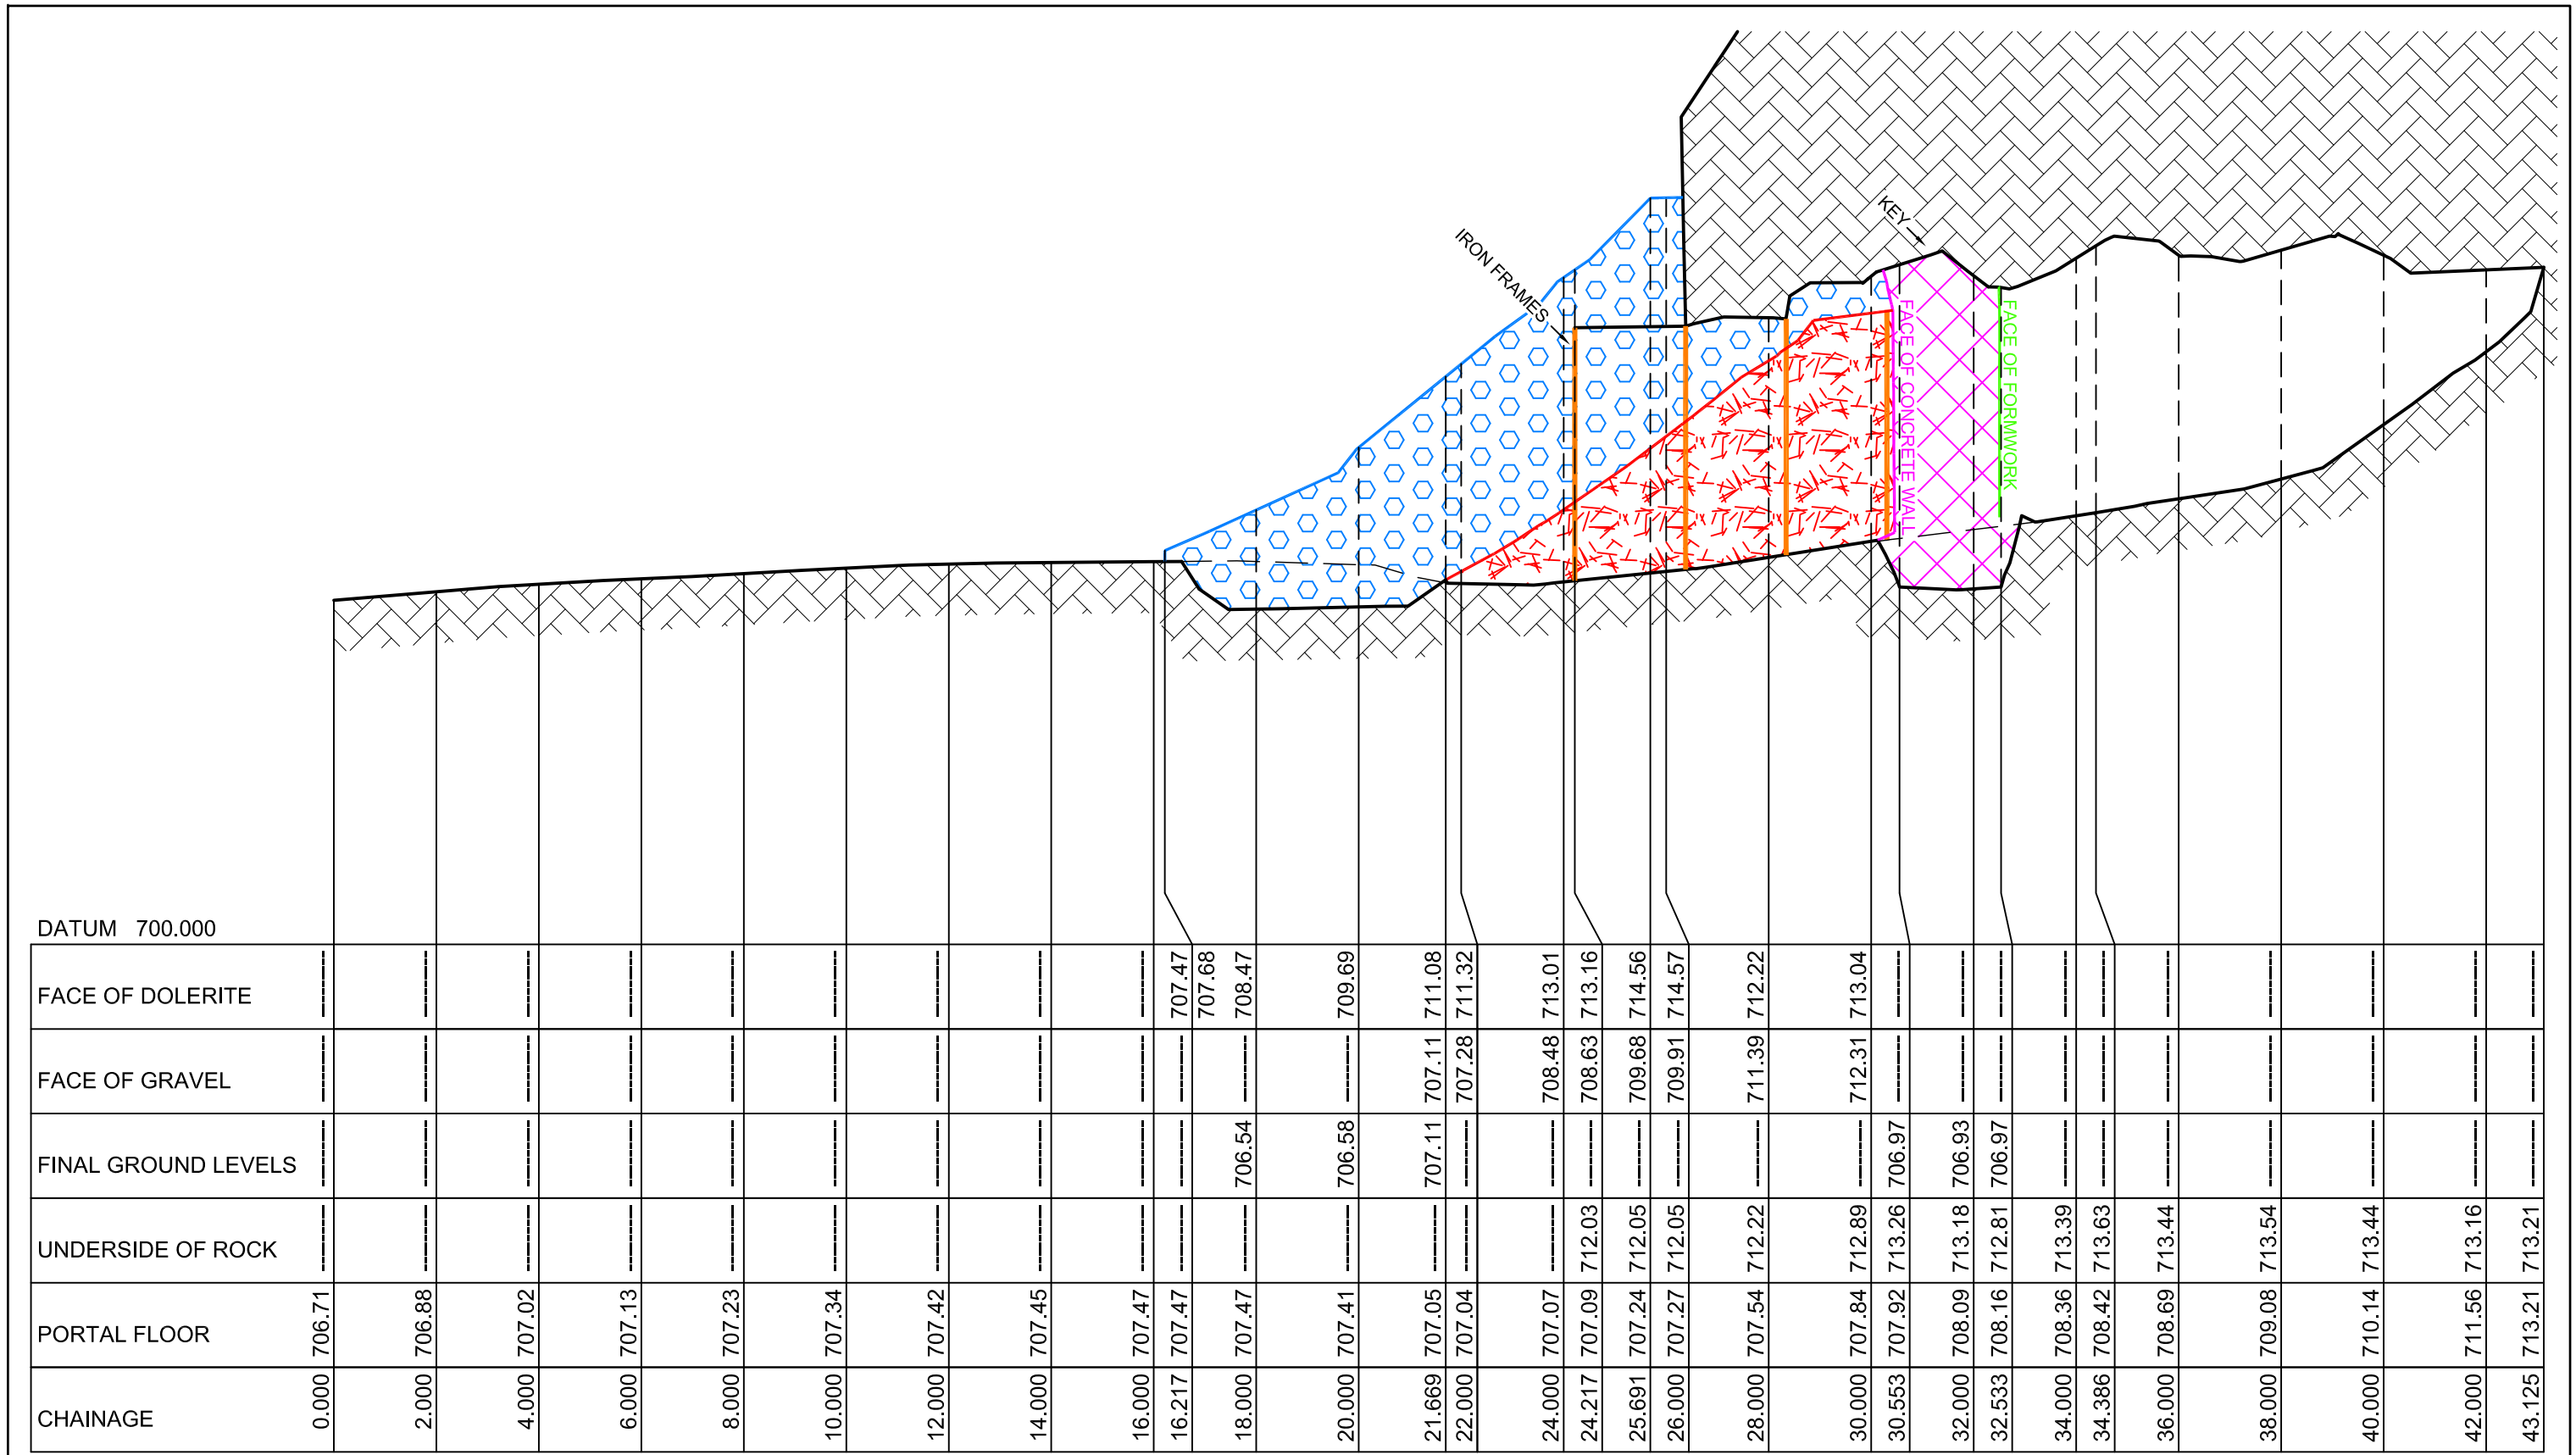

J:\Surveyors\Jobs\Veolia\16700 Woodlawn Bioreactor\Veolia Southern Portal\Cad\16700-SP5 Final Plans.dwg

ISSUE	AMENDMENT	DATE
A	INITIAL ISSUE	18/09/2013

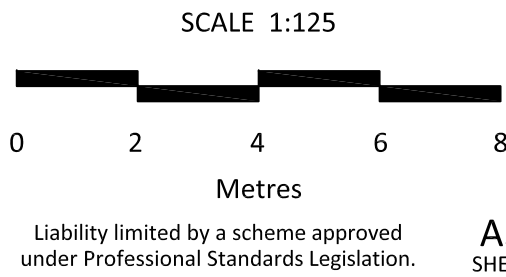

**VEOLIA**  
ENVIRONMENTAL SERVICES

LandTeam Australia Pty Ltd  
ABN 35 300 283 592  
Goulburn Office  
36 Montague Street p: (02) 4821 1033  
Postal: PO Box 1040 f: (02) 4821 7238  
GOULBURN NSW 2580 e: goulburn@landteam.com.au FS550318

**SOUTHERN PORTAL SEALING PROJECT**

LONGITUDINAL SECTION  
COMPLETED SEALING WORKS OF SOUTHERN PORTAL  
WOODLAWN BIOREACTOR  
COLLECTOR ROAD  
TARAGO

DATUM: AHD | ORIGIN: PILLAR 715 | CONTOUR INTERVAL: N/A

DATE: 18/09/2013

SURVEYED: MK/SH

DRAWN: MK

CHECKED: JK

DRAWING No.

**16700-SP5-2**

ISSUE **A**



DATUM 705.41

<u>PORTAL FLOOR</u>	706.67	706.74	706.80	706.87	706.95	707.02	707.10	707.17	707.25	707.33	707.41
OFFSET	-5.00	-4.00	-3.00	-2.00	-1.00	0.00	1.00	2.00	3.00	4.00	5.00

CH4.000

DATUM 705.81

<u>PORTAL FLOOR</u>	707.05	707.10	707.16	707.21	707.28	707.34	707.40	707.46	707.52	707.58	707.64
OFFSET	-5.00	-4.00	-3.00	-2.00	-1.00	0.00	1.00	2.00	3.00	4.00	5.00

CH10.000

DATUM 705.26

<u>PORTAL FLOOR</u>	706.49	706.56	706.64	706.73	706.80	706.88	706.95	707.03	707.11	707.20	707.29
OFFSET	-5.00	-4.00	-3.00	-2.00	-1.00	0.00	1.00	2.00	3.00	4.00	5.00

CH2.000

DATUM 705.68

<u>PORTAL FLOOR</u>	706.92	706.98	707.04	707.10	707.17	707.23	707.30	707.36	707.42	707.48	707.54
OFFSET	-5.00	-4.00	-3.00	-2.00	-1.00	0.00	1.00	2.00	3.00	4.00	5.00

CH8.000

DATUM 705.80

<u>PORTAL FLOOR</u>	706.80	706.86	706.95	707.04	707.13	707.21	707.30	707.39	707.47	707.55
OFFSET	1.19	2.00	3.00	4.00	5.00	6.00	7.00	8.00	9.00	10.00

CH0.000

DATUM 705.55

<u>PORTAL FLOOR</u>	706.79	706.86	706.92	706.99	707.07	707.13	707.20	707.26	707.33	707.41	707.48
OFFSET	-5.00	-4.00	-3.00	-2.00	-1.00	0.00	1.00	2.00	3.00	4.00	5.00

CH6.000

J:\Surveyors\Jobs\Veolia\16700 Woodlawn Bioreactor\Veolia Southern Portal\Cad\16700-SP5 Final Plans.dwg

ISSUE	AMENDMENT	DATE
A	INITIAL ISSUE	18/09/2013

SCALE 1:200

0 3 6 9 12  
Metres

Liability limited by a scheme approved under Professional Standards Legislation.

A3 SHEET

**VEOLIA**  
ENVIRONMENTAL SERVICES

LandTeam Australia Pty Ltd  
ABN 35 300 283 592  
Goulburn Office  
36 Montague Street p: (02) 4821 1033  
Postal: PO Box 1040 f: (02) 4821 7238  
GOULBURN NSW 2580 e: goulburn@landteam.com.au FS550318

**SOUTHERN PORTAL SEALING PROJECT**

CROSS SECTIONS: CH0.000 - CH10.000  
COMPLETED SEALING WORKS OF SOUTHERN PORTAL  
WOODLAWN BIOREACTOR  
COLLECTOR ROAD  
TARAGO

DATUM: AHD | ORIGIN: PILLAR 715 | CONTOUR INTERVAL: N/A

DATE:	18/09/2013
SURVEYED:	MK/SH
DRAWN:	MK
CHECKED:	JK
DRAWING No.	<b>16700-SP5-3</b>

**A**

FILL MATERIAL LEGEND	
	DOLERITE
	GRAVEL
	CONCRETE

DATUM 705.80

<u>PORTAL FLOOR</u>	707.17	707.22	707.28	707.34	707.39	707.45	707.50	707.56	707.61	707.68	707.74
OFFSET	-5.00	-4.00	-3.00	-2.00	-1.00	0.00	1.00	2.00	3.00	4.00	5.00

CH14.000

DATUM 705.89

<u>PORTAL FLOOR</u>	707.11	707.18	707.23	707.29	707.36	707.42	707.48	707.54	707.59	707.66	707.72
OFFSET	-5.00	-4.00	-3.00	-2.00	-1.00	0.00	1.00	2.00	3.00	4.00	5.00

CH12.000

DATUM 705.43

<u>PORTAL FLOOR</u>	707.27	707.19	707.04	706.99	707.36	707.38	707.43	707.47	707.50	707.56	707.61	707.69	707.76	707.77	707.80	707.82	707.85	707.91	707.94
<u>DOLERITE</u>	708.37	708.38	708.42	708.62	708.50	708.44	708.45	708.47	708.50	708.48	708.44	708.46	708.47	708.44	708.33	708.26			
<u>FINISHED FLOOR</u>		707.00	706.58		706.58	706.58	706.55	706.54	706.55	706.55	706.51	706.46	706.72	706.83					
OFFSET	-5.08	-5.00	-4.81	-4.00	-3.00	-2.00	-1.00	0.00	1.00	2.00	3.00	4.00	5.00	5.21	6.00	6.55	7.00	8.00	8.51

CH18.000

DATUM 705.95

<u>PORTAL FLOOR</u>	706.98	707.27	707.30	707.34	707.35	707.41	707.47	707.52	707.58	707.63	707.69	707.74
<u>DOLERITE</u>				707.63	707.61	707.58						
OFFSET	-5.00	-4.00	-3.00	-2.14	-2.00	-1.01	0.00	1.00	2.00	3.00	4.00	5.00

CH16.000

J:\Surveyors\Jobs\Veolia\16700 Woodlawn Bioreactor\Veolia Southern Portal\Cad\16700-SP5 Final Plans.dwg

ISSUE	AMENDMENT	DATE
A	INITIAL ISSUE	18/09/2013

SCALE 1:200

0 3 6 9 12  
Metres

Liability limited by a scheme approved under Professional Standards Legislation.

A3 SHEET

**VEOLIA**  
ENVIRONMENTAL SERVICES

LandTeam Australia Pty Ltd  
ABN 35 300 283 592  
Goulburn Office  
36 Montague Street p: (02) 4821 1033  
Postal: PO Box 1040 f: (02) 4821 7238  
GOULBURN NSW 2580 e: goulburn@landteam.com.au FS550318

**SOUTHERN PORTAL SEALING PROJECT**

CROSS SECTIONS: CH12.000 - CH18.000  
COMPLETED SEALING WORKS OF SOUTHERN PORTAL  
WOODLAWN BIOREACTOR  
COLLECTOR ROAD  
TARAGO



DATUM: AHD | ORIGIN: PILLAR 715 | CONTOUR INTERVAL: N/A

DATE:	18/09/2013
SURVEYED:	MK/SH
DRAWN:	MK
CHECKED:	JK
DRAWING No.	16700-SP5-4

A


**FILL MATERIAL LEGEND**

	DOLERITE
	GRAVEL
	CONCRETE

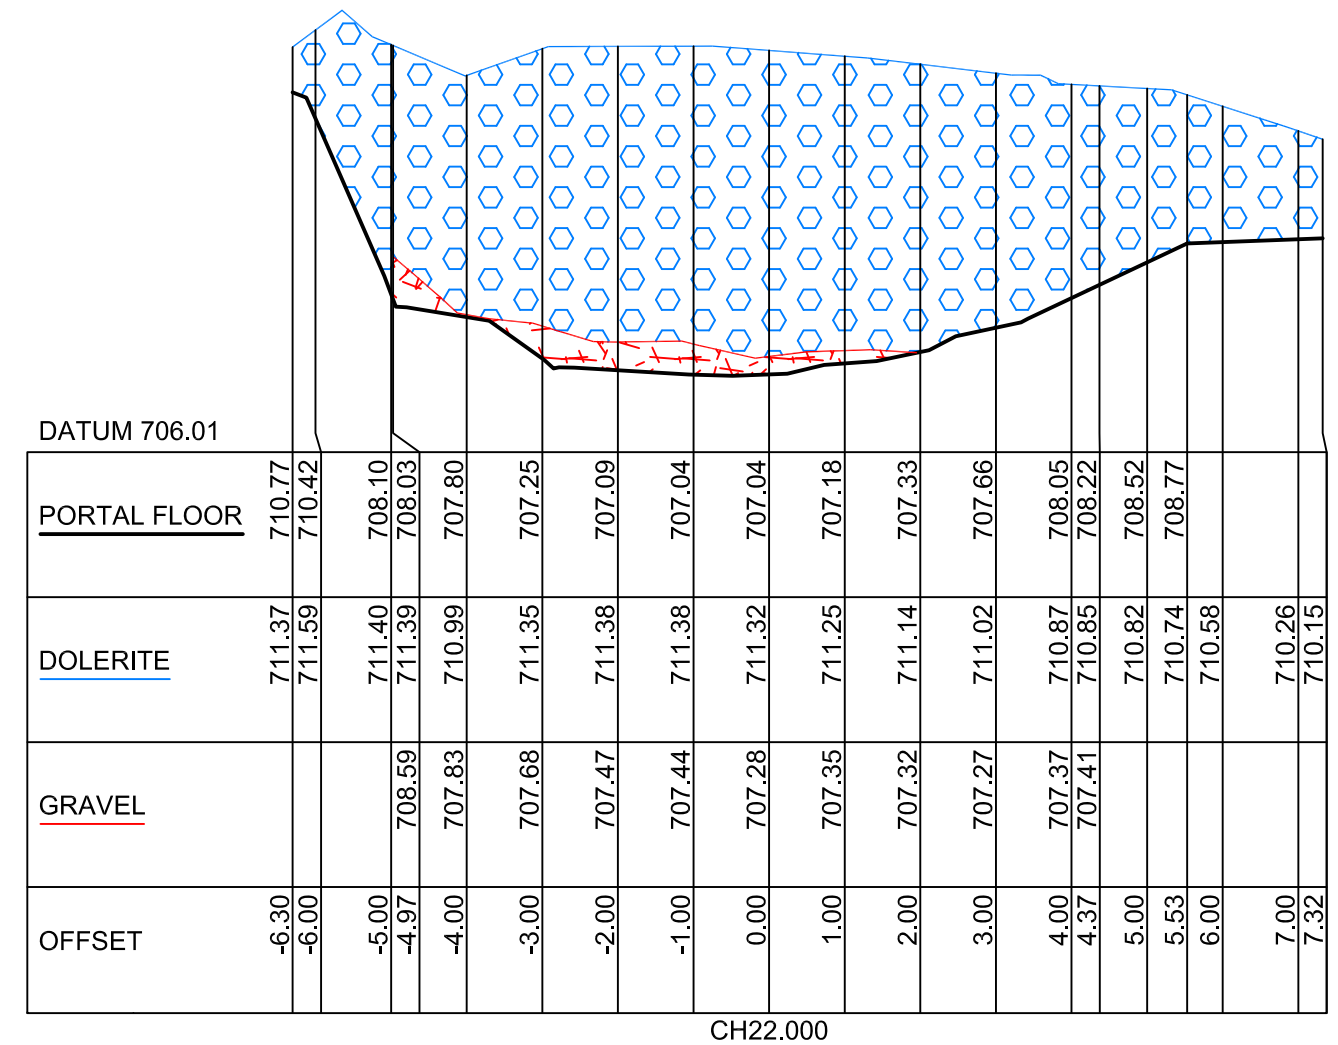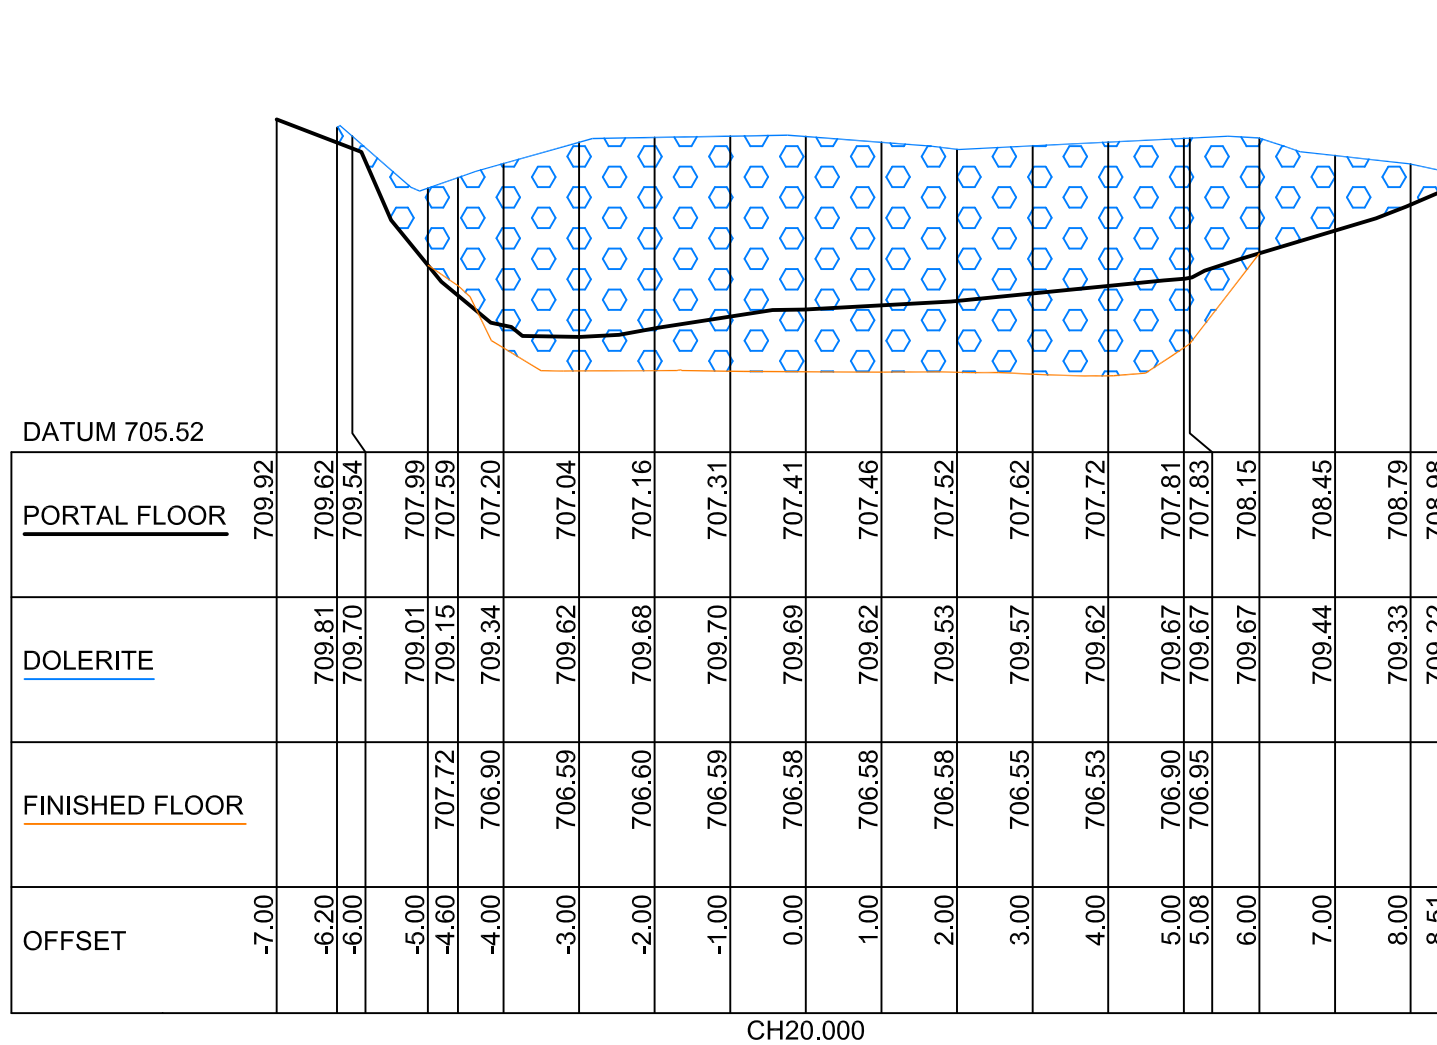

J:\Surveyors\Jobs\Veolia\16700 Woodlawn Bioreactor\Veolia Southern Portal\Cad\16700-SP5 Final Plans.dwg

ISSUE	AMENDMENT	DATE
A	INITIAL ISSUE	18/09/2013

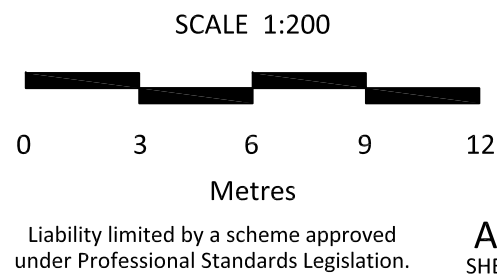



**LandTeam Australia Pty Ltd**  
ABN 35 300 283 592  
 Goulburn Office  
 36 Montague Street p: (02) 4821 1033  
 Postal: PO Box 1040 f: (02) 4821 7238  
 GOULBURN NSW 2580 e: goulburn@landteam.com.au FS550318

SOUTHERN PORTAL SEALING PROJECT		
CROSS SECTIONS: CH20.000 - CH22.000 COMPLETED SEALING WORKS OF SOUTHERN PORTAL WOODLAWN BIOREACTOR COLLECTOR ROAD TARAGO		
DATUM: AHD	ORIGIN: PILLAR 715	CONTOUR INTERVAL: N/A

DATE:	18/09/2013
SURVEYED:	MK/SH
DRAWN:	MK
CHECKED:	JK
DRAWING No.	16700-SP5-5


A

FILL MATERIAL LEGEND	
	DOLERITE
	GRAVEL
	CONCRETE

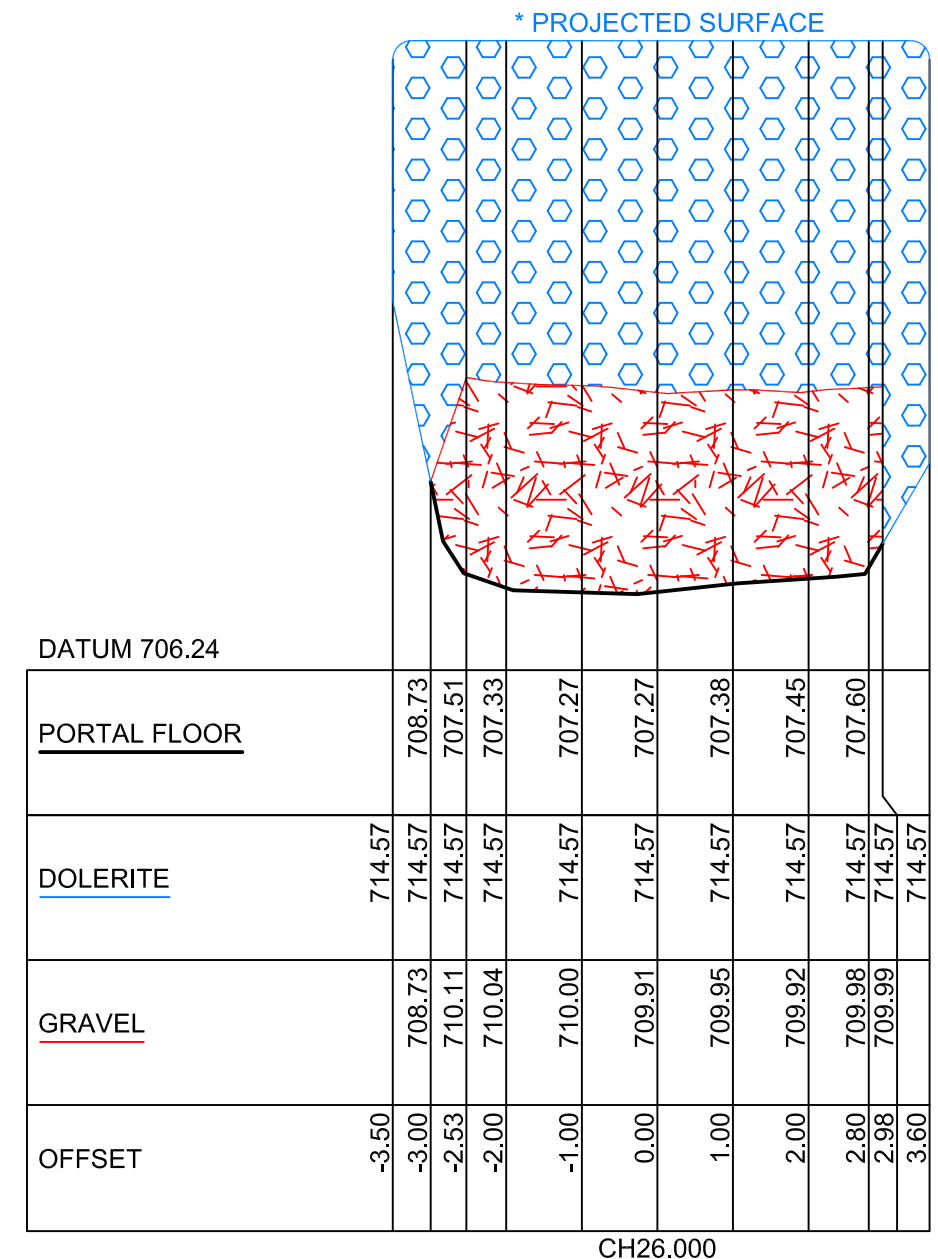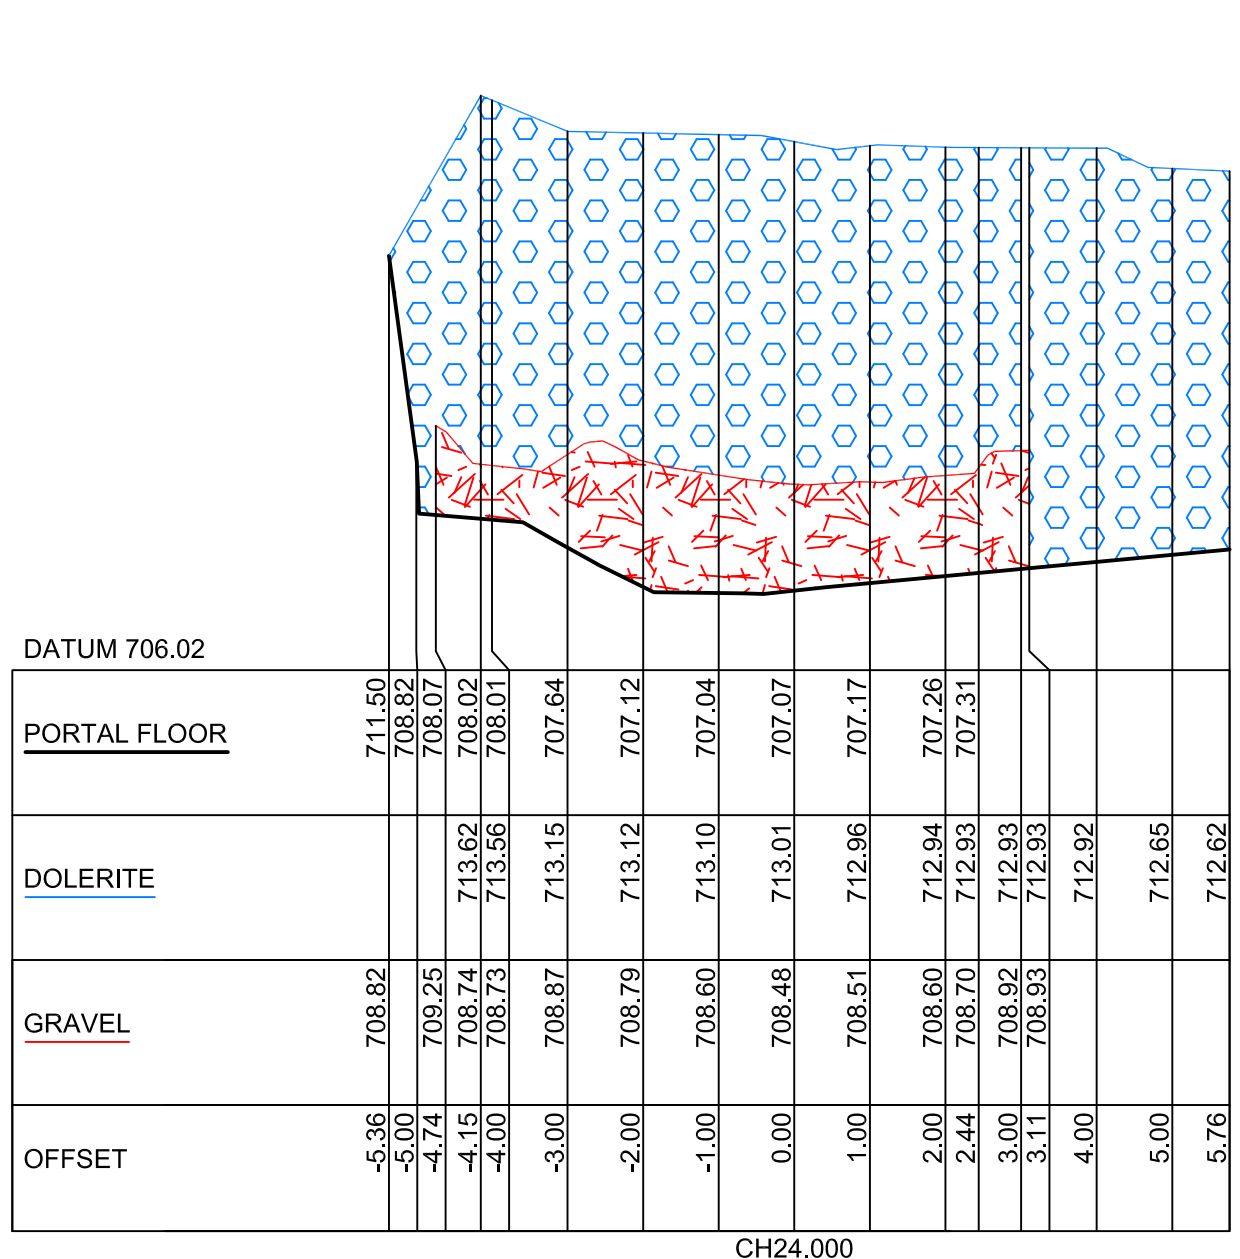

J:\Surveyors\Jobs\Veolia\16700 Woodlawn Bioreactor\Veolia Southern Portal\Cad\16700-SP5 Final Plans.dwg

ISSUE	AMENDMENT	DATE
A	INITIAL ISSUE	18/09/2013

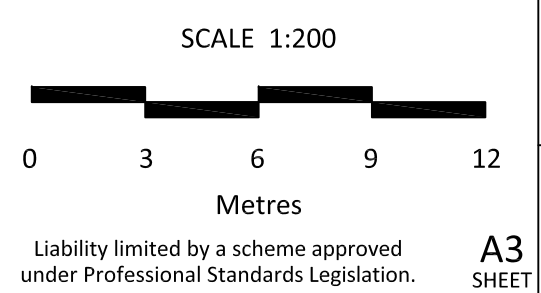

LandTeam Australia Pty Ltd  
 ABN 35 300 283 592  
 Goulburn Office  
 36 Montague Street p: (02) 4821 1033  
 Postal: PO Box 1040 f: (02) 4821 7238  
 GOULBURN NSW 2580 e: goulburn@landteam.com.au FS550318


**SOUTHERN PORTAL SEALING PROJECT**

CROSS SECTIONS: CH24.000 - CH26.000  
 COMPLETED SEALING WORKS OF SOUTHERN PORTAL  
 WOODLAWN BIOREACTOR  
 COLLECTOR ROAD  
 TARAGO

DATUM: AHD    ORIGIN: PILLAR 715    CONTOUR INTERVAL: N/A


DATE:	18/09/2013
SURVEYED:	MK/SH
DRAWN:	MK
CHECKED:	JK
DRAWING No.	A
<b>16700-SP5-6</b>	

FILL MATERIAL LEGEND	
	DOLERITE
	GRAVEL
	CONCRETE

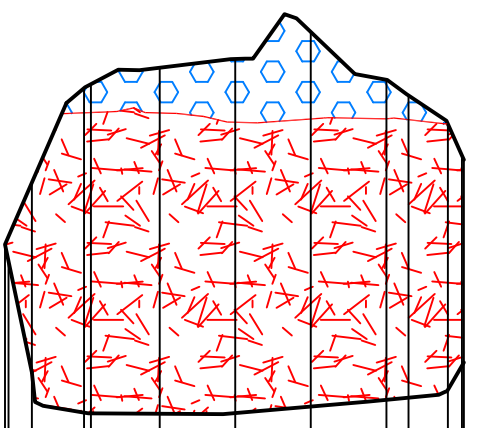


DATUM 706.52	
<u>PORTAL FLOOR</u>	708.08 707.55 707.54 707.53 707.54 707.63 707.72 707.74 707.85
<u>UNDERSIDE OF ROCK</u>	709.77 709.55 710.59 711.84 711.89 712.11 712.22 712.58 711.95 711.74 711.36 710.94 710.89
<u>GRAVEL</u>	
<u>OFFSET</u>	-3.05 -3.00 -2.69 -2.00 -1.91 -1.00 0.00 1.00 2.00 2.29 2.81 3.00 3.02

CH28.000

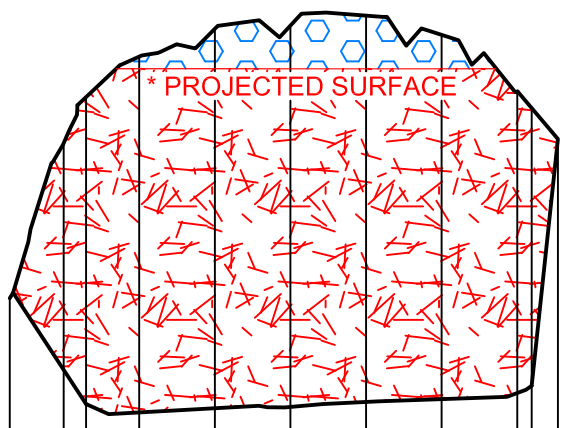

DATUM 706.74	
<u>PORTAL FLOOR</u>	707.88 707.77 707.82 707.84 707.91 707.94 708.02 708.12
<u>UNDERSIDE OF ROCK</u>	709.28 711.33 711.94 712.47 712.84 712.89 713.02 712.76 712.01 711.79 711.38
<u>GRAVEL</u>	
<u>OFFSET</u>	-3.71 -3.00 -2.70 -2.00 -1.00 0.00 1.00 2.00 3.00 3.19 3.54

CH30.000

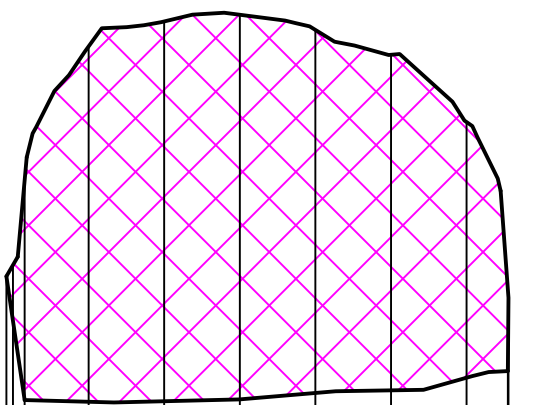


DATUM 707.05	
<u>PORTAL FLOOR</u>	708.08 708.06 708.07 708.09 708.18 708.21 708.38 708.47 708.44
<u>UNDERSIDE OF ROCK</u>	709.72 709.87 710.99 712.76 713.09 713.18 712.98 712.65 711.76 708.47 709.44
<u>GRAVEL</u>	
<u>OFFSET</u>	-3.09 -3.00 -2.85 -2.00 -1.00 0.00 1.00 2.00 3.00 3.55 3.55

CH32.000

J:\Surveyors\Jobs\Veolia\16700 Woodlawn Bioreactor\Veolia Southern Portal\Cad\16700-SP5 Final Plans.dwg

ISSUE	AMENDMENT	DATE
A	INITIAL ISSUE	18/09/2013

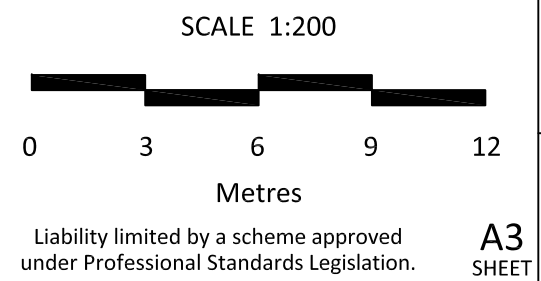

**VEOLIA**  
ENVIRONMENTAL SERVICES

LandTeam Australia Pty Ltd  
ABN 35 300 283 592  
Goulburn Office  
36 Montague Street p: (02) 4821 1033  
Postal: PO Box 1040 f: (02) 4821 7238  
GOULBURN NSW 2580 e: goulburn@landteam.com.au FS550318


**SOUTHERN PORTAL SEALING PROJECT**

CROSS SECTIONS: CH28.000 - CH32.000  
COMPLETED SEALIG WORKS OF SOUTHERN PORTAL  
WOODLAWN BIOREACTOR  
COLLECTOR ROAD  
TARAGO


DATUM: AHD | ORIGIN: PILLAR 715 | CONTOUR INTERVAL: N/A

DATE:	18/09/2013
SURVEYED:	MK/SH
DRAWN:	MK
CHECKED:	JK
DRAWING No.	16700-SP5-7


A

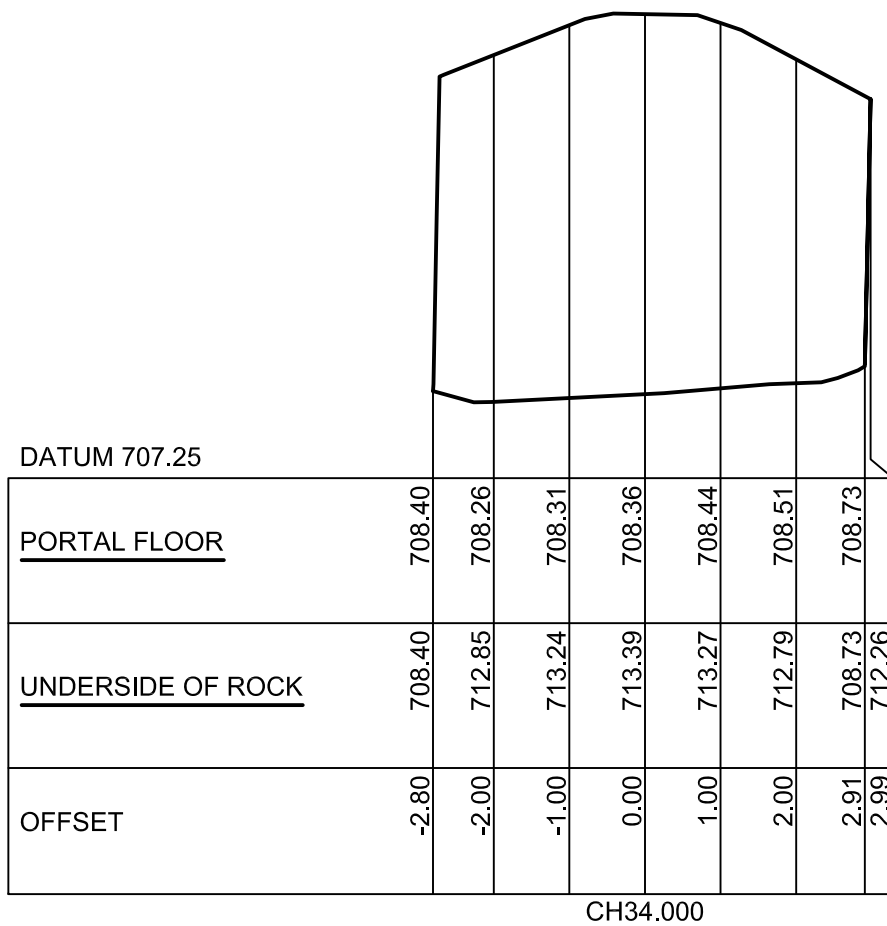

CH34.000

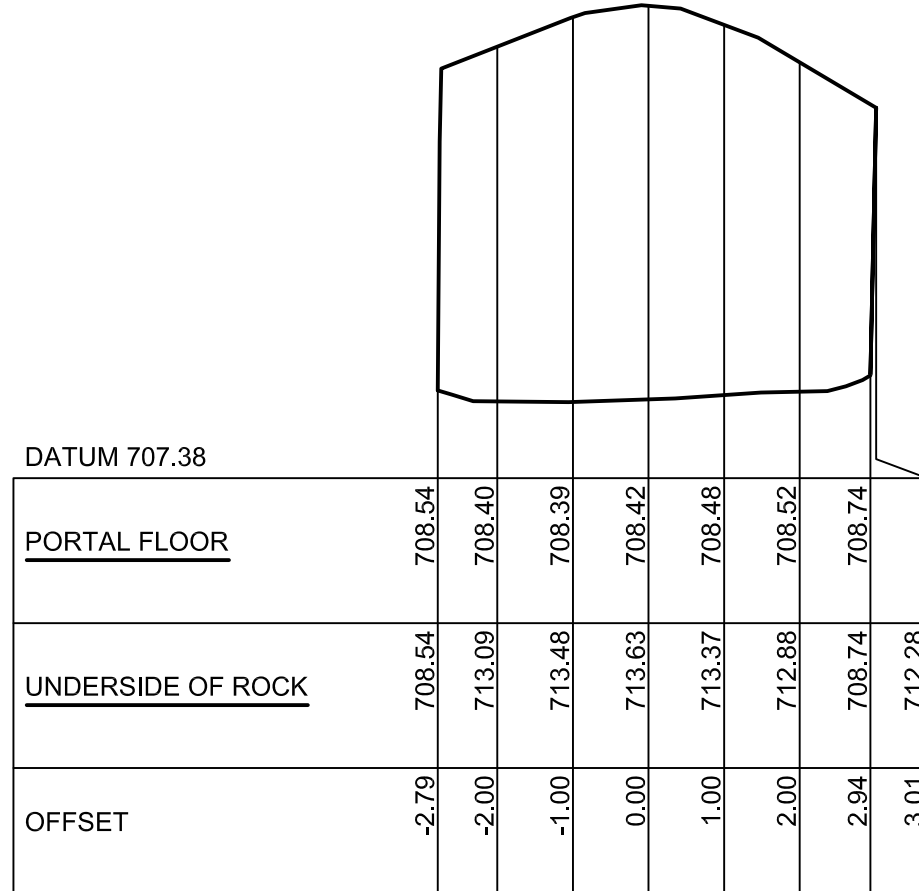


CH34.386

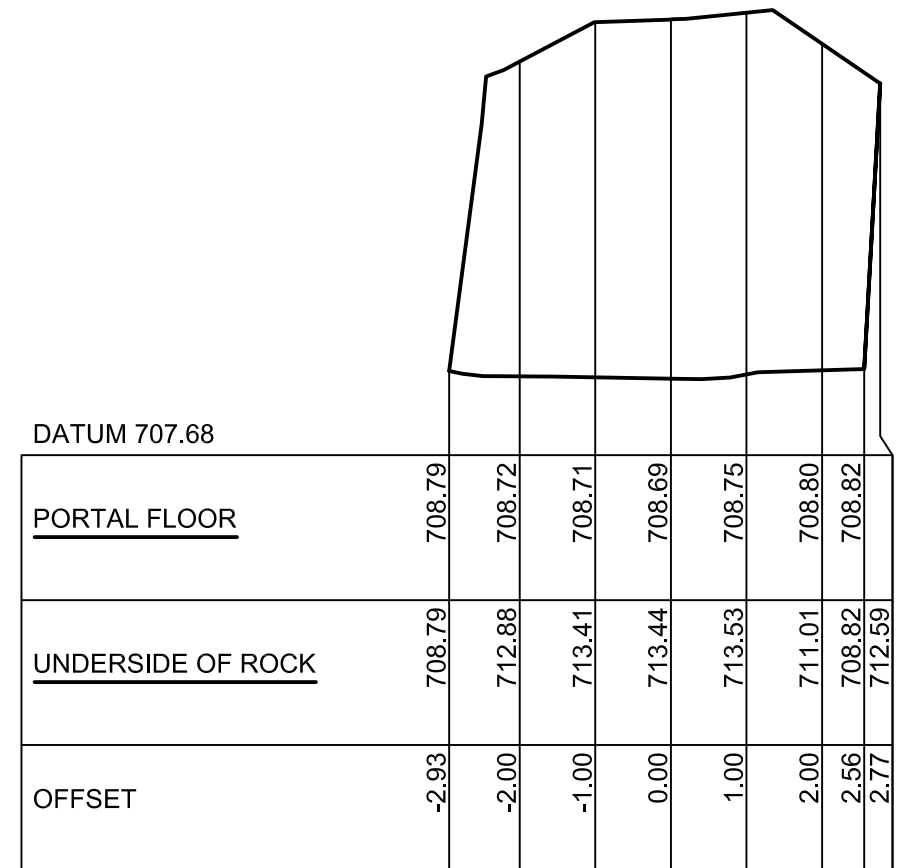

CH36.000

J:\Surveyors\Jobs\Veolia\16700 Woodlawn Bioreactor\Veolia Southern Portal\Cad\16700-SP5 Final Plans.dwg

ISSUE	AMENDMENT	DATE
A	INITIAL ISSUE	18/09/2013

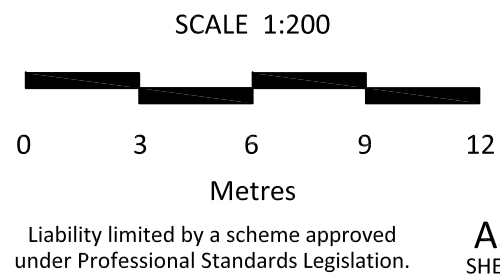





A3 SHEET



LandTeam Australia Pty Ltd  
 ABN 35 300 283 592  
 Goulburn Office  
 36 Montague Street p: (02) 4821 1033  
 Postal: PO Box 1040 f: (02) 4821 7238  
 GOULBURN NSW 2580 e: goulburn@landteam.com.au FS550318


SOUTHERN PORTAL SEALING PROJECT		
CROSS SECTIONS: CH34.000 - CH36.000 COMPLETED SEALING WORKS OF SOUTHERN PORTAL WOODLAWN BIOREACTOR COLLECTOR ROAD TARAGO		
DATUM: AHD	ORIGIN: PILLAR 715	CONTOUR INTERVAL: N/A

DATE: 18/09/2013	ISSUE <b>A</b>
SURVEYED: MK/SH	
DRAWN: MK	DRAWING No. <b>16700-SP5-8</b>
CHECKED: JK	
DRAWING No.	

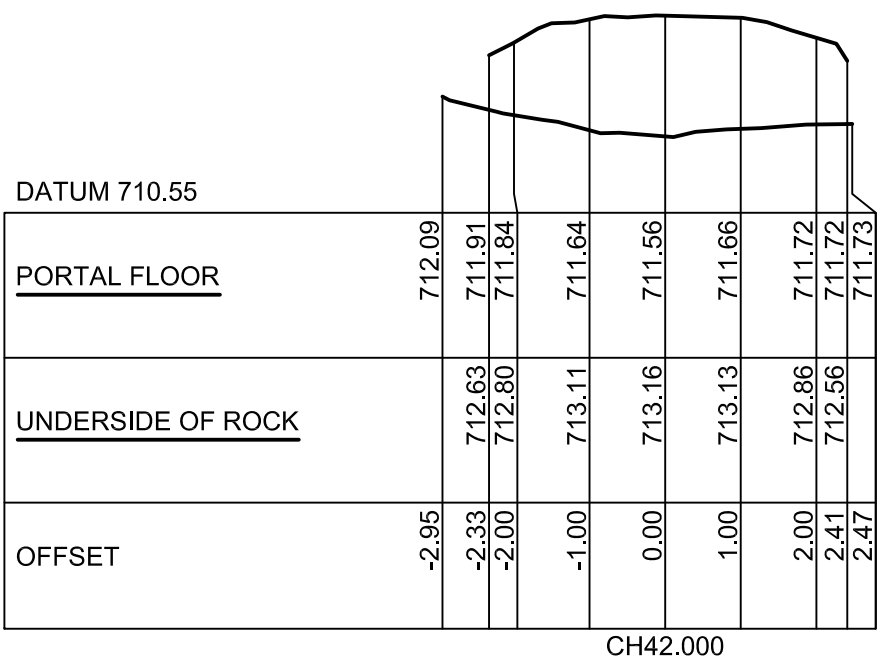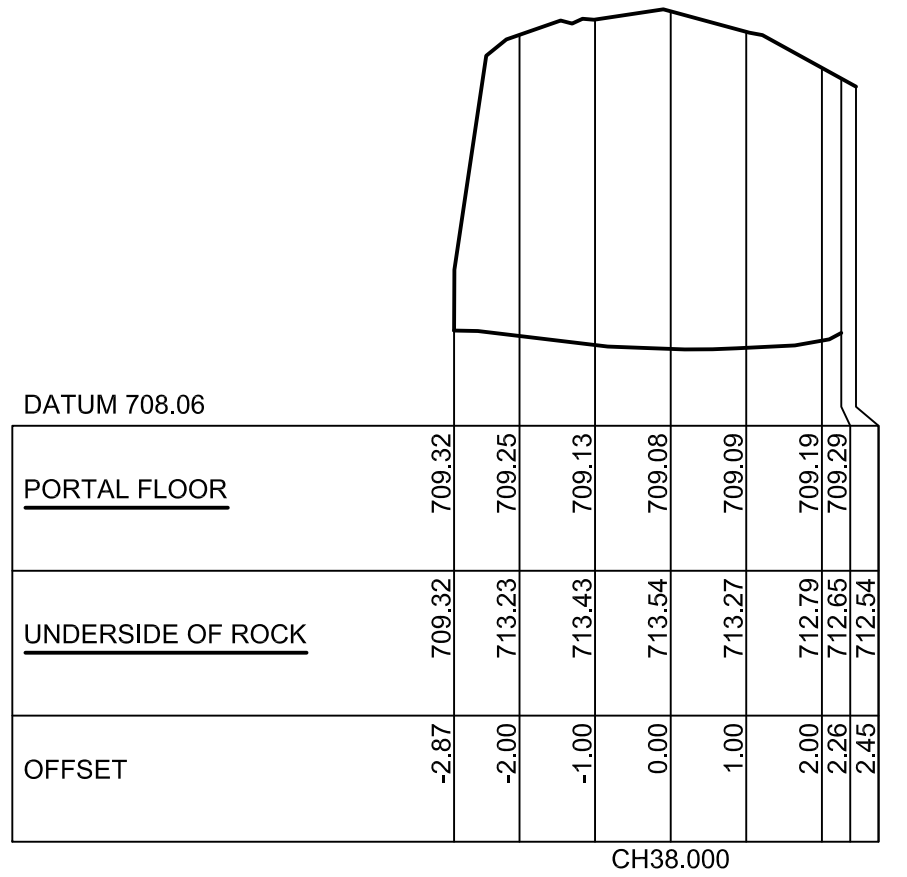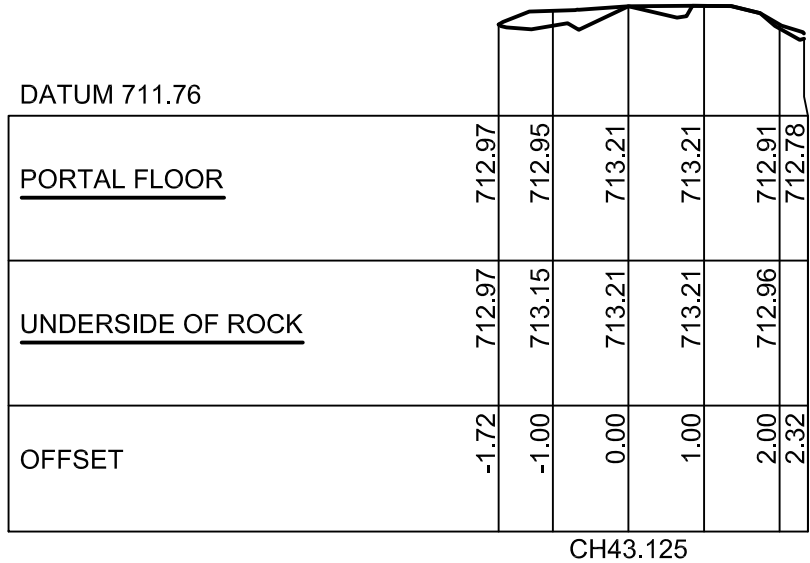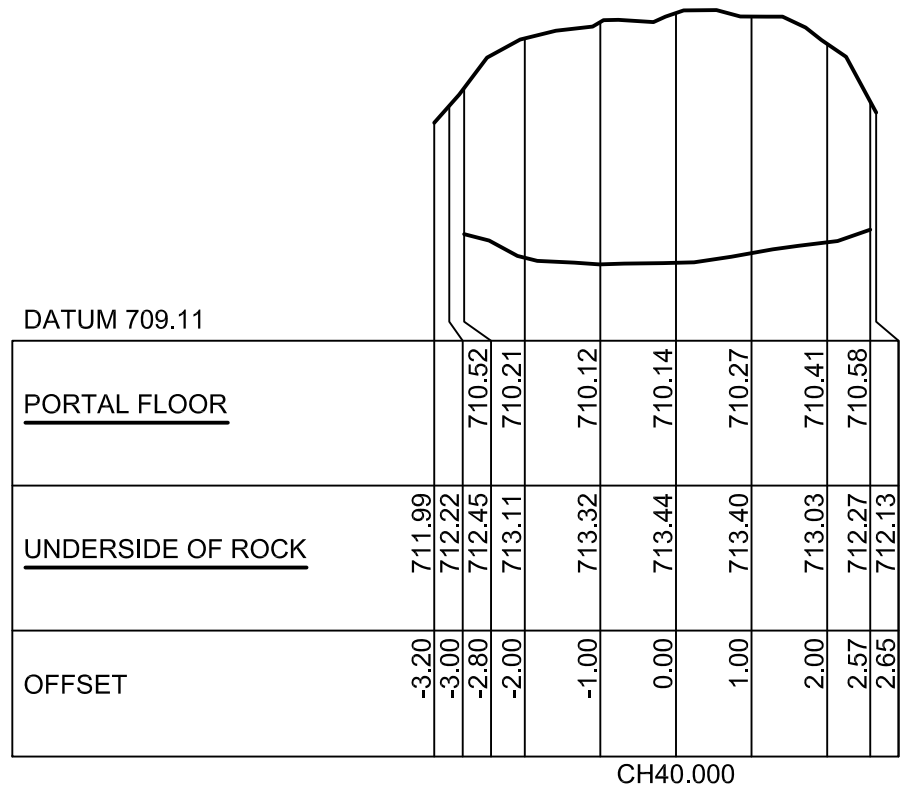

J:\Surveyors\Jobs\Veolia\16700 Woodlawn Bioreactor\Veolia Southern Portal\Cad\16700-SP5 Final Plans.dwg

ISSUE	AMENDMENT	DATE
A	INITIAL ISSUE	18/09/2013

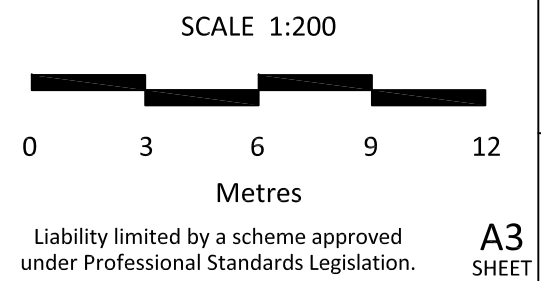

**VEOLIA**  
ENVIRONMENTAL SERVICES

LandTeam Australia Pty Ltd  
ABN 35 300 283 592  
Goulburn Office  
36 Montague Street p: (02) 4821 1033  
Postal: PO Box 1040 f: (02) 4821 7238  
GOULBURN NSW 2580 e: goulburn@landteam.com.au FS550318


**SOUTHERN PORTAL SEALING PROJECT**

CROSS SECTIONS: CH38.000 - CH43.125  
COMPLETED SEALING WORKS OF SOUTHERN PORTAL  
WOODLAWN BIOREACTOR  
COLLECTOR ROAD  
TARAGO

DATUM: AHD | ORIGIN: PILLAR 715 | CONTOUR INTERVAL: N/A

DATE:	18/09/2013
SURVEYED:	MK/SH
DRAWN:	MK
CHECKED:	JK
DRAWING No.	<b>16700-SP5-9</b>

**A**

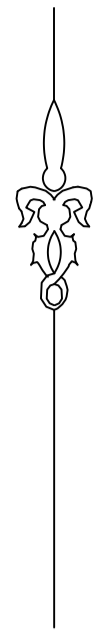

EVAPORATION DAM ED2




LEGEND

--- LEACHATE TRANSFER LINE

NOTE: REFER ALSO TO LANDTEAM DRAWING No's. 16800-451 AND 201146-CAT1 FOR SURFACE WATER DRAINAGE AND SUB-CATCHMENT DETAILS

Liability limited by a scheme approved under Professional Standards Legislation.

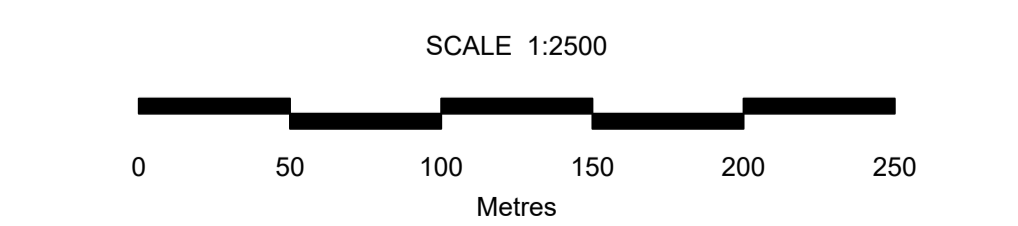

COPYRIGHT: Concepts and information contained within these drawings and related documents are the copyright of LandTeam Australia Pty Ltd. Unauthorised copying of part or whole of the document(s) is a breach of this copyright.

ISSUE	AMENDMENT	DRAWN	DATE
B	EVAPORATION DAMS ED3 ADDED	JA	6/2006
C	CEA CONSTRUCTION AREA UPDATED	JA	1/2007
D	GENERAL REVISION & REMOVAL OF REDUNDANT DETAIL	MK	14/04/2016
E	NOTE REGARDING LEACHATE EXTRACTION ADDED	MK	14/04/2016
F	MINOR ADDITIONS AND AMENDMENTS	MK	21/07/2016
G	GENERAL AMENDMENTS AND RE-ISSUE	MK	24/07/2018
H	ED1CD2 ADDED & VARIOUS AMENDMENTS	MK	18/01/2023

LandTeam Australia Pty Ltd  
 ABN 35 300 283 592  
**Goulburn Office**  
 36 Montague Street  
 Postal: PO Box 1040  
 GOULBURN NSW 2580  
 p: (02) 4821 1033  
 f: (02) 4821 7238  
 e: goulburn@landteam.com.au  
 www.landteam.com.au



A1 SHEET	VEOLIA ENVIRONMENTAL SERVICES		WOODLAWN BIOREACTOR COLLECTOR ROAD, TARAGO	
	LEACHATE TRANSFER SYSTEM WOODLAWN BIOREACTOR		SURVEYED: N/A	ISSUE: H
DATE: 18/01/2023		DRAWN: MK		16800-180
DATUM: AHD		CHECKED: JK		





## Mechanical Evaporator Operation Protocol

### Woodlawn Bioreactor

#### Protocol Objective

This protocol outlines the specific operational requirements for use of mechanical evaporation units to assist in evaporating leachate that has been treated through the onsite leachate treatment system.

#### Background

Veolia utilise mechanical evaporation to assist in volume reduction of leachate onsite. These units are a critical part of the leachate treatment infrastructure in order to meet the zero discharge conditions under the site Environment Protection Licence 11436 – Condition L1.3. In order to maintain sufficient freeboard in onsite storage dams, mechanical evaporation is required.

Mechanical evaporators (shown below) operate by pumping liquid to a unit, where the liquid is blown through a misting fan and is then dispersed through a chute into the atmosphere. Moisture loss is increased through the phase transition of liquid water to water vapor (evaporation).



Figure 1: Evaporator units in action



## **Veolia Operating Protocol**

The following set of conditions will need to be satisfied in order to operate the evaporators. These conditions apply to all evaporators, as defined in Figure 2.

1. Evaporation must only be undertaken on leachate that has been treated through a leachate treatment system.

Under no circumstances is untreated leachate to be pumped into evaporators. All leachate pumped from the waste must first pass through the leachate treatment system prior to storage in the ED3 storage dam system.

2. If monitoring results indicate that leachate treatment targets are not being achieved, any evaporators operating must cease immediately.

Recommencement of the evaporators from the direct discharge pond will occur once monitoring results indicate that the leachate treatment targets are being achieved.

3. Automated control of the evaporators will be dictated by current weather conditions, specifically wind direction, wind speed and relative humidity.

Operation of the evaporators is automated by onsite sensors which records, wind speed and wind direction. Veolia have the evaporator units set up to operate under the following conditions

- Wind direction – Must be directing any spray back over the dams (the actual direction will depend on the location of the evaporators and will be controlled by the onsite weather station).
- Wind Speed – Must be more than 0.2m/s


If weather conditions do not meet the criteria specified, then the evaporators will automatically switch off. Once favourable weather conditions return, the evaporators will automatically recommence operation. The automation is based on a timer, where the parameters must reach these criteria before switching on/off.

4. The evaporators must not be run under any circumstances while works adjacent to the ED3 System are being undertaken.

Veolia will switch control from “automated” to “off” whilst any works are being undertaken in the vicinity of the evaporators. Control will be switched back to automated when works are complete unless otherwise agreed.



Figure 2 – Woodlawn ED3 North system

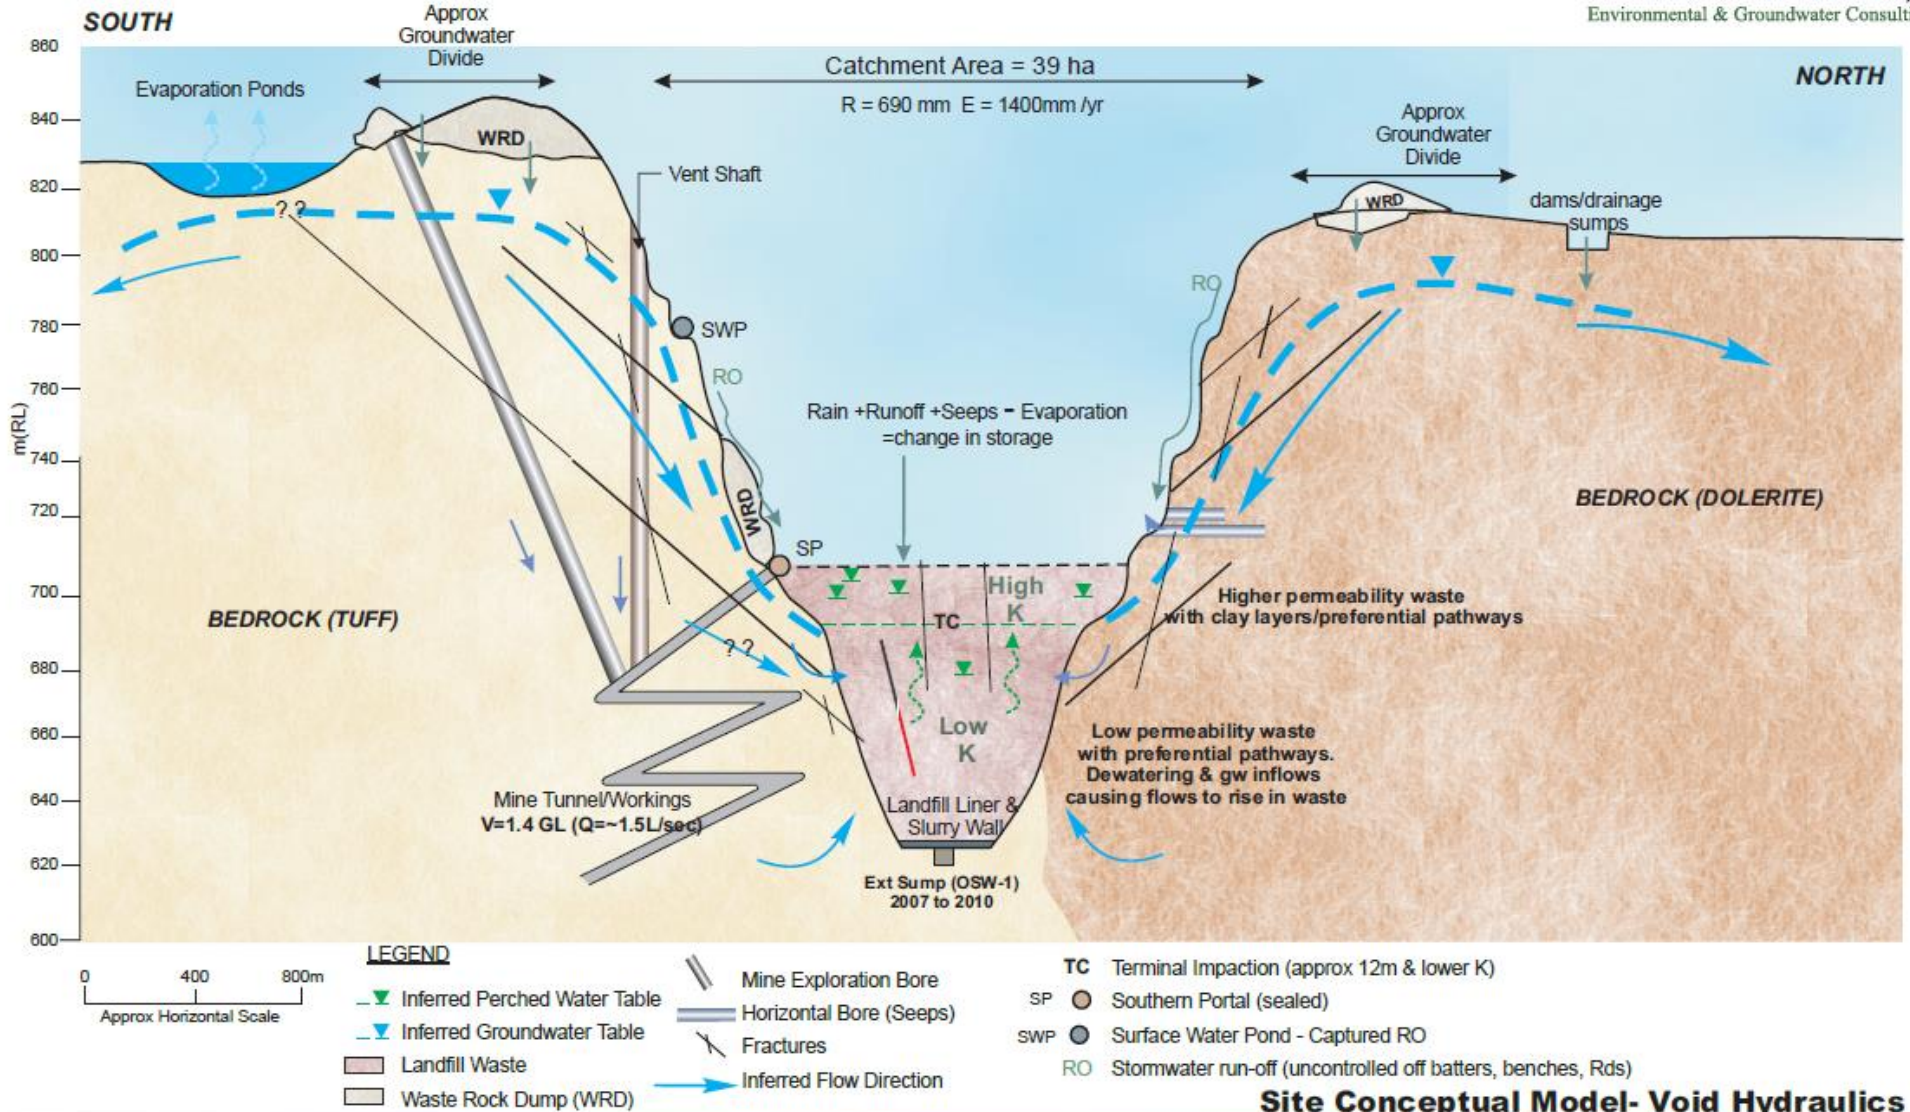

**Site Conceptual Model- Void Hydraulics**



THE ODOUR  
UNIT



**Veolia Australia & New Zealand**

---

**Woodlawn Bioreactor Facility Odour  
Modelling Study**

---

**Long-term Treated Leachate Solution**

**July 2016**

**Final Report**

**THE ODOUR UNIT PTY LTD**

ABN 5309 116 5061  
ACN 091 165 061

Bay 4 Suite 3011  
Australian Technology Park  
2 Locomotive St  
EVELEIGH, NSW 2015  
E: [info@oodurunit.com.au](mailto:info@oodurunit.com.au)  
W: [www.odourunit.com.au](http://www.odourunit.com.au)

This document may only be used for the purpose for which it was commissioned and in accordance with the Terms of Engagement for the commission. This document should not be used or copied without written authorisation from **THE ODOUR UNIT PTY LTD** or **VEOLIA AUSTRALIA & NEW ZEALAND**.

**Project Number:** N1806L.06

<b>Report Revision</b>		
<b>Revision Number</b>	<b>Date</b>	<b>Description</b>
Draft report	21.07.2016	Internal review
Final report (unsigned)	22.07.2016	Issued to client for review
Final Report (signed)	22.07.2016	Final report issued
<b>Report Preparation</b>		
<b>Report Prepared By:</b> M. Assal & S. Hayes		<b>Approved By:</b> M. Assal
<b>Report Title:</b> Veolia Australia & New Zealand Woodlawn Bioreactor Facility Odour Modelling Study – Long-term Treated Leachate Solution		

## CONTENTS

<b>1</b>	<b>INTRODUCTION.....</b>	<b>5</b>
1.1	Scope of Works .....	5
<b>2</b>	<b>STUDY METHODOLOGY.....</b>	<b>7</b>
2.1	Projected ED3S System Odour Emission Rates.....	7
2.2	ED1 Treated Leacaehe Quality Target Values .....	8
2.3	Regression Analysis .....	8
2.3.1	Leachate quality parameters selected .....	9
2.3.2	Leachate quality parameter regression results .....	10
2.3.3	Projected SOERs values .....	13
2.3.4	Regression Results Discussion .....	13
<b>3</b>	<b>ODOUR DISPERSION MODELLING METHODOLOGY .....</b>	<b>15</b>
3.1	NSW Odour Criteria and Dispersion Model Guidelines .....	15
3.2	Odour Dispersion Model Selection .....	17
3.3	Geophysical and Meteorological Configuration .....	18
3.3.1	Terrain configuration.....	18
3.3.2	Land use configuration .....	19
3.3.3	Geophysical configuration .....	19
3.3.4	Meteorological configuration.....	20
3.4	CALPUFF Dispersion Model Configuration .....	29
3.4.1	Computational domain.....	29
3.4.2	Receptor configuration.....	29
3.4.3	Source Configuration and Emission Rates .....	29
3.4.4	CALPUFF Model Options .....	29
3.5	Modelling Sensitivity Test Scenarios .....	29
<b>4</b>	<b>ODOUR DISPERSION MODELLING RESULTS.....</b>	<b>31</b>
<b>5</b>	<b>MODELLING STUDY FINDINGS &amp; CONCLUSION.....</b>	<b>33</b>
<b>6</b>	<b>BIBLIOGRAPHY .....</b>	<b>34</b>
	<b>REPORT SIGNATURE PAGE.....</b>	<b>36</b>

## LIST OF FIGURES & TABLES

### FIGURES

Figure 2.1 - SOER and BOD SOER regression projection results .....	11
Figure 2.2 - SOER and Ammonia regression projection results .....	12
Figure 3.1 - Terrain map of Woodlawn and surrounds .....	19
Figure 3.2 - Land use map of Woodlawn and surrounds .....	20
Figure 3.3 - Annual windroses for Goulburn Airport 5 years and 2015 only .....	23
Figure 3.4 - Annual and seasonal windroses for Woodlawn 2015 (modelled) .....	24

Figure 3.5 - Monthly average temperatures for Goulburn Airport 5 years and 2015 only .....	25
Figure 3.6 - Annual diurnal temperature for Goulburn Airport 5 years and 2015 only	26
Figure 3.7 - Annual X-Y scatter plot diurnal mixing height for Woodlawn 2015 (modelled) .....	27
Figure 3.8 - Annual stability class frequency for Woodlawn 2015 (modelled).....	28
Figure 4.1 – Long-term treated leachate solution (Scenarios #1 to #4) .....	32

## TABLES

Table 2.1 - Projected Odour Emission Rates for ED3S .....	7
Table 2.2 – Final treated leachate quality target values by the MBR Treatment Plant .	8
Table 2.3 – Coefficient of determination for leachate quality parameters.....	9
Table 2.4 – Projected SOER results for ED1 under varying target values.....	13
Table 3.1 - EPA peak-to-mean factors .....	16
Table 3.2 - Odour Performance Criteria under Various Population Densities.....	17
Table 3.3 - CALMET key variable fields .....	22

## APPENDICES

**Appendix A:** LEACHATE AND ODOUR QUALITY CORRELATION ANALYSIS WORKSHEET

**Appendix B:** BUREAU OF METEOROLOGY BASIC CLIMATOLOGICAL STATION METADATA – GOULBURN AIRPORT (COMPLIED 26 NOVEMBER 2015)

**Appendix C:** CALPUFF SOURCE AND EMISSION MODELLING CONFIGURATIONS



---

# 1 INTRODUCTION

---

In June 2016, Veolia Australia & New Zealand (Veolia) engaged The Odour Unit Pty Ltd (TOU) to carry out an odour dispersion model study to evaluate the odour profile contribution and assess compliance against the New South Wales Environment Protection Authority (NSW EPA) odour performance criteria of the addition of the proposed Evaporation Dam 1 (ED1) System to the Leachate Management System (LMS) at the Woodlawn Bioreactor Facility located at Collector Road, Tarago, NSW (the Site).

The basis for this additional pond system is to create the necessary reserve capacity for the storage of treated leachate from the future Membrane Bioreactor (MBR) Treatment Plant. This is part of Veolia's long term strategy for managing leachate at the Site. The MBR Treatment Plant will see the decommissioning of the existing Leachate Aeration Dam (LAD) and storage in Evaporation Dam 3 South (ED3S), once it fully operation. The expected date of this decommissioning is end of 2017. Overall, this is considered to represent a significant upgrade in the Leachate Management System (LMS) and aims to improve the stored treated leachate quality at the Woodlawn Bioreactor Facility.

## 1.1 SCOPE OF WORKS

The scope of works for the odour dispersion model study consisted of:

- Sourcing and setting up the original odour dispersion model used in the *Environmental Assessment Woodlawn Expansion Report* dated August 2010 (EA). Some meteorology-based revisions to this model were necessary given the year that the model was completed (see **Section 3** for details);
- Inclusion of the proposed ED1 System into the EA odour dispersion model;
- Undertaking of a regression analysis for the purposes of developing a mathematical function that can project the expected specific odour emission rate (SOER) based on the final treated leachate quality generated by the proposed MBR Treatment Plant. This analysis was based on an extensive dataset pertaining to leachate quality and odour emissions from the LMS obtained during the previous four odour audits, conducted annually, at the Woodlawn Bioreactor Facility since 2012; and
- Odour dispersion modelling projection of the individual off-site odour impact from the inclusion of the proposed ED1 System. In addition, the cumulative off-site odour impact with the other modelled emission sources in the EA were

undertaken to assess site-wide compliance with the relevant NSW EPA odour performance criterion.

The following report details the methodology and findings from the odour dispersion model in the context of the quality of treated leachate from the MBR Treatment Plant and storage in ED1 system.

## 2 STUDY METHODOLOGY

The odour dispersion modelling study methodology required the need to setup and carry out new modelling runs of the original EA odour dispersion model, developed by the former Heggies Pty Ltd, now operating as SLR Consulting, to evaluate the contribution and assess compliance of the proposed addition of ED1 system to the LMS and other modelled emissions. The original dispersion modelling configuration and the adopted odour emission rates used in the EA odour dispersion model can be found in *Section 5* of the EA's *Odour and Dust Impact Assessment (Rev 7)* report dated February 2011. Moreover, the modelling study from TOU reports titled *Proposed Addition of ED3S to Leachate Management System* dated May 2016 should be read in conjunction with this report.

### 2.1 PROJECTED ED3S SYSTEM ODOUR EMISSION RATES

The projected ED3S System odour emission rates adopted from the May 2016 study were used as part of this modelling study. For convenience, the derived odour emission rates have been presented in **Table 2.1**.

<b>Table 2.1 - Projected Odour Emission Rates for ED3S</b>			
<b>ED3N System 2015</b>			
<b>Source ID</b>	<b>Dam Surface Area (m<sup>2</sup>)</b>	<b>SOER (ou.m<sup>3</sup>/m<sup>2</sup>/s)</b>	<b>OER (ou.m<sup>3</sup>/s)</b>
ED3N-1	6,000	0.132	794
ED3N-2	5,500	0.145	797
ED3N-3	5,500	0.091	500
ED3N-4	25,000	0.269	6,720
<b>ED3N Total</b>	<b>42,000</b>	<b>0.159 (mean)</b>	<b>8,810</b>
<b>Projected ED3S System</b>			
ED3S	89,435	0.159	14,200
ED3S-S	28,330		4,510
<b>ED3S Total</b>	<b>118,000</b>		<b>18,700</b>

The modelling was carried out on the basis of ED3S-S at total water level (TWL). This is considered to be a conservative approach as ED3S-S is planned to receive treated leachate until the end of 2017, after which it will be decommissioned and replacement with the MBR Treatment Plant and ED1 System.

## 2.2 ED1 TREATED LEACHATE QUALITY TARGET VALUES

The treated leachate quality target values were supplied by Veolia on 5 July 2016, understood to be from the designer and installer of the MBR Treatment Plant. These are summarised in **Table 2.2**.

Parameter	Units	Minimum	Average	Maximum
pH	--	--	--	7 - 7.5
Conductivity	µS/cm	--	36,000	--
COD	mg/L	--	--	2,500
BOD	mg/L	--	--	10
Total Phosphorus	mg/L	--	--	13
Ammonia	mg/L	--	--	10
Nitrate	mg/L	--	--	500
TSS	mg/L	--	--	5
TDS	mg/L	--	--	30,000
Chloride	mg/L	--	--	5,000

## 2.3 REGRESSION ANALYSIS

As previously mentioned in **Section 1**, a regression analysis for the purposes of developing a mathematical function that can project the expected SOER based on the final treated leachate quality generated by the proposed MBR Treatment Plant. This analysis is considered to be important for the purposes of inputting reliable odour emissions data in the dispersion model and undertaking of a sensitivity analysis, where the effect of fluctuations in the final effluent quality can be examined and the resultant odour impact assessed.

The regression analysis involved three key steps:

1. Evaluation of key leachate parameters that are likely to have the most significant impact to odour emission from stored leachate, based on an extensive dataset pertaining to leachate quality and odour emissions from the LMS obtained during the previous four odour audits, conducted annually, at the Woodlawn Bioreactor Facility since 2012. A summary of the processed data is provided in **Appendix A**. The raw dataset can be provided upon request. The parameters examined included: pH, Biological Oxygen Demand (BOD), Total phosphorus, Ammonia, Nitrate, Total Suspended Solids, Total Dissolved Solids, Chloride and Volatile Fatty Acids (VFAs);
2. Once a positive and confident correlation was developed between odour and the leachate quality parameter, a regression function was developed; and

### 3. Undertaking of a sensitivity analysis with leachate quality parameters at:

- The final effluent target design values (see **Table 2.2**); and
- Leachate quality values above the final target design values (see **Table 2.4**).

Upon completion of the regression analysis, the mean of the projected SOERs between leachate quality parameter was undertaken. For example, if the BOD regression model produced a SOER of 1 ou.m<sup>3</sup>/m<sup>2</sup>/s and Ammonia of 2 ou.m<sup>3</sup>/m<sup>2</sup>/s, the arithmetic mean was computed (i.e. 1.5 ou.m<sup>3</sup>/m<sup>2</sup>/s in this hypothetical example). A nominal multiplicity factor was then applied to the mean value at 2, 5, and 10 times above the final target design values.

#### 2.3.1 Leachate quality parameters selected

From the list of leachate quality parameters listed in **Section 2.3**, the following parameters were selected for a covariance and correlation analysis: pH, BOD, Ammonia, Sulphide, and VFAs. These parameters are well known to be a contributing factor for the generation of adverse levels of odour from wastewater, if they are not adequately managed.


The covariance analysis conducted (see **Appendix A**) indicated a positive covariance suggesting that a relationship existed between SOER and BOD, Ammonia, Sulphide and VFAs. pH was found to have a negative covariance, suggesting that a relationship between SOER and pH is not likely. From there, a correlation analysis was undertaken, the result of which are summarised in **Table 2.3** below. The result shows the coefficient of determination (R<sup>2</sup>). Put simply, the closer the R<sup>2</sup> value is to 1 the stronger the statistical relationship between the two variables, in this case the SOER and leachate quality parameter.

<b>Table 2.3 – Coefficient of determination for leachate quality parameters</b>	
<b>Leachate quality parameter</b>	<b>R<sup>2</sup></b>
<b>BOD</b>	0.89
<b>Sulphide</b>	0.35
<b>Ammonia</b>	0.94
<b>VFAs</b>	0.86

The detailed analysis worksheet is appended as **Appendix A**. On the basis of the results in **Table 2.3**, BOD and Ammonia were selected as the parameters for further analysis.

### 2.3.2 Leachate quality parameter regression results

The regression results between SOER and the leachate quality parameters including BOD and Ammonia are illustrated in **Figure 2.1 & Figure 2.2**, respectively. As can be seen, for both regression results for BOD and Ammonia, there exists a strong exponential correlation with SOER.

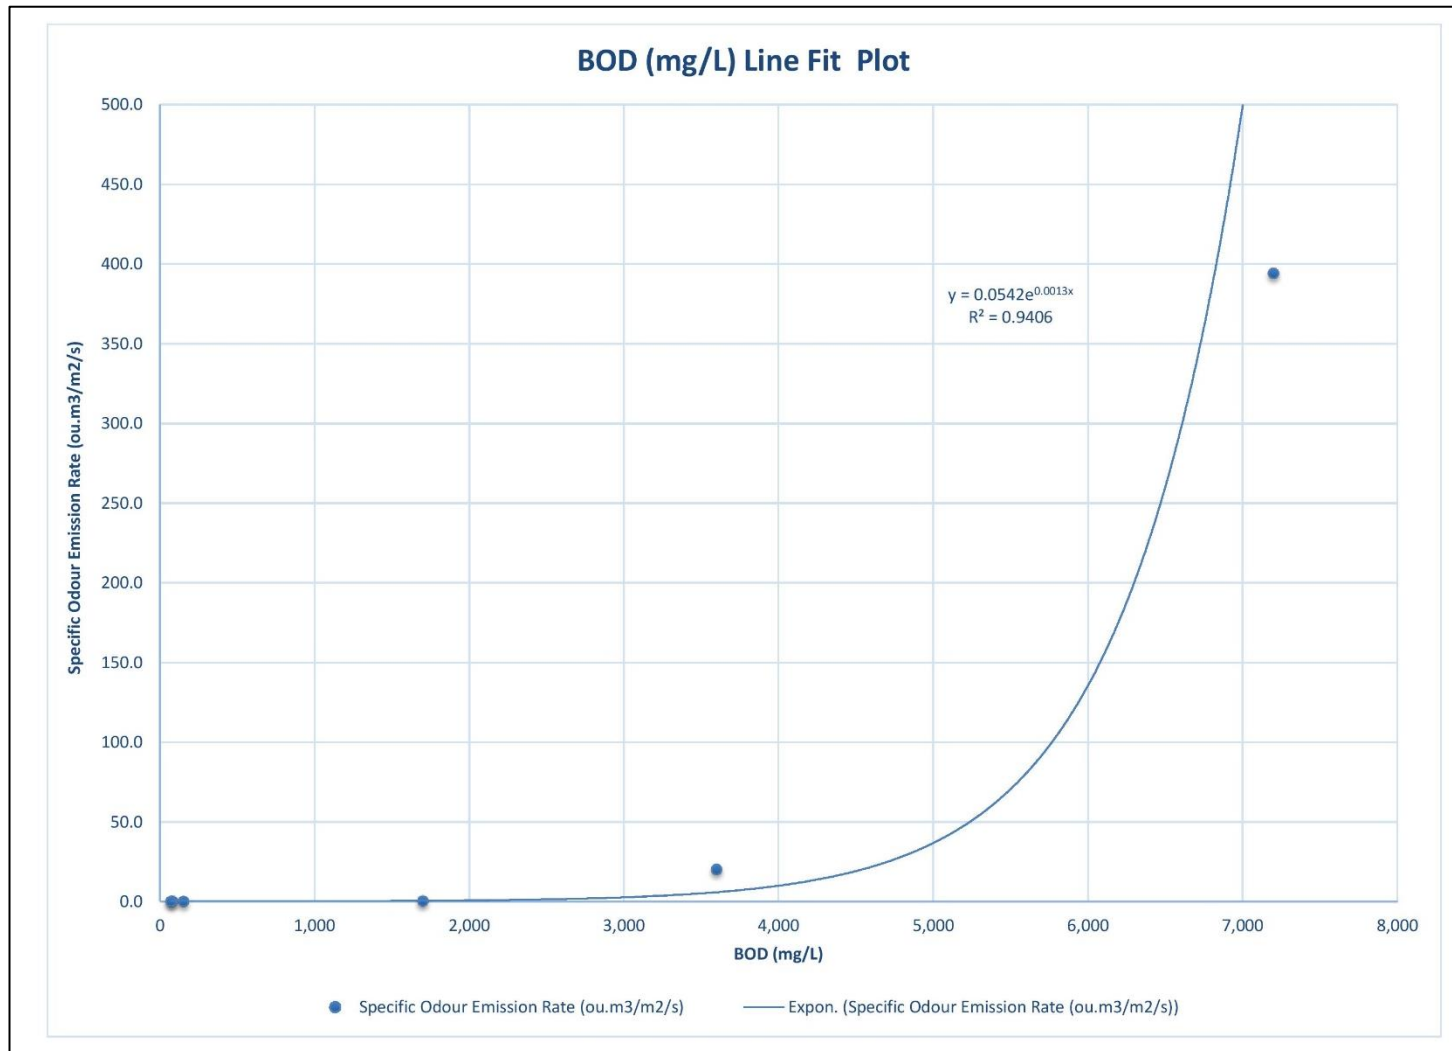

**Figure 2.1 - SOER and BOD SOER regression projection results**

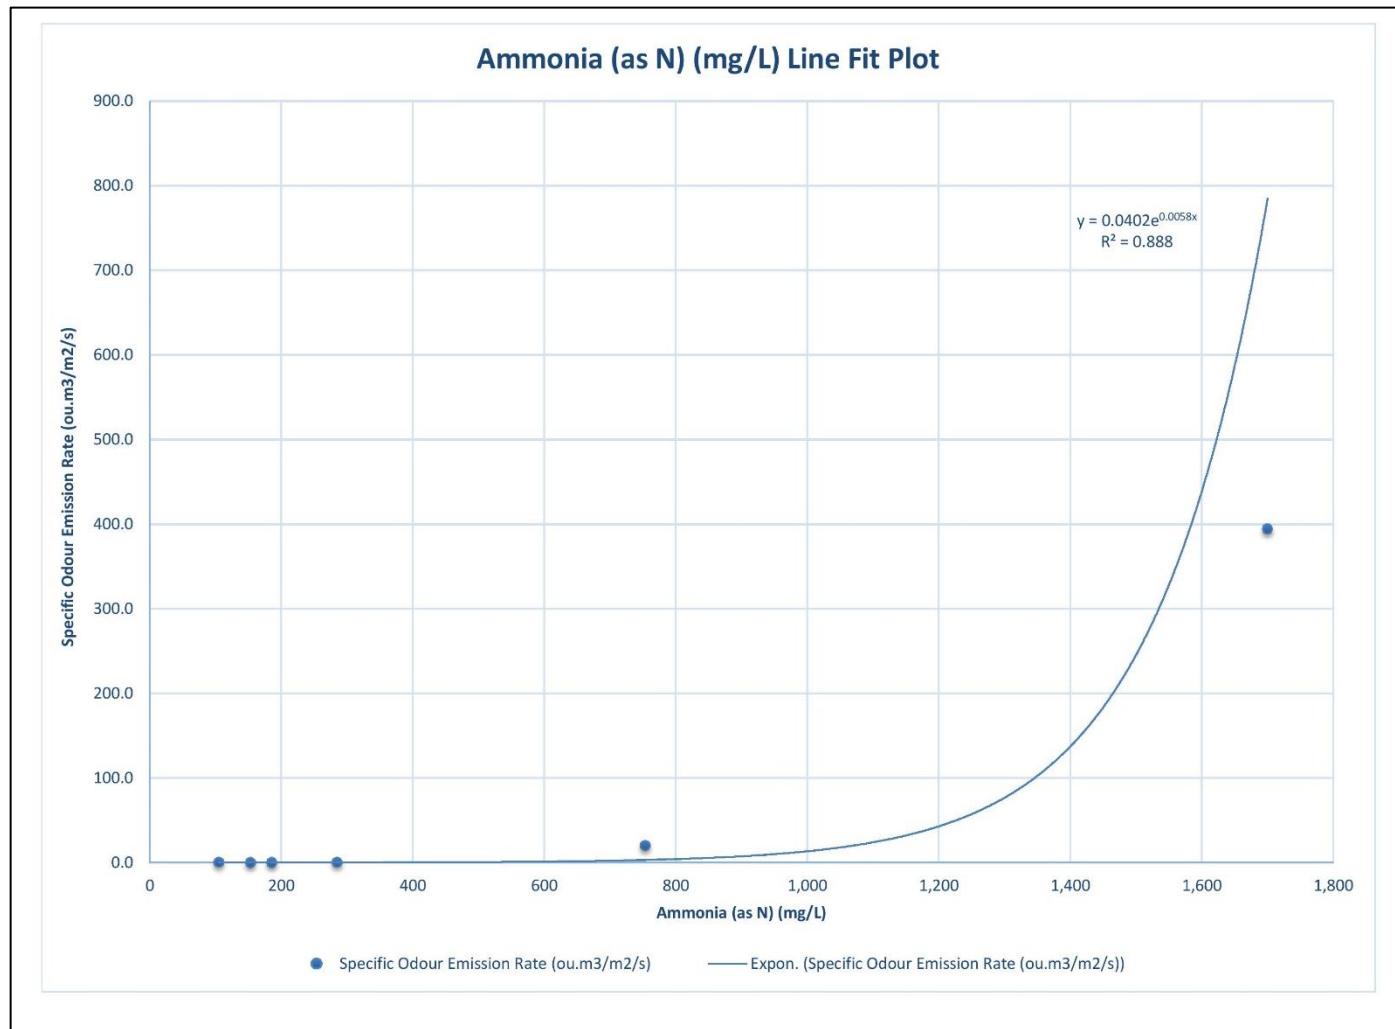


Figure 2.2 - SOER and Ammonia regression projection results



### 2.3.3 Projected SOERs values

Based on the regression analysis results presented in **Section 2.3.2**, the selected leachate quality parameters for further analysis (i.e. BOD and Ammonia) were entered into the regression function and resultant SOERs calculated. The results from this computation are summarised in **Table 2.4**.

**Table 2.4 – Projected SOER results for ED1 under varying target values**

Scenario No.	BOD (mg/L)	Ammonia (mg/L)	Scenario Description (Factor)	Mean SOER (ou.m <sup>3</sup> /m <sup>2</sup> /s)	Comments
1	10	10	Design	0.0488	Design target, as indicated
2	20	20	2 x	0.0504	Treated leachate 2 x above design target
3	50	50	5 x	0.0558	Treated leachate 5 x above design target
4	100	100	10 x	0.0668	Treated leachate 10 x above design target

When compared to the results from **Table 2.1** where a derived SOER for treated leachate of 0.159 ou.m<sup>3</sup>/m<sup>2</sup>/s is used, the values in **Table 2.4** suggest that the quality of treated leachate from the proposed MBR Treatment Plant will be superior and of a higher quality than that possible under the existing LMS. This is consistent with the stringent final effluent targets shown in **Table 2.2**. From an odour performance viewpoint, this is considered to be a good outcome for the long-term and sustainable management of leachate at the Site.

### 2.3.4 Regression Results Discussion

The regression results are based on observable and real leachate quality and odour emissions data. It is considered that the data used is a reasonable basis for the projected SOERs values generated in this study, for the following reasons:

- The odour emissions data used was collected from different leachate quality including untreated, partially leachate and fully treated leachate over four audits i.e. equivalent to four years' worth of data. This provided a span of different operationally scenarios from best case to worst case; and

- It was possible to obtain data from Veolia on leachate quality that was close to the time of the odour sampling. This meant the odour emissions could be closely related to leachate quality.

The correlation made in this study are considered to be unique to the Site. Therefore, any correlations presented in this study are not necessarily transposable to other facilities, particularly other waste management facilities.

---

## 3 ODOUR DISPERSION MODELLING METHODOLOGY

---

### 3.1 NSW ODOUR CRITERIA AND DISPERSION MODEL GUIDELINES

Regulatory authority guidelines for odorous impacts of gaseous process emissions are not designed to satisfy a 'zero odour impact criteria', but rather to minimise the nuisance effect to acceptable levels of these emissions to a large range of odour sensitive receptors within the local community.

The odour impact assessment for this project has been carried out in accordance with the methods outlined by the documents:

- Environment Protection Authority, 2005, *Approved Methods for the Modelling and Assessment of Air Pollutants in New South Wales*;
- Environment Protection Authority, 2006, *Technical Framework (and Notes): Assessment and Management of Odour from Stationary Sources in NSW*; and
- Barclay & Scire, 2011. *Generic Guidance and Optimum Model Settings for the CALPUFF Modeling System for Inclusion into the 'Approved Methods for the Modeling and Assessments of Air Pollutants in NSW, Australia'*.

The documents specify that the odour modelling for Level 3 impact assessments, upon which this study has been conducted, be based on the use of:

- The 99.0<sup>th</sup> percentile dispersion model predictions;
- 1-hour averaging times with built-in peak-to-mean ratios to adjust the averaging time to a 1-second nose-response-time;
- Odour emission rates multiplied by the peak-to-mean ratios as outlined in **Table 3.1**;
- The near field distance, defined typically as 10 times the largest source dimension, either height or width; and
- The appropriate odour unit performance criterion, based on the population of the affected community in the vicinity of the development.

**Table 3.1 - EPA peak-to-mean factors**

Source type	Pasquill-Gifford stability class	Near-field P/M60*	Far-field P/M60*
Area	A, B, C, D	2.5	2.3
	E, F	2.3	1.9
Line	A-F	6	6
Surface wake-free point	A, B, C	12	4
	D, E, F	25	7
Tall wake-free point	A, B, C	17	3
	D, E, F	35	6
Wake-affected point	A-F	2.3	2.3
Volume	A-F	2.3	2.3

\* Ratio of peak 1-second average concentrations to mean 1-hour average concentrations

Source: Environment Protection Authority, 2005 – Table 6.1

The impact assessment criteria (IAC) for complex mixtures of odours are designed to include receptors with a range of sensitivities. Therefore a statistical approach is used to determine the acceptable ground level concentration of odour at the nearest sensitive receptor. This criterion is determined by the following equation (Environment Protection Authority, 2005, p. 37):

$$IAC = \frac{\log_{10}(p) - 4.5}{-0.6} \quad \text{Equation 3.1}$$

where,

**IAC** = Impact Assessment Criteria (ou)

**p** = population

Based on **Equation 3.1**, **Table 3.2** outlines the odour performance criteria for six different affected population density categories. It states that higher odour concentrations are permitted in lower population density applications.

**Table 3.2 - Odour Performance Criteria under Various Population Densities**

Population of affected community	Odour performance criterion (ou)
Urban Area ( $\geq \sim 2000$ )	2.0
$\sim 500$	3.0
$\sim 125$	4.0
$\sim 30$	5.0
$\sim 10$	6.0
Single rural residence ( $\leq \sim 2$ )	7.0

**Source:** Environment Protection Authority, 2005 – Table 7.5

The original odour impact assessment (Heggies, 2010) had adopted the IAC of **6 ou** “given the low number of sensitive receptor locations in the vicinity of the Woodlawn site” (PAE Holmes, 2010). TOU has maintained consistency with this approach as conditions have not significantly changed.

### 3.2 ODOUR DISPERSION MODEL SELECTION

The odour dispersion modelling assessment was carried out using the CALPUFF System (Version 6.42). CALPUFF is a puff dispersion model that is able to simulate the effects of time- and three dimensional space-varying meteorological conditions on pollutant transport (Environment Protection Authority, 2005). CALMET is a meteorological model that produces three dimensional gridded wind and temperature fields to be fed into CALPUFF (Atmospheric Studies Group, 2011). The primary output from CALPUFF is hourly pollutant concentrations evaluated at gridded and/or discrete receptor locations. CALPOST processes the hourly pollutant concentration output to produce tables at each receptor and contour plots across the modelling domain. For further technical information about the CALPUFF modelling system refer to the document *CALPUFF Modeling System Version 6 User Instructions* (Atmospheric Studies Group, 2011).

The CALPUFF system can account for a variety of effects such as non-steady-state meteorological conditions, complex terrain, varying land uses, plume fumigation and low wind speed dispersion (Environment Protection Authority, 2005). CALPUFF is considered an appropriate dispersion model for impact assessment by EPA in their document - *Approved Methods and Guidance for the Modelling and Assessment of Air Pollutants in New South Wales* in one or more of the following applications:

- complex terrain, non-steady-state conditions,
- buoyant line plumes,
- coastal effects such as fumigation,

- high frequency of stable calm night-time conditions,
- high frequency of calm conditions, and
- inversion break-up fumigation conditions.

In the case of the this odour impact assessment, CALPUFF was required in order to handle the complexity of surrounding terrain features. Under calm and very light winds, non-steady-state conditions such as accumulation of odour and/or downslope movement with drainage air flow would almost certainly occur.


For this study, the air contaminant was odour and ground level concentrations in odour units (ou) have been projected.

### **3.3 GEOPHYSICAL AND METEOROLOGICAL CONFIGURATION**

A CALMET hybrid three-dimensional meteorological data file for Tarago, NSW was produced that incorporated of gridded numerical meteorological data supplemented by surface observation data, topography and land use over the domain area.

#### **3.3.1 Terrain configuration**

Terrain elevations were sourced from 1 Second Shuttle Radar Topography Mission (SRTM) Derived Smoothed Digital Elevation Model (DEM-S). The SRTM data was treated with several processes including but not limited to removal of stripes, void filling, tree offset removal and adaptive smoothing (Gallant, et al., 2011). The DEM-S was used as input into TERREL processor to produce a 400 km<sup>2</sup> grid at 0.15 km resolution. A map of the terrain is illustrated in **Figure 3.1**.

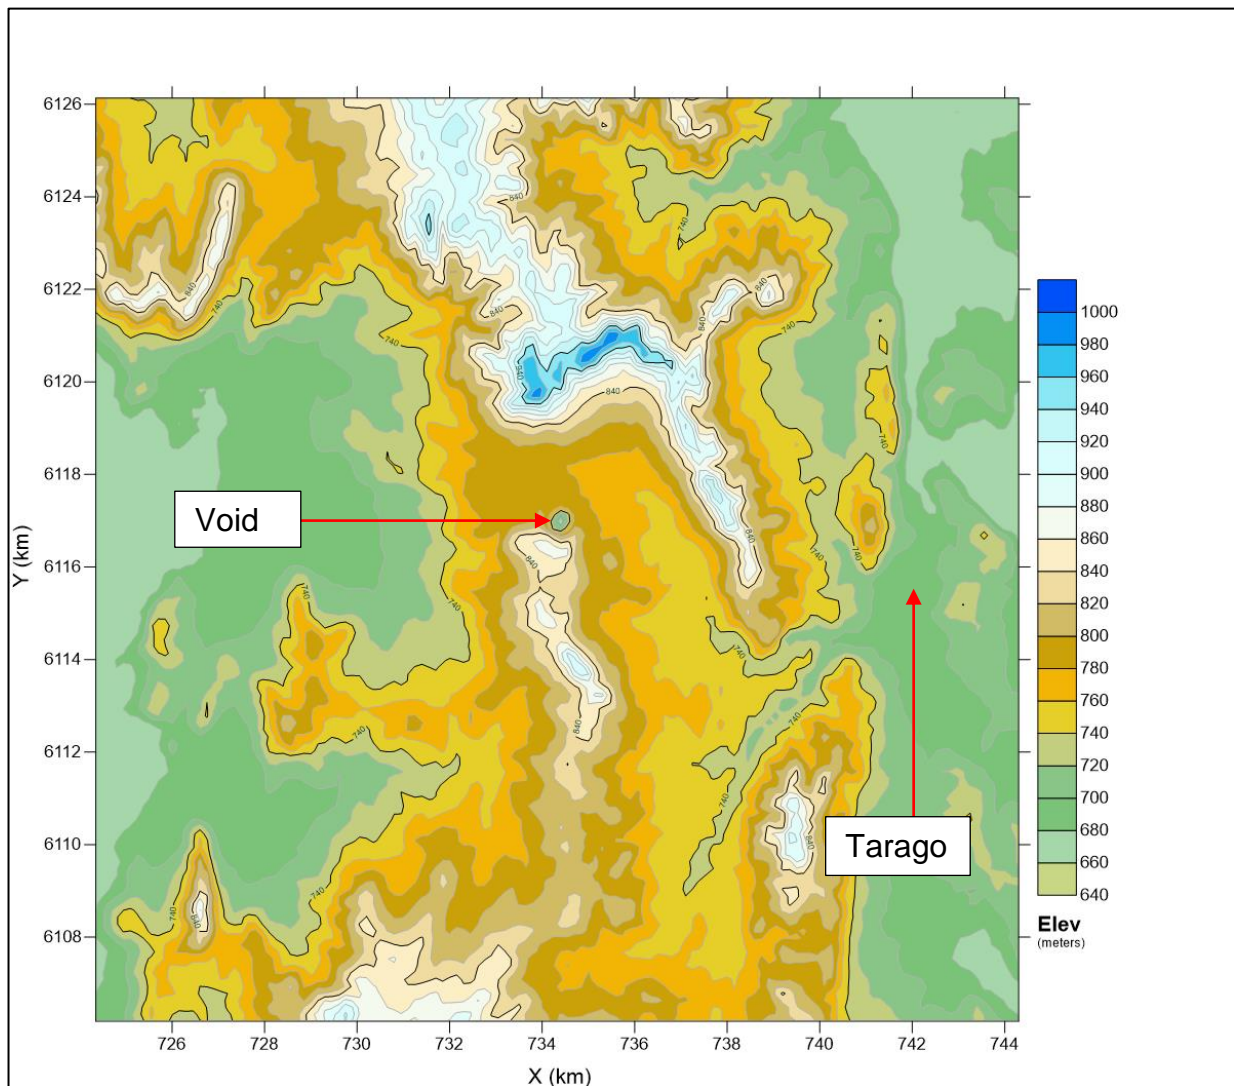


**Figure 3.1 - Terrain map of Woodlawn and surrounds**

### 3.3.2 Land use configuration

Land use was sourced from the United States Geological Survey (USGS) Global Land Cover Characteristics Data Base for the Australia-Pacific Region (USGS, 1997). The data was used as input into CTGPROC processor to produce a 400 km<sup>2</sup> grid at 0.15 km resolution. A map of the land use is illustrated in **Figure 3.2**.

### 3.3.3 Geophysical configuration

The geophysical data file was created using the MAKEGEO processor. Land use data from CTGPROC and terrain data from TERREL was used as input to produce a 400 km<sup>2</sup> geophysical grid at 0.15 km resolution.

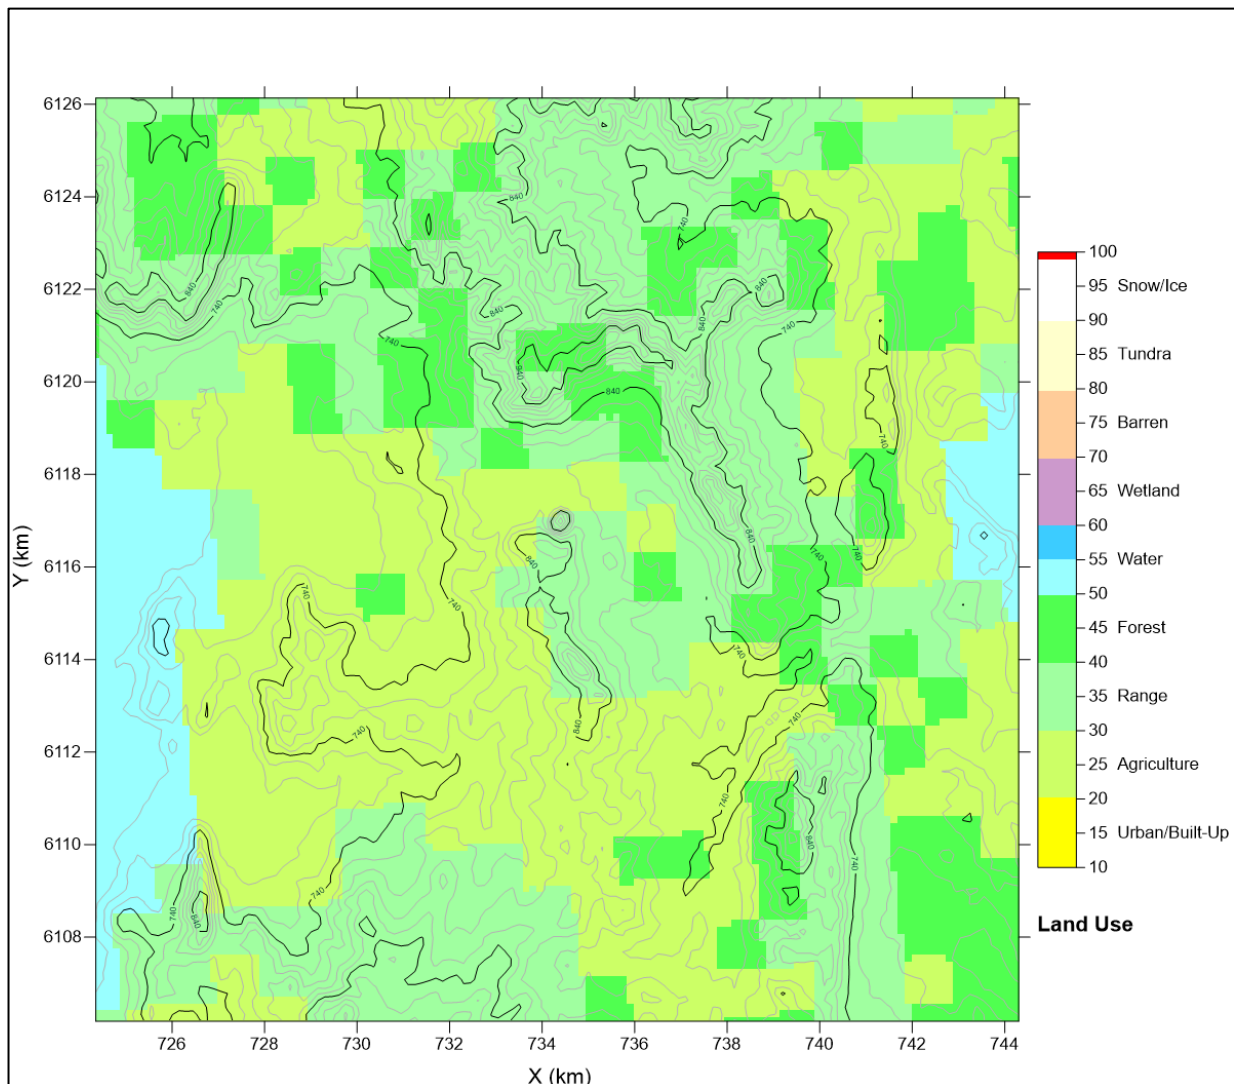

**Figure 3.2 - Land use map of Woodlawn and surrounds**

### 3.3.4 Meteorological configuration

#### 3.3.4.1 Input data

One-hour average observed meteorological surface data for the latest representative year (2015) was sourced from Goulburn Airport maintained by Bureau of Meteorology (BOM). The location of Goulburn Airport surface station and other metadata are available in **Appendix B**. The BOM data was formatted into generic format and was processed with SMERGE to produce a surface meteorological data file.

Numerical meteorological data was produced as a 3D data tile from The Air Pollution Model (v4.0.5) and processed it with CALTAPM (v7.0.0) into a suitable format. TAPM was run using multiple nested grids, at least three nests and 35 vertical levels centred over the Woodlawn site. TAPM innermost nest was 33 km by 33 km at 1 km resolution. The nested grid resolutions were close to a ratio of three as possible.



### 3.3.4.2 CALMET meteorological model configuration

CALMET was run using the hybrid option that uses geophysical data, surface station data from Bundaberg Airport and upper air data from the TAPM 3D data tile. The data was used to initialise the diagnostic functions of the CALMET module to produce a full 3D meteorology data for input into CALPUFF. **Table 3.3** shows key variable fields selected.

### 3.3.4.3 Meteorological data analysis

Observed 2015 BOM surface data was compared with longer term climate (2011 – 2015) from Goulburn Airport to gauge how representative and suitable the year is for the purpose of air quality dispersion modelling. For reference, meteorological data was also extracted from the CALMET model for the location directly nearby the Woodlawn site office. The annual windroses for Goulburn Airport show very good agreement with west to northwest winds dominating (**Figure 3.3**). The Woodlawn windroses (**Figure 3.4**) show bias to lighter winds and greater frequency of east to south-easterly winds, perhaps due influences from the nearby valley and ridgelines. A more conservative bias is expected relative to the observations at Goulburn Airport.

Both monthly average (**Figure 3.5**) and diurnal temperature (**Figure 3.6**) profiles for the long term and 2015 are in very good agreement. Diurnal mixing heights and stability class frequencies over the Woodlawn site are shown in **Figure 3.7** and **Figure 3.8** respectively.

<b>Table 3.3 - CALMET key variable fields</b>												
<b>Grid Configuration (WGS-84 UTM Zone 55S)</b>												
134						<b>NX Cells</b>						
134						<b>NY Cells</b>						
0.15						<b>Cell Size (km)</b>						
724.277			6106.107			<b>SW Corner (km)</b>						
11						<b>Vertical Layers</b>						
<b>ZFACE (m)</b>	0	20	40	80	160	320	640	1000	1500	2000	2500	3000
<b>LAYER</b>	1	2	3	4	5	6	7	8	9	10	11	
<b>MID-PT (m)</b>	10	30	60	120	240	480	820	1250	1750	2250	2750	
<b>Critical Wind Field Settings</b>												
<b>Value</b>	<b>Found</b>		<b>Typical</b>		<b>Values</b>							
TERRAD	4		None		Terrain scale (km) for terrain effects							
IEXTRP	-4		4,-4		Similarity extrap. of wind (-4 ignore upper stn sfc)							
ICALM	0		0		Do Not extrapolate calm winds							
RMAX1	6		None		MAX radius of influence over land in layer 1 (km)							
RMAX2	8		None		MAX radius of influence over land aloft (km)							
R1	3		None		Distance (km) where OBS wt = IGF wt in layer 1							
R2	4		None		Distance (km) where OBS wt = IGF wt aloft							

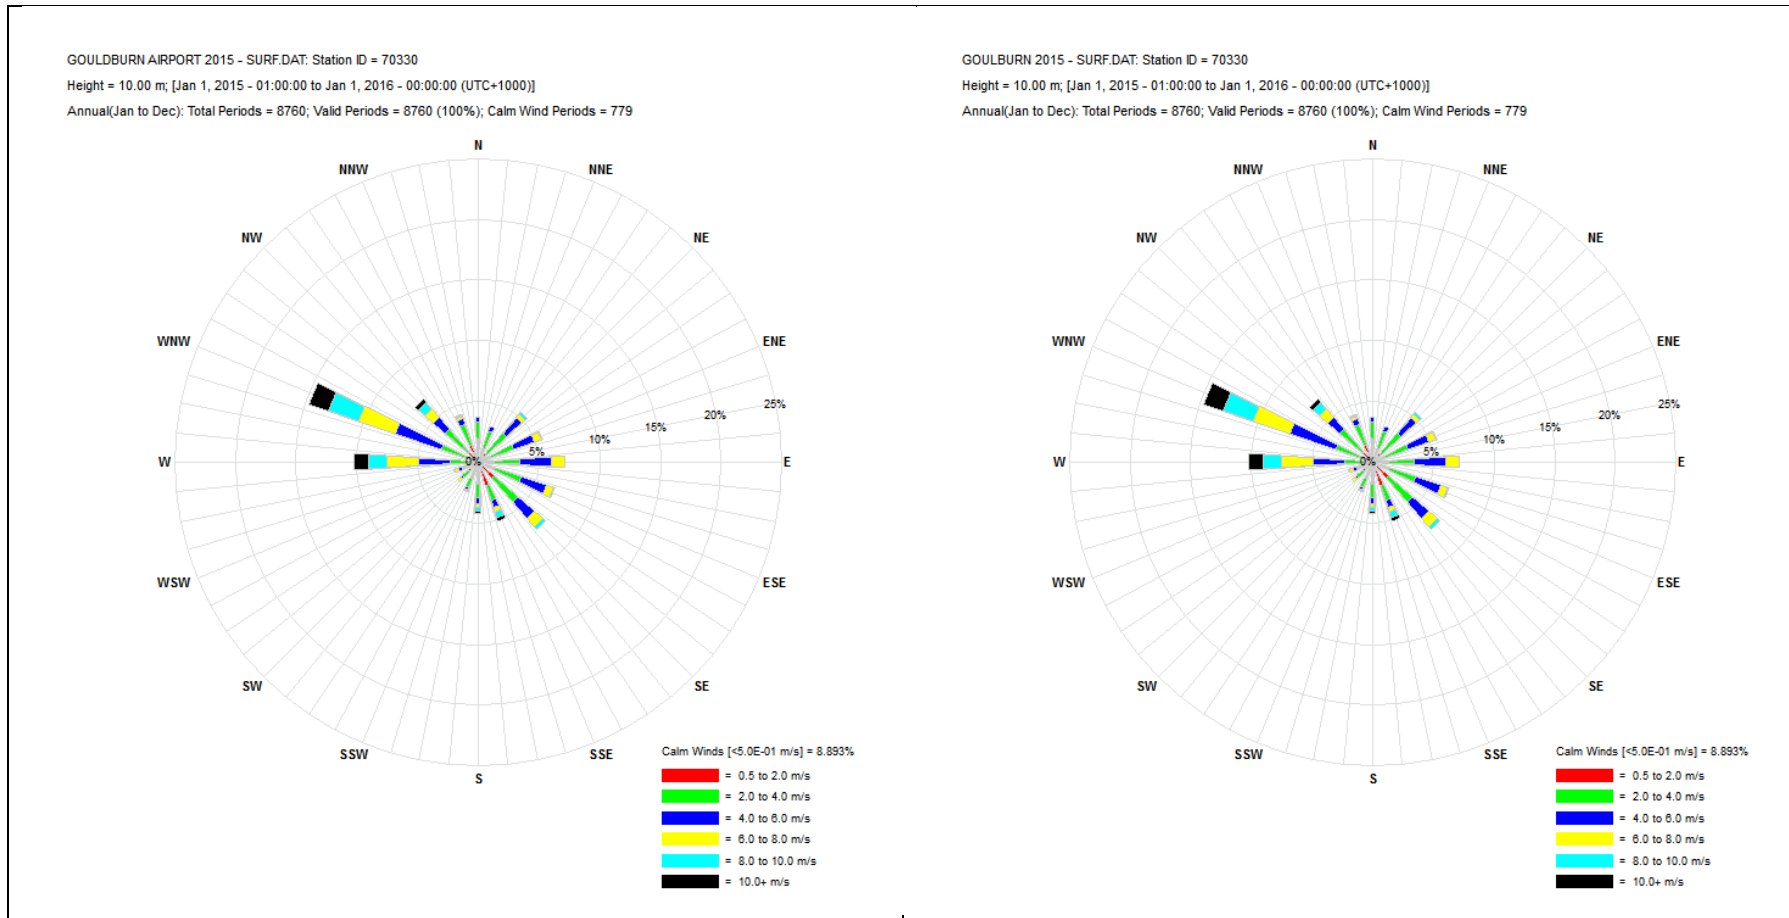


Figure 3.3 - Annual windroses for Goulburn Airport 5 years and 2015 only



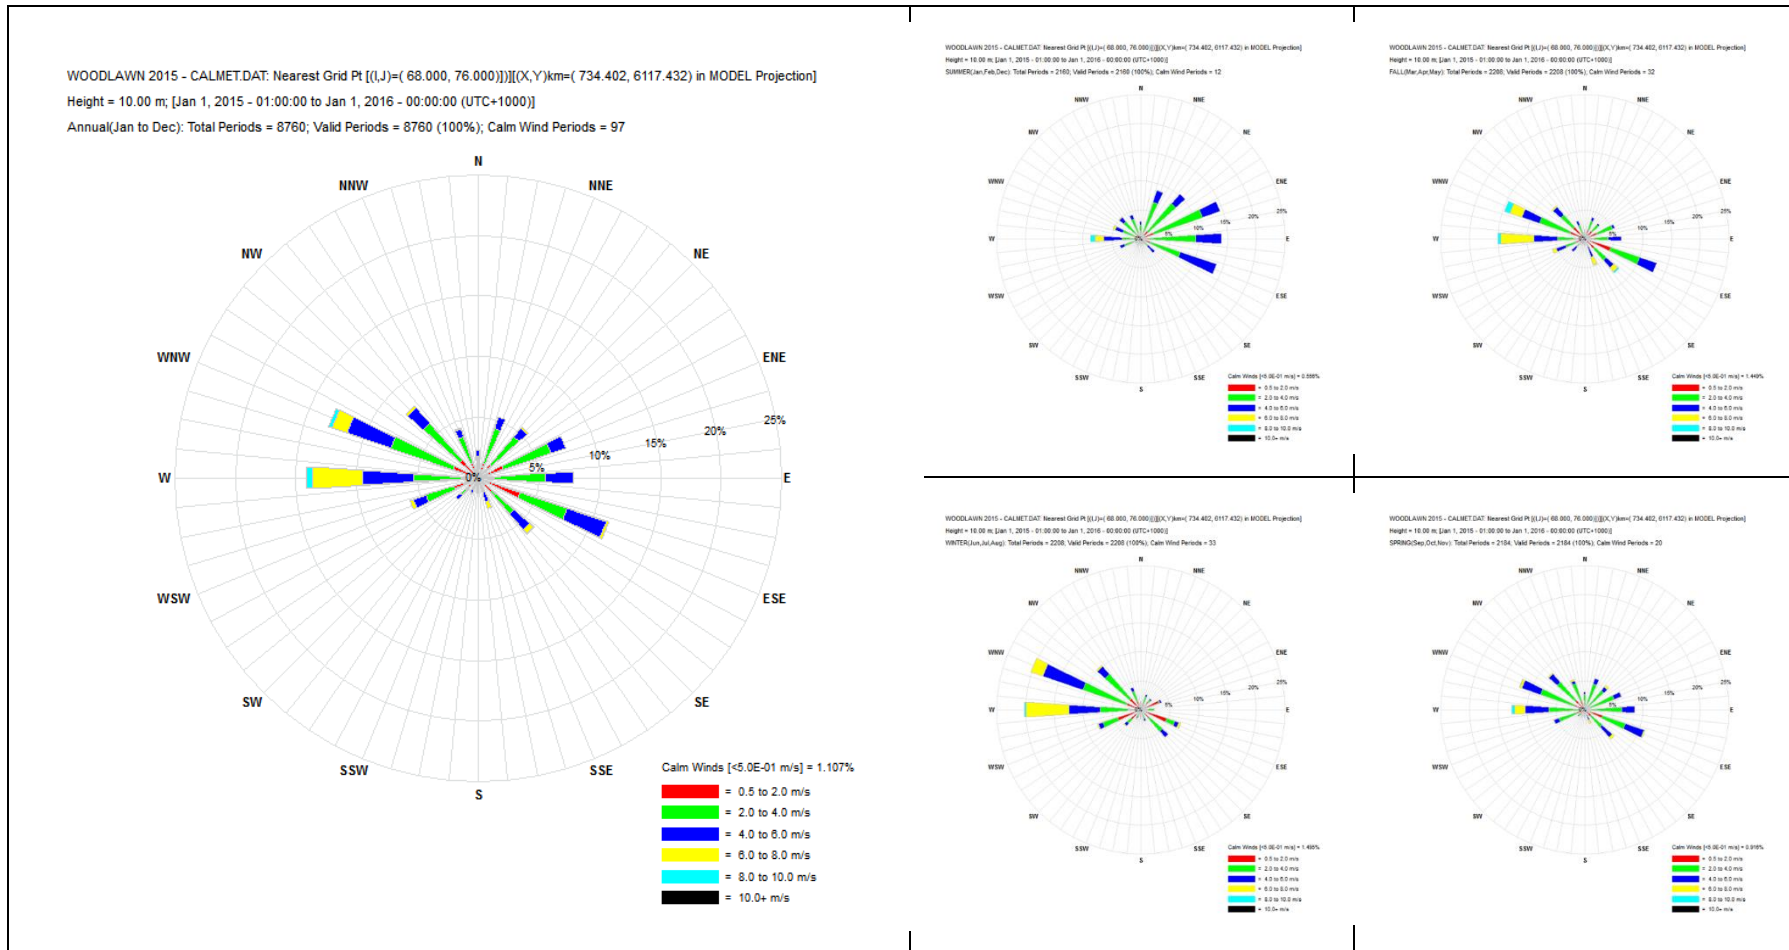



Figure 3.4 - Annual and seasonal windroses for Woodlawn 2015 (modelled)

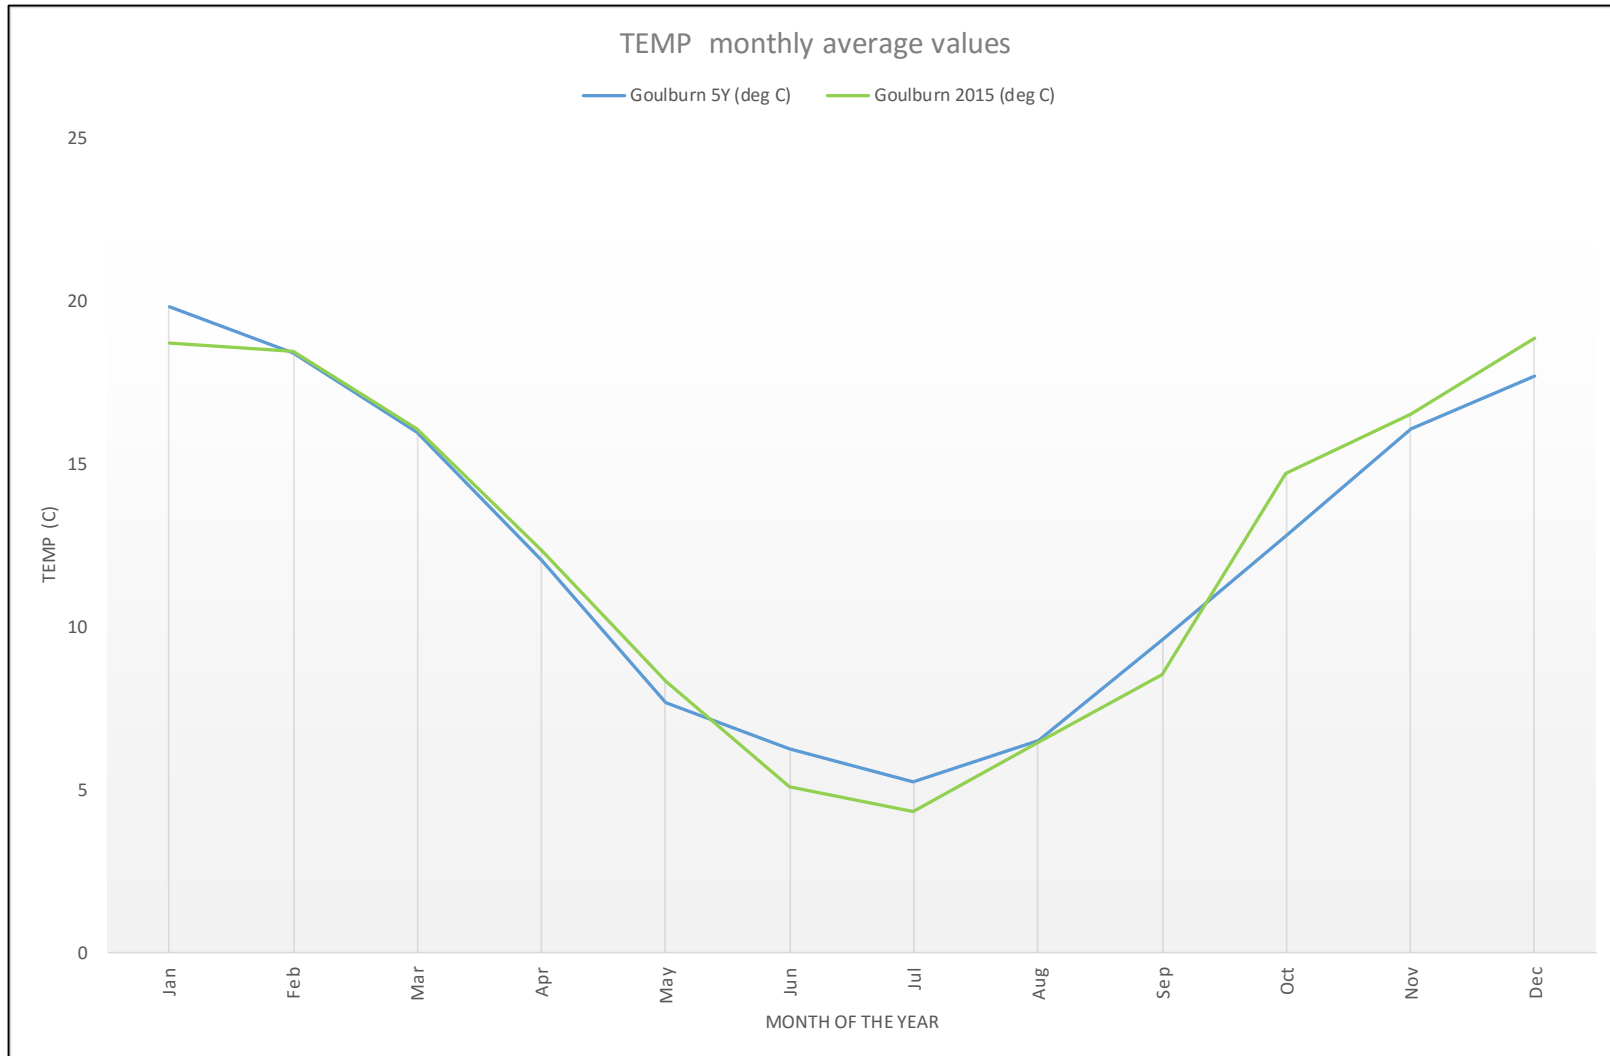

**Figure 3.5 - Monthly average temperatures for Goulburn Airport 5 years and 2015 only**

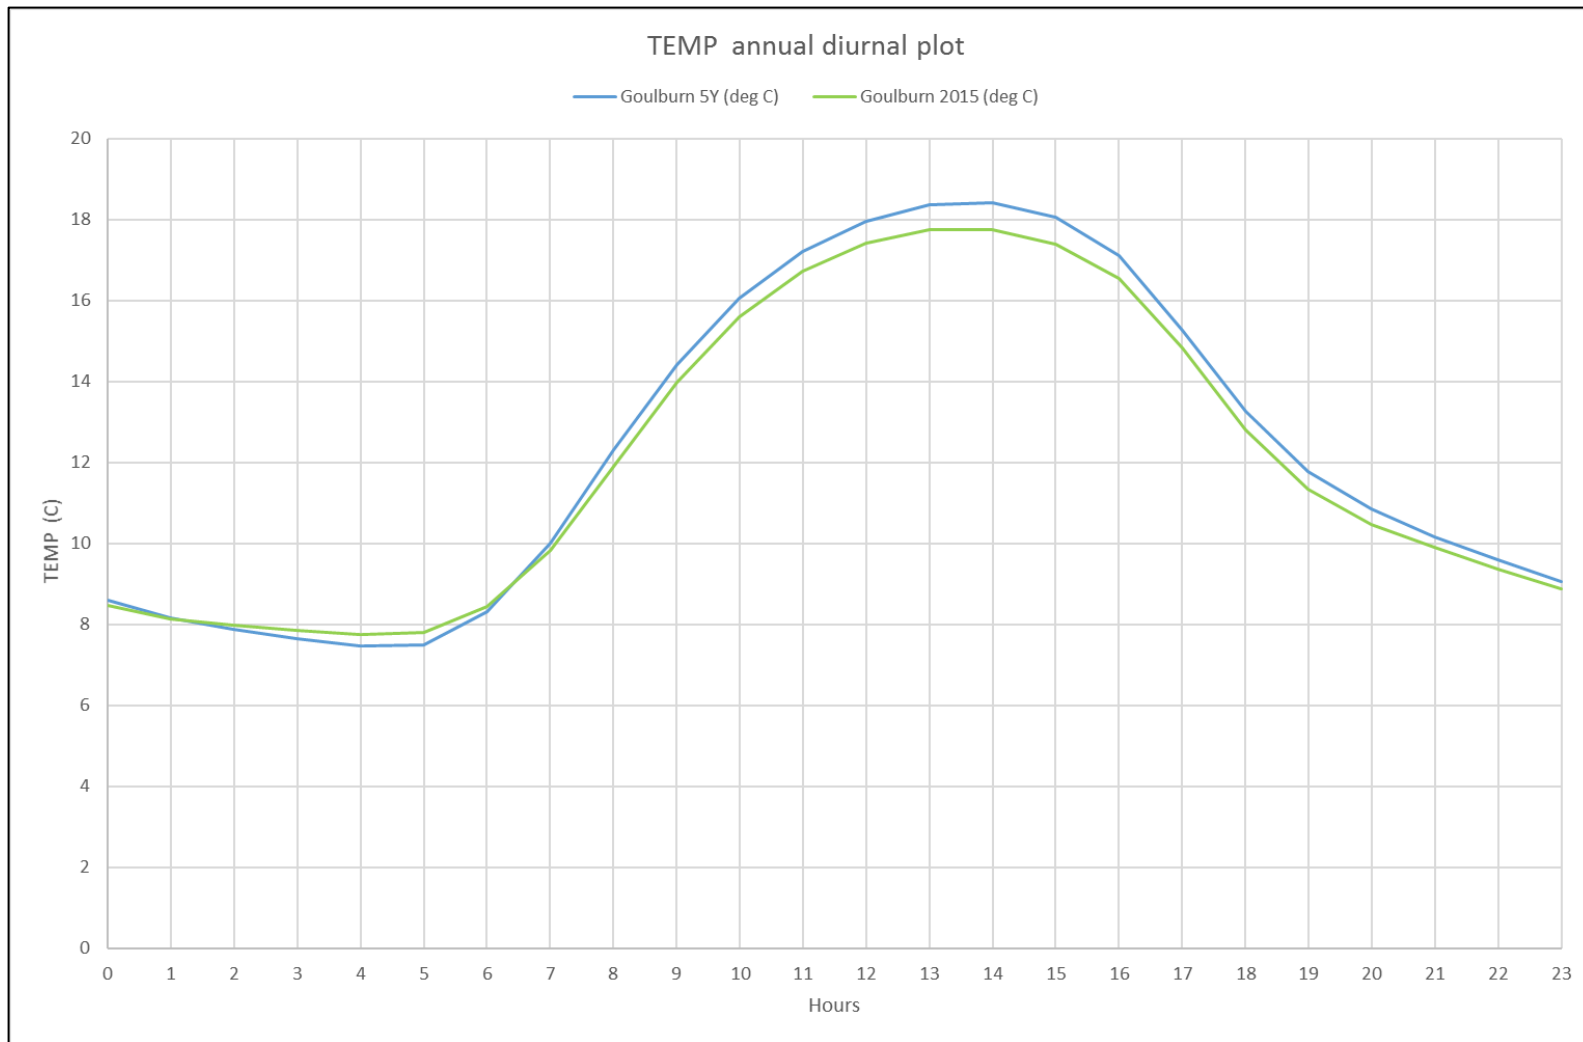

**Figure 3.6 - Annual diurnal temperature for Goulburn Airport 5 years and 2015 only**

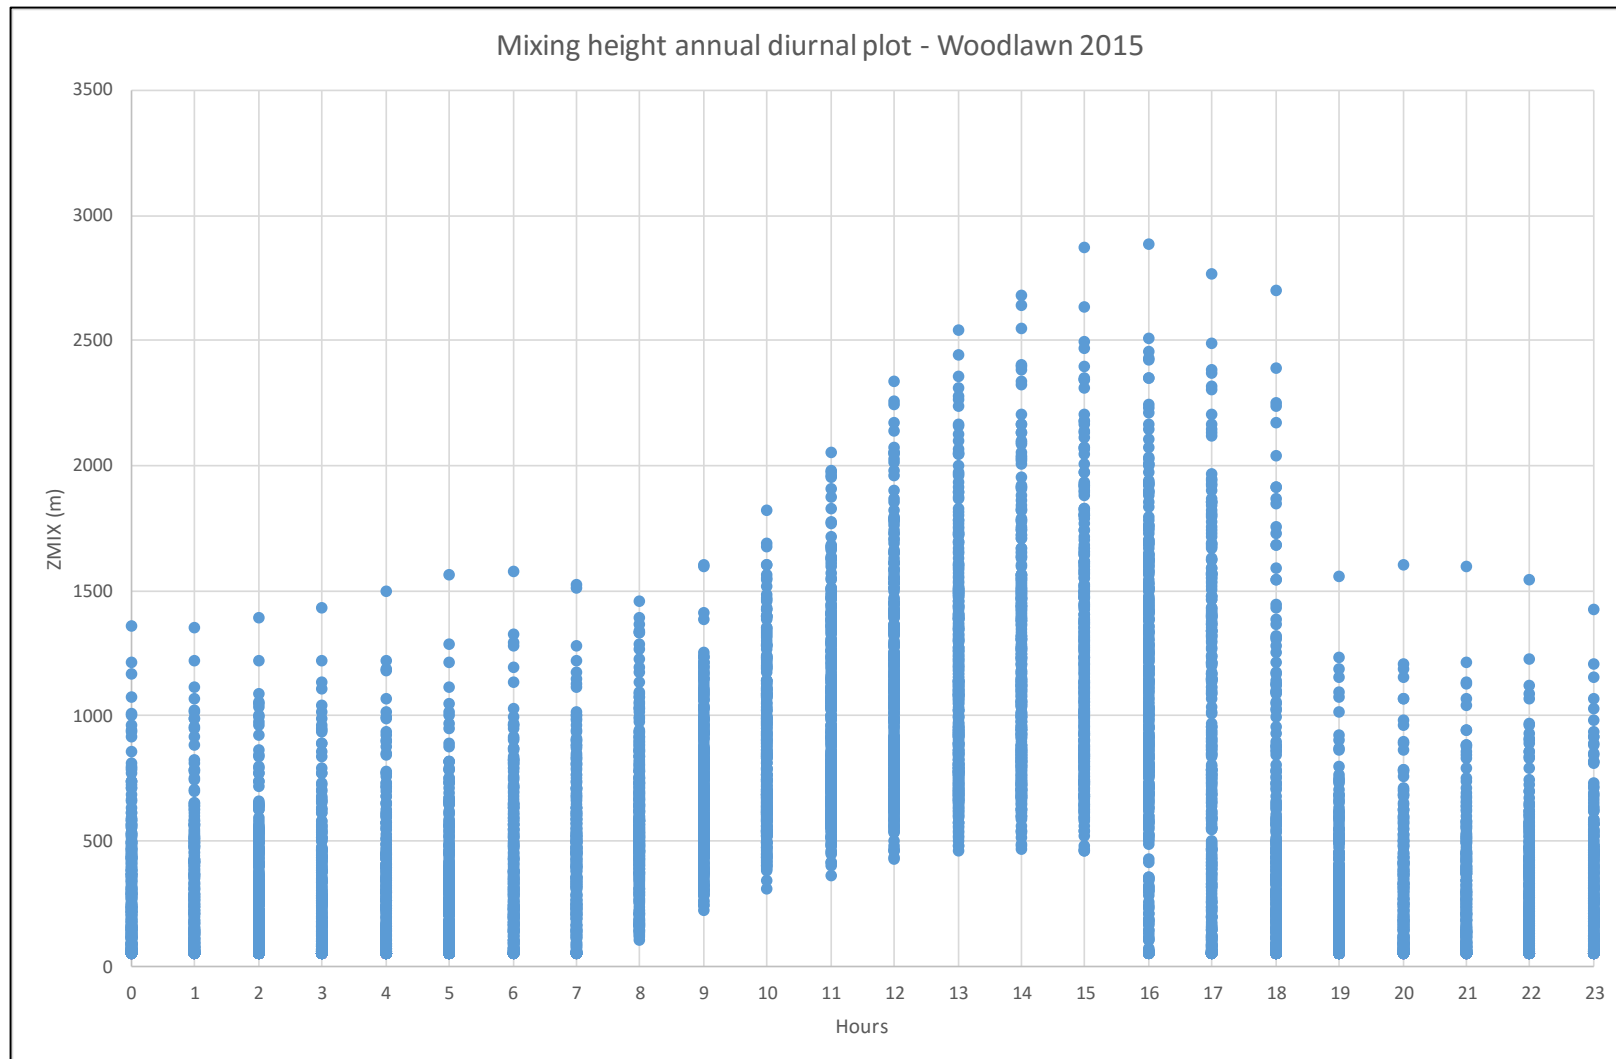

**Figure 3.7 - Annual X-Y scatter plot diurnal mixing height for Woodlawn 2015 (modelled)**

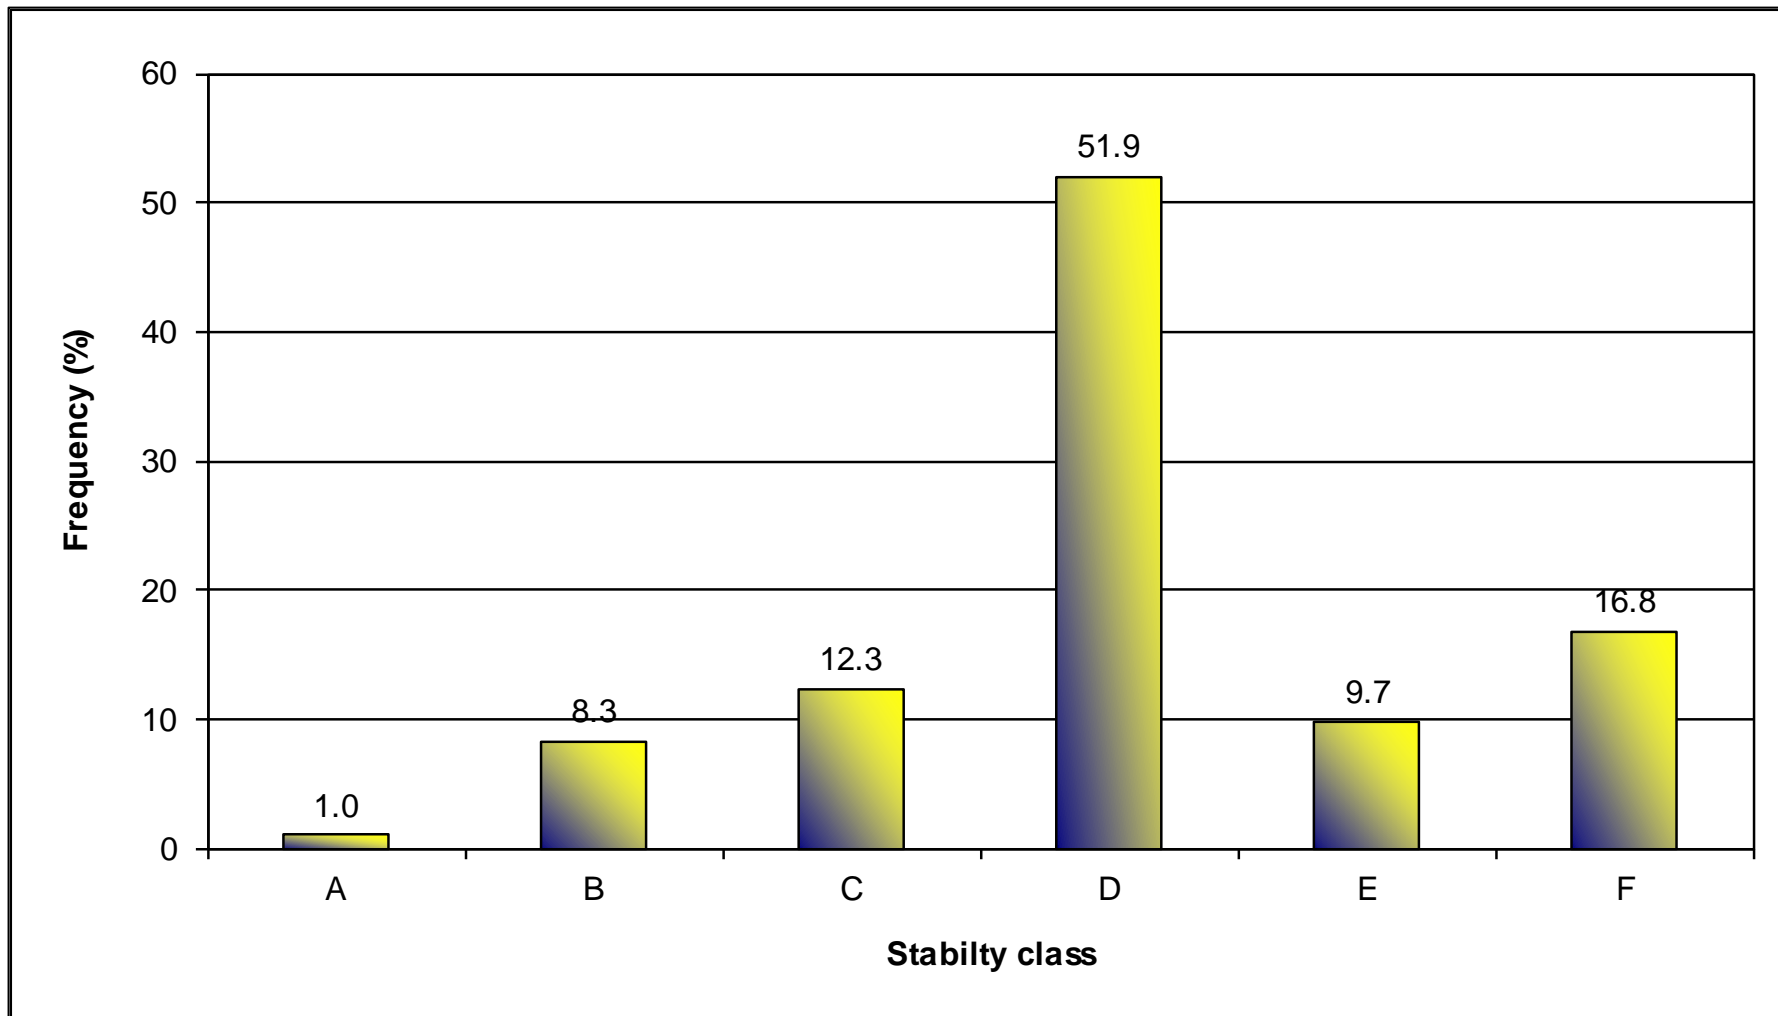


Figure 3.8 - Annual stability class frequency for Woodlawn 2015 (modelled)



### 3.4 CALPUFF DISPERSION MODEL CONFIGURATION

#### 3.4.1 Computational domain

The computational domain was set to the same parameters as the meteorological domain.

#### 3.4.2 Receptor configuration

Three groups of arbitrary discrete receptors were configured over the modelling domain. Four sensitive discrete receptors were placed at ground level at the same locations identified by the previous EA modelling (Heggies, 2010). A receptor grid was created with a fine resolution inner nest of 9.6 km by 9.6 km by 0.15 km spacing; and an outer nest of 19.35 km by 19.35 km by 0.45 km spacing.

#### 3.4.3 Source Configuration and Emission Rates

See **Appendix C** for full odour source and emission rate configurations. The CALPUFF model text output files can be produced upon request.

#### 3.4.4 CALPUFF Model Options

CALPUFF default model options were set except for the following as recommended in *Table A-4* contained and explained within *Barclay and Scire (2011)*:

- Dispersion coefficients (MDISP) = dispersion coefficients from internally calculated sigma v, sigma w using micrometeorological variables (2);
- Probability Density Function used for dispersion under convective conditions (MPDF) = Yes (1); and
- Minimum turbulence velocities sigma v for each stability class over land and water (SVMIN) = 0.2 m/s for A, B, C, D, E, F (0.200, 0.200, ... , 0.200).

### 3.5 MODELLING SENSITIVITY TEST SCENARIOS

The following sensitivity test scenarios were simulated with CALPUFF:

- **Scenario #1:** design target values;
- **Scenario #2:** if leachate quality is exceeded by a factor of 2 times from the design target value;
- **Scenario #3:** if leachate quality is exceeded by a factor of 5 times from the design target value; and
- **Scenario #4:** if leachate quality is exceeded by a factor of 10 times from the design target value.

A total surface area of 47.6 hectares (ha) was used for the ED1 system in the modelling. This represents the top water level (TWL) of ED1, when the maximum exposed surface area will occur. This is considered to represent a conservative approach and necessary as to assess the long term feasibility of treated leachate stored in the ED1 System from an odour performance viewpoint.


---

## 4 ODOUR DISPERSION MODELLING RESULTS

---

The odour dispersion modelling results are visually shown in **Figure 4.1**. These plots illustrate the isopleth of the projected ground level odour concentration against the 6 ou odour performance criterion concentration based on 1-hour averaging at the 99.0th percentile frequency at the nearest sensitive receptor.

The sensitivity analysis conducted for the long-term treated leachate solution under each modelled scenario show a negligible change in the extent of odour impact, even if the leachate quality target is exceeded by an order of magnitude. The results are considered conservative and were modelled on the basis of TWL i.e. when ED3S and ED1 Systems are full and are at their maximum exposed surface area.

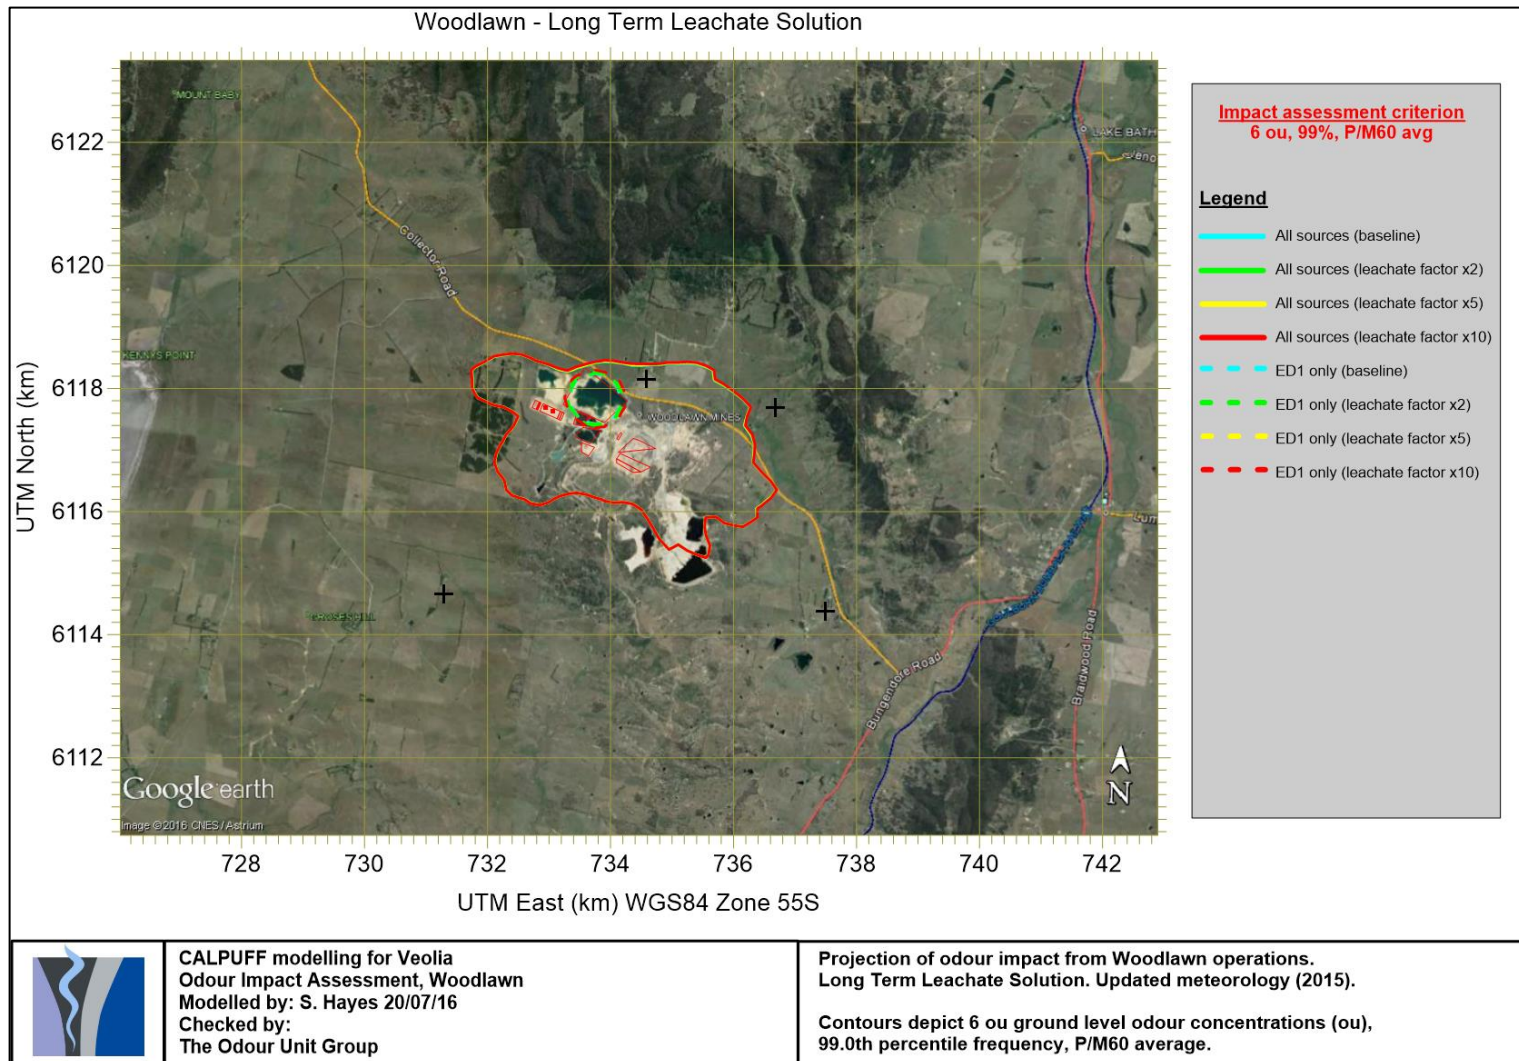

**Figure 4.1 – Long-term treated leachate solution (Scenarios #1 to #4)**

---

## 5 MODELLING STUDY FINDINGS & CONCLUSION

---

The aim of the odour dispersion modelling study was to evaluate the odour profile contribution and assess compliance against the NSW EPA odour performance criteria of the addition of the proposed ED1 System to the LMS at the Site. This also includes the proposed ED3S System, as discussed in **Section 2.1**. The modelling was conducted with the 6 ou odour performance criterion ground level concentration based on 1-hour averaging at the 99.0<sup>th</sup> percentile frequency at the nearest sensitive receptor. The modelling projection results demonstrate compliance with this criterion at the nearest sensitive receptor and minimal sensitivity to possible fluctuations in leachate quality of 2, 5 and 10 times above the target design value at TWL. On this basis, it can be safely concluded that the proposed MBR Treatment Plant and subsequent storage of the treated leachate flow in ED1 system will not result in any significant increase to off-site odour impacts, have negligible change on the existing surrounding off-site amenity, and is in compliance with the relevant NSW EPA odour performance criterion. This is attributable to the high leachate treatment quality criteria proposed (see **Table 2.2**).

Overall, the modelling study finds that the proposed MBR Treatment Plant and subsequent storage of the final treated effluent will not result in any adverse levels of odour impact, and represents a sustainable, long term solution for the management and storage of leachate at the Site.

---

## 6 BIBLIOGRAPHY

---

- The Odour Unit Pty Ltd, May 2016, *Woodlawn Bioreactor Modelling Study - Proposed Addition of ED3S to Leachate Management System*, Final Report, May 2016
- The Odour Unit Pty Ltd, December 2015, *Woodlawn Bioreactor Expansion Project – Independent Odour Audit #4 – Final Report*
- Wessel, P. & Smith, W. H. F., 2015, *Global Self-consistent Hierarchical High-resolution Geography*, National Oceanic and Atmospheric Administration - National Centers for Environmental Information
- Environmental Assessment Woodlawn Expansion Project Volume 2 – Appendices, March 2011, *Appendix D – Air Quality and Odour Assessment*.
- SLR Consulting Australia Pty Ltd, *Odour and Dust Impact Assessment*, February 2011, 30-2464-R2, Revision 7
- Atmospheric Studies Group, 2011, *CALPUFF Modeling System Version 6 User Instructions*, Lowell: TRC Environmental Corporation.
- Gallant, J. C. et al, 2011, *1 second SRTM Derived Digital Elevation Models User Guide*, Canberra: Geoscience Australia.
- Environmental Assessment Woodlawn Expansion Project Volume 1 – Main Report, August 2010, *Chapter 9 – Air Quality and Odour Assessment*.
- Environment Protection Authority, 2006, *Technical Framework: Assessment and management of odour from stationary sources*, Sydney, Department of Environment and Conservation.
- Environment Protection Authority, 2006, *Technical notes: assessment and management of odour from stationary sources in NSW*, Sydney, Department of Environment and Conservation.
- Environment Protection Authority, 2005, *Approved Methods for the Modelling and Assessment of Air Pollutants in New South Wales*, Sydney, Department of Environment and Conservation.

- United States Geological Survey, 1997, Global Land Cover Characteristics Database.

---

## REPORT SIGNATURE PAGE

---

The Odour Unit Pty Ltd (NSW)

**P:** (02) 9209 4420

**F:** (02) 9209 4421

**E:** [info@odourunit.com.au](mailto:info@odourunit.com.au)

**ABN:** 53 091 165 061



Michael Assal  
Senior Engineer & Consultant



Steven Hayes  
Senior Atmospheric Scientist &  
Consultant





THE ODOUR  
UNIT



**Veolia Australia & New Zealand**

---

**Woodlawn Bioreactor Facility Odour  
Modelling Study**

---

**Long-term Treated Leachate Solution**

**July 2016**

**Appendices**



THE ODOUR  
UNIT



# **Veolia Australia & New Zealand**

---

## **APPENDIX A:**

### **LEACHATE AND ODOUR QUALITY CORRELATION ANALYSIS WORKSHEET**

---

## **Long-term Treated Leachate Solution**

**July 2016**



Job No.	N1806L00										
Document Title	Appendix A - Veolia Woodlawn Odour Treatment Long Term Solution: Leachate and odour quality correlation analysis worksheet										
Sample Location	Specific Odour Emission Rate (ou.m3/m2/s)	H2S (ppm)	pH	BOD (mg/L)	Sulphide (mg/L)	Ammonia (as N) (mg/L)	VFA (mg/L)	Odour character			
Untreated	394.2	180	7.8	7,200	0.4	1,700	6,100	rotten egg			
Partially Treated	20.1	8.0	8.0	3,600	0.3	754	3,090	rotten egg, onion, cabbage			
LAD -1	0.323	0.000	8.9	1,700	0.1	285	285	sweet, garbage, ammonia			
LAD -2	0.0269	0.000	8.6	154	0.02	186	960	stale water			
Treated & Stored - 1	0.187	0.000	8.7	81	0.5	105	338	stagnant water, dirty water, fatty, greasy, sweet onion, grain wheat			
Treated & Stored - 2	0.0364	0.003	8.3	73	0.3	153	646	musty, soil, rubber, stale water, burnt, ruffy, sewage, cooking oil, fat, rubbery, dusty, stale air			
Sample Location	Specific Odour Emission Rate (ou.m3/m2/s)	H2S (ppm)									
Untreated	394.2	180									
Partially Treated	20.1	8.0									
LAD -1	0.323	0.000									
LAD -2	0.0269	0.000									
Treated & Stored - 1	0.187	0.000									
Treated & Stored - 2	0.0364	0.003									
Covariance statistics			Specific Odour Emission Rate (ou.m3/m2/s)	H2S (ppm)							
			Specific Odour Emission Rate (ou.m3/m2/s)	21187.47519							
			H2S (ppm)	9606.19475							
			4429.056443								
Correlation Statistics			Specific Odour Emission Rate (ou.m3/m2/s)	H2S (ppm)							
			Specific Odour Emission Rate (ou.m3/m2/s)	1							
			H2S (ppm)	0.999979653							
			1								
Sample Location	Specific Odour Emission Rate (ou.m3/m2/s)	pH									
Untreated	394.2	7.8									
Partially Treated	20.1	8.0									
LAD -1	0.323	8.9									
LAD -2	0.0269	8.6									
Treated & Stored - 1	0.187	8.7									
Treated & Stored - 2	0.0364	8.3									
Covariance statistics			Specific Odour Emission Rate (ou.m3/m2/s)	pH							
			Specific Odour Emission Rate (ou.m3/m2/s)	21187.47519							
			pH	-38.79848801							
			0.150242284								
Correlation Statistics			Specific Odour Emission Rate (ou.m3/m2/s)	pH							
			Specific Odour Emission Rate (ou.m3/m2/s)	1							
			pH	-0.687667579							
			1								
Sample Location	Specific Odour Emission Rate (ou.m3/m2/s)	BOD (mg/L)									
Untreated	394.2	7,200									
Partially Treated	20.1	3,600									
LAD -1	0.323	1,700									
LAD -2	0.0269	154									
Treated & Stored - 1	0.187	81									
Treated & Stored - 2	0.0364	73									
Covariance statistics			Specific Odour Emission Rate (ou.m3/m2/s)	BOD (mg/L)							
			Specific Odour Emission Rate (ou.m3/m2/s)	21187.47519							
			BOD (mg/L)	31750.3624							
			6731165.225								
Correlation Statistics			Specific Odour Emission Rate (ou.m3/m2/s)	BOD (mg/L)							
			Specific Odour Emission Rate (ou.m3/m2/s)	1							
			BOD (mg/L)	0.894012612							
			1								
Sample Location	Specific Odour Emission Rate (ou.m3/m2/s)	Sulphide (mg/L)									
Untreated	394.2	0.4									
Partially Treated	20.1	0.3									
LAD -1	0.323	0.1									
LAD -2	0.0269	0.02									
Treated & Stored - 1	0.187	0.5									
Treated & Stored - 2	0.0364	0.3									
Covariance statistics			Specific Odour Emission Rate (ou.m3/m2/s)	Sulphide (mg/L)							
			Specific Odour Emission Rate (ou.m3/m2/s)	21187.47519							
			Sulphide (mg/L)	8.532460277							
			0.028070139								
Correlation Statistics			Specific Odour Emission Rate (ou.m3/m2/s)	Sulphide (mg/L)							
			Specific Odour Emission Rate (ou.m3/m2/s)	1							
			Sulphide (mg/L)	0.351928312							
			1								
Sample Location	Specific Odour Emission Rate (ou.m3/m2/s)	Ammonia (as N) (mg/L)									
Untreated	394.2	1,700									
Partially Treated	20.1	754									
LAD -1	0.323	285									
LAD -2	0.0269	186									
Treated & Stored - 1	0.187	105									
Treated & Stored - 2	0.0364	153									
Covariance statistics			Specific Odour Emission Rate (ou.m3/m2/s)	Ammonia (as N) (mg/L)							
			Specific Odour Emission Rate (ou.m3/m2/s)	21187.47519							
			Ammonia (as N) (mg/L)	7750.136875							
			319982.4849								
Correlation Statistics			Specific Odour Emission Rate (ou.m3/m2/s)	Ammonia (as N) (mg/L)							
			Specific Odour Emission Rate (ou.m3/m2/s)	1							
			Ammonia (as N) (mg/L)	0.9419829309							
			1								
Sample Location	Specific Odour Emission Rate (ou.m3/m2/s)	VFA (mg/L)									
Untreated	394.2	6,100									
Partially Treated	20.1	3,090									
LAD -1	0.323	285									
LAD -2	0.0269	960									
Treated & Stored - 1	0.187	338									
Treated & Stored - 2	0.0364	646									
Covariance statistics			Specific Odour Emission Rate (ou.m3/m2/s)	VFA (mg/L)							
			Specific Odour Emission Rate (ou.m3/m2/s)	21187.47519							
			VFA (mg/L)	274444.3055							
			4707211.875								
Correlation Statistics			Specific Odour Emission Rate (ou.m3/m2/s)	VFA (mg/L)							
			Specific Odour Emission Rate (ou.m3/m2/s)	1							
			VFA (mg/L)	0.869027221							
			1								



## **Veolia Australia & New Zealand**

---

### **APPENDIX B:**

**BUREAU OF METEOROLOGY BASIC  
CLIMATOLOGICAL STATION METADATA –  
GOULBURN AIRPORT (COMPLIED 26  
NOVEMBER 2015)**

---

**Long-term Treated Leachate Solution**

**July 2016**



## Basic Climatological Station Metadata

Current status

**Metadata compiled: 26 NOV 2015**

**Station:** GOULBURN AIRPORT AWS

**Bureau of Meteorology station number:** 070330

**Bureau of Meteorology district name:** Sthn Tablelands Gburn-Monaro

**State:** NSW

**World Meteorological Organization number:** 95716

**Identification:** YGLB

**Network Classification:** National Benchmark Network for Agrometeorology

**Station purpose:** Synoptic, Aeronautical

**Automatic Weather Station:** Almos



Current Station Location				
<b>Latitude</b>	<b>Decimal</b>	-34.8085	<b>Hour Min Sec</b>	34°48'31"S
<b>Longitude</b>	<b>Decimal</b>	149.7312	<b>Hour Min Sec</b>	149°43'52"E
<b>Station Height</b>	640 m	<b>Barometer Height</b>	640.8 m	
<b>Method of station geographic positioning</b>			GPS	

**Year opened:** 1988

**Status:** Open

## Station summary

No summary for this site has been written as yet.

**Historical metadata for this site has not been quality controlled for accuracy and completeness. Data other than current station information, particularly earlier than 1998, should be considered accordingly. Information may not be complete, as backfilling of historical data is incomplete.**

Prepared by the Bureau of Meteorology.

Contact us by phone on (03) 9669 4082, by fax on (03) 9669 4515, or by email on [climatedata@bom.gov.au](mailto:climatedata@bom.gov.au)

Station metadata is compiled for a range of internal purposes and varies in quality and completeness. The Bureau cannot provide any warranty nor accept any liability for this information. © Copyright Commonwealth of Australia 2015, Bureau of Meteorology.




## Basic Climatological Station Metadata

Current status

<b>Station:</b> GOULBURN AIRPORT AWS	<b>Location:</b> GOULBURN AIRPORT AWS			<b>State:</b> NSW
<b>Bureau No.:</b> 070330	<b>WMO No.:</b> 95716	<b>Aviation ID:</b> YGLB	<b>Opened:</b> 07 Nov 1988	<b>Current Status:</b> Still open
<b>Latitude:</b> -34.8085	<b>Longitude:</b> 149.7312	<b>Elevation:</b> 640 m	<b>Barometer Elev:</b> 640.8 m	<b>Metadata compiled:</b> 26 NOV 2015

### Observation summary

The table below indicates the approximate completeness of the record for individual element types within the Australian Data Archive for Meteorology. For elements not listed see the note below.

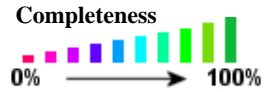

#### DAILY DATA HOLDINGS

OBSERVATION TYPE	FIRST MONTH	LAST MONTH	COMPLETENESS (% estimate)	SINGLE DAYS MISSED	FULL MONTHS MISSED
<b>MAXIMUM AIR TEMPERATURE</b>	JUL 1990	OCT 2015	95.9	372	0
1 8 5 0	1 9 0 0	1 9 0 0	1 9 5 0	2 0 0 0	0 0 0 0
<b>MAXIMUM WIND GUST SPEED</b>	JUN 2003	OCT 2015	98.8	53	0
1 8 5 0	1 9 0 0	1 9 0 0	1 9 5 0	2 0 0 0	0 0 0 0
<b>WIND RUN ABOVE 10 FEET</b>	JUN 2003	OCT 2015	98.7	57	0
1 8 5 0	1 9 0 0	1 9 0 0	1 9 5 0	2 0 0 0	0 0 0 0
<b>RAINFALL</b>	JUN 1994	NOV 2015	94	N/A	N/A
1 8 5 0	1 9 0 0	1 9 0 0	1 9 5 0	2 0 0 0	0 0 0 0

#### HOURLY DATA HOLDINGS - from 1 to 24 observations per day

OBSERVATION TYPE	FIRST MONTH	LAST MONTH	COMPLETENESS (% estimate)	FREQUENCY average daily	SINGLE DAYS MISSED	FULL MONTHS MISSED
<b>AIR TEMPERATURE</b>	AUG 1989	OCT 2015	97.7	8.6	61	0
1 8 5 0	1 9 0 0	1 9 0 0	1 9 5 0	2 0 0 0	0 0 0 0	0 0 0 0
<b>DEW POINT</b>	AUG 1989	OCT 2015	97.4	8.6	64	0
1 8 5 0	1 9 0 0	1 9 0 0	1 9 5 0	2 0 0 0	0 0 0 0	0 0 0 0
<b>MEAN SEA LEVEL PRESSURE</b>	SEP 1995	OCT 2015	98.4	8.9	42	0
1 8 5 0	1 9 0 0	1 9 0 0	1 9 5 0	2 0 0 0	0 0 0 0	0 0 0 0
<b>TOTAL CLOUD AMOUNT</b>	AUG 1995	OCT 2015	8.3	5.4	111	217
1 8 5 0	1 9 0 0	1 9 0 0	1 9 5 0	2 0 0 0	0 0 0 0	0 0 0 0
<b>WIND SPEED</b>	AUG 1989	OCT 2015	97.7	8.6	59	0
1 8 5 0	1 9 0 0	1 9 0 0	1 9 5 0	2 0 0 0	0 0 0 0	0 0 0 0

**Historical metadata for this site has not been quality controlled for accuracy and completeness. Data other than current station information, particularly earlier than 1998, should be considered accordingly. Information may not be complete, as backfilling of historical data is incomplete.**

Prepared by the Bureau of Meteorology.

Contact us by phone on (03) 9669 4082, by fax on (03) 9669 4515, or by email on [climatedata@bom.gov.au](mailto:climatedata@bom.gov.au)

Station metadata is compiled for a range of internal purposes and varies in quality and completeness. The Bureau cannot provide any warranty nor accept any liability for this information. © Copyright Commonwealth of Australia 2015, Bureau of Meteorology.



## Basic Climatological Station Metadata

Current status

<b>Station:</b>	GOULBURN AIRPORT AWS		<b>Location:</b>	GOULBURN AIRPORT AWS		<b>State:</b>	NSW	
<b>Bureau No.:</b>	070330	<b>WMO No.:</b>	95716	<b>Aviation ID:</b>	YGLB	<b>Opened:</b>	07 Nov 1988	
<b>Latitude:</b>	-34.8085	<b>Longitude:</b>	149.7312	<b>Elevation:</b>	640 m	<b>Barometer Elev:</b>	640.8 m	
							<b>Current Status:</b>	Still open
							<b>Metadata compiled:</b>	26 NOV 2015

### THERE ARE NO RAINFALL INTENSITY DATA HOLDINGS

#### ONE-MINUTE DATA HOLDINGS

OBSERVATION TYPE	FIRST MONTH	LAST MONTH	COMPLETENESS (% estimate)	FREQUENCY average daily	SINGLE DAYS MISSED	FULL MONTHS MISSED
ALL ELEMENTS	SEP 2010	NOV 2015	99.1	1427.4	N/A	0

#### HALF-HOURLY DATA HOLDINGS

OBSERVATION TYPE	FIRST MONTH	LAST MONTH	COMPLETENESS (% estimate)	FREQUENCY average daily	SINGLE DAYS MISSED	FULL MONTHS MISSED
ALL ELEMENTS	JAN 1989	NOV 2015	72.1	34.6	N/A	2

### THERE ARE NO UPPER-AIR EDT DATA HOLDINGS

#### Holdings calculated up to 01 Nov 2015

The % complete figure is the completeness of observations averaged over all months of record, for the given station and observation type, taking gaps into account. For hourly holdings, the completeness is relative to the maximum number of daily observations for the site each month, and is therefore an estimate. For daily holdings, the completeness figure shown is exact.

The single days missed figure is the total number of days for which no observation was received, not including full missed months. The full months missed figure is the total of full month gaps over the period of record. Where an element is not included assumptions can generally be made about availability, and the list to use has been suggested below.

#### Unlisted element

Minimum air temperature  
Wet bulb temperature  
Soil temperature at 20, 50 & 100cm  
Relative humidity  
Minimum temp. of water in evaporimeter  
Visual observations eg. weather, visibility  
Sea related observations

#### Listed element to use

Maximum air temperature  
Dew point  
10cm soil temperature  
Dew point  
Evaporimeter - max water temp  
Total cloud amount  
Sea state

**Historical metadata for this site has not been quality controlled for accuracy and completeness. Data other than current station information, particularly earlier than 1998, should be considered accordingly. Information may not be complete, as backfilling of historical data is incomplete.**

Prepared by the Bureau of Meteorology.

Contact us by phone on (03) 9669 4082, by fax on (03) 9669 4515, or by email on [climatedata@bom.gov.au](mailto:climatedata@bom.gov.au)

Station metadata is compiled for a range of internal purposes and varies in quality and completeness. The Bureau cannot provide any warranty nor accept any liability for this information. © Copyright Commonwealth of Australia 2015, Bureau of Meteorology.




## Extended Climatological Station Metadata

All History

<b>Station:</b> GOULBURN AIRPORT AWS	<b>Location:</b> GOULBURN AIRPORT AWS			<b>State:</b> NSW
<b>Bureau No.:</b> 070330	<b>WMO No.:</b> 95716	<b>Aviation ID:</b> YGLB	<b>Opened:</b> 07 Nov 1988	<b>Current Status:</b> Still open
<b>Latitude:</b> -34.8085	<b>Longitude:</b> 149.7312	<b>Elevation:</b> 640 m	<b>Barometer Elev:</b> 640.8 m	<b>Metadata compiled:</b> 26 NOV 2015

### Instrument Location and Surrounding Features

17/11/2010(most recent)

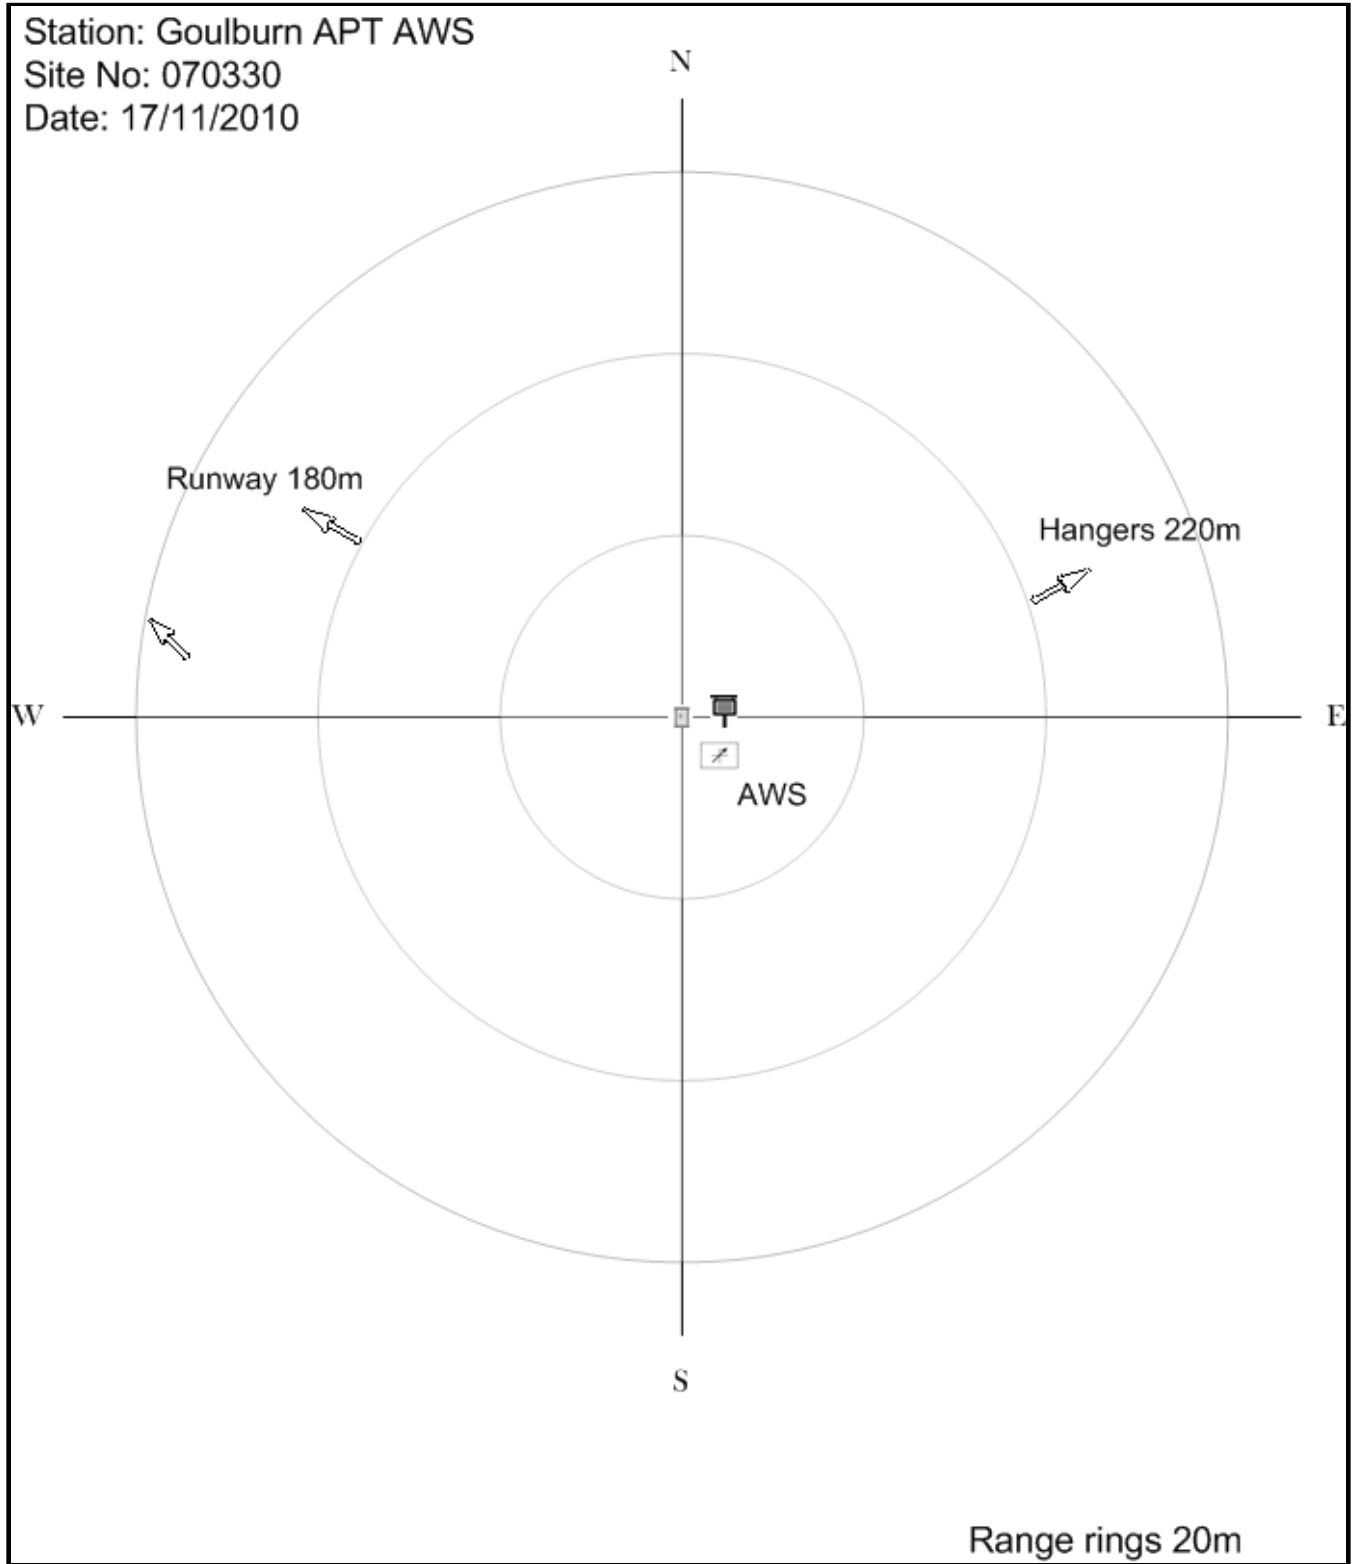

**Historical metadata for this site has not been quality controlled for accuracy and completeness. Data other than current station information, particularly earlier than 1998, should be considered accordingly. Information may not be complete, as backfilling of historical data is incomplete.**

Prepared by the Bureau of Meteorology.

Contact us by phone on (03) 9669 4082, by fax on (03) 9669 4515, or by email on [climatedata@bom.gov.au](mailto:climatedata@bom.gov.au)

Station metadata is compiled for a range of internal purposes and varies in quality and completeness. The Bureau cannot provide any warranty nor accept any liability for this information. © Copyright Commonwealth of Australia 2015, Bureau of Meteorology.






## Extended Climatological Station Metadata

All History

<b>Station:</b>	GOULBURN AIRPORT AWS		<b>Location:</b>	GOULBURN AIRPORT AWS		<b>State:</b>	NSW	
<b>Bureau No.:</b>	070330	<b>WMO No.:</b>	95716	<b>Aviation ID:</b>	YGLB	<b>Opened:</b>	07 Nov 1988	
<b>Latitude:</b>	-34.8085	<b>Longitude:</b>	149.7312	<b>Elevation:</b>	640 m	<b>Barometer Elev:</b>	640.8 m	
							<b>Current Status:</b>	Still open
							<b>Metadata compiled:</b>	26 NOV 2015

### Instrument Location and Surrounding Features

26/03/2007

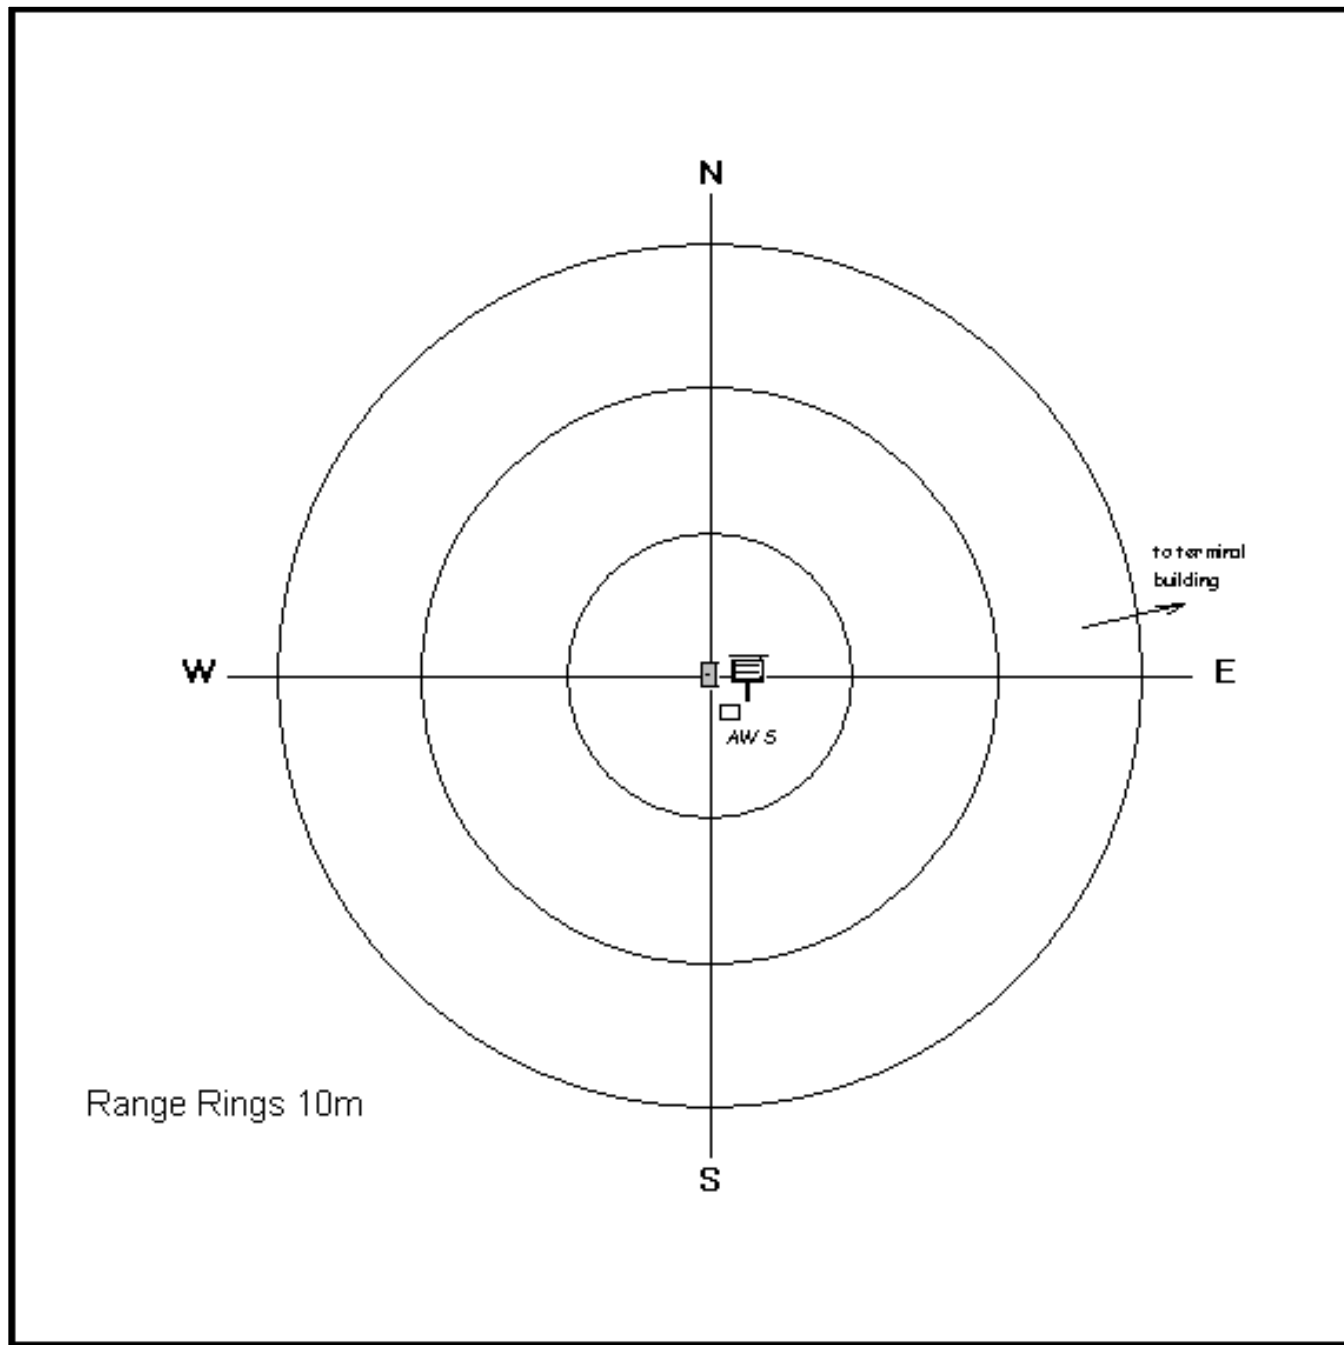

**Historical metadata for this site has not been quality controlled for accuracy and completeness. Data other than current station information, particularly earlier than 1998, should be considered accordingly. Information may not be complete, as backfilling of historical data is incomplete.**

Prepared by the Bureau of Meteorology.

Contact us by phone on (03) 9669 4082, by fax on (03) 9669 4515, or by email on [climatedata@bom.gov.au](mailto:climatedata@bom.gov.au)

Station metadata is compiled for a range of internal purposes and varies in quality and completeness. The Bureau cannot provide any warranty nor accept any liability for this information. © Copyright Commonwealth of Australia 2015, Bureau of Meteorology.




## Extended Climatological Station Metadata

All History

<b>Station:</b>	GOULBURN AIRPORT AWS		<b>Location:</b>	GOULBURN AIRPORT AWS		<b>State:</b>	NSW	
<b>Bureau No.:</b>	070330	<b>WMO No.:</b>	95716	<b>Aviation ID:</b>	YGLB	<b>Opened:</b>	07 Nov 1988	
<b>Latitude:</b>	-34.8085	<b>Longitude:</b>	149.7312	<b>Elevation:</b>	640 m	<b>Barometer Elev:</b>	640.8 m	
							<b>Current Status:</b>	Still open
							<b>Metadata compiled:</b>	26 NOV 2015

### Instrument Location and Surrounding Features

13/11/2002

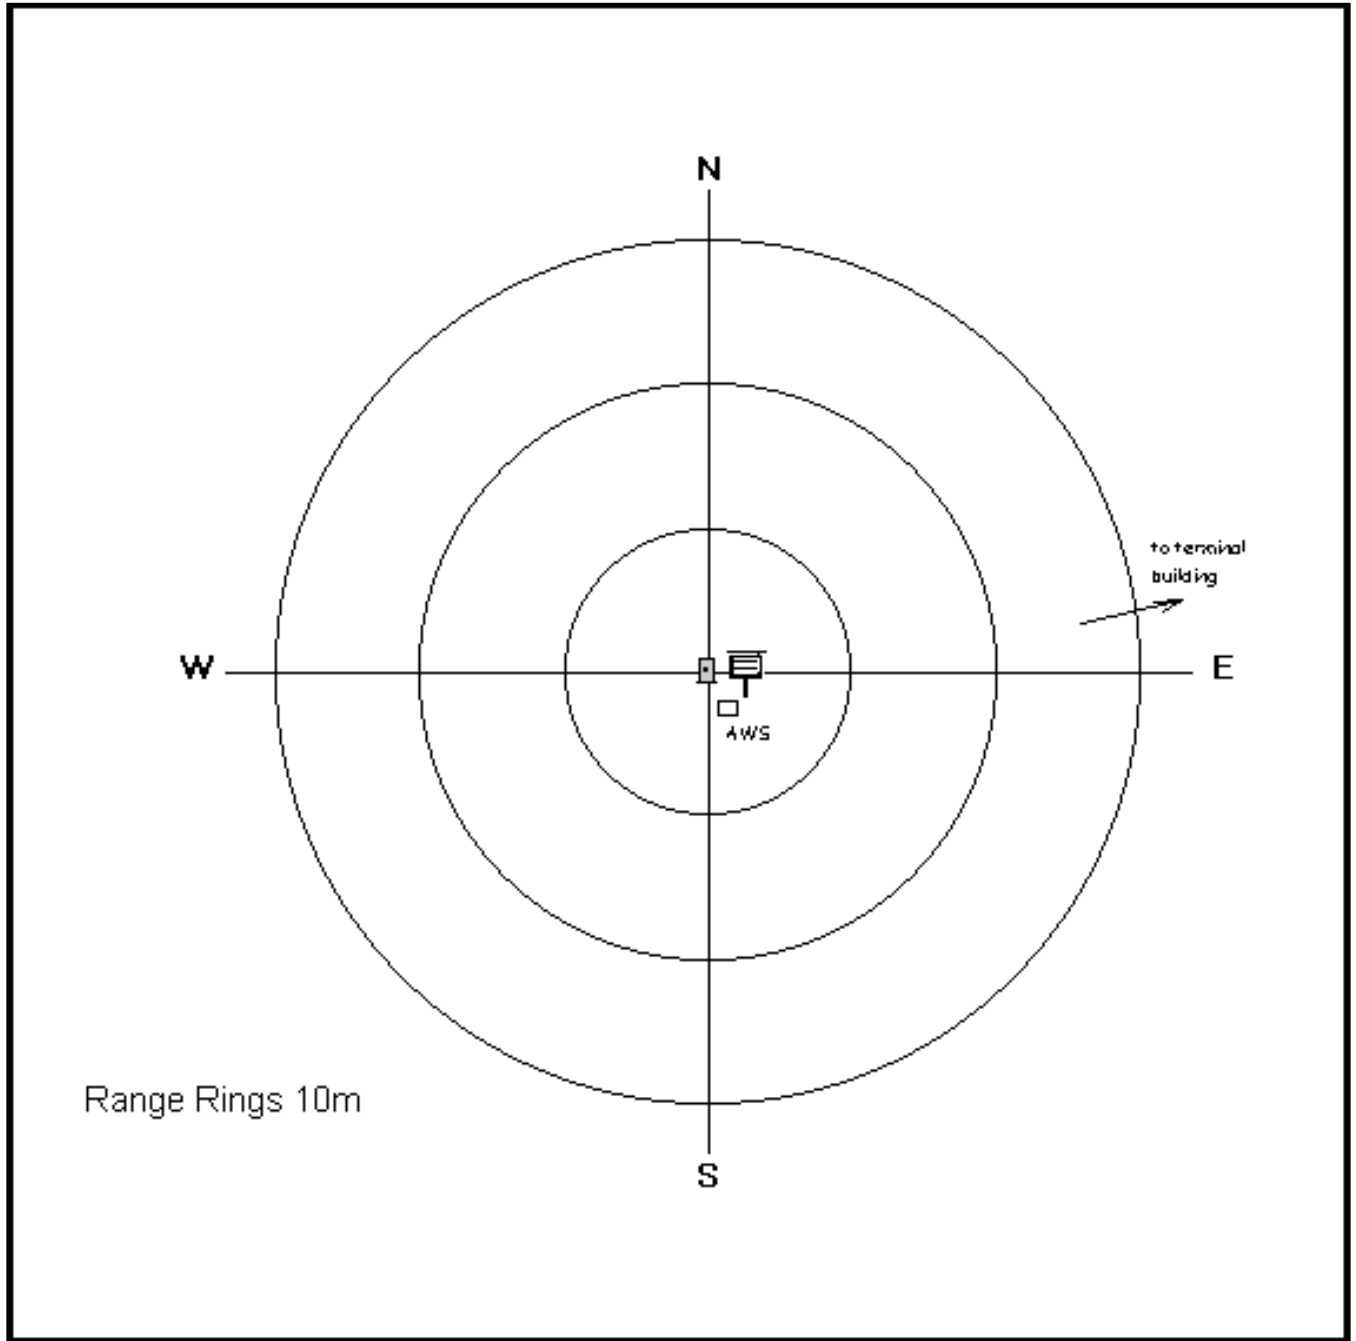

**Historical metadata for this site has not been quality controlled for accuracy and completeness. Data other than current station information, particularly earlier than 1998, should be considered accordingly. Information may not be complete, as backfilling of historical data is incomplete.**

Prepared by the Bureau of Meteorology.

Contact us by phone on (03) 9669 4082, by fax on (03) 9669 4515, or by email on [climatedata@bom.gov.au](mailto:climatedata@bom.gov.au)

Station metadata is compiled for a range of internal purposes and varies in quality and completeness. The Bureau cannot provide any warranty nor accept any liability for this information. © Copyright Commonwealth of Australia 2015, Bureau of Meteorology.




## Extended Climatological Station Metadata

All History

<b>Station:</b> GOULBURN AIRPORT AWS	<b>Location:</b> GOULBURN AIRPORT AWS			<b>State:</b> NSW
<b>Bureau No.:</b> 070330	<b>WMO No.:</b> 95716	<b>Aviation ID:</b> YGLB	<b>Opened:</b> 07 Nov 1988	<b>Current Status:</b> Still open
<b>Latitude:</b> -34.8085	<b>Longitude:</b> 149.7312	<b>Elevation:</b> 640 m	<b>Barometer Elev:</b> 640.8 m	<b>Metadata compiled:</b> 26 NOV 2015

### Instrument Location and Surrounding Features

27/03/2001

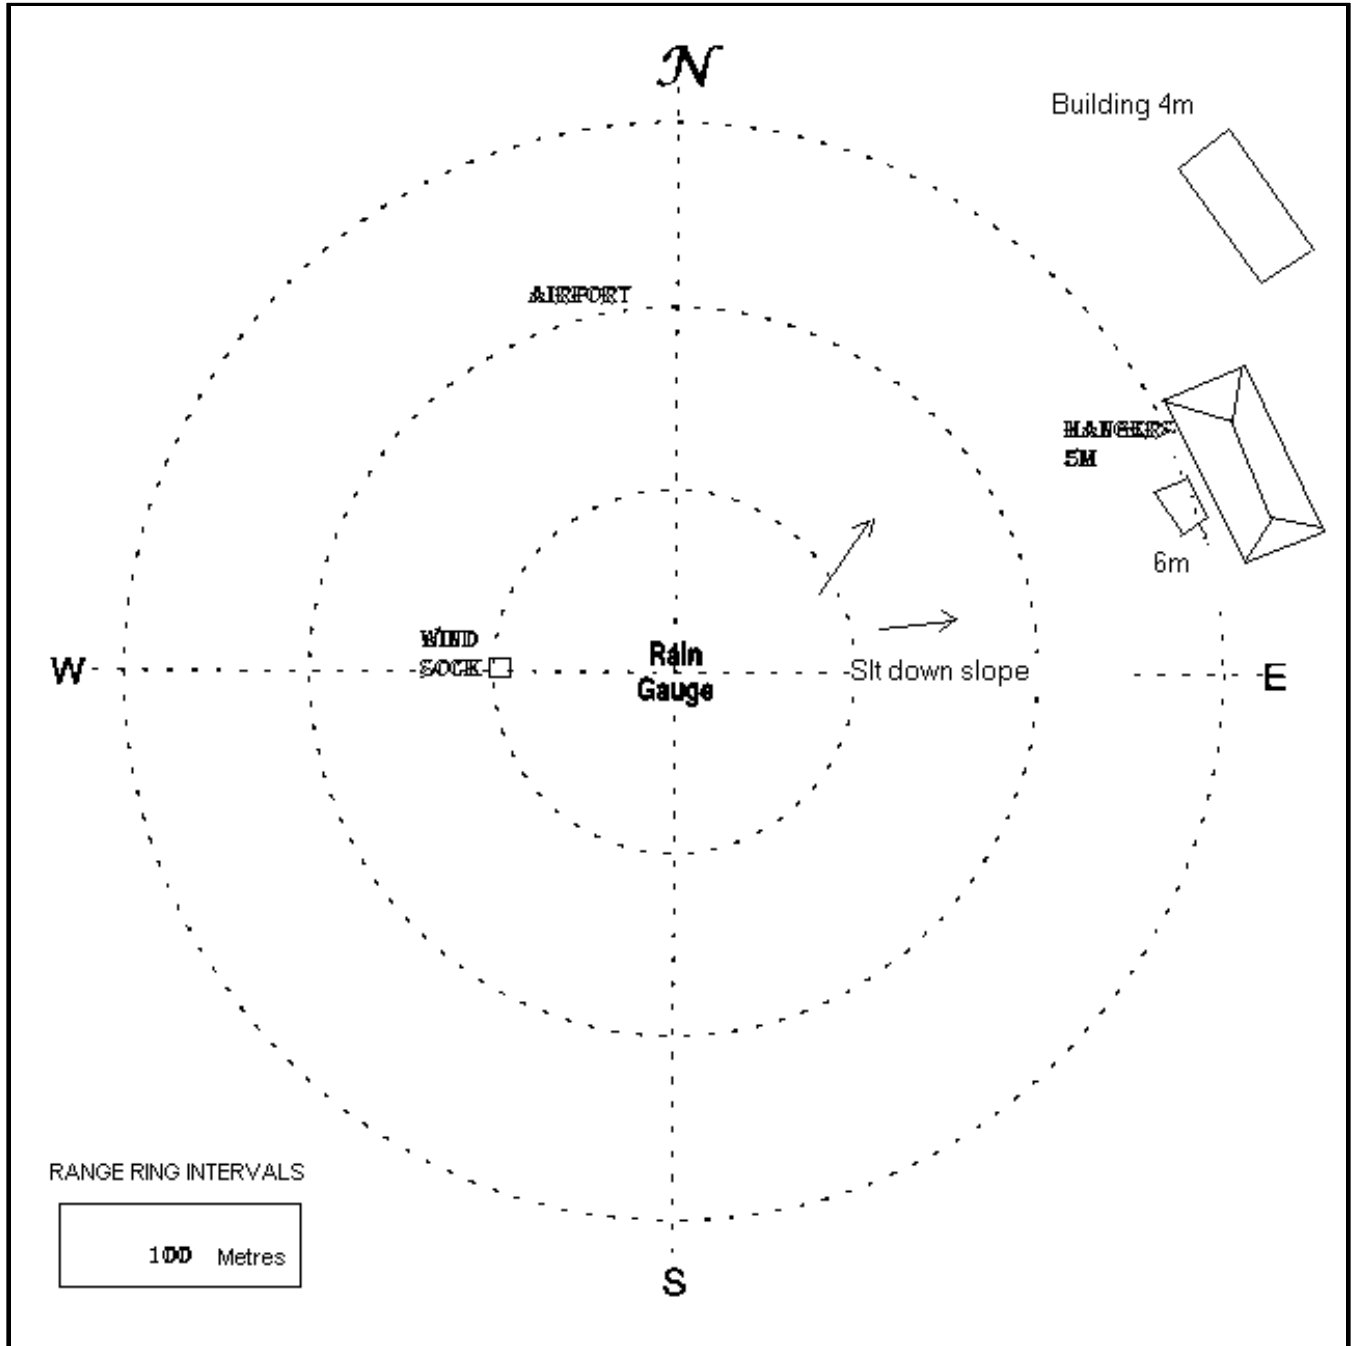

**Historical metadata for this site has not been quality controlled for accuracy and completeness. Data other than current station information, particularly earlier than 1998, should be considered accordingly. Information may not be complete, as backfilling of historical data is incomplete.**

Prepared by the Bureau of Meteorology.

Contact us by phone on (03) 9669 4082, by fax on (03) 9669 4515, or by email on [climatedata@bom.gov.au](mailto:climatedata@bom.gov.au)

Station metadata is compiled for a range of internal purposes and varies in quality and completeness. The Bureau cannot provide any warranty nor accept any liability for this information. © Copyright Commonwealth of Australia 2015, Bureau of Meteorology.




## Extended Climatological Station Metadata

All History

<b>Station:</b>	GOULBURN AIRPORT AWS		<b>Location:</b>	GOULBURN AIRPORT AWS		<b>State:</b>	NSW
<b>Bureau No.:</b>	070330	<b>WMO No.:</b>	95716	<b>Aviation ID:</b>	YGLB	<b>Opened:</b>	07 Nov 1988
<b>Latitude:</b>	-34.8085	<b>Longitude:</b>	149.7312	<b>Elevation:</b>	640 m	<b>Barometer Elev:</b>	640.8 m
						<b>Current Status:</b>	Still open
						<b>Metadata compiled:</b>	26 NOV 2015

### Instrument Location and Surrounding Features

09/03/1998

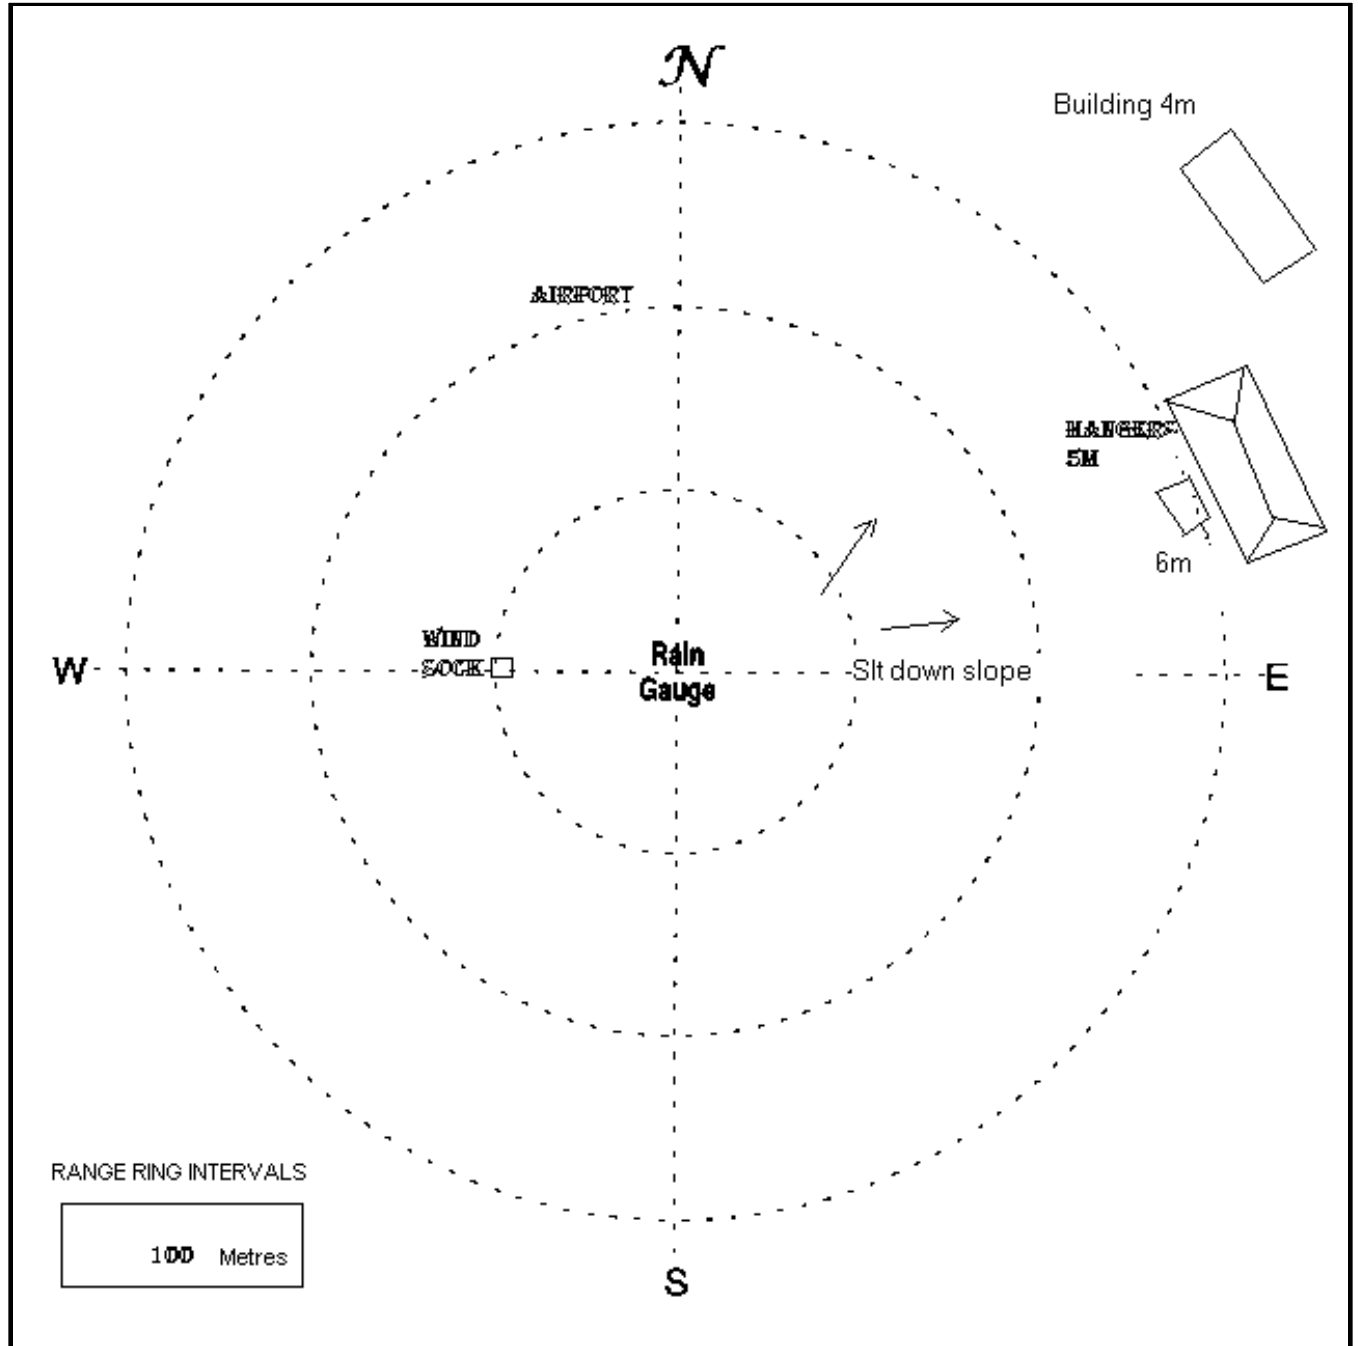

**Historical metadata for this site has not been quality controlled for accuracy and completeness. Data other than current station information, particularly earlier than 1998, should be considered accordingly. Information may not be complete, as backfilling of historical data is incomplete.**

Prepared by the Bureau of Meteorology.

Contact us by phone on (03) 9669 4082, by fax on (03) 9669 4515, or by email on [climatedata@bom.gov.au](mailto:climatedata@bom.gov.au)

Station metadata is compiled for a range of internal purposes and varies in quality and completeness. The Bureau cannot provide any warranty nor accept any liability for this information. © Copyright Commonwealth of Australia 2015, Bureau of Meteorology.




## Extended Climatological Station Metadata

All History

<b>Station:</b> GOULBURN AIRPORT AWS	<b>Location:</b> GOULBURN AIRPORT AWS			<b>State:</b> NSW
<b>Bureau No.:</b> 070330	<b>WMO No.:</b> 95716	<b>Aviation ID:</b> YGLB	<b>Opened:</b> 07 Nov 1988	<b>Current Status:</b> Still open
<b>Latitude:</b> -34.8085	<b>Longitude:</b> 149.7312	<b>Elevation:</b> 640 m	<b>Barometer Elev:</b> 640.8 m	<b>Metadata compiled:</b> 26 NOV 2015

### Skyline Diagram 11/02/2014(most recent)

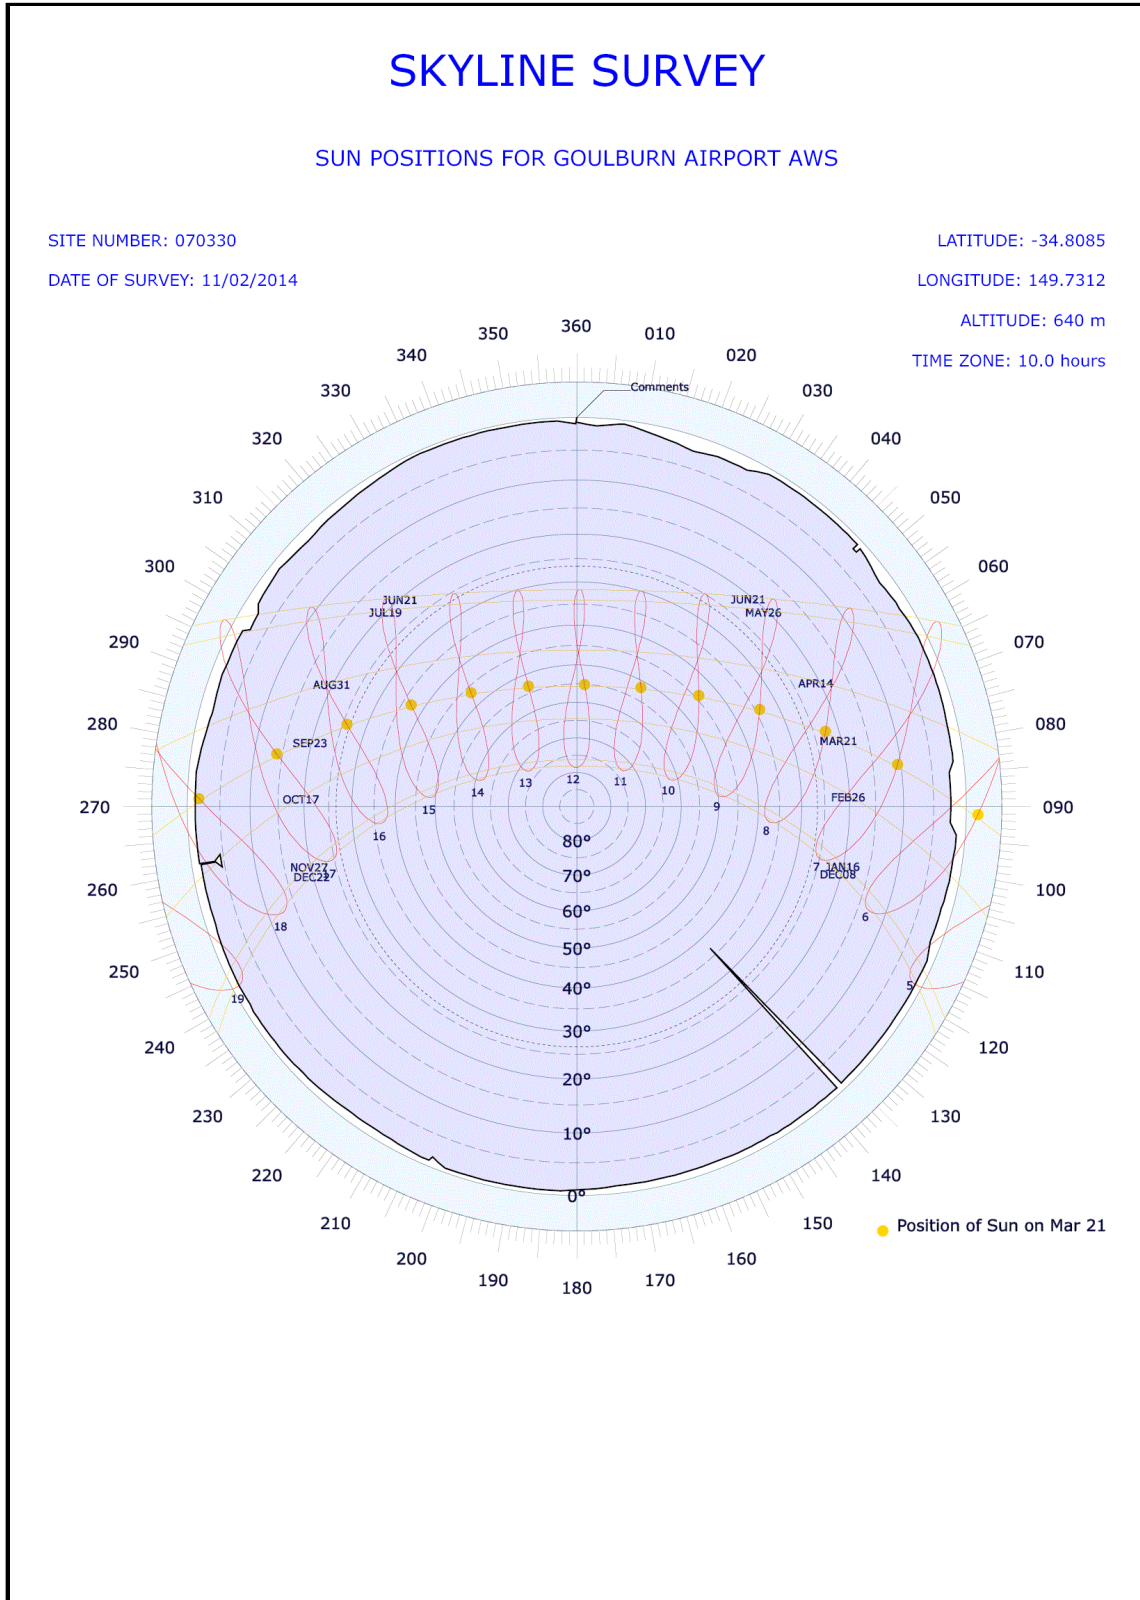

**Historical metadata for this site has not been quality controlled for accuracy and completeness. Data other than current station information, particularly earlier than 1998, should be considered accordingly. Information may not be complete, as backfilling of historical data is incomplete.**

Prepared by the Bureau of Meteorology.

Contact us by phone on (03) 9669 4082, by fax on (03) 9669 4515, or by email on [climatedata@bom.gov.au](mailto:climatedata@bom.gov.au)

Station metadata is compiled for a range of internal purposes and varies in quality and completeness. The Bureau cannot provide any warranty nor accept any liability for this information. © Copyright Commonwealth of Australia 2015, Bureau of Meteorology.




## Extended Climatological Station Metadata

All History

<b>Station:</b> GOULBURN AIRPORT AWS	<b>Location:</b> GOULBURN AIRPORT AWS			<b>State:</b> NSW
<b>Bureau No.:</b> 070330	<b>WMO No.:</b> 95716	<b>Aviation ID:</b> YGLB	<b>Opened:</b> 07 Nov 1988	<b>Current Status:</b> Still open
<b>Latitude:</b> -34.8085	<b>Longitude:</b> 149.7312	<b>Elevation:</b> 640 m	<b>Barometer Elev:</b> 640.8 m	<b>Metadata compiled:</b> 26 NOV 2015

### Skyline Diagram

06/09/2009

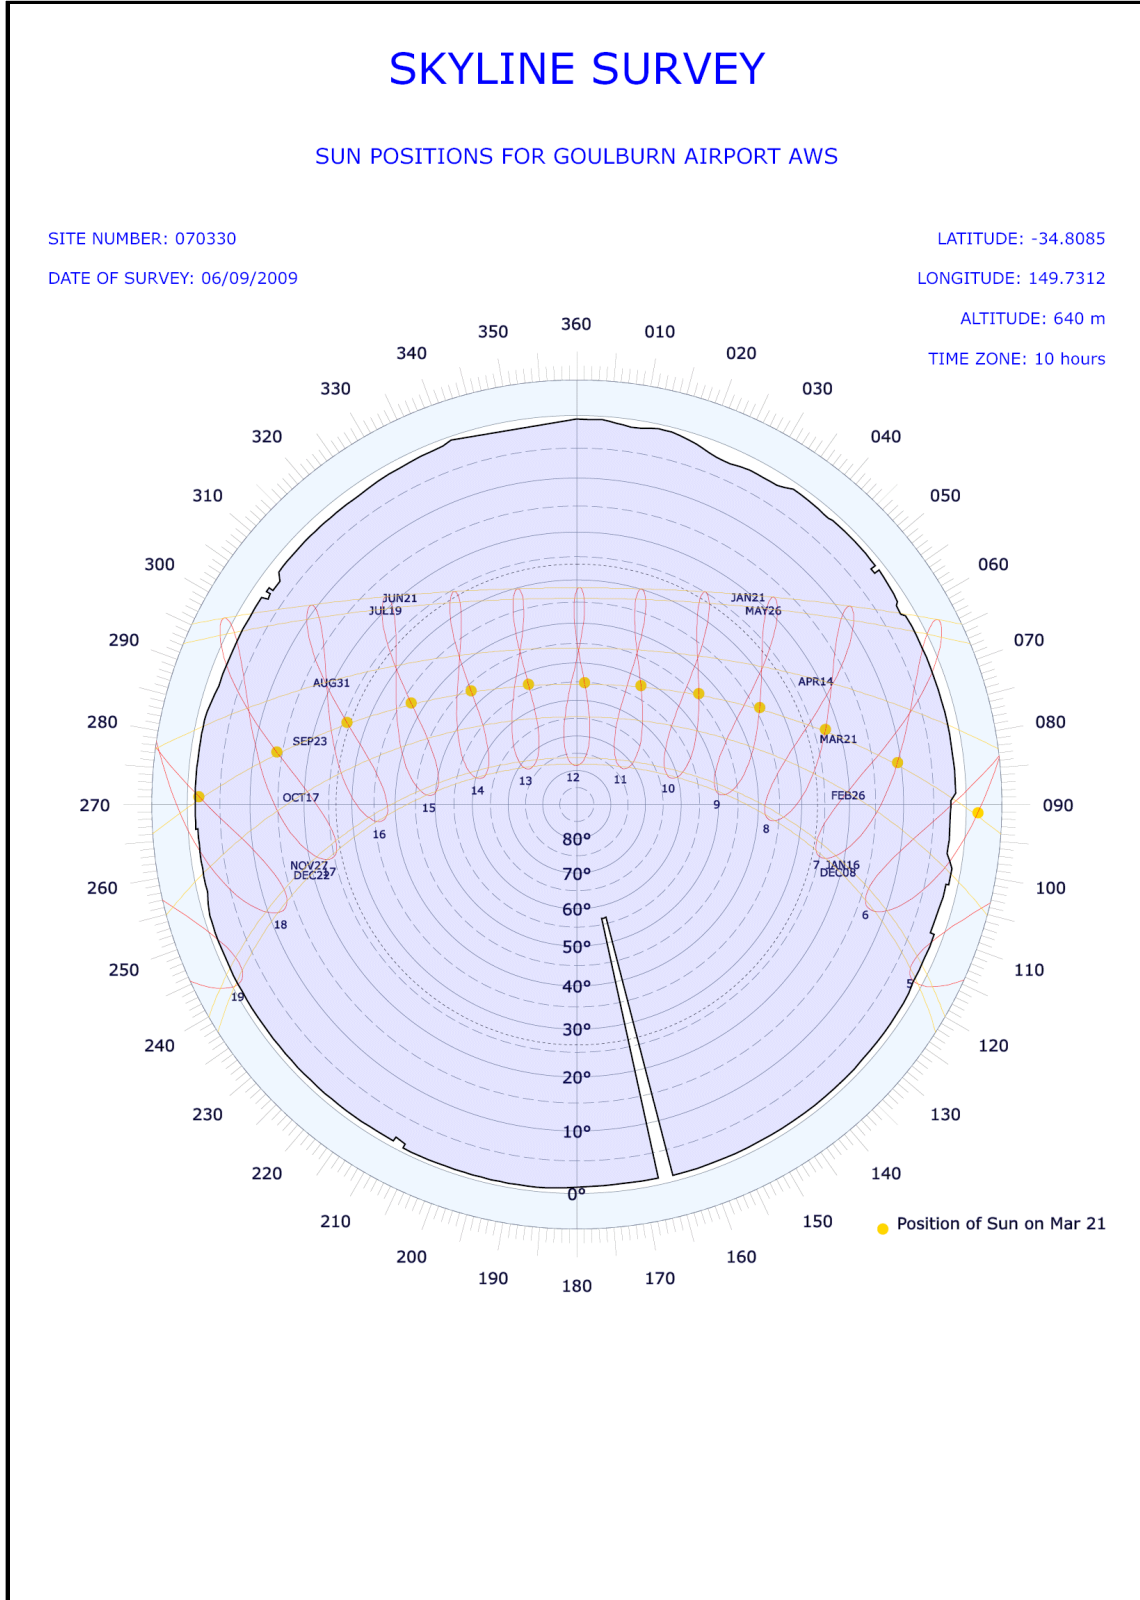

**Historical metadata for this site has not been quality controlled for accuracy and completeness. Data other than current station information, particularly earlier than 1998, should be considered accordingly. Information may not be complete, as backfilling of historical data is incomplete.**

Prepared by the Bureau of Meteorology.

Contact us by phone on (03) 9669 4082, by fax on (03) 9669 4515, or by email on [climatedata@bom.gov.au](mailto:climatedata@bom.gov.au)

Station metadata is compiled for a range of internal purposes and varies in quality and completeness. The Bureau cannot provide any warranty nor accept any liability for this information. © Copyright Commonwealth of Australia 2015, Bureau of Meteorology.




## Extended Climatological Station Metadata

All History

<b>Station:</b> GOULBURN AIRPORT AWS	<b>Location:</b> GOULBURN AIRPORT AWS			<b>State:</b> NSW
<b>Bureau No.:</b> 070330	<b>WMO No.:</b> 95716	<b>Aviation ID:</b> YGLB	<b>Opened:</b> 07 Nov 1988	<b>Current Status:</b> Still open
<b>Latitude:</b> -34.8085	<b>Longitude:</b> 149.7312	<b>Elevation:</b> 640 m	<b>Barometer Elev:</b> 640.8 m	<b>Metadata compiled:</b> 26 NOV 2015

### Skyline Diagram

24/02/2004

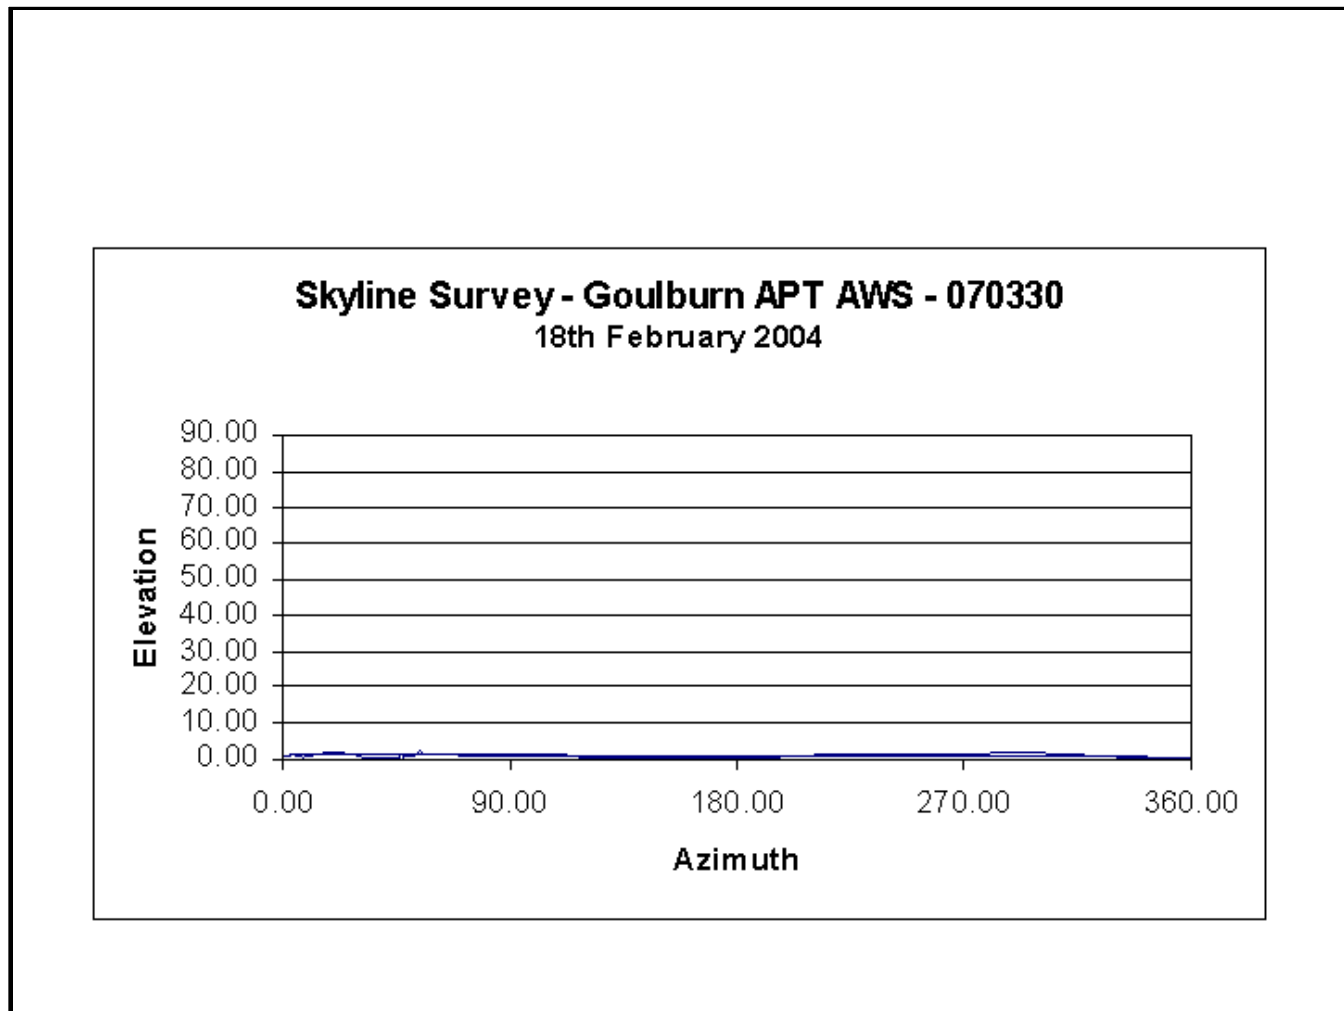

**Historical metadata for this site has not been quality controlled for accuracy and completeness. Data other than current station information, particularly earlier than 1998, should be considered accordingly. Information may not be complete, as backfilling of historical data is incomplete.**

Prepared by the Bureau of Meteorology.

Contact us by phone on (03) 9669 4082, by fax on (03) 9669 4515, or by email on [climatedata@bom.gov.au](mailto:climatedata@bom.gov.au)

Station metadata is compiled for a range of internal purposes and varies in quality and completeness. The Bureau cannot provide any warranty nor accept any liability for this information. © Copyright Commonwealth of Australia 2015, Bureau of Meteorology.



## Extended Climatological Station Metadata

All History

<b>Station:</b>	GOULBURN AIRPORT AWS		<b>Location:</b>	GOULBURN AIRPORT AWS		<b>State:</b>	NSW		
<b>Bureau No.:</b>	070330	<b>WMO No.:</b>	95716	<b>Aviation ID:</b>	YGLB	<b>Opened:</b>	07 Nov 1988	<b>Current Status:</b>	Still open
<b>Latitude:</b>	-34.8085	<b>Longitude:</b>	149.7312	<b>Elevation:</b>	640 m	<b>Barometer Elev:</b>	640.8 m	<b>Metadata compiled:</b>	26 NOV 2015

### Station Observation Program Summary (Surface Observations) from 01/11/1988 to 13/09/2010

Current Observation	Continuous	Half Hourly	Hourly
Surface Observations	-	Y	Y

Current Observation	Program Type	12 AM	3 AM	6 AM	9 AM	12 PM	3 PM	6 AM	9 AM
Surface Observation	PERFORMED	Y	Y	Y	Y	Y	Y	Y	Y
Surface Observation	REPORTED	Y	Y	Y	Y	Y	Y	Y	Y
Surface Observation	SEASONAL	-	-	-	-	-	-	-	-

### Station Observation Program Summary (Surface Observations) 26 NOV 2015 (most recent)

Current Observation	Continuous	Half Hourly	Hourly
Surface Observations	Y	Y	Y

Current Observation	Program Type	12 AM	3 AM	6 AM	9 AM	12 PM	3 PM	6 AM	9 AM
Surface Observation	PERFORMED	Y	Y	Y	Y	Y	Y	Y	Y
Surface Observation	REPORTED	Y	Y	Y	Y	Y	Y	Y	Y
Surface Observation	SEASONAL	-	-	-	-	-	-	-	-

**Historical metadata for this site has not been quality controlled for accuracy and completeness. Data other than current station information, particularly earlier than 1998, should be considered accordingly. Information may not be complete, as backfilling of historical data is incomplete.**

Prepared by the Bureau of Meteorology.

Contact us by phone on (03) 9669 4082, by fax on (03) 9669 4515, or by email on [climatedata@bom.gov.au](mailto:climatedata@bom.gov.au)

Station metadata is compiled for a range of internal purposes and varies in quality and completeness. The Bureau cannot provide any warranty nor accept any liability for this information. © Copyright Commonwealth of Australia 2015, Bureau of Meteorology.





## Extended Climatological Station Metadata

All History

<b>Station:</b>	GOULBURN AIRPORT AWS		<b>Location:</b>	GOULBURN AIRPORT AWS		<b>State:</b>	NSW
<b>Bureau No.:</b>	070330	<b>WMO No.:</b>	95716	<b>Aviation ID:</b>	YGLB	<b>Opened:</b>	07 Nov 1988
<b>Latitude:</b>	-34.8085	<b>Longitude:</b>	149.7312	<b>Elevation:</b>	640 m	<b>Barometer Elev:</b>	640.8 m
						<b>Current Status:</b>	Still open
						<b>Metadata compiled:</b>	26 NOV 2015

### Station Equipment History

#### Equipment Install/Remove

##### Cloud Height

31/OCT/2013 INSTALL Ceilometer (Type Vaisala CL31 S/N - J3510003) Surface Observations

##### River Height (No Electronic History)

##### Wind Run (No Electronic History)

##### Spectral Radiation (No Electronic History)

##### Sea Surface Temperature (No Electronic History)

##### Sea Water Temperature (No Electronic History)

##### Evaporation (No Electronic History)

##### Minimum Temperature (No Electronic History)

##### Soil Temperature 50cm (No Electronic History)

##### Sub Surface Temperature (No Electronic History)

##### Electrical Conductivity (No Electronic History)

##### Maximum Temperature (No Electronic History)

##### Soil Temperature 20cm (No Electronic History)

##### Solar Radiation (No Electronic History)

##### Soil Temperature 5cm (No Electronic History)

##### Oxygen Content (No Electronic History)

##### Sea Water Level (No Electronic History)

##### Surface Inclination (No Electronic History)

##### Terrestrial Minimum Temperature (No Electronic History)

##### Visibility (No Electronic History)

##### Solar Radiation (Direct) (No Electronic History)

##### Magnetic Bearing (No Electronic History)

##### Wind Direction

10/SEP/2004 INSTALL Anemometer (Type Synchrotac Cups - Type 732 S/N - 80261) Surface Observations

01/NOV/1988 INSTALL Anemometer (Type Synchrotac Vane - Type 706 S/N - WS - 74105 WD - 74066) Surface Observations

01/NOV/1988 INSTALL Mast Anemometer (Type Pivot, Standard 8m S/N - NONE) Infrastructure

15/FEB/2005 REPLACE Anemometer (Now Synchrotac Cups - Type 732 S/N - D100) Surface Observations

10/SEP/2004 REPLACE Anemometer (Now Synchrotac Vane - Type 706 S/N - 80309) Surface Observations

15/FEB/2005 REPLACE Anemometer (Now Synchrotac Vane - Type 706 S/N - D100) Surface Observations

##### Air Temperature

01/NOV/1988 INSTALL Humidity Probe (Type Rotronics S/N - 713201/9) Surface Observations

23/FEB/2012 REPLACE Humidity Probe (Now Rotronics MP101A-T4-W4W S/N - 11666-005) Surface Observations

19/FEB/2010 REPLACE Humidity Probe (Now Rotronics MP101A-T4-W4W S/N - 39220-007) Surface Observations

03/APR/2012 REPLACE Humidity Probe (Now Rotronics MP101A-T4-W4W S/N - 49513-003) Surface Observations

25/NOV/2002 REPLACE Humidity Probe (Now Vaisala HMP45D S/N - X4150011) Surface Observations

01/NOV/1988 INSTALL Temperature Probe - Dry Bulb (Type Rosemount S/N - NONE) Surface Observations

23/FEB/2012 REPLACE Temperature Probe - Dry Bulb (Now WIKA TR40 S/N - 107822-1) Surface Observations

01/NOV/1988 INSTALL Thermometer, Mercury, Dry Bulb (Type Dobbie S/N - M1803) Surface Observations

##### Wet Bulb Temperature (No Electronic History)

##### Lightning (No Electronic History)

##### Turbidity (No Electronic History)

##### Total Column Ozone Amount (No Electronic History)

Historical metadata for this site has not been quality controlled for accuracy and completeness. Data other than current station information, particularly earlier than 1998, should be considered accordingly. Information may not be complete, as backfilling of historical data is incomplete.

Prepared by the Bureau of Meteorology.

Contact us by phone on (03) 9669 4082, by fax on (03) 9669 4515, or by email on [climatedata@bom.gov.au](mailto:climatedata@bom.gov.au)

Station metadata is compiled for a range of internal purposes and varies in quality and completeness. The Bureau cannot provide any warranty nor accept any liability for this information. © Copyright Commonwealth of Australia 2015, Bureau of Meteorology.



## Extended Climatological Station Metadata

All History

<b>Station:</b>	GOULBURN AIRPORT AWS		<b>Location:</b>	GOULBURN AIRPORT AWS		<b>State:</b>	NSW	
<b>Bureau No.:</b>	070330	<b>WMO No.:</b>	95716	<b>Aviation ID:</b>	YGLB	<b>Opened:</b>	07 Nov 1988	
<b>Latitude:</b>	-34.8085	<b>Longitude:</b>	149.7312	<b>Elevation:</b>	640 m	<b>Barometer Elev:</b>	640.8 m	
							<b>Current Status:</b>	Still open
							<b>Metadata compiled:</b>	26 NOV 2015

### Station Equipment History (continued)

#### Equipment Install/Remove(Continued)

##### Pressure

- 01/MAY/1995 INSTALL Barometer (Type Vaisala PA11A S/N - 601091) Surface Observations
- 23/SEP/2002 REPLACE Barometer (Now Vaisala PA11A S/N - 458199) Surface Observations
- 31/MAR/2011 REPLACE Barometer (Now Vaisala PTB220B S/N - D3540108) Surface Observations

##### Humidity

- 01/NOV/1988 INSTALL Humidity Probe (Type Rotronics S/N - 713201/9) Surface Observations
- 23/FEB/2012 REPLACE Humidity Probe (Now Rotronics MP101A-T4-W4W S/N - 11666-005) Surface Observations
- 19/FEB/2010 REPLACE Humidity Probe (Now Rotronics MP101A-T4-W4W S/N - 39220-007) Surface Observations
- 03/APR/2012 REPLACE Humidity Probe (Now Rotronics MP101A-T4-W4W S/N - 49513-003) Surface Observations
- 25/NOV/2002 REPLACE Humidity Probe (Now Vaisala HMP45D S/N - X4150011) Surface Observations

##### Sunshine Hours (No Electronic History)

##### Pressure Trend (No Electronic History)

##### Snow Height (No Electronic History)

##### Wind Speed

- 10/SEP/2004 INSTALL Anemometer (Type Synchronac Cups - Type 732 S/N - 80261) Surface Observations
- 01/NOV/1988 INSTALL Anemometer (Type Synchronac Vane - Type 706 S/N - WS - 74105 WD - 74066) Surface Observations
- 01/NOV/1988 INSTALL Mast Anemometer (Type Pivot, Standard 8m S/N - NONE) Infrastructure
- 15/FEB/2005 REPLACE Anemometer (Now Synchronac Cups - Type 732 S/N - D100) Surface Observations
- 10/SEP/2004 REPLACE Anemometer (Now Synchronac Vane - Type 706 S/N - 80309) Surface Observations
- 15/FEB/2005 REPLACE Anemometer (Now Synchronac Vane - Type 706 S/N - D100) Surface Observations

##### Rainfall

- 01/NOV/1988 INSTALL Raingauge (Type Rimco 7499 TBRG S/N - 66837) Surface Observations
- 31/JUL/2006 REPLACE Raingauge (Now Rimco 7499 TBRG S/N - 84619) Surface Observations
- 01/AUG/2006 REPLACE Raingauge (Now Rimco 7499 TBRG S/N - 84625) Surface Observations

##### Soil Temperature 100cm (No Electronic History)

##### Soil Temperature 10cm (No Electronic History)

##### Solar Radiation (Long Wave) (No Electronic History)

##### RF Reflectivity (No Electronic History)

The following table summarises information on field performance checks available electronically over the period indicated. The number of instances an instrument was found to fail field performance checks should only be used as a guide. A system of data quality flags is implemented by the Bureau of Meteorology to indicate the data quality of an observation as determined by a multi-stage quality control process.

Available Date Range	Element	Fail Field Performance Check
14/NOV/2013 - 10/MAR/2015	Cloud Height	0
09/MAR/1998 - 18/NOV/2015	Wind Direction	6
09/MAR/1998 - 18/NOV/2015	Air Temperature	3
09/MAR/1998 - 10/MAR/2015	Pressure	0
09/MAR/1998 - 18/NOV/2015	Humidity	2
09/MAR/1998 - 18/NOV/2015	Wind Speed	6
09/MAR/1998 - 18/NOV/2015	Rainfall	4

#### Station Detail Changes

09/MAY/2006 CLASSIFICATION Category D (TAF D)

**Historical metadata for this site has not been quality controlled for accuracy and completeness. Data other than current station information, particularly earlier than 1998, should be considered accordingly. Information may not be complete, as backfilling of historical data is incomplete.**

Prepared by the Bureau of Meteorology.

Contact us by phone on (03) 9669 4082, by fax on (03) 9669 4515, or by email on [climatedata@bom.gov.au](mailto:climatedata@bom.gov.au)

Station metadata is compiled for a range of internal purposes and varies in quality and completeness. The Bureau cannot provide any warranty nor accept any liability for this information. © Copyright Commonwealth of Australia 2015, Bureau of Meteorology.



## Extended Climatological Station Metadata

All History

<b>Station:</b>	GOULBURN AIRPORT AWS		<b>Location:</b>	GOULBURN AIRPORT AWS		<b>State:</b>	NSW	
<b>Bureau No.:</b>	070330	<b>WMO No.:</b>	95716	<b>Aviation ID:</b>	YGLB	<b>Opened:</b>	07 Nov 1988	
<b>Latitude:</b>	-34.8085	<b>Longitude:</b>	149.7312	<b>Elevation:</b>	640 m	<b>Barometer Elev:</b>	640.8 m	
							<b>Current Status:</b>	Still open
							<b>Metadata compiled:</b>	26 NOV 2015

### Station Equipment History (continued)

#### Station Detail Changes(Continued)

01/NOV/1988 CLASSIFICATION Mesonet (FME)  
05/OCT/2001 CLASSIFICATION National Benchmark Network for Agrometeorology (NBNA)  
10/JAN/2011 CLASSIFICATION Standard (ASOSSTD)  
10/JUN/2014 CLASSIFICATION Standard Aviation or Defence (AVSTD)  
28/JUN/2011 OBJECT Document/AWS SITE AUDIT  
14/NOV/2013 OBJECT Document/CEILOMETER STATUS  
24/FEB/2004 OBJECT Document/Goulburn APT AWS Skyline points  
06/SEP/2009 OBJECT Document/SKYLINE DATA  
11/FEB/2014 OBJECT Document/SKYLINE DATA  
07/NOV/1988 STATION - (nondb seeding) Opened  
07/NOV/1988 STATION - (nondb seeding) aero\_ht Changed to 652.6  
07/NOV/1988 STATION - (nondb seeding) bar\_ht Changed to 640.8  
07/NOV/1988 STATION - (nondb seeding) bar\_ht\_deriv Changed to MAP 1:25 000  
07/NOV/1988 STATION - (nondb seeding) stn\_ht Changed to 640  
07/NOV/1988 STATION - (nondb seeding) stn\_ht\_deriv Changed to MAP 1:25 000  
07/NOV/1988 STATION - (nondb seeding) wmo\_num Changed to 95716  
07/NOV/1988 STATION aviation\_id Changed to YGLB  
07/NOV/1988 STATION latitude Changed to -34.80854  
07/NOV/1988 STATION latlon\_deriv Changed to GPS  
07/NOV/1988 STATION latlon\_error Changed to 4  
07/NOV/1988 STATION longitude Changed to 149.73118  
09/MAR/1998 STATION lu\_0\_100m Changed to Airport  
09/MAR/1998 STATION lu\_100m\_1km Changed to Airport  
09/MAR/1998 STATION lu\_1km\_10km Changed to Open farmland, grassland or tundra  
07/NOV/1988 STATION name Changed to GOULBURN AIRPORT AWS  
09/MAR/1998 STATION soil\_type Changed to red soil  
09/MAR/1998 STATION surface\_type Changed to fully covered by grass

#### System Changes

01/NOV/1988 SYSTEM Infrastructure Commenced  
01/NOV/1988 SYSTEM Surface Observations Commenced

**Historical metadata for this site has not been quality controlled for accuracy and completeness. Data other than current station information, particularly earlier than 1998, should be considered accordingly. Information may not be complete, as backfilling of historical data is incomplete.**

Prepared by the Bureau of Meteorology.

Contact us by phone on (03) 9669 4082, by fax on (03) 9669 4515, or by email on [climatedata@bom.gov.au](mailto:climatedata@bom.gov.au)

Station metadata is compiled for a range of internal purposes and varies in quality and completeness. The Bureau cannot provide any warranty nor accept any liability for this information. © Copyright Commonwealth of Australia 2015, Bureau of Meteorology.

## Notes on these metadata

The following notes have been compiled to assist with interpreting the metadata provided in this document. These notes are subject to change as the network evolves. Changes in station-specific metadata occur more frequently, both as recent changes are recorded and historical information is transferred from paper file to electronic database.

### Reliability of the metadata

The Commonwealth Bureau of Meteorology maintains information on more than 20,000 stations which have operated since observations began in the mid 1800s. The amount of information available for each of these sites and its associated uncertainty are influenced by a number of factors including the type and purpose of the station and the time over which it operated.

Early information about stations was held only on paper file. In 1998 a corporate electronic database was established to help maintain information about the network and its components. The number of parameters recorded about a station is now much greater than before this database was established. The national database has also helped improve consistency in the metadata through the implementation of predefined fields. As a result, and through the refinement of operating procedures, station metadata recorded since 1998 are of a higher overall standard than previously, although occasional omissions and errors are still possible.

The Bureau is part way through a task of entering historical information held on paper file into the corporate database. **Until this process is completed there will remain large gaps in the information contained in these metadata documents and considerable caution should be used when deriving conclusions from the metadata.** As an example, two consecutive entries about a rain gauge dated 50 years apart may appear in the equipment metadata. This may either mean that nothing happened to that instrument over the 50 years, or that information for the intervening period has yet to be entered into the database. Similarly, if no information was available about instruments at a site when it was first established, fields which were required to have a value present may have used the earliest information available as a best-guess estimate. Sometimes this was the metadata current when the database was established in 1998. In some instances there may be gaps in metadata relevant to the post 1998 period.

For the above reasons it is recommended that all metadata prior to 1998 be considered as indicative only, and used with caution, unless it has been quality controlled. The Bureau of Meteorology should be contacted if further information or confirmation of the data is required. Depending on the nature of the inquiry there may be a fee associated with this request. Contact details are provided in the telephone book for each capital city or the Bureau's web site at:  
<http://www.bom.gov.au>

The following pages contain explanatory notes for selected terms found in this document.

### Station Number

The Bureau of Meteorology station number uniquely specifies a station and is not intended to change over time, although on very rare occasions a station number may change or be deleted from the record (usually to correct an error). Generally a new station number is established if an existing station changes in a way that would affect the climate data record for that site (measured in terms of air temperature and precipitation). Significant station moves are an example of this.

Some stations also possess a World Meteorological Organization (WMO) station number. The WMO number is different to the Bureau of Meteorology number. It also uniquely specifies a station at any given time but can be reassigned to another station if the new station takes priority in the global reporting network. Only selected stations will have a WMO number. Significant stations may maintain their WMO number for many decades.

**Historical metadata for this site has not been quality controlled for accuracy and completeness. Data other than current station information, particularly earlier than 1998, should be considered accordingly. Information may not be complete, as backfilling of historical data is incomplete.**

Prepared by the Bureau of Meteorology.

Contact us by phone on (03) 9669 4082, by fax on (03) 9669 4515, or by email on [climatedata@bom.gov.au](mailto:climatedata@bom.gov.au)

Station metadata is compiled for a range of internal purposes and varies in quality and completeness. The Bureau cannot provide any warranty nor accept any liability for this information. © Copyright Commonwealth of Australia 2015, Bureau of Meteorology.



## Notes on these metadata

### Network Classification

<b>SUPPORTING the BASIC CLIMATE SERVICE</b>
Global Climate Observing System (GCOS)
GCOS Upper Air Network (GUAN)
GCOS Surface Network (GSN)
National Climate Network {not yet assigned}
Reference Climate Stations (RCS)
Regional Basic Climatological Network (RBCN)
CLIMAT Stations (CLC)
CLIMAT TEMP Stations (CLT)
<b>SUPPORTING the NATIONAL WEATHER WATCH SYSTEM</b>
WMO Global Observing System (GOS)
GOS Upper Air Network
GOS Satellite Network
Global Atmospheric Watch
Background Atmospheric Pollution Monitoring Network (BAPMON)
Basic Ozone Network
Basic Solar and Terrestrial Radiation Network
Regional Basic Synoptic Network (RBSN)
WMO Global Oceanic Observing System (GOOS)
<b>SUPPORTING the BASIC WEATHER SERVICE (BWS)</b>
BWS Land Network
Significant Land Locations
Capital City Mesonets
National Benchmark Network for Agrometeorology (NBNA)
BWS Marine Network
Significant Coastal Locations
Open Ocean Network
BWS Upper Air Network
Major Significant Locations
BWS Remote Sensing Network
Weather Watch Radar Network
Fire Weather Wind Mesonets
High Resolution Satellite
<b>SUPPORTING the BASIC HYDROLOGICAL SERVICE</b>
Regional Flood Warning Network
Water Resources Assessment Network
Global Hydrological Network
Global Terrestrial Observing System (GTOS)
World Hydrological Cycle Observing System (WHYCOS)
National Hydrological Network

Networks of stations are defined for a variety of purposes (as defined in above table).

**Historical metadata for this site has not been quality controlled for accuracy and completeness. Data other than current station information, particularly earlier than 1998, should be considered accordingly. Information may not be complete, as backfilling of historical data is incomplete.**

Prepared by the Bureau of Meteorology.

Contact us by phone on (03) 9669 4082, by fax on (03) 9669 4515, or by email on [climatedata@bom.gov.au](mailto:climatedata@bom.gov.au)

Station metadata is compiled for a range of internal purposes and varies in quality and completeness. The Bureau cannot provide any warranty nor accept any liability for this information. © Copyright Commonwealth of Australia 2015, Bureau of Meteorology.

## Notes on these metadata

### Network Classification Continued...

Stations may be included in several different networks, which may change over time. The table on the previous page lists current network classifications related to the scientific purpose of the network. Some of these networks - the GCOS network for instance - are components of a global network. Entries in the database for some networks may not be complete, thus not properly representing the status of the network. The composition of the network will usually change over time. While several of the networks have international significance, other network classifications have been developed to aid operational management.

### Station Purpose

The station purpose can be classified according to the observation program listed below. Parameters in brackets list some of the various different configurations which occur.

- Synoptic [Seasonal, River Height, Climatological, Telegraphic Rain, Aeronautical, Upper Air]
- Climatological [Seasonal, Telegraphic Rain]
- Aeronautical
- Rainfall [River Height]
- River Height
- Telegraphic Rain [Non-Telegraphic River Height, Telegraphic River Height]
- Non-Telegraphic Rain [Telegraphic River Height]
- Evaporation [Rainfall, River Height, Telegraphic River Height, Non-Telegraphic River Height, Telegraphic Rain, Non-Telegraphic Rain]
- Pluviograph [Rainfall, Telegraphic Rain, Non-Telegraphic Rain, River Height, Telegraphic River Height, Non-Telegraphic River Height]
- Radiation
- Lightning Flash Counter
- Public Information
- Local Conditions
- Radar Site
- Unclassified
- No Routine Observations

Note: Telegraphic observations are those which are sent by some electronic means be it a phone or telegram to the responsible Bureau office. It is a term which is historically linked to analogue non automatic data transmission.

### Station Observation Program Summary

#### Surface Observations

The following terms are used to describe the frequency of surface observations at a site. Historical observation programs will typically be missing for many sites until the database is backfilled with information.

Set a)

- Continuous Program
  - More than half hourly observations sent (eg an automatic weather station {AWS} which continuously transmits 10 minute observations). This will automatically include half hourly and hourly observations programs.
- Half hourly observations
  - Half hourly observations sent. This will automatically include hourly observations.
- Hourly observations
  - Hourly observations sent only. Stations report on non-synoptic hours (ie. 0100, 0200, 0400, 0500, etc)

**Historical metadata for this site has not been quality controlled for accuracy and completeness. Data other than current station information, particularly earlier than 1998, should be considered accordingly. Information may not be complete, as backfilling of historical data is incomplete.**

Prepared by the Bureau of Meteorology.

Contact us by phone on (03) 9669 4082, by fax on (03) 9669 4515, or by email on [climatedata@bom.gov.au](mailto:climatedata@bom.gov.au)

Station metadata is compiled for a range of internal purposes and varies in quality and completeness. The Bureau cannot provide any warranty nor accept any liability for this information. © Copyright Commonwealth of Australia 2015, Bureau of Meteorology.

## Notes on these metadata

### Surface observations continued....

#### Set b)

- Performed
  - Observations performed, instruments read and observations recorded
- Reported
  - Observations performed, instruments read and reported real time
- Seasonal
  - The program may only be performed during a defined season (such as Fire Weather observations) or the routine program may increase in reporting frequency and/or parameters. The program dates are currently modified at the start and end of each season for stations performing seasonal observations. Historically this was not always the case.

### Current Station Equipment Summary

Equipment listed in this metadata product is catalogued under one of systems listed below, appropriate to its application. The "Infrastructure" category has been included since it contains information about the mast height of an anemometer (if present).

- Flood Warning
- Infrastructure
- Radiation
- Rainfall Intensity
- Surface Observations
- Upper Air
- Weather Watch {RADAR}

### Station Equipment History

#### Equipment Install/Remove

One of four types of actions can be performed on an instrument in this listing:

**Install** - A new instrument is installed at the site. This can be either a completely new addition (eg the first barometer at the site), or the replacement of an existing instrument with a different type (eg replacing mercury barometer with electronic barometer)

**Remove** - An instrument can be removed either when it is no longer necessary to measure a particular element, or when the element is to be measured by an instrument of a different type ( see under "Install" above)

**Replace** - This occurs when one instrument is replaced with another of the same type (eg Kew pattern mercury barometer replacing another Kew pattern mercury barometer)

**Share** - The same instrument is used for observations under two (or more) systems (eg a rain gauge may be used within both Surface Observations and Rainfall Intensity systems)

**Unshare** - The instrument is no longer shared between systems

**Historical metadata for this site has not been quality controlled for accuracy and completeness. Data other than current station information, particularly earlier than 1998, should be considered accordingly. Information may not be complete, as backfilling of historical data is incomplete.**

Prepared by the Bureau of Meteorology.

Contact us by phone on (03) 9669 4082, by fax on (03) 9669 4515, or by email on [climatedata@bom.gov.au](mailto:climatedata@bom.gov.au)

Station metadata is compiled for a range of internal purposes and varies in quality and completeness. The Bureau cannot provide any warranty nor accept any liability for this information. © Copyright Commonwealth of Australia 2015, Bureau of Meteorology.

## Notes on these metadata

### Calibration

During a site inspection an instrument will be calibrated as either being within or not within the specified tolerance in accuracy.

Where a quantitative calibration result can be achieved by comparison to a transfer standard (eg barometer comparisons and tipping bucket rain gauge calibrations), the instrument will be recorded as being within or outside the required tolerance. Instruments (such as 203mm rain gauges, screens and evaporation pans) where quantitative calibrations cannot be derived should be regarded as meeting specifications when the instrument is in 'good working order'.

This product provides a summary table of the number of times an instrument was found to be out of calibration

### Station Detail Changes

This set of metadata indicates when some aspect of the general information about a station has changed.

#### - STATION

Metadata which are categorised as pertaining to STATION are items of (textual) information describing a specific attribute of the station. A reference to (nondB seeding) indicates initial information of this field has been sourced from a previous database.

#### Station position

##### - Latitude and longitude

Derivation of station latitude and longitude, defined by the location of the rain gauge when it is present, has changed over time. Current practice is to locate or verify open and operational station latitude and longitude based on Global Positioning System equipment. Methods used to locate a station as described in this product (latlon\_deriv) are as follows: GPS, MAP 1:10000, MAP 1:12500, MAP 1:25000, MAP 1:50000, MAP 1:100000, MAP 1:250000, SURVEY, and Unknown (which is more commonly represented by a null value). The field latlon\_error should be used with caution as the method of determining this value has been interpreted in different ways over time.

##### - Height

Determination of heights for observing sites is by survey where possible. Otherwise height may be determined using a Digital Aneroid Barometer and a known surveyed point, or derived from map contours. The source of height is provided in the corresponding parameter with a suffix of "\_deriv".

Heights which may appear in these metadata are:

- aero\_ht
  - The official elevation of the aerodrome which normally corresponds to the altitude of the highest threshold of the runways at that airport;
- bar\_ht
  - this represents the height of the mercury barometer cistern or the digital aneroid barometer above mean sea level (MSL);
- stn\_ht
  - this normally represents the height of the rain gauge above MSL

**Historical metadata for this site has not been quality controlled for accuracy and completeness. Data other than current station information, particularly earlier than 1998, should be considered accordingly. Information may not be complete, as backfilling of historical data is incomplete.**

Prepared by the Bureau of Meteorology.

Contact us by phone on (03) 9669 4082, by fax on (03) 9669 4515, or by email on [climatedata@bom.gov.au](mailto:climatedata@bom.gov.au)

Station metadata is compiled for a range of internal purposes and varies in quality and completeness. The Bureau cannot provide any warranty nor accept any liability for this information. © Copyright Commonwealth of Australia 2015, Bureau of Meteorology.





## Notes on these metadata

### - Land Use

To assist the long term understanding of climate change it is important to be able to determine the differences over time which are attributed to variations in the climate. Since land use has an effect on the micro climate around the site, and changes in land use will therefore affect the climate record, it is important that the characteristics of the site are monitored. Soil types are recorded as they affect the land use and also add to the knowledge of the site details.

#### Defined Land use Types.

- Non-vegetated (barren, desert)
- Coastal or Island
- Forest
- Open farmland, grassland or tundra
- Small town, less than 1000 population
- Town 1000 to 10,000 population
- City area with buildings less than 10 metres (3 stories)
- City area with buildings greater than 10 metres (3 stories)
- Airport

The land use code is entered on the station inspection form in the ranges 0 to 100 m, 100 to 1 km and 1km to 10 km; ie:

- lu\_0\_100m: Land Use 0 to 100 metres from the enclosure
- lu\_100m\_1km: Land Use 100 metres to 1 kilometre
- lu\_1km\_10km: Land Use 1 kilometre to 10 kilometres

#### Defined Soil Type (At Enclosure).

- unable to determine
- sand
- black soil
- clay
- rock
- red soil
- other

#### Surface Type (At Enclosure).

- unable to determine
- fully covered by grass
- mostly covered by grass
- partly covered by grass
- bare ground
- sand
- concrete
- asphalt
- rock
- other

**Historical metadata for this site has not been quality controlled for accuracy and completeness. Data other than current station information, particularly earlier than 1998, should be considered accordingly. Information may not be complete, as backfilling of historical data is incomplete.**

Prepared by the Bureau of Meteorology.

Contact us by phone on (03) 9669 4082, by fax on (03) 9669 4515, or by email on [climatedata@bom.gov.au](mailto:climatedata@bom.gov.au)

Station metadata is compiled for a range of internal purposes and varies in quality and completeness. The Bureau cannot provide any warranty nor accept any liability for this information. © Copyright Commonwealth of Australia 2015, Bureau of Meteorology.



THE ODOUR  
UNIT



## **Veolia Australia & New Zealand**

---

### **APPENDIX C:**

### **CALPUFF SOURCE AND EMISSION MODELLING CONFIGURATIONS**

---

### **Long-term Treated Leachate Solution**


**July 2016**

AREA SOURCE

Source (12 chars.)	Lower (km)	Lower (km)	Upper (km)	Upper (km)	Upper (km)	Upper (km)	Lower (km)	Lower (km)	Effect. (m)	Base (m)	Init. (m)	ODOR (g/m**2/s)
LDAM	734.1	6117.183	734.166	6117.287	734.184	6117.268	734.129	6117.163	0	797.19	0.1	3.6
GW	733.455	6117.624	733.399	6117.421	733.552	6117.39	733.652	6117.541	0	791.39	0.1	0.3
TL1	733.559	6117.387	733.658	6117.54	733.707	6117.508	733.725	6117.46	0	791.56	0.1	3.6
UTL	733.661	6117.366	733.788	6117.346	733.73	6117.455	733.662	6117.37	0	791.55	0.1	5
SW	733.55	6117.367	733.84	6117.319	733.661	6117.1	733.424	6117.219	0	792.37	0.1	0.1
COVW	734.128	6116.962	734.37	6117.189	734.463	6117.157	734.735	6117.023	0	731.67	0.1	0.3
AGEDW	734.156	6116.944	734.649	6116.721	734.498	6116.646	734.099	6116.859	0	687.56	0.1	3.6
FW	734.099	6116.858	734.098	6116.793	734.359	6116.638	734.493	6116.644	0	753.02	0.1	0.7
WR3	733.132	6117.509	733.185	6117.628	732.905	6117.753	732.852	6117.634	0	793.74	2	0.253
WR2	733.163	6117.495	733.216	6117.614	733.185	6117.628	733.132	6117.509	0	792.15	2	13
WR4	733.193	6117.482	733.246	6117.6	733.216	6117.614	733.163	6117.495	0	791.81	2	11.3
WR4_2	732.816	6117.65	732.869	6117.769	732.857	6117.775	732.803	6117.656	0	796.36	2	11.3
WR5	732.803	6117.656	732.857	6117.775	732.843	6117.781	732.79	6117.662	0	796.38	2	5.45
WR5_2	732.79	6117.662	732.843	6117.781	732.778	6117.81	732.725	6117.691	0	796.74	2	0.253
ED3S-S	733.529	6116.967	733.523	6117.122	733.739	6117.044	733.641	6116.904	0	794	0.1	0.159
ED1	733.233	6117.742	733.577	6118.346	734.273	6117.793	733.898	6117.446		785	0.1	0.0488

VOLUME SOURCE

Source (12 chars.)	X (km)	Y (km)	Effect. (m)	Base (m)	Init. (m)	Init. (m)	ODOR (g/s)
SRC_1	732.95	6117.695	0	0	20	2	5.65
SRC_2	733.066	6117.623	0	0	10	2	2.37

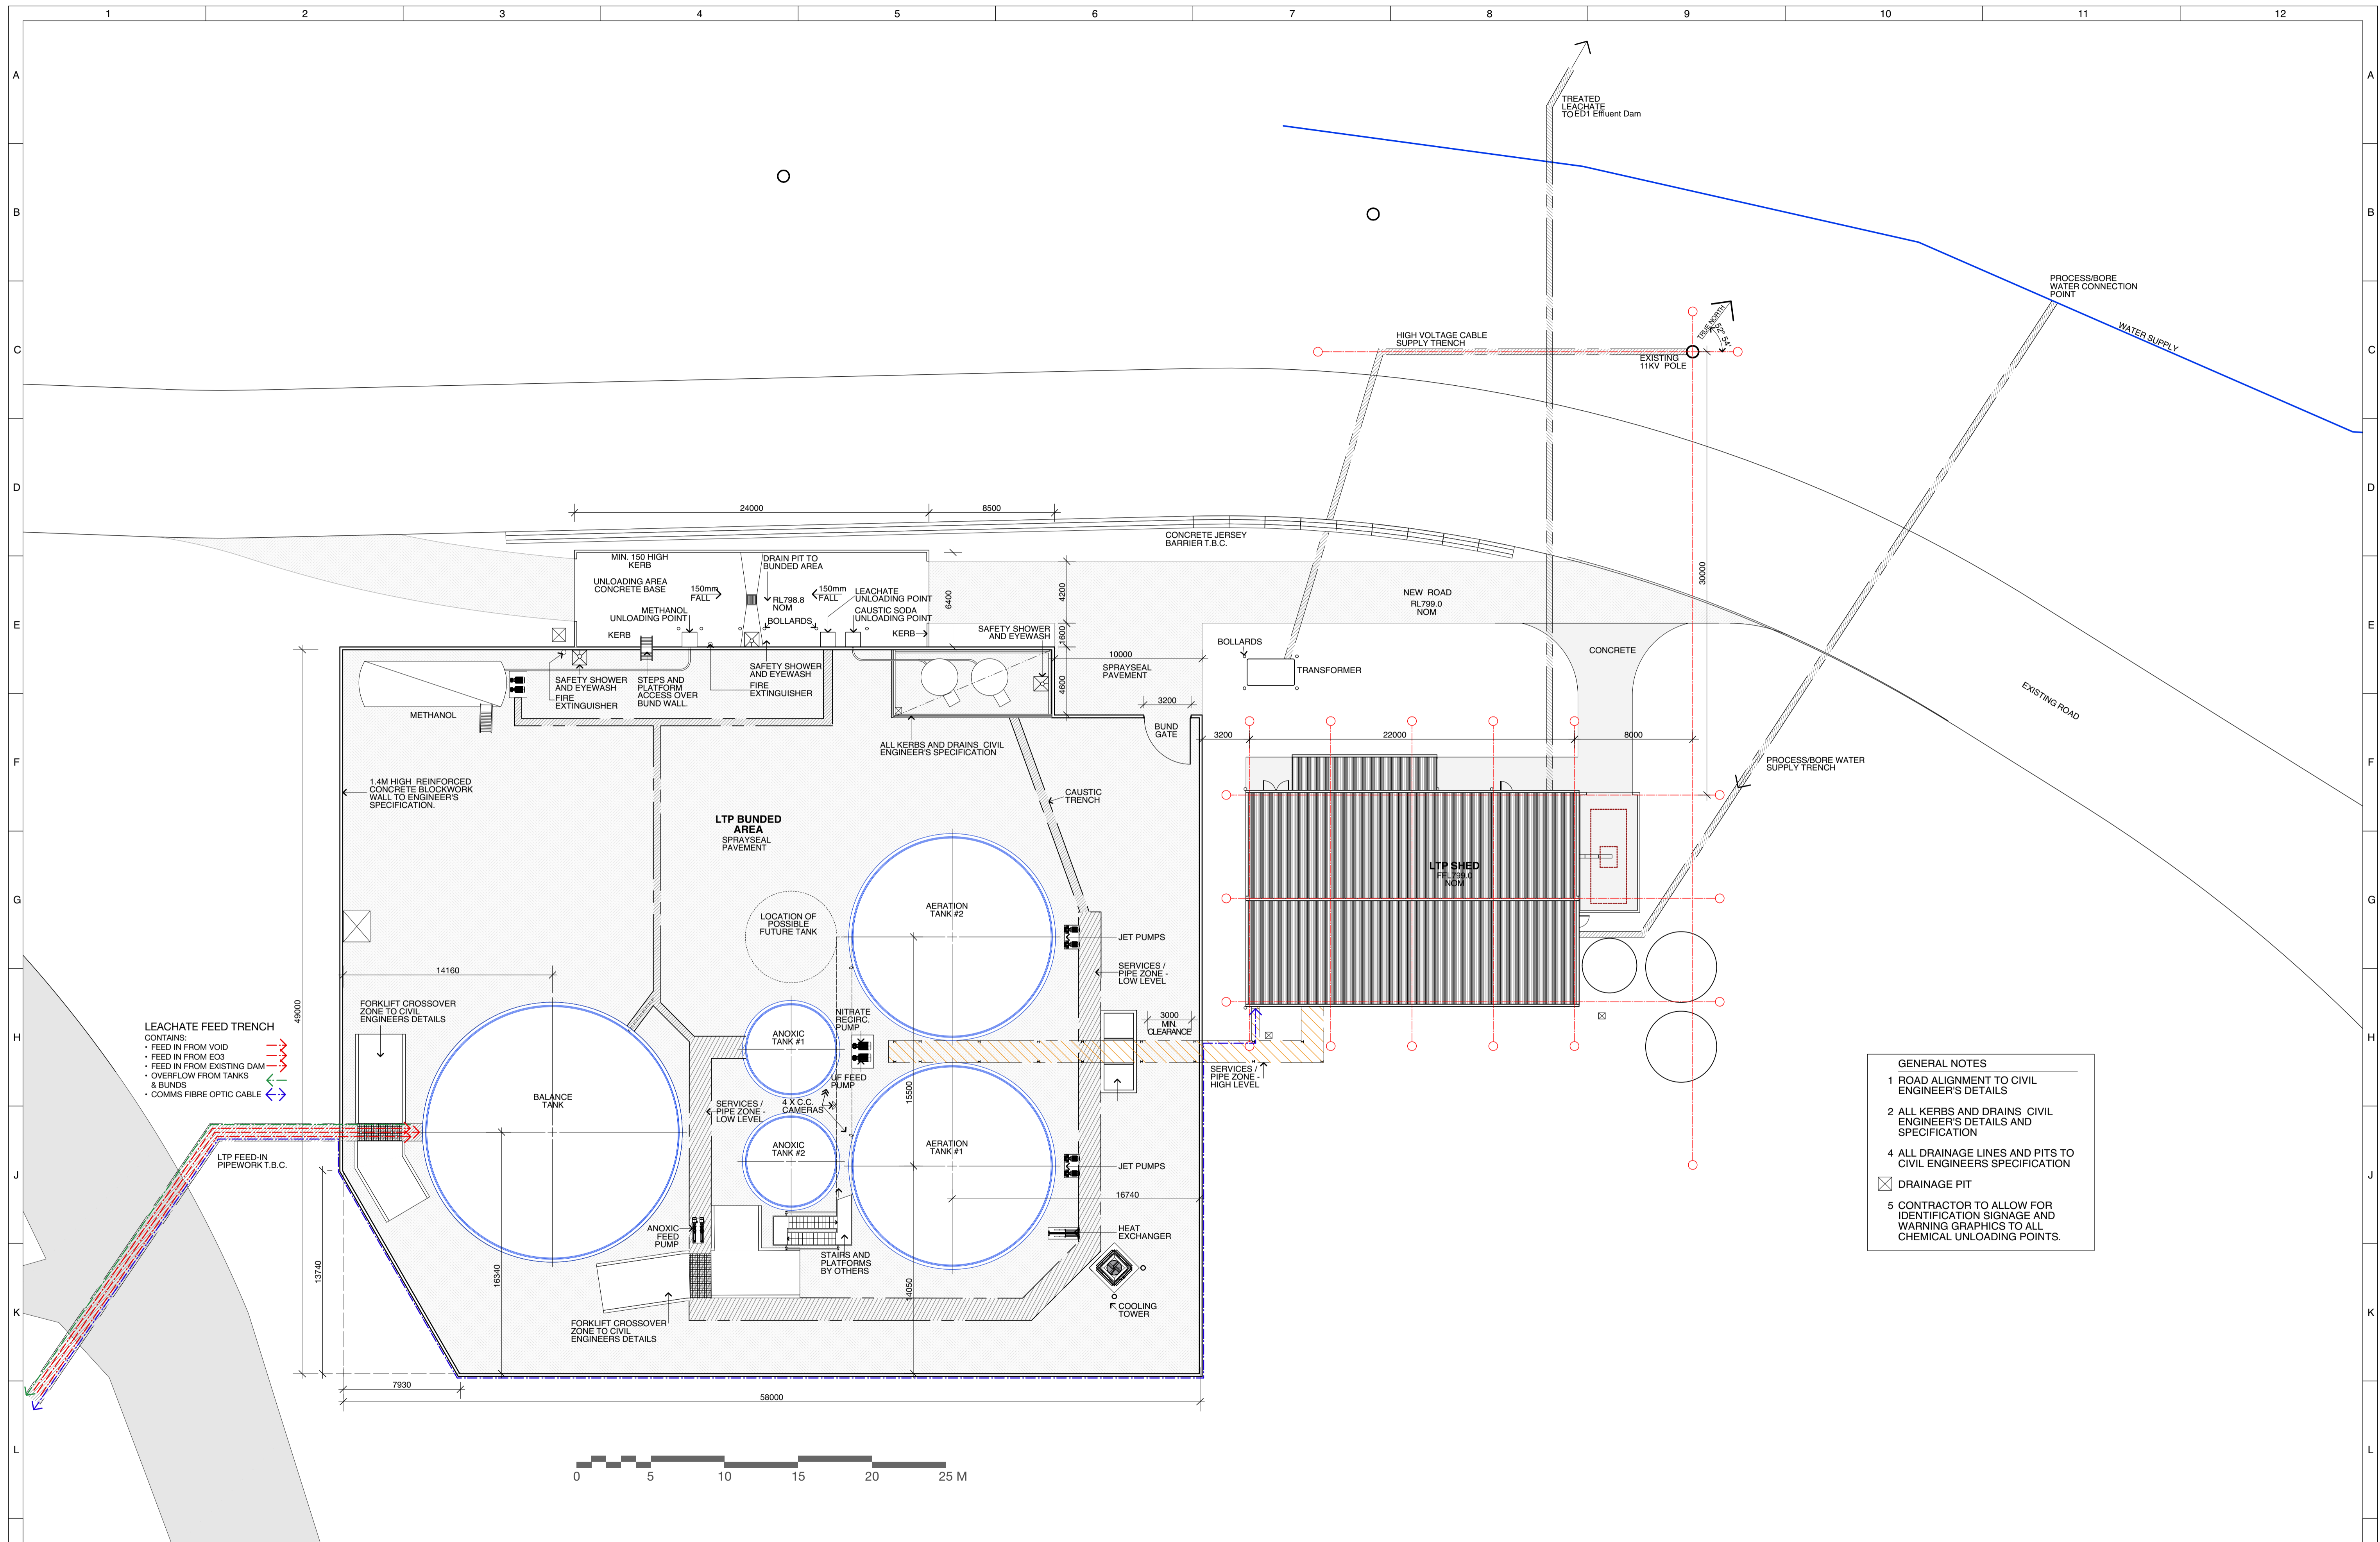

- GENERAL NOTES**
- ROAD ALIGNMENT TO CIVIL ENGINEER'S DETAILS
  - ALL KERBS AND DRAINS CIVIL ENGINEER'S DETAILS AND SPECIFICATION
  - ALL DRAINAGE LINES AND PITS TO CIVIL ENGINEERS SPECIFICATION
  - DRAINAGE PIT
  - CONTRACTOR TO ALLOW FOR IDENTIFICATION SIGNAGE AND WARNING GRAPHICS TO ALL CHEMICAL UNLOADING POINTS.

REV	REVISION	DRAWN	CHECKED	APPROVED	REVISION DATE
B_01	ISSUED FOR TENDER	JM	MS	MS	31/05/2017
B_00	ISSUED FOR CONCEPT DESIGN	JM			24/04/2017

DO NOT SCALE THIS DRAWING  
IF IN DOUBT ASK  
THIRD ANGLE PROJECTION


THIS DRAWING IS THE SUBJECT OF COPYRIGHT  
AND MUST NOT BE COPIED OR OTHERWISE USED  
WITHOUT THE EXPRESS AUTHORITY OF VEOLIA  
AUSTRALIA AND NEW ZEALAND

Level 4, Bay Centre,  
65 Pirrama Road  
Pyrmont, NSW, 2009  
Sydney, Australia.  
Phone: +61 (2) 85710000  
Web: www.veolia.com/anz  
Email: reception.PYR@veolia.com

DRAWN	DATE	PROJECT
CHECKED	DATE	TITLE
APPROVED	DATE	

PROJECT: WOODLAWN LEACHATE TREATMENT PLANT  
TITLE: LTP PLANT LAYOUT PLAN

SCALE	1:200	SHEET	01	OF	01	SIZE	A1
DRAWING No.	00004-Z-00-D02-00-01			REVISION	B_01		

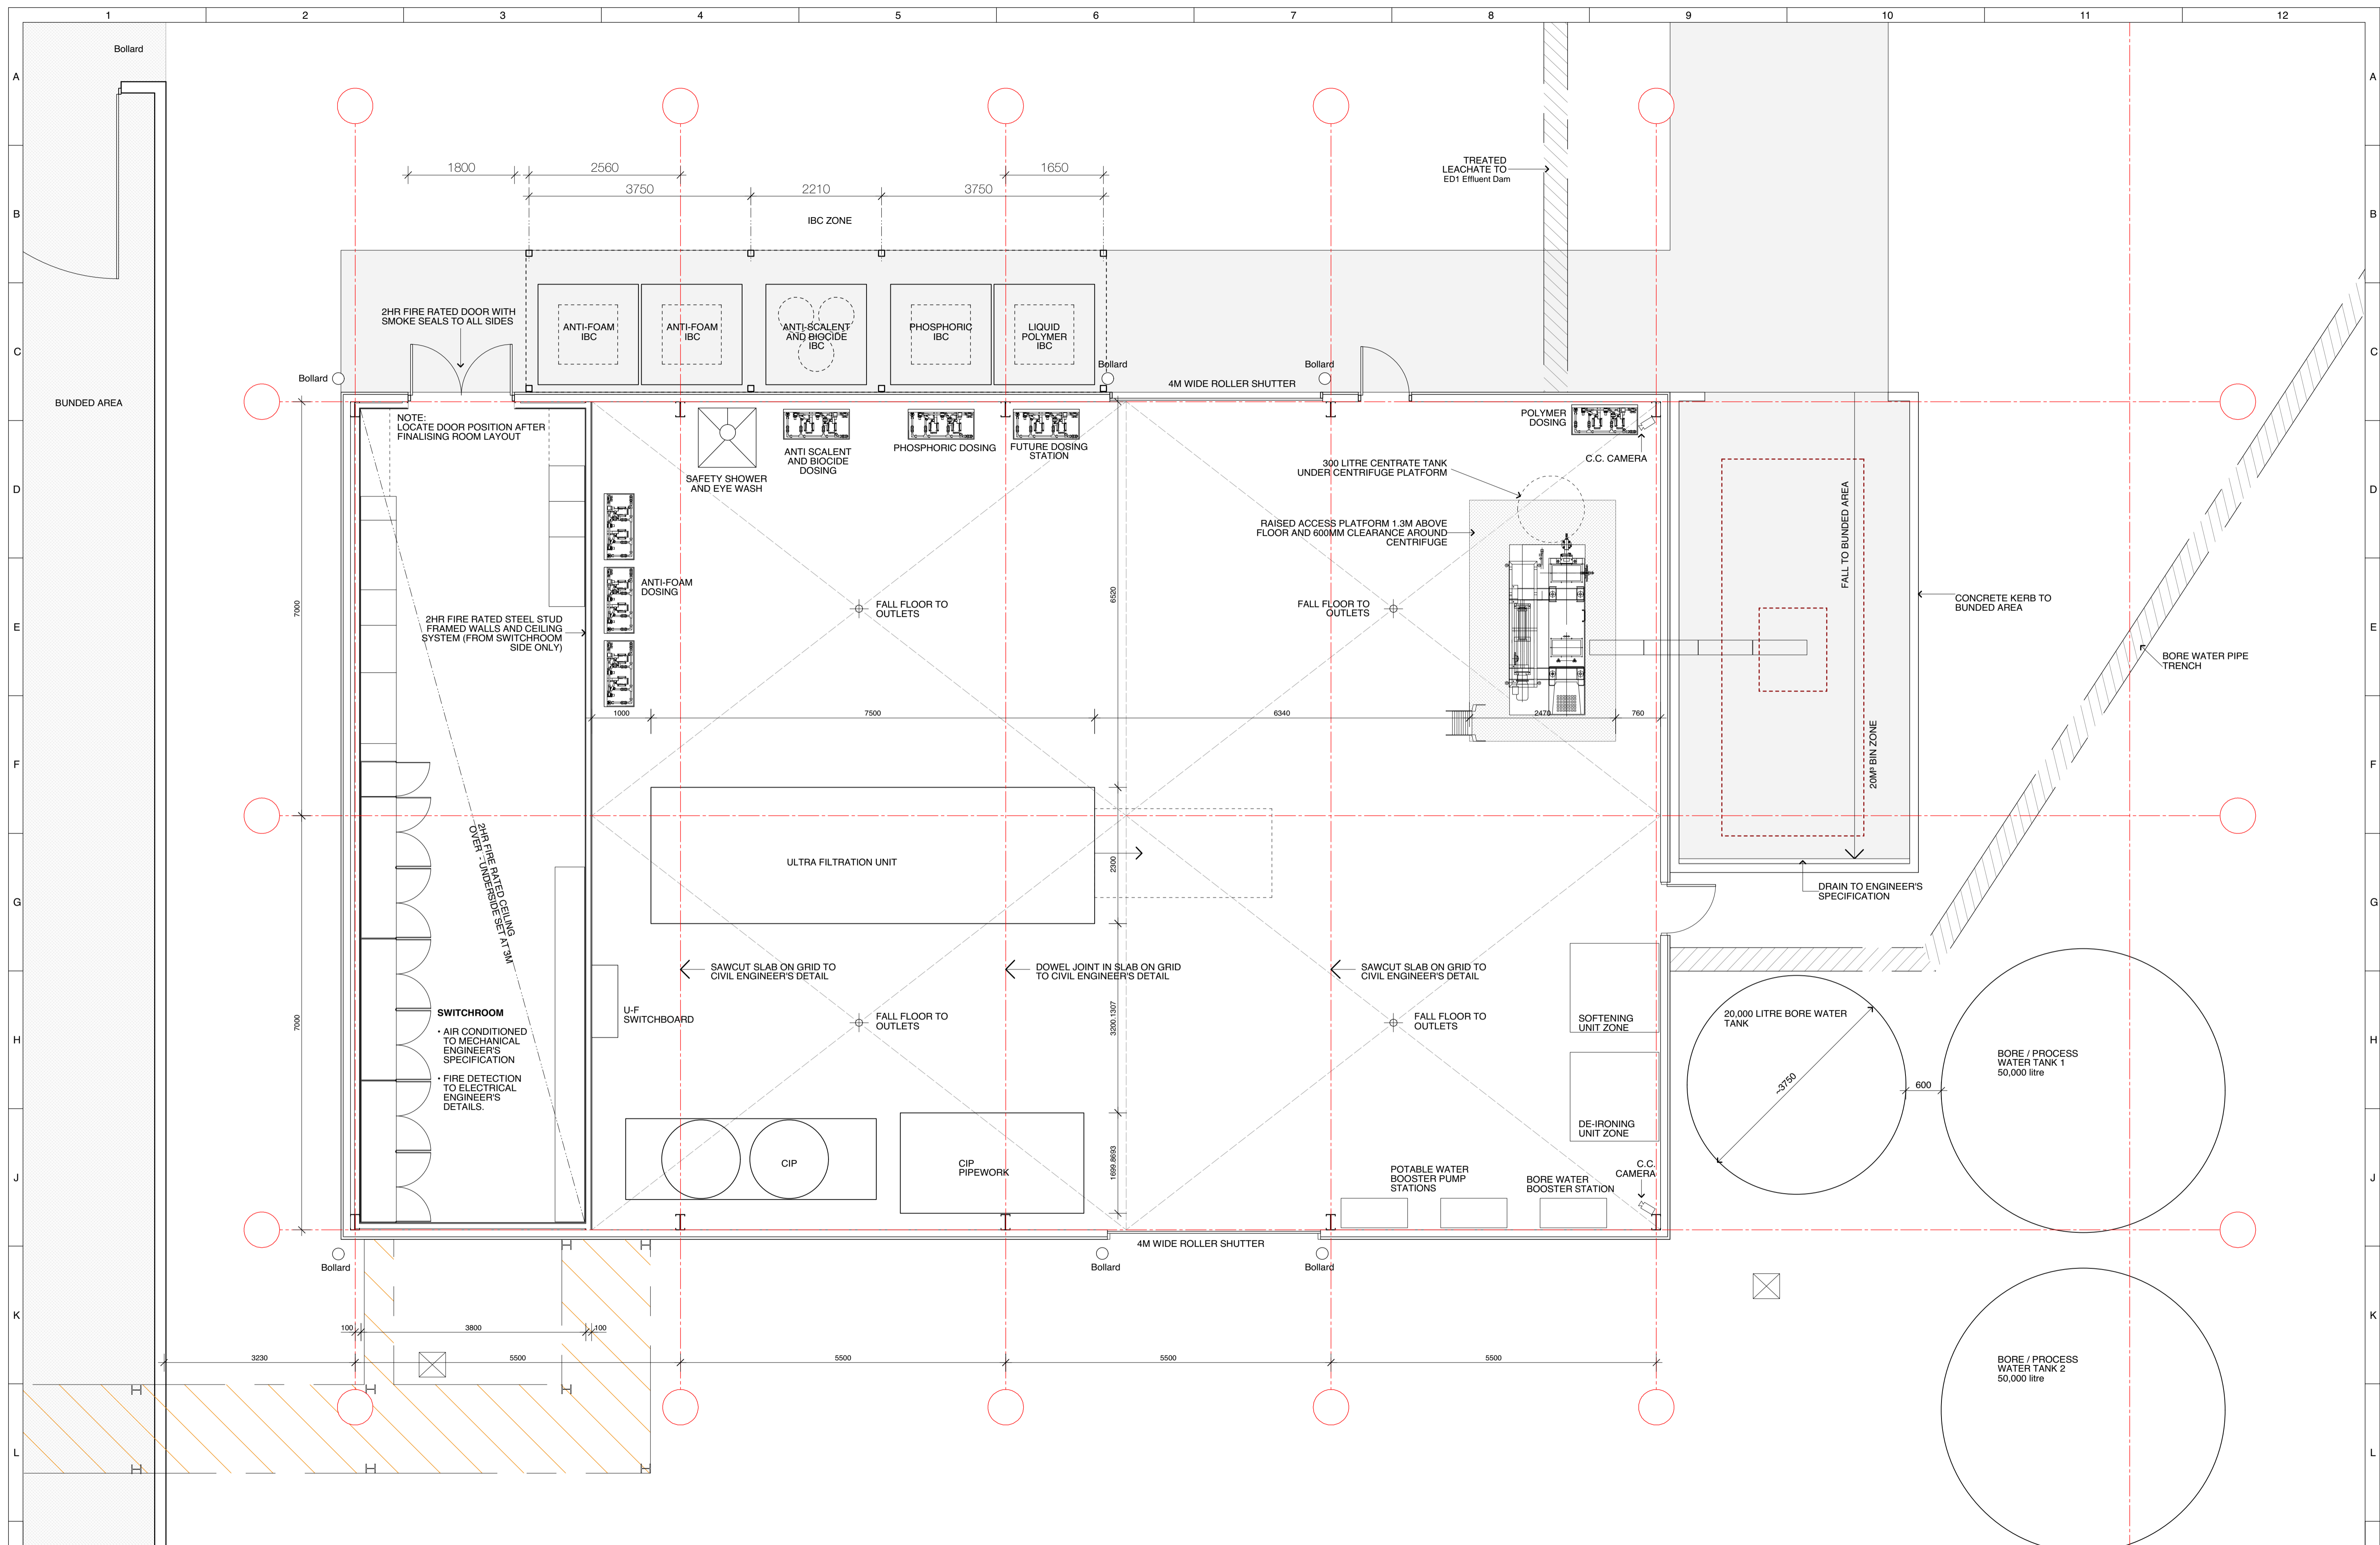

REV	1	2	3	4	5	6	7	8	9	10	11	12
B_01	ISSUED FOR TENDER	JM	MS	MS	31/05/2017							
B_00	ISSUED FOR CONCEPT DESIGN	JM			24/04/2017							
REV	1	2	3	4	5	6	7	8	9	10	11	12
	REVISION	DRAWN	CHECKED	APPROVED	REVISION DATE							

DO NOT SCALE THIS DRAWING  
IF IN DOUBT ASK  
THIRD ANGLE PROJECTION

THIS DRAWING IS THE SUBJECT OF COPYRIGHT  
AND MUST NOT BE COPIED OR OTHERWISE USED  
WITHOUT THE EXPRESS AUTHORITY OF VEOLIA  
AUSTRALIA AND NEW ZEALAND

Level 4, Bay Centre,  
65 Pirrama Road  
Pyrmont, NSW, 2009  
Sydney, Australia.  
Phone: +61 (2) 85710000  
Web: www.veolia.com/anz  
Email: reception.PYR@veolia.com

DRAWN  
DATE  
24/04/2017

CHECKED  
MS  
DATE  
24/04/2017

APPROVED  
DATE

PROJECT  
WOODLAWN LEACHATE TREATMENT PLANT

TITLE  
LTP SHED LAYOUT PLAN


SCALE  
1:100

SHEET  
01 OF 01

SIZE  
A1

DRAWING No.  
00004-Z-00-D03-00-01

REVISION  
B\_01

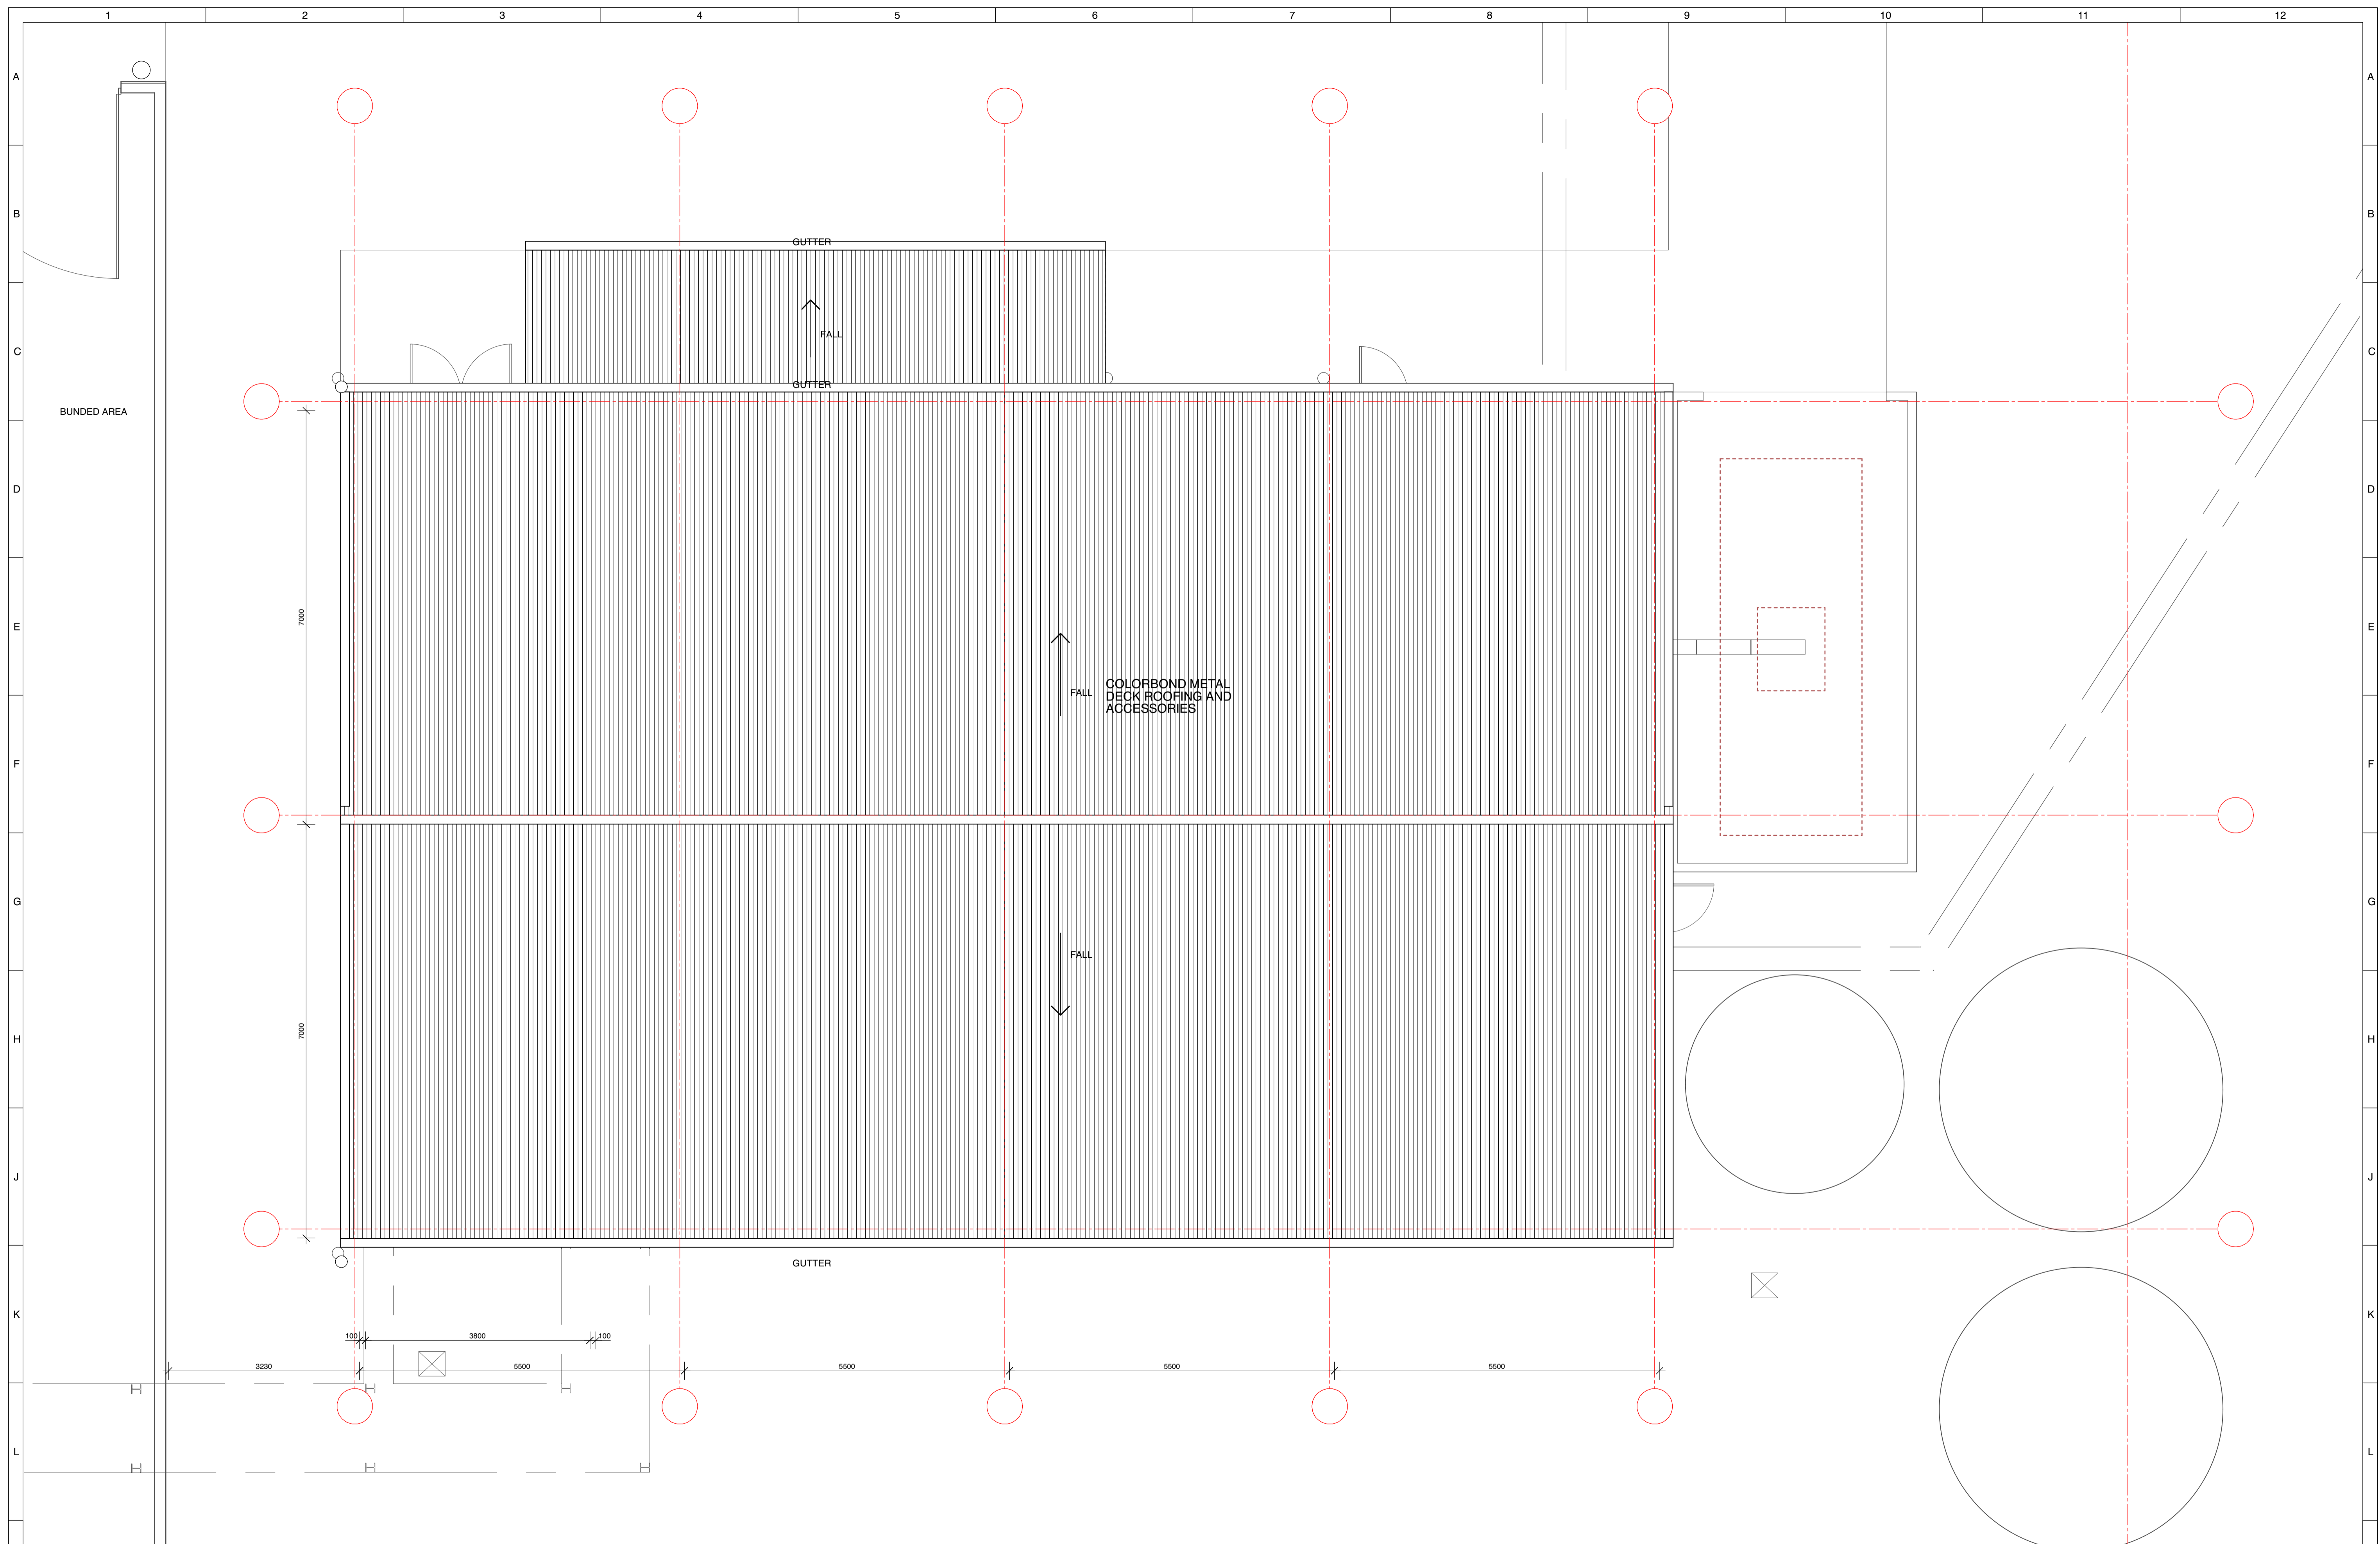

REV	REVISION	DRAWN	CHECKED	APPROVED	REVISION DATE
B_01	ISSUED FOR TENDER	JM	MS	MS	31/05/2017
B_00	ISSUED FOR CONCEPT DESIGN	JM	-	-	24/04/2017

DO NOT SCALE THIS DRAWING  
IF IN DOUBT ASK  
THIRD ANGLE PROJECTION

THIS DRAWING IS THE SUBJECT OF COPYRIGHT  
AND MUST NOT BE COPIED OR OTHERWISE USED  
WITHOUT THE EXPRESS AUTHORITY OF VEOLIA  
AUSTRALIA AND NEW ZEALAND

Level 4, Bay Centre,  
65 Pirrama Road  
Pyrmont, NSW, 2009  
Sydney, Australia.  
Phone: +61 (2) 85710000  
Web: www.veolia.com/anz  
Email: reception.PYR@veolia.com

DRAWN	DATE
CHECKED	DATE
APPROVED	DATE

PROJECT WOODLAWN LEACHATE TREATMENT PLANT

TITLE LTP SHED ROOF PLAN

SCALE	1:50	SHEET	01	OF	01	SIZE	A1
DRAWING No.	00004-Z-00-D04-00-01			REVISION	B_01		