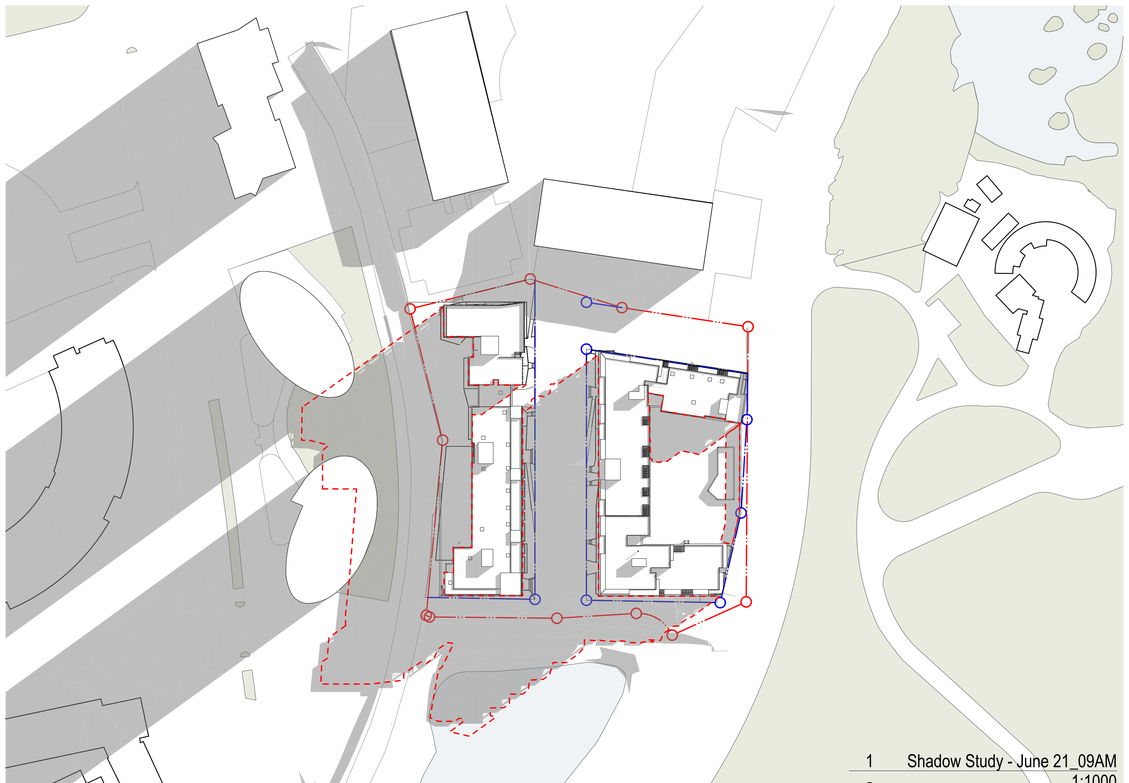

1 Shadow Study - June 21_09AM
- 1:1000

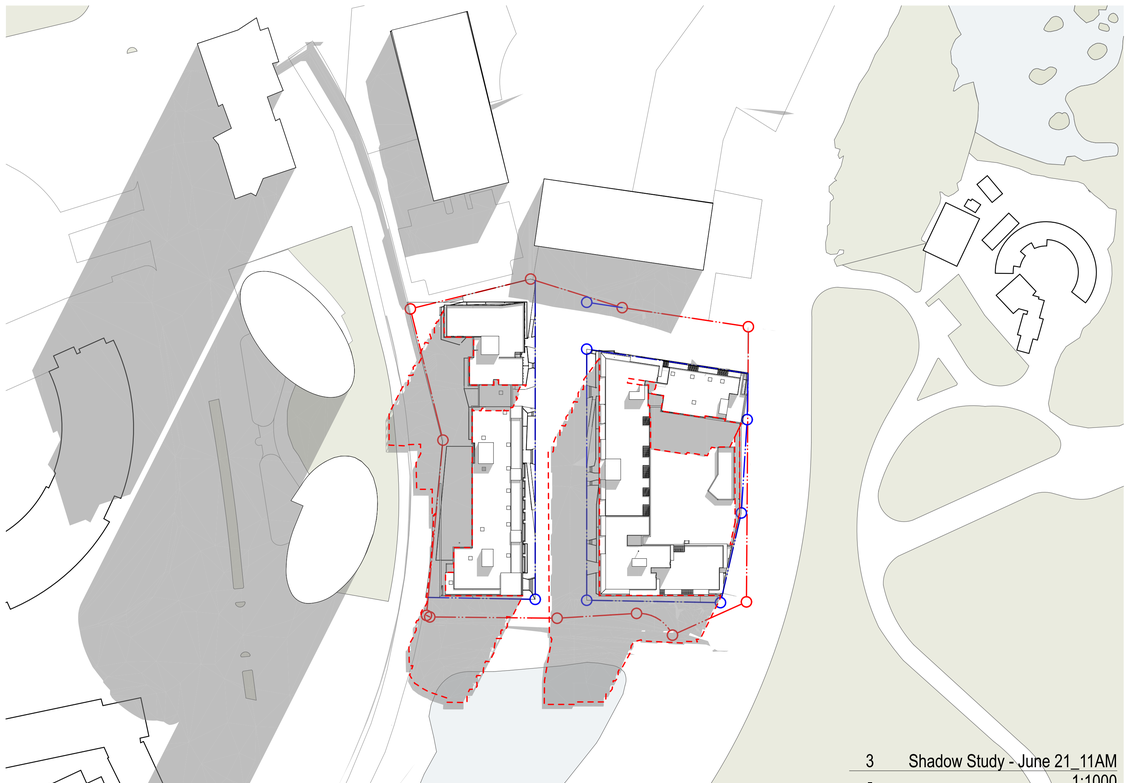

3 Shadow Study - June 21_11AM
- 1:1000

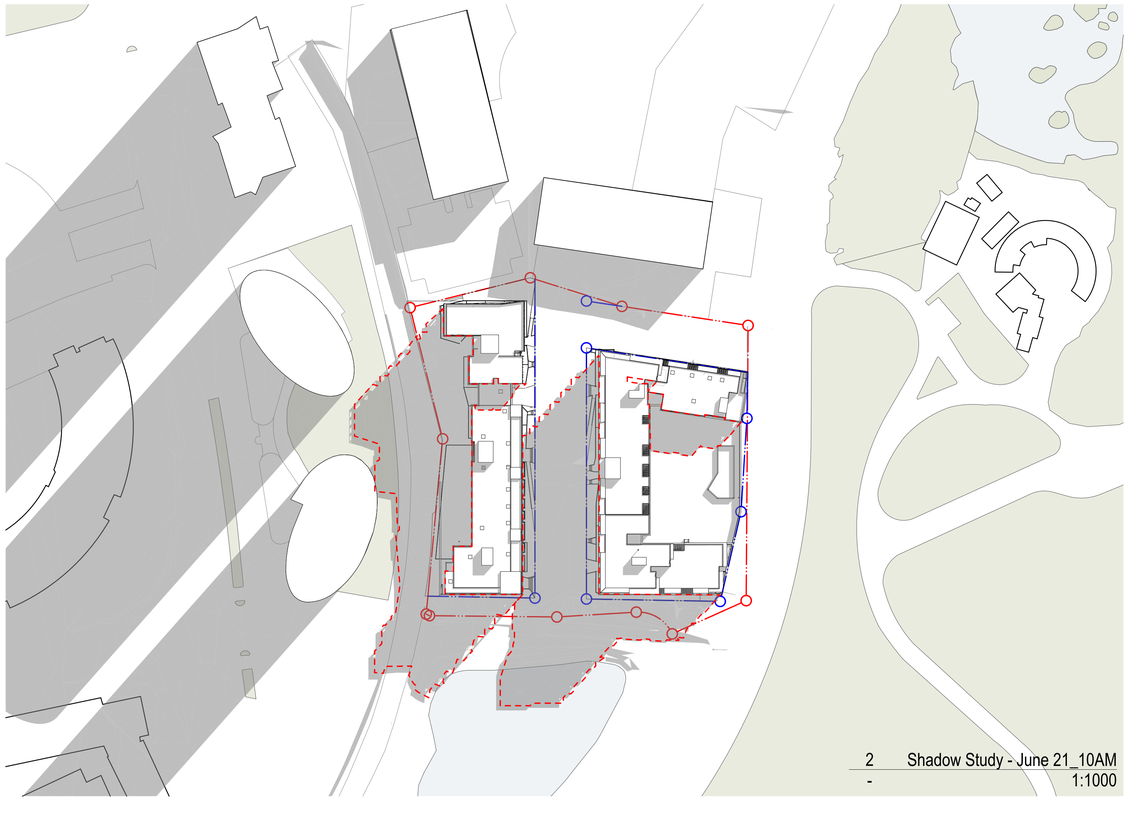

2 Shadow Study - June 21_10AM
- 1:1000

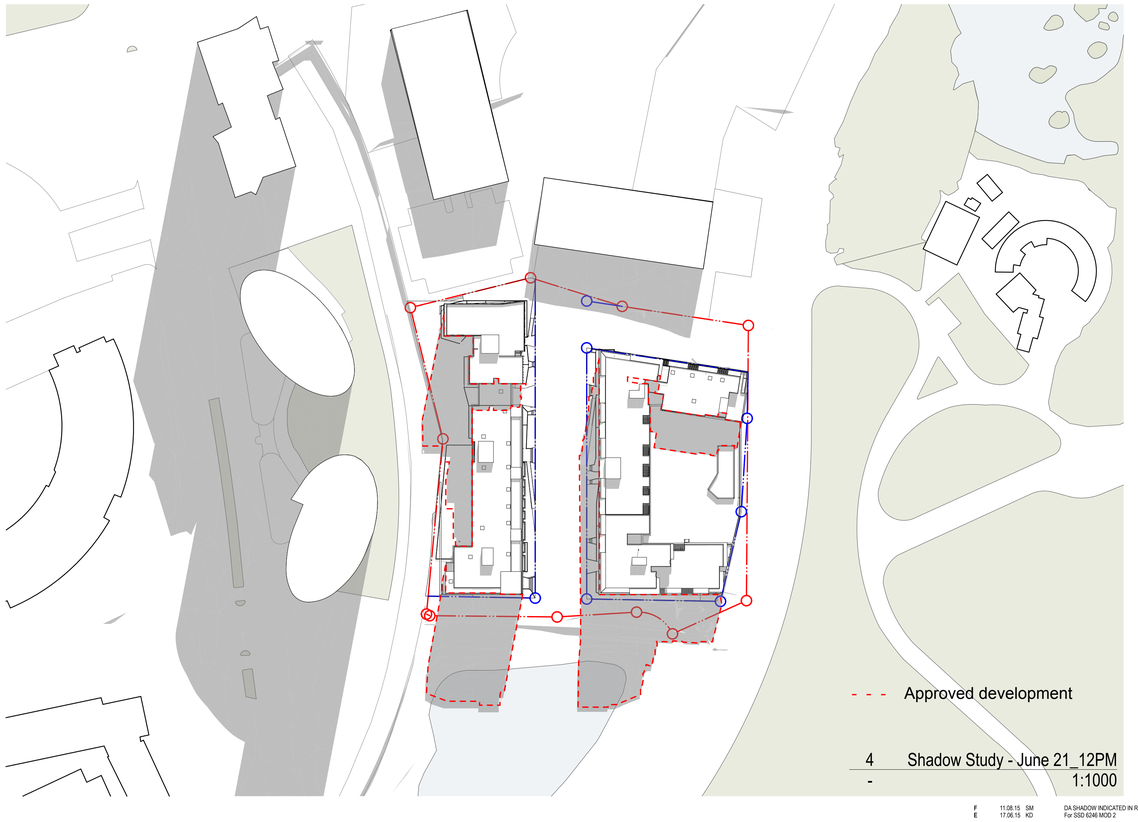

4 Shadow Study - June 21_12PM
- 1:1000

NOTES

THIS DRAWING IS THE COPYRIGHT © OF TURNER. NO REPRODUCTION WITHOUT PERMISSION. UNLESS NOTED OTHERWISE THIS DRAWING IS **NOT FOR CONSTRUCTION**. ALL DIMENSIONS AND LEVELS ARE TO BE CHECKED ON SITE PRIOR TO THE COMMENCEMENT OF WORK. INFORM TURNER OF ANY DISCREPANCIES FOR CLARIFICATION BEFORE PROCEEDING WITH WORK. DRAWINGS ARE NOT TO BE SCALED. USE ONLY FIGURED DIMENSIONS. REFER TO CONSULTANT DOCUMENTATION FOR FURTHER INFORMATION.

DLCS Quality Endorsed Company ISO 9001:2008, Licence Number 4168
Nominated Architect: Nicholas Turner 5695, ABN 86 064 084 911

CLIENT
Meriton
528 Kent Street Sydney NSW 2000

Rev.	Date	Approved by	Revision Notes
F	11.08.15	SM	DA SHADOW INDICATED IN RED DASHED LINE
E	17.06.15	KD	For SSD 6246 MOD 2

Project Title
Residential Development
100 Bennelong Road Olympic Park NSW 2127

Drawing Title
Shadow Studies
Shadow Studies - Jun 21 Sheet 1

Scale: **1:1000 @B1, 40%@A3**
Project No.: **13056**
Drawn by: **MP**
North
Status: **SSD 6246 MOD 2**
Dwg No.: **A-SSD-750-003**
Rev: **F**

turner.
Level 1, 410 Crown Street
Surry Hills NSW 2010
Australia
T +61 2 8668 0002
F +61 2 8668 0088
turnerstudio.com.au