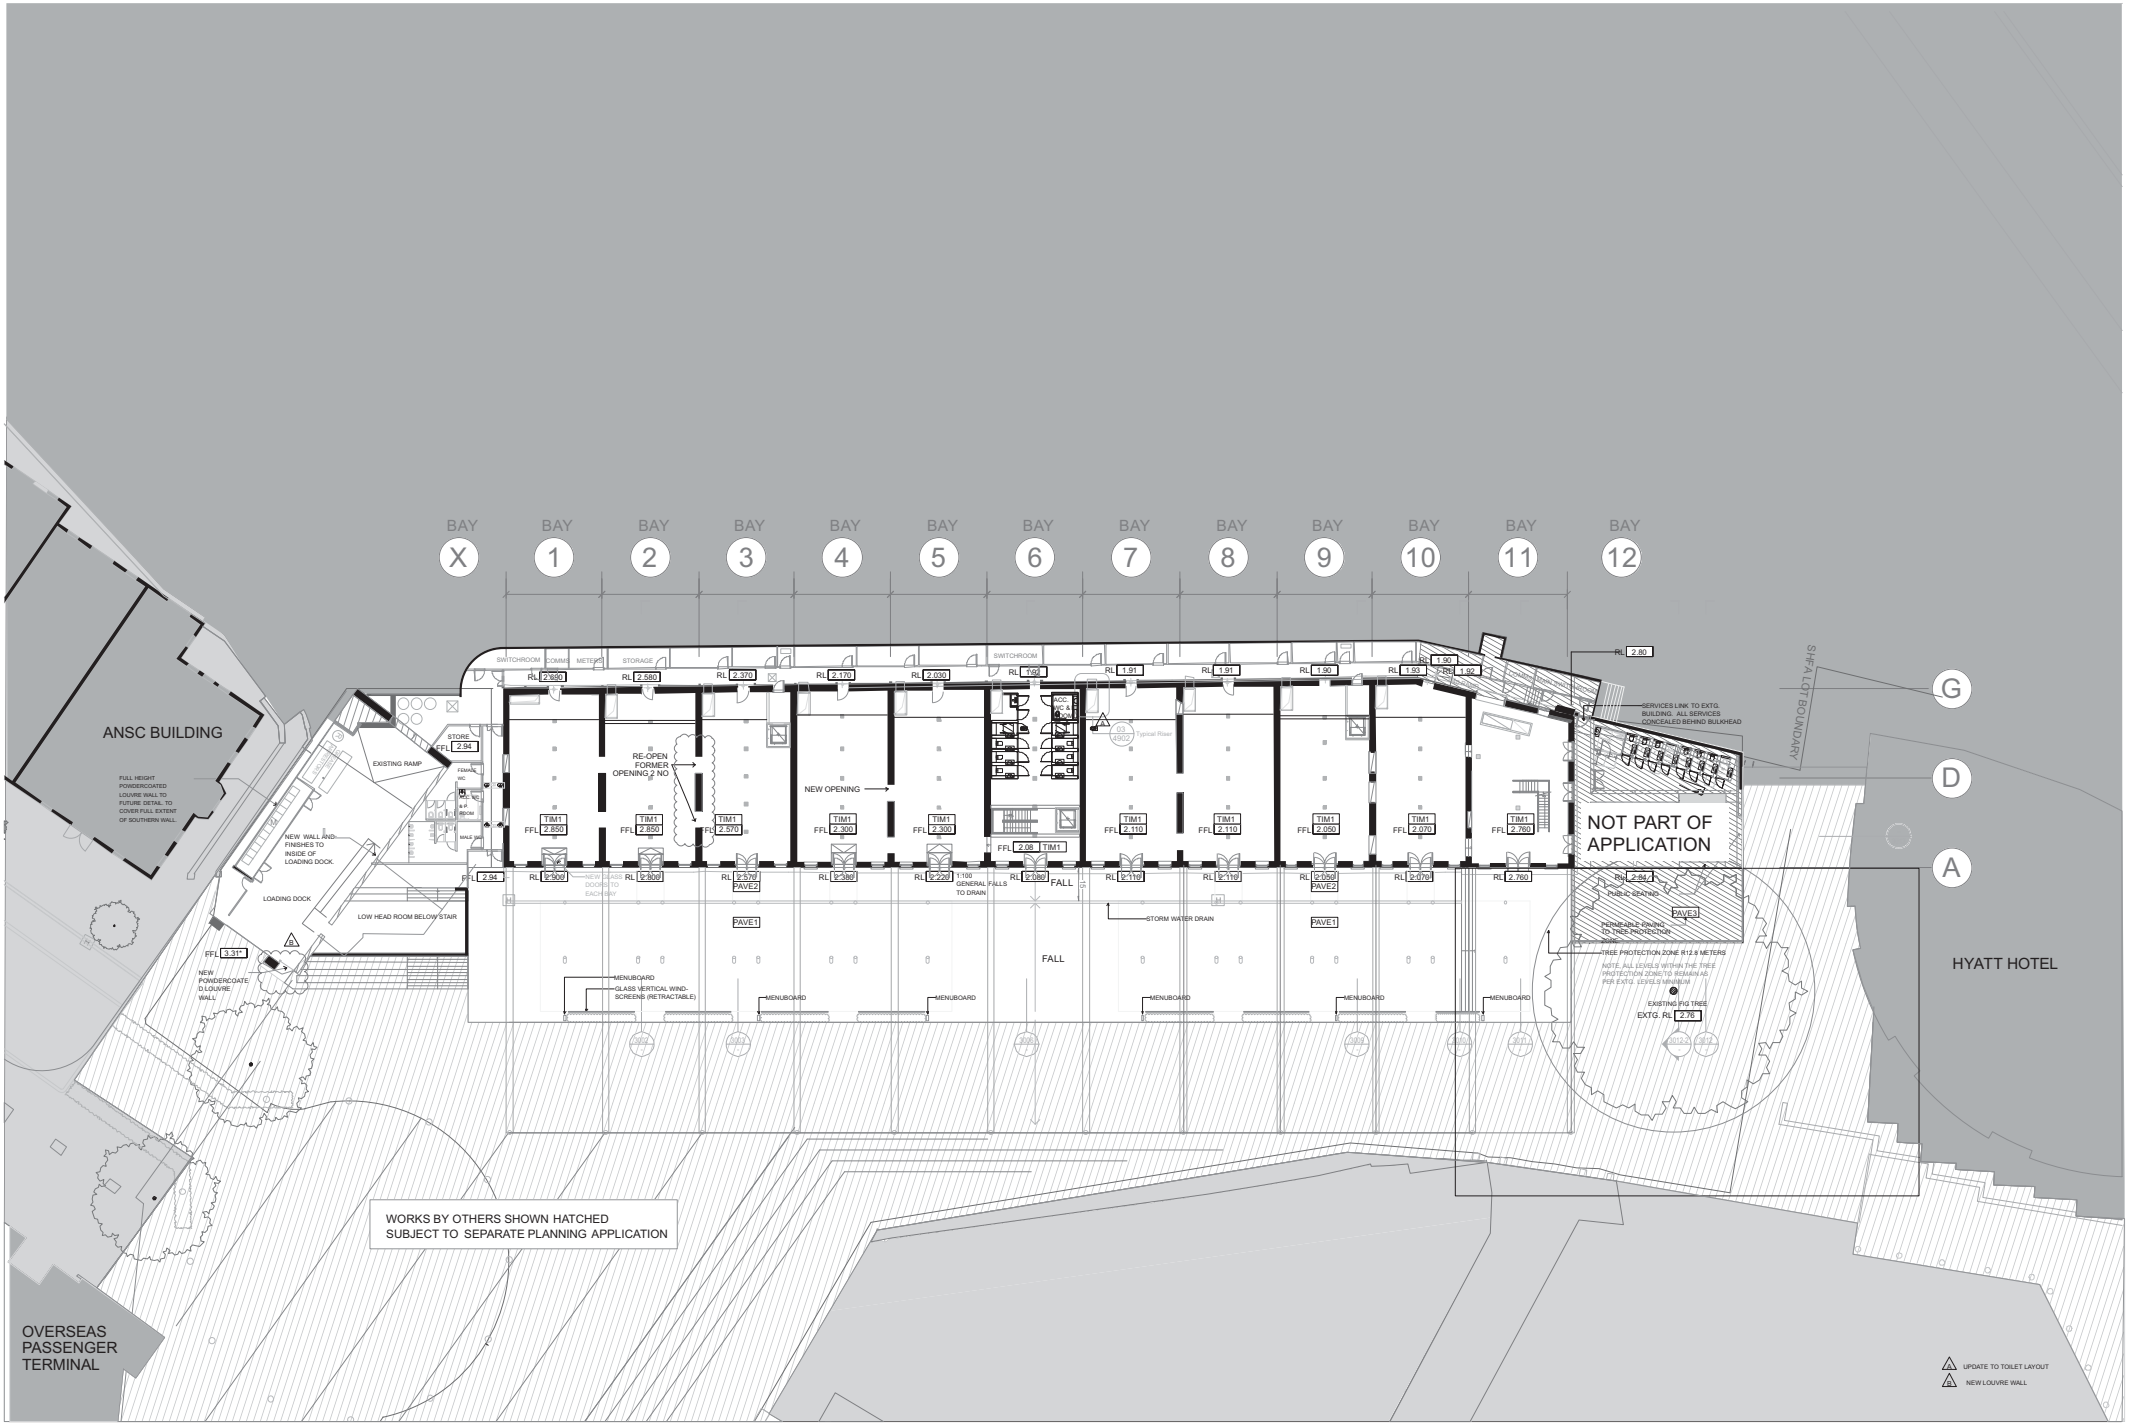

Client
Tallawoladah Pty Ltd
Suite 301, 35 Lime St, Sydney NSW 2000

Project Manager & Quantity Surveyor
Altus Page Kirkland
The Podium Building, 1 Market Street, Sydney NSW 2000
Telephone +61 2 9283 7311
www.altusgroup.com

Services Engineer
Northrop Consulting Engineers Pty Ltd.
Level 11, 345 George Street, Sydney, NSW 2000
Telephone +61 2 9241 4188 Facsimile +61 2 9241 4324
http://www.northrop.com.au

Structural & Civil Engineer
Taylor Thomson Whitting Consulting Engineers
Level 3, 48 Chandos Street St Leonards NSW 2065
Telephone +61 2 9439 7288 Facsimile +61 2 9439 3146
www.ttw.com.au

Materials Key
Refer to Appendix 2- Materials Board for finishes

PAVE1	GB1	CONC2	MP1	SL
PAVE2	GB2	TIM1	MP2	MS
PAVE3	GL1	TIM2	SS1	GLT
PAVE4	GL2	TILE1	PT1	PC
PAVE5	GL3	TILE2	PT5	
ASPHL	GL4	TILE3	BL1	
ST1	CONC1	SP1	TR2	

Key
Existing Works
New Works
infills to existing opening
Indicative Fit out design (not part of the scope of works)

Project Title
CAMPBELL'S STORES
SYDNEY HARBOUR

Survey Note:
Drawings are based on As built drawings and Survey information provided by SHFA to form the basis for the floor levels of level 01 and 02 as well as the roof ridge level.
Surveys are oriented to MGA North point, and AHD Datum.
Where tide levels have been provided registered to 'Fort Denison' levels, RL 0.00 AHD is assumed to correlate to Fort Denison -0.625m.

Surveys used:
'9r1649-R01r1'
'9r1649-B-Manlcup'
'R2061_2004'
For adjacent buildings used:
'R2061_cloud'

Rev	Date	App	Ckd	Revision or reason for issue
-	D3 12/02/19			Reopen former openings 2 no.

Scale / North Point
1:200@ B1, 1:300@ A3
0 1 2 4 6 10m

Do not scale from drawing. Use marked dimensions.
To be read in conjunction with all other Consultant's drawings.
The Architect to be immediately notified of any discrepancies.
Copyright on this drawing retained by the Architect.

Key Plan

Drawing Title
GROUND FLOOR

Drawing Number
EA-A-1001

Revision
D3

Drawing Status
EA