NSW GOVERNMENT | Planning, Industry & Environment

Issued under the Environmental Planning and Assessment Act 1979

Approved Section: 4.55(1A) Application No: SSD-8365-Mod-1

Granted on: 6 April 2020 Sheet no: 1 of 35 Signed:

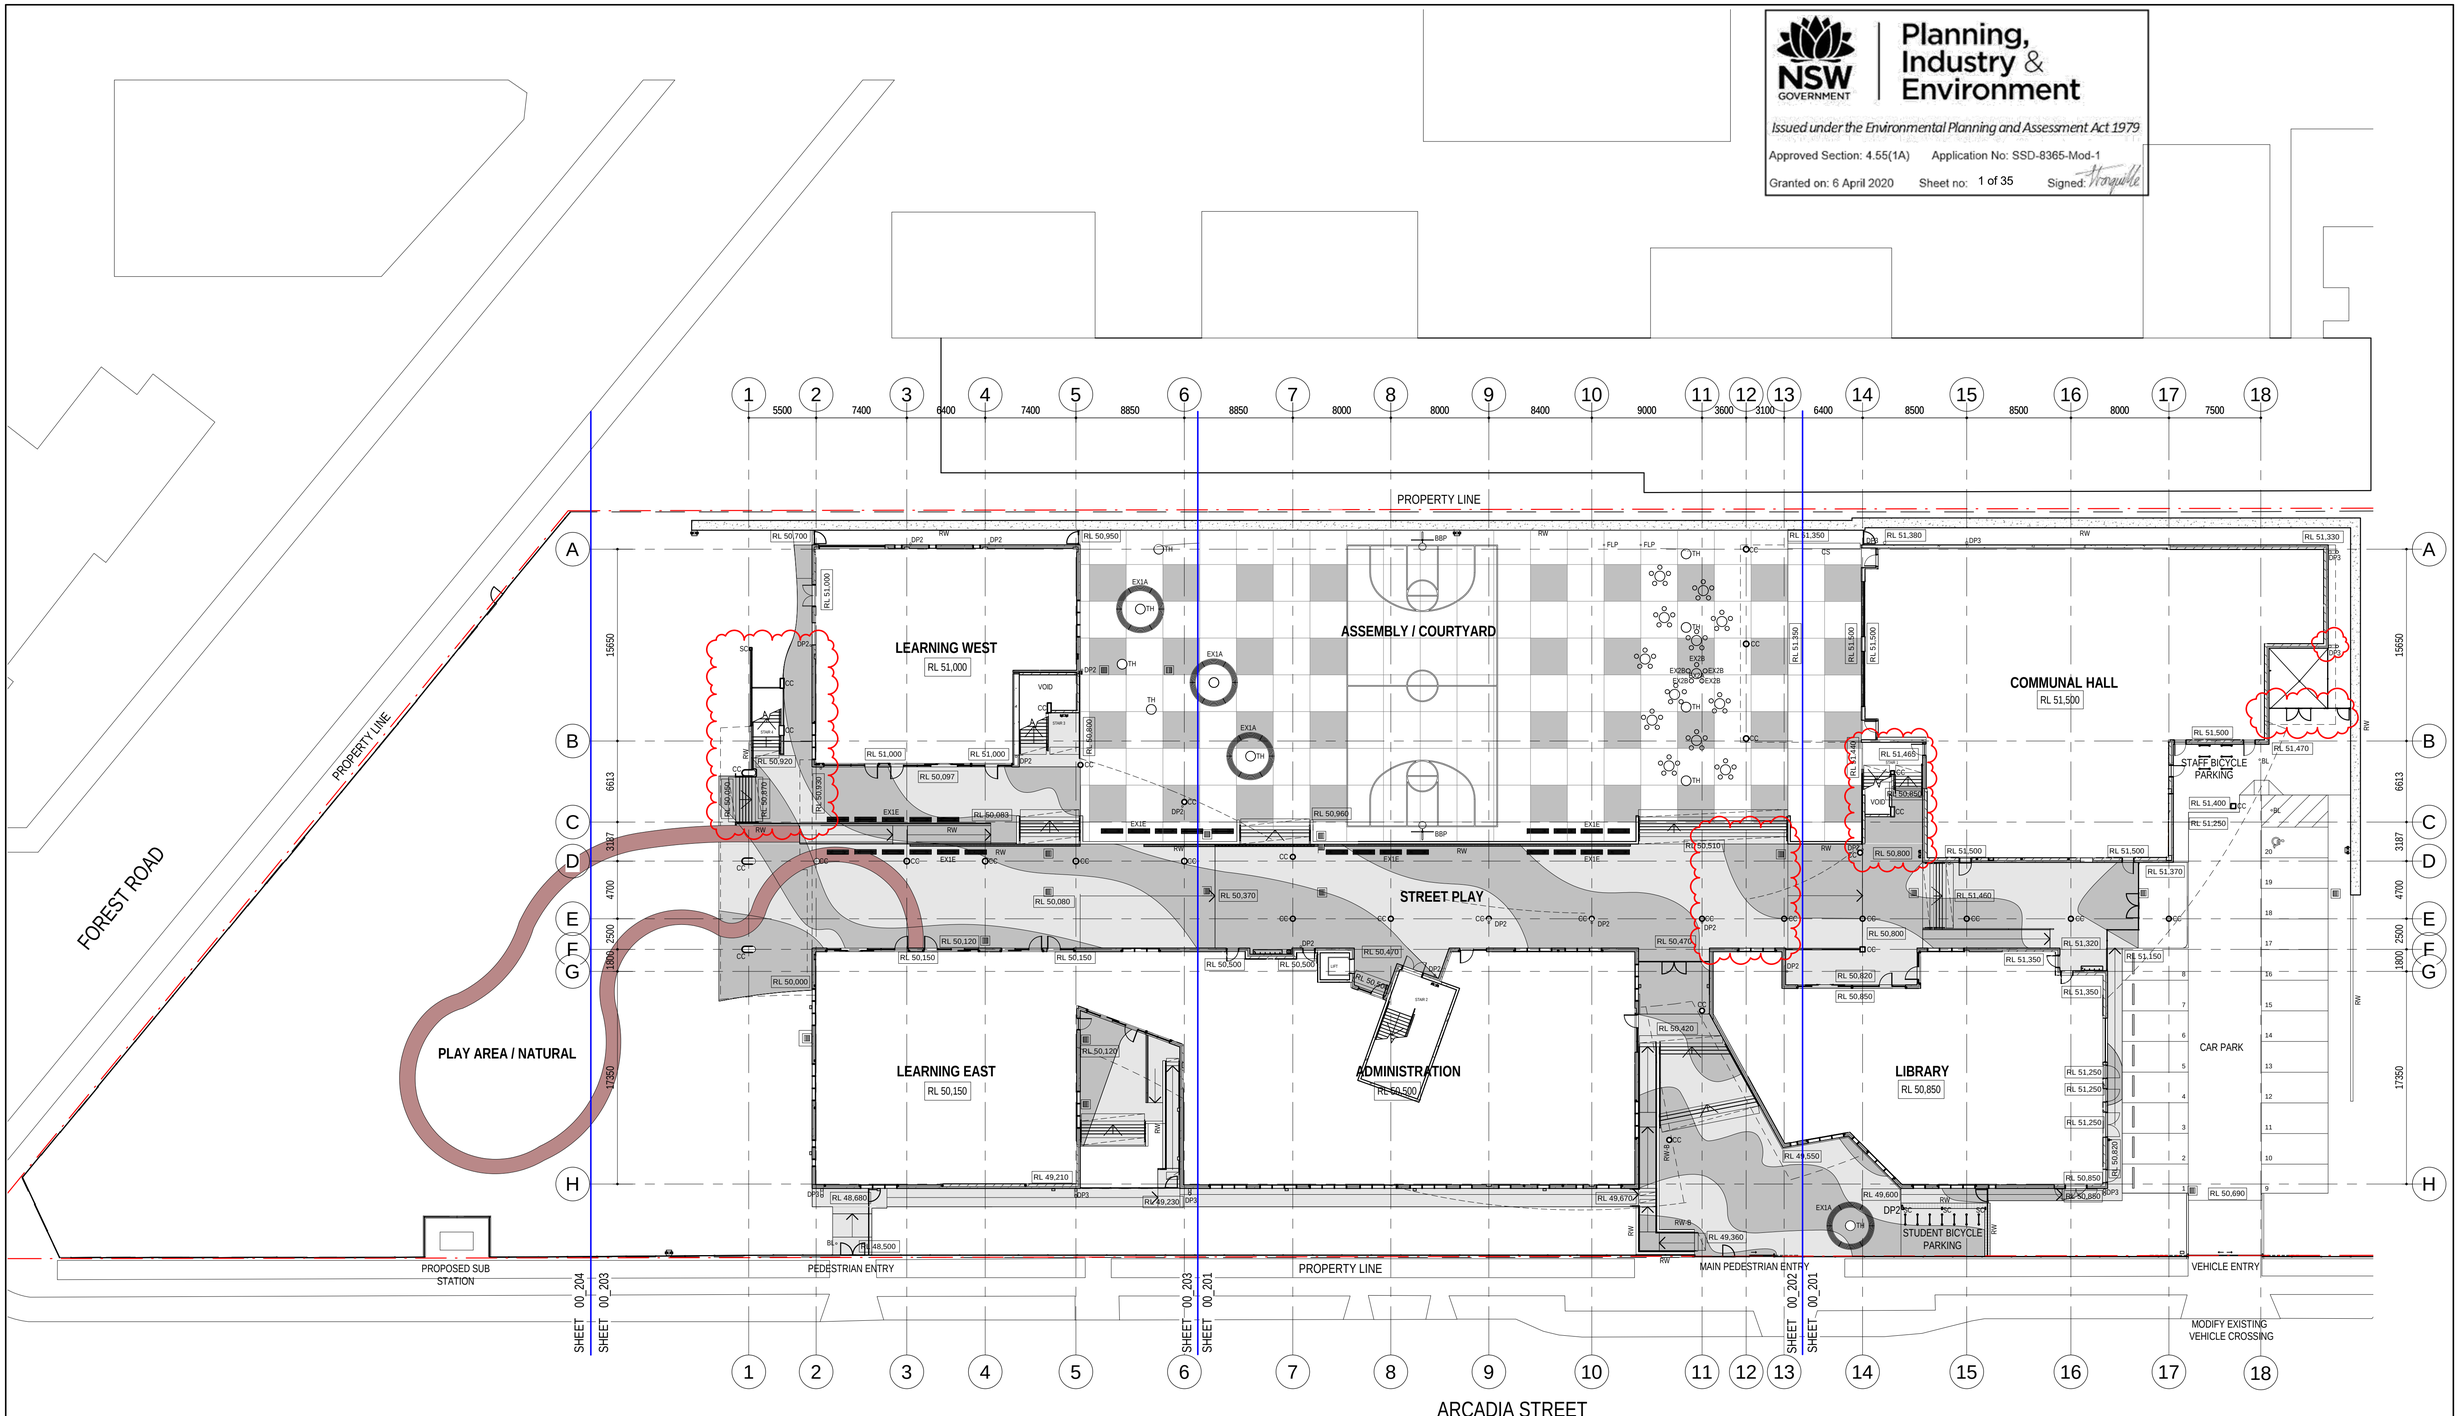

13/11/2019 3:00:16 PM

ISSUED FOR S4.55(1A)

AMENDMENTS

REV	BY	DATE	DESCRIPTION
01	RO	17.05.19	ISSUE FOR CONSTRUCTION
02	MW	01.07.19	AMEND OSD TANK POSITION AND SIZE
03	AC	19.07.19	MOVED RETAINING WALL, MOVED DOWNPIPE, AMEND STUDENT BIKE PARKING RETAINING WALL
04	MW	01.08.19	ISSUED FOR INFORMATION
05	MW	16.10.19	ADD STAIR 04, AMEND STAIR 01, DELETE SC & AMEND ROOF AT WASTE. ISSUED FOR S4.55(1A)
06	MW	28.10.19	AMEND EXTENT OF RAMP NEAR ST-8, ADD/AMEND RLs TO MATCH CIVIL

LEGEND

NOTE:
REFER TO CIVIL DRAWINGS FOR ALL EXTERNAL WORKS SITE RL

REFER TO ARC 00_201 - 00_204, 00_213, 00_231- 00_233
FOR SETOUT OF COLOURED CONCRETE AND COLOURED WATERPROOF MEMBRANE.
REFER TO FINISHES DRAWINGS FOR COLOUR CODES

KEY PLAN

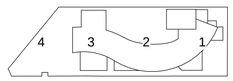

NSW GOVERNMENT Education

STRUCTURE, CIVIL & HYDRAULIC
WOOLACOTTS ENGINEERS
T: 02 8203 1500

MECH, ELECT, IT, COMMS & SEC.
JHA CONSULTING
T: 02 9437 1000

BCA
GROUP DLA
T: 02 8355 3160

LANDSCAPE
LORNA HARRISON P/L
T: 02 9555 1147

PERUMAL PEDAVOLI ARCHITECTS
T: 02 9291 0000
WEB: www.pp-a.com.au
Nominated Architect:
Vince Pedavoli NSW reg No.5045

STATUTORY PLANNER
DON FOX PLANNING P/L
T: 02 9473 4914

PERUMAL PEDAVOLI ARCHITECTS

PENSHURST PUBLIC SCHOOL
18 Arcadia Street, Penshurst

DRAWING NAME
OVERALL SITE MASTERPLAN

CONTRACT NUMBER: SINSW-18-1257

PROJECT NORTH

0 2500 5000 7500 10000 12500 25000
SCALE As indicated @ A1

DRAWN	CHECKED	VERIFIED	DATE
Author	Checker	Approver	12 NOVEMBER 2019

DRAWING NUMBER: 3199-ARC-CD-00_200
REVISION: 06

PROJECT CODE | DISCIPLINE | PHASE | SERIES NUMBER

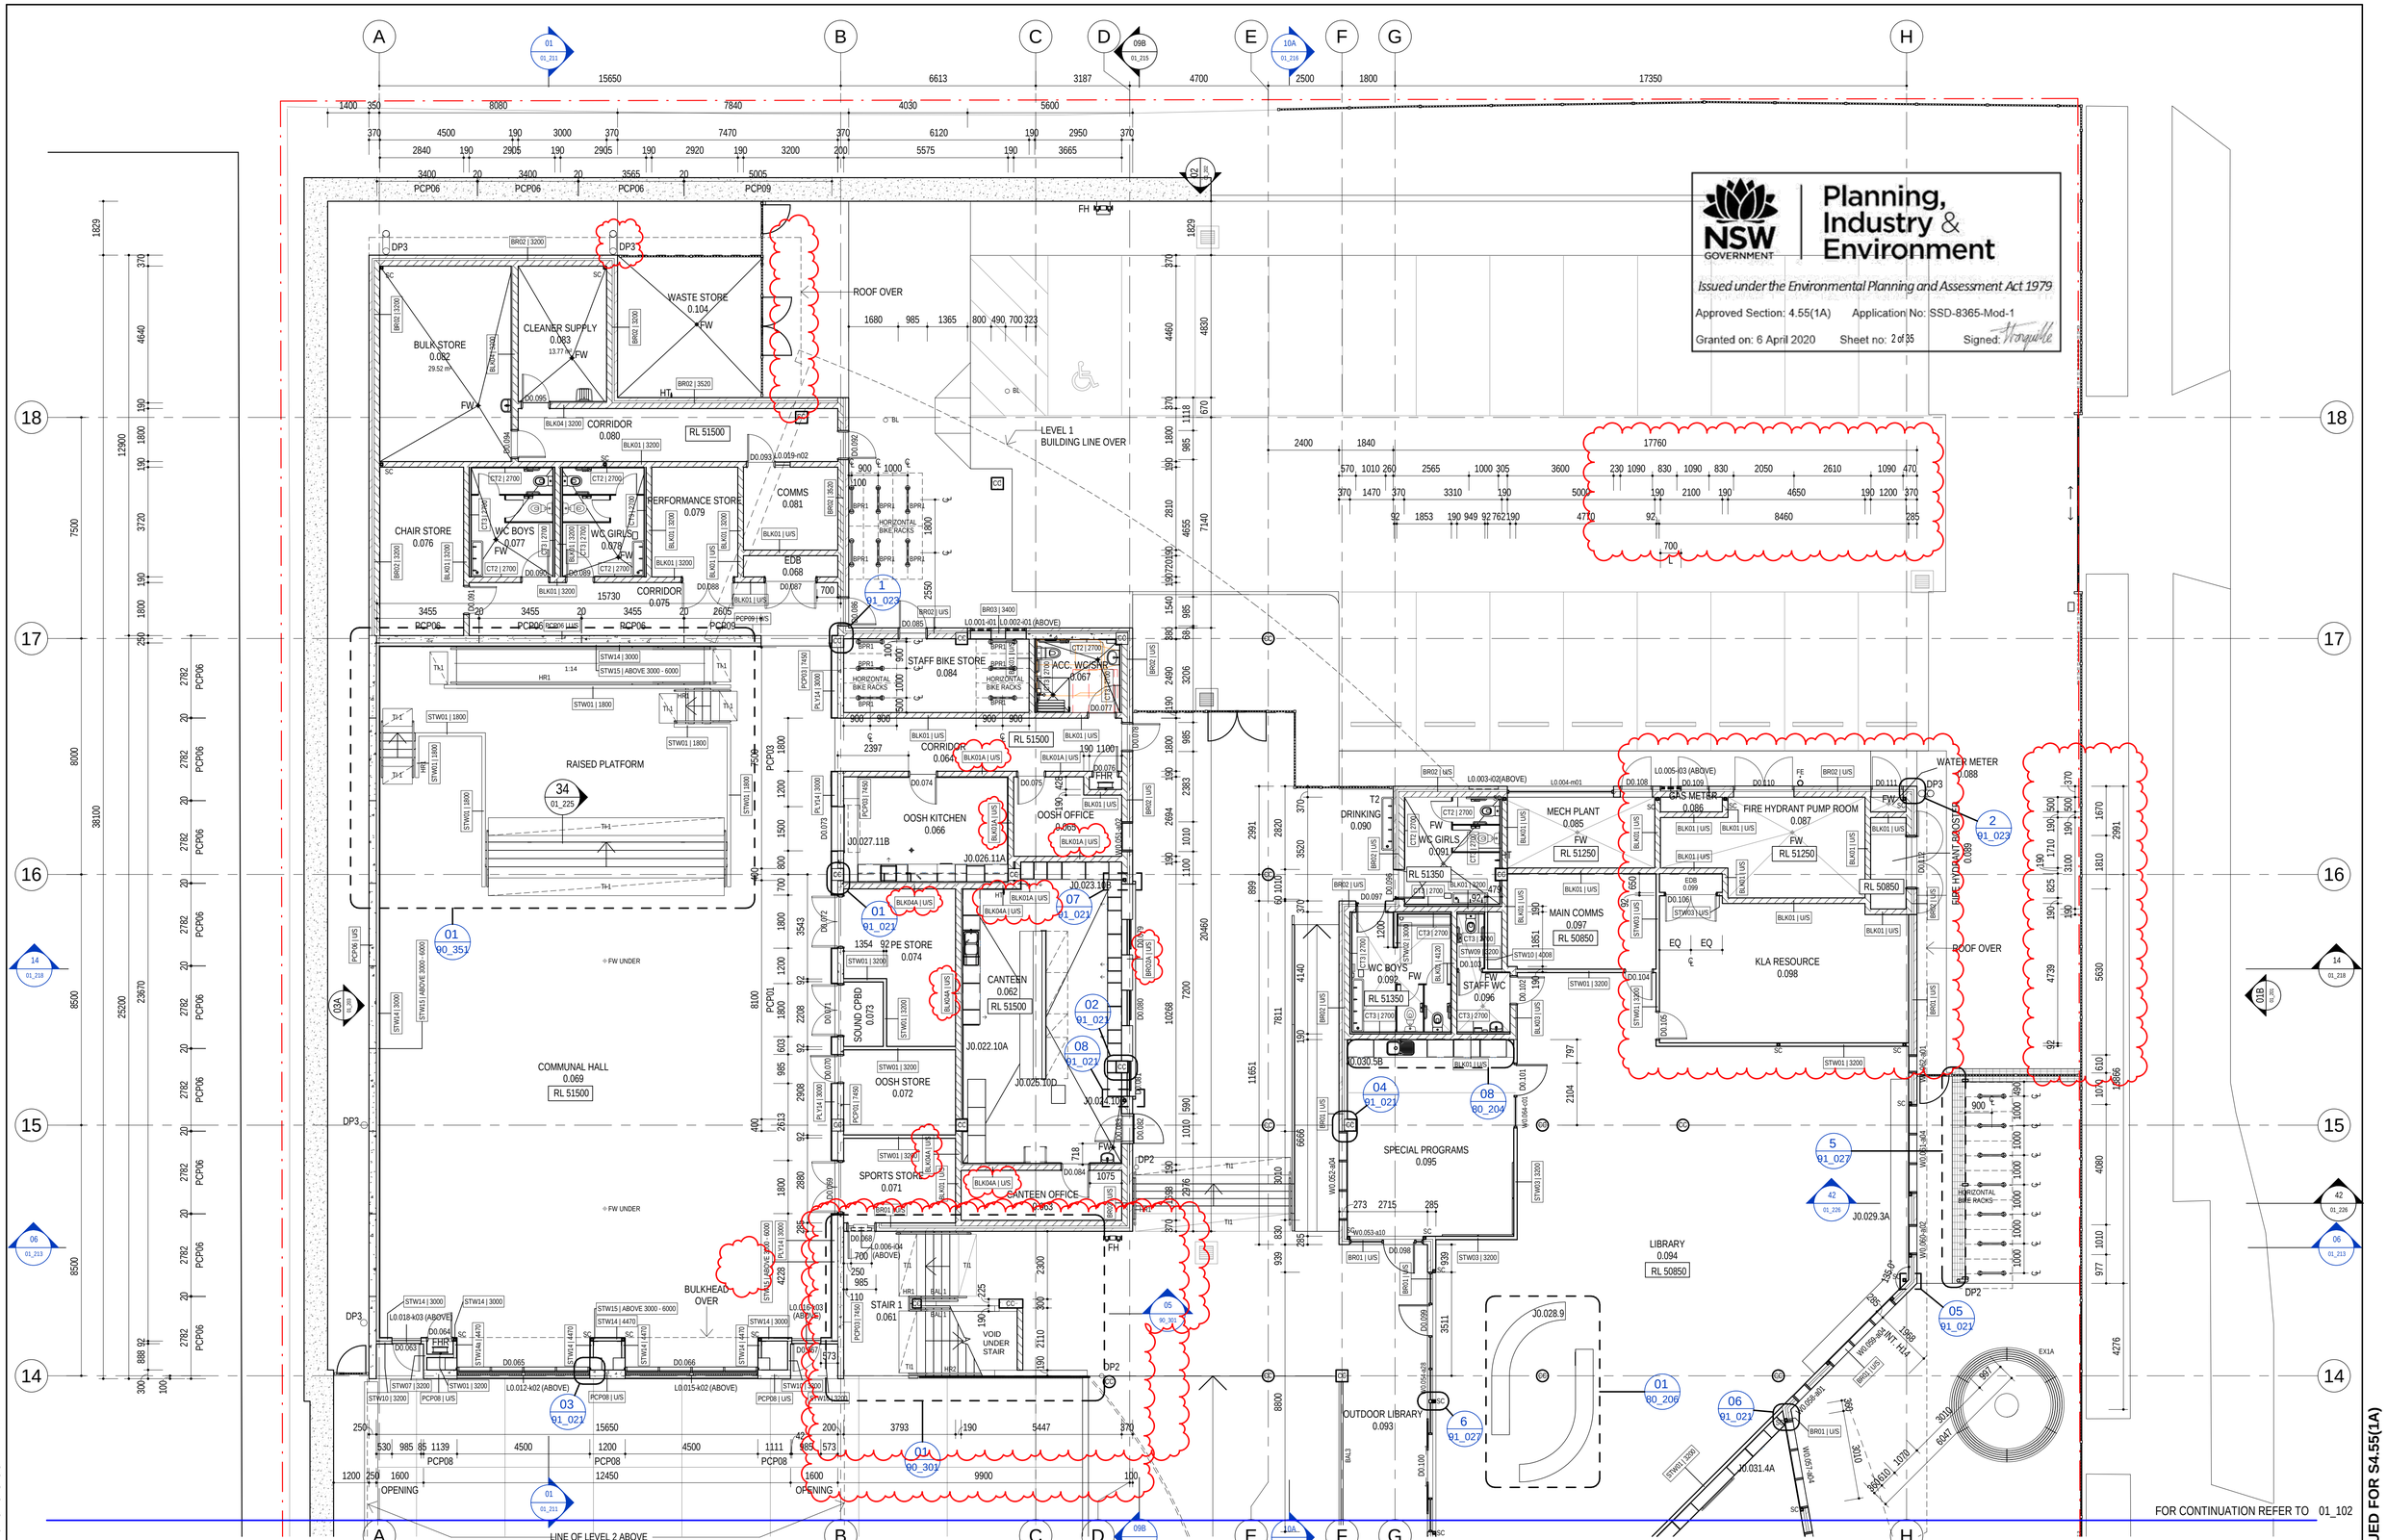

Planning, Industry & Environment

Issued under the Environmental Planning and Assessment Act 1979

Approved Section: 4.55(1A) Application No: SSD-8365-Mod-1

Granted on: 6 April 2020 Sheet no: 2 of 35 Signed:

13/11/2019 3:00:41 PM

ISSUED FOR S4.55(1A)

AMENDMENTS			
REV	BY	DATE	DESCRIPTION
06	MW	16.08.19	MOVE HYDRANT INTO CAR PARK
07	MW	30.08.19	AMEND WALL HEIGHT AND/OR TYPES, RE-SIZE LOUVRE
08	MW	06.09.19	CHANGE WALL FROM STW01 TO STW03 (60/60/60)
09	MW	16.10.19	ENLARGE FH PUMP RM & REDUCE GAS METER RM., AMEND STAIR 01 & SPORT STORE, DELETE SC & MOVE DP FOR WASTE AREA. ISSUED FOR S4.55(1A)
010	MW	28.10.19	CANTEEN & OOSH KITCHEN WALLS CORE FILLED BLOCKWORK
011	MW	05.11.19	ADD LOWER STEPS TO STAIR 1

LEGEND

KEY PLAN

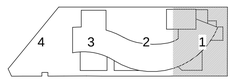

NSW GOVERNMENT Education

STRUCTURE, CIVIL & HYDRAULIC WOOLACOTTS ENGINEERS T: 02 8203 1500	**PERUMAL PEDAVOLI ARCHITECTS** T: 02 9291 0000 WEB: www.pp-a.com.au Nominated Architect: Vince Pedavoli NSW reg No.5045
MECH, ELECT, IT, COMMS & SEC. JHA CONSULTING T: 02 9437 1000	
BCA GROUP DLA T: 02 8355 3160	
LANDSCAPE LORNA HARRISON P/L T: 02 9555 1147	**STATUTORY PLANNER** DON FOX PLANNING P/L T: 02 9473 4914

PERUMAL PEDAVOLI ARCHITECTS

PENSHURST PUBLIC SCHOOL

18 Arcadia Street, Penshurst

DRAWING NAME: FLOOR PLAN - LEVEL 0 - PART 1

CONTRACT NUMBER	SINSW-18-1257		
PROJECT NORTH			
0 1000 2000 3000 4000 5000 10000 SCALE 1 : 100 @ A1			
DRAWN	CHECKED	VERIFIED	DATE
Author	Checker	Approver	12 NOVEMBER 2019
DRAWING NUMBER			REVISION
PROJECT CODE	DISCIPLINE	PHASE	SERIES NUMBER
3199-ARC-CD-01_101			011

FOR CONTINUATION REFER TO 01_102

LEVEL 1 BUILDING LINE OVER
LWC HSU STUDENT 0.034
ROOF LINE OVER
HSU PS-K 0.031
CLEAR
S.O. GRID G5
LOUVRE
WITHDRAWAL 0.035
OUTDOOR STORE 0.037
RL 50150
PRESENTATION ROOM 0.043
MSR 0.048
RL 49210
SPECIAL PROGRAMS 0.038
STORE 0.039
EDB 0.044
MECH PLANT 0.047
PRACTICAL ACTIVITIES AREA 0.041
STORE 0.042
HOME BASE x 3 0.040
WITHDRAWAL 0.046
WITHDRAWAL 0.045
LEVEL 2 BUILDING LINE OVER
PRESENTATION ROOM 0.057
STAIR 3 0.060
WITHDRAWAL 0.056
HOME BASE x 3 0.053
WITHDRAWAL 0.055
COMMS 0.051
GARDEN STORE 0.049
MECH PLANT 0.052
PLANT LOBBY 0.050
EDB 0.059
PRACTICAL ACTIVITIES AREA 0.054
STAIR 4 0.106

Planning, Industry & Environment
NSW GOVERNMENT
Issued under the Environmental Planning and Assessment Act 1979
Approved Section: 4.55(1A) | Application No: SSD-8365-Mod-1
Granted on: 6 April 2020 | Sheet no: 3 of 35 | Signed:

13/11/2019 10:01:23 AM

ISSUED FOR S4.55(1A)

AMENDMENTS			
REV	BY	DATE	DESCRIPTION
02	MW	05.06.19	AMEND SIZE OF HSU SLIDING DOOR & WALL NIB SIZES
03	MW	01.07.19	AMEND OSD TANK POSITION AND SIZE, MOVE CC
04	AC	19.07.19	RETAINING WALL MOVED
05	MW	02.08.19	ADD DIMENSION BACK TO A GRID & GENERAL AMENDMENTS
06	MW	30.08.19	AMEND WALL HEIGHT AND/OR TYPES, DELETE LOUVRE
07	MW	06.09.19	CHANGE WALL FROM STW01 TO STW03 (60/60/60)
08	MW	16.10.19	ADD STAIR 04 & AMEND OUTDOOR AREAS. ISSUED FOR S4.55(1A)
09	MW	30.10.19	ADD STAIR 04 & AMEND PAVING. MOVEMECH DOOR AND SC

LEGEND

KEY PLAN

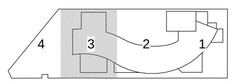

NSW GOVERNMENT Education

STRUCTURE, CIVIL & HYDRAULIC WOOLACOTTS ENGINEERS T: 02 8203 1500	**PERUMAL PEDAVOLI ARCHITECTS** T: 02 9291 0000 WEB: www.pp-a.com.au Nominated Architect: Vince Pedavoli NSW reg No.5045
MECH, ELECT, IT, COMMS & SEC. JHA CONSULTING T: 02 9437 1000	
BCA GROUP DLA T: 02 8355 3160	
LANDSCAPE LORNA HARRISON P/L T: 02 9555 1147	**STATUTORY PLANNER** DON FOX PLANNING P/L T: 02 9473 4914

PERUMAL PEDAVOLI ARCHITECTS

PENSHURST PUBLIC SCHOOL
18 Arcadia Street, Penshurst

DRAWING NAME
FLOOR PLAN - LEVEL 0 - PART 3

CONTRACT NUMBER: SINSW-18-1257
PROJECT NORTH

0 1000 2000 3000 4000 5000 10000
SCALE 1 : 100 @ A1

DRAWN	CHECKED	VERIFIED	DATE
Author	Checker	Approver	12 NOVEMBER 2019

DRAWING NUMBER: 3199-ARC-CD-01_103
REVISION: 09

PROJECT CODE | DISCIPLINE | PHASE | SERIES NUMBER

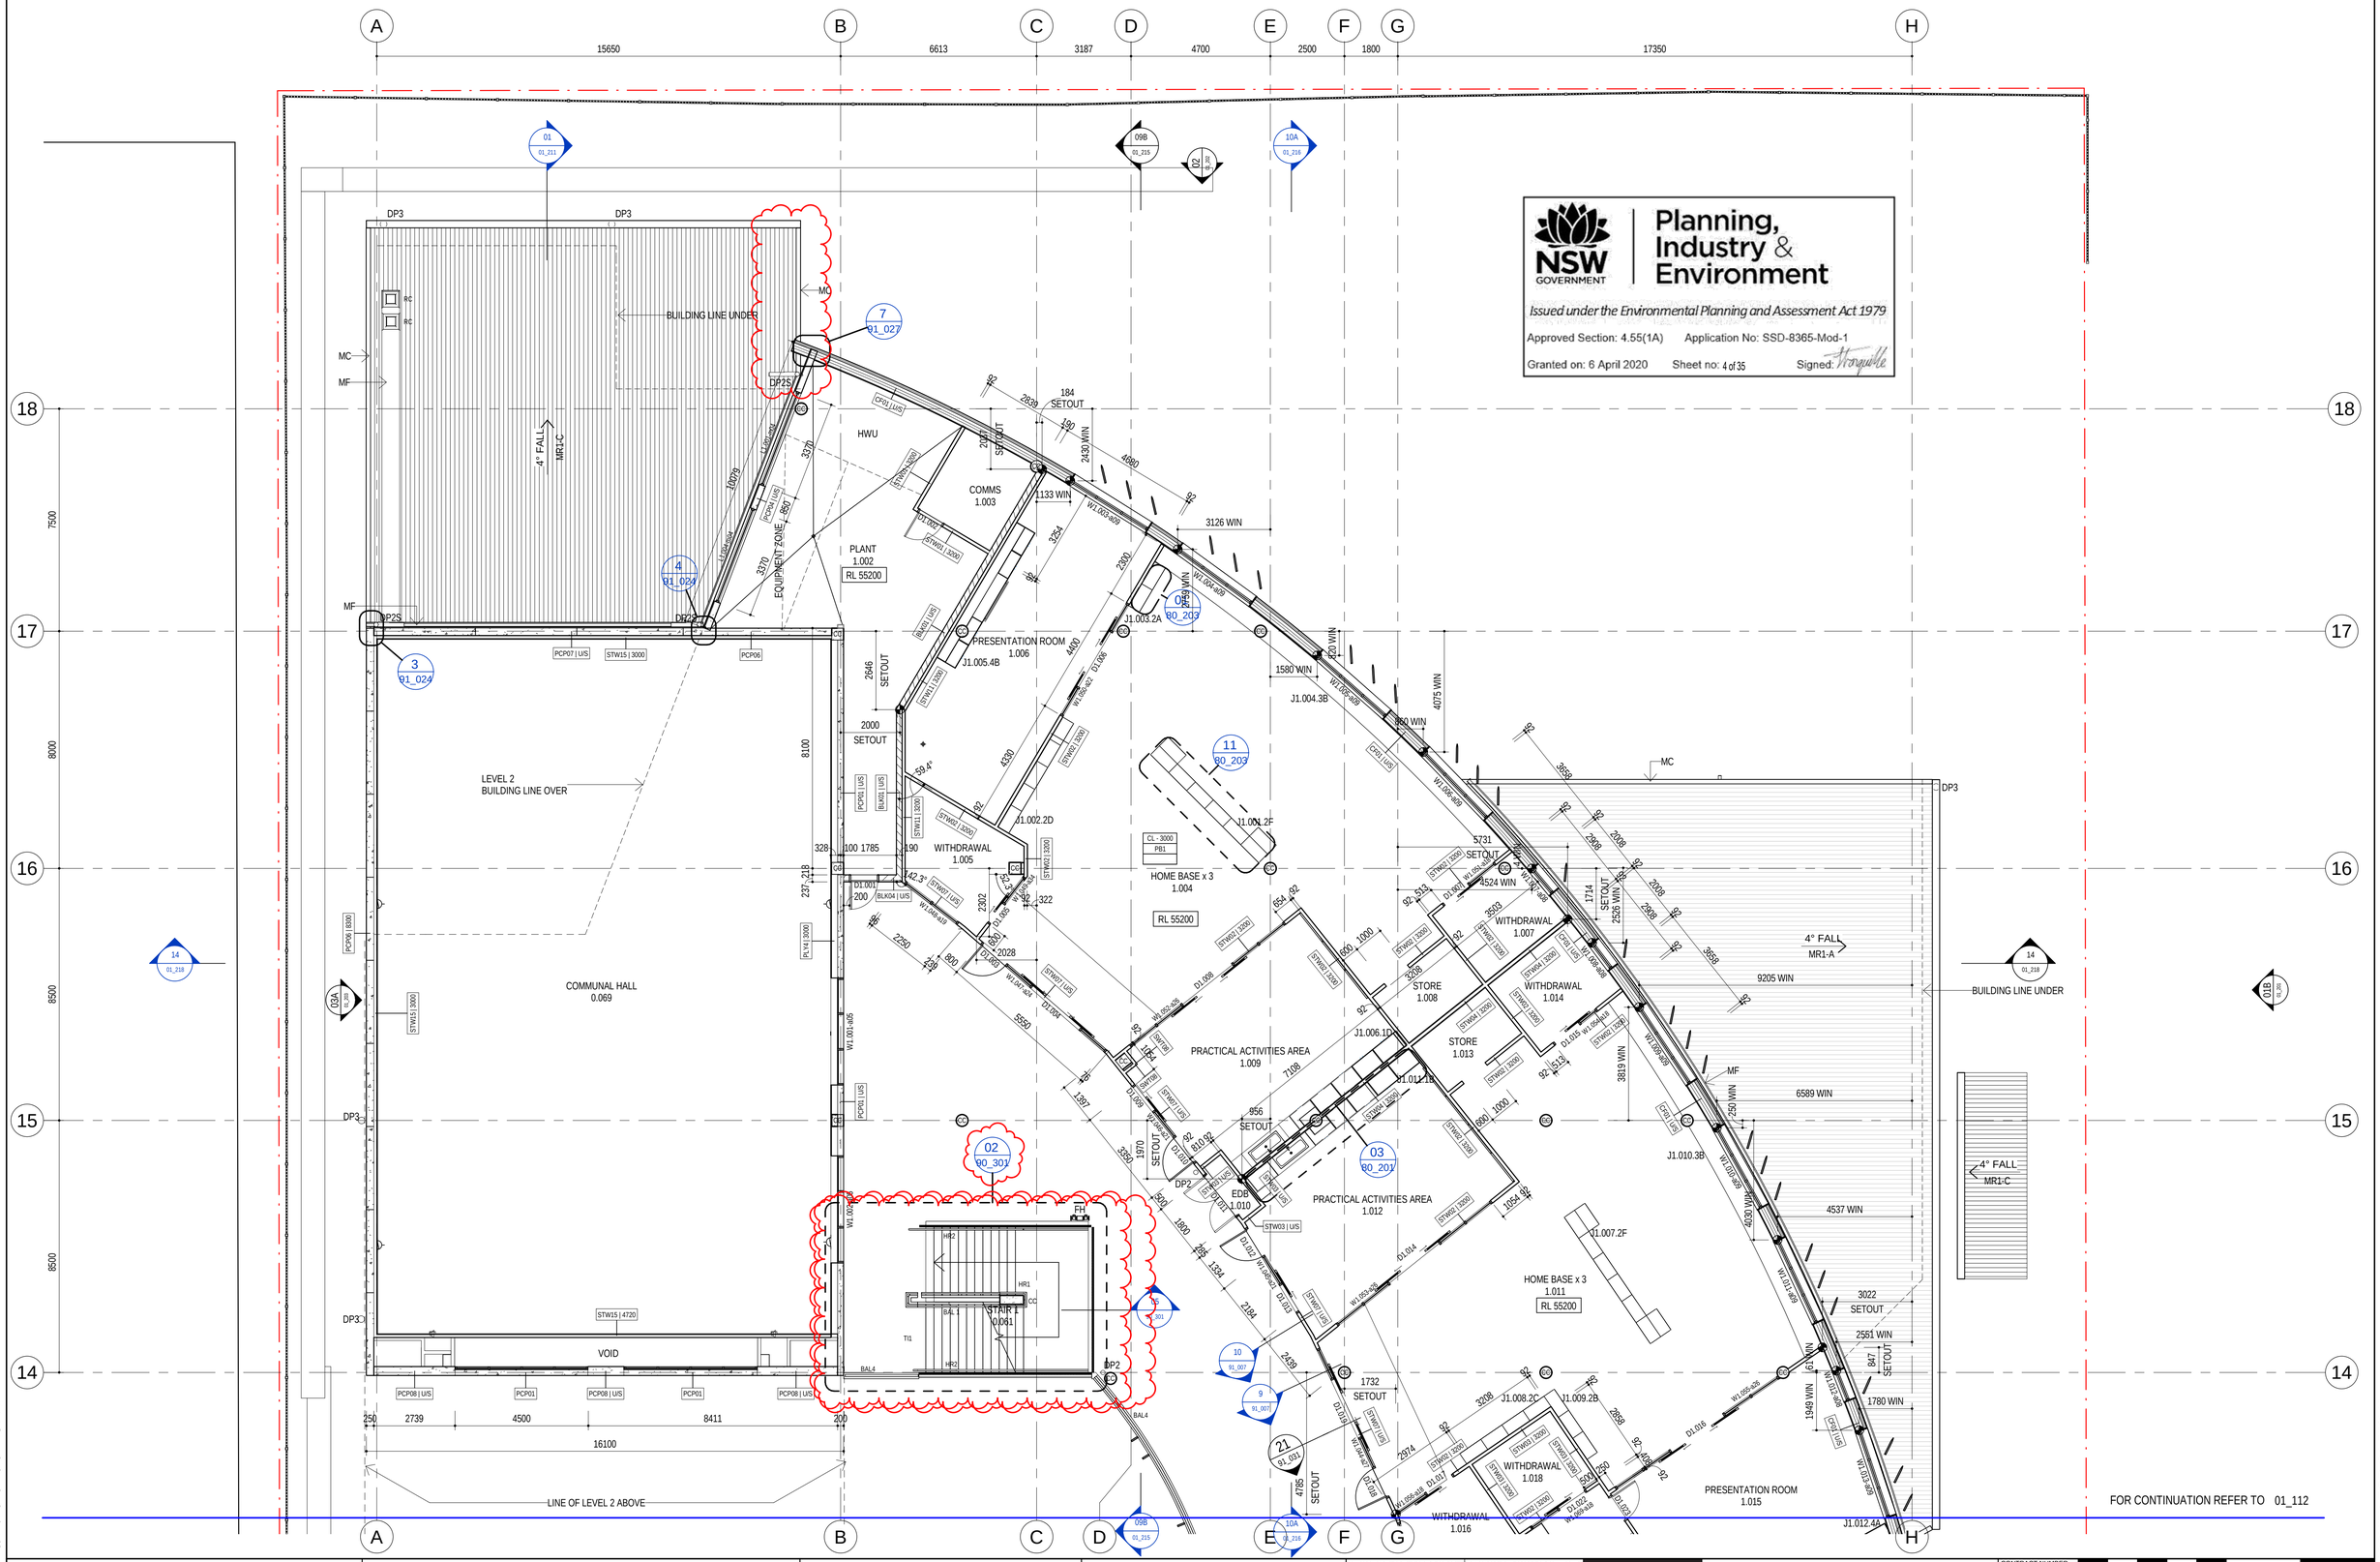

13/11/2019 10:01:48 AM

ISSUED FOR S4.55(1A)

AMENDMENTS

REV	BY	DATE	DESCRIPTION
02	MW/RO	05.06.19	SHOW BIKE ROOF & ADD WALL NIB SIZES
03	MW	01.07.19	ADJUST STAIR TREADS AND LANDINGS, MOVE CC
04	MW	02.08.19	AMEND ROOF CODES TO INCLUDE COLOUR
05	BS	09.08.19	DETAIL UPDATED
06	MW	30.08.19	AMEND WALL HEIGHT AND/OR TYPES, DELETE LOUVRE
07	MW	06.09.19	CHANGE WALL FROM STW01 TO STW03 (60/60/60)
08	MW	16.10.19	AMEND STAIR 01 & ROOF OVER WASTE. ISSUED FOR S4.55(1A)
09	MW	28.10.19	FLIP STAIR 01 - AMEND TREADS, CC, SCREENS & ROOF FALL

LEGEND

KEY PLAN

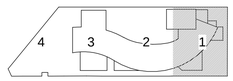

NSW GOVERNMENT Education

STRUCTURE, CIVIL & HYDRAULIC
WOOLACOTTS ENGINEERS
T: 02 8203 1500

MECH, ELECT, IT, COMMS & SEC.
J+A CONSULTING
T: 02 9437 1000

BCA
GROUP DLA
T: 02 8355 3160

LANDSCAPE
LORNA HARRISON P/L
T: 02 9555 1147

PERUMAL PEDAVOLI ARCHITECTS
T: 02 9291 0000
WEB: www.pp-a.com.au
Nominated Architect:
Vince Pedavoli NSW reg No.5045

STATUTORY PLANNER
DON FOX PLANNING P/L
T: 02 9473 4914

PERUMAL PEDAVOLI ARCHITECTS

PENSHURST PUBLIC SCHOOL
18 Arcadia Street, Penshurst

DRAWING NAME
FLOOR PLAN - LEVEL 1 - PART 1

CONTRACT NUMBER
SINSW-18-1257

PROJECT NORTH

0 1000 2000 3000 4000 5000 10000
SCALE 1 : 100 @ A1

DRAWN	CHECKED	VERIFIED	DATE
Author	Checker	Approver	12 NOVEMBER 2019

DRAWING NUMBER: 3199-ARC-CD-01_111
REVISION: 09

PROJECT CODE | DISCIPLINE | PHASE | SERIES NUMBER

FOR CONTINUATION REFER TO 01_112


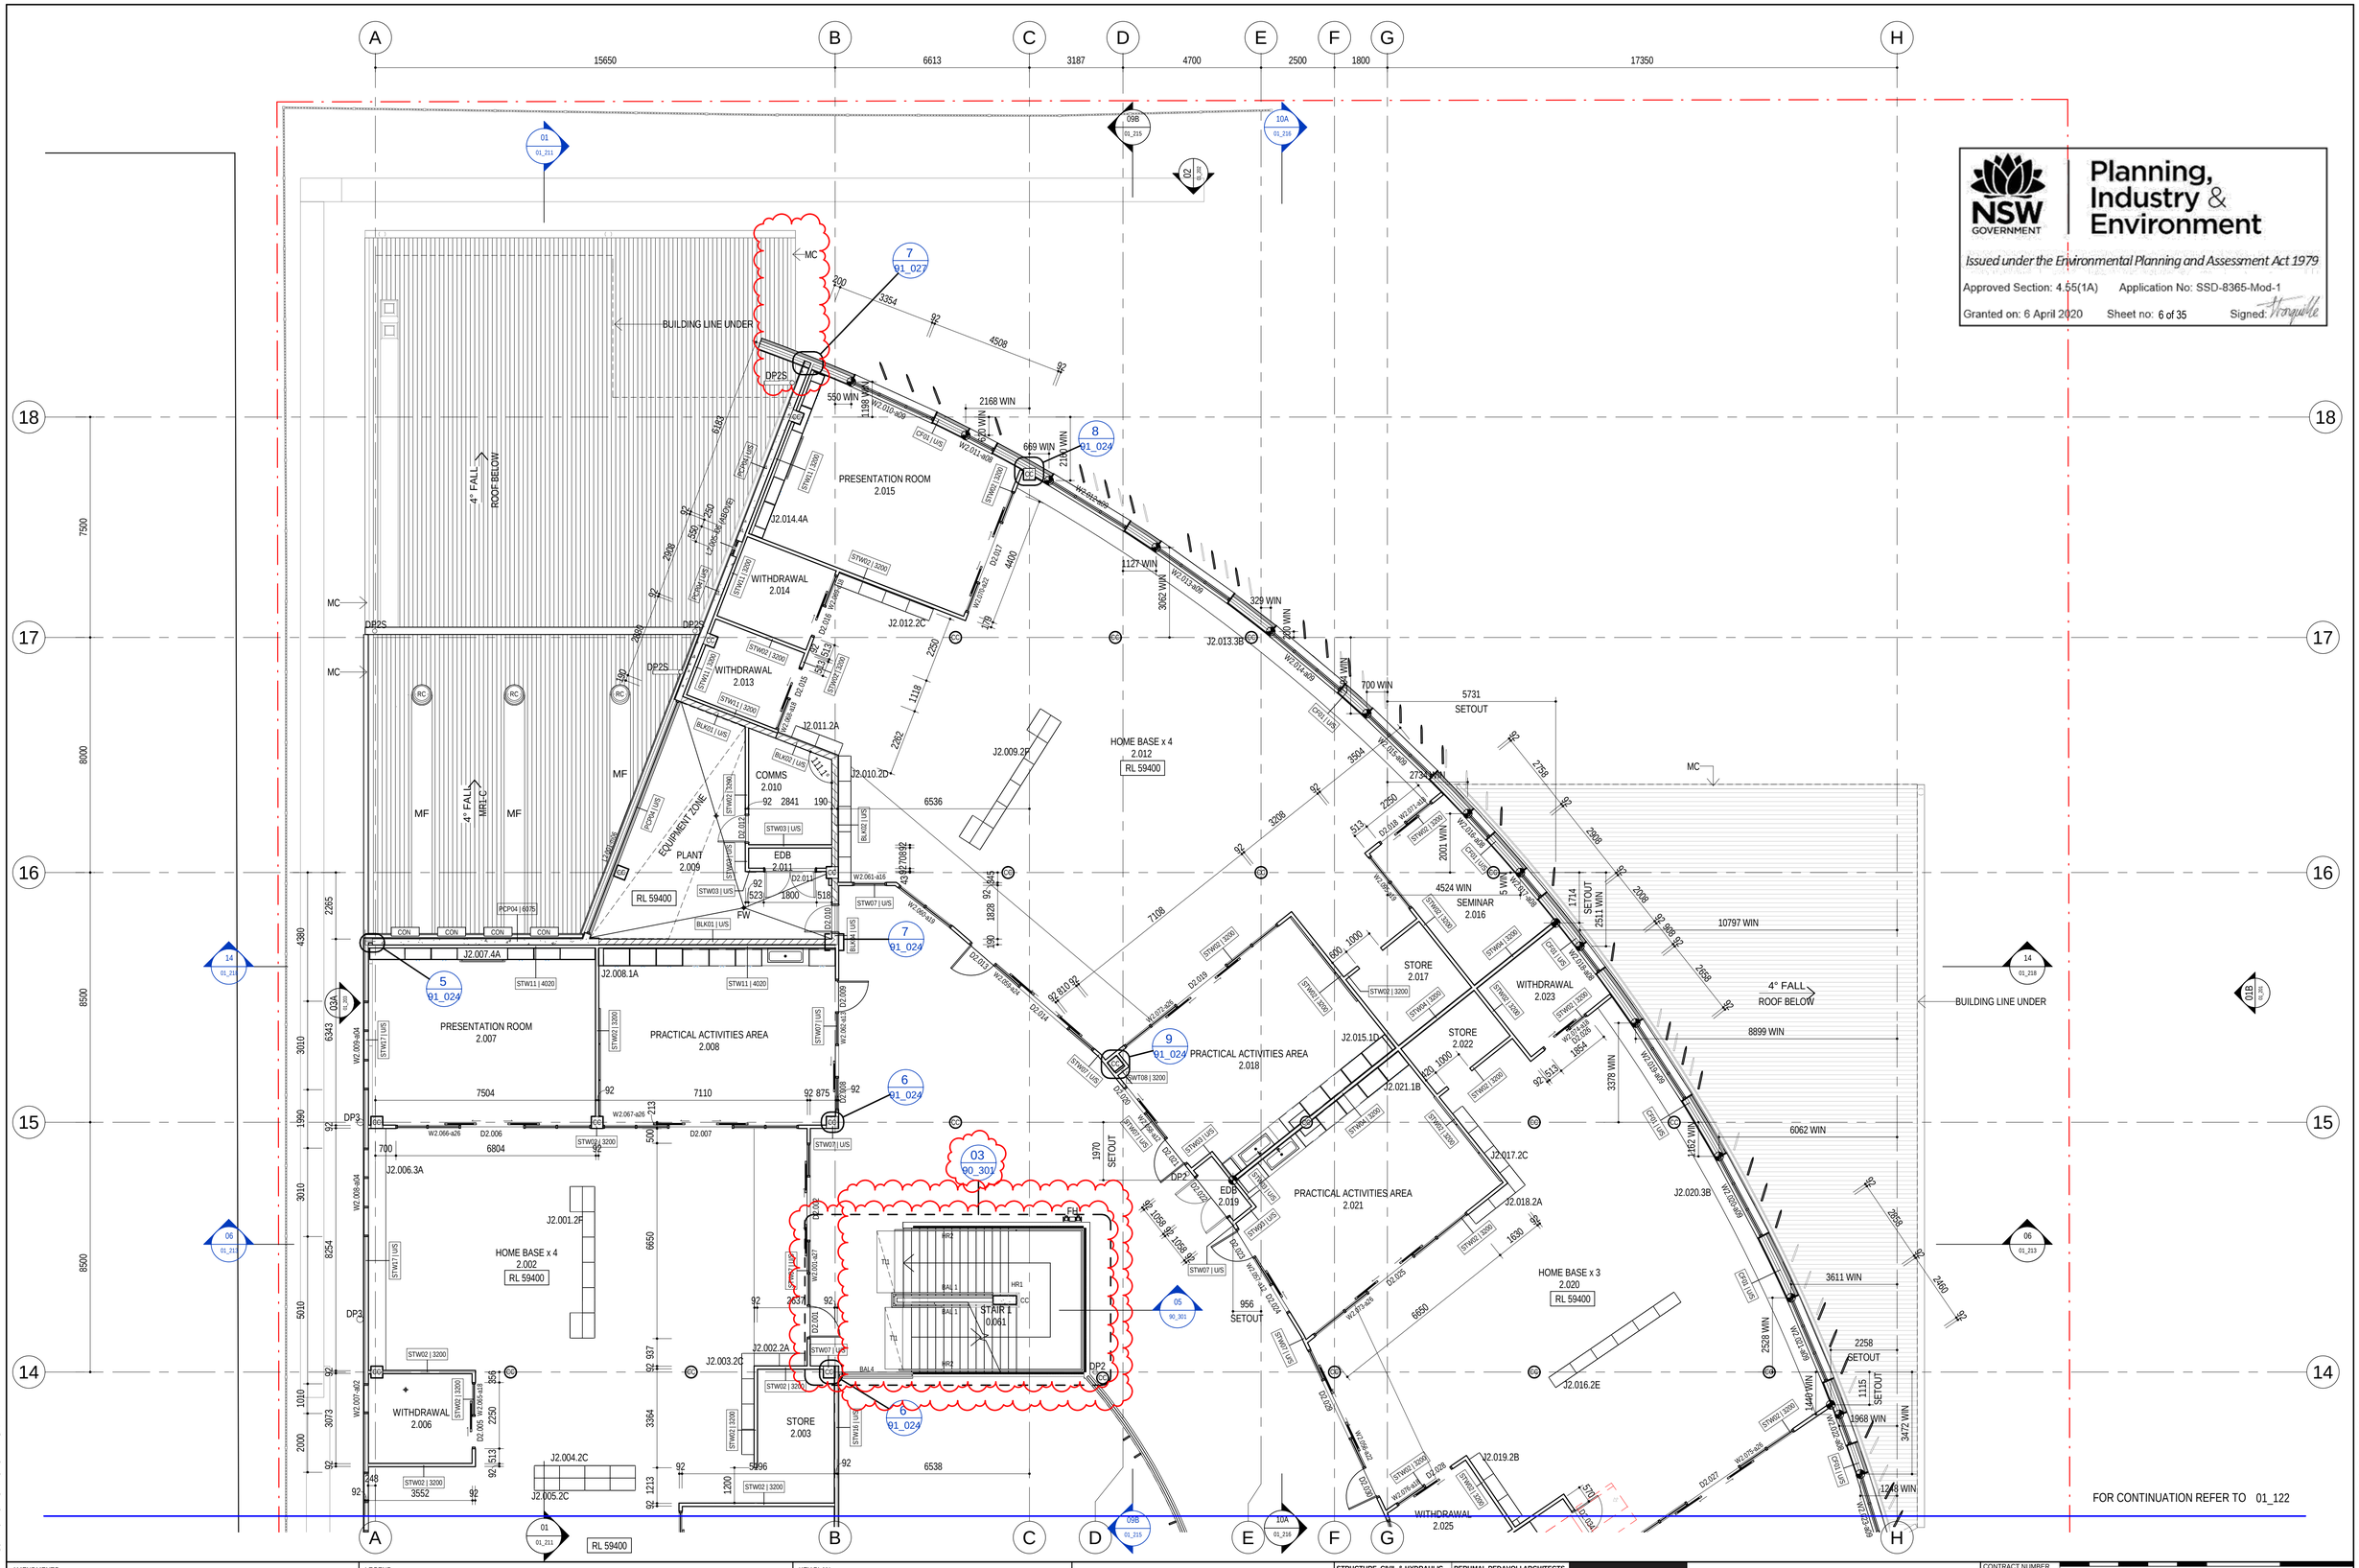

NSW GOVERNMENT
Planning, Industry & Environment
Issued under the Environmental Planning and Assessment Act 1979
Approved Section: 4.55(1A) Application No: SSD-8365-Mod-1
Granted on: 6 April 2020 Sheet no: 6 of 35 Signed:

13/11/2019 10:02:45 AM

ISSUED FOR S4.55(1A)

AMENDMENTS

REV	BY	DATE	DESCRIPTION
03	MW	01.07.19	ADJUST STAIR TREADS AND LANDINGS, MOVE CC
04	MW/BS	02.08.19	AMEND ROOF CODES TO INCLUDE COLOUR. LOUVRE LOCATION AMENDED
05	BS	09.08.19	DETAIL UPDATED
06	MW	30.08.19	AMEND WALL HEIGHT AND/OR TYPES
07	MW	06.09.19	CHANGE WALL FROM STW01 TO STW03 (60/60/60)
08	MW	16.10.19	AMEND STAIR 01 & ROOF OVER WASTE. ISSUED FOR S4.55(1A)
09	MW	28.10.19	FLIP STAIR 01 - AMEND TREADS, CC, SCREENS & ROOF FALL

LEGEND

KEY PLAN

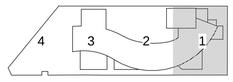

NSW GOVERNMENT Education

STRUCTURE, CIVIL & HYDRAULIC
WOOLACOTTS ENGINEERS
T: 02 8203 1500

MECH, ELECT, IT, COMMS & SEC.
JHA CONSULTING
T: 02 9437 1000

BCA
GROUP DLA
T: 02 8355 3160

LANDSCAPE
LORNA HARRISON P/L
T: 02 9555 1147

PERUMAL PEDAVOLI ARCHITECTS
T: 02 9291 0000
WEB: www.pp-a.com.au
Nominated Architect
Vince Pedavoli NSW reg No.5045

STATUTORY PLANNER
DON FOX PLANNING P/L
T: 02 9473 4914

PERUMAL PEDAVOLI ARCHITECTS

PENSHURST PUBLIC SCHOOL
18 Arcadia Street, Penshurst

DRAWING NAME
FLOOR PLAN - LEVEL 2 - PART 1

CONTRACT NUMBER: SINSW-18-1257

PROJECT NORTH

0 1000 2000 3000 4000 5000 10000
SCALE 1 : 100 @ A1

DRAWN	CHECKED	VERIFIED	DATE
Author	Checker	Approver	12 NOVEMBER 2019

DRAWING NUMBER: 3199-ARC-CD-01_121
REVISION: 09

PROJECT CODE | DISCIPLINE | PHASE | SERIES NUMBER

FOR CONTINUATION REFER TO 01_122

ROOF BELOW

RL 59400



















4° FALL ROOF BELOW

MC

SETOUT

EDB 2.049

FH

DP2

PCP05 | UIS

EX1B

BAL4

BAL3

HR1

HR2

15650 6613 3187 4700 2500 1800 17350

8850 7400 6400 7400 5500

NSW GOVERNMENT | Planning, Industry & Environment

Issued under the Environmental Planning and Assessment Act 1979

Approved Section: 4.55(1A) Application No: SSD-8365-Mod-1

Granted on: 6 April 2020 Sheet no: 7 of 35 Signed:

13/11/2019 10:03:10 AM

ISSUED FOR S4.55(1A)

AMENDMENTS

REV	BY	DATE	DESCRIPTION
E	MW	18.04.19	GATEWAY 4 REVIEW
01	RO	17.05.19	ISSUE FOR CONSTRUCTION
02	RO	05.06.19	WINDOW WIDTH REDUCED
03	MW	01.07.19	MOVE CC, AMEND WINDOW TYPE
04	MW	30.08.19	AMEND WALL HEIGHT AND/OR TYPES
05	MW	06.09.19	CHANGE WALL FROM STW01 TO STW03 (60/60/60)
06	MW	16.10.19	ADD STAIR 04 & AMEND HOMEBASE. ISSUED FOR S4.55(1A)
07	MW	29.10.19	ADD STAIR 04 & AMEND ADJOINING BUILDING

LEGEND

KEY PLAN

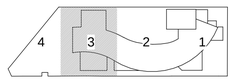

NSW GOVERNMENT Education

STRUCTURE, CIVIL & HYDRAULIC WOOLACOTTS ENGINEERS T: 02 8203 1500

MECH, ELECT, IT, COMMS & SEC. JHA CONSULTING T: 02 9437 1000

BCA GROUP DLA T: 02 8355 3160

LANDSCAPE LORNA HARRISON P/L T: 02 9555 1147

PERUMAL PEDAVOLI ARCHITECTS T: 02 9291 0000 WEB: www.pp-a.com.au Nominated Architect: Vince Pedavoli NSW reg No.5045

STATUTORY PLANNER DON FOX PLANNING P/L T: 02 9473 4914

PERUMAL PEDAVOLI ARCHITECTS

PENSHURST PUBLIC SCHOOL

18 Arcadia Street, Penshurst

DRAWING NAME: FLOOR PLAN - LEVEL 2 - PART 3

CONTRACT NUMBER: SINSW-18-1257

PROJECT NORTH

SCALE 1 : 100 @ A1

DRAWN	CHECKED	VERIFIED	DATE
Author	Checker	Approver	12 NOVEMBER 2019

DRAWING NUMBER | REVISION

PROJECT CODE | DISCIPLINE | PHASE | SERIES NUMBER: 3199-ARC-CD-01_123 | 07

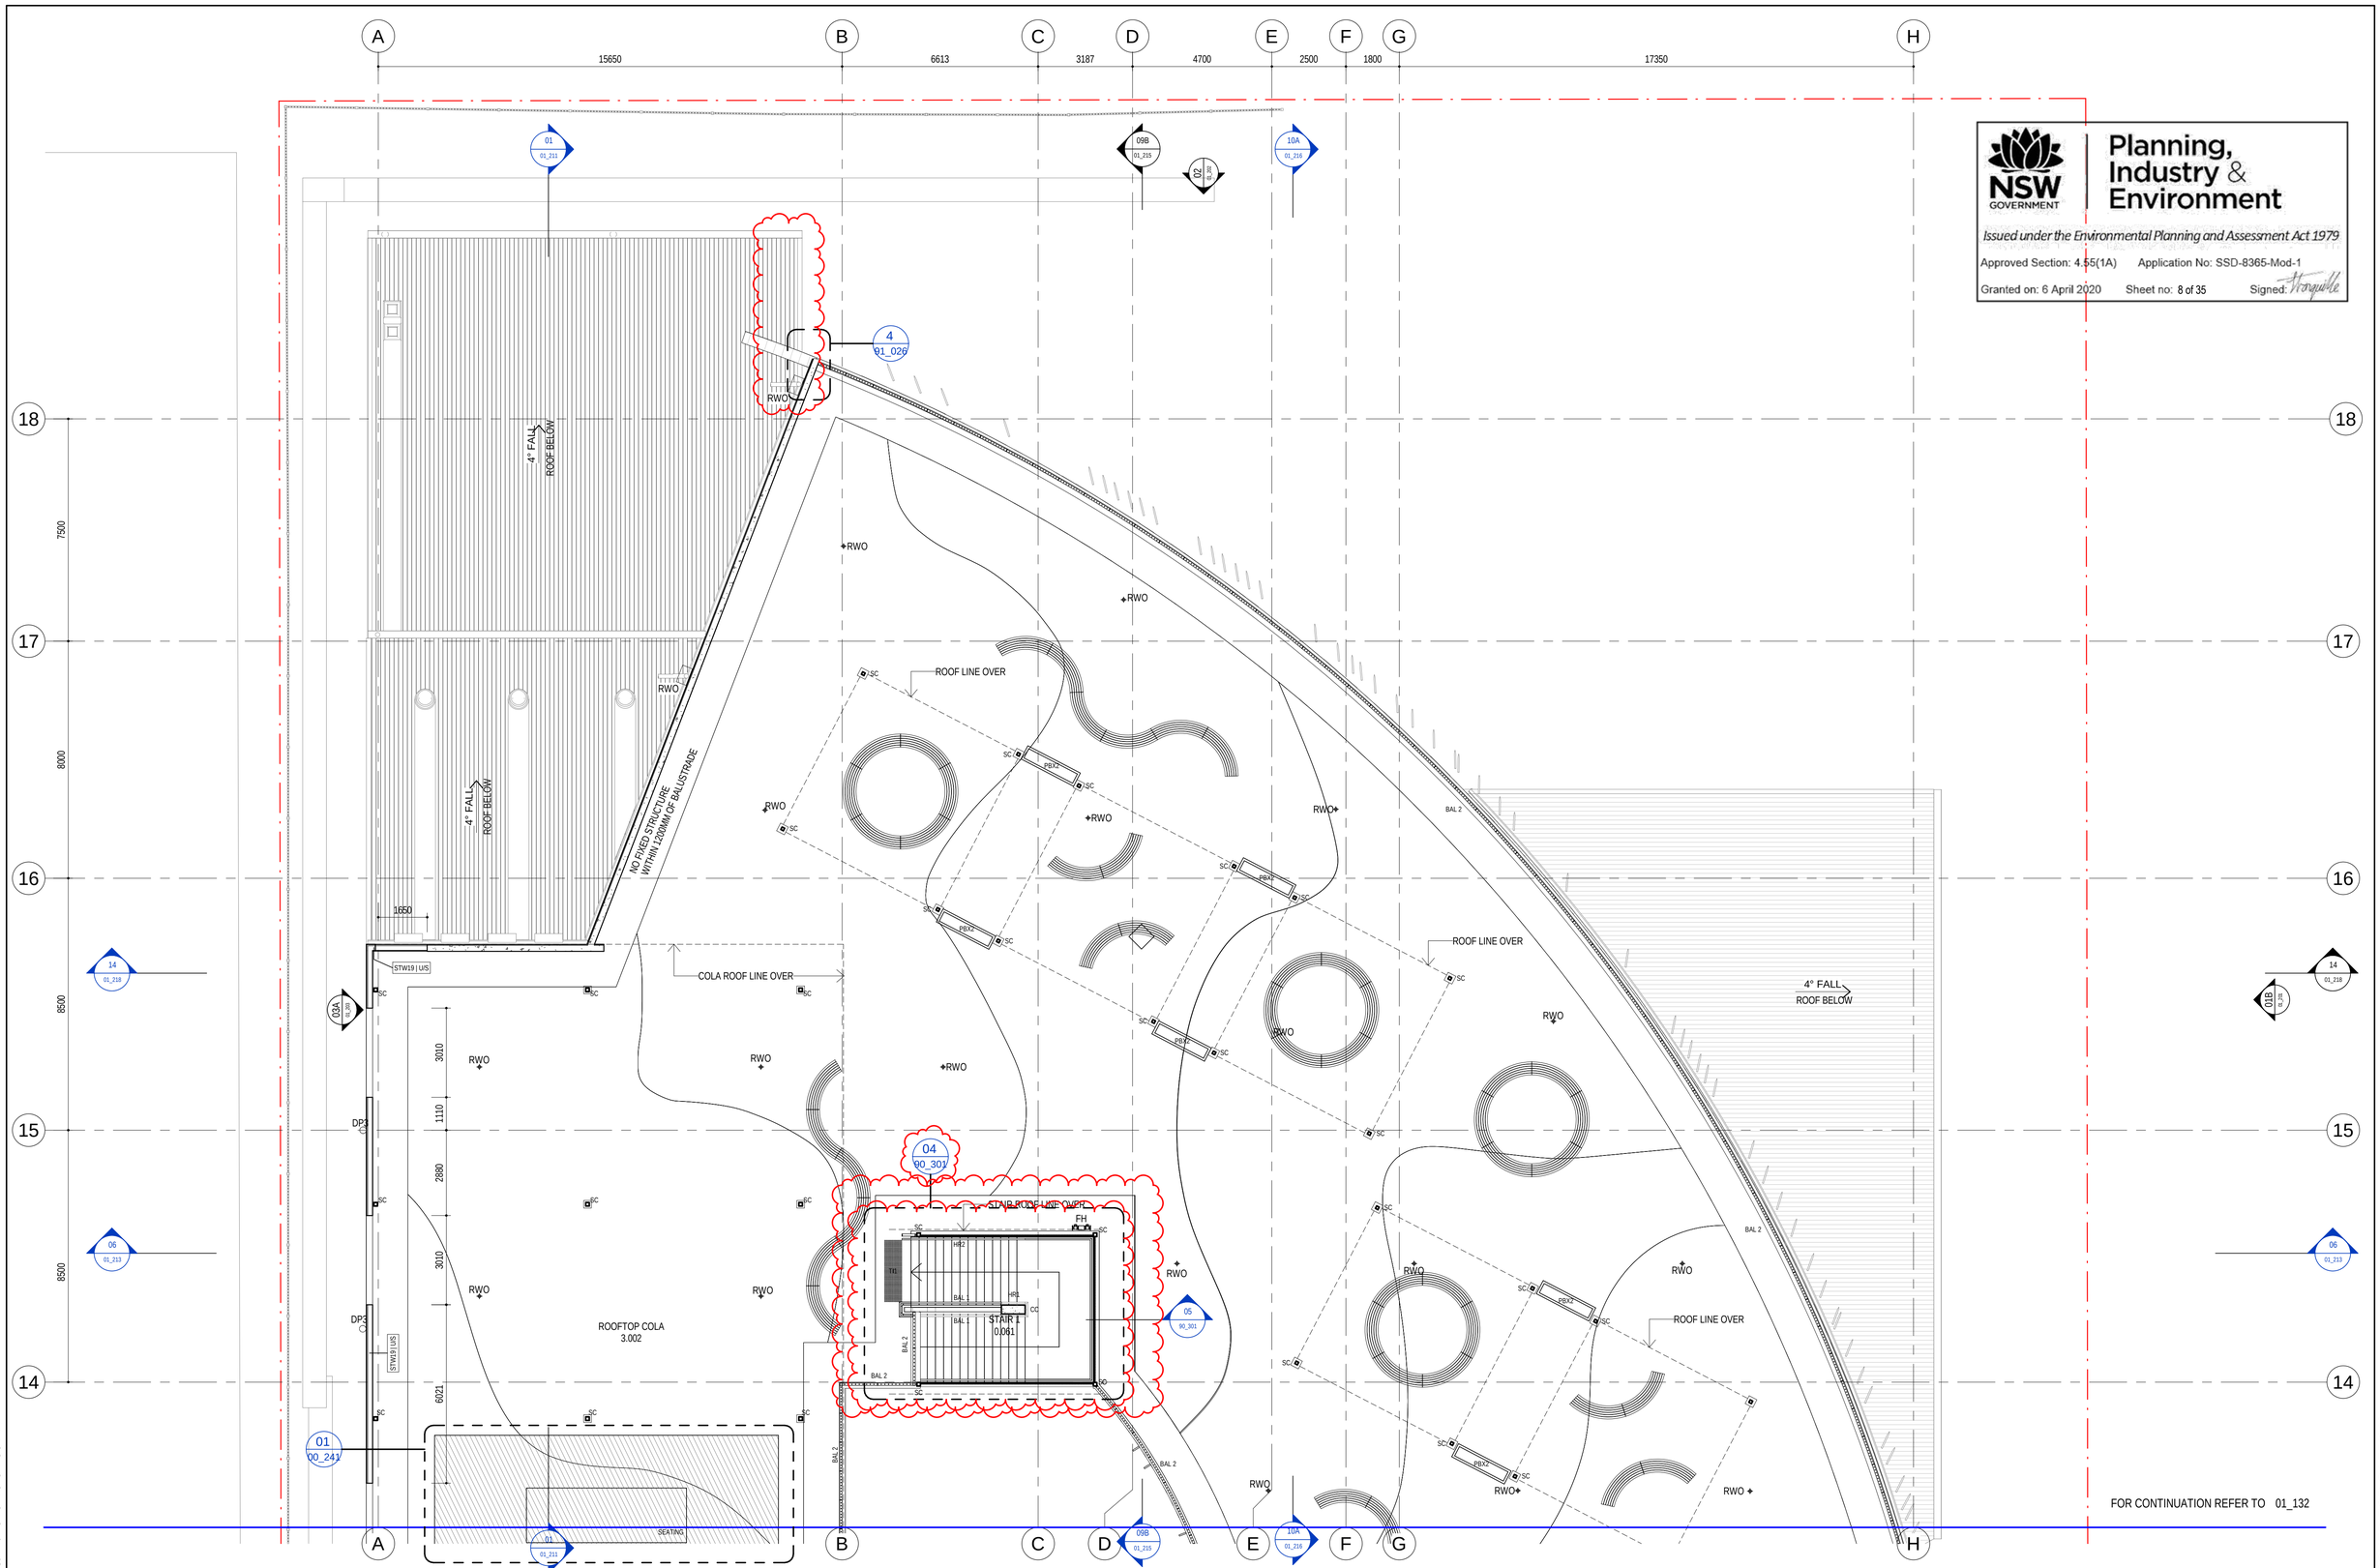

Planning, Industry & Environment

Issued under the Environmental Planning and Assessment Act 1979

Approved Section: 4.55(1A) Application No: SSD-8365-Mod-1

Granted on: 6 April 2020 Sheet no: 8 of 35 Signed:

FOR CONTINUATION REFER TO 01_132

13/11/2019 10:04:09 AM

ISSUED FOR S4.55(1A)

AMENDMENTS

REV	BY	DATE	DESCRIPTION
B	AC	08.03.19	ADDED TACTILE TILES
C	MW	08.04.19	GENERAL UPDATE. ISSUED FOR REVIEW
D	MW	18.04.19	GATEWAY 4 REVIEW
01	RO	17.05.19	ISSUE FOR CONSTRUCTION
02	MW	01.07.19	ADD / AMEND NOTES & DIMENSIONS
03	AC	19.07.19	AMENDED WALL TYPE
04	MW	16.10.19	AMEND STAIR 01 & ROOF OVER WASTE. ISSUED FOR S4.55(1A)
05	MW	28.10.19	FLIP STAIR 01 - AMEND TREADS, CC, SCREENS & ROOF FALL

LEGEND

KEY PLAN

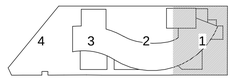

NSW GOVERNMENT Education

STRUCTURE, CIVIL & HYDRAULIC
WOOLACOTTS ENGINEERS
T: 02 8203 1500

MECH, ELECT, IT, COMMS & SEC.
JHA CONSULTING
T: 02 9437 1000

BCA
GROUP DLA
T: 02 8355 3160

LANDSCAPE
LORNA HARRISON P/L
T: 02 9555 1147

PERUMAL PEDAVOLI ARCHITECTS
T: 02 9291 0000
WEB: www.pp-a.com.au
Nominated Architect:
Vince Pedavoli NSW reg No.5045

STATUTORY PLANNER
DON FOX PLANNING P/L
T: 02 9473 4914

PERUMAL PEDAVOLI ARCHITECTS

PENSHURST PUBLIC SCHOOL
18 Arcadia Street, Penshurst

DRAWING NAME
FLOOR PLAN - LEVEL 3 - PART 1

CONTRACT NUMBER
SINSW-18-1257

PROJECT NORTH

0 1000 2000 3000 4000 5000 10000
SCALE 1 : 100 @ A1

DRAWN	CHECKED	VERIFIED	DATE
Author	Checker	Approver	12 NOVEMBER 2019

DRAWING NUMBER: 3199-ARC-CD-01_131

REVISION: 05

PROJECT CODE | DISCIPLINE | PHASE | SERIES NUMBER

FOR CONTINUATION REFER TO 01_132

ROOF LINE OVER

DP2

STAIR 3
0.060

STAIR 4
0.105

OUTDOOR LEARNING &
VEGETABLE GARDEN BELOW

4° FALL
ROOF BELOW

R 6000

NO FIXED STRUCTURE WITHIN
1200MM OF BALUSTRADE

RWO

BAL 2

8850
7400
6400
7400
5500

15650
6613
3187
4700
2500
1800
17350

Planning, Industry & Environment

Issued under the Environmental Planning and Assessment Act 1979

Approved Section: 4.55(1A) Application No: SSD-8365-Mod-1

Granted on: 6 April 2020 Sheet no: 9 of 35 Signed:

13/11/2019 10:04:57 AM

ISSUED FOR S4.55(1A)

AMENDMENTS

REV	BY	DATE	DESCRIPTION
B	AC	08.03.19	ADDED TACTILE TILES
C	MW	08.04.19	GENERAL UPDATE. ISSUED FOR REVIEW
D	CW/AC	18.04.19	STEEL FRAMES AMENDED, WALL MOUNTED LIGHTS ADDED, CROSS REF ADDED. GATEWAY 4 REVIEW
01	RO	17.05.19	ISSUE FOR CONSTRUCTION
02	MW	01.07.19	ADD / AMEND NOTES & DIMENSIONS
03	MW	16.10.19	ADD STAIR 04 & AMEND OUTDOOR AREAS. ISSUED FOR S4.55(1A)
04	MW	29.10.19	ADD STAIR 04 & AMEND ADJOINING BUILDING

LEGEND

KEY PLAN

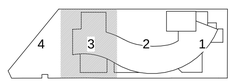

NSW GOVERNMENT Education

STRUCTURE, CIVIL & HYDRAULIC
WOOLACOTTS ENGINEERS
T: 02 8203 1500

MECH, ELECT, IT, COMMS & SEC.
JHA CONSULTING
T: 02 9437 1000

BCA
GROUP DLA
T: 02 8355 3160

LANDSCAPE
LORNA HARRISON P/L
T: 02 9555 1147

PERUMAL PEDAVOLI ARCHITECTS
T: 02 9291 0000
WEB: www.pp-a.com.au
Nominated Architect:
Vince Pedavoli NSW reg No.5045

STATUTORY PLANNER
DON FOX PLANNING P/L
T: 02 9473 4914

PERUMAL PEDAVOLI ARCHITECTS

PENSHURST PUBLIC SCHOOL
18 Arcadia Street, Penshurst

DRAWING NAME
FLOOR PLAN - LEVEL 3 - PART 3

CONTRACT NUMBER SINSW-18-1257

PROJECT NORTH

0 1000 2000 3000 4000 5000 10000
SCALE 1 : 100 @ A1

DRAWN	CHECKED	VERIFIED	DATE
Author	Checker	Approver	12 NOVEMBER 2019

DRAWING NUMBER REVISION

PROJECT CODE	DISCIPLINE	PHASE	SERIES NUMBER	
3199-ARC-CD-01_133				04

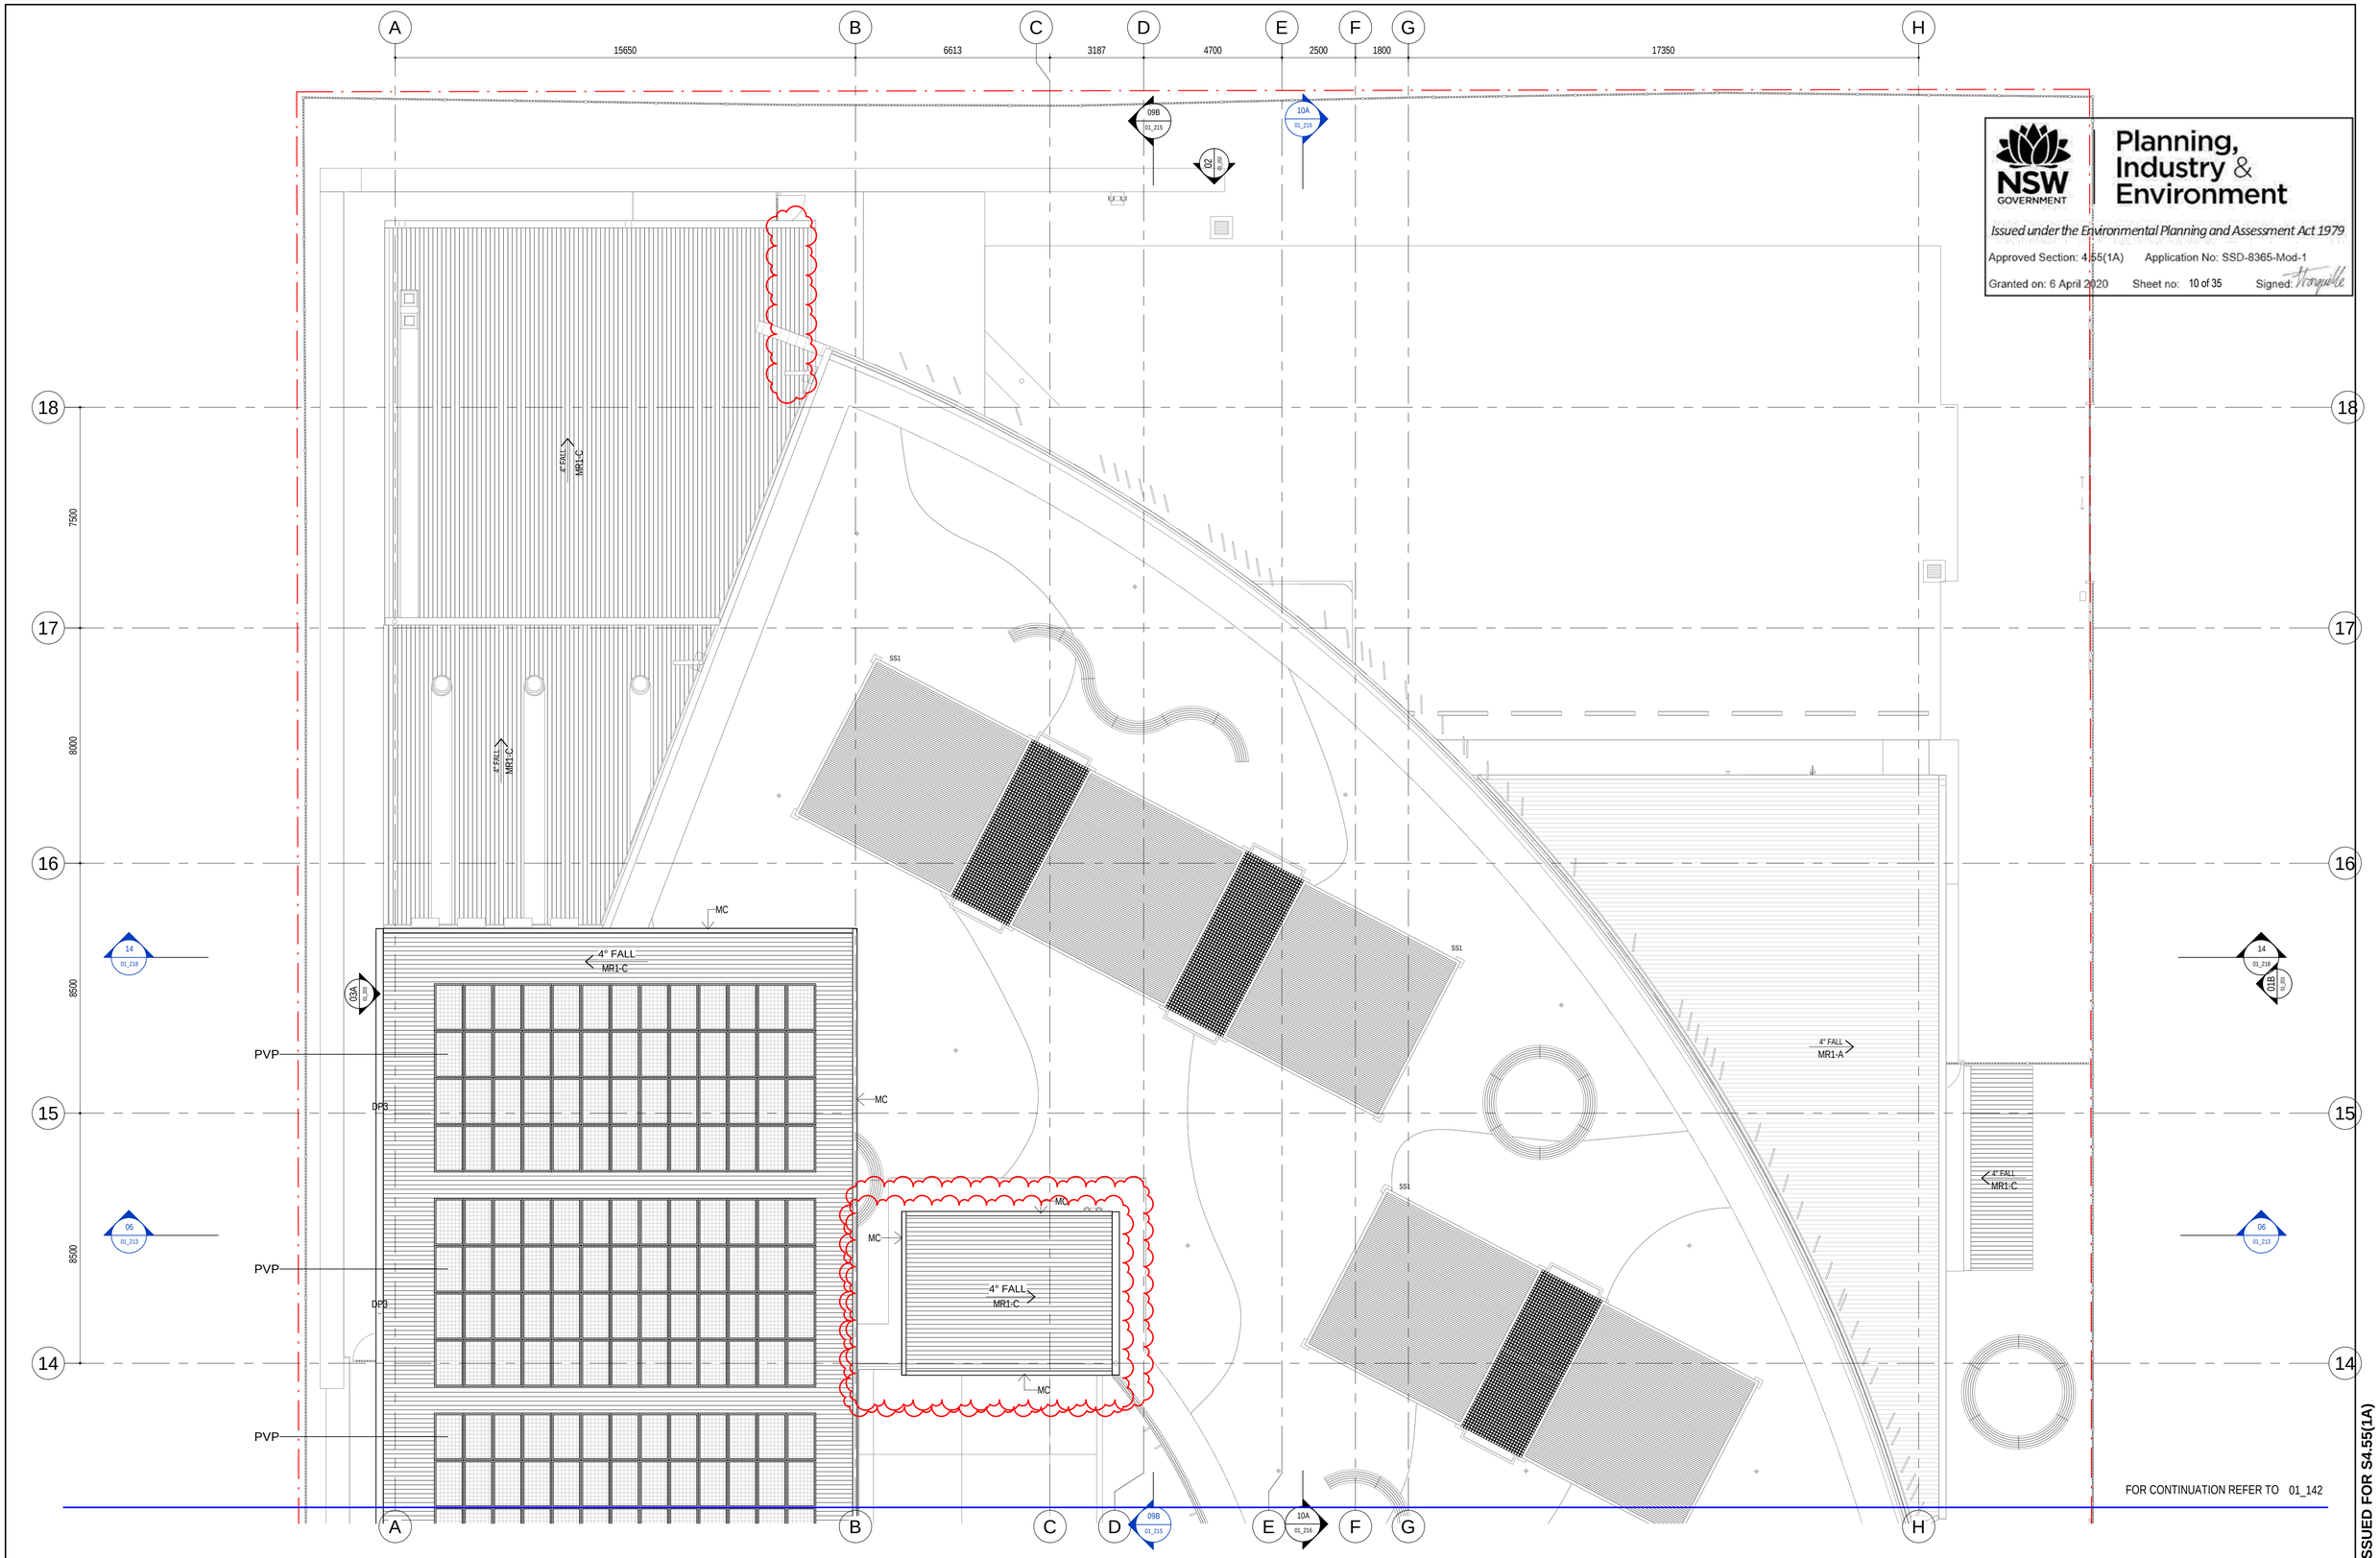

NSW GOVERNMENT Planning, Industry & Environment

Issued under the Environmental Planning and Assessment Act 1979

Approved Section: 4.55(1A) Application No: SSD-8365-Mod-1

Granted on: 6 April 2020 Sheet no: 10 of 35 Signed:

13/11/2019 10:13:15 AM

ISSUED FOR S4.55(1A)

AMENDMENTS

REV	BY	DATE	DESCRIPTION
A	MW	31.08.18	ISSUED FOR TENDER
B	AC	08.03.19	ADDED TRELLIS
C	AC	08.04.19	ADDED METAL CAPPING / METAL FLASHING. ISSUED FOR REVIEW
D	MW	18.04.19	GATEWAY 4 REVIEW
01	RO	17.05.19	ISSUE FOR CONSTRUCTION
02	MW	02.08.19	AMEND ROOF CODES TO INCLUDE COLOUR
03	MW	16.10.19	AMEND STAIR 01 & ROOF OVER WASTE. ISSUED FOR S4.55(1A)
04	MW	28.10.19	FLIP STAIR 01 - AMEND TREADS, CC, SCREENS & ROOF FALL

LEGEND

KEY PLAN

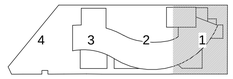

NSW GOVERNMENT Education

STRUCTURE, CIVIL & HYDRAULIC
WOOLACOTTS ENGINEERS
T: 02 8203 1500

MECH, ELECT, IT, COMMS & SEC.
JHA CONSULTING
T: 02 9437 1000

BCA
GROUP DLA
T: 02 8355 3160

LANDSCAPE
LORNA HARRISON P/L
T: 02 9555 1147

PERUMAL PEDAVOLI ARCHITECTS
T: 02 9291 0000
WEB: www.pp-a.com.au
Nominated Architect:
Vince Pedavoli NSW reg No.5045

STATUTORY PLANNER
DON FOX PLANNING P/L
T: 02 9473 4914

PERUMAL PEDAVOLI ARCHITECTS

PENSHURST PUBLIC SCHOOL

18 Arcadia Street, Penshurst

DRAWING NAME

ROOF PLAN - PART 1

CONTRACT NUMBER SINSW-18-1257

PROJECT NORTH

0 1000 2000 3000 4000 5000 10000

SCALE 1 : 100 @ A1

DRAWN	CHECKED	VERIFIED	DATE
Author	Checker	Approver	12 NOVEMBER 2019

DRAWING NUMBER REVISION

PROJECT CODE	DISCIPLINE	PHASE	SERIES NUMBER	
3199	ARC	CD	01_141	04

FOR CONTINUATION REFER TO 01_142

DP2
MC
4° FALL
MR1-C
SS1
4° FALL
MR1-A

15650 | 6613 | 3187 | 4700 | 2500 | 1800 | 17350

8850 | 7400 | 6400 | 7400 | 5500

Planning, Industry & Environment
NSW GOVERNMENT
Issued under the Environmental Planning and Assessment Act 1979
Approved Section: 4.55(1A) Application No: SSD-8365-Mod-1
Granted on: 6 April 2020 Sheet no: 11 of 35 Signed:

13/11/2019 10:14:00 AM

ISSUED FOR S4.55(1A)

AMENDMENTS

REV	BY	DATE	DESCRIPTION
A	MW	31.08.18	ISSUED FOR TENDER
B	AC	08.03.19	ADDED TRELLIS
C	AC	08.04.19	ADDED METAL CAPPING / METAL FLASHING. ISSUED FOR REVIEW
D	MW	18.04.19	GATEWAY 4 REVIEW
01	RO	17.05.19	ISSUE FOR CONSTRUCTION
02	MW	02.08.19	AMEND ROOF CODES TO INCLUDE COLOUR
03	MW	16.10.19	ADD STAIR 04 & AMEND HOMEBASE. ISSUED FOR S4.55(1A)
04	MW	29.10.19	ADD STAIR 04 & AMEND ADJOINING BUILDING

LEGEND

KEY PLAN

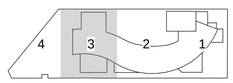

NSW GOVERNMENT Education

STRUCTURE, CIVIL & HYDRAULIC
WOOLACOTTS ENGINEERS
T: 02 8203 1500

MECH, ELECT, IT, COMMS & SEC.
JHA CONSULTING
T: 02 9437 1000

BCA
GROUP DLA
T: 02 8355 3160

LANDSCAPE
LORNA HARRISON P/L
T: 02 9555 1147

PERUMAL PEDAVOLI ARCHITECTS
T: 02 9291 0000
WEB: www.pp-a.com.au
Nominated Architect:
Vince Pedavoli NSW reg No.5045

STATUTORY PLANNER
DON FOX PLANNING P/L
T: 02 9473 4914

PERUMAL PEDAVOLI ARCHITECTS

PENSHURST PUBLIC SCHOOL
18 Arcadia Street, Penshurst

DRAWING NAME
ROOF PLAN - PART 3

CONTRACT NUMBER SINSW-18-1257

PROJECT NORTH

0 1000 2000 3000 4000 5000 10000
SCALE 1 : 100 @ A1

DRAWN	CHECKED	VERIFIED	DATE
Author	Checker	Approver	12 NOVEMBER 2019

DRAWING NUMBER | REVISION

PROJECT CODE | DISCIPLINE | PHASE | SERIES NUMBER
3199-ARC-CD-01_143 | 04

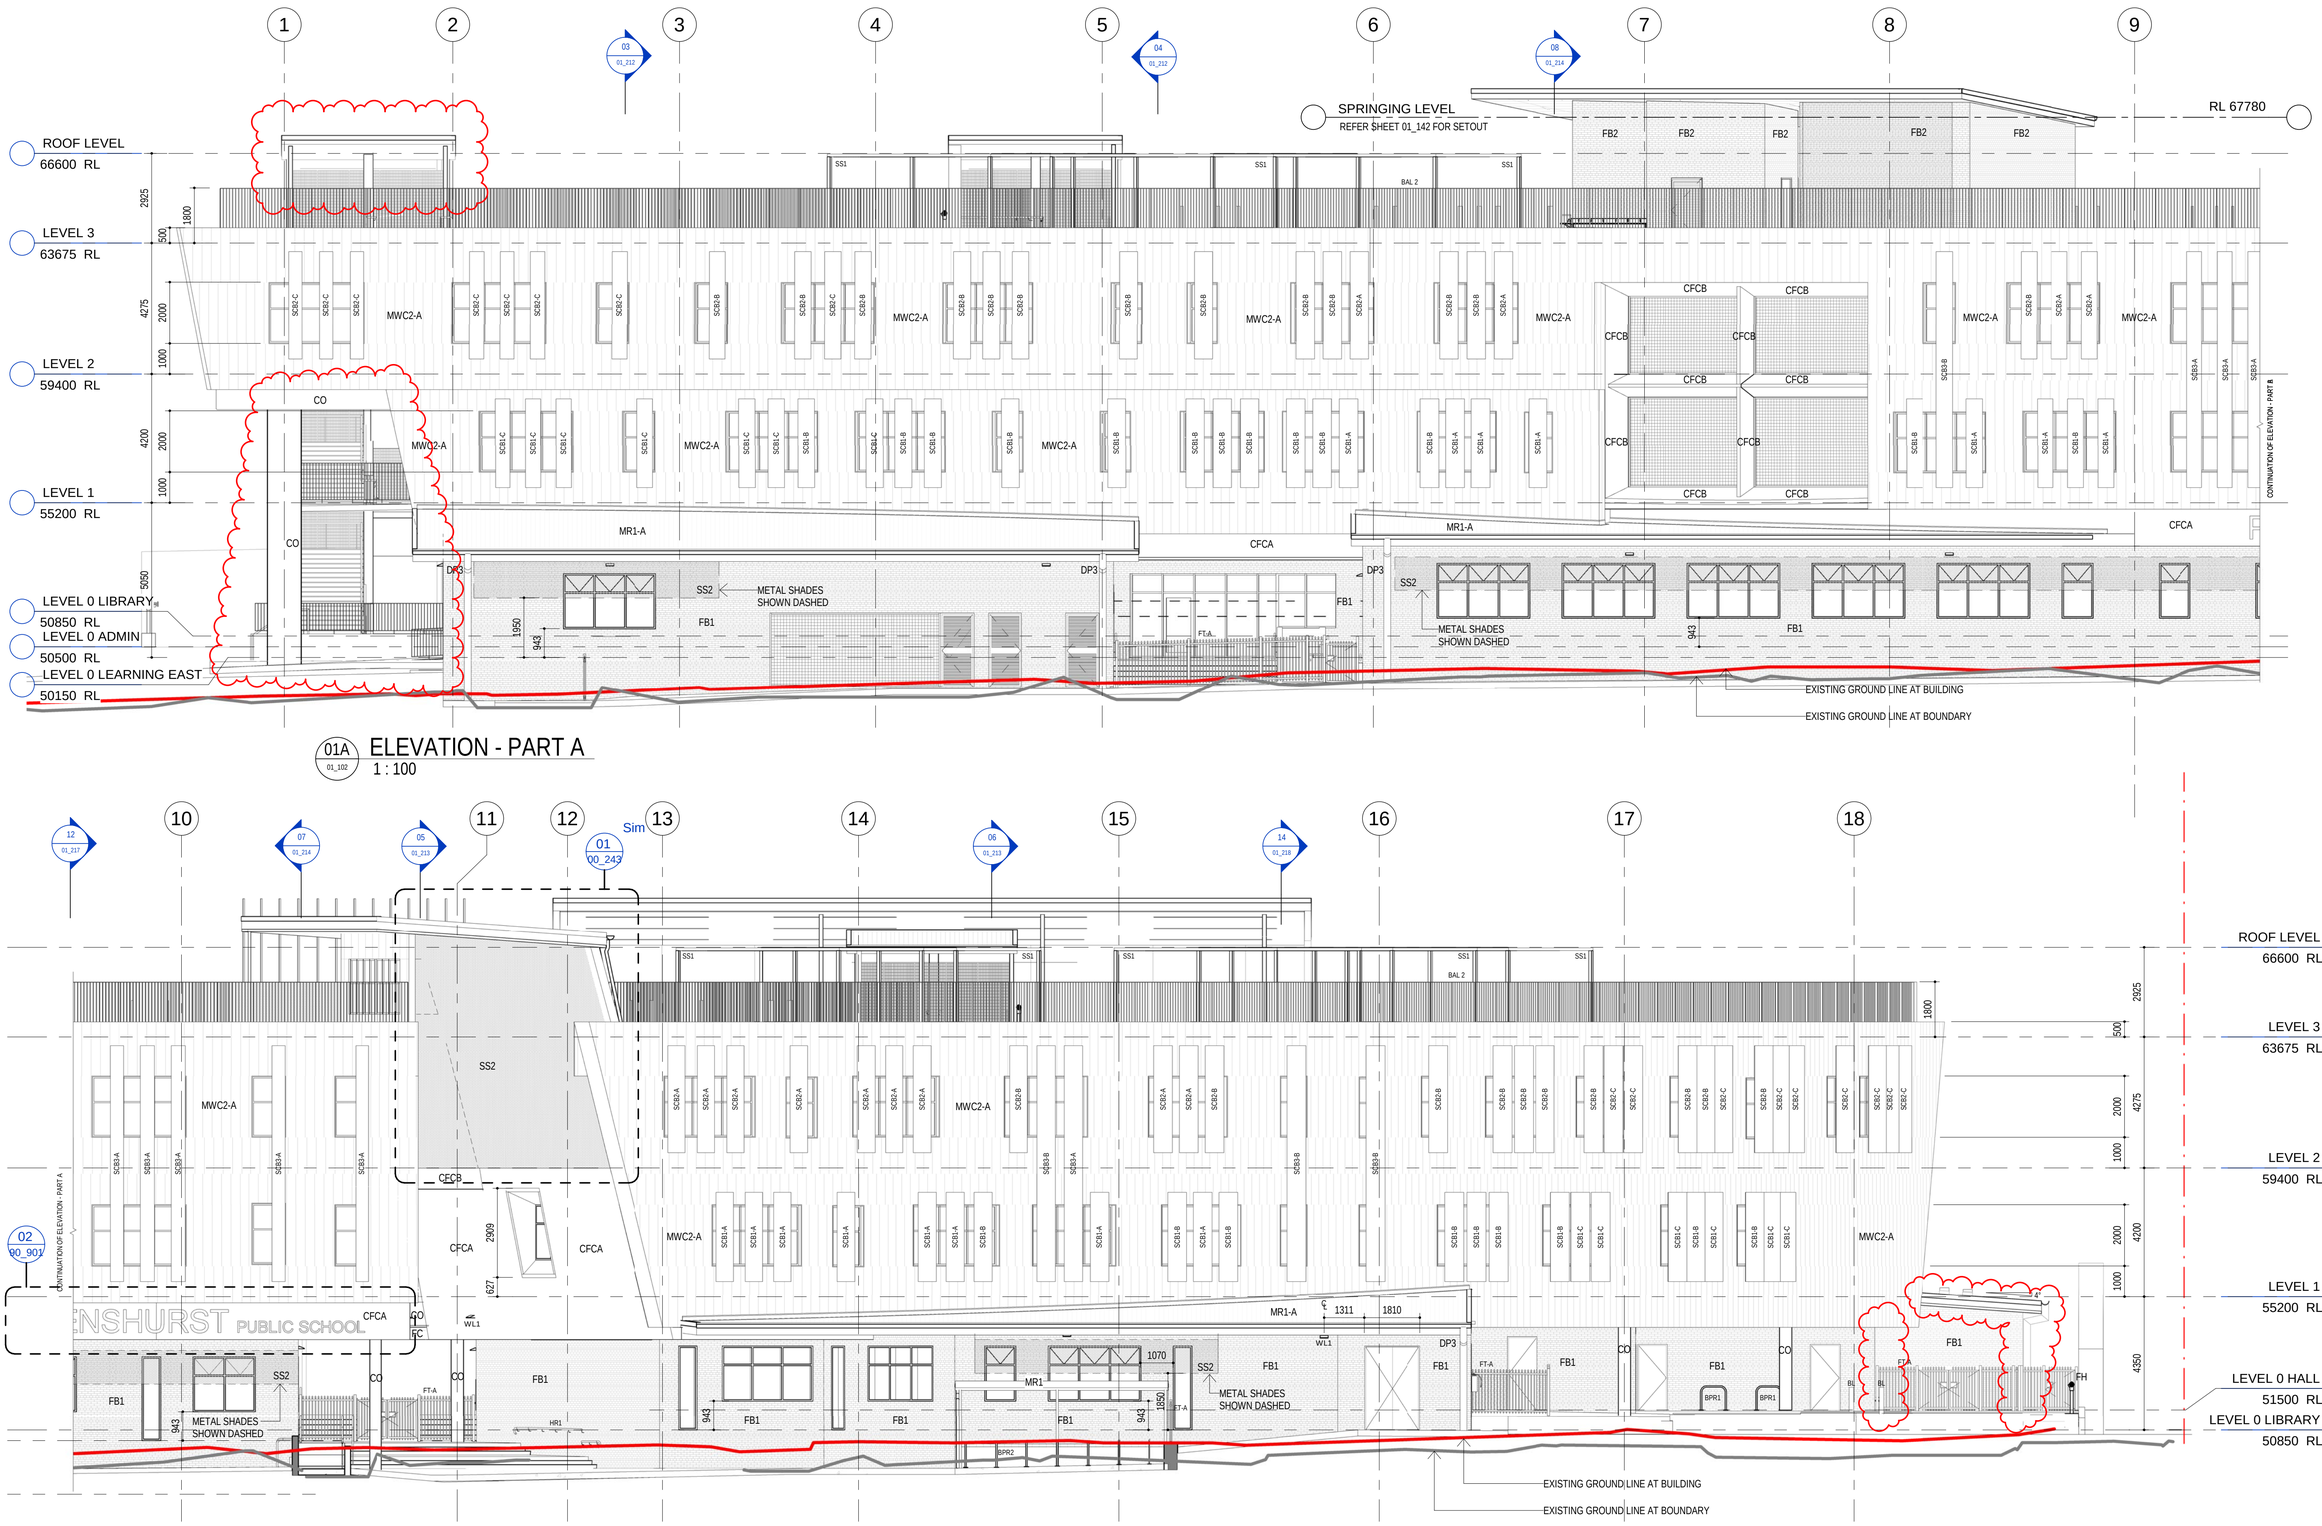

01A 01_102 **ELEVATION - PART A**
1 : 100

01B 01_101 **ELEVATION - PART B**
1 : 100

13/11/2019 10:19:20 AM

ISSUED FOR S4.55(1A)

AMENDMENTS			
REV	BY	DATE	DESCRIPTION
C	MW	08.04.19	GENERAL UPDATE. ISSUED FOR REVIEW
D	MW	18.04.19	GATEWAY 4 REVIEW
01	RO	17.05.19	ISSUE FOR CONSTRUCTION
02	MW	02.08.19	AMEND ROOF CODES TO INCLUDE COLOUR
03	MW	09.08.19	L3 ROOF RAISED. SETOUT & SPRINGING HT DETAILED, MOVE HYDRANT
04	MW	16.08.19	MOVE HYDRANT INTO CAR PARK
05	MW	16.10.19	ADD STAIR 04, AMEND STAIR 01, DELETE SC & AMEND ROOF AT WASTE. ISSUED FOR S4.55(1A)

LEGEND

KEY PLAN

NSW GOVERNMENT Planning, Industry & Environment

Issued under the Environmental Planning and Assessment Act 1979

Approved Section: 4.55(1A) Application No: SSD-8365-Mod-1

Granted on: 6 April 2020 Sheet no: 12 of 35 Signed:

NSW GOVERNMENT Education

STRUCTURE, CIVIL & HYDRAULIC WOOLACOTTS ENGINEERS T: 02 8203 1500

MECH, ELECT, IT, COMMS & SEC. JHA CONSULTING T: 02 9437 1000

BCA GROUP DLA T: 02 8355 3160

LANDSCAPE LORNA HARRISON P/L T: 02 9555 1147

PERUMAL PEDAVOLI ARCHITECTS T: 02 9291 0000 WEB: www.pp-a.com.au Nominated Architect: Vince Pedavoli NSW reg No.5045

STATUTORY PLANNER DON FOX PLANNING P/L T: 02 9473 4914

PERUMAL PEDAVOLI ARCHITECTS

PENSHURST PUBLIC SCHOOL
18 Arcadia Street, Penshurst

DRAWING NAME
ELEVATIONS - SHEET 1

CONTRACT NUMBER	SINSW-18-1257			
PROJECT NORTH	DRAWN	CHECKED	VERIFIED	DATE
	Author	Checker	Approver	12 NOVEMBER 2019

0 1000 2000 3000 4000 5000 10000 SCALE 1 : 100 @ A1

DRAWING NUMBER: 3199-ARC-CD-01_201 REVISION: 05

PROJECT CODE | DISCIPLINE | PHASE | SERIES NUMBER

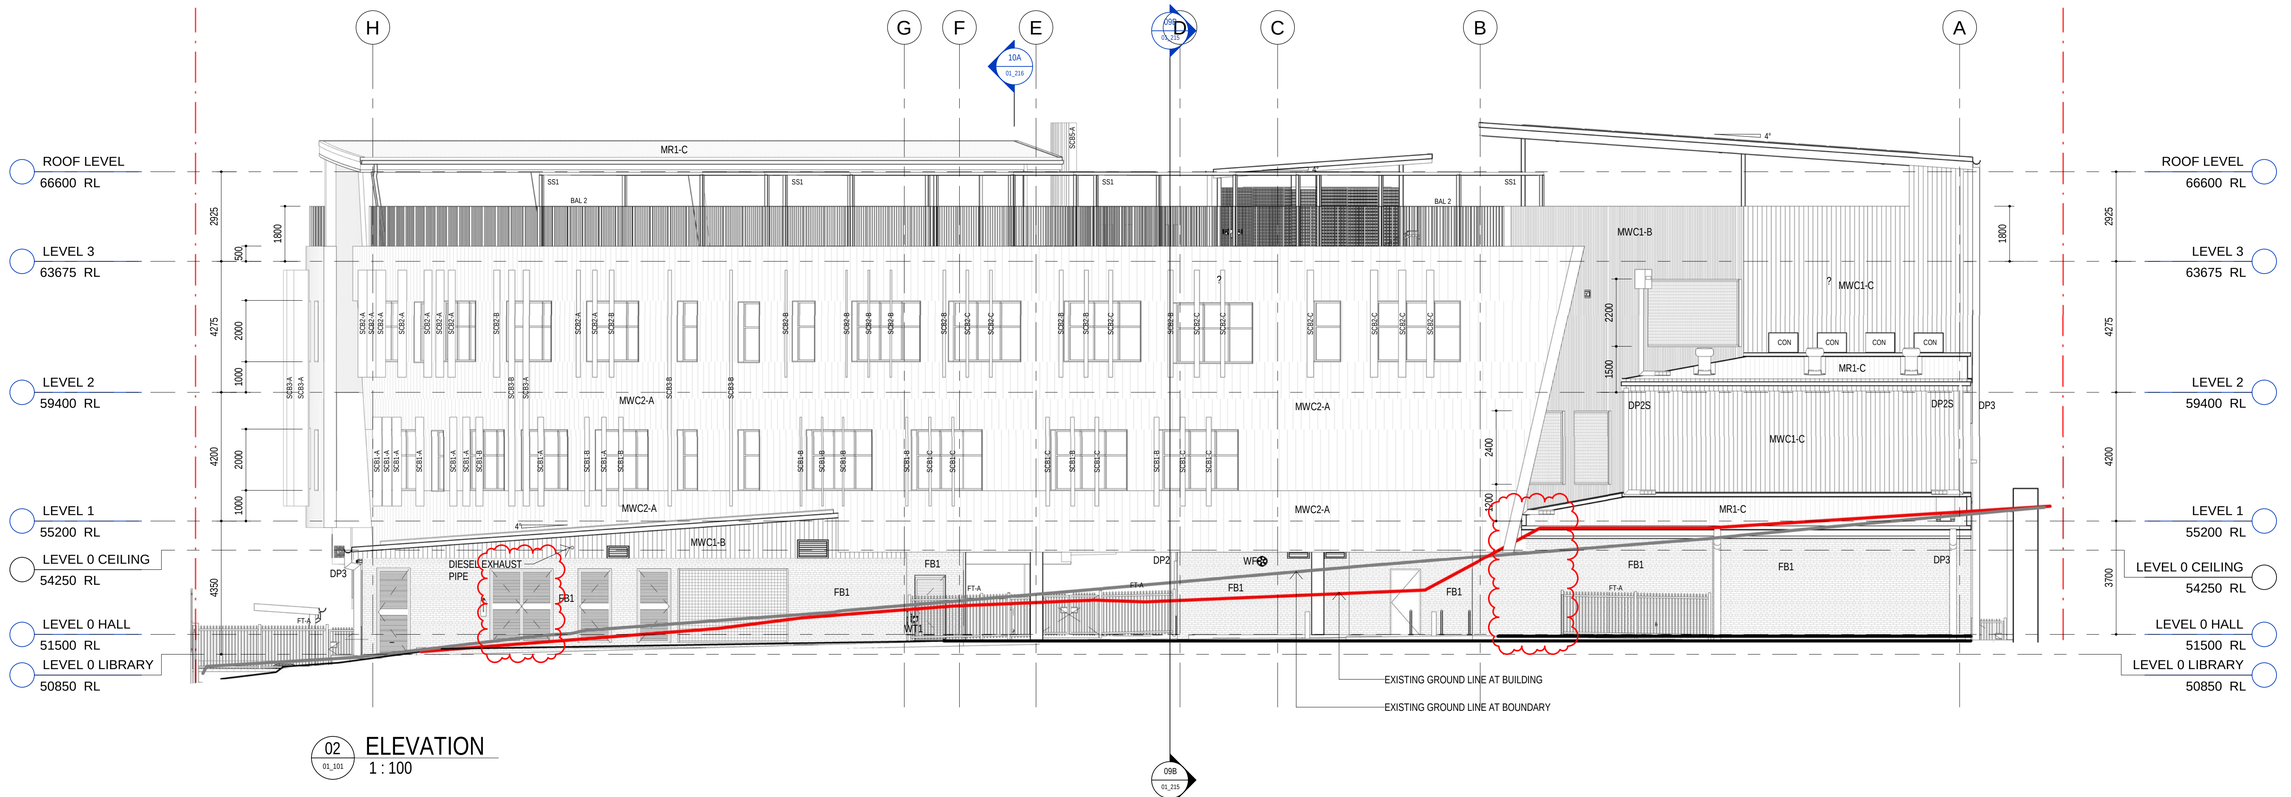

02 01_101 ELEVATION
1 : 100

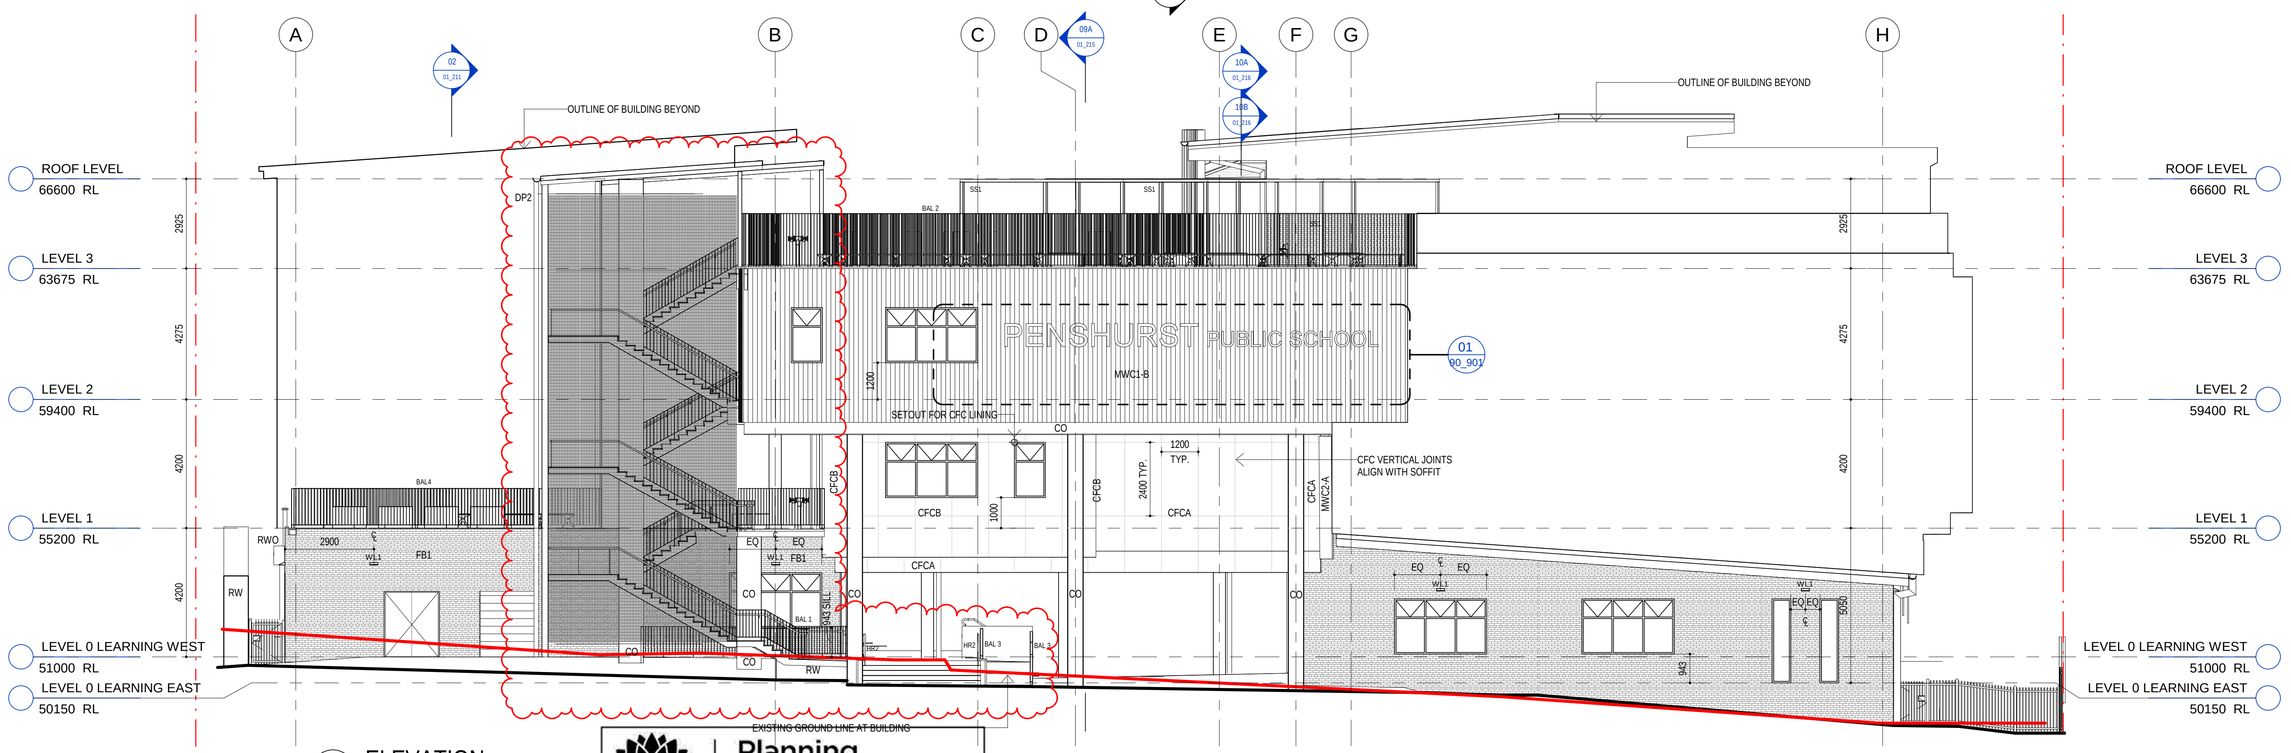

04 01_103 ELEVATION
1 : 100

13/11/2019 10:24:29 AM

ISSUED FOR S4.55(1A)

AMENDMENTS

REV	BY	DATE	DESCRIPTION
C	MW	08.04.19	GENERAL UPDATE. ISSUED FOR REVIEW
D	MW	18.04.19	GATEWAY 4 REVIEW
01	RO	17.05.19	ISSUE FOR CONSTRUCTION
02	MW	01.07.19	AMEND OSD TANK POSITION AND SIZE
03	MW	02.08.19	AMEND ROOF CODES TO INCLUDE COLOUR
04	MW	30.08.19	AMEND LOUVRES - RESIZED OR DELETED
05	MW	16.10.19	ADD STAIR 04, AMEND STAIR 01, DELETE SC & AMEND ROOF AT WASTE. ISSUED FOR S4.55(1A)

LEGEND

KEY PLAN

NSW GOVERNMENT Planning, Industry & Environment

Issued under the Environmental Planning and Assessment Act 1979

Approved Section: 4.55(1A) Application No: SSD-8365-Mod-1

Granted on: 6 April 2020 Sheet no: 13 of 35 Signed:

NSW GOVERNMENT Education

STRUCTURE, CIVIL & HYDRAULIC
WOOLACOTTS ENGINEERS
T: 02 8203 1500

MECH, ELECT, IT, COMMS & SEC.
JHA CONSULTING
T: 02 9437 1000

BCA
GROUP DLA
T: 02 8355 3160

LANDSCAPE
LORNA HARRISON P/L
T: 02 9555 1147

PERUMAL PEDAVOLI ARCHITECTS
T: 02 9291 0000
WEB: www.pp-a.com.au
Nominated Architect:
Vince Pedavoli NSW reg No.5045

STATUTORY PLANNER
DON FOX PLANNING P/L
T: 02 9473 4914

PERUMAL PEDAVOLI ARCHITECTS

PENSHURST PUBLIC SCHOOL
18 Arcadia Street, Penshurst

DRAWING NAME
ELEVATIONS - SHEET 2

CONTRACT NUMBER
SINSW-18-1257

PROJECT NORTH

0 1000 2000 3000 4000 5000 10000
SCALE 1 : 100 @ A1

DRAWN	CHECKED	VERIFIED	DATE
Author	Checker	Approver	12 NOVEMBER 2019

DRAWING NUMBER

REVISION

PROJECT CODE DISCIPLINE PHASE SERIES NUMBER
3199-ARC-CD-01_202 05

03A 01_101 ELEVATION - PART A
1 : 100

03B 01_102 ELEVATION - PART B
1 : 100

13/11/2019 10:33:43 AM

ISSUED FOR S4.55(1A)

AMENDMENTS

REV	BY	DATE	DESCRIPTION
C	MW	08.04.19	GENERAL UPDATE. ISSUED FOR REVIEW
D	MW	18.04.19	GATEWAY 4 REVIEW
01	RO	17.05.19	ISSUE FOR CONSTRUCTION
02	AC	19.07.19	ADJUSTED WINDOW OPENING
03	MW	02.08.19	AMEND ROOF CODES TO INCLUDE COLOUR, MOVE PRECAST PENOS
04	MW	09.08.19	L3 ROOF RAISED. SETOUT & SPRINGING HEIGHT DETAILED
05	MW	30.08.19	AMEND LOUVRES - RESIZED OR DELETED
06	MW	16.10.19	ADD STAIR 04 & AMEND OUTDOOR AREAS. ISSUED FOR S4.55(1A)

LEGEND

KEY PLAN

NSW GOVERNMENT Planning, Industry & Environment

Issued under the Environmental Planning and Assessment Act 1979

Approved Section: 4.55(1A) Application No: SSD-8365-Mod-1

Granted on: 6 April 2020 Sheet no: 14 of 35 Signed:

NSW GOVERNMENT Education

STRUCTURE, CIVIL & HYDRAULIC
WOOLACOTTS ENGINEERS
T: 02 8203 1500

MECH, ELECT, IT, COMMS & SEC.
JHA CONSULTING
T: 02 9437 1000

BCA
GROUP DLA
T: 02 8355 3160

LANDSCAPE
LORNA HARRISON P/L
T: 02 9555 1147

PERUMAL PEDAVOLI ARCHITECTS
T: 02 9291 0000
WEB: www.pp-a.com.au
Nominated Architect:
Vince Pedavoli NSW reg No.5045

STATUTORY PLANNER
DON FOX PLANNING P/L
T: 02 9473 4914

PERUMAL PEDAVOLI ARCHITECTS

PENSHURST PUBLIC SCHOOL
18 Arcadia Street, Penshurst

DRAWING NAME
ELEVATIONS - SHEET 3

CONTRACT NUMBER
SINSW-18-1257

PROJECT NORTH

0 1000 2000 3000 4000 5000 10000
SCALE 1 : 100 @ A1

DRAWN	CHECKED	VERIFIED	DATE
Author	Checker	Approver	12 NOVEMBER 2019

DRAWING NUMBER

REVISION

PROJECT CODE DISCIPLINE PHASE SERIES NUMBER
3199-ARC-CD-01_203

06

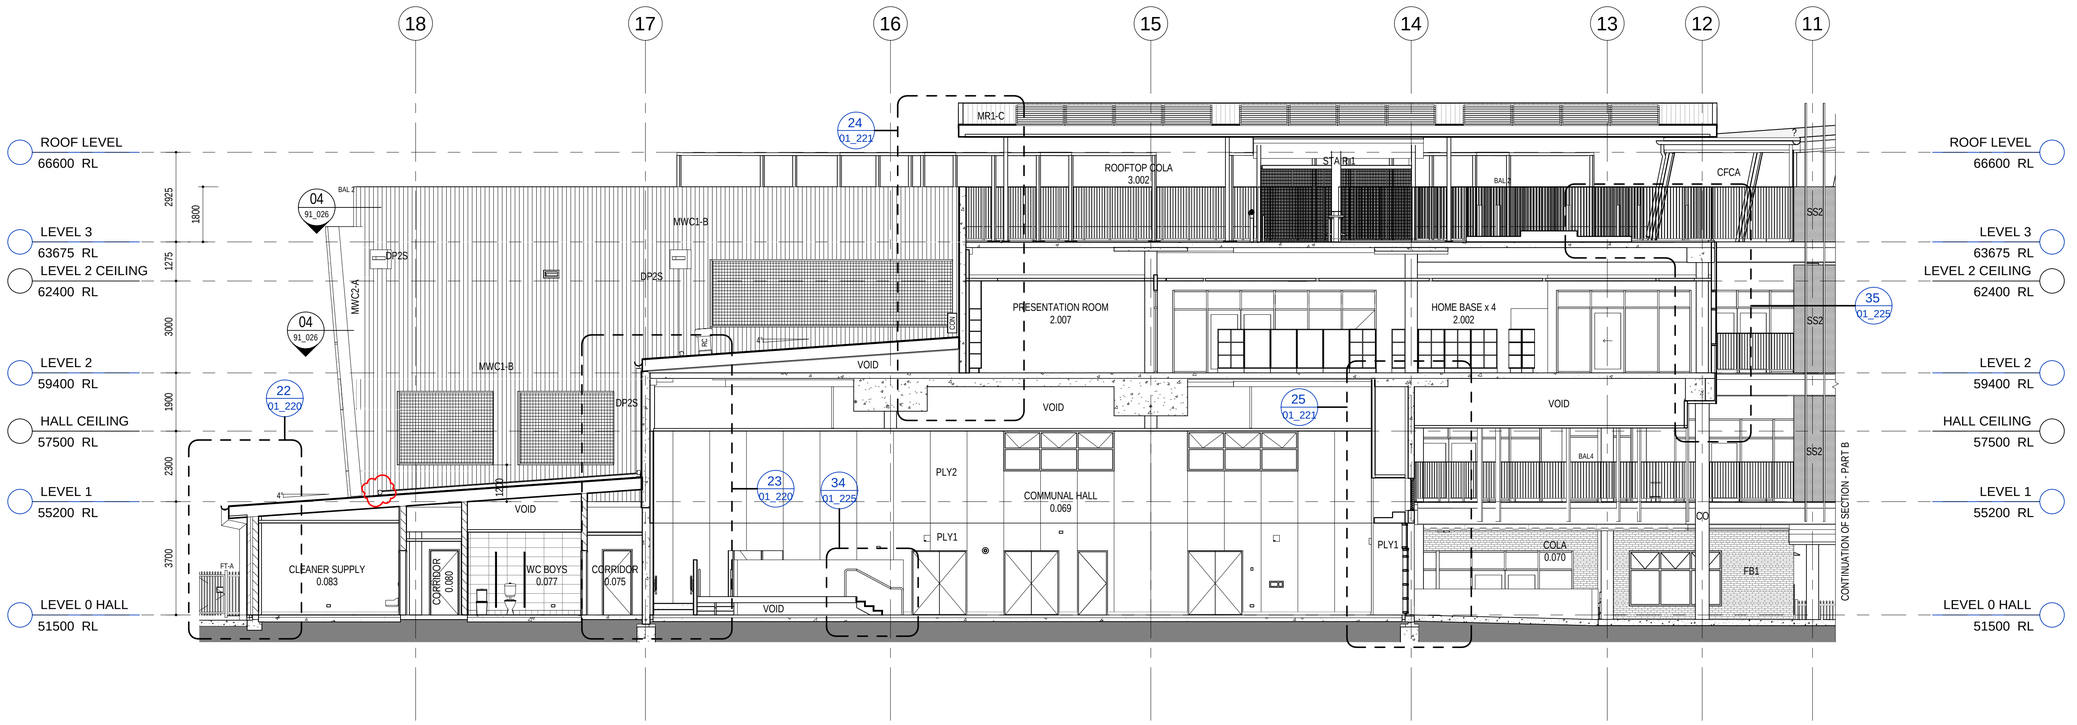

01 / 01_101 SECTION
1 : 100

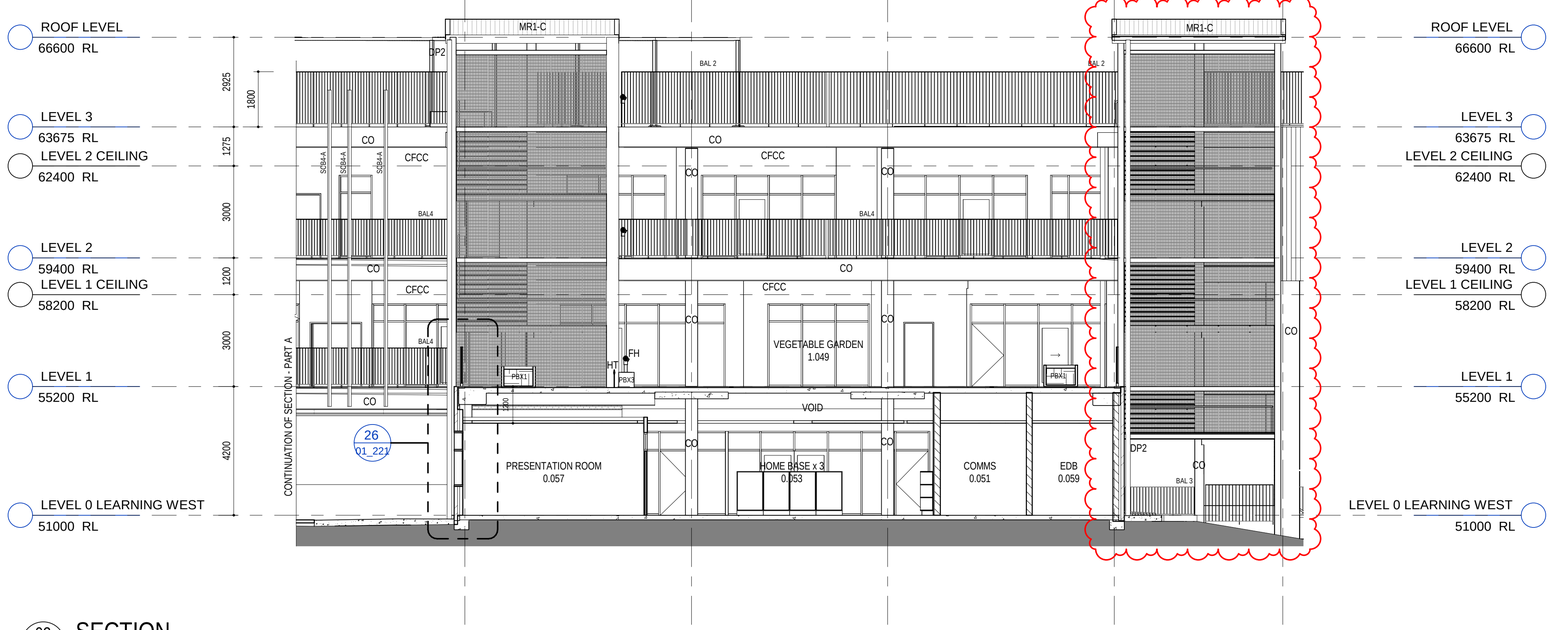

02 / 01_103 SECTION
1 : 100

Planning, Industry & Environment
NSW GOVERNMENT

Issued under the Environmental Planning and Assessment Act 1979

Approved Section: 4.55(1A) Application No: SSD-8365-Mod-1

Granted on: 6 April 2020 Sheet no: 15 of 35 Signed:

13/11/2019 10:34:26 AM

ISSUED FOR S4.55(1A)

AMENDMENTS			
REV	BY	DATE	DESCRIPTION
A	MW	31.08.18	ISSUED FOR TENDER
B	MW	25.02.19	ISSUED FOR INFORMATION
C	MW	08.04.19	GENERAL UPDATE. ISSUED FOR REVIEW
D	MW	18.04.19	GATEWAY 4 REVIEW
01	RO	17.05.19	ISSUE FOR CONSTRUCTION
02	MW	30.08.19	AMEND LOUVRES - RESIZED OR DELETED
03	MW	16.10.19	ADD STAIR 04, AMEND STAIR 01, DELETE SC & AMEND ROOF AT WASTE. ISSUED FOR S4.55(1A)

LEGEND

KEY PLAN

NSW GOVERNMENT Education

STRUCTURE, CIVIL & HYDRAULIC
WOOLACOTTS ENGINEERS
T: 02 8203 1500

MECH, ELECT, IT, COMMS & SEC.
JHA CONSULTING
T: 02 9437 1000

BCA
GROUP DLA
T: 02 8355 3160

LANDSCAPE
LORNA HARRISON P/L
T: 02 9555 1147

PERUMAL PEDAVOLI ARCHITECTS
T: 02 9291 0000
WEB: www.pp-a.com.au
Nominated Architect:
Vince Pedavoli NSW reg No.5045

STATUTORY PLANNER
DON FOX PLANNING P/L
T: 02 9473 4914

PERUMAL PEDAVOLI ARCHITECTS

PENSHURST PUBLIC SCHOOL
18 Arcadia Street, Penshurst

DRAWING NAME
SECTIONS - SHEET 1

CONTRACT NUMBER: SINSW-18-1257
PROJECT NORTH

0 1000 2000 3000 4000 5000 10000
SCALE 1 : 100 @ A1

DRAWN	CHECKED	VERIFIED	DATE
Author	Checker	Approver	12 NOVEMBER 2019

DRAWING NUMBER: REVISION

PROJECT CODE	DISCIPLINE	PHASE	SERIES NUMBER	
3199-ARC-CD-01_211				03

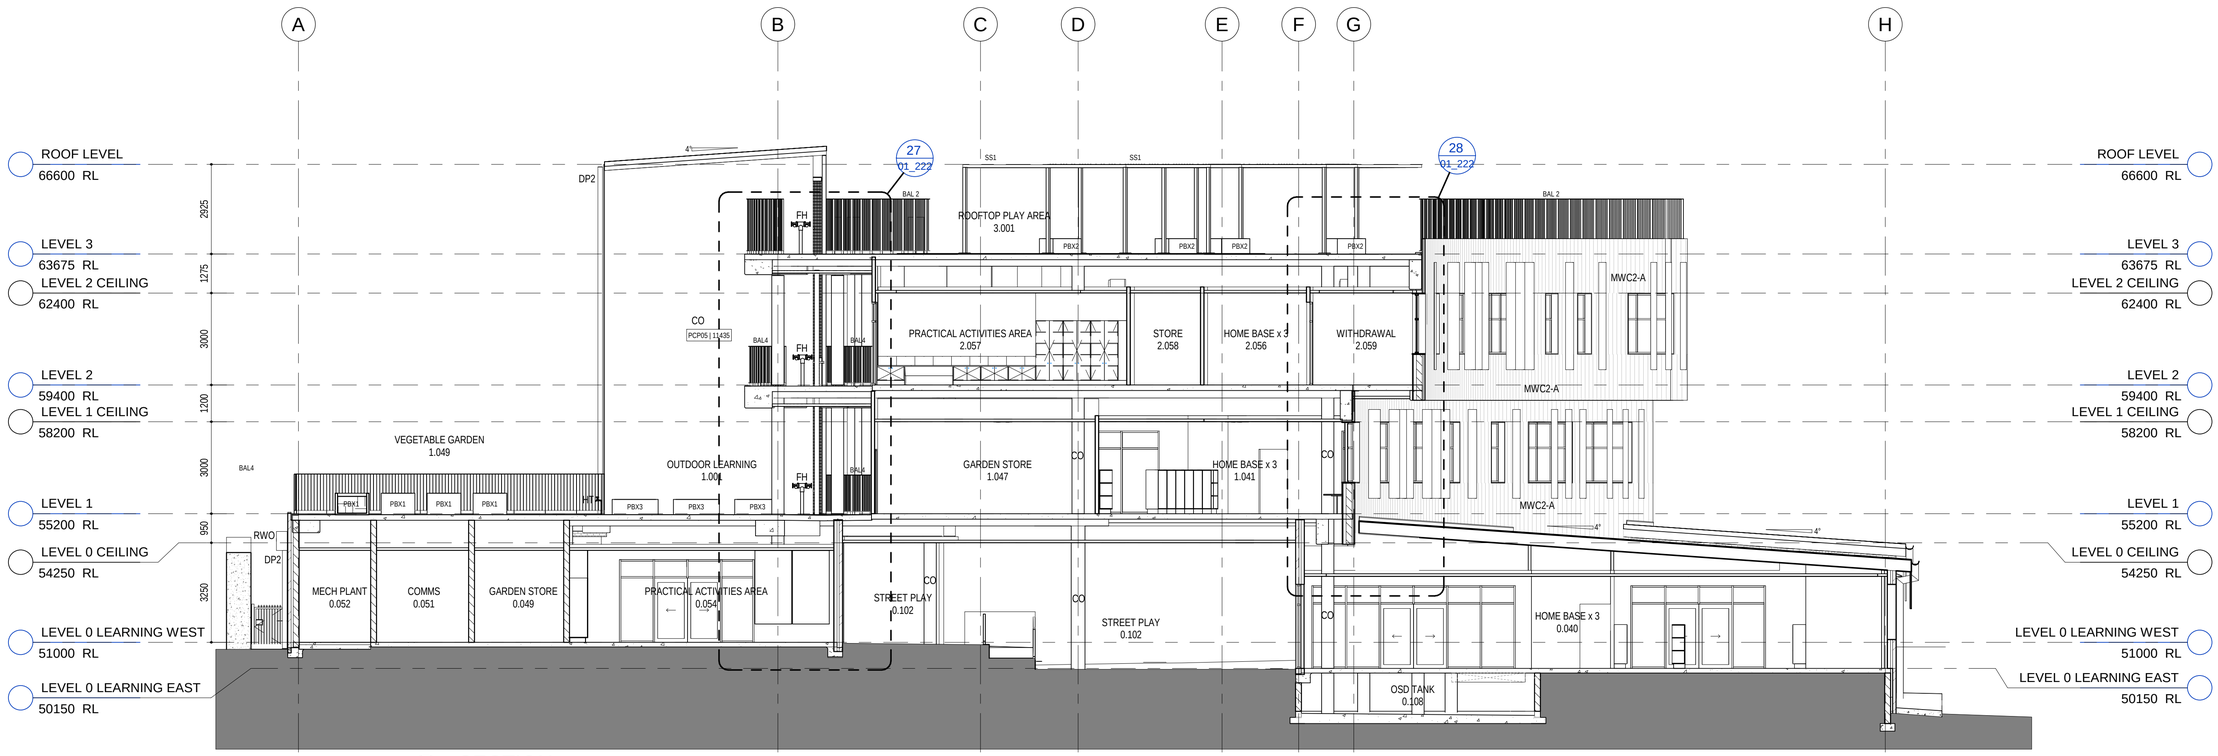

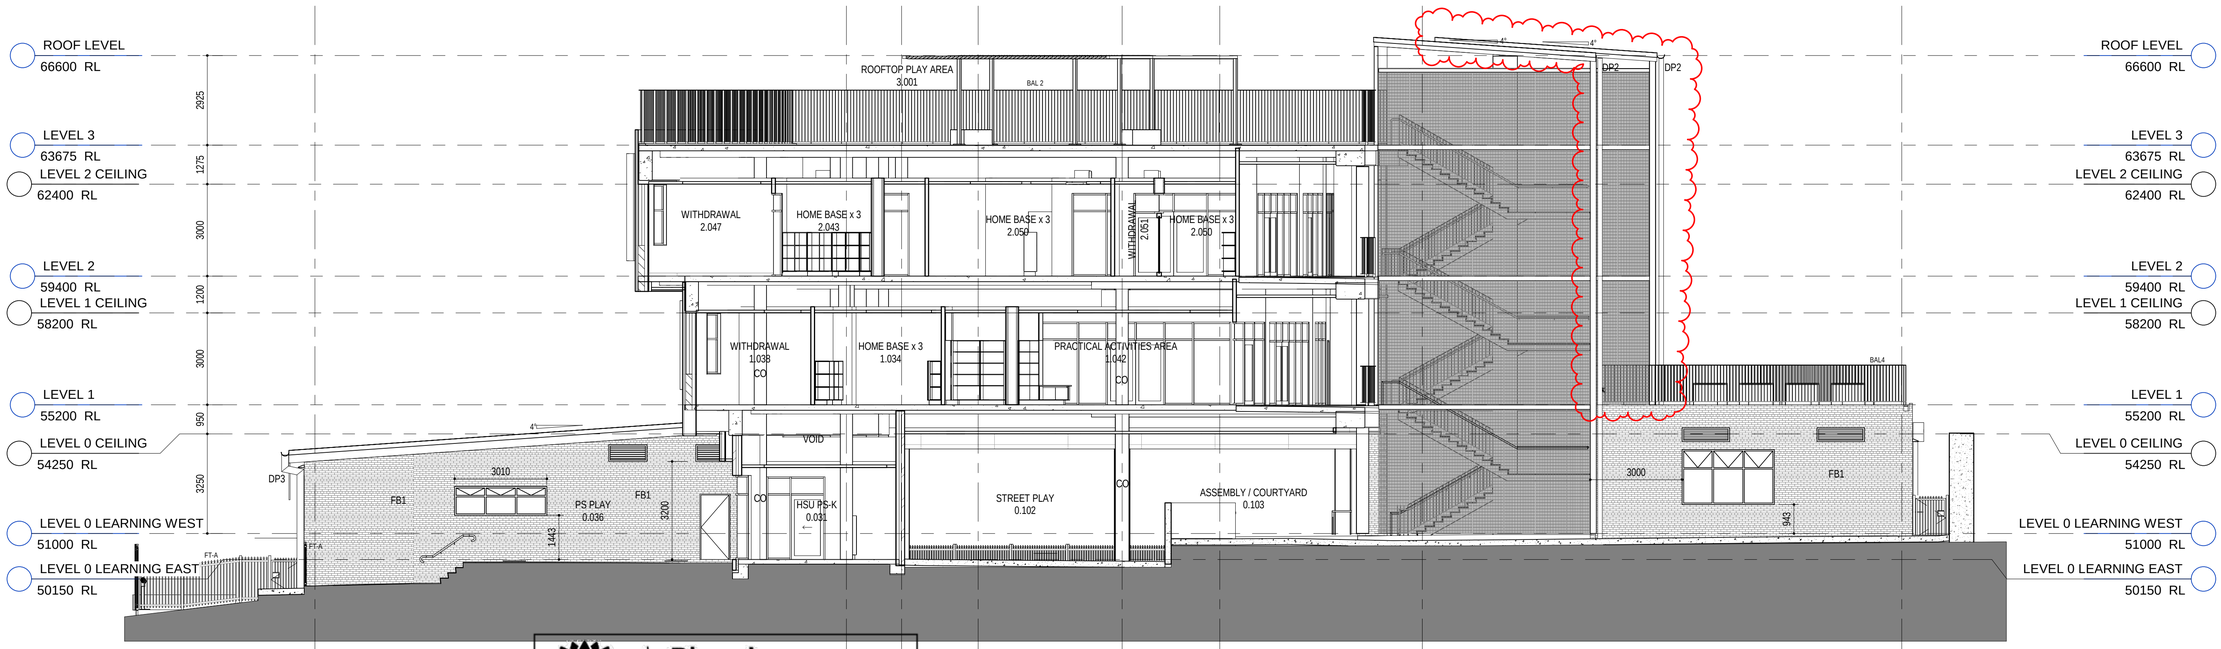

13/11/2019 10:35:07 AM

ISSUED FOR S4.55(1A)

Planning, Industry & Environment

Issued under the Environmental Planning and Assessment Act 1979

Approved Section: 4.55(1A) Application No: SSD-8365-Mod-1

Granted on: 6 April 2020 Sheet no: 16 of 35 Signed:

AMENDMENTS

REV	BY	DATE	DESCRIPTION
A	MW	31.08.18	ISSUED FOR TENDER
B	MW	25.02.19	ISSUED FOR INFORMATION
C	MW	08.04.19	GENERAL UPDATE. ISSUED FOR REVIEW
D	MW	18.04.19	GATEWAY 4 REVIEW
01	RO	17.05.19	ISSUE FOR CONSTRUCTION
02	MW	01.07.19	AMEND OSD TANK POSITION AND SIZE
03	MW	16.10.19	ADD STAIR 04. AMEND STAIR 01, DELETE SC & AMEND ROOF AT WASTE. ISSUED FOR S4.55(1A)

LEGEND

KEY PLAN

NSW GOVERNMENT Education

STRUCTURE, CIVIL & HYDRAULIC
WOOLACOTTS ENGINEERS
T: 02 8203 1500

MECH, ELECT, IT, COMMS & SEC.
JHA CONSULTING
T: 02 9437 1000

BCA
GROUP DLA
T: 02 8355 3160

LANDSCAPE
LORNA HARRISON P/L
T: 02 9555 1147

PERUMAL PEDAVOLI ARCHITECTS
T: 02 9291 0000
WEB: www.pp-a.com.au
Nominated Architect
Vince Pedavoli NSW reg No.5045

STATUTORY PLANNER
DON FOX PLANNING P/L
T: 02 9473 4914

PERUMAL PEDAVOLI ARCHITECTS

PENSHURST PUBLIC SCHOOL
18 Arcadia Street, Penshurst

DRAWING NAME
SECTIONS - SHEET 2

CONTRACT NUMBER
SINSW-18-1257

PROJECT NORTH

0 1000 2000 3000 4000 5000 10000
SCALE 1 : 100 @ A1

DRAWN	CHECKED	VERIFIED	DATE
Author	Checker	Approver	12 NOVEMBER 2019

DRAWING NUMBER

REVISION

PROJECT CODE	DISCIPLINE	PHASE	SERIES NUMBER	
3199	ARC	CD	01_212	03

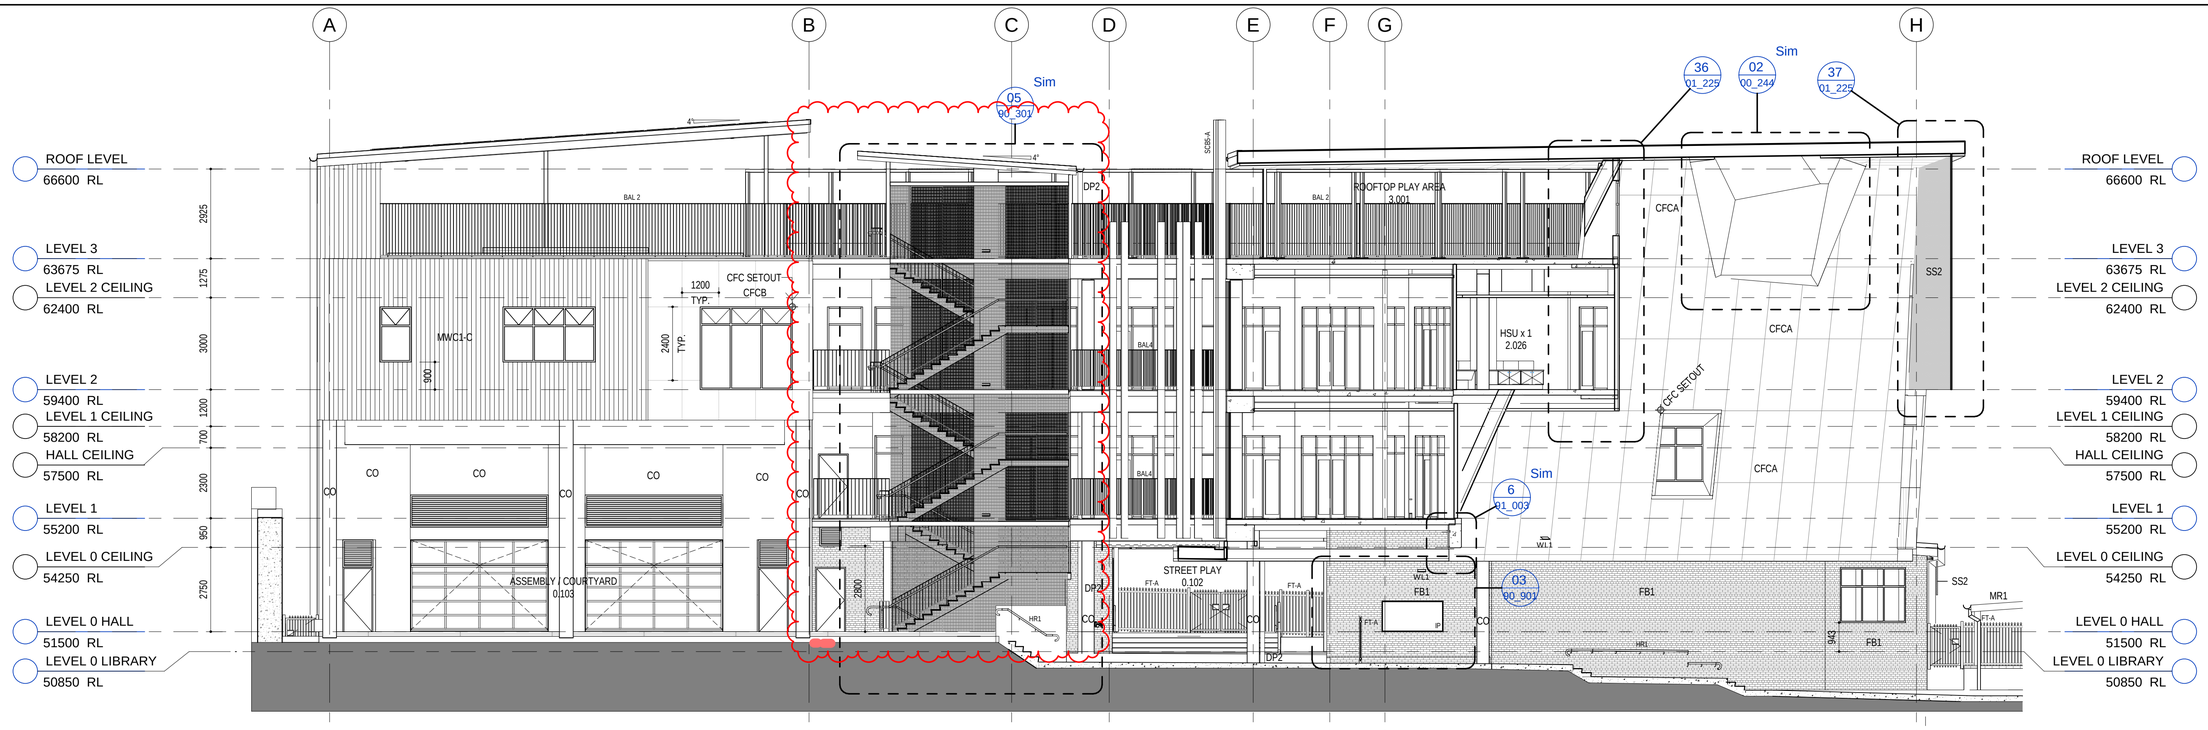

05 01_102 SECTION
1 : 100

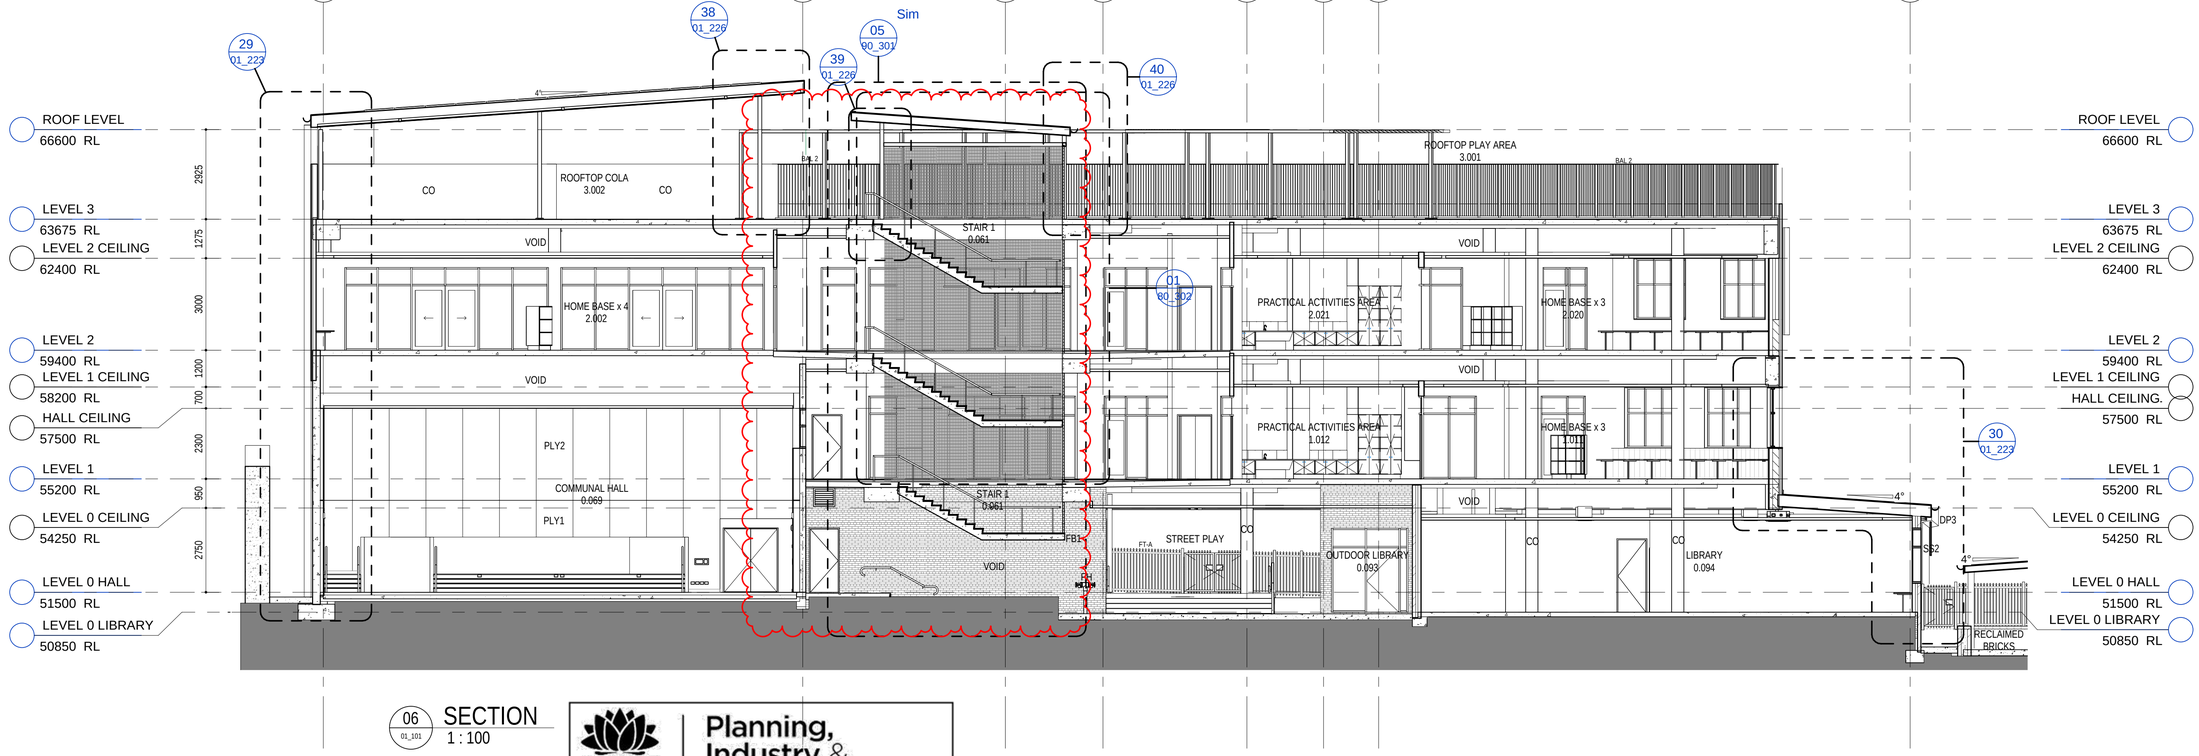

06 01_101 SECTION
1 : 100

NSW GOVERNMENT Planning, Industry & Environment

Issued under the Environmental Planning and Assessment Act 1979

Approved Section: 4.55(1A) Application No: SSD-8365-Mod-1

Granted on: 6 April 2020 Sheet no: 17 of 35 Signed:

13/11/2019 10:36:01 AM

ISSUED FOR S4.55(1A)

AMENDMENTS

REV	BY	DATE	DESCRIPTION
B	MW	25.02.19	ISSUED FOR INFORMATION
C	BS/MW	08.04.19	LOUVRES ADDED & GENERAL UPDATE. ISSUED FOR REVIEW
D	MW	18.04.19	GATEWAY 4 REVIEW
01	RO	17.05.19	ISSUE FOR CONSTRUCTION
02	MW	01.07.19	ADD DETAIL TAGS / CROSS REFERENCES
03	BS	02.08.19	DOOR LOCATION AMENDED. DIMENSION ADDED
04	MW	16.10.19	ADD STAIR 04, AMEND STAIR 01, DELETE SC & AMEND ROOF AT WASTE. ISSUED FOR S4.55(1A)

LEGEND

KEY PLAN

NSW GOVERNMENT Education

STRUCTURE, CIVIL & HYDRAULIC WOOLACOTTS ENGINEERS T: 02 8203 1500

MECH, ELECT, IT, COMMS & SEC. J+A CONSULTING T: 02 9437 1000

BCA GROUP DLA T: 02 8355 3160

LANDSCAPE LORNA HARRISON P/L T: 02 9555 1147

PERUMAL PEDAVOLI ARCHITECTS T: 02 9291 0000 WEB: www.pp-a.com.au Nominated Architect: Vince Pedavoli NSW reg No.5045

STATUTORY PLANNER DON FOX PLANNING P/L T: 02 9473 4914

PERUMAL PEDAVOLI ARCHITECTS

PENSHURST PUBLIC SCHOOL
18 Arcadia Street, Penshurst

DRAWING NAME
SECTIONS - SHEET 3

CONTRACT NUMBER SINSW-18-1257

PROJECT NORTH

0 1000 2000 3000 4000 5000 10000 SCALE 1 : 100 @ A1

DRAWN	CHECKED	VERIFIED	DATE
Author	Checker	Approver	12 NOVEMBER 2019

DRAWING NUMBER REVISION

PROJECT CODE DISCIPLINE PHASE SERIES NUMBER
3199-ARC-CD-01_213 04

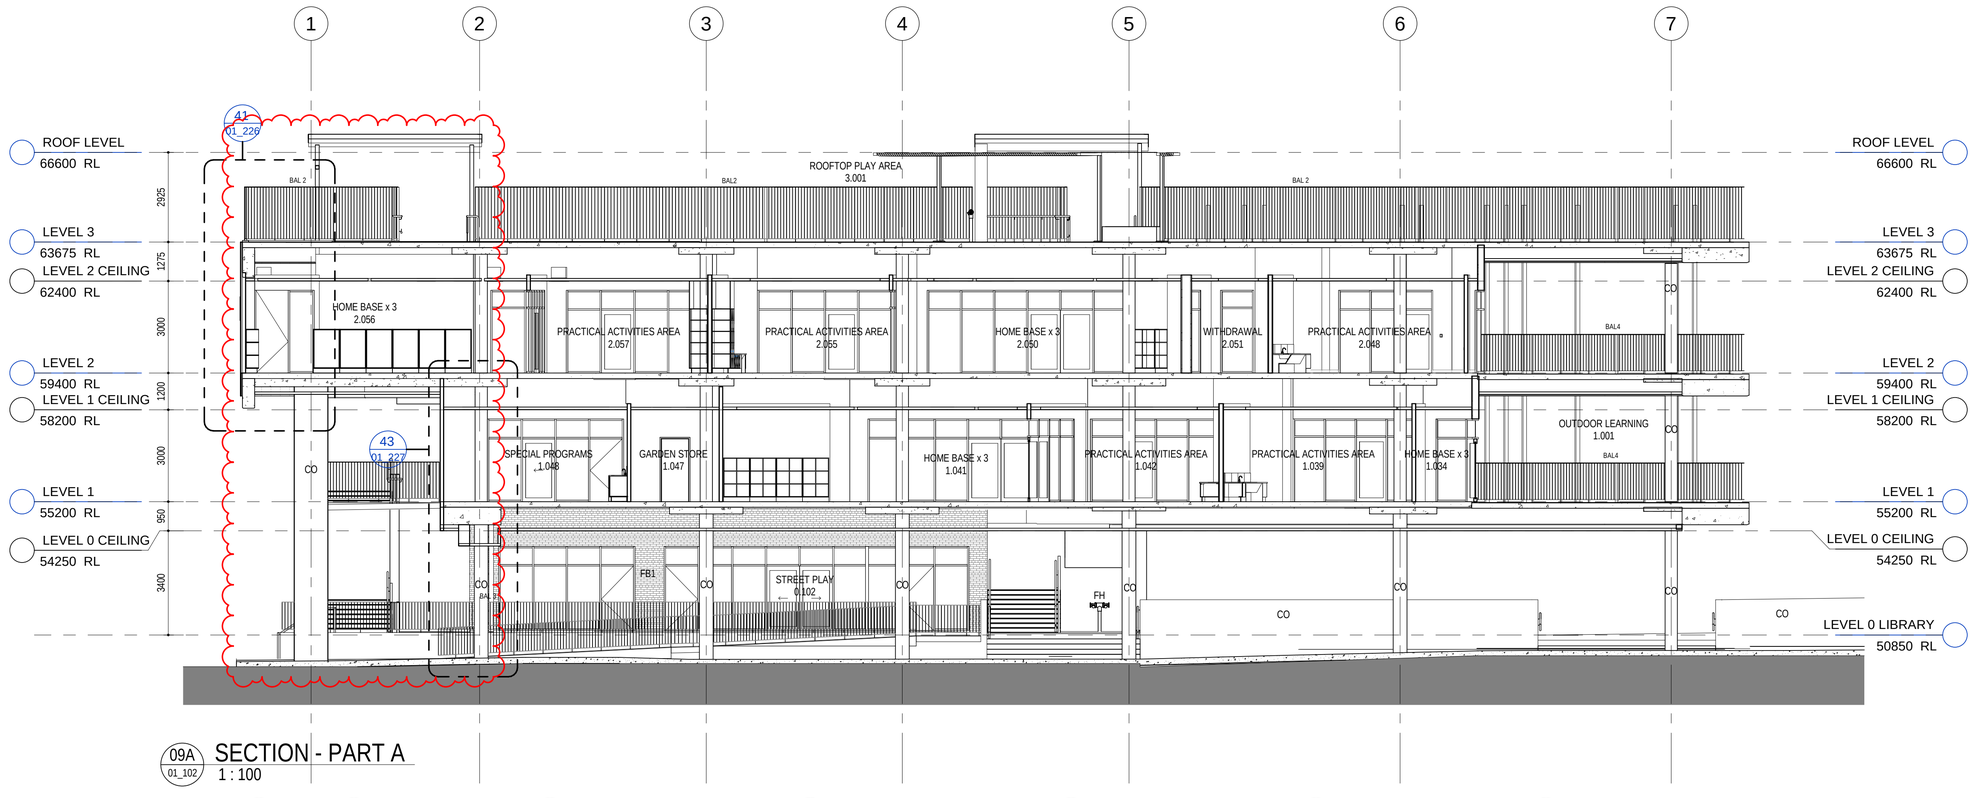

13/11/2019 10:36:36 AM

ISSUED FOR S4.55(1A)

AMENDMENTS			
REV	BY	DATE	DESCRIPTION
	MW	17.08.18	FOR REVIEW
A	MW	31.08.18	ISSUED FOR TENDER
B	MW	25.02.19	ISSUED FOR INFORMATION
C	MW	08.04.19	GENERAL UPDATE. ISSUED FOR REVIEW
D	MW	18.04.19	GATEWAY 4 REVIEW
01	RO	17.05.19	ISSUE FOR CONSTRUCTION
02	MW	16.10.19	ADD STAIR 04, AMEND STAIR 01, DELETE SC & AMEND ROOF AT WASTE. ISSUED FOR S4.55(1A)

LEGEND

KEY PLAN

NSW GOVERNMENT
Planning, Industry & Environment

Issued under the Environmental Planning and Assessment Act 1979

Approved Section: 4.55(1A) Application No: SSD-8365-Mod-1

Granted on: 6 April 2020 Sheet no: 18 of 35 Signed:

NSW GOVERNMENT Education

STRUCTURE, CIVIL & HYDRAULIC
WOOLACOTTS ENGINEERS
T: 02 8203 1500

MECH, ELECT, IT, COMMS & SEC.
JHA CONSULTING
T: 02 9437 1000

BCA
GROUP DLA
T: 02 8355 3160

LANDSCAPE
LORNA HARRISON P/L
T: 02 9555 1147

PERUMAL PEDAVOLI ARCHITECTS
T: 02 9291 0000
WEB: www.pp-a.com.au
Nominated Architect:
Vince Pedavoli NSW reg No.5045

STATUTORY PLANNER
DON FOX PLANNING P/L
T: 02 9473 4914

PERUMAL PEDAVOLI ARCHITECTS

PENSHURST PUBLIC SCHOOL
18 Arcadia Street, Penshurst

DRAWING NAME
SECTIONS - SHEET 5

CONTRACT NUMBER
SINSW-18-1257

PROJECT NORTH

0 1000 2000 3000 4000 5000 10000
SCALE 1 : 100 @ A1

DRAWN	CHECKED	VERIFIED	DATE
Author	Checker	Approver	12 NOVEMBER 2019

DRAWING NUMBER: 3199-ARC-CD-01_215
REVISION: 02

PROJECT CODE | DISCIPLINE | PHASE | SERIES NUMBER

NSW GOVERNMENT | Planning, Industry & Environment
Issued under the Environmental Planning and Assessment Act 1979
Approved Section: 4.55(1A) Application No: SSD-8365-Mod-1
Granted on: 6 April 2020 Sheet no: 19 of 35 Signed:

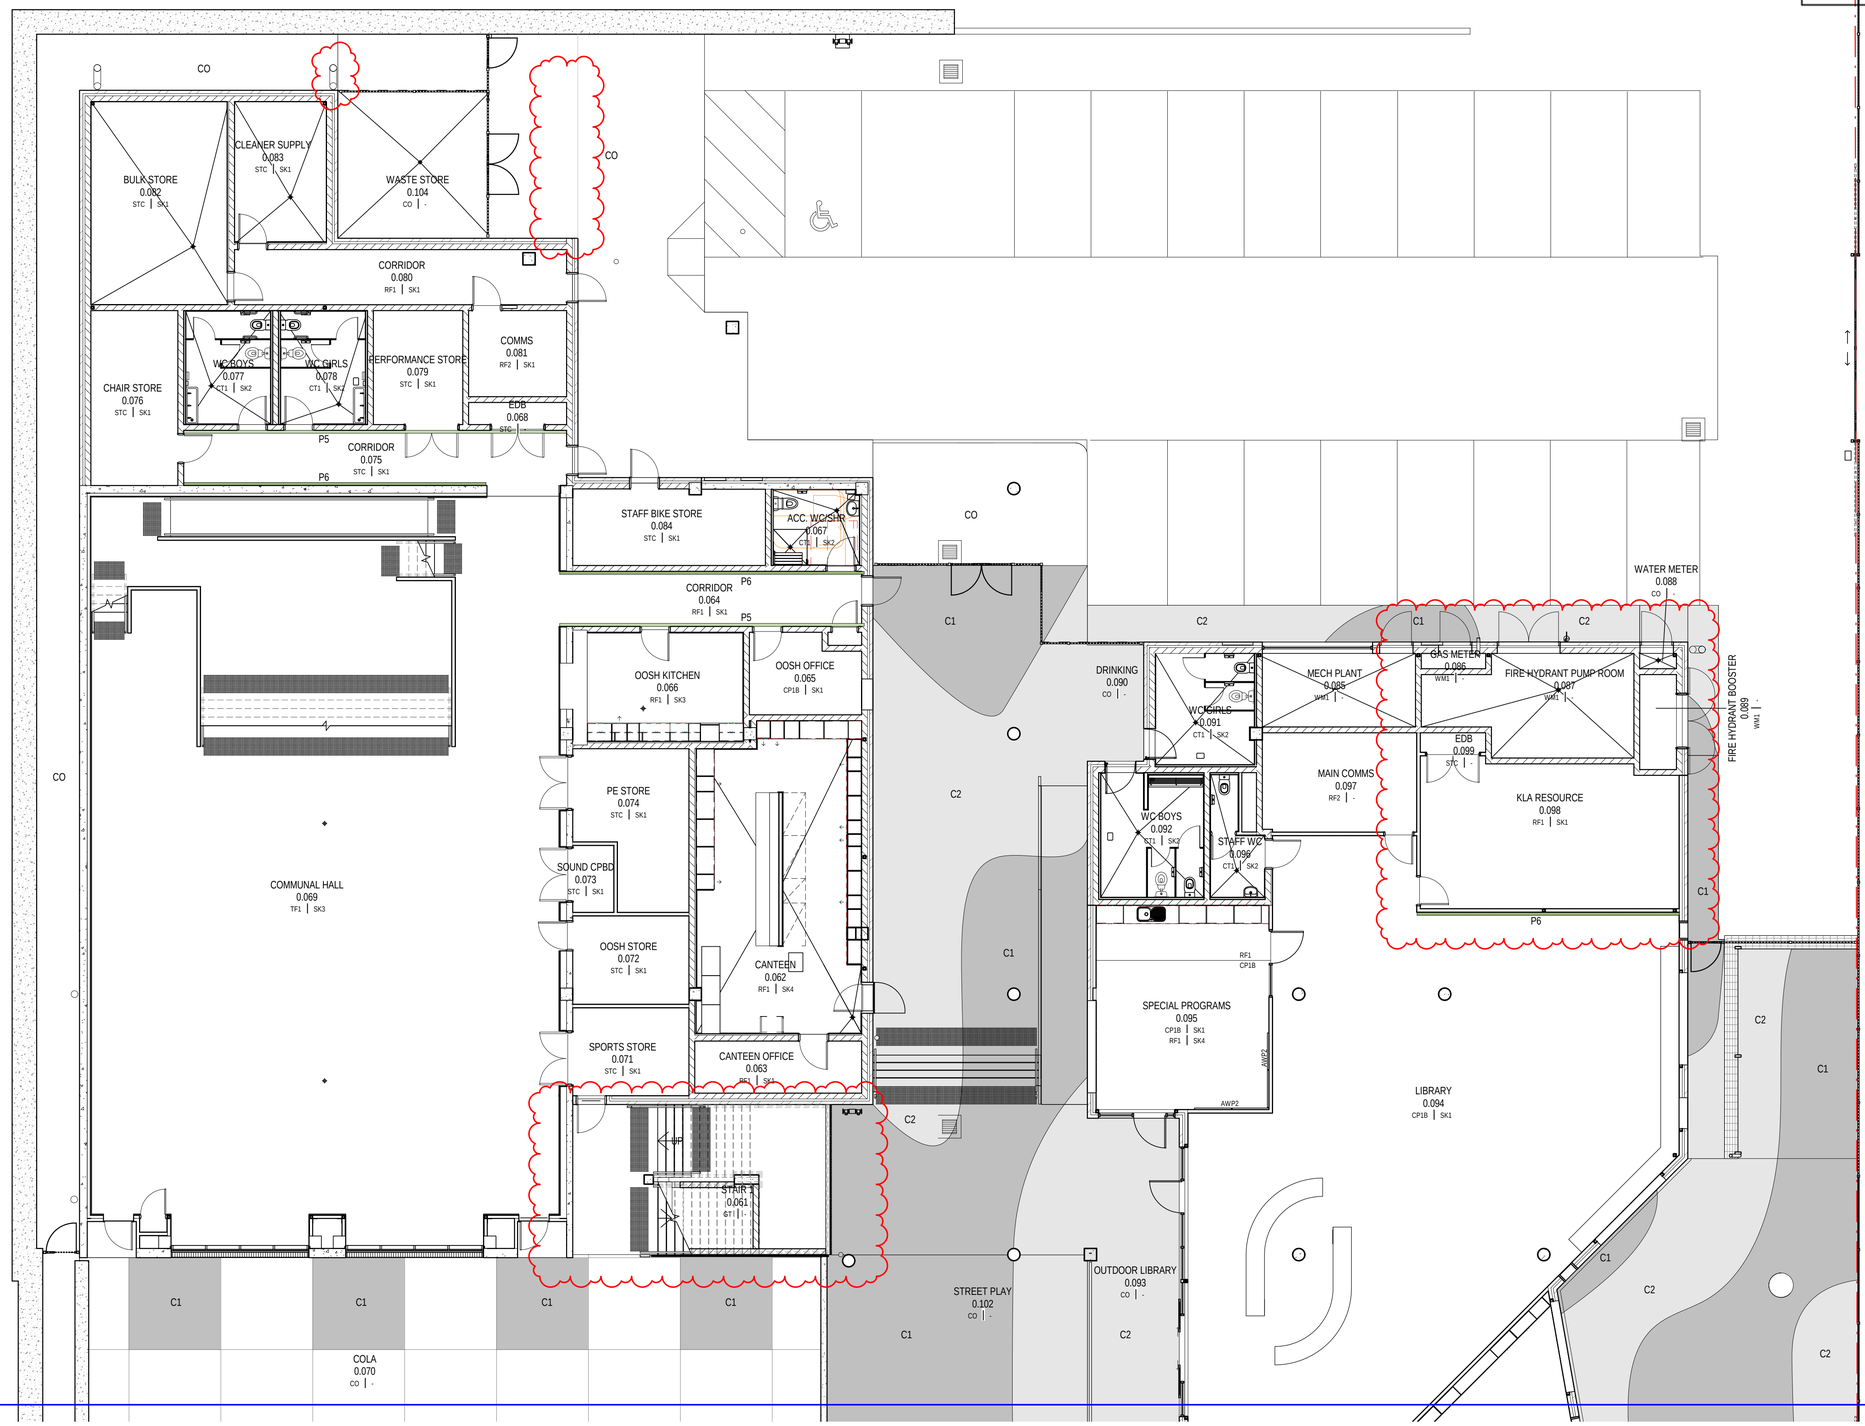

FOR CONTINUATION REFER TO 01_402

13/11/2019 10:37:03 AM

ISSUED FOR S4.55(1A)

AMENDMENTS			
REV	BY	DATE	DESCRIPTION
A	MW	31.08.18	ISSUED FOR TENDER
B	MW	08.04.19	GENERAL UPDATE. ISSUED FOR REVIEW
C	MW	18.04.19	GATEWAY 4 REVIEW
01	RO	17.05.19	ISSUE FOR CONSTRUCTION
02	MW	01.07.19	ADD / AMEND NOTES & DIMENSIONS
03	MW	16.10.19	ENLARGE FH PUMP RM & REDUCE GAS METER RM., AMEND STAIR 01 & SPORT STORE, DELETE SC & MOVE DP FOR WASTE AREA. ISSUED FOR S4.55(1A)

LEGEND

C1 C1 C1

KEY PLAN

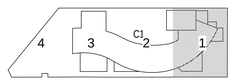

NSW GOVERNMENT Education

STRUCTURE, CIVIL & HYDRAULIC WOOLACOTTS ENGINEERS T: 02 8203 1500
MECH, ELECT, IT, COMMS & SEC. JHA CONSULTING T: 02 9437 1000
BCA GROUP DLA T: 02 8355 3160
LANDSCAPE LORNA HARRISON P/L T: 02 9555 1147
PERUMAL PEDAVOLI ARCHITECTS T: 02 9291 0000 WEB: www.pp-a.com.au Nominated Architect: Vince Pedavoli NSW reg No.5045
STATUTORY PLANNER DON FOX PLANNING P/L T: 02 9473 4914
PERUMAL PEDAVOLI ARCHITECTS

PENSHURST PUBLIC SCHOOL
18 Arcadia Street, Penshurst

DRAWING NAME
FINISHES PLAN - LEVEL 0 - PART 1

CONTRACT NUMBER	0 1000 2000 3000 4000 5000 10000
SINSW-18-1257	SCALE 1 : 100 @ A1

PROJECT NORTH

DRAWN	CHECKED	VERIFIED	DATE
Author	Checker	Approver	12 NOVEMBER 2019

DRAWING NUMBER: 3199-ARC-CD-01_401 REVISION: 03

PROJECT CODE | DISCIPLINE | PHASE | SERIES NUMBER

FOR CONTINUATION REFER TO 01_402

ASSEMBLY / COURTYARD
0.103
CO

PRESENTATION ROOM
0.057
CP1C | SK1

STORE
0.058
RF1 | SK1

STAIR 3
0.060
GT | -

WITHDRAWAL
0.056
CP1A | SK1

HOME BASE x 3
0.053
CP1A | SK1
RF1 | SK1

WITHDRAWAL
0.055
CP1A | SK1

COMMS
0.051
RF2 | -

MECH PLANT
0.052
WM1 | -

PLANT LOBBY
0.050
WM1 |

EDB
0.059
STC | -

GARDEN STORE
0.049
WM1 | -

PRACTICAL ACTIVITIES AREA
0.054
RF1 | SK1

STAIR 4
0.106
GT | -

STREET PLAY
0.102
CO | -

PATH

WC / SHOWER
0.034
CT1 | SK2

HSU PS-K
0.031
CP1A | SK1
RF1 | SK4

WITHDRAWAL
0.035
CP1A | SK1

OUTDOOR STORE
0.037
WM1 | -

SPECIAL PROGRAMS
0.038
RF1 | SK1

STORE
0.039
RF1 | SK1

PRESENTATION ROOM
0.043
CP1C | SK1

MSR
0.048
STC | -

EDB
0.044
STC | -

MECH PLANT
0.047
WM1 | -

STORE
0.042
RF1 | SK1

PRACTICAL ACTIVITIES AREA
0.041
RF1 | SK1

HOME BASE x 3
0.040
CP1A | SK1
RF1 | SK1

WITHDRAWAL
0.046
CP1A | SK1

WITHDRAWAL
0.045
CP1A | SK1

AT

P9

NSW GOVERNMENT | Planning, Industry & Environment

Issued under the Environmental Planning and Assessment Act 1979

Approved Section: 4.55(1A) Application No: SSD-8365-Mod-1

Granted on: 6 April 2020 Sheet no: 20 of 35 Signed:

13/11/2019 10:37:57 AM

ISSUED FOR S4.55(1A)

AMENDMENTS

REV	BY	DATE	DESCRIPTION
	MW	17.08.18	FOR REVIEW
A	MW	31.08.18	ISSUED FOR TENDER
B	MW	08.04.19	GENERAL UPDATE. ISSUED FOR REVIEW
C	MW	18.04.19	GATEWAY 4 REVIEW
01	RO	17.05.19	ISSUE FOR CONSTRUCTION
02	MW	01.07.19	ADD PAINT FINISH TO CONCRETE COLS
03	BS	26.07.19	FLOOR FINISH AMENDED
04	MW	16.10.19	ADD STAIR 04 & AMEND OUTDOOR AREAS. ISSUED FOR S4.55(1A)

LEGEND

KEY PLAN

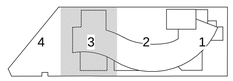

NSW GOVERNMENT | Education

STRUCTURE, CIVIL & HYDRAULIC WOOLACOTTS ENGINEERS T: 02 8203 1500	**PERUMAL PEDAVOLI ARCHITECTS** T: 02 9291 0000 WEB: www.pp-a.com.au Nominated Architect: Vince Pedavoli NSW reg No.5045
MECH, ELECT, IT, COMMS & SEC. J+A CONSULTING T: 02 9437 1000	
BCA GROUP DLA T: 02 8355 3160	
LANDSCAPE LORNA HARRISON P/L T: 02 9555 1147	**STATUTORY PLANNER** DON FOX PLANNING P/L T: 02 9473 4914

PERUMAL PEDAVOLI ARCHITECTS

PENSHURST PUBLIC SCHOOL
18 Arcadia Street, Penshurst

DRAWING NAME
FINISHES PLAN - LEVEL 0 - PART 3

CONTRACT NUMBER: SINSW-18-1257

PROJECT NORTH

0 1000 2000 3000 4000 5000 10000
SCALE 1 : 100 @ A1

DRAWN	CHECKED	VERIFIED	DATE
Author	Checker	Approver	12 NOVEMBER 2019

DRAWING NUMBER: 3199-ARC-CD-01_403
REVISION: 04

PROJECT CODE | DISCIPLINE | PHASE | SERIES NUMBER

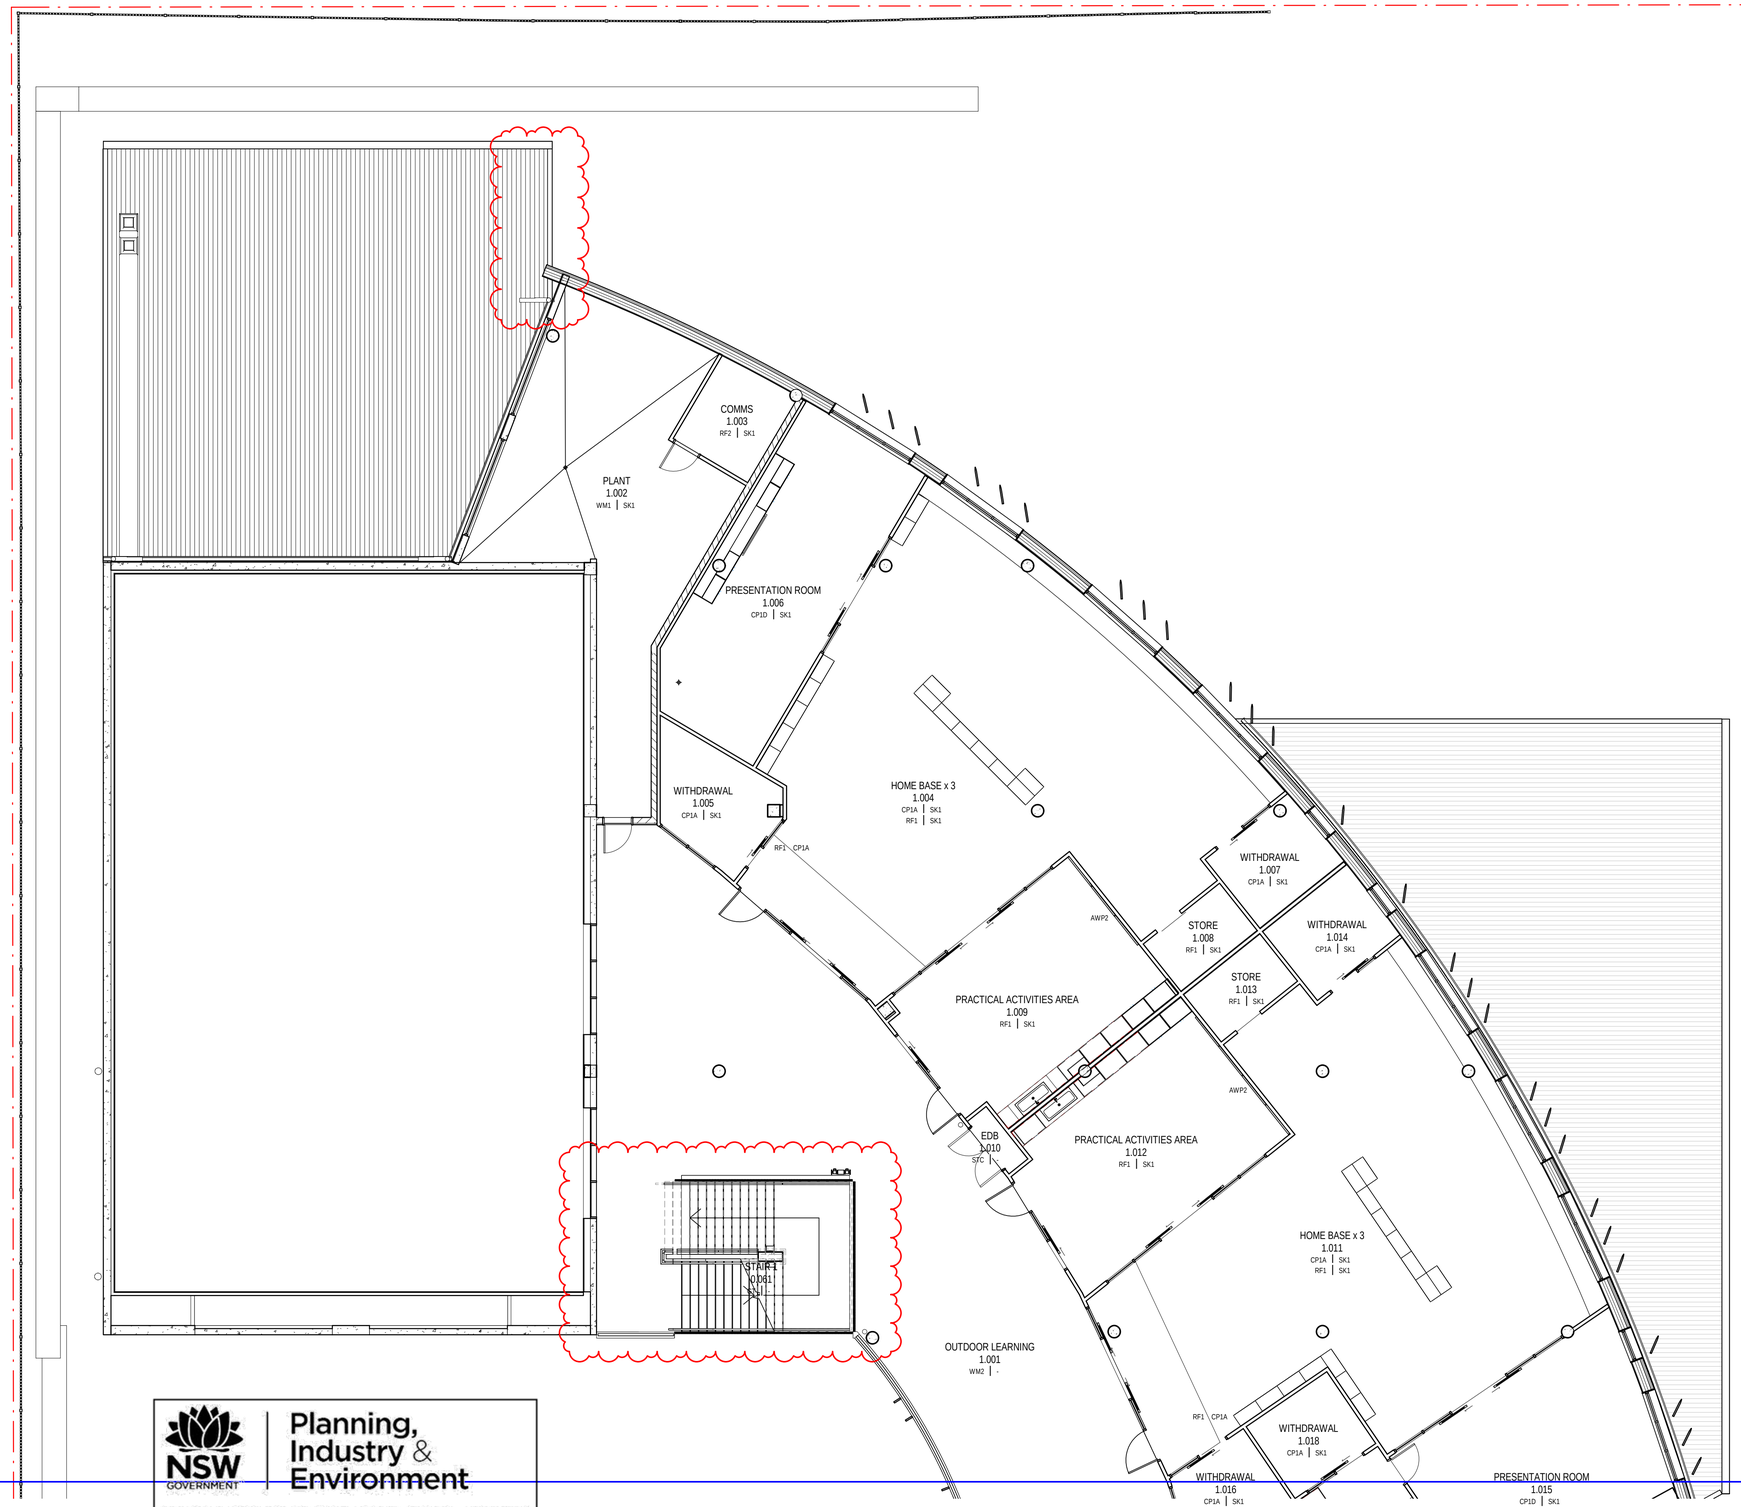

FOR CONTINUATION REFER TO 01_412

13/11/2019 10:38:20 AM

ISSUED FOR S4.55(1A)

NSW GOVERNMENT | Planning, Industry & Environment

Issued under the Environmental Planning and Assessment Act 1979

Approved Section: 4.55(1A) Application No: SSD-8365-Mod-1

Granted on: 6 April 2020 Sheet no: 21 of 35 Signed:

AMENDMENTS

REV	BY	DATE	DESCRIPTION
	MW	20.07.18	PROGRESS ISSUE
	MW	10.08.18	PROGRESS ISSUE
	MW	17.08.18	FOR REVIEW
A	MW	31.08.18	ISSUED FOR TENDER
B	MW	08.04.19	GENERAL UPDATE. ISSUED FOR REVIEW
C	MW	18.04.19	GATEWAY 4 REVIEW
01	RO	17.05.19	ISSUE FOR CONSTRUCTION
02	MW	16.10.19	AMEND STAIR 01 & ROOF OVER WASTE. ISSUED FOR S4.55(1A)

LEGEND

KEY PLAN

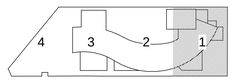

NSW GOVERNMENT | Education

STRUCTURE, CIVIL & HYDRAULIC
WOOLACOTTS ENGINEERS
T: 02 8203 1500

MECH, ELECT, IT, COMMS & SEC.
JHA CONSULTING
T: 02 9437 1000

BCA
GROUP DLA
T: 02 8355 3160

LANDSCAPE
LORNA HARRISON P/L
T: 02 9555 1147

PERUMAL PEDAVOLI ARCHITECTS
T: 02 9291 0000
WEB: www.pp-a.com.au
Nominated Architect:
Vince Pedavoli NSW reg No.5045

STATUTORY PLANNER
DON FOX PLANNING P/L
T: 02 9473 4914

PERUMAL PEDAVOLI ARCHITECTS

PENSHURST PUBLIC SCHOOL
18 Arcadia Street, Penshurst

DRAWING NAME
FINISHES PLAN - LEVEL 1 - PART 1

CONTRACT NUMBER
SINSW-18-1257

PROJECT NORTH

0 1000 2000 3000 4000 5000 10000
SCALE 1 : 100 @ A1

DRAWN	CHECKED	VERIFIED	DATE
Author	Checker	Approver	12 NOVEMBER 2019

DRAWING NUMBER
3199-ARC-CD-01_411

REVISION
02

PROJECT CODE | DISCIPLINE | PHASE | SERIES NUMBER

FOR CONTINUATION REFER TO 01_412

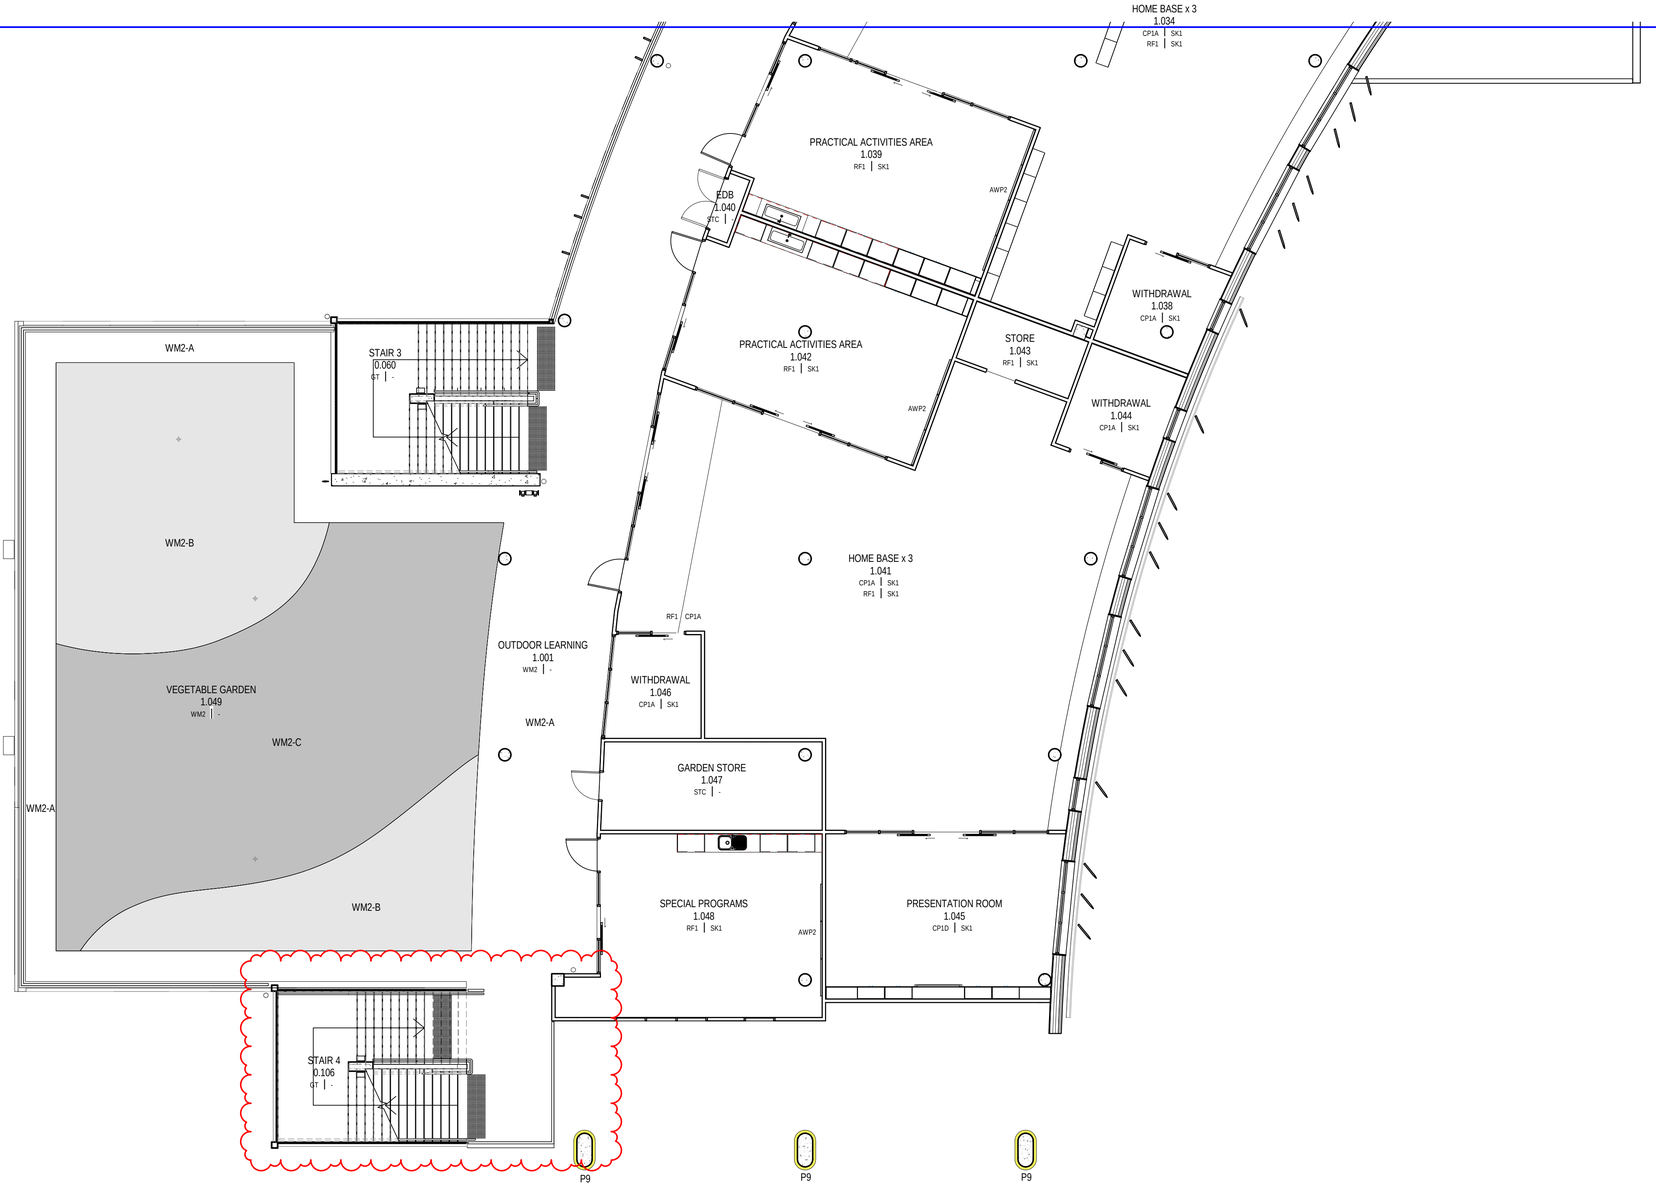

NSW GOVERNMENT | Planning, Industry & Environment

Issued under the Environmental Planning and Assessment Act 1979

Approved Section: 4.55(1A) Application No: SSD-8365-Mod-1

Granted on: 6 April 2020 Sheet no: 22 of 35 Signed:

13/11/2019 10:38:56 AM

ISSUED FOR S4.55(1A)

AMENDMENTS

REV	BY	DATE	DESCRIPTION
	MW	20.07.18	PROGRESS ISSUE
	MW	10.08.18	PROGRESS ISSUE
	MW	17.08.18	FOR REVIEW
A	MW	31.08.18	ISSUED FOR TENDER
B	MW	08.04.19	GENERAL UPDATE. ISSUED FOR REVIEW
C	MW	18.04.19	GATEWAY 4 REVIEW
01	RO	17.05.19	ISSUE FOR CONSTRUCTION
02	MW	16.10.19	ADD STAIR 04 & AMEND HOMEBASE. ISSUED FOR S4.55(1A)

LEGEND

KEY PLAN

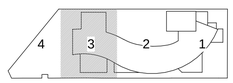

NSW GOVERNMENT | Education

STRUCTURE, CIVIL & HYDRAULIC
WOOLACOTTS ENGINEERS
T: 02 8203 1500

MECH, ELECT, IT, COMMS & SEC.
JHA CONSULTING
T: 02 9437 1000

BCA
GROUP DLA
T: 02 8355 3160

LANDSCAPE
LORNA HARRISON P/L
T: 02 9555 1147

PERUMAL PEDAVOLI ARCHITECTS
T: 02 9291 0000
WEB: www.pp-a.com.au
Nominated Architect:
Vince Pedavoli NSW reg No.5045

STATUTORY PLANNER
DON FOX PLANNING P/L
T: 02 9473 4914

PERUMAL PEDAVOLI ARCHITECTS

PENSHURST PUBLIC SCHOOL
18 Arcadia Street, Penshurst

DRAWING NAME
FINISHES PLAN - LEVEL 1 - PART 3

CONTRACT NUMBER
SINSW-18-1257

PROJECT NORTH

0 1000 2000 3000 4000 5000 10000
SCALE 1 : 100 @ A1

DRAWN	CHECKED	VERIFIED	DATE
Author	Checker	Approver	12 NOVEMBER 2019

DRAWING NUMBER
3199-ARC-CD-01_413

REVISION
02

PROJECT CODE | DISCIPLINE | PHASE | SERIES NUMBER

NSW GOVERNMENT | Planning, Industry & Environment

Issued under the Environmental Planning and Assessment Act 1979

Approved Section: 4.55(1A) Application No: SSD-8365-Mod-1

Granted on: 6 April 2020 Sheet no: 23 of 35 Signed:

FOR CONTINUATION REFER TO 01_422

13/11/2019 10:39:19 AM

ISSUED FOR S4.55(1A)

AMENDMENTS

REV	BY	DATE	DESCRIPTION
	MW	20.07.18	PROGRESS ISSUE
	MW	10.08.18	PROGRESS ISSUE
	MW	17.08.18	FOR REVIEW
A	MW	31.08.18	ISSUED FOR TENDER
B	MW	08.04.19	GENERAL UPDATE. ISSUED FOR REVIEW
C	MW	18.04.19	GATEWAY 4 REVIEW
01	RO	17.05.19	ISSUE FOR CONSTRUCTION
02	MW	16.10.19	AMEND STAIR 01 & ROOF OVER WASTE. ISSUED FOR S4.55(1A)

LEGEND

KEY PLAN

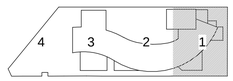

NSW GOVERNMENT Education

STRUCTURE, CIVIL & HYDRAULIC
WOOLACOTTS ENGINEERS
T: 02 8203 1500

MECH, ELECT, IT, COMMS & SEC.
JHA CONSULTING
T: 02 9437 1000

BCA
GROUP DLA
T: 02 8355 3160

LANDSCAPE
LORNA HARRISON P/L
T: 02 9555 1147

PERUMAL PEDAVOLI ARCHITECTS
T: 02 9291 0000
WEB: www.pp-a.com.au
Nominated Architect:
Vince Pedavoli NSW reg No.5045

STATUTORY PLANNER
DON FOX PLANNING P/L
T: 02 9473 4914

PERUMAL PEDAVOLI ARCHITECTS

PENSHURST PUBLIC SCHOOL
18 Arcadia Street, Penshurst

DRAWING NAME
FINISHES PLAN - LEVEL 2 - PART 1

CONTRACT NUMBER
SINSW-18-1257

PROJECT NORTH

0 1000 2000 3000 4000 5000 10000
SCALE 1 : 100 @ A1

DRAWN	CHECKED	VERIFIED	DATE
Author	Checker	Approver	12 NOVEMBER 2019

DRAWING NUMBER | REVISION

PROJECT CODE | DISCIPLINE | PHASE | SERIES NUMBER

3199-ARC-CD-01_421 | 02

FOR CONTINUATION REFER TO 01_422

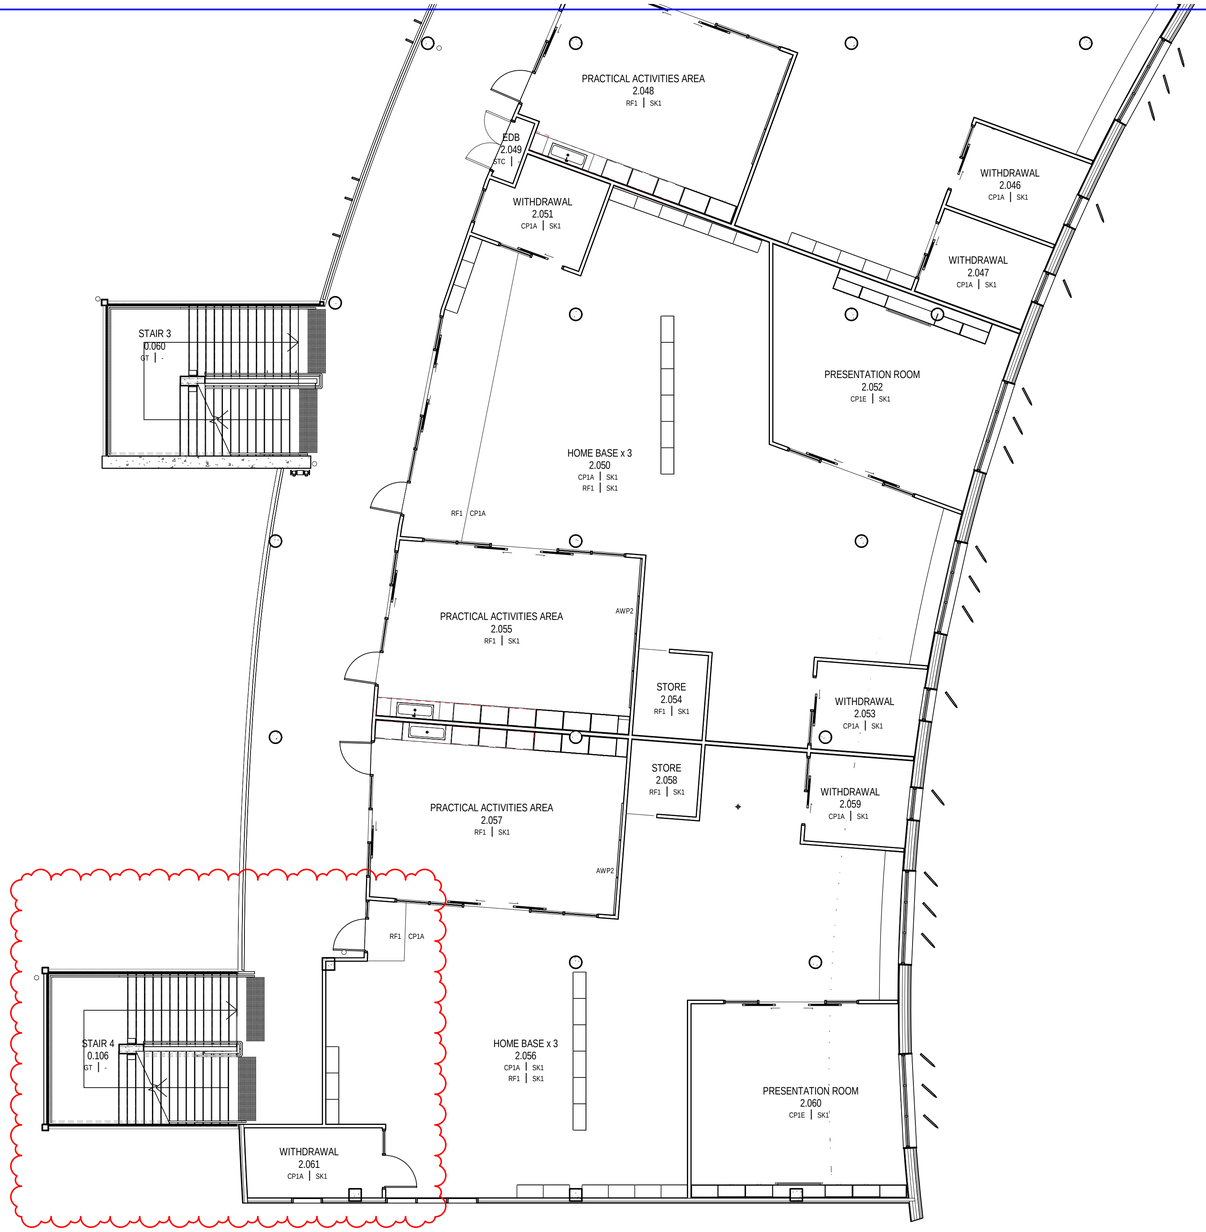

NSW GOVERNMENT | Planning, Industry & Environment

Issued under the Environmental Planning and Assessment Act 1979

Approved Section: 4.55(1A) Application No: SSD-8365-Mod-1

Granted on: 6 April 2020 Sheet no: 24 of 35 Signed:

13/11/2019 10:39:43 AM

ISSUED FOR S4.55(1A)

AMENDMENTS

REV	BY	DATE	DESCRIPTION
	MW	20.07.18	PROGRESS ISSUE
	MW	10.08.18	PROGRESS ISSUE
	MW	17.08.18	FOR REVIEW
A	MW	31.08.18	ISSUED FOR TENDER
B	MW	08.04.19	GENERAL UPDATE. ISSUED FOR REVIEW
C	MW	18.04.19	GATEWAY 4 REVIEW
01	RO	17.05.19	ISSUE FOR CONSTRUCTION
02	MW	16.10.19	ADD STAIR 04 & AMEND HOMEBASE. ISSUED FOR S4.55(1A)

LEGEND

KEY PLAN

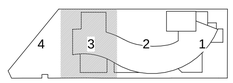

NSW GOVERNMENT Education

STRUCTURE, CIVIL & HYDRAULIC
WOOLACOTTS ENGINEERS
T: 02 8203 1500

MECH, ELECT, IT, COMMS & SEC.
JHA CONSULTING
T: 02 9437 1000

BCA
GROUP DLA
T: 02 8355 3160

LANDSCAPE
LORNA HARRISON P/L
T: 02 9555 1147

PERUMAL PEDAVOLI ARCHITECTS
T: 02 9291 0000
WEB: www.pp-a.com.au
Nominated Architect:
Vince Pedavoli NSW reg No.5045

STATUTORY PLANNER
DON FOX PLANNING P/L
T: 02 9473 4914

PERUMAL PEDAVOLI ARCHITECTS

PENSHURST PUBLIC SCHOOL
18 Arcadia Street, Penshurst

DRAWING NAME
FINISHES PLAN - LEVEL 2 - PART 3

CONTRACT NUMBER
SINSW-18-1257

PROJECT NORTH

0 1000 2000 3000 4000 5000 10000
SCALE 1 : 100 @ A1

DRAWN	CHECKED	VERIFIED	DATE
Author	Checker	Approver	12 NOVEMBER 2019

DRAWING NUMBER

PROJECT CODE	DISCIPLINE	PHASE	SERIES NUMBER	REVISION
3199	ARC	CD	01_423	02

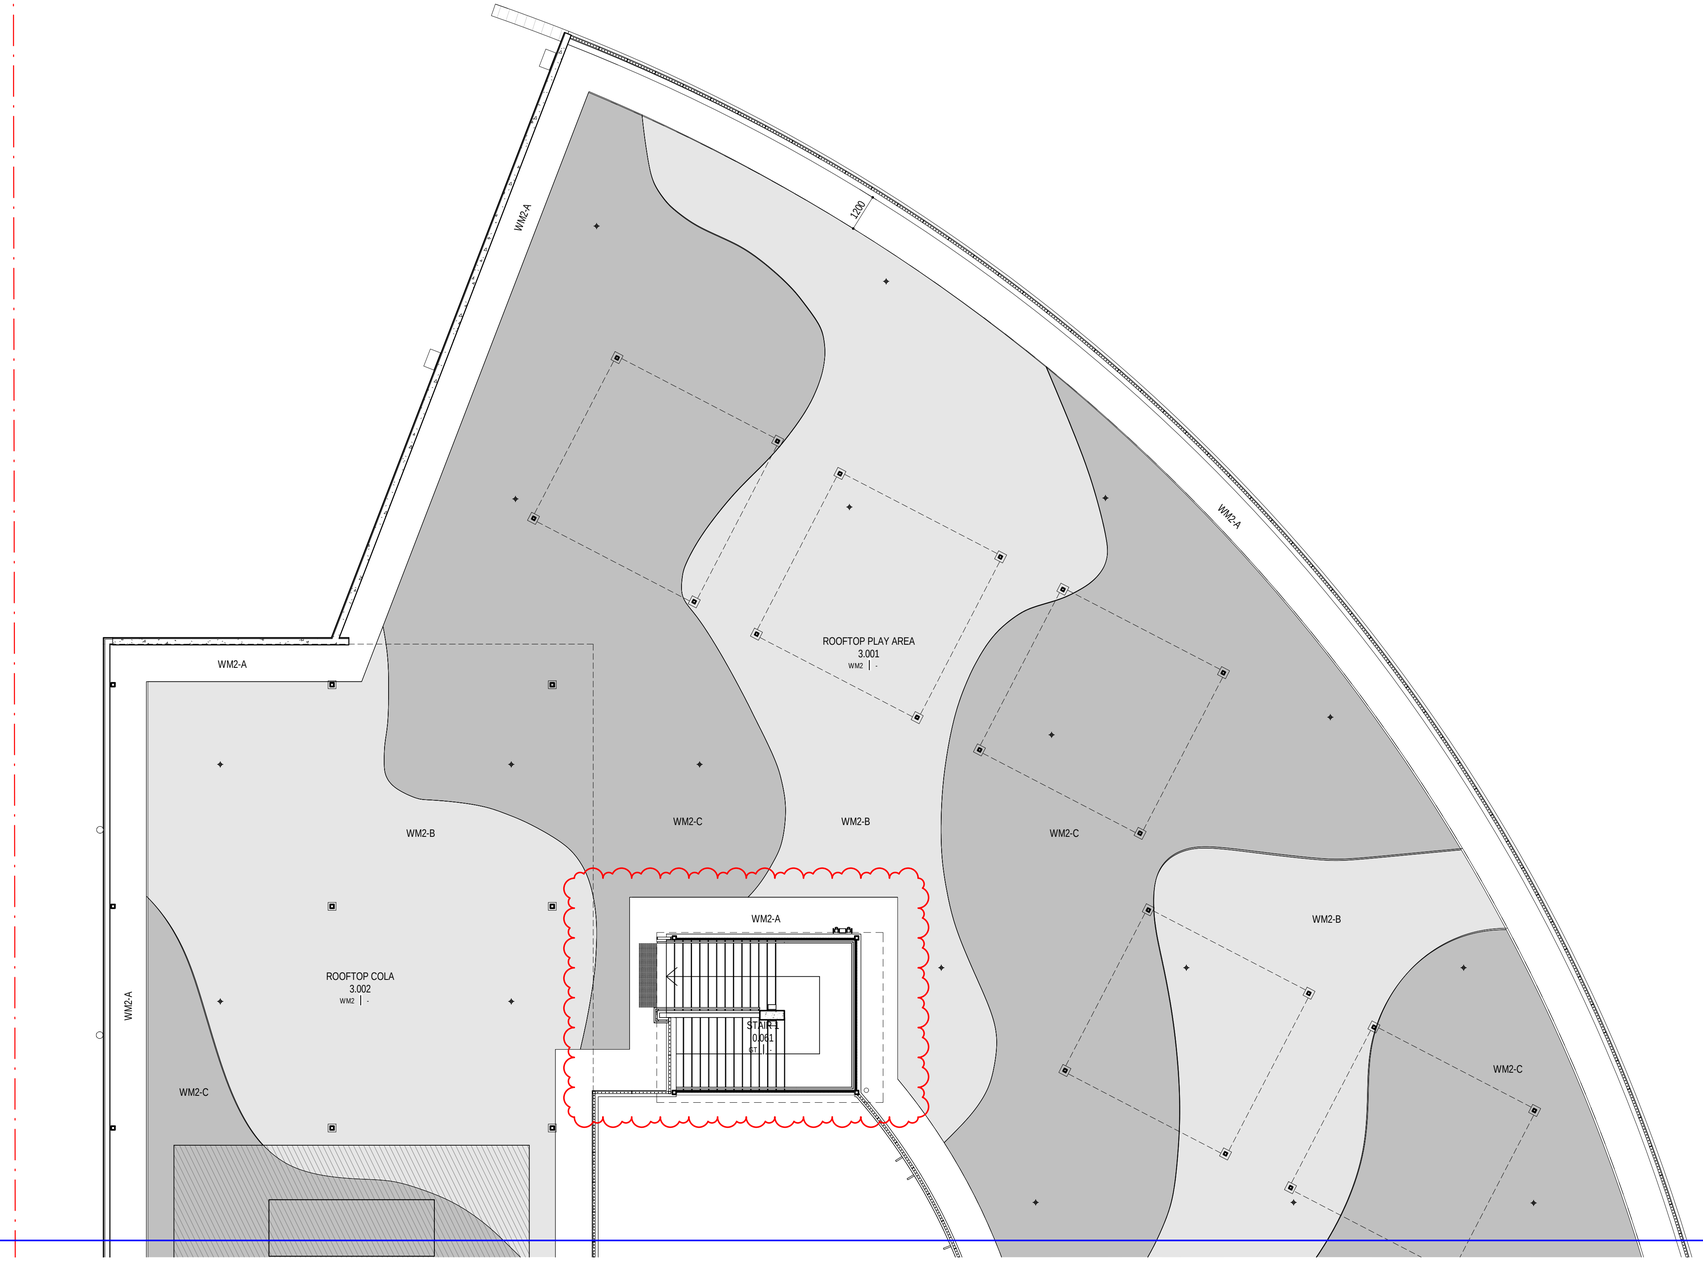

Issued under the Environmental Planning and Assessment Act 1979

Approved Section: 4.55(1A) Application No: SSD-8365-Mod-1

Granted on: 6 April 2020 Sheet no: 25 of 35 Signed:

FOR CONTINUATION REFER TO 01_432

13/11/2019 10:40:23 AM

ISSUED FOR S4.55(1A)

AMENDMENTS

REV	BY	DATE	DESCRIPTION
	MW	20.07.18	PROGRESS ISSUE
	MW	10.08.18	PROGRESS ISSUE
	MW	17.08.18	FOR REVIEW
A	MW	31.08.18	ISSUED FOR TENDER
B	MW	08.04.19	GENERAL UPDATE. ISSUED FOR REVIEW
C	MW	18.04.19	GATEWAY 4 REVIEW
01	RO	17.05.19	ISSUE FOR CONSTRUCTION
02	MW	16.10.19	AMEND STAIR 01 & ROOF OVER WASTE. ISSUED FOR S4.55(1A)

LEGEND

KEY PLAN

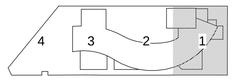

NSW GOVERNMENT Education

STRUCTURE, CIVIL & HYDRAULIC
WOOLACOTTS ENGINEERS
T: 02 8203 1500

MECH, ELECT, IT, COMMS & SEC.
JHA CONSULTING
T: 02 9437 1000

BCA
GROUP DLA
T: 02 8355 3160

LANDSCAPE
LORNA HARRISON P/L
T: 02 9555 1147

PERUMAL PEDAVOLI ARCHITECTS
T: 02 9291 0000
WEB: www.pp-a.com.au
Nominated Architect:
Vince Pedavoli NSW reg No.5045

STATUTORY PLANNER
DON FOX PLANNING P/L
T: 02 9473 4914

PERUMAL PEDAVOLI ARCHITECTS

PENSHURST PUBLIC SCHOOL
18 Arcadia Street, Penshurst

DRAWING NAME
FINISHES PLAN - LEVEL 3 - PART 1

CONTRACT NUMBER
SINSW-18-1257

PROJECT NORTH

0 1000 2000 3000 4000 5000 10000
SCALE 1 : 100 @ A1

DRAWN	CHECKED	VERIFIED	DATE
Author	Checker	Approver	12 NOVEMBER 2019

DRAWING NUMBER
PROJECT CODE DISCIPLINE PHASE SERIES NUMBER
3199-ARC-CD-01_431

REVISION
02

FOR CONTINUATION REFER TO 01_432

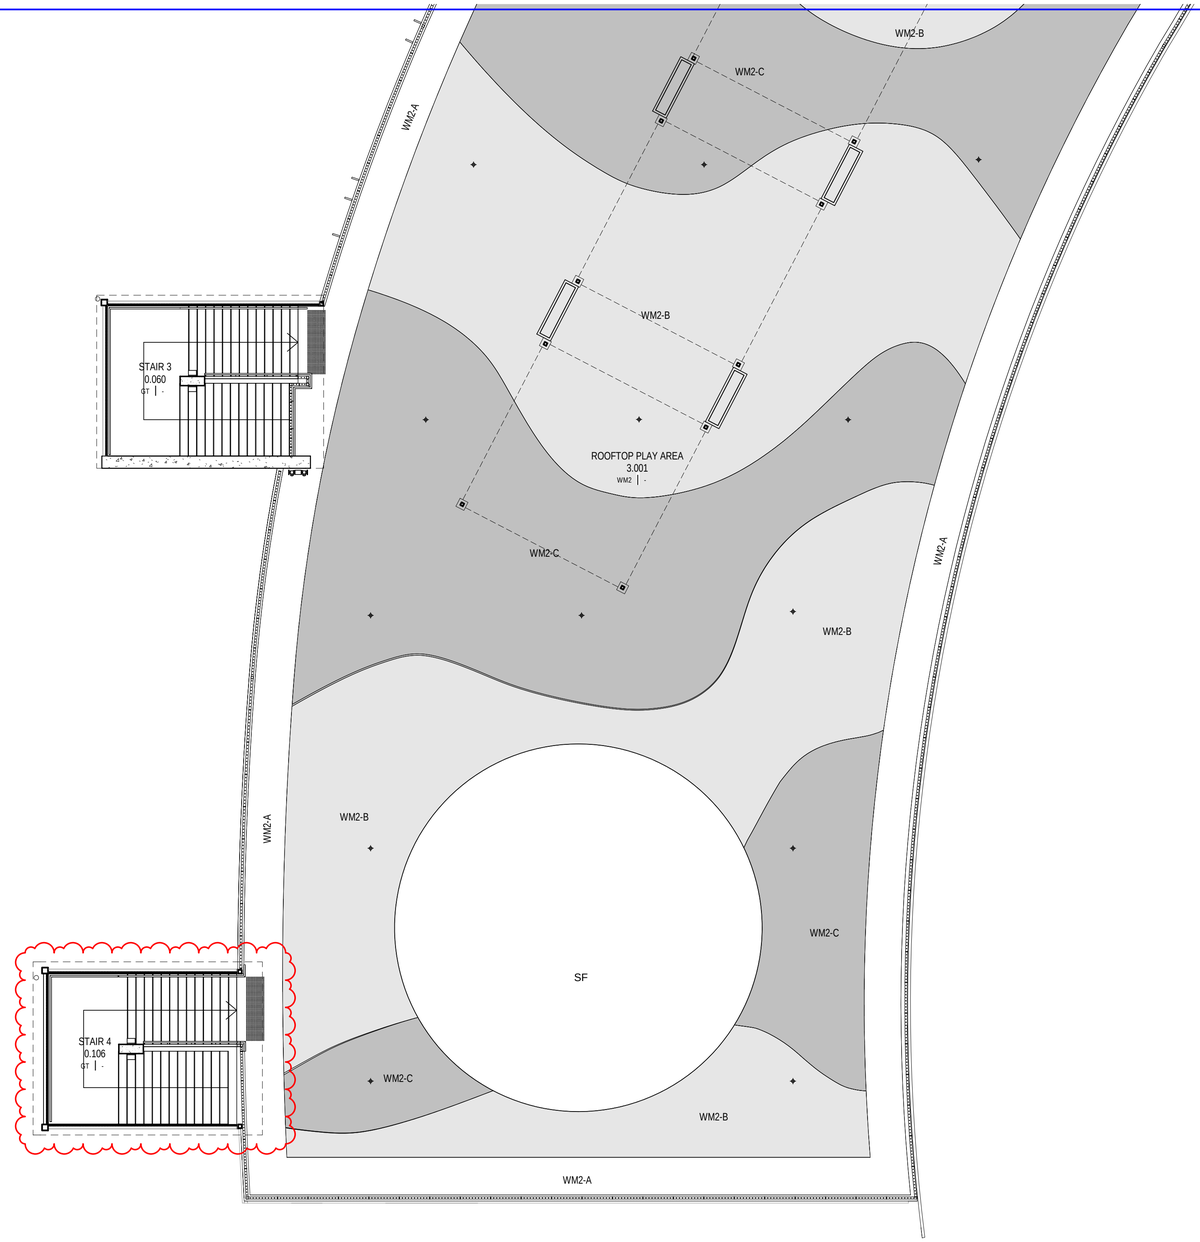

NSW GOVERNMENT | Planning, Industry & Environment

Issued under the Environmental Planning and Assessment Act 1979

Approved Section: 4.55(1A) Application No: SSD-8365-Mod-1

Granted on: 6 April 2020 Sheet no: 26 of 35 Signed:

13/11/2019 10:41:03 AM

ISSUED FOR S4.55(1A)

AMENDMENTS

REV	BY	DATE	DESCRIPTION
	MW	20.07.18	PROGRESS ISSUE
	MW	10.08.18	PROGRESS ISSUE
	MW	17.08.18	FOR REVIEW
A	MW	31.08.18	ISSUED FOR TENDER
B	MW	08.04.19	GENERAL UPDATE. ISSUED FOR REVIEW
C	MW	18.04.19	GATEWAY 4 REVIEW
01	RO	17.05.19	ISSUE FOR CONSTRUCTION
02	MW	16.10.19	ADD STAIR 04 & AMEND HOMEBASE. ISSUED FOR S4.55(1A)

LEGEND

KEY PLAN

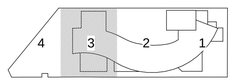

NSW GOVERNMENT | Education

STRUCTURE, CIVIL & HYDRAULIC
WOOLACOTTS ENGINEERS
T: 02 8203 1500

MECH, ELECT, IT, COMMS & SEC.
JHA CONSULTING
T: 02 9437 1000

BCA
GROUP DLA
T: 02 8355 3160

LANDSCAPE
LORNA HARRISON P/L
T: 02 9555 1147

PERUMAL PEDAVOLI ARCHITECTS
T: 02 9291 0000
WEB: www.pp-a.com.au
Nominated Architect:
Vince Pedavoli NSW reg No.5045

STATUTORY PLANNER
DON FOX PLANNING P/L
T: 02 9473 4914

PERUMAL PEDAVOLI ARCHITECTS

PENSHURST PUBLIC SCHOOL
18 Arcadia Street, Penshurst

DRAWING NAME
FINISHES PLAN - LEVEL 3 - PART 3

CONTRACT NUMBER
SINSW-18-1257

PROJECT NORTH

0 1000 2000 3000 4000 5000 10000
SCALE 1 : 100 @ A1

DRAWN	CHECKED	VERIFIED	DATE
Author	Checker	Approver	12 NOVEMBER 2019

DRAWING NUMBER

REVISION

PROJECT CODE	DISCIPLINE	PHASE	SERIES NUMBER	
3199	ARC	CD	01_433	02

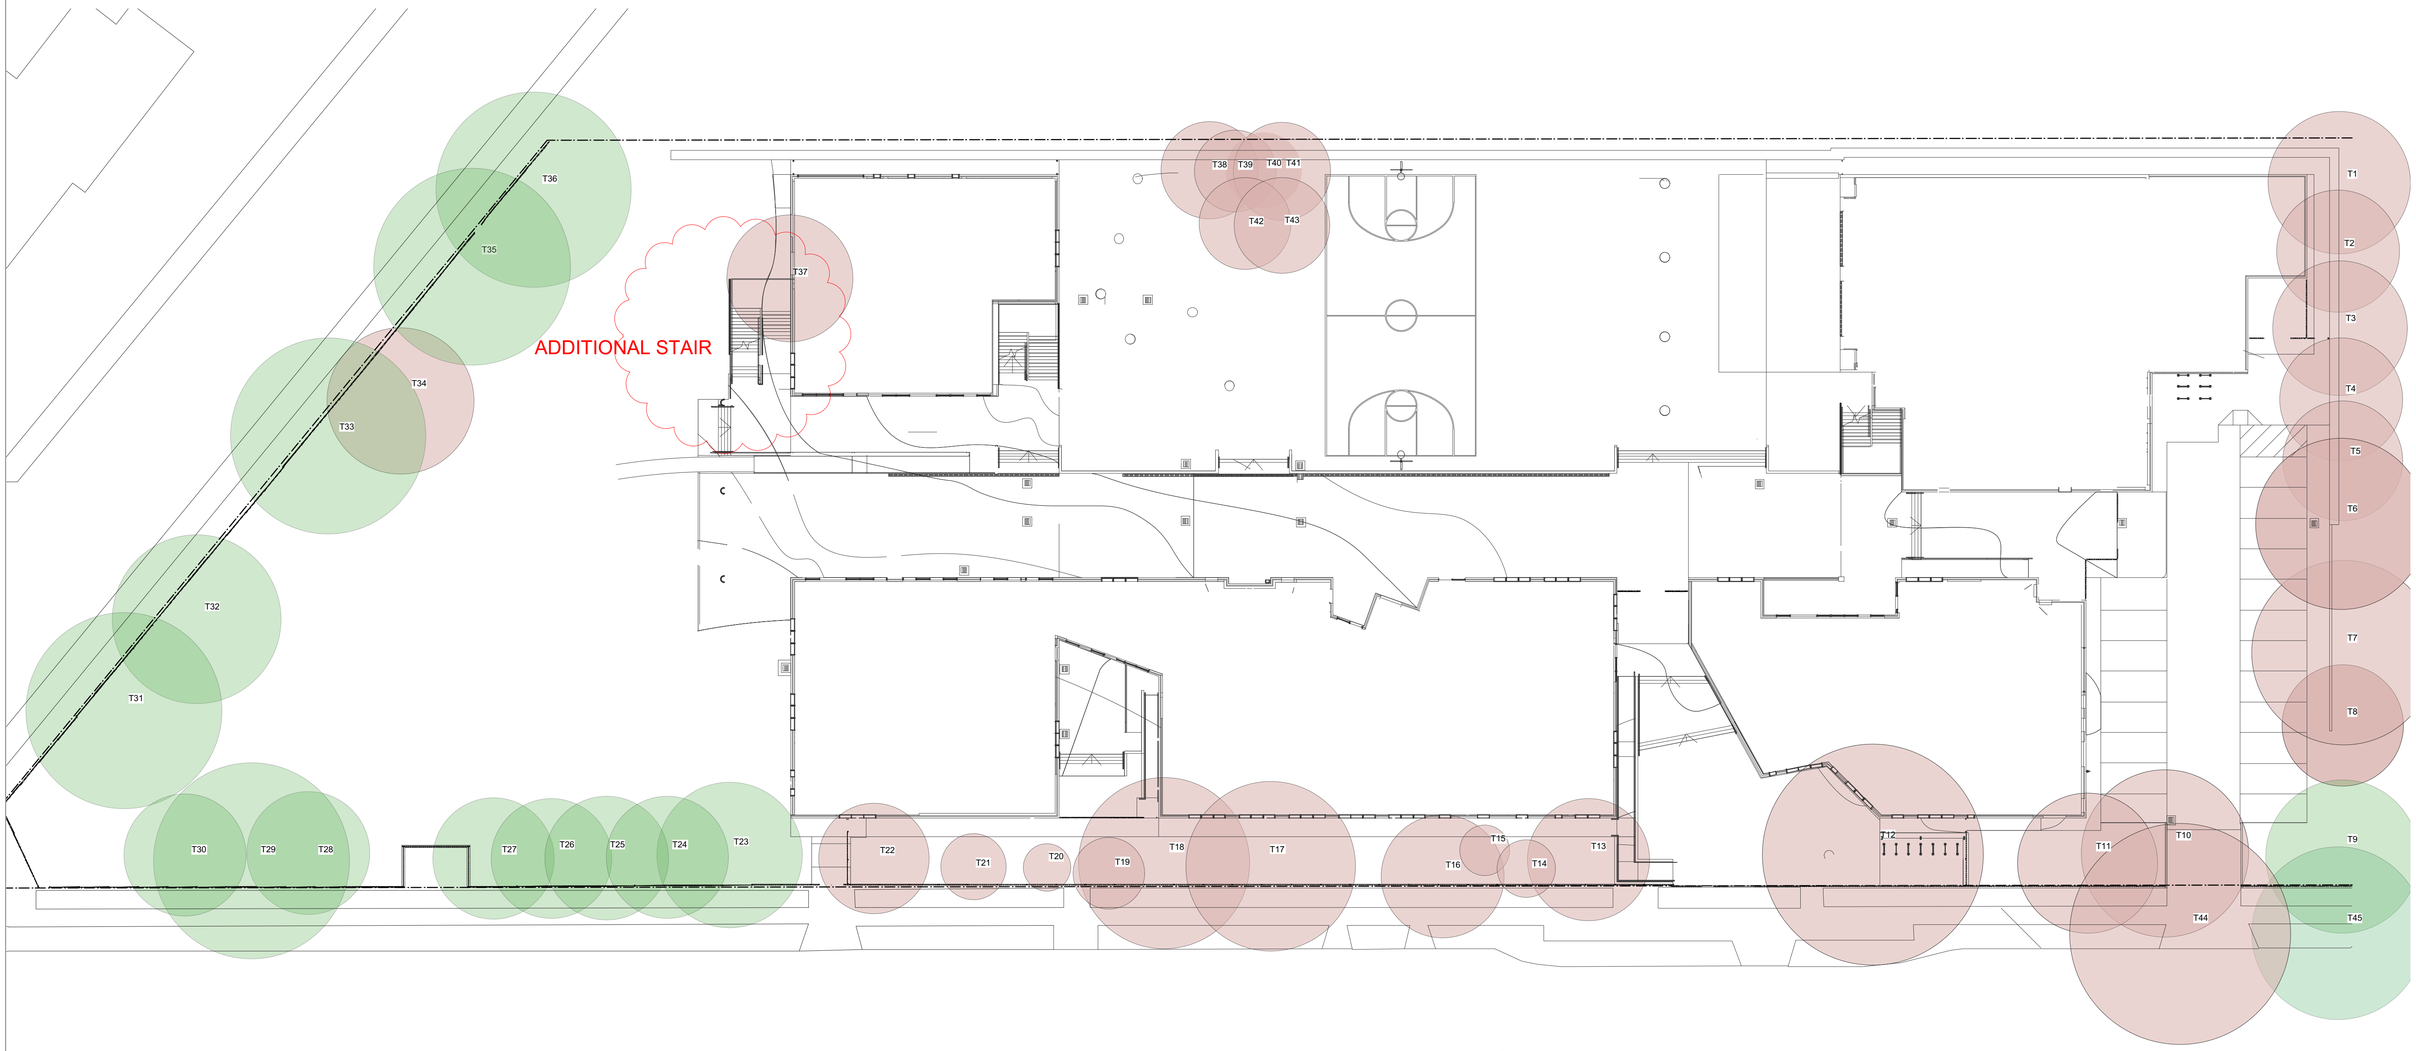

TREES RETAINED

09	Lophostemon confertus	Brush Box
23	Lophostemon confertus	Brush Box
24	Lophostemon confertus	Brush Box
25	Lophostemon confertus	Brush Box
26	Lophostemon confertus	Brush Box
27	Lophostemon confertus	Brush Box
28	Lophostemon confertus	Brush Box
29	Lophostemon confertus	Brush Box
30	Lophostemon confertus	Brush Box
31	Lophostemon confertus	Brush Box
32	Lophostemon confertus	Brush Box
33	Ficus rubiginosa	Port Jackson Fig
35	Cinnamomum camphora	Camphor Laurel
36	Ficus rubiginosa	Port Jackson Fig
45	Eucalyptus microcorys	Tallowood

TREES TO BE REMOVED

01	Lophostemon confertus	Brush Box
02	Lophostemon confertus	Brush Box
03	Lophostemon confertus	Brush Box
04	Lophostemon confertus	Brush Box
05	Lophostemon confertus	Brush Box
06	Lophostemon confertus	Brush Box
07	Lophostemon confertus	Brush Box
08	Lophostemon confertus	Brush Box
10	Lophostemon confertus	Brush Box
11	Lophostemon confertus	Brush Box
12	Lophostemon confertus	Brush Box
13	Pittosporum rhombifolium	Pittosporum
14	Pittosporum rhombifolium	Pittosporum
15	Allocasuarina torulosa	Forest Oak
16	Eucalyptus botryoides	Bangalay
17	Eucalyptus species	Eucalyptus spp

TREES TO BE REMOVED (cont)

18	Corymbia citriodora	Lemon Scented Gun
19	Acacia binervia	Wattle
20	Livistona australis	Cabbage Palm
21	Callistemon viminalis	Bottle Brush
22	Melaleuca linarifolia	Snow in Summer
34	Celtis sinensis	Hackberry
37	Harpephyllum caffrum	Kaffir Plum
38	Casuarina glauca	Swamp Oak
39	Casuarina glauca	Swamp Oak
40	Casuarina glauca	Swamp Oak
41	Casuarina glauca	Swamp Oak
42	Casuarina glauca	Swamp Oak
43	Casuarina glauca	Swamp Oak
44	Eucalyptus microcorys	Tallowood

NSW GOVERNMENT | Planning, Industry & Environment

Issued under the Environmental Planning and Assessment Act 1979

Approved Section: 4.55(1A) Application No: SSD-8365-Mod-1

Granted on: 6 April 2020 Sheet no: 27 of 35 Signed:

PLOT DATE 18/10/19

ISSUED FOR CONSTRUCTION

AMENDMENTS

REV	BY	DATE	DESCRIPTION
1	LH	10/05/2019	ISSUED FOR CONSTRUCTION
2	LH	17/10/19	ISSUED FOR S4.55 (1A).

NSW GOVERNMENT | Education

STRUC, CIVIL & HYD
WOOLACOTTS ENGINEERS
T: 02 82031500

MECH, ELEC, IT, COMMS & SEC.
JHA CONSULTING
T: 02 9437 1000

BCA
GROUP DLA
T: 02 8355 3160

STATUTORY PLANNER
DON FOX PLANNING P/L
T: 02 9473 4914

PERUMAL PEDAVOLI ARCHITECTS
T: +61 2 9291 0000
WEB: www.pp-a.com.au
Nominated Architect:
Vince Pedavoli NSW reg No. 5045

CONTRACT NUMBER
SINSW-18-1257

LORNA HARRISON
LANDSCAPE ARCHITECTS
68 Beattie Street
BALMAIN
NSW 2041
M 0403350023
E lorna@landarchitects.com

PENSHURST PUBLIC SCHOOL

18 Arcadia Street, Penshurst

LANDSCAPE SITE PLAN
TREES RETAINED/REMOVED

north

0m 5m 10m 15m 20m 25m

SCALE 1:250@A1

10 May 2019

DRAWING NUMBER				REVISION
PROJECT	DISCIPLINE	PHASE	SERIES NUMBER	
555	LAN	CD	01	2

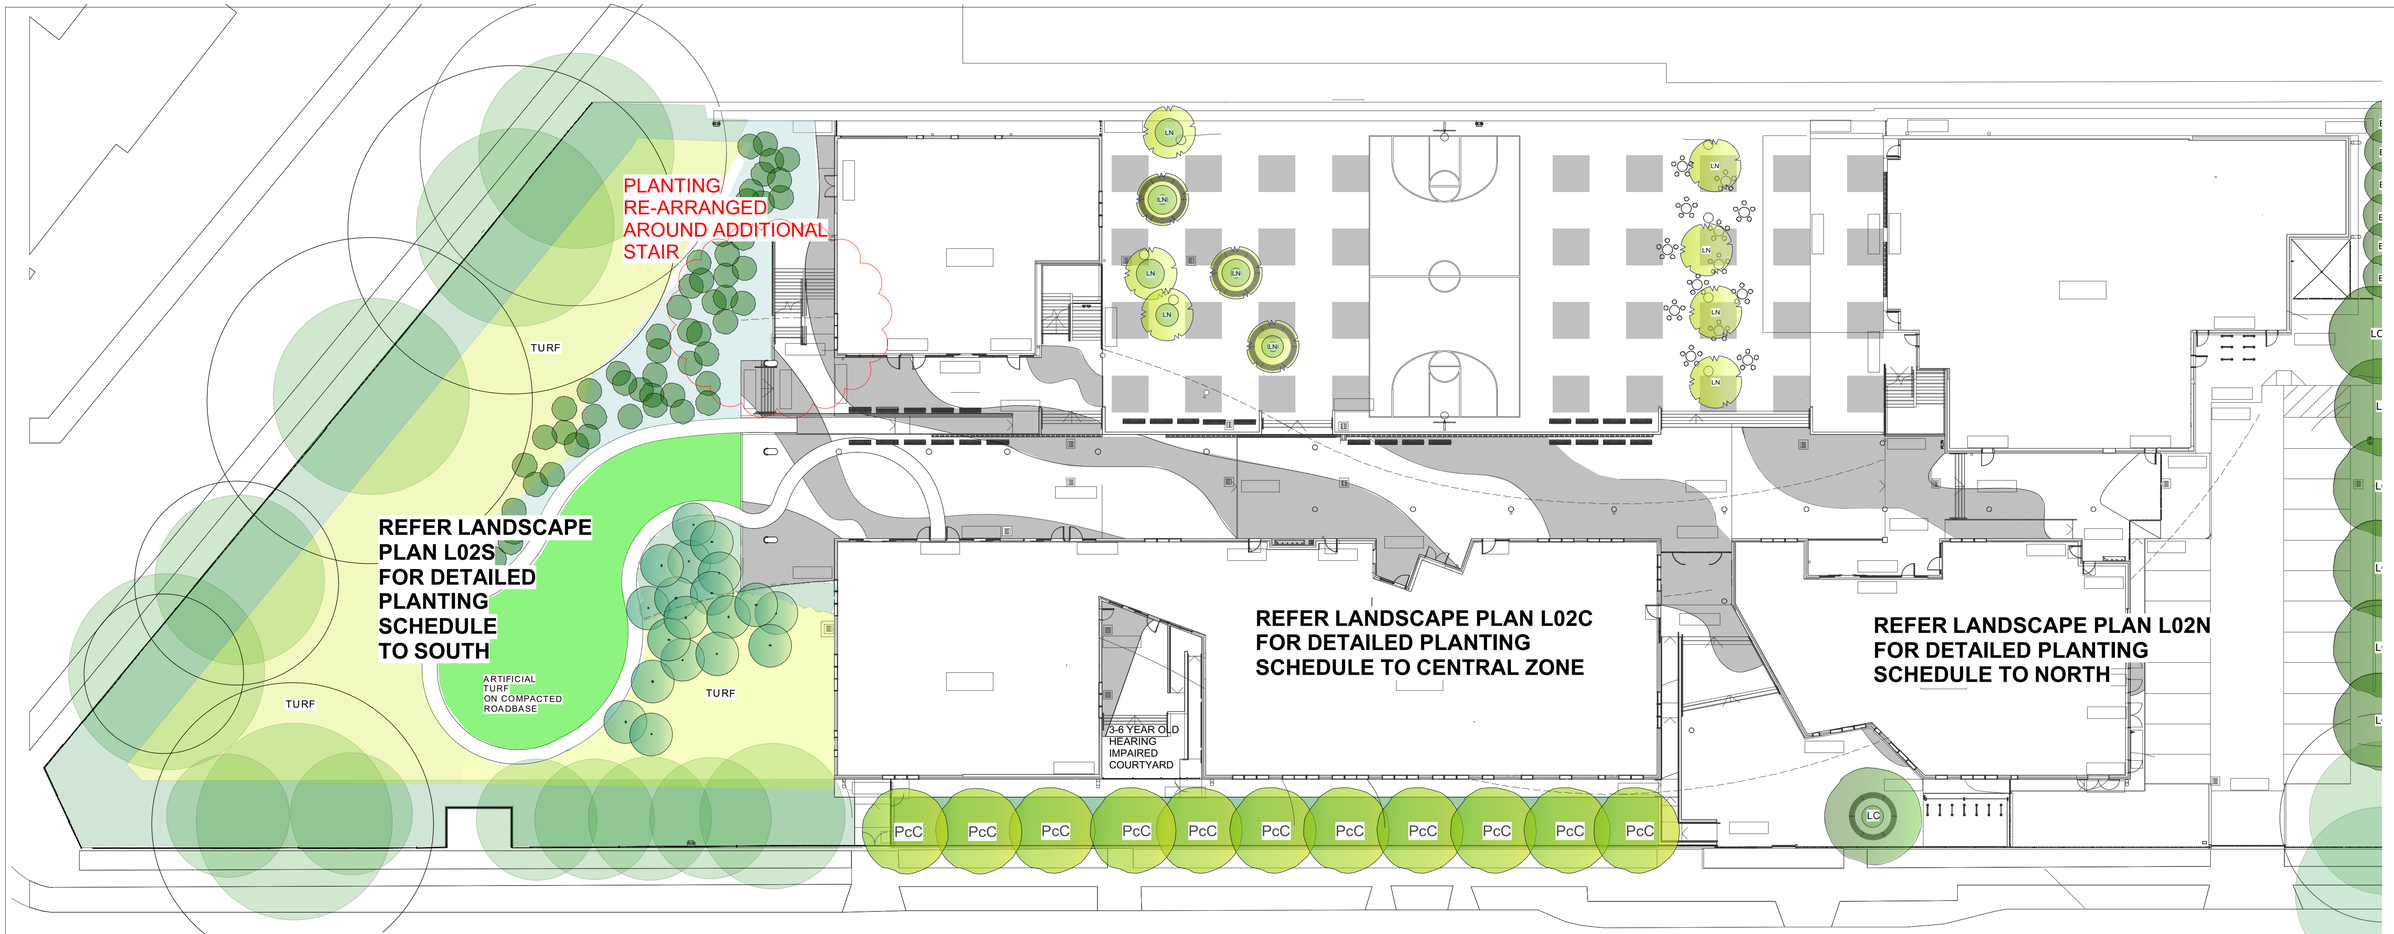

PROPOSED PLANTING SCHEDULE
TOTAL PROJECT

BOTANICAL NAME	COMMON NAME	MATURE H x W	INSTALL POT SIZE	NO OFF
ARCADIA STREET DECIDUOUS TREES				
Pyrus calleryana `Cleveland Street'	Pear Tree 'Cleveland Street'	11 x 3-6	400 litre	11
ARCADIA STREET EVERGREEN TREE		8 x 8	400 litre	1
Lophostemon confertus	Brush Box			
EVERGREEN TREES TO NORTH WEST BOUNDARY				
Lophostemon confertus		8 x 8	400 litre	6
Elaeocarpus reticulatus	Brush Box Bluenerry Ash	5 x 4	200 litre	6
MEDIUM SCALE FLOWERING TREE TO CENTRAL COURTYARD		7 x 5	200 litre	10
Lagerstroemia `Natchez'	Crepe Myrtle			
PAPERBARK`FOREST'		8 x 5	100 litre	5
Melalecua decora	White Cloud Tree	8 x 5	100 litre	5
Melaleuca linariifolia	Snow in Summer	6 x 3	100 litre	15
Melaleuca quinquenervia	Prickly Paperbarxk	7 x 5	100 litre	5
Melaleuca styphelioides	Broad Leaved Paperbark			
EVERGREEN NATIVE TREES				
Backhousia myrtifolia		5 x 2	100 litre	3
Cupaniopsis ancardioides	Cinnamon Myrtle	8 x 6	100 litre	7
Hymenosporum flavum	Tuckeroo	5 x 4	100 litre	3
Tristaniopsis `Luscious'	Native frangipani Water Gum	7 x 7	100 litre	6
MULCHED MASS PLANTING - SHRUBS				
Callistemon spp		1 x 1	200mm	130
Grevillea spp	Bottlebrush	1 x 1	200mm	130
Westringia spp	Grevillea Coastal Rosemary spp	1 x 1	200mm	196
GRASSES + CLUMPING PLANTS				
Dianella `LIttle Jess'		600 x 400	150mm	840
Doryanthes excelsa	Blue Flax Grass	1 x 1	25 litre	25
Liriope `Just Right'	Gymea Lily	200 x 300	150mm	200
Lomandra longifolia	Liriope	1 x 1	150mm	65
Lomandra `Shara'	Spiny Mat rush	600 x 600	150mm	1686
Lomandra `Tanika'	Lomandra `Shara' Tanika	400x 400	150mm	243
GROUND COVERS		400 x 600	150mm	100
Acacia cognate `Limelight'	Wattle			
CLIMBERS		-	200mm	29
Solanum jasminoides	Potatoe Vince	-	200mm	29
Tracehslospermum jasminoides	Star Jasmine	-	200mm	29
Pandorea jasminoides	Bower Vine			

LEGEND

EXISTING TREES TO BE RETAINED

WETLAND GRASSES PLANTED INTO BANKS AND DRAINAGE SWALE INTO EROSION CONTROL FABRIC

NATURAL TURF ON GRADE

STREET FURNITURE AUSTRALIA CURVED BENCH SEATING

STREET FURNITURE AUSTRALIA METAL CAFE TABLES AND STOOLS FOR OUTDOOR EATING/GATHERING

3-6 YEARS HEARING IMPAIRED COURTYARD: ARTIFICIAL TURF

NSW GOVERNMENT Planning, Industry & Environment

Issued under the Environmental Planning and Assessment Act 1979

Approved Section: 4.55(1A) Application No: SSD-8365-Mod-1

Granted on: 6 April 2020 Sheet no: 28 of 35 Signed:

ISSUED FOR CONSTRUCTION

PLOT DATE 18/10/19

AMENDMENTS

REV	BY	DATE	DESCRIPTION
1	LH	10/05/2019	ISSUED FOR CONSTRUCTION
2	LH	17/10/19	ISSUED FOR S4.55 (1A).

NSW GOVERNMENT Education

STRUC, CIVIL & HYD
WOOLACOTTS ENGINEERS
T: 02 82031500

MECH, ELEC, IT, COMMS & SEC.
JHA CONSULTING
T: 02 9437 1000

BCA
GROUP DLA
T: 02 8355 3160

STATUTORY PLANNER
DON FOX PLANNING P/L
T: 02 9473 4914

PERUMAL PEDAVOLI ARCHITECTS
T: +61 2 9291 0000
WEB: www.pp-a.com.au
Nominated Architect:
Vince Pedavoli NSW reg No. 5045

CONTRACT NUMBER
SINSW-18-1257

LORNA HARRISON
LANDSCAPE ARCHITECTS
68 Beattie Street
BALMAIN
NSW 2041
M 0403350023
E lorna@landarchitects.com

PENSHURST PUBLIC SCHOOL

18 Arcadia Street, Penshurst

LANDSCAPE SITE PLAN
GROUND LEVEL

north

0m 5m 10m 15m 20m 25m

SCALE 1:250@A1

10 MAY 2019

DRAWING NUMBER				REVISION
PROJECT	DISCIPLINE	PHASE	SERIES NUMBER	
555	LAN	CD	02	2

PROPOSED PLANTING SCHEDULE
THIS SHEET

BOTANICAL NAME	COMMON NAME	MATURE H x W	INSTALL POT SIZE	NO OFF
PAPERBARK`FOREST'				
Melalecua decora	White Cloud Tree	8 x 5	100 litre	5
Melaleuca linariifolia	Snow in Summer	8 x 5	100 litre	5
Melaleuca quinquenervia	Prickly Paperbarxk	6 x 3	100 litre	15
Melaleuca styphelioides	Broad Leaved Paperbark	7 x 5	100 litre	5
EVERGREEN NATIVE TREES				
Backhousia myrtifolia	Cinnamon Myrtle	5 x 2	100 litre	3
Cupaniopsis ancardioides	Tuckeroo	8 x 6	100 litre	7
Hymenosporum flavum	Native frangipani	5 x 4	100 litre	3
Tristaniopsis `Luscious'	Water Gum	7 x 7	100 litre	6
MULCHED MASS PLANTING - SHRUBS				
Callistemon spp	Bottlebrush	1 x 1	200mm	150
Grevillea spp	Grevillea	1 x 1	200mm	150
GRASSES + CLUMPING PLANTS				
Dianella spp	Blue Flax Grass	600 x 400	150mm	90
Doryanthes excelsa	Gymea Lily	1 x 1	25 litre	25
Liriope `Just Right'	Liriope	200 x 300	150mm	100
Lomandra `Tanika'	Lomandra `Tanika'	600 x 600	150mm	100
Lomandra `Shara'	Lomandra `Shara'	600 x 600	150mm	1686
GROUND COVERS				
Acacia cognate `Limelight'	Wattle	400 x 600	150mm	150

Planning, Industry & Environment
NSW GOVERNMENT
Issued under the Environmental Planning and Assessment Act 1979
Approved Section: 4.55(1A) Application No: SSD-8365-Mod-1
Granted on: 6 April 2020 Sheet no: 29 of 35 Signed:

PLOT DATE 18/10/19

ISSUED FOR CONSTRUCTION

AMENDMENTS

REV	BY	DATE	DESCRIPTION
1	LH	10/05/2019	ISSUED FOR CONSTRUCTION
2	LH	17/10/19	ISSUED FOR S4.55 (1A).

NSW GOVERNMENT Education

STRUC, CIVIL & HYD
WOOLACOTTS ENGINEERS
T: 02 82031500

MECH, ELEC, IT, COMMS & SEC.
JHA CONSULTING
T: 02 9437 1000

BCA
GROUP DLA
T: 02 8355 3160

STATUTORY PLANNER
DON FOX PLANNING P/L
T: 02 9473 4914

PERUMAL PEDAVOLI ARCHITECTS
T: +61 2 9291 0000
WEB: www.pp-a.com.au
Nominated Architect:
Vince Pedavoli NSW reg No. 5045

CONTRACT NUMBER
SINSW-18-1257

LORNA HARRISON
LANDSCAPE ARCHITECTS
68 Beattie Street
BALMAIN
NSW 2041
M 0403350023
E lorna@landarchitects.com

PENSHURST PUBLIC SCHOOL

18 Arcadia Street, Penshurst

LANDSCAPE SITE PLAN
GROUND LEVEL SOUTH

north

0m 5m 10m 15m 20m 25m

SCALE 1:200@A1

10 MAY 2019

DRAWING NUMBER				REVISION
PROJECT	DISCIPLINE	PHASE	SERIES NUMBER	
555	LAN	CD	02_S	2

CONSTRUCTION ISSUE

PENSHURST PUBLIC SCHOOL UPGRADE

CIVIL ENGINEERING DRAWINGS

GENERAL NOTES

G1 THESE DRAWINGS SHALL BE READ IN CONJUNCTION WITH ALL OTHER CONSULTANTS DRAWINGS, SPECIFICATIONS AND AS1100 TECHNICAL DRAWING.

G2 ANY DISCREPANCIES SHALL BE REFERRED TO THE CONTRACT ADMINISTRATOR FOR DECISION BEFORE PROCEEDING WITH THE WORK.

G3 DIMENSIONS SHALL NOT BE OBTAINED BY SCALING THE DRAWINGS.

G4 ANY SET OUT DIMENSIONS SHOWN ON THE DRAWING SHALL BE VERIFIED BY THE BUILDER.

G5 DURING CONSTRUCTION THE CONTRACTOR SHALL MAINTAIN THE WORKS IN A STABLE CONDITION AND NO PART SHALL BE OVERSTRESSED.

G6 ALL WORK SHALL COMPLY WITH THE BUILDING CODE OF AUSTRALIA, CONDITIONS OF THE DEVELOPMENT CONSENT AND RELEVANT AUSTRALIAN STANDARD CODES.

COMPACTION DENSITY NOTES

CD1 FILLING 98% STANDARD (AS1289 TEST 5.1.1)

CD2 COHESIVE SUBGRADE 98% STANDARD (AS1289 TEST 5.1.1)
COHESIONLESS SUBGRADE 80% (AS1289 TEST 5.6.1)

CD3 SUB BASECOURSE 95% MODIFIED (AS1289 TEST 5.2.1)

CD4 BASECOURSE 98% MODIFIED (AS1289 TEST 5.2.1)

EROSION CONTROL NOTES

E1 INSTALL SILT FENCES ON LOW SIDE OF SITE AND AS REQUIRED BY LOCAL COUNCIL PRIOR TO COMMENCEMENT OF TOPSOIL STRIPPING.

E2 INSTALL DRAINAGE SYSTEM AND SILT FENCES AROUND PITS AS SOON AS PRACTICABLE.

E3 REINSTATE GRASS COVER AS SOON AS PRACTICABLE.

DRAINAGE NOTES

D1 ALL WORKS SHALL BE IN ACCORDANCE WITH AS3500.3

D2 FOR PIPE DIAMETERS NOT EXCEEDING 150mm, USE:
- VITRIFIED CLAY PIPE TO AS1741 OR
- SEWER GRADE UPVC TO AS1260 OR
- CLASS 2 FIBRE REINFORCED CONCRETE TO AS4139

D3 FOR PIPE DIAMETERS EXCEEDING 150mm, USE:
- CLASS 2 REINFORCED CONCRETE PIPE TO AS4058 OR
- CLASS 2 FIBRE REINFORCED CONCRETE PIPE TO AS4139
UNLESS NOTED OTHERWISE ON PLAN.

D4 PVC PIPES SHALL BE SOLVENT WELDED. ALL OTHER PIPES SHALL BE RUBBER RING JOINTED UNLESS NOTED OTHERWISE.

D5 UNLESS SPECIFIED OTHERWISE, BED & BACKFILL SHALL BE COMPACTED SAND TO 100mm ABOVE THE PIPE. REMAINDER OF BACKFILL SHALL BE COMPACTED EXCAVATED MATERIAL. WHEN UNDER VEHICULAR PAVEMENT, REMAINDER OF BACKFILL SHALL BE COMPACTED BASECOURSE.

D6 LOADS ON PIPES DURING CONSTRUCTION SHALL NOT EXCEED THE REQUIREMENT OF AS3725, OR THE RECOMMENDATIONS OF THE PIPE MANUFACTURER.

D7 TRENCH WIDTHS SHALL BE IN ACCORDANCE WITH AS3500, BUT NOMINALLY THE GREATER OF 1.5 PIPE DIAMETER OR PIPE DIAMETER PLUS 300.

D8 FOR ROOF DRAINAGE REFER HYDRAULIC ENGINEERS DRAWING.

D9 WSUD FEATURES
- ENVIROPOD INSERTS IN ALL PITS
- GROSS POLLUTANT TRAP VORTSENTRY MODEL H518 OR APPROVED EQUIVALENT.

CONCRETE NOTES

C1 ALL WORKMANSHIP AND MATERIALS SHALL BE IN ACCORDANCE WITH AS3600 CURRENT EDITION WITH AMENDMENTS, EXCEPT WHERE VARIED BY THE CONTRACT DOCUMENTS.

C2 CONCRETE QUALITY - AS NOTED BELOW.
PROJECT ASSESSMENT OF STRENGTH GRADE SHALL BE USED.

CONCRETE QUALITY				
ELEMENT	Strength Grade	Slump mm	Max. Agg. mm	Cement Type
KERBS AND FOOTINGS	N25	80	20	GP
VEHICULAR PAVEMENT	N40	80	20	GP
REMAINDER	N32	80	20	GP

C3 CLEAR COVER OF REINFORCEMENT SHALL BE AS NOTED ON THE DRAWINGS. REINFORCEMENT SHALL BE RIGIDLY SUPPORTED TO MAINTAIN SPECIFIED COVER DURING CONSTRUCTION.

C4 SIZES OF CONCRETE ELEMENTS DO NOT INCLUDE THICKNESS OF APPLIED FINISH.

C5 CONSTRUCTION JOINTS WHERE NOT SHOWN SHALL BE LOCATED TO THE APPROVAL OF THE CONTRACT ADMINISTRATOR.

C6 CONDUITS, PIPES ETC., SHALL ONLY BE LOCATED IN THE MIDDLE ONE THIRD OF SLAB DEPTH. (UNLESS NOTED OTHERWISE.)

C7 REINFORCEMENT SYMBOLS:
R - GRADE 250 PLAIN BAR IN ACCORDANCE WITH AS1302
N - GRADE 500 DEFORMED BAR DUCTILITY CLASS N (D500N) IN ACCORDANCE WITH AS/NZS4671 WITH A CARBON EQUIVALENT (CE) LIMIT OF 0.39 MAX.
SL - GRADE 500 SQUARE WELDED FABRIC, DEFORMED BARS DUCTILITY CLASS L (D500L) IN ACCORDANCE WITH AS/NZS4671.
RL - GRADE 500 RECTANGULAR WELDED FABRIC, DEFORMED BARS DUCTILITY CLASS L (D500L) IN ACCORDANCE WITH AS/NZS4671.

C8 REINFORCEMENT IS REPRESENTED DIAGRAMMATICALLY; IT IS NOT NECESSARILY SHOWN IN TRUE PROJECTION.

C9 SPLICES IN REINFORCEMENT SHALL BE MADE ONLY IN THE POSITIONS SHOWN. OBTAIN APPROVAL FROM THE CONTRACT ADMINISTRATOR FOR ANY OTHER SPLICES.

C10 WELDING OF REINFORCEMENT SHALL NOT BE PERMITTED UNLESS SHOWN ON THE STRUCTURAL DRAWINGS.

C11 FABRIC SHALL BE LAPPED 400 mm.

C12 BUNDLED BARS SHALL BE TIED TOGETHER AT 30 BAR DIAMETERS CENTRES WITH 3 WRAPS OF TIE WIRE.

C13 CURE CONCRETE IN ACCORDANCE WITH AS3600. METHOD OF CURING SHALL BE SUBMITTED TO THE CONTRACT ADMINISTRATOR FOR APPROVAL.

C14 WHERE SLABS OR BEAMS BEAR UPON MASONRY OTHER THAN REINFORCED BLOCK WALLS - THE TOP COURSE SHALL BE LEVEL, SMOOTH AND COVERED BY TWO LAYERS OF GALVANISED FLAT STEEL WITH GRAPHITE GREASE BETWEEN LAYERS.

ASPHALTIC CONCRETE PAVEMENT NOTES

AC1 SUB BASECOURSE MATERIAL SHALL BE DGS 40 MATERIAL COMPLYING WITH R.M.S. FORM QA3051.

AC2 BASECOURSE MATERIAL SHALL BE DGB 20 MATERIAL COMPLYING WITH R.M.S. FORM QA3051.

AC3 ASPHALTIC CONCRETE SURFACING SHALL BE SUPPLIED AND LAID IN ACCORDANCE WITH R.M.S. SPECIFICATION R116 & AS 2150 ASPHALTIC PAVING - GUIDE TO GOOD PRACTICE.

MASONRY NOTES

M1 ALL WORKMANSHIP AND MATERIALS SHALL BE IN ACCORDANCE WITH AS3700 CURRENT EDITION WITH AMENDMENTS, EXCEPT WHERE VARIED BY CONTRACT DOCUMENTS.

M2 MASONRY UNITS
MINIMUM CHARACTERISTIC UNCONFINED COMPRESSIVE STRENGTH (f'uc) = 15 MPa.

M3 MORTAR
MINIMUM MORTAR CLASSIFICATION M3

M4 UNLESS NOTED OTHERWISE MASONRY WALLS BUILT AGAINST STEEL OR CONCRETE COLUMNS, WALLS OR BEAMS SHALL BE FIXED TO THOSE ELEMENTS USING 50 mm WIDE x 1.5 mm THICK WITH 50 mm UPTURN GALVANISED STEEL BONDING TIES AT 600 mm MAXIMUM CENTRES, POWER FIXED WITH 3.8 DIA. DRIVE PINS. EMBED EACH TIE A MINIMUM OF 400 mm INTO COURSING OF HOLLOW BLOCKWORK, 300 INTO SOLID BLOCK WORK AND BRICKWORK.

M5 CAVITY AND VENEER TIES TO BE TYPE A, MEDIUM DUTY, SPACED AT 600mm MAX. CTS. (VERTICAL AND HORIZONTAL).
AT EACH SIDE OF COLUMNS AND CONTROL JOINTS, CROSS WALLS, AND AROUND THE PERIMETER OF OPENINGS, PROVIDE TIES AT 300mm MAX. CTS.

M6 CAVITIES IN MASONRY WALLS SHALL BE FILLED WITH MORTAR TO FINISH GROUND LEVEL PRIOR TO BACKFILLING AGAINST WALL. BACKFILLING AND COMPACTION OF FILL MATERIAL AGAINST BRICK WALLS SHALL BE CARRIED OUT SIMULTANEOUSLY ON EACH SIDE OF THE WALL.

M7 REINFORCED CONCRETE BLOCK WALLS SHALL COMPLY WITH THE FOLLOWING:

1. ALL BLOCKS SHALL BE DOUBLE "U" BLOCKS WITH SHALLOW TOP GROOVES FOR REINFORCEMENT.
2. ALL MORTAR DAGS SHALL BE REMOVED BEFORE FILLING CORES WITH GROUT. PROVIDE CLEAN OUT HOLES AT THE BASE OF ALL WALLS AND EACH POUR BREAK.
3. FILL ALL CORES WITH GROUT OF f'c 20 MPa SLUMP 230. 10 mm AGGREGATE SIZE. MINIMUM CEMENT CONTENT = 300kg/m^3.
4. ALL PERPENDS, EXCEPT WHERE REQUIRED FOR WEEPHOLES SHALL BE FULLY FILLED WITH MORTAR.
5. CORE GROUT IS TO BE COMPACTED TO ENSURE COMPLETE FILLING OF ALL CORES.
6. PROVIDE TEMPORARY PROPPING TO WALLS WHERE REQUIRED FOR STABILITY DURING CONSTRUCTION.
7. STARTER BARS SHALL BE ACCURATELY POSITIONED BY TEMPLATES OR SIMILAR MEANS.
8. STARTER BARS SHALL BE TIED TO VERTICAL WALL BARS THROUGH INSPECTION OPENINGS AT THE BASE OF THE WALL AND ALSO ACCURATELY FIXED IN POSITION AT THE TOP BY AN APPROPRIATE METHOD.
9. REINFORCEMENT SHALL BE ACCURATELY PLACED AND FIRMLY HELD IN POSITION TO A TOLERANCE OF ± 10 mm.

EXISTING SERVICES NOTES

ES1 AT START OF PROJECT, IDENTIFY THE LOCATION, TYPE, SIZE AND LEVEL OF ALL SERVICES. ADVISE THE SUPERINTENDENT IMMEDIATELY OF ANY POTENTIAL CLASHES WITH PROPOSED WORKS.

FOUNDATION NOTES

F1 UNLESS NOTED FOOTINGS SHALL BEAR UPON COMPACTED FILL OR VERY STIFF NATURAL CLAY WITH A MINIMUM ALLOWABLE BEARING CAPACITY OF 150KPa REFER TO GEOTECHNICAL REPORT No. 30104Srpt PREPARED BY JK GEOTECHNICS DATED 9TH OF FEBRUARY 2017

F2 FOUNDATION MATERIAL SHALL BE INSPECTED AND APPROVED BY A GEOTECHNICAL ENGINEER FOR THE NOMINATED ALLOWABLE BEARING CAPACITY PRIOR TO COMMENCING FOOTING CONSTRUCTION.

F3 FOOTINGS SHALL BE LOCATED CENTRAL UNDER WALLS AND COLUMNS UNLESS NOTED OTHERWISE.

F4 UNLESS OTHERWISE APPROVED, EXCAVATIONS NEAR NEW OR EXISTING FOOTINGS SHALL NOT BE WITHIN THE FOOTING INFLUENCE LINE.

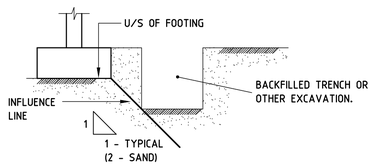

LEGEND

CONCRETE FOOTPATH PAVEMENT:
110mm THICK N32 CONCRETE SLAB
REINFORCED WITH SL72 FABRIC (40 TOP COVER)
ON 100mm COMPACTED DGB20 BASECOURSE MATERIAL
ON COMPACTED SUBGRADE.
CONCRETE FINISH TO LANDSCAPE ARCHITECT'S DETAIL. 04

CONCRETE FOOTPATH PAVEMENT 2:
125mm THICK N32 CONCRETE SLAB
REINFORCED WITH SL82 FABRIC (40 TOP COVER)
ON 100mm COMPACTED DGB20 BASECOURSE MATERIAL
ON COMPACTED SUBGRADE.
CONCRETE FINISH TO LANDSCAPE ARCHITECT'S DETAIL.

HEAVY DUTY CONCRETE PAVEMENT:
180mm THICK N40 CONCRETE SLAB
REINFORCED WITH SL102 FABRIC (40 TOP COVER) ON
100mm DGB20 BASECOURSE MATERIAL ON
COMPACTED SUBGRADE

ASPHALTIC CONCRETE CARPARK PAVEMENT:
40mm AC10 ON
200mm COMPACTED DGB20 BASECOURSE MATERIAL ON
200mm COMPACTED DGS40 SUB-BASECOURSE MATERIAL ON
COMPACTED SUBGRADE.

SYNTHETIC TURF:
50mm THICK SYTHETIC TURF TO LANDSCAPE ARCHITECT'S DETAIL
ON 150mm DGB20 BASECOURSE MATERIAL ON
COMPACTED SUBGRADE

SW EXISTING STORMWATER PIPE

NEW STORMWATER PIPE

SWALE

KR NEW KERB RAMP

K&G NEW KERB & GUTTER

RK ROLLED KERB

KO KERB ONLY

DT DOWNTURN

K&A KERB AND APRON

FK FLUSH KERB

KW KERB RETAINING WALL

WS WHEEL STOP

3.80 PROPOSED SPOT LEVEL

EX 3.80 EXISTING SPOT LEVEL

GD GRATED DRAIN

TOW TOP OF WALL

RW RETAINING WALL

ET EDGE THICKENING 04

NEW GRATED PIT

NEW COVER PIT

k DOWELLED KEY JOINT

pd PLATE DOWEL JOINT

c COLOUR CHANGE JOINT.
DRAWINGS TO BE READ IN CONJUNCTION WITH LANDSCAPE ARCHITECTS PLANS FOR ALL AREAS OF COLOUR CHANGE IN CONCRETE PAVEMENT.

(2E) 2 EXTRA N12 BARS

(2V) 2 EXTRA N12 BARS

CO CLEAR OUT

DP DOWNPIPE

FW FLOOR WASTE

PIPE ENLARGER

DROPPER 03

DRAWING LIST

CIVIL WORKS

3199-CIV-DD-01_001	STANDARD NOTES & DRAWING LIST
3199-CIV-DD-01_002	CIVIL WORKS PLAN
3199-CIV-DD-01_003	LONG SECTION - SHEET 1
3199-CIV-DD-01_004	LONG SECTION - SHEET 2
3199-CIV-DD-01_005	CIVIL WORKS DETAILS - SHEET 1
3199-CIV-DD-01_006	CIVIL WORKS DETAILS - SHEET 2
3199-CIV-DD-01_007	CIVIL WORKS DETAILS - SHEET 3
3199-CIV-DD-01_008	SEDIMENT & EROSION CONTROL PLAN & DETAILS

NSW GOVERNMENT Planning, Industry & Environment

Issued under the Environmental Planning and Assessment Act 1979

Approved Section: 4.55(1A) Application No: SSD-8365-Mod-1

Granted on: 6 April 2020 Sheet no: 30 of 35 Signed:

AMMENDMENTS

REV	BY	DATE	DESCRIPTION
A	SETB	31.08.18	ISSUE FOR TENDER
B	SETB	05.04.19	DRAFT IFC
C	AP	18.04.19	GATEWAY 4 REVIEW - LEGEND UPDATED
01	A.P	10.05.19	ISSUE FOR CONSTRUCTION
02	A.P	21.06.19	CONCRETE PAVEMENT THICKNESS REVISED
03	A.P	16.10.19	DROPPER ADDED TO LEGEND
04	A.P	05.11.19	LEGEND UPDATED

Woolacotts. CONSULTING ENGINEERS
T +61 2 8203 1500 f www.woolacotts.com.au
Ground Floor, 12a Brown Street, Chatswood, NSW 2067

This drawing is copyright and must not be used, reproduced or copied wholly or in part without written permission of Woolacotts Consulting Engineers Pty Ltd.

Job Number	Approved	Verified	Prepared
16-242	SETB 10.05.19	AP 31.08.18	JK 31.08.18

NSW GOVERNMENT Education

STRUCTURE, CIVIL & HYDRAULIC ENGINEERS
WOOLACOTTS ENGINEERS
T: 02 8203 1500

MECH, ELECT, IT, COMMS & SEC.
JHA CONSULTING
T: 02 9437 1000

BCA
GROUP DLA
T: 02 8355 3160

LANDSCAPE
LORNA HARRISON P/L
T: 02 9555 1147

PERUMAL PEDAVOLI ARCHITECTS
T: 02 9291 0000
WEB: www.pp-a.com.au
Nominated Architect:
Vince Pedavoli NSW reg No.5045

STATUTORY PLANNER
DON FOX PLANNING P/L
T: 02 9473 4914

PERUMAL PEDAVOLI ARCHITECTS

PENSHURST PUBLIC SCHOOL
18 Arcadia Street, Penshurst

Drawing Name
STANDARD NOTES AND DRAWING LIST

CONTRACT NUMBER
SINSW-18-1257

PROJECT NORTH

SCALE - @ A1

DRAWN	CHECKED	VERIFIED	Date
			10 MAY 2019

Drawing Number | Revision

PROJECT CODE DISCIPLINE PHASE SERIES NUMBER
3199 - CIV- CD- 01_001 04

CONSTRUCTION ISSUE

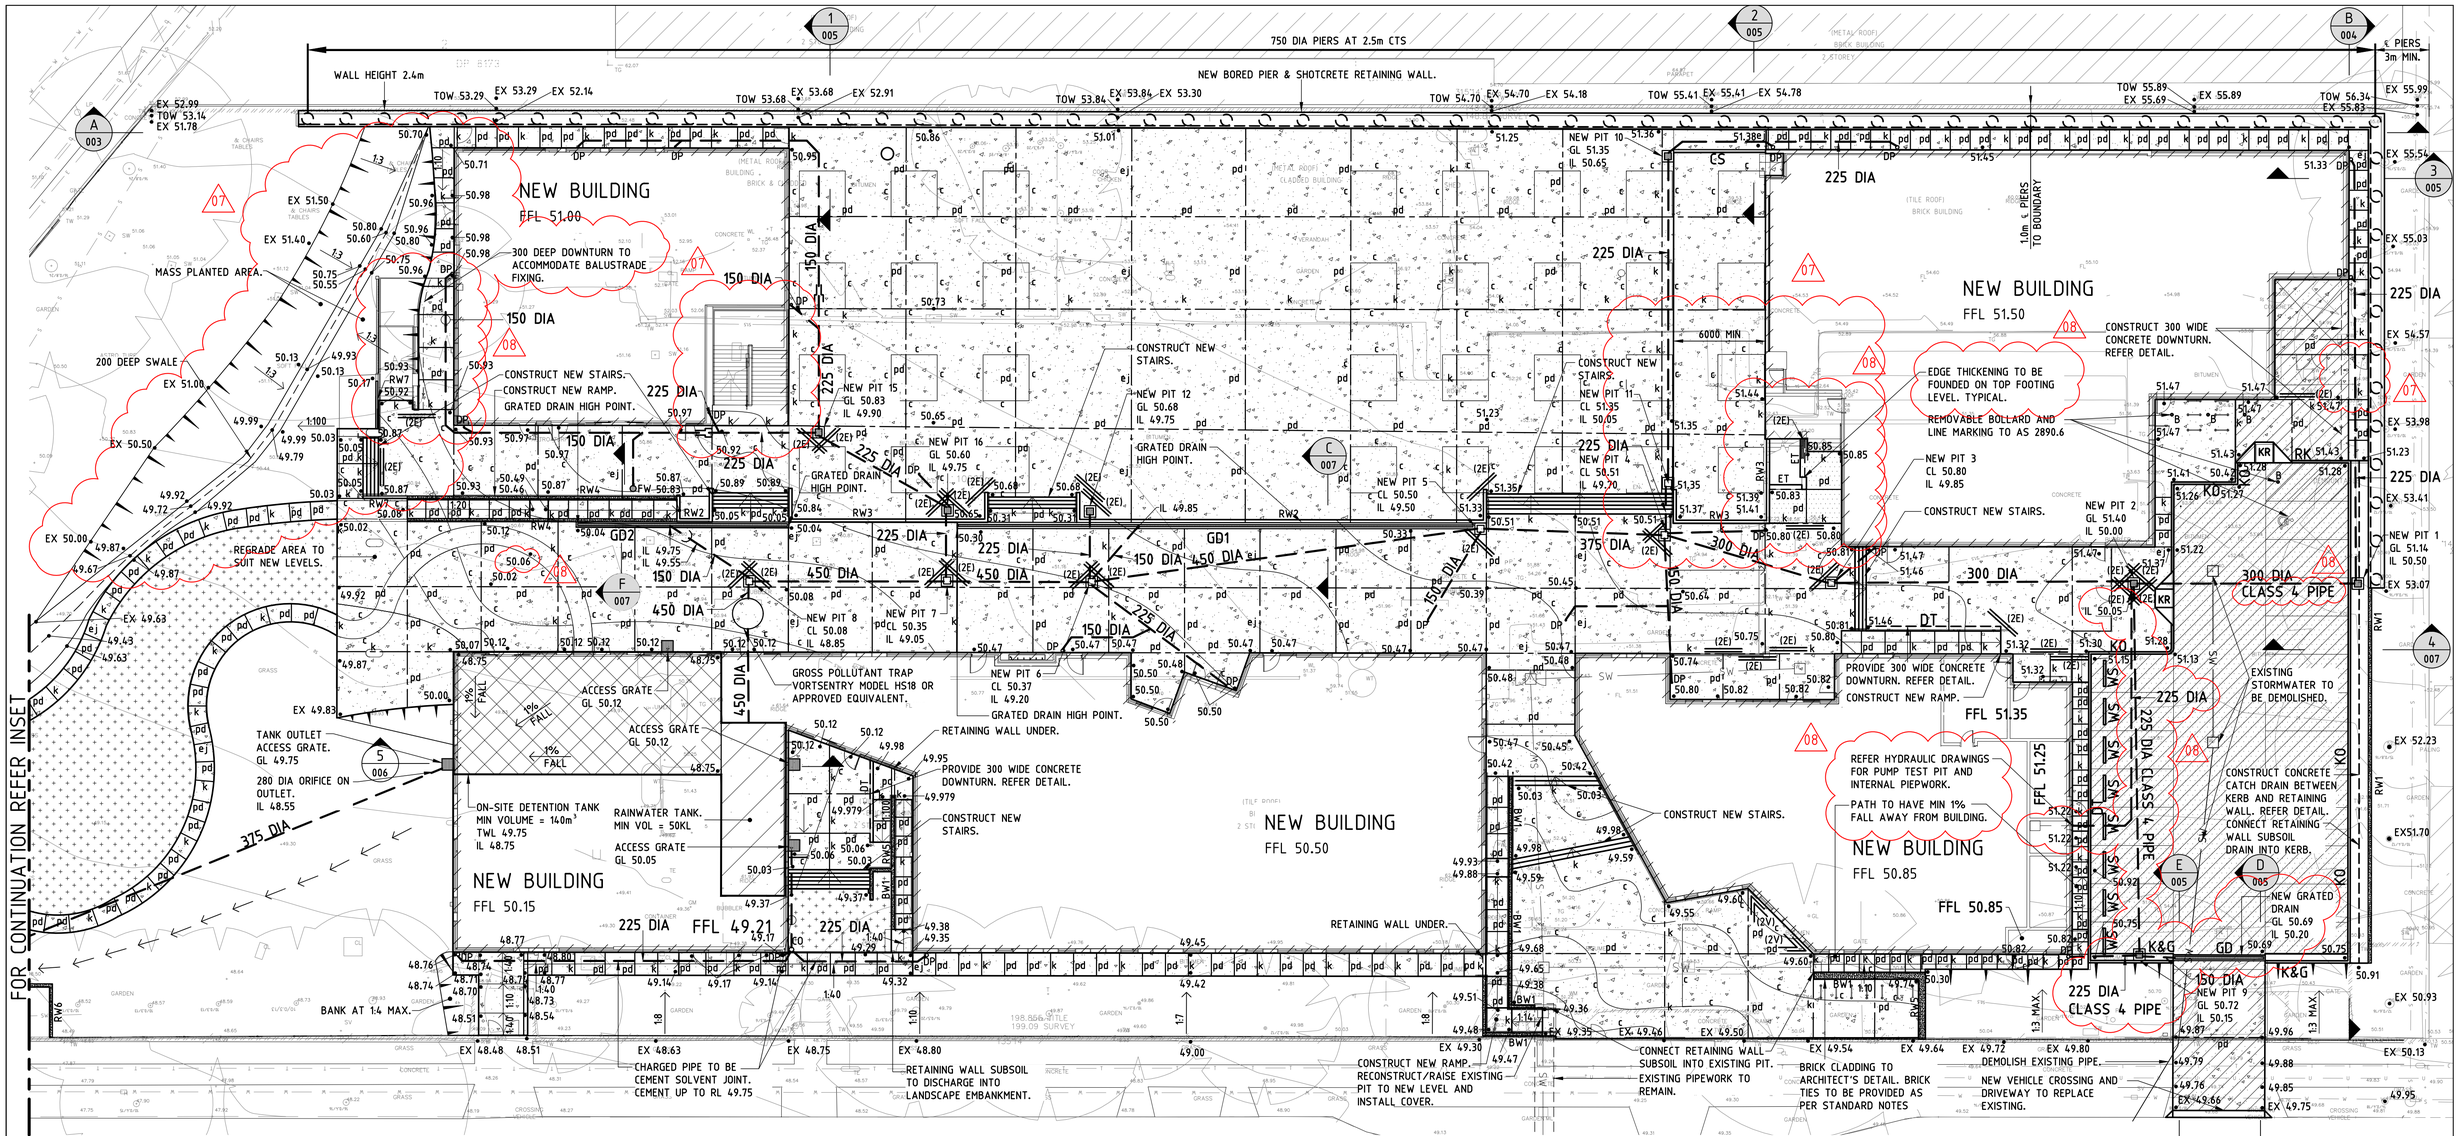

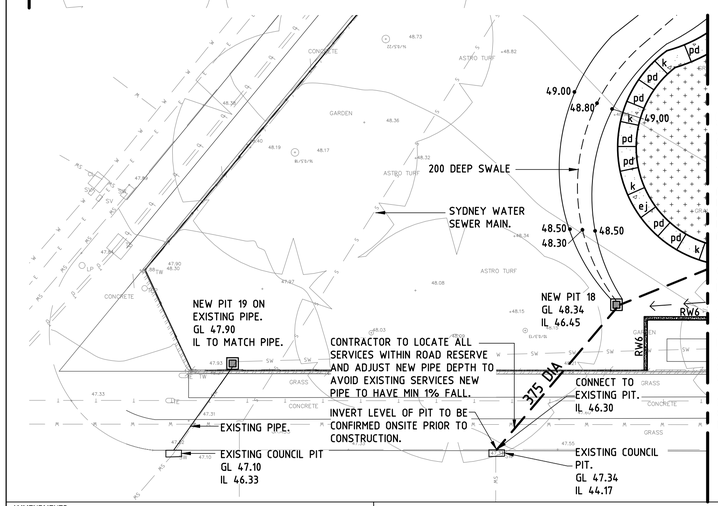

NOTE: DRAWINGS TO BE READ IN CONJUNCTION WITH LANDSCAPE ARCHITECTS PLANS FOR ALL AREAS OF COLOUR CHANGE IN CONCRETE PAVEMENT.

NOTE: ALL EXISTING STORMWATER DRAINAGE STRUCTURES TO BE DEMOLISED. UNLESS NOTIFIED OTHERWISE.

NOTE:
A SUBSOIL DRAINAGE PIPE SHALL BE PROVIDED ADJACENT TO EVERY INLET STORMWATER PIPE AT EACH PIT FOR A DISTANCE UPSTREAM OF 3m. THE SUBSOIL PIPE SHALL BE FITTED WITH A FILTER SOCK TIED AT THE UPSTREAM END TO PRECLUDE THE ENTRY OF THE FILTER MATERIAL. THE SUBSOIL PIPE SHALL BE LAID AT THE SAME GRADE AS THE STORMWATER PIPELINE AT INVERT LEVEL OR 1 IN 20 MAX. PROVIDE FLAP VALVE AT CONNECTION TO PIT TO PREVENT BACKFLOW.

NOTE:
ALL RETAINING WALL SUBSOIL PIPES TO CONNECT INTO NEAREST STORMWATER PIT UNLESS NOTIFIED OTHERWISE. SUBSOIL LINE TO HAVE MIN. 0.5% GRADE.

NOTE:
DETAILED DILAPIDATION REPORTS INDICATING THE EXTENT OF EXISTING DAMAGE TO THE SURROUNDING EXISTING BUILDINGS ON NEIGHBOURING PROPERTIES ARE TO BE UNDERTAKEN BEFORE THE CONSTRUCTION OF THE BORED PIER RETAINING WALL AND BOUNDARY BLOCKWORK WALL.

REFERENCE DRAWINGS:

FOR STANDARD NOTES, DRAWING LIST AND LEGEND REFER TO DRG. No. CIV_01_001.

NSW GOVERNMENT | Planning, Industry & Environment

Issued under the Environmental Planning and Assessment Act 1979

Approved Section: 4.55(1A) Application No: SSD-8365-Mod-1

Granted on: 6 April 2020 Sheet no: 31 of 35 Signed:

AMMENDMENTS			
REV	BY	DATE	DESCRIPTION
01	A.P	10.05.19	ISSUE FOR CONSTRUCTION
02	A.P	21.06.19	PATHWAY AMENDED
03	A.P	26.06.19	OSD LOCATION REVISED
04	A.P	26.07.19	REVISED BIKE RAMP LAYOUT
05	A.P	29.08.19	EXTERNAL LIFT LEVELS REVISED
06	A.P	14.10.19	STAIR AND OUTDOOR AREA FOR CO-ORDINATION
07	A.P	16.10.19	NEW STAIR & OUTDOOR AREA AMMENDED
08	A.P	05.11.19	STAIR 1 AND 4 REVISED

Woolacotts. CONSULTING ENGINEERS
T +61 2 8203 1500 I www.woolacotts.com.au
Ground Floor, 12a Brown Street, Chatswood, NSW 2067

This drawing is copyright and must not be used, reproduced or copied wholly or in part without written permission of Woolacotts Consulting Engineers Pty Ltd.

Job Number	Approved	Verified	Prepared
16-242	SETB 10.05.19	AP 31.08.18	JK 31.08.18

NSW GOVERNMENT | Education

STRUCTURE, CIVIL & HYDRAULIC WOOLACOTTS ENGINEERS T: 02 8203 1500	PERUMAL PEDAVOLI ARCHITECTS T: 02 9291 0000 WEB: www.pp-a.com.au Nominated Architect: Vince Pedavoli NSW reg No.5045	
MECH, ELECT, IT, COMMS & SEC. JHA CONSULTING T: 02 9437 1000		
BCA GROUP DLA T: 02 8355 3160		
LANDSCAPE LORNA HARRISON P/L T: 02 9555 1147	STATUTORY PLANNER DON FOX PLANNING P/L T: 02 9473 4914	

PERUMAL PEDAVOLI ARCHITECTS

PENSHURST PUBLIC SCHOOL
18 Arcadia Street, Penshurst

Drawing Name: CIVIL WORKS PLAN

CONTRACT NUMBER: SINSW-18-1257

PROJECT NORTH

SCALE 1:200 @ A1

DRAWN	CHECKED	VERIFIED	Date
			10 MAY 2019

Drawing Number | Revision

PROJECT CODE	DISCIPLINE	PHASE	SERIES NUMBER	
3199	CIV	CD	01_002	08

CONSTRUCTION ISSUE

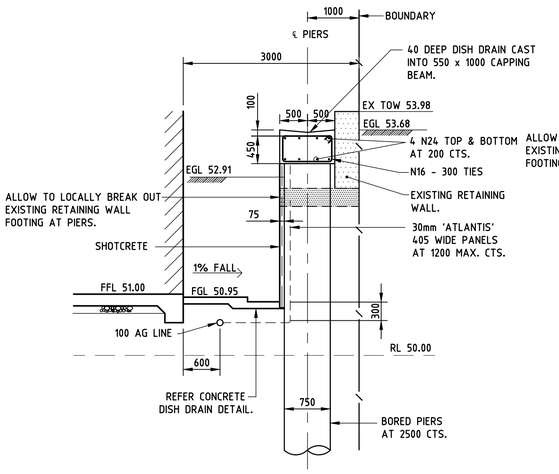

SECTION 1 / 002
SCALE 1:50

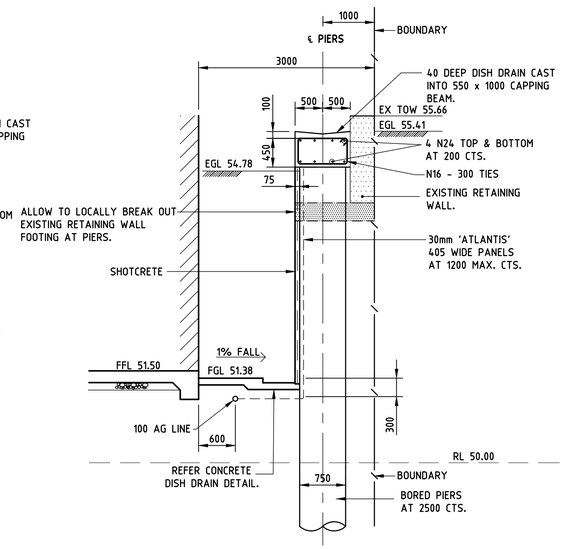

SECTION 2 / 002
SCALE 1:50

SECTION 3 / 002 SIMILAR

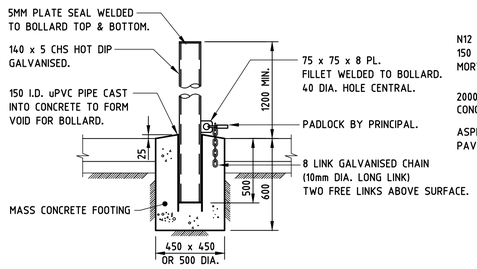

REMOVABLE BOLLARD (B)

ALL COMPONENETS TO BE HOT DIP GALVANISED.

REFER LANDSCAPE ARCHITECT'S PLANS FOR LOCATIONS.

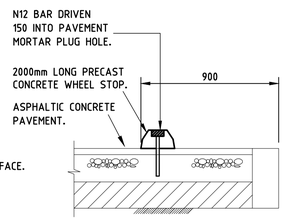

WHEEL STOP DETAIL (WS)

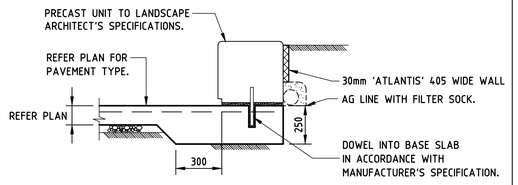

FOR ALL DIMENSIONS REFER LANDSCAPE ARCHITECT'S DETAILS.

PRECAST SEATING WALL DETAIL (CW)

05

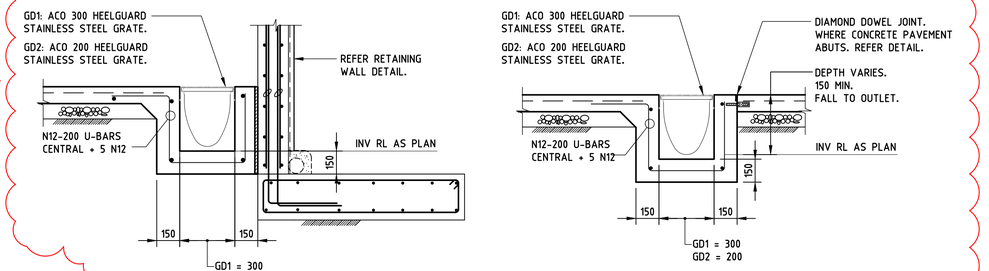

TYPICAL GRATED DRAIN DETAILS

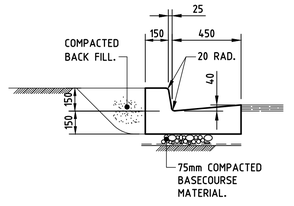

KERB & GUTTER (K&G)

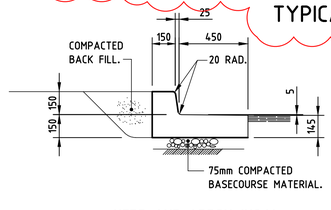

KERB AND APRON (K&A)

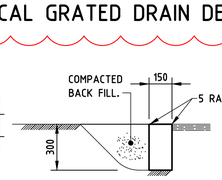

FLUSH KERB (FK)

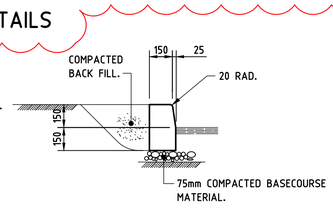

KERB ONLY - TYPE 1 (KO)

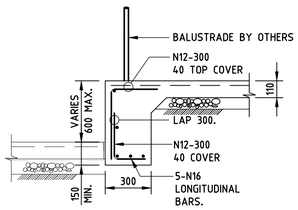

CONCRETE DOWNTURN (DT)

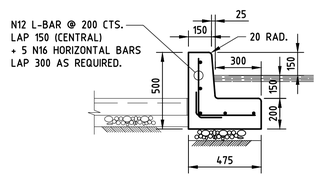

KERB ONLY - TYPE 2 (KO2)

DETAIL SIMILAR AT 300 HIGH KERB.

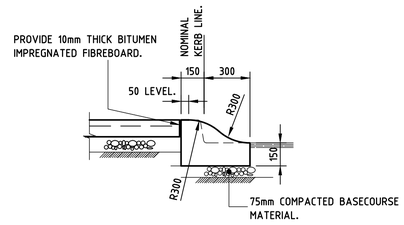

ROLL KERB ONLY (RK)

KERB AND GUTTER DETAILS

PROVIDE 10mm THICK BITUMEN IMPREGNATED FIBRE BOARD OR ABLEFLEX AT 9m CTS. AND TOOLED JOINT AT 3m CTS.

DATUM R.L. 48.00						
DESIGN LEVEL		49.76	49.79	49.87	50.69	51.15
EXISTING LEVEL	49.66	49.74	49.79	49.93	50.75	51.87

SECTION E / 002
SCALE 1:100

DATUM R.L. 48.00						
DESIGN LEVEL		49.85	49.88	49.96	50.69	51.15
EXISTING LEVEL	49.75	49.78	49.82	49.92	50.70	51.87

SECTION D / 002
SCALE 1:100

06

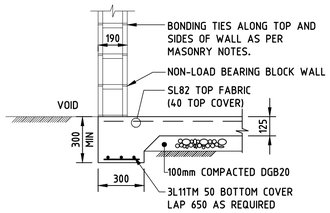

EDGE THICKENING (ET)

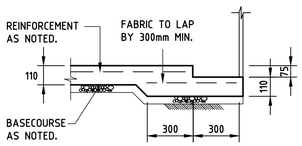

CONCRETE DISH DRAIN DETAIL

DISH DRAIN TO HAVE MIN 0.5% LONGITUDINAL FALL

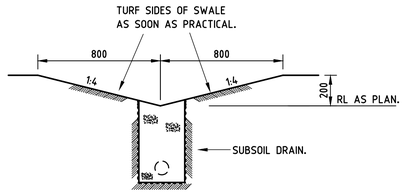

TYPICAL SWALE DETAIL (WITH SUBSOIL DRAIN)

NOTE: SUBSOIL DRAINS ARE TO BE INSTALLED UNDER ALL NEW SWALES.

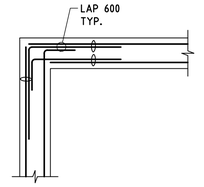

WALL CORNER DETAIL

VERTICAL BARS OMITTED FOR CLARITY.

REFERENCE DRAWINGS:

FOR STANDARD NOTES & DRAWING LIST REFER TO DRG. No. CIV_01_001.

NSW GOVERNMENT | Planning, Industry & Environment

Issued under the Environmental Planning and Assessment Act 1979

Approved Section: 4.55(1A) Application No: SSD-8365-Mod-1

Granted on: 6 April 2020 Sheet no: 32 of 35 Signed:

AMMENDMENTS			
REV	BY	DATE	DESCRIPTION
A	SETB	31.08.18	ISSUE FOR TENDER
B	SETB	05.04.19	DRAFT IFC
C	AP	18.04.19	GATEWAY 4 REVIEW
01	A.P	10.05.19	ISSUE FOR CONSTRUCTION
02	A.P	26.06.19	ORIFICE DETAIL MOVED - DWG 006
03	A.P	04.07.19	SECTIONS D & E REVISED
04	A.P	26.07.19	CONCRETE DISH DRAIN DETAIL ADDED
05	A.P	16.10.19	GRATED DRAIN DETAILS AMMENDED
06	A.P	05.11.19	EDGE THICKENING DETAIL ADDED

Woolacotts. CONSULTING ENGINEERS
T +61 2 8203 1500 | www.woolacotts.com.au
Ground Floor, 12a Brown Street, Chatswood, NSW 2067

This drawing is copyright and must not be used, reproduced or copied wholly or in part without written permission of Woolacotts Consulting Engineers Pty Ltd.

Job Number	Approved	Verified	Prepared
16-242	SETB 10.05.19	AP 31.08.18	JK 31.08.18

NSW GOVERNMENT | Education

STRUCTURE, CIVIL & HYDRAULIC WOOLACOTTS ENGINEERS T: 02 8203 1500
MECH, ELECT, IT, COMMS & SEC. JHA CONSULTING T: 02 9437 1000
BCA GROUP DLA T: 02 8355 3160
LANDSCAPE LORNA HARRISON P/L T: 02 9555 1147
PERUMAL PEDAVOLI ARCHITECTS T: 02 9291 0000 WEB: www.pp-a.com.au Nominated Architect: Vince Pedavoli NSW reg No.5045
STATUTORY PLANNER DON FOX PLANNING P/L T: 02 9473 4914
PERUMAL PEDAVOLI ARCHITECTS

PENSHURST PUBLIC SCHOOL
18 Arcadia Street, Penshurst

Drawing Name: CIVIL WORKS DETAILS - SHEET 1

CONTRACT NUMBER: SINSW-18-1257

PROJECT NORTH: NORTH

SCALE 1:20 @ A1

DRAWN	CHECKED	VERIFIED	Date
			10 MAY 2019

Drawing Number | Revision

PROJECT CODE | DISCIPLINE | PHASE | SERIES NUMBER

3199 - CIV- CD- 01_005 | 06

CONSTRUCTION ISSUE

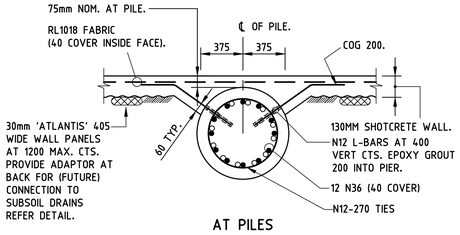

AT PILES

TYPICAL SHOTCRETE WALL DETAIL

○ DENOTES SPLICE BARS

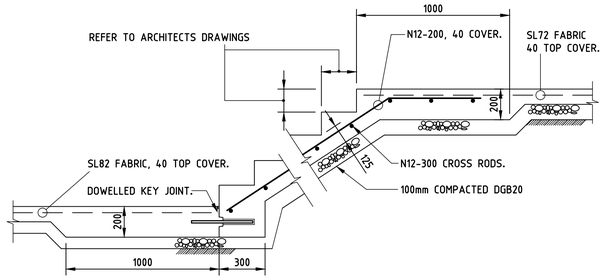

TYPICAL STAIR DETAIL

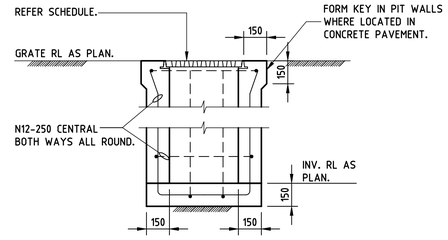

STANDARD PIT

04

PIT SCHEDULE

PIT No.	SIZE	GRATE/COVER & FRAME TYPE
1	600 x 600	CLASS 'A' GRATE AND FRAME
2	900 x 900	CLASS 'B' HEELGUARD STYLE GRATE AND FRAME
3	600 x 900	CLASS 'B' COVER AND FRAME
4	600 x 900	CLASS 'B' COVER AND FRAME
5	600 x 900	CLASS 'B' COVER AND FRAME
6	600 x 900	CLASS 'B' COVER AND FRAME
7	900 x 900	CLASS 'B' COVER AND FRAME
8	900 x 900	CLASS 'B' COVER AND FRAME
9	600 x 600	CLASS 'C' GRATE AND FRAME
10	600 x 600	CLASS 'B' HEELGUARD STYLE GRATE AND FRAME
11	900 x 900	CLASS 'B' COVER AND FRAME
12	600 x 900	CLASS 'B' HEELGUARD STYLE GRATE AND FRAME
15	600 x 900	CLASS 'B' HEELGUARD STYLE GRATE AND FRAME
16	600 x 600	CLASS 'B' HEELGUARD STYLE GRATE AND FRAME
18	900 x 900	CLASS 'B' GRATE AND FRAME
19	900 x 900	CLASS 'B' GRATE AND FRAME

NOTE:
1. PROVIDE GALVANISED STEP IRONS AT PITS DEEPER THAN 1.2m IN ACCORDANCE WITH AS 3500.
2. PROVIDE ENVIROPOD INSERTS TO BE INSTALLED IN ALL GRATED INLET PITS.
3. ALL PITS TO HAVE LOCKABLE SECURE GRATES

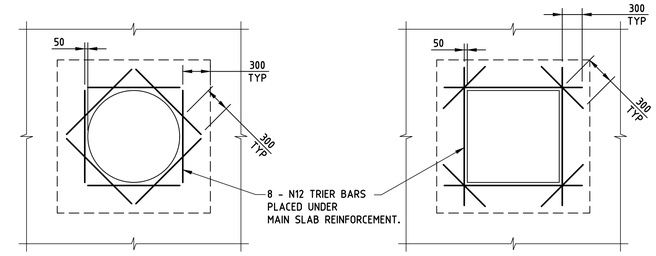

BASE SLAB - REINFORCING DETAIL
FOR PENETRATIONS = <1200mm

BASE SLAB - REINFORCING DETAIL
FOR PENETRATIONS = <1200mm IN BOTH DIRECTIONS

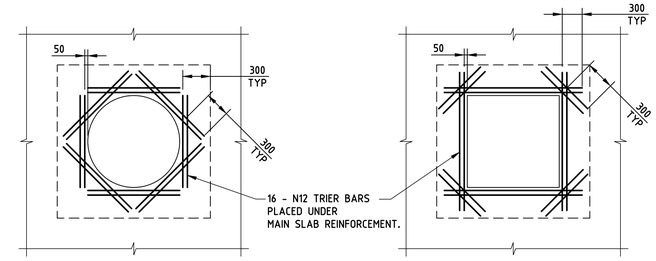

BASE SLAB - REINFORCING DETAIL
DETAIL FOR CIRCULAR PENETRATIONS

BASE SLAB - REINFORCING DETAIL
DETAIL FOR SQUARE PENETRATIONS

TYPICAL CONCRETE PAVEMENT PENETRATION DETAILS

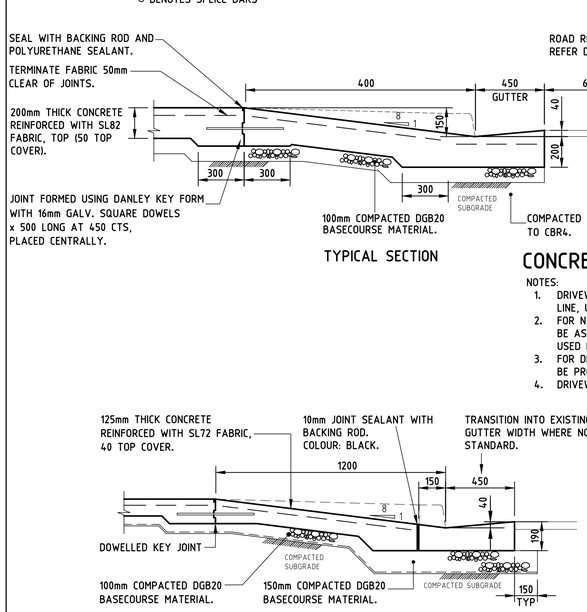

TYPICAL SECTION

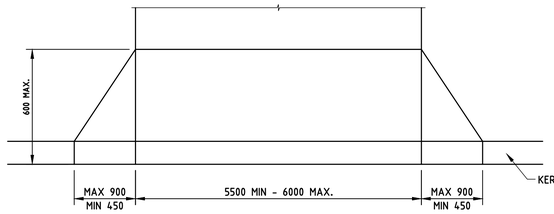

PLAN

CONCRETE VEHICULAR CROSSING

NOTES:
1. DRIVEWAY TO BE GENERALLY PERPENDICULAR TO KERB LINE, UNLESS APPROVED OTHERWISE.
2. FOR NARROW FOOTPATH WIDTHS, LENGTH OF RAMP TO BE AS SHORT AS POSSIBLE, OR LAYBACK ONLY TO BE USED IN APPROVED APPLICATIONS.
3. FOR DRIVEWAYS WIDER THAN 6m, A TOOL JOINT SHALL BE PROVIDED ALONG THE CENTRE OF THE DRIVEWAY.
4. DRIVEWAY CONCRETE SHALL BE WOOD FLOAT FINISHED.

SECTION

KERB RAMP (KR)

IN ACCORDANCE WITH AS 1428.1

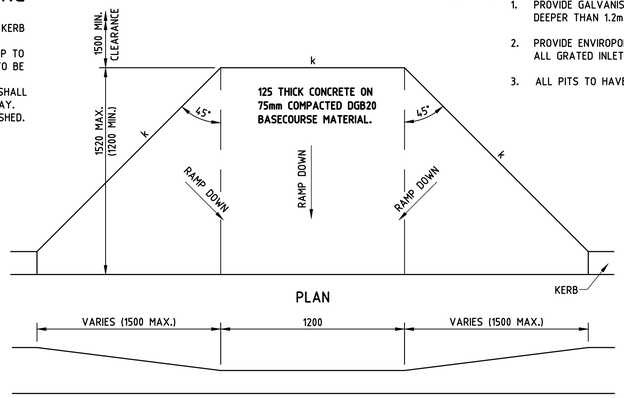

PLAN

ELEVATION

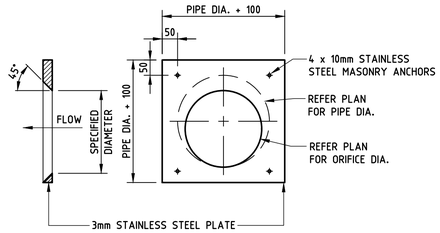

ORIFICE DETAIL

NOT TO SCALE

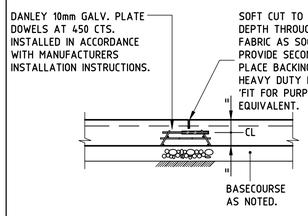

PLATE DOWEL JOINT
SHOWN 'pd' ON PLAN.

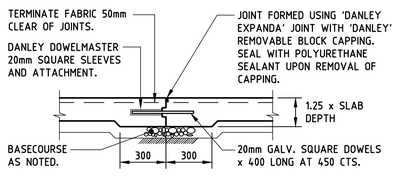

DOWELLED EXPANSION JOINT
SHOWN 'ej' ON PLAN.

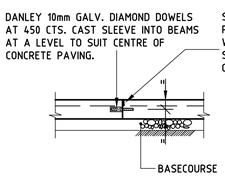

DIAMOND DOWEL JOINT
SHOWN AS 'dd' ON PLAN.

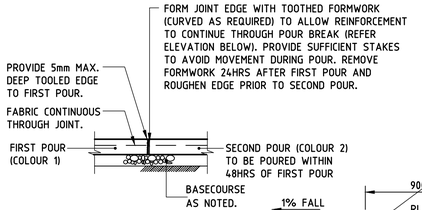

COLOUR CHANGE JOINT
SHOWN 'c' ON PLAN

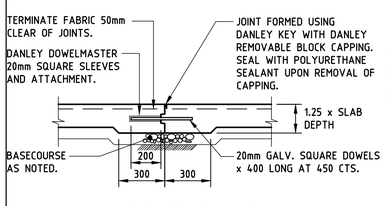

DOWELLED KEY JOINT
SHOWN 'k' ON PLAN.

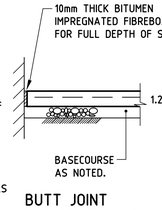

BUTT JOINT
TO BE PROVIDED ALONG BUILDING LINE
WHERE CONCRETE PAVEMENT ABUTS.
EXCEPT AT GRATED DRAINS AND DOORWAYS.
FOR JOINTS AT GRATED DRAINS AND DOORWAYS
REFER TO STRUCTURAL DRGS

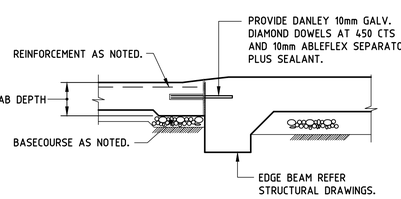

AT DOOR THRESHOLDS

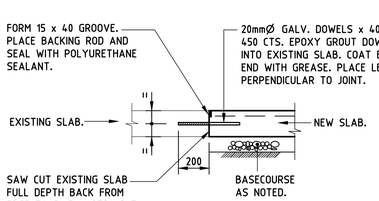

SAWCUT JOINT
SHOWN 'sc' ON PLAN.

CONCRETE JOINT DETAILS

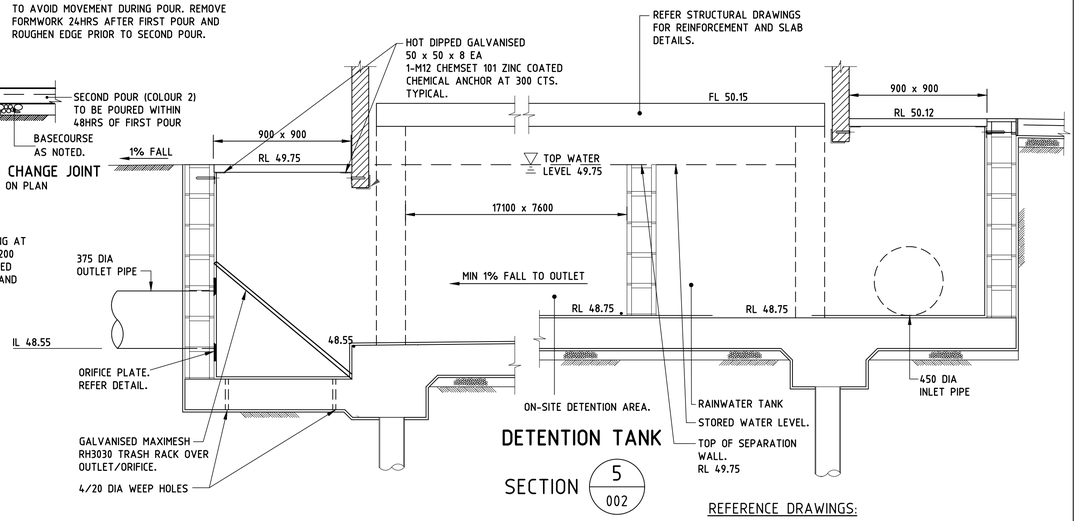

DETENTION TANK

SECTION 5/002

REFERENCE DRAWINGS:
FOR STANDARD NOTES & DRAWING LIST REFER TO DRG. No. CIV_01_001.

AMMENDMENTS

REV	BY	DATE	DESCRIPTION
A	SETB	31.08.18	ISSUE FOR TENDER
B	SETB	05.04.19	DRAFT IFC
C	AP	18.04.19	GATEWAY 4 REVIEW-COLOUR CHANGE JOINT DETAIL
01	A.P	10.05.19	ISSUE FOR CONSTRUCTION
02	A.P	21.06.19	PAVEMENT PENETRATION DETAILS ADDED
03	A.P	26.06.19	OSD SECTION REVISED
04	A.P	16.10.19	PIT SCHEDULE AMMENDED

NSW GOVERNMENT Planning, Industry & Environment

Issued under the Environmental Planning and Assessment Act 1979

Approved Section: 4.55(1A) Application No: SSD-8365-Mod-1

Granted on: 6 April 2020 Sheet no: 33 of 35 Signed:

Woolacotts. CONSULTING ENGINEERS
T +61 2 8203 1500 E www.woolacotts.com.au
Ground Floor, 12a Brown Street, Chatswood, NSW 2067
This drawing is copyright and must not be used, reproduced or copied wholly or in part without written permission of Woolacotts Consulting Engineers Pty Ltd.

Job Number	Approved	Verified	Prepared
16-242	SETB 10.05.19	AP 10.05.19	JK 10.05.19

NSW GOVERNMENT Education

STRUCTURE, CIVIL & HYDRAULIC ENGINEERS WOOLACOTTS ENGINEERS T: 02 8203 1500	PERUMAL PEDAVOLI ARCHITECTS T: 02 9291 0000 WEB: www.pp-a.com.au Nominated Architect: Vince Pedavoli NSW reg No.5045
MECH, ELECT, IT, COMMS & SEC. JHA CONSULTING T: 02 9437 1000	
BCA GROUP DLA T: 02 8355 3160	
LANDSCAPE LORNA HARRISON P/L T: 02 9555 1147	STATUTORY PLANNER DON FOX PLANNING P/L T: 02 9473 4914

PERUMAL PEDAVOLI ARCHITECTS

CONTRACT NUMBER: SINSW-18-1257

PENSHURST PUBLIC SCHOOL
18 Arcadia Street, Penshurst

Drawing Name: CIVIL WORKS DETAILS - SHEET 2

SCALE 1:20 @ A1

DRAWN	CHECKED	VERIFIED	Date
			10 MAY 2019

PROJECT NORTH

Drawing Number: 3199 - CIV- CD- 01_006 Revision: 04

PROJECT CODE | DISCIPLINE | PHASE | SERIES NUMBER

CONSTRUCTION ISSUE

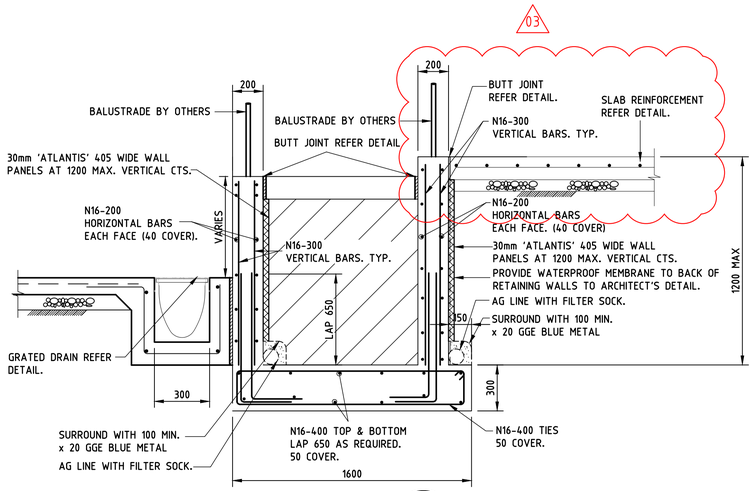

SECTION F 002

RETAINING WALL TYPE 4 (RW4)

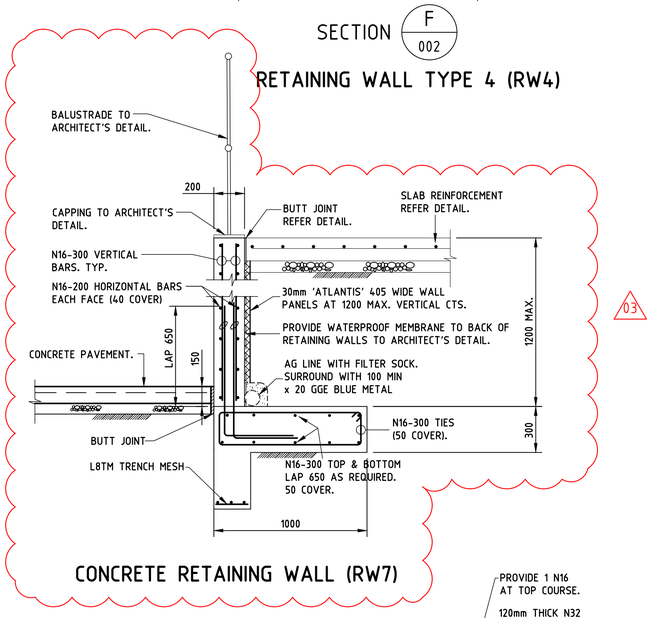

CONCRETE RETAINING WALL (RW7)

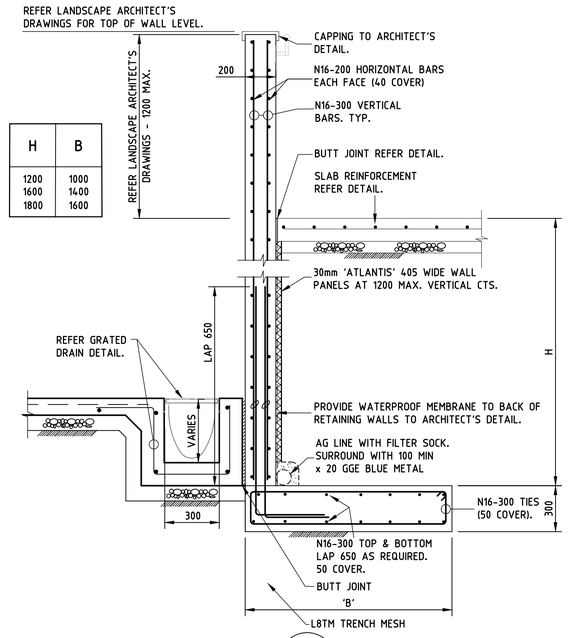

SECTION C 002

CONCRETE RETAINING WALL (RW2)

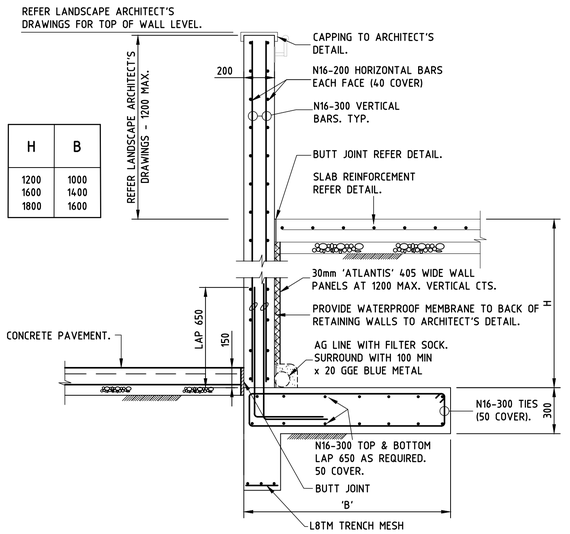

CONCRETE RETAINING WALL (RW3)

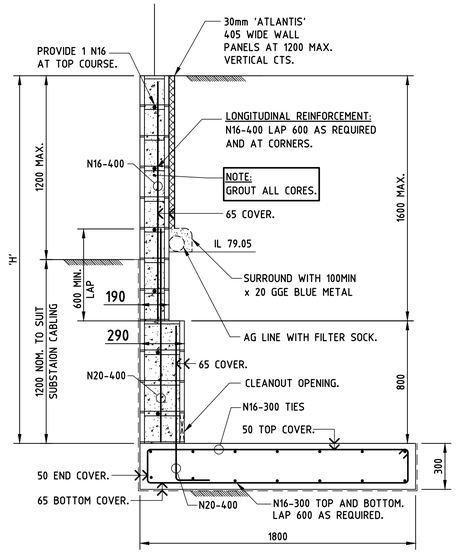

BLOCK RETAINING WALL 6 (RW6)

PROVIDE VERTICAL CONTROL JOINTS AT 12m MAX. CTS. (6m MAX FROM CORNERS) USING A 10mm BITUMEN IMPREGNATED FIBREBOARD SEPARATOR. TERMINATE HORIZONTAL REINFORCEMENT EACH SIDE OF JOINT. 50mm END COVER.

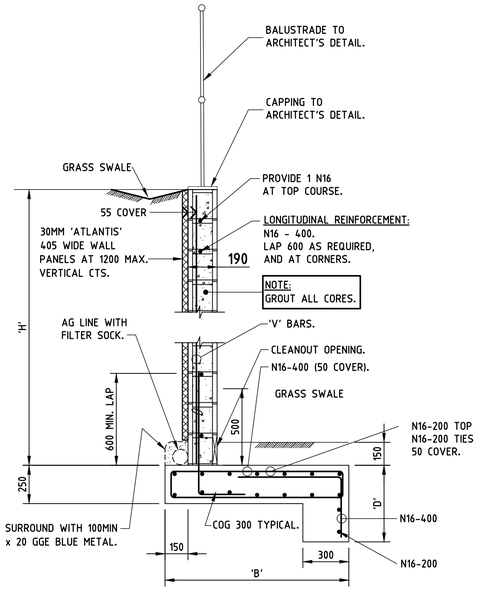

BLOCK RETAINING WALL 5 (RW5)

H	B	D	V-BARS
1000	750	250	N16-400
1400	1000	250	N16-400
1800	1450	450	N16-400

PROVIDE VERTICAL CONTROL JOINTS AT 12m MAX. CTS. (6m MAX FROM CORNERS) USING A 10mm BITUMEN IMPREGNATED FIBREBOARD SEPARATOR. TERMINATE HORIZONTAL REINFORCEMENT EACH SIDE OF JOINT. 50mm END COVER.

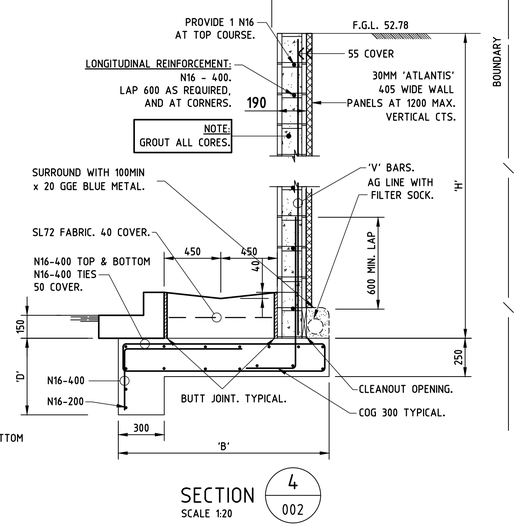

SECTION 4 002
SCALE 1:20

RW1 RETAINING WALL TO 2.0M HEIGHT

H	B	D	V-BARS
800	750	250	N12-400
1000	750	250	N12-400
1200	800	250	N12-400
1400	1000	250	N16-400
1600	1200	350	N16-400
1800	1450	450	N16-400
2000	1700	550	N16-200

PROVIDE VERTICAL CONTROL JOINTS AT 12m MAX. CTS. (6m MAX FROM CORNERS) USING A 10mm BITUMEN IMPREGNATED FIBREBOARD SEPARATOR. TERMINATE HORIZONTAL REINFORCEMENT EACH SIDE OF JOINT. 50mm END COVER.

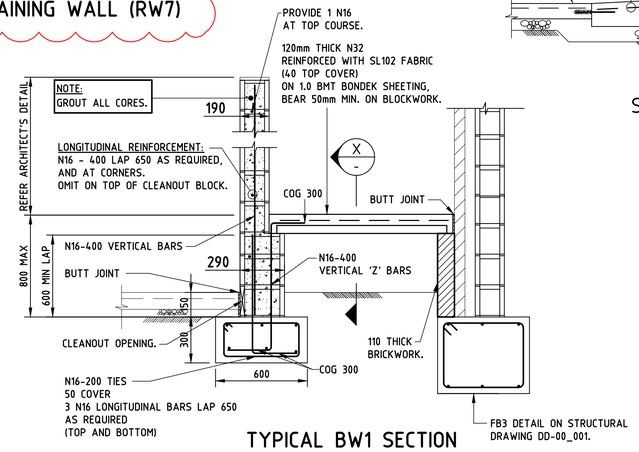

TYPICAL BW1 SECTION

AT BONDEK PORTION OF RAMP

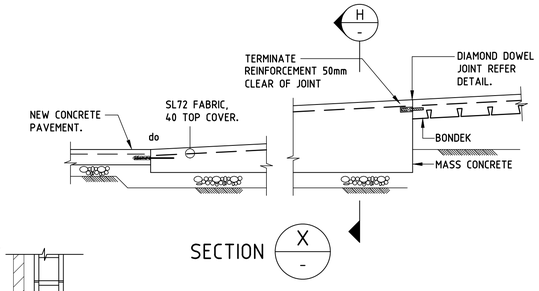

SECTION X -

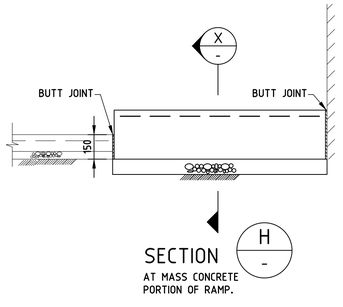

SECTION H -
AT MASS CONCRETE PORTION OF RAMP.

AMMENDMENTS			
REV	BY	DATE	DESCRIPTION
A	AP	18.04.19	GATEWAY 4 REVIEW - RETAINING WALLS ADDED
01	A.P	10.05.19	ISSUE FOR CONSTRUCTION
02	A.P	26.07.19	BW1 DETAIL REVISED
03	A.P	16.10.19	RW7 ADDED, RW4 REVISED.

NSW GOVERNMENT | Planning, Industry & Environment

Issued under the Environmental Planning and Assessment Act 1979

Approved Section: 4.55(1A) Application No: SSD-8365-Mod-1

Granted on: 6 April 2020 Sheet no: 34 of 35 Signed:

Woolacotts. CONSULTING ENGINEERS
T +61 2 8203 1500 | www.woolacotts.com.au
Ground Floor, 12a Brown Street, Chatswood, NSW 2067

This drawing is copyright and must not be used, reproduced or copied wholly or in part without written permission of Woolacotts Consulting Engineers Pty Ltd.

Job Number	Approved	Verified	Prepared
16-242	SETB 10.05.19	AP 10.05.19	JK 10.05.19

NSW GOVERNMENT | Education

STRUCTURE, CIVIL & HYDRAULIC WOOLACOTTS ENGINEERS T: 02 8203 1500	PERUMAL PEDAVOLI ARCHITECTS T: 02 9291 0000 WEB: www.pp-a.com.au Nominated Architect: Vince Pedavoli NSW reg No.5045	PERUMAL PEDAVOLI ARCHITECTS
MECH, ELECT, IT, COMMS & SEC. JHA CONSULTING T: 02 9437 1000		
BCA GROUP DLA T: 02 8355 3160		
LANDSCAPE LORNA HARRISON P/L T: 02 9555 1147	STATUTORY PLANNER DON FOX PLANNING P/L T: 02 9473 4914	

PENSHURST PUBLIC SCHOOL
18 Arcadia Street, Penshurst

Drawing Name: CIVIL WORKS DETAILS - SHEET 3

CONTRACT NUMBER: SINSW-18-1257

PROJECT NORTH

SCALE 1:20 @ A1

DRAWN	CHECKED	VERIFIED	Date
			10 MAY 2019

Drawing Number | Revision

PROJECT CODE | DISCIPLINE | PHASE | SERIES NUMBER

3199 - CIV- CD- 01_007 | 03

CONSTRUCTION ISSUE

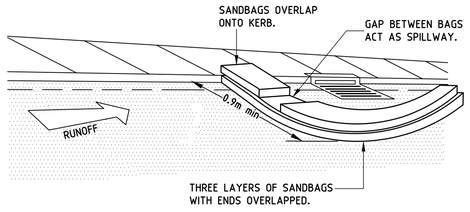

TYPICAL SANDBAG KERB INLET SEDIMENT TRAP

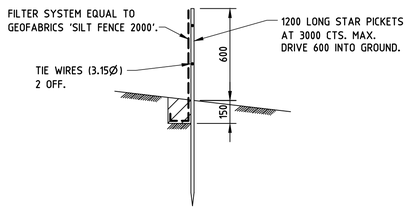

SILT FENCE DETAIL

TO BE PLACED AROUND LOW SIDE OF WORKS AND AS REQUIRED TO PREVENT SOIL WASHING OFF SITE.

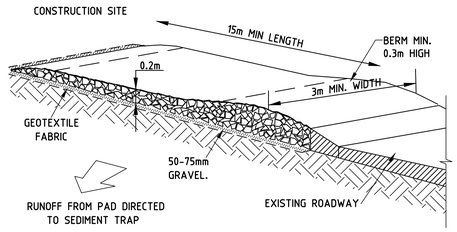

TEMPORARY CONSTRUCTION EXIT

TO BE PROVIDED WHERE CONSTRUCTION VEHICLES LEAVE SITE.

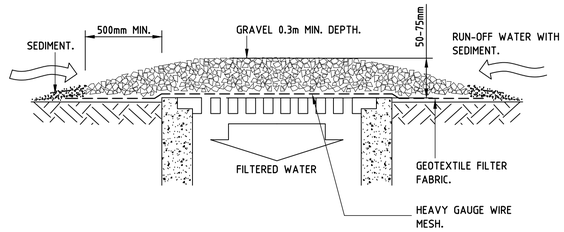

WIRE MESH AND GRAVEL DROP INLET SEDIMENT TRAP.

TO BE PROVIDED AT ALL NEW AND EXISTING GRATED PITS WITHIN IMPERVIOUS AREAS.

LEGEND

- TEMPORARY SITE EXIT
- DETENTION TANK
- RAINWATER TANK
- SW — EXISTING STORMWATER PIPE
- SILT FENCE
- SILT TRAP
- SWALE

NOTE.
- PROVIDE SILT TRAP AROUND ALL EXISTING GRATED INLET PITS UNTIL THEY ARE REMOVED/DEMOLISHED.
- PROVIDE SILT TRAPS AROUND ALL NEW PITS DURING CONSTRUCTION.

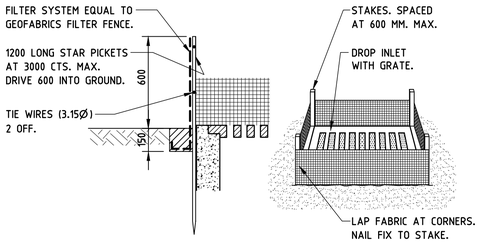

GEOTEXTILE FILTER FABRIC DROP INLET SEDIMENT TRAP.

TO BE PROVIDED AT ALL NEW AND EXISTING GRATED PITS WITHIN PERVIOUS AREAS.

EROSION AND SEDIMENT CONTROL DETAILS

PROVIDE AS REQUIRED TO PREVENT SILT FROM LEAVING THE SITE.

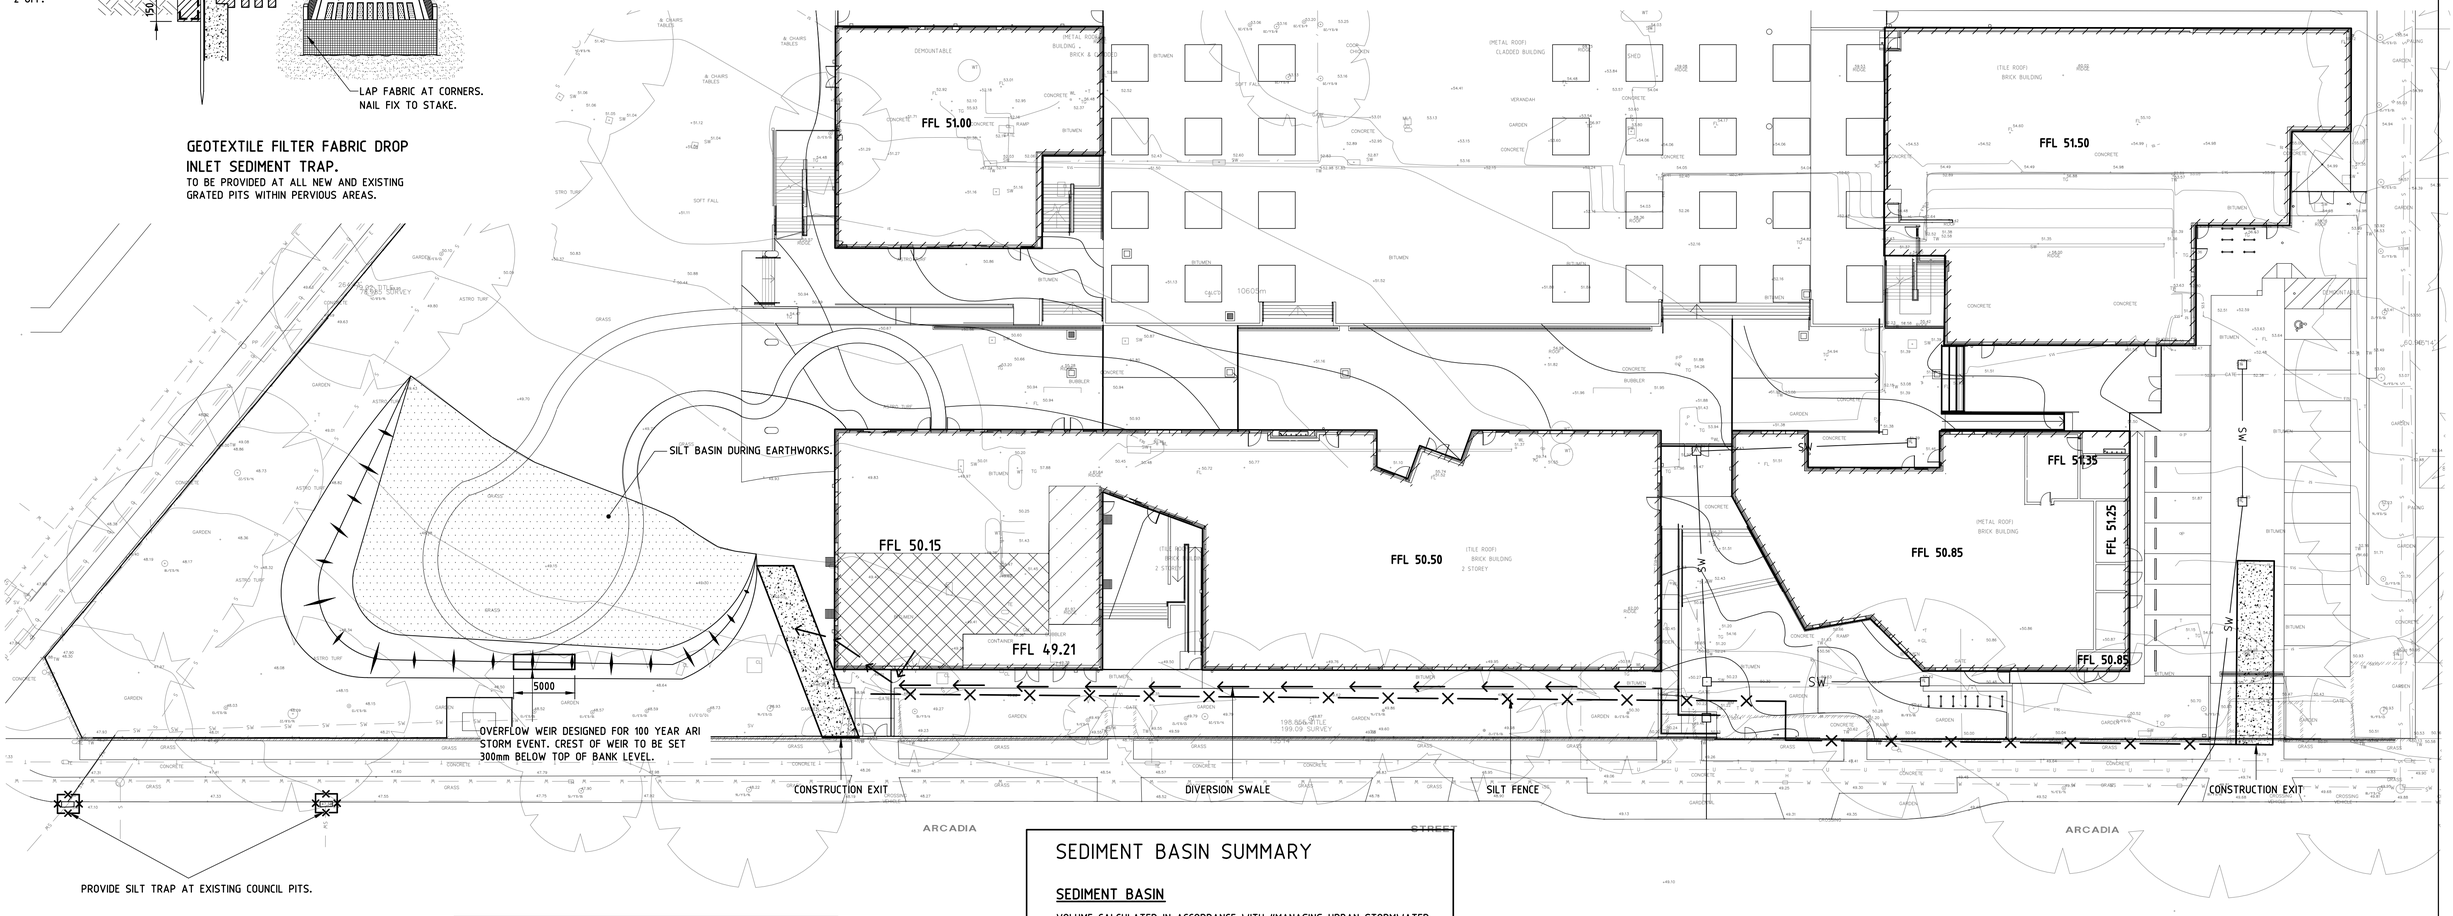

SEDIMENT BASIN SUMMARY

SEDIMENT BASIN

VOLUME CALCULATED IN ACCORDANCE WITH "MANAGING URBAN STORMWATER SOILS AND CONSTRUCTION VOLUME 1, 4TH EDITION 2004".

TYPE D AND F SOILS

DESIGN RAINFALL DEPTH (DAYS)	= 5 DAYS
DESIGN RAINFALL DEPTH (%)	= 85%
5DAY 85% RAINFALL EVENT (GRAFTON NSW)	= 31.5mm
RAINFALL INTENSITY 2YEAR, 6MIN STORM	= 9.82mm
RAINFALL EROSIVITY (R-FACTOR)	= 3557
VOLUMETRIC RUNOFF COEFFICIENT	= 0.64

BASIN VOLUMES

CATCHMENT AREA (ha)	= 1.051ha
SETTLING ZONE VOLUME (m^3)	= 212m^3
SEDIMENT STORAGE VOLUME (m^3)	= 106m^3
TOTAL BASIN VOLUME (m^3)	= 318m^3

SEDIMENT DETAIL TO BE CONSTRUCTED IN ACCORDANCE WITH DETAIL SD6-4 OF "MANAGING URBAN STORMATER-SOILS AND CONSTRUCTION, VOLUME 1, 4TH EDITION 2004"

NSW GOVERNMENT | Planning, Industry & Environment

Issued under the Environmental Planning and Assessment Act 1979

Approved Section: 4.55(1A) Application No: SSD-8365-Mod-1

Granted on: 6 April 2020 Sheet no: 35 of 35 Signed:

AMMENDMENTS

REV	BY	DATE	DESCRIPTION
A	SETB	31.08.18	ISSUE FOR TENDER
B	SETB	26.03.19	SEDIMENT BASIN VOLUME ADDED
C	SETB	05.04.19	DRAFT IFC
D	AP	18.04.19	GATEWAY 4 REVIEW
01	A.P	10.05.19	ISSUE FOR CONSTRUCTION

Woolacotts. CONSULTING ENGINEERS
T +61 2 8203 1500 I www.woolacotts.com.au
Ground Floor, 12a Brown Street, Chatswood, NSW 2067

This drawing is copyright and must not be used, reproduced or copied wholly or in part without written permission of Woolacotts Consulting Engineers Pty Ltd.

Job Number	Approved	Verified	Prepared
16-242	SETB 10.05.19	AP 10.05.19	JK 10.05.19

NSW GOVERNMENT | Education

STRUCTURE, CIVIL & HYDRAULIC
WOOLACOTTS ENGINEERS
T: 02 8203 1500

MECH, ELECT, IT, COMMS & SEC.
JHA CONSULTING
T: 02 9437 1000

BCA
GROUP DLA
T: 02 8355 3160

LANDSCAPE
LORNA HARRISON P/L
T: 02 9655 1147

PERUMAL PEDAVOLI ARCHITECTS
T: 02 9291 0000
WEB: www.pp-a.com.au
Nominated Architect:
Vince Pedavoli NSW reg No.5045

STATUTORY PLANNER
DON FOX PLANNING P/L
T: 02 9473 4914

PERUMAL PEDAVOLI ARCHITECTS

PENSHURST PUBLIC SCHOOL
18 Arcadia Street, Penshurst

Drawing Name
SEDIMENT & EROSION CONTROL PLAN & DETAILS

CONTRACT NUMBER
SINSW-18-1257

SCALE 1:250 @ A1

PROJECT NORTH

DRAWN	CHECKED	VERIFIED	Date
			10 MAY 2019

Drawing Number | Revision

PROJECT CODE DISCIPLINE PHASE SERIES NUMBER
3199 - CIV- CD- 01_008 | 01