
| Room Type ID | Name |
|---|---|
| C02 | PARK (TEAM) |
| C06 | PARK (VIP) |
| C08 | SERVICE ROAD |
| C09 | SERVICE / BOH CORRIDORS |
| C10 | PITCH ACCESS VOMITORIES |
| C11 | ENTRANCE - VIP |
| C16 | GOODS LIFT |
| C17 | SERVICE LIFT |
| C18 | PASSENGER LIFT |
| C19 | LIFT LOBBY |
| C20 | SERVICE STAIRS |
| C24 | ACCESS SHAFT |
| D02 | STORE - UNIFORM |
| D03 | STORE - RADIO |
| D09 | EVENT BRIEFING ROOM |
| D19 | PATRON SERVICES OFFICE |
| D20 | FIRST AID ROOM |
| D22 | HIRERS OFFICE |
| D23 | HIRERS AMENITIES |
| D25 | STORE - MERCHANDISE |
| D26 | EVENT DAY OFFICE |
| D28 | TICKET BOX WEST |
| D31 | POLICE INTERVIEW ROOM |
| D40 | EVENT LAUNDRY COLLECTION |
| D41 | EVENT STAFF FACILITIES |
| D42 | EVENT STAFF RECEPTION |
| D43 | EVENT WASH ROOM - (F) |
| D44 | EVENT WASH ROOM - (M) |
| D45 | GUARD HOUSE |
| D47 | POLICE BRIEFING ROOM |
| D48 | POLICE RECEPTION |
| E07 | MECH OTHER |
| E10 | GENERATOR ROOM |
| E12 | SUB-STATION |
| E13 | UPS ROOM |
| E15 | GREASE TRAP |
| E30 | MAIN COMPUTER ROOM |
| E31 | DAS ROOM |
| E41 | OB RISER |
| E42 | DB RISER |
| E43 | DIESEL TANK |
| E44 | ELECTRICAL RISER |
| E45 | FHR |
| E46 | FIRE RISER |
| E47 | HOT WATER ROOM |
| E48 | MAIN SWITCH ROOM |
| E51 | MECH RISER |
| E54 | TANK - POTABLE WATER |
| E55 | PUMP ROOM - RAINWATER |
| E56 | TANK - RAINWATER |
| E59 | SEWER PUMP ROOM |
| E61 | MECH - PITCH DRAIN |
| E64 | PUMP ROOM - POTABLE WATER |
| E70 | COMMS ROOM |
| E71 | HYDRAULIC RISER |
| E81 | DB |
| E82 | MDF ROOM |
| E83 | COMMS RISER |
| E85 | SFIP |
| F01 | STORE - GROW LIGHTS AND FANS |
| F02 | STORE - GROUNDS AND MAINTENANCE |
| F06 | LOADING DOCK - GENERAL SUPPLIES |
| F07 | LOADING DOCK - CATERING |
| F10 | DOCK MANAGERS OFFICE |
| F11 | SECURITY OFFICE |
| F13 | SECURITY TOILET (UA) |
| F17 | STORE - GENERAL |
| F19 | STORE - DANGEROUS GOODS |
| F21 | STORE - EVENT |
| F22 | STORE - HOME TEAM |
| F23 | OFFICE - 2P (G&M) |
| F24 | OFFICE - 3P (BSO) |
| F26 | SECURITY OFFICE BREAK ROOM |
| F27 | CLEANERS OFFICE |
| F28 | SIGN IN DESK |
| H01 | MAIN KITCHEN |
| H21 | CHEFS OFFICE |
| H27 | STORE - CELLAR STORE |
| H28 | STORE - KEGS |
| H32 | STORE - KITCHEN |
| J01 | PLAYING SURFACE |
| K03 | TENANCY (MEDICAL / RESTAURANT) |
| M02 | MEDIA STORE |
| M03 | PHOTOGRAPHERS WORKROOM |
| M04 | PRESS CONFERENCE ROOM |
| M06 | OB COMPOUND |
| M19 | MEDIA TOILET (M) |
| M20 | MEDIA TOILET (F) |
| M21 | MEDIA - TOILET (UA) |
| M26 | OB GENERATOR |
| P01 | TUNNEL CLUB |
| P11 | PREM TOILETS - (M) |
| P12 | PREM TOILETS - (F) |
| P13 | PREM TOILETS - (UA-R) |
| S16 | OFFICIALS BENCH |
| S17 | SIN BIN |
| T01 | LOCKER ROOM |
| T02 | PLAYERS WET AREA |
| T03 | PHYSIO / MASSAGE |
| T04 | MEDICAL ROOM |
| T05 | COACHES OFFICE |
| T06 | PROPERTY ROOM |
| T07 | DRINKS STATION |
| T08 | WARM-UP ROOM |
| T09 | PLAYERS LOBBY |
| T10 | COACHES BRIEFING |
| T11 | RECOVERY ROOM |
| T15 | TUNNEL - PRIMARY |
| T17 | INDEPENDENT MEDICAL ROOM |
| T18 | DOPING CONTROL STATION |
| T19 | OFFICIALS LOCKER ROOM (M) |
| T20 | OFFICIALS LOCKER ROOM (F) |
| T21 | OFFICIALS LOBBY |
| T23 | TEAM CIRCULATION |
| T26 | COACHES TOILET |
| T30 | DOPING CONTROL TOILETS - (UA-R) |
| T31 | FIRST AID WC |
| T32 | INDEPENDENT MEDICAL ROOM TOILETS - (UA-R) |
| W01 | WASTE STORE |
| W03 | BIN STORE |
| W06 | CLEANERS ROOM |
| W07 | STORE - CLEANERS |
| Z05 | INDOOR WICKETS |
| Z06 | OSD TANK |
| Z07 | TENANCY OVERFLOW |

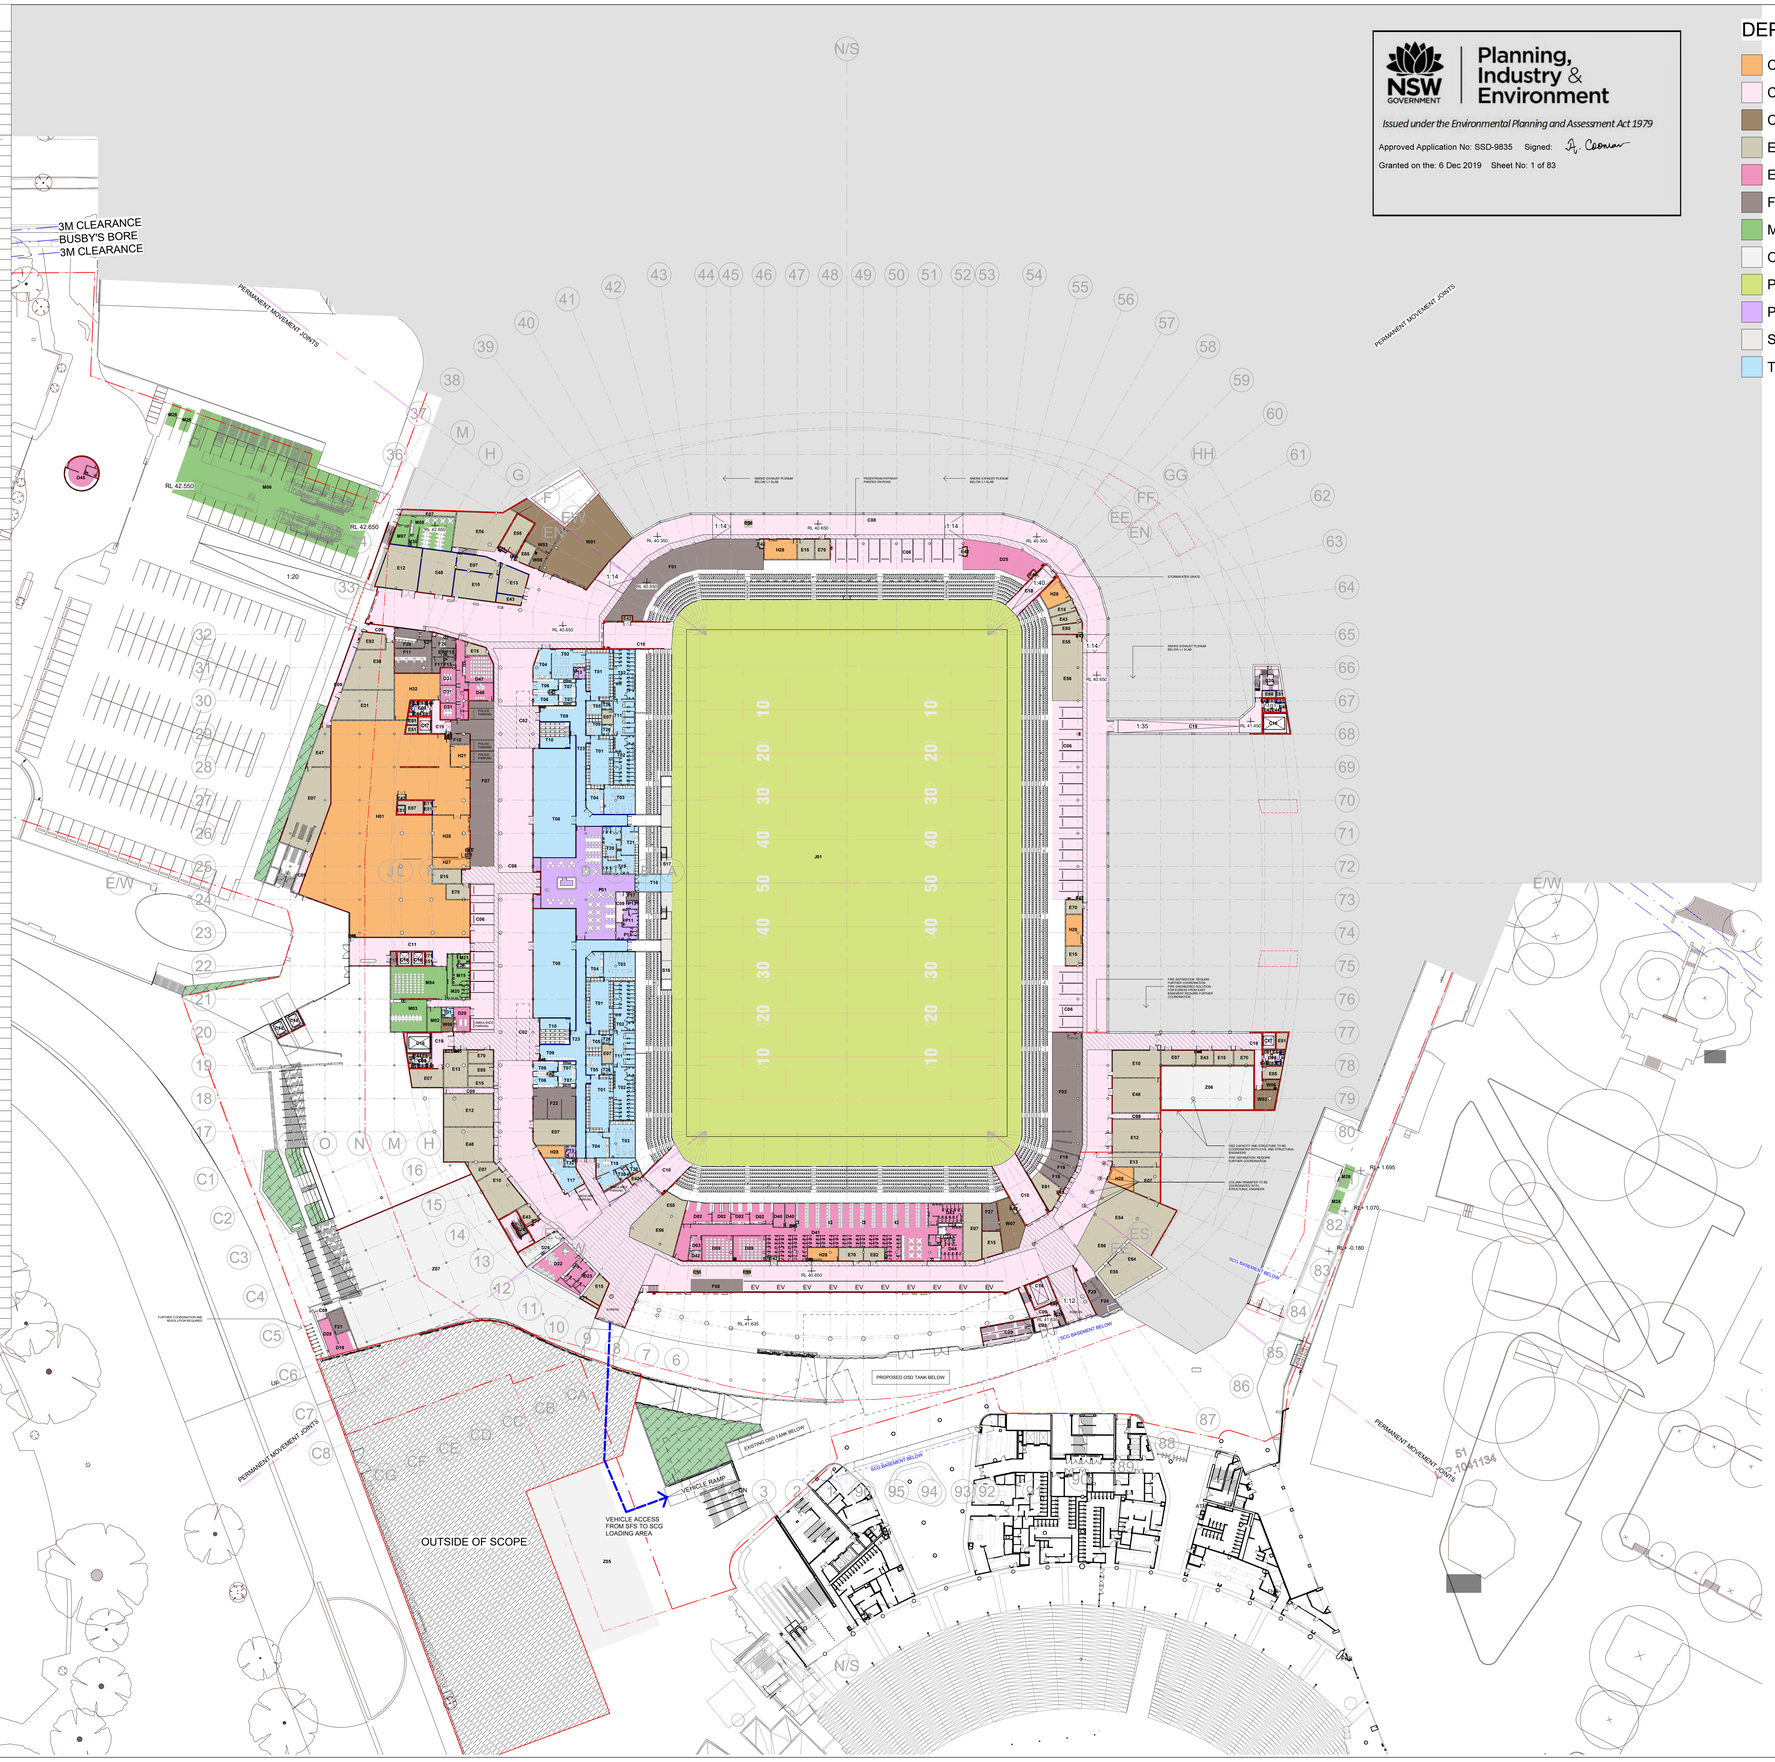


Planning, Industry & Environment
NSW GOVERNMENT

*Issued under the Environmental Planning and Assessment Act 1979*

Approved Application No: SSD-9835 Signed:

Granted on the: 6 Dec 2019 Sheet No: 1 of 83

## DEPARTMENT LEGEND

- CATERING FACILITIES
- CIRCULATION AREAS
- CLEANING AND WASTE FACILITIES
- ENGINEERING SERVICES
- EVENT DAY FACILITIES
- FACILITY MANAGEMENT AREAS
- MEDIA FACILITIES
- OTHER
- PITCH
- PREMIUM AREAS
- SEATING BOWL
- TEAM FACILITIES

WALL LOADING LEGEND:

MINIMUM - 2kN
MINIMUM - 3kN

LEGEND:

LOOSE FIT LINE
SSD BOUNDARY
EXTENT OF FUTURE MEZZANINE TO BE DEMOLISHED
SP POP UP CARTS - SERVICE POINT

Notes:
ALLOW FOR SUB ROOF TO THE FOLLOWING ROOMS IN ORDER TO PROTECT EQUIPMENT AGAINST WET SERVICES ABOVE (WHERE APPLICABLE):
- DAS, MCR, COMMS, MDF, GENERATOR, UPS, MAIN SWITCH, HV INTAKE
SUB ROOF TO HAVE SPRINKLER PROTECTION OVER VOID SPACE
TO BE COORDINATED WITH STRUCTURAL ENGINEER AND SERVICES CONSULTANTS.

REFER TO LANDSCAPE ARCHITECT'S DRAWINGS FOR LANDSCAPE LAYOUT, DETAILS AND DESIGN

LOOSE FURNITURE SHOWN INDICATIVELY ONLY, NOT TO BE INCLUDED IN TENDER COSTING UNLESS INSTRUCTED OTHERWISE

Notes:
PODIUM LEVELS REQUIRE FURTHER COORDINATION. REFER TO LANDSCAPE ARCHITECT DRAWINGS FOR LATEST INFORMATION

© COPYRIGHT COX ARCHITECTURE PTY LTD
ANY FORM OF REPRODUCTION OF THIS DRAWING IN FULL OR IN PART WITHOUT THE WRITTEN PERMISSION OF COX ARCHITECTURE PTY LTD CONSTITUTES AN INFRINGEMENT OF COPYRIGHT

LOCATION PLAN

REFER DWG
- A40.00.01
- A30.EW.01
- A30.NS.01

FOR FACADE EXTENT/TYPE

REFER TO LANDSCAPE ARCHITECTS PLANS FOR LANDSCAPE & PUBLIC DOMAIN

| Rev | Description | By | Date |
|---|---|---|---|
| A | SSDA Stage 2 Issue | | 11.06.19 |
| B | SSDA Stage 2 Issue | | 13.08.19 |
| C | SSDA Stage 2 Issue | | 20.09.19 |

General Notes:
CONTRACTOR AND SUB-CONTRACTORS SHALL VERIFY ALL DIMENSIONS OF THIS DRAWING AND SITE CONDITIONS PRIOR TO ANY WORK COMMENCING

ALL SHOP DRAWINGS SHALL BE SUBMITTED TO THE ARCHITECT. THE MANUFACTURER SHALL NOT COMMENCE ANY WORKS PRIOR TO THE RETURN OF APPROVED SHOP DRAWINGS SIGNED BY THE RELEVANT CONSULTANT.

FIGURED DIMENSIONS TAKE PRECEDENCE OVER SCALED DIMENSIONS.

THIS DRAWING SHOULD BE READ IN CONJUNCTION WITH ALL RELEVANT CONTRACTS, SPECIFICATIONS, DRAWINGS AND CONSULTANT DOCUMENTS.

COPYRIGHT OF THIS DRAWING IS VESTED IN THE PRINCIPAL

NOTE: ALL REVISIONS TO DRAWINGS WILL BE CLOUDED AND TAGGED

Structure Notes:

STRUCTURAL ELEMENTS SHOWN IN ARCHITECTURAL DRAWINGS ARE INDICATIVE ONLY AND INCLUDED FOR SPATIAL CO-ORDINATION PURPOSES ONLY

FOR FULL STRUCTURAL DESIGN INCLUDING SUPERSTRUCTURE, BOWL STRUCTURE, FOUNDATIONS SIZES & DETAILS, SLAB SIZES & DETAILS, SUB-SOIL & SHORING CONSTRUCTION, STRUCTURAL WALL SIZES & DETAILS REFER STRUCTURAL ENGINEER'S REPORT

FINAL ENGINEERING CONNECTIONS AND MEMBER TYPES TO MATCH ARCHITECTURAL INTENT.

Notes:
REFER TO SERVICE ENGINEER'S DRAWINGS FOR LOCATION OF S.D.F BOXES, GPO'S AND SKIRTING DUCTS. REFER TO SERVICES ENGINEER'S DRAWINGS FOR CO-ORDINATION OF SLAB & WALL 'BLOCKOUTS' AND 'CORED' PENETRATIONS.

REFER TO HYDRAULIC ENGINEER'S SERVICE PLAN FOR LOCATION OF SUB-FLOOR SERVICES.

REFER TO DOOR SCHEDULES FOR DOOR HARDWARE AND FURNITURE DETAILS
REFER TO MECHANICAL ENGINEER'S DRAWINGS AND SHOP DRAWINGS TO CONFIRM SIZES OF ALL DUCT PENETRATIONS AND LOUVRE OPENING SIZES.

REFER TO MECHANICAL ENGINEER'S DETAILS FOR PENETRATIONS AND BUILDING IN OF DUCTS, GRILLES, PLANT AND CEILING PLENUMS.

BUILD IN HIGH LEVEL OPENINGS FOR PLENUMS IN CEILING SPACES. REFER TO MECHANICAL ENGINEERS DRAWING.

FOR ADDITIONAL SETOUT INFORMATION WHERE NO DIMENSIONING SHOWN, REFER TO REFERENCE TAGS FOR DETAILED ARCHITECTURAL DRAWINGS

REFER TO ARCHITECTURAL SPECIFICATION, SCHEDULES AND ROOM DATA SHEETS FOR FF&E AND FINISHES CODES FOR FURTHER DETAIL AND OTHER MISCELLANEOUS ITEMS.

**Cox Architecture**
Level 6, 155 Clarence Street,
Sydney, NSW 2000, Australia
T + 61 2 9267 9599
F + 61 2 9264 5844
www.coxarchitecture.com.au

**ASPECT Studios**
78/80 George St, Redfern,
NSW, 2016, Australia
T + 61 2 9699 7182
www.aspect-studios.com/au

**Nominated Architects**
Joe Agius no. 8491
Russell Lee no. 6367

**Consultants**

Roof Structure & Super Structure
NAME: ARUP
ADDRESS: Level 5 , Barrack Place, 151 Clarence St, Sydney, NSW, 2000
TEL/FAX: 9320 9320

NAME:
ADDRESS:
TEL/FAX:

NAME:
ADDRESS:
TEL/FAX:

**Client**
INSW

**Project No.**
218018.00

**Project**
SYDNEY FOOTBALL STADIUM
Driver Ave, Moore Park NSW 2021

**Drawing Title**
FLOOR PLAN BASEMENT LEVEL


**Document Control Status:**
DESIGN DEVELOPMENT

| | |
|---|---|
| A0 DRAWING SHEET | **Drawn:** COX |
| **Co-ordinated:** Checker | **Scale:** As indicated @ A0 |
| **Project Architect:** Designer | **Date:** 20.09.19 |
| **Project Director:** Approver | **Revision:** C |
| **Drawing Number:** A13.L0.01 | **North:** |

Cox Architecture Pty Ltd ACN 002 535 891

PLOT STAMP DATE: 20/09/2019 1:47:08 PM

| Room Type ID | Name |
|---|---|
| C09 | SERVICE / BOH CORRIDORS |
| C13 | ENTRANCE - GENERAL |
| C14 | CONCOURSE - GENERAL |
| C18 | PASSENGER LIFT |
| C20 | STAIR |
| C24 | ACCESS SHAFT |
| C25 | ATRIUM - GENERAL |
| C26 | ATRIUM - PREMIUM |
| D10 | EVENT BREAK ROOM |
| D19 | PATRON SERVICES OFFICE |
| D21 | FIRST AID POST |
| D25 | STORE - MERCHANDISE |
| D28 | TICKET BOX WEST |
| D29 | TICKET BOX EAST |
| D41 | EVENT STAFF FACILITIES |
| E07 | MECH OTHER |
| E23 | FIRE CONTROL ROOM |
| E24 | PUMP ROOM - FIRE |
| E42 | DB RISER |
| E44 | ELECTRICAL RISER |
| E45 | FHR |
| E47 | HOT WATER ROOM |
| E51 | MECH RISER |
| E60 | SMOKE EXHAUST |
| E70 | COMMS ROOM |
| E71 | HYDRAULIC RISER |
| E81 | DB |
| E83 | COMMS RISER |
| F17 | STORE - GENERAL |
| F18 | STORE - FURNITURE |
| F21 | STORE - EVENT |
| G01 | GA TOILET (M) |
| G02 | GA TOILET (F) |
| G03 | GA TOILET (UA-R) |
| G04 | GA TOILET (UA-L) |
| G05 | CHANGING PLACE |
| G06 | PARENTING RM |
| G07 | PRAYER RM |
| H13 | CATERING STORE - LOOSE FF&E |
| H25 | STORE - MOBILE EQUIPMENT DISPERSED |
| H29 | OUTLET - FOOD |
| H30 | OUTLET - BAR |
| H33 | OUTLET - MINI MART |
| K01 | MERCHANDISE KIOSK |
| K02 | MERCHANDISE SUPER STORE |
| P21 | CLUB LOUNGE CLOAK ROOM |
| P22 | MEMBERS RECEPTION |
| S01 | BOWL - SEATING POSITION - SEATED |
| W03 | BIN STORE |
| W05 | BIN BAY |
| W06 | CLEANERS ROOM |
| Z11 | UNALLOCATED |

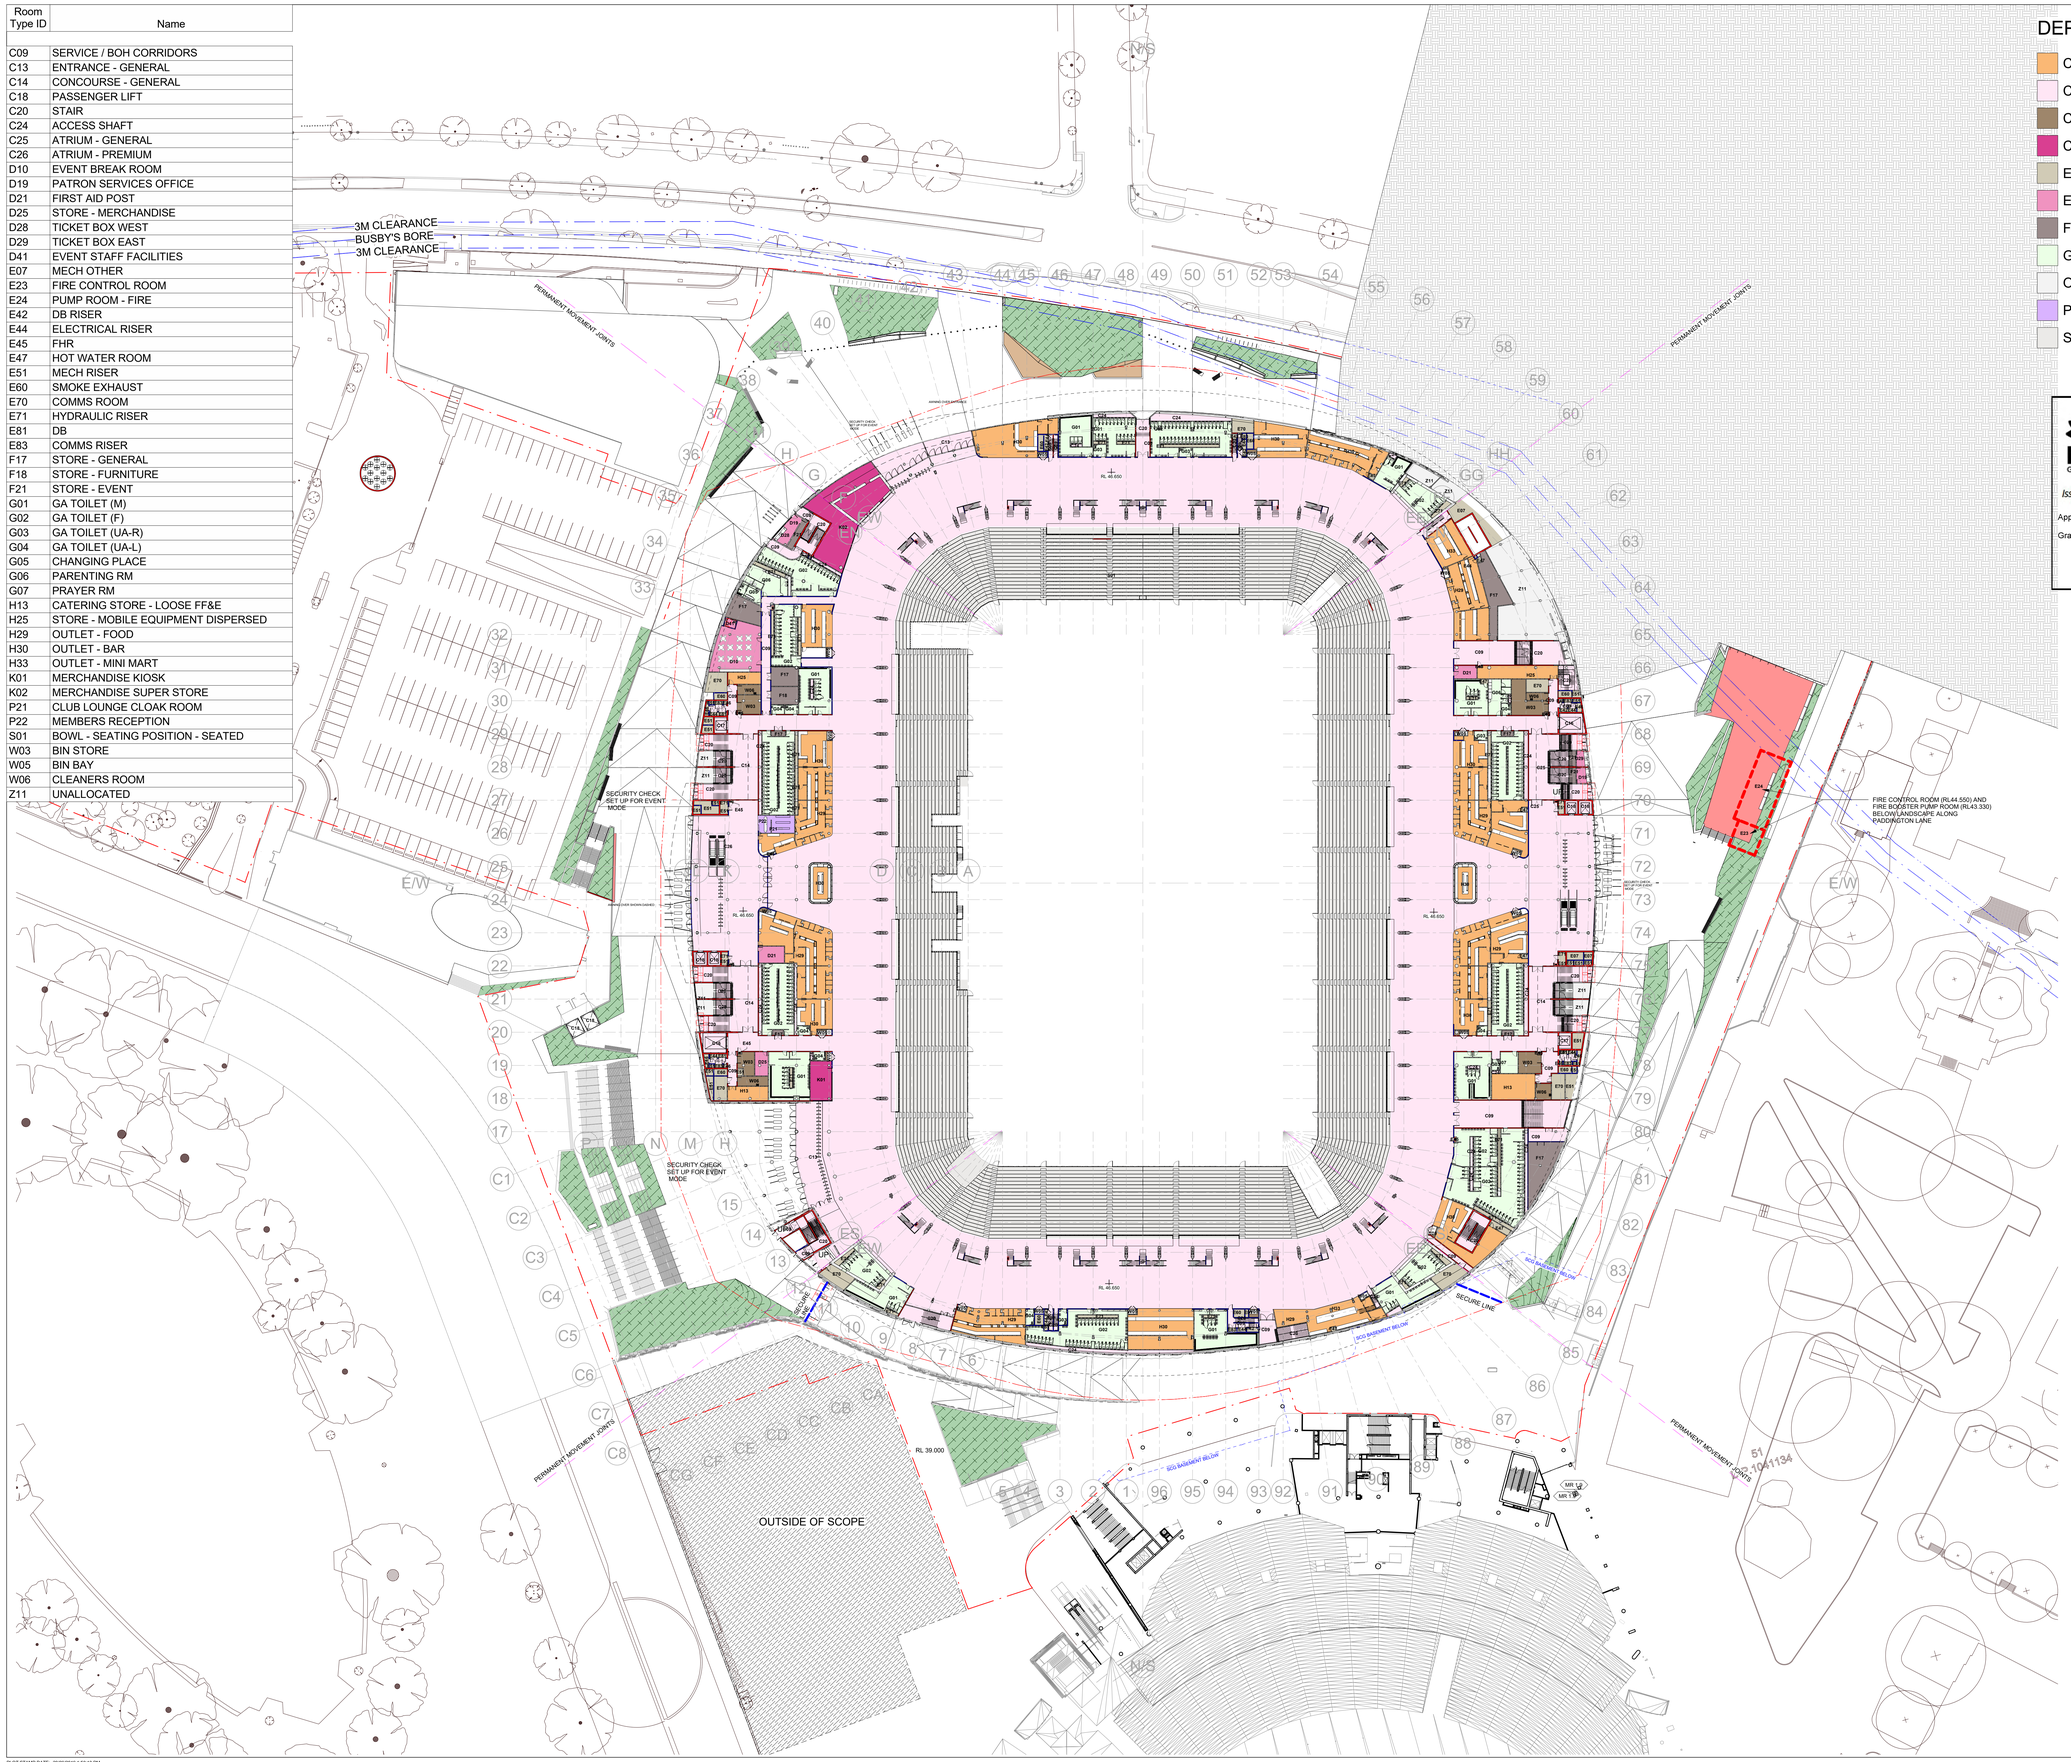


## DEPARTMENT LEGEND

- CATERING FACILITIES
- CIRCULATION AREAS
- CLEANING AND WASTE FACILITIES
- COMMERCIAL FACILITIES
- ENGINEERING SERVICES
- EVENT DAY FACILITIES
- FACILITY MANAGEMENT AREAS
- GENERAL ADMISSION AREAS
- OTHER
- PREMIUM AREAS
- SEATING BOWL

## WALL LOADING LEGEND:

- MINIMUM - 2kN
- MINIMUM - 3kN

## LEGEND:

- LOOSE FIT LINE
- SSD BOUNDARY
- EXTENT OF FUTURE MEZZANINE
- TO BE DEMOLISHED
- SP — POP UP CARTS - SERVICE POINT

Notes:
ALLOW FOR SUB ROOF TO THE FOLLOWING ROOMS IN ORDER TO PROTECT EQUIPMENT AGAINST WET SERVICES ABOVE (WHERE APPLICABLE):
- DAS, MCR, COMMS, MDF, GENERATOR, UPS, MAIN SWITCH, HV INTAKE
SUB ROOF TO HAVE SPRINKLER PROTECTION OVER VOID SPACE.
TO BE COORDINATED WITH STRUCTURAL ENGINEER AND SERVICES CONSULTANTS.

REFER TO LANDSCAPE ARCHITECT'S DRAWINGS FOR LANDSCAPE LAYOUT, DETAILS AND DESIGN

LOOSE FURNITURE SHOWN INDICATIVELY ONLY, NOT TO BE INCLUDED IN TENDER COSTING UNLESS INSTRUCTED OTHERWISE

Notes:
PODIUM LEVELS REQUIRE FURTHER COORDINATION. REFER TO LANDSCAPE ARCHITECT DRAWINGS FOR LATEST INFORMATION

© COPYRIGHT COX ARCHITECTURE PTY LTD
ANY FORM OF REPRODUCTION OF THIS DRAWING IN FULL OR IN PART WITHOUT THE WRITTEN PERMISSION OF COX ARCHITECTURE PTY LTD CONSTITUTES AN INFRINGEMENT OF COPYRIGHT

LOCATION PLAN

REFER DWG
- A40.00.01
- A30.EW.01
- A30.NS.01

FOR FACADE EXTENT/TYPE

REFER TO LANDSCAPE ARCHITECTS PLANS FOR LANDSCAPE & PUBLIC DOMAIN

| Rev | Description | By | Date |
|---|---|---|---|
| A | SSDA Stage 2 Issue | | 11.06.19 |
| B | SSDA Stage 2 Issue | | 13.08.19 |
| C | SSDA Stage 2 Issue | | 20.09.19 |

NSW GOVERNMENT Planning, Industry & Environment

*Issued under the Environmental Planning and Assessment Act 1979*

Approved Application No: SSD-9835 Signed:

Granted on the: 6 Dec 2019 Sheet No: 2 of 83

General Notes:
THE CONTRACTOR AND SUB-CONTRACTORS SHALL VERIFY ALL DIMENSIONS OF THIS DRAWING AND SITE CONDITIONS PRIOR TO ANY WORK COMMENCING.

ALL SHOP DRAWINGS SHALL BE SUBMITTED TO THE ARCHITECT. THE MANUFACTURER SHALL NOT COMMENCE ANY WORKS PRIOR TO THE RETURN OF APPROVED SHOP DRAWINGS SIGNED BY THE RELEVANT CONSULTANT.

FIGURED DIMENSIONS TAKE PRECEDENCE OVER SCALED DIMENSIONS.

THIS DRAWING SHOULD BE READ IN CONJUNCTION WITH ALL RELEVANT CONTRACTS, SPECIFICATIONS, DRAWINGS AND CONSULTANT DOCUMENTS.

COPYRIGHT OF THIS DRAWING IS VESTED IN THE PRINCIPAL

NOTE: ALL REVISIONS TO DRAWINGS WILL BE CLOUDED AND TAGGED

Structure Notes:

STRUCTURAL ELEMENTS SHOWN IN ARCHITECTURAL DRAWINGS ARE INDICATIVE ONLY AND INCLUDED FOR SPATIAL CO-ORDINATION PURPOSES ONLY.

FOR FULL STRUCTURAL DESIGN INCLUDING SUPERSTRUCTURE, BOWL STRUCTURE, FOOTING SIZING SIZES & DETAILS, SLAB SIZES & DETAILS, SUB-SOIL & SHORING DETAILS, COLUMN SIZES, STRUCTURAL WALL SIZES & DETAILS REFER STRUCTURAL ENGINEER'S REPORT

FINAL ENGINEERING CONNECTIONS AND MEMBER TYPES TO MATCH ARCHITECTURAL INTENT.

Notes:
REFER TO SERVICE ENGINEER'S DRAWINGS FOR LOCATION OF S.D.F BOXES, GPO'S AND SHIFTING DUCTS. REFER TO SERVICES ENGINEER'S DRAWINGS FOR CO-ORDINATION OF SLAB & WALL 'BLOCKOUTS' AND 'CORED' PENETRATIONS.

REFER TO HYDRAULIC ENGINEER'S SERVICE PLAN FOR LOCATION OF SUB-FLOOR SERVICES.

REFER TO DOOR SCHEDULES FOR DOOR HARDWARE AND FURNITURE DETAILS
REFER TO MECHANICAL ENGINEER'S DRAWINGS AND SHOP DRAWINGS TO CONFIRM SIZES OF ALL DUCT PENETRATIONS AND LOUVRE OPENING SIZES.

REFER TO MECHANICAL ENGINEER'S DETAILS FOR PENETRATIONS AND BUILDING IN OF DUCTS, GRILLES, PLANT AND CEILING PLENUMS.

BUILD IN HIGH LEVEL OPENINGS FOR PLENUMS IN CEILING SPACES. REFER TO MECHANICAL ENGINEERS DRAWING.

FOR ADDITIONAL SETOUT INFORMATION WHERE NO DIMENSIONING SHOWN, REFER TO REFERENCE TAGS FOR DETAILED ARCHITECTURAL DRAWINGS

REFER TO ARCHITECTURAL SPECIFICATION, SCHEDULES AND ROOM DATA SHEETS FOR FF&E AND FINISHES CODES FOR FURTHER DETAIL AND OTHER MISCELLANEOUS ITEMS.

INSW Infrastructure New South Wales

**Cox Architecture**
Level 6, 155 Clarence Street,
Sydney, NSW 2000, Australia
T + 61 2 9267 9599
F + 61 2 9264 5844
www.coxarchitecture.com.au

**ASPECT Studios**
78/80 George St, Redfern,
NSW, 2016, Australia
T + 61 2 9699 7182
www.aspect-studios.com/au

**Nominated Architects**
Joe Agius no. 6491
Russell Lee no. 6367

COX ASPECT Studios®

**Consultants**

Roof Structure & Super Structure
NAME: ARUP
ADDRESS: Level 5 , Barrack Place, 151 Clarence St, Sydney, NSW, 2000
TEL/FAX: 9320 9320

NAME:
ADDRESS:
TEL/FAX:

NAME:
ADDRESS:
TEL/FAX:

**Client**
INSW

**Project No.**
218018.00

**Project**
SYDNEY FOOTBALL STADIUM
Driver Ave, Moore Park NSW 2021

**Drawing Title**
FLOOR PLAN LEVEL 1 (GA CONCOURSE LEVEL)

**Document Control Status:**
DESIGN DEVELOPMENT

| | |
|---|---|
| A0 DRAWING SHEET | **Drawn:** COX |
| **Co-ordinated:** Checker | **Scale:** As indicated @ A0 |
| **Project Architect:** Designer | **Date:** 20.09.19 |
| **Project Director:** Approver | **Revision:** C |
| **Drawing Number:** A13.L1.02 | **North:** |

Cox Architecture Pty Ltd ACN 002 535 891

PLOT STAMP DATE: 20/09/2019 1:50:13 PM

| Room Type ID | Name |
|---|---|
| A01 | ADMINISTRATION ENTRANCE |
| A02 | SCGT MANAGEMENT OFFICE |
| A03 | CEO OFFICE |
| A04 | EXECUTIVE OFFICE |
| A05 | BOARD ROOM |
| A07 | MEETING ROOM (S) |
| A08 | ADMIN BREAKOUT ROOM |
| A09 | ADMINISTRATION STAFF ROOM |
| A10 | UTILITY ROOMS |
| A16 | OFFICE TOILETS - (F) |
| A17 | OFFICE TOILETS - (M) |
| A18 | OFFICE TOILETS - (UA - L) |
| A19 | ADMIN - AIRLOCK |
| C09 | SERVICE / BOH CORRIDORS |
| C20 | STAIR |
| C24 | ACCESS SHAFT |
| C25 | ATRIUM - GENERAL |
| E07 | MECH OTHER |
| E10 | GENERATOR ROOM |
| E12 | SUB-STATION |
| E13 | UPS ROOM |
| E45 | FHR |
| E47 | HOT WATER ROOM |
| E48 | MAIN SWITCH ROOM |
| E51 | MECH RISER |
| E67 | GAS METER ROOM |
| E68 | HV INTAKE ROOM |
| E69 | WATER METER ROOM |
| E70 | COMMS ROOM |
| E71 | HYDRAULIC RISER |
| E86 | FIRE BRIGADE BOOSTER |
| H28 | STORE - KEGS |
| W06 | CLEANERS ROOM |

© COPYRIGHT COX ARCHITECTURE PTY LTD
ANY FORM OF REPRODUCTION OF THIS DRAWING IN FULL OR IN PART WITHOUT THE WRITTEN PERMISSION OF COX ARCHITECTURE PTY LTD CONSTITUTES AN INFRINGEMENT OF COPYRIGHT

NSW GOVERNMENT | Planning, Industry & Environment

*Issued under the Environmental Planning and Assessment Act 1979*

Approved Application No: SSD-9835 Signed:

Granted on the: 6 Dec 2019 Sheet No: 3 of 83

## DEPARTMENT LEGEND

- ADMINISTRATION FACILITIES
- CATERING FACILITIES
- CIRCULATION AREAS
- CLEANING AND WASTE FACILITIES
- ENGINEERING SERVICES

LOCATION PLAN

REFER TO LANDSCAPE ARCHITECTS PLANS FOR LANDSCAPE & PUBLIC DOMAIN

| Rev | Description | By | Date |
|---|---|---|---|
| A | SSDA Stage 2 Issue | | 11.06.19 |
| B | SSDA Stage 2 Issue | | 13.08.19 |
| C | SSDA Stage 2 Issue | | 20.09.19 |

General Notes:
CONTRACTOR AND SUB-CONTRACTORS SHALL VERIFY ALL DIMENSIONS OF THIS DRAWING AND SITE CONDITIONS PRIOR TO ANY WORK COMMENCING.

ALL SHOP DRAWINGS SHALL BE SUBMITTED TO THE ARCHITECT. THE MANUFACTURER SHALL NOT COMMENCE ANY WORKS PRIOR TO THE RETURN OF APPROVED SHOP DRAWINGS SIGNED BY THE RELEVANT CONSULTANT.

FIGURED DIMENSIONS TAKE PRECEDENCE OVER SCALED DIMENSIONS.

THIS DRAWING SHOULD BE READ IN CONJUNCTION WITH ALL RELEVANT CONTRACTS, SPECIFICATIONS, DRAWINGS AND CONSULTANT DOCUMENTS.

COPYRIGHT OF THIS DRAWING IS VESTED IN THE PRINCIPAL

NOTE: ALL REVISIONS TO DRAWINGS WILL BE CLOUDED AND TAGGED

Structure Notes:

STRUCTURAL ELEMENTS SHOWN IN ARCHITECTURAL DRAWINGS ARE INDICATIVE ONLY AND INCLUDED FOR SPATIAL CO-ORDINATION PURPOSES ONLY.

FOR FULL STRUCTURAL DESIGN INCLUDING SUPERSTRUCTURE, BOWL STRUCTURE, FOOTING SIZING SIZES & DETAILS, SLAB SIZES & DETAILS, SUB-SOIL & SHORING CONSTRUCTION, SUPERSTRUCTURAL WALL SIZES & DETAILS REFER STRUCTURAL ENGINEER'S REPORT

FINAL ENGINEERING CONNECTIONS AND MEMBER TYPES TO MATCH ARCHITECTURAL INTENT.

Notes:
REFER TO SERVICE ENGINEER'S DRAWINGS FOR LOCATION OF S.D.F BOXES, GPO'S AND SKIRTING DUCTS. REFER TO SERVICES ENGINEER'S DRAWINGS FOR CO-ORDINATION OF SLAB & WALL 'BLOCKOUTS' AND 'CORED' PENETRATIONS.

REFER TO HYDRAULIC ENGINEER'S SERVICE PLANS FOR LOCATION OF SUB-FLOOR SERVICES.

REFER TO DOOR SCHEDULES FOR DOOR HARDWARE AND FURNITURE DETAILS
REFER TO MECHANICAL ENGINEERS DRAWINGS AND SHOP DRAWINGS TO CONFIRM SIZES OF ALL DUCT PENETRATIONS AND LOUVRE OPENING SIZES.

REFER TO MECHANICAL ENGINEER'S DETAILS FOR PENETRATIONS AND BUILDING IN OF DUCTS, GRILLES, PLANT AND CEILING PLENUMS.

BUILD IN HIGH LEVEL OPENINGS FOR PLENUMS IN CEILING SPACES. REFER TO MECHANICAL ENGINEER'S DRAWING

FOR ADDITIONAL SETOUT INFORMATION WHERE NO DIMENSIONING SHOWN, REFER TO REFERENCE TAGS FOR DETAILED ARCHITECTURAL DRAWINGS.

REFER TO ARCHITECTURAL SPECIFICATION, SCHEDULES AND ROOM DATA SHEETS FOR FF&E AND FINISHES CODES FOR FURTHER DETAIL AND OTHER MISCELLANEOUS ITEMS.

insw Infrastructure New South Wales

**Cox Architecture**
Level 6, 155 Clarence Street,
Sydney, NSW 2000, Australia
T + 61 2 9267 9599
F + 61 2 9264 5844
www.coxarchitecture.com.au

**ASPECT Studios**
78/80 George St. Redfern,
NSW, 2016, Australia
T + 61 2 9699 7182
www.aspect-studios.com/au

**Nominated Architects**
Jon Agius no. 6481
Russell Lee no. 6367

**Consultants**

Roof Structure & Super Structure
NAME: ARUP
ADDRESS: Level 5, Barrack Place, 151 Clarence St, Sydney, NSW, 2000
TEL/FAX: 9320 9320

NAME:
ADDRESS:
TEL/FAX:

NAME:
ADDRESS:
TEL/FAX:

**Client**
INSW

**Project No.**
218018.00

**Project**
SYDNEY FOOTBALL STADIUM
Driver Ave, Moore Park NSW 2021

**Drawing Title**
FLOOR PLAN LEVEL 1 (CONCOURSE MEZZANINE PLAN)

**Document Control Status:**
DESIGN DEVELOPMENT

| | |
|---|---|
| AS DRAWING SHEET | **Drawn:** Author |
| **Co-ordinated:** Checker | **Scale:** As indicated @ A0 |
| **Project Architect:** Designer | **Date:** 20.09.19 |
| **Project Director:** Approver | **Revision:** C |
| **Drawing Number:** A13.L1M.03 | **North:** |

Cox Architecture Pty Ltd ACN 002 535 881

3M CLEARANCE
BUSBY'S BORE
3M CLEARANCE

PERMANENT MOVEMENT JOINTS

SUB ROOF AT RL 49.650 (BLUE HATCH)

SUB ROOF AT RL 99.620 (BLUE HATCH)

GAS ASSEMBLY AND METER IN LANDSCAPE

RL 51.150

PODIUM LEVELS REQUIRE FURTHER COORDINATION - REFER TO LANDSCAPE ARCHITECTS DRAWINGS FOR DETAILS

FIRE BOOSTER ASSEMBLY NEXT TO PADDINGTON LANE

SHELL ONLY
OUTSIDE OF SCOPE

2kN LOADING BALUSTRADE TO BE CONFIRMED BY STRUCTURAL ENGINEER

SUB ROOF AT RL 69.650 (BLUE HATCH)

REFER DWG
- A40.00.01
- A30.EW.01
- A30.NS.01

FOR FACADE EXTENT/TYPE

WALL LOADING LEGEND:

MINIMUM - 2kN
MINIMUM - 3kN

LEGEND:

LOOSE FIT LINE
SSD BOUNDARY
EXTENT OF FUTURE MEZZANINE TO BE DEMOLISHED
SP POP UP CARTS - SERVICE POINT

Notes:
ALLOW FOR SUB ROOF TO THE FOLLOWING ROOMS IN ORDER TO PROTECT EQUIPMENT AGAINST WET SERVICES ABOVE (WHERE APPLICABLE):
- DAS, MCR, COMMS, MDF, GENERATOR, UPS, MAIN SWITCH, HV INTAKE
SUB ROOF TO HAVE SPRINKLER PROTECTION OVER VOID SPACE.
TO BE COORDINATED WITH STRUCTURAL ENGINEER AND SERVICES CONSULTANTS.

REFER TO LANDSCAPE ARCHITECT'S DRAWINGS FOR LANDSCAPE LAYOUT, DETAILS AND DESIGN


LOOSE FURNITURE SHOWN INDICATIVELY ONLY, NOT TO BE INCLUDED IN TENDER COSTING UNLESS INSTRUCTED OTHERWISE

Notes:
PODIUM LEVELS REQUIRE FURTHER COORDINATION. REFER TO LANDSCAPE ARCHITECT DRAWINGS FOR LATEST INFORMATION

PLOT STAMP DATE: 20/09/2019 1:54:42 PM


## X - LEGEND - LEVEL 2

| Room Type ID | Name |
|---|---|
| | |
| C09 | SERVICE / BOH CORRIDORS |
| C15 | CONCOURSE - PREMIUM |
| C20 | STAIR |
| C22 | ESCALATOR |
| C24 | ACCESS SHAFT |
| C26 | ATRIUM - PREMIUM |
| D21 | FIRST AID POST |
| E42 | DB RISER |
| E45 | FHR |
| E47 | HOT WATER ROOM |
| E51 | MECH RISER |
| E70 | COMMS ROOM |
| E71 | HYDRAULIC RISER |
| F17 | STORE - GENERAL |
| F18 | STORE - FURNITURE |
| H13 | CATERING STORE - LOOSE FF&E |
| H22 | SATELLITE KITCHEN |
| H28 | STORE - KEGS |
| H29 | OUTLET - FOOD |
| H30 | OUTLET - BAR |
| P05 | HIRERS DINING ROOM |
| P07 | MEMBERS RESERVE |
| P11 | PREM TOILETS - (M) |
| P12 | PREM TOILETS - (F) |
| P13 | PREM TOILETS - (UA-R) |
| P14 | PREM TOILETS - (UA-L) |
| P17 | PREM PARENTING RM |
| P18 | PREMIUM TERRACE |
| P19 | PREMIUM LOUNGE |
| P20 | PREMIUM LOUNGE CLOAK ROOM |
| P21 | CLUB LOUNGE CLOAK ROOM |
| P26 | PREM TOILETS - AIRLOCK |
| P31 | MEMBERS TERRACE |
| P32 | CORPORATE CORRIDOR |
| S01 | BOWL - SEATING POSITION - SEATED |
| S05 | BOWL - CORPORATE BOXES |
| S10 | BOWL - MEMBERS SEATS |
| S18 | BOWL - PREMIUM TERRACE |
| S23 | BOWL - PREMIUM LOUNGE |
| W03 | BIN STORE |
| W05 | BIN BAY |
| W06 | CLEANERS ROOM |

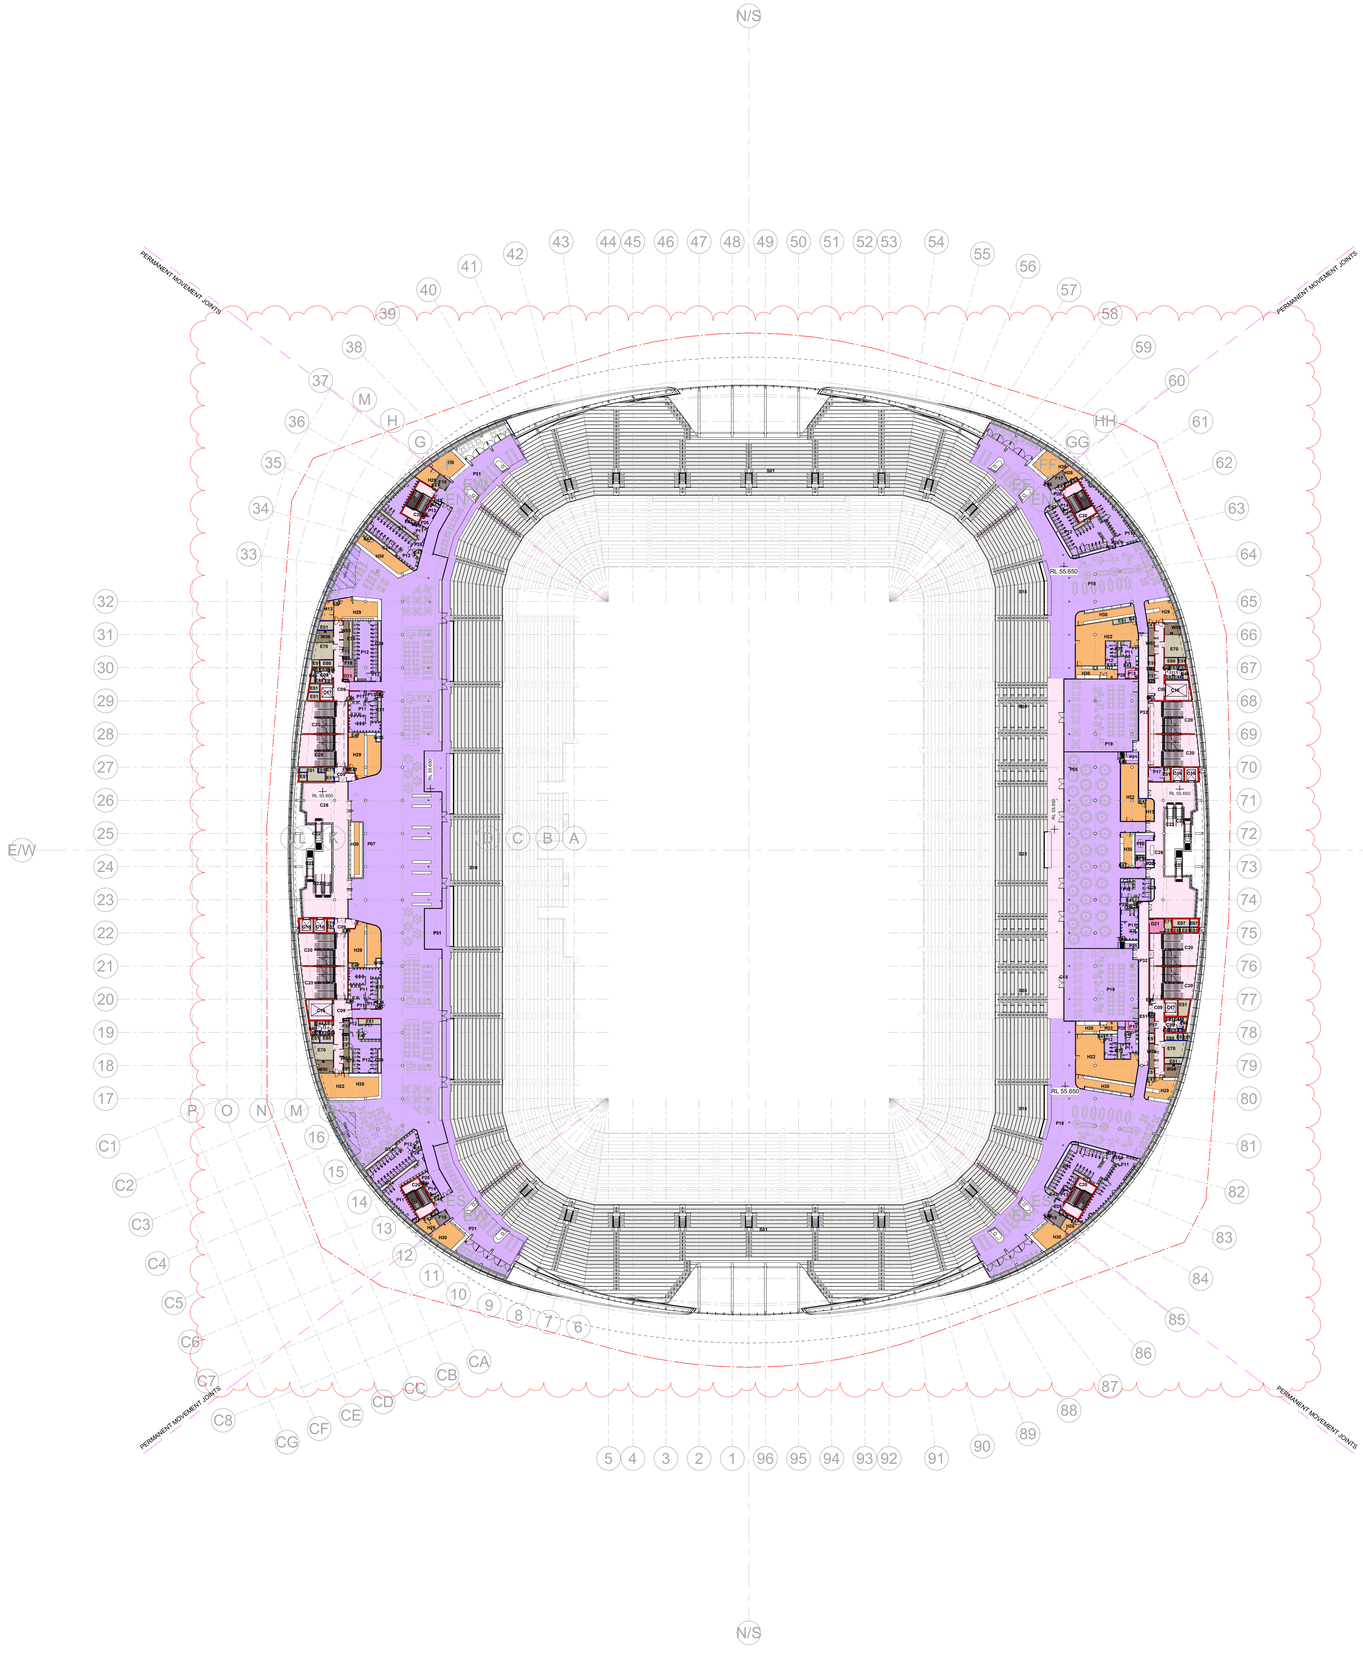
N/S
E/W
E/W
N/S
PERMANENT MOVEMENT JOINTS
PERMANENT MOVEMENT JOINTS
PERMANENT MOVEMENT JOINTS
PERMANENT MOVEMENT JOINTS
RL 55.650
RL 55.650
RL 55.650

## X - LEGEND - LEVEL 3

| Room Type ID | Name |
|---|---|
| C09 | SERVICE / BOH CORRIDORS |
| C16 | GOODS LIFT |
| C20 | STAIR |
| C22 | ESCALATOR |
| C24 | ACCESS SHAFT |
| C26 | ATRIUM - PREMIUM |
| D14 | IN-HOUSE VIDEO PRODUCTION |
| D16 | PA SYSTEM CONTROL ROOM |
| D21 | FIRST AID POST |
| D38 | PRODUCTION BREAKOUT ROOM |
| D39 | PRODUCTION OPERATIONS ROOM |
| E45 | FHR |
| E46 | FIRE RISER |
| E47 | HOT WATER ROOM |
| E51 | MECH RISER |
| E70 | COMMS ROOM |
| E71 | HYDRAULIC RISER |
| E78 | SERVER RACKS |
| F17 | STORE - GENERAL |
| F18 | STORE - FURNITURE |
| H22 | SATELLITE KITCHEN |
| H30 | OUTLET - BAR |
| M02 | MEDIA STORE |
| M12 | TV COMMENTARY BOX |
| M13 | STUDIO BOX |
| M14 | RADIO BOX (L) |
| M15 | RADIO BOX (S) |
| M16 | WRITTEN PRESS |
| M17 | MEDIA LOUNGE |
| M18 | MAKE-UP STUDIO |
| M19 | MEDIA TOILET (M) |
| M20 | MEDIA TOILET (F) |
| M21 | MEDIA - TOILET (UA) |
| M23 | PRESS VIDEO BOOTH |
| P08 | SUITE |
| P09 | SUPER SUITE |
| P10 | DIAMOND CLUB |
| P11 | PREM TOILETS - (M) |
| P12 | PREM TOILETS - (F) |
| P13 | PREM TOILETS - (UA-R) |
| P14 | PREM TOILETS - (UA-L) |
| P23 | SUPER SUITE RECEPTION & CLOAK |
| P24 | DIAMOND CLUB RECEPTION & CLOAK |
| P25 | SUITE TERRACE |
| P26 | PREM TOILETS - AIRLOCK |
| P27 | SUPER SUITE TOILETS - (UA-R) |
| P28 | SUPER SUITE TOILETS - AIRLOCK |
| P29 | SUPER SUITE TOILETS - (F) |
| P30 | SUPER SUITE TOILETS - (M) |
| P33 | SUITE CORRIDOR |
| S11 | BOWL - SUITE |
| S12 | BOWL - SUPER SUITE |
| T12 | COACHES BOXES |
| T22 | OFFICIALS BOX |
| T26 | COACHES TOILET (UA) |
| W03 | BIN STORE |
| W06 | CLEANERS ROOM |
| Z01 | VOID |
| Z04 | OUTDOOR TERRACE |
| Z11 | UNALLOCATED |

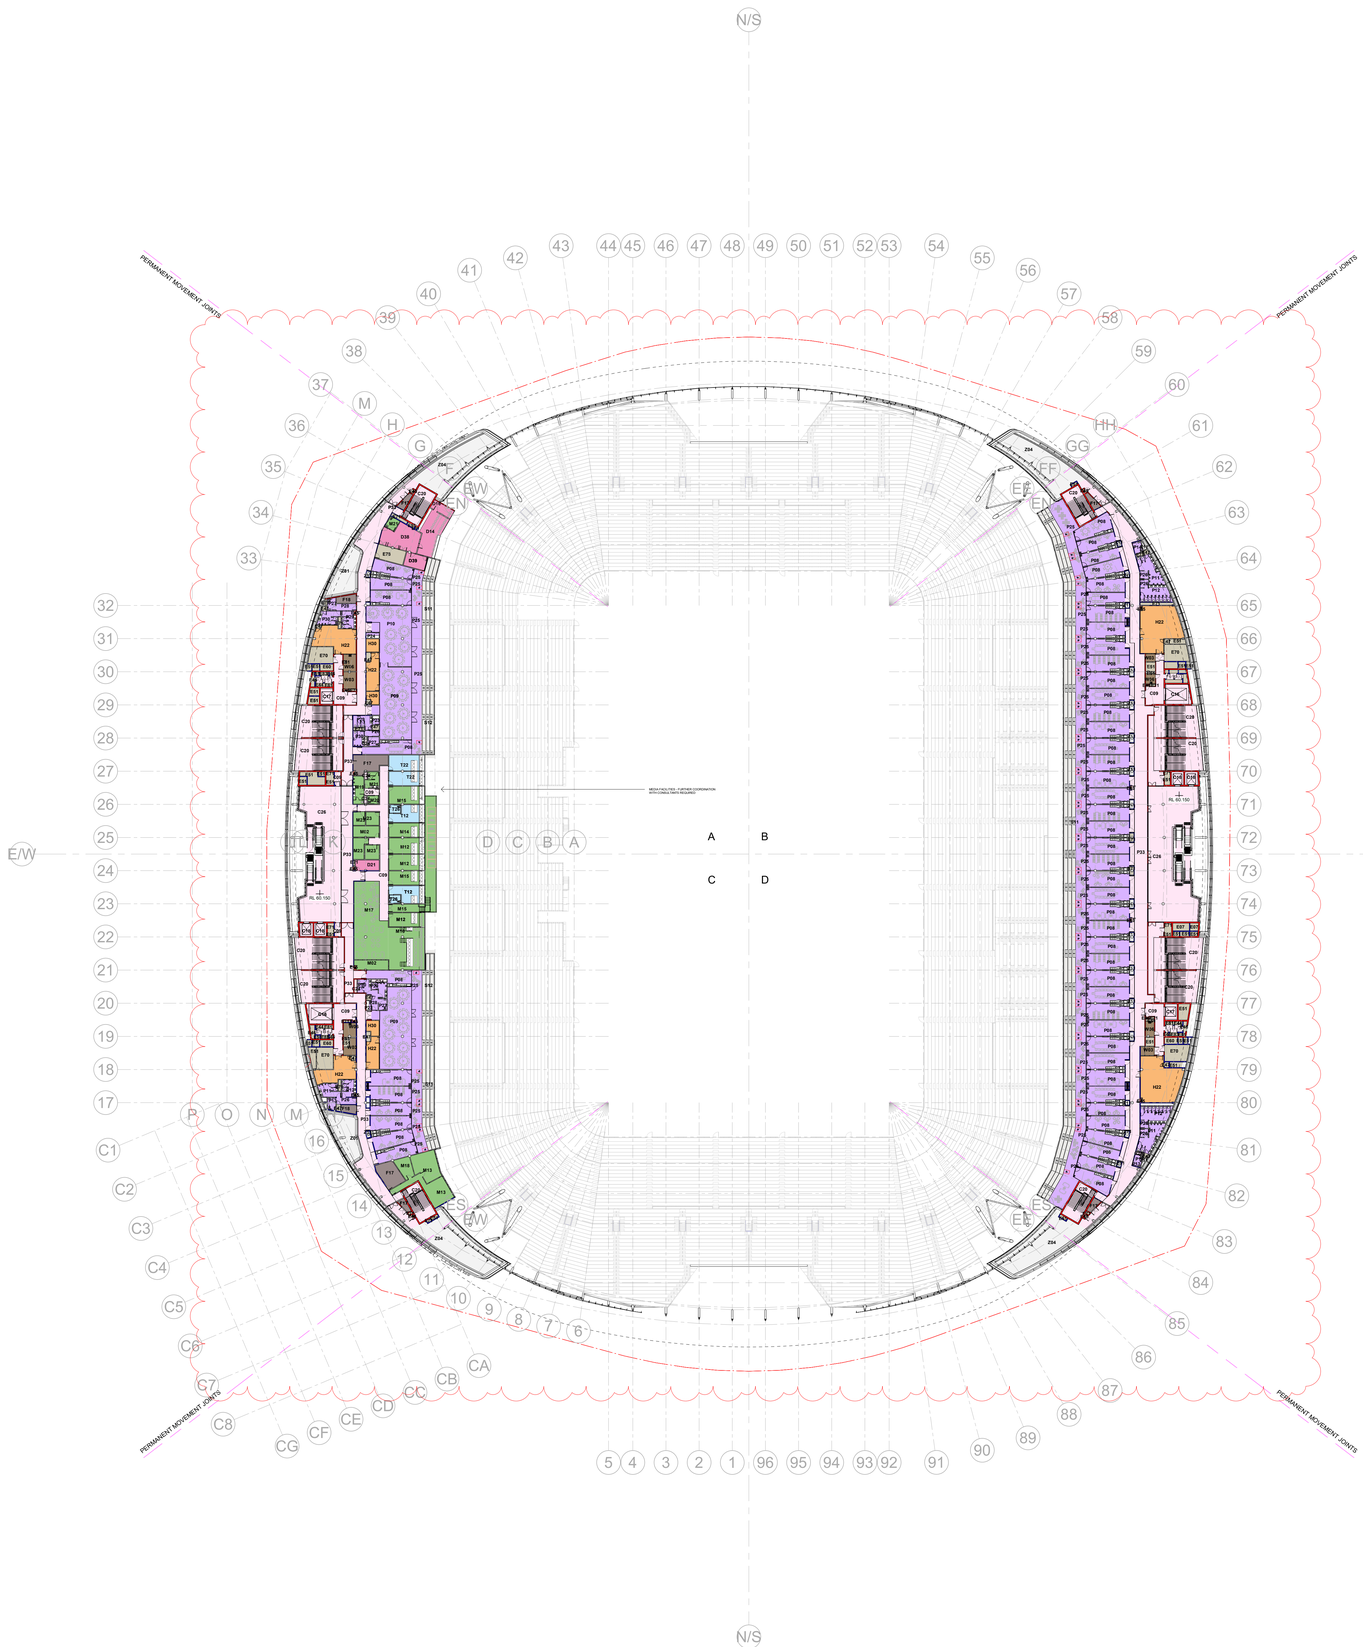


## DEPARTMENT LEGEND

- CATERING FACILITIES
- CIRCULATION AREAS
- CLEANING AND WASTE FACILITIES
- ENGINEERING SERVICES
- EVENT DAY FACILITIES
- FACILITY MANAGEMENT AREAS
- MEDIA FACILITIES
- OTHER
- PREMIUM AREAS
- SEATING BOWL
- TEAM FACILITIES

NSW GOVERNMENT | Planning, Industry & Environment

*Issued under the Environmental Planning and Assessment Act 1979*

Approved Application No: SSD-9835 Signed:

Granted on the: 6 Dec 2019 Sheet No: 5 of 83

WALL LOADING LEGEND:

MINIMUM - 2kN/m²
MINIMUM - 3kN/m²

LEGEND:

LOOSE FIT LINE
SSD BOUNDARY
EXTENT OF FUTURE MEZZANINE TO BE DEMOLISHED
SP POP UP CARTS - SERVICE POINT

Notes:
ALLOW FOR SUB ROOF TO THE FOLLOWING ROOMS IN ORDER TO PROTECT EQUIPMENT AGAINST WET SERVICES ABOVE (WHERE APPLICABLE):
- DAS, MCR, COMMS, MDF, GENERATOR, UPS, MAIN SWITCH, HV INTAKE
SUB ROOF TO HAVE SPRINKLER PROTECTION OVER VOID SPACE.
TO BE COORDINATED WITH STRUCTURAL ENGINEER AND SERVICES CONSULTANTS.

REFER TO LANDSCAPE ARCHITECT'S DRAWINGS FOR LANDSCAPE LAYOUT, DETAILS AND DESIGN

LOOSE FURNITURE SHOWN INDICATIVELY ONLY, NOT TO BE INCLUDED IN TENDER COSTING UNLESS INSTRUCTED OTHERWISE

Notes:
PODIUM LEVELS REQUIRE FURTHER COORDINATION. REFER TO LANDSCAPE ARCHITECT DRAWINGS FOR LATEST INFORMATION

© COPYRIGHT COX ARCHITECTURE PTY LTD
ANY FORM OF REPRODUCTION OF THIS DRAWING IN FULL OR IN PART WITHOUT THE WRITTEN PERMISSION OF COX ARCHITECTURE PTY LTD CONSTITUTES AN INFRINGEMENT OF COPYRIGHT

LOCATION PLAN

REFER DWG
- A40.00.01
- A30.EW.01
- A30.NS.01

FOR FACADE EXTENT/TYPE

| Rev | Description | By | Date |
|---|---|---|---|
| A | SSDA Stage 2 Issue | | 11.06.19 |
| B | SSDA Stage 2 Issue | | 13.08.19 |
| C | SSDA Stage 2 Issue | | 20.09.19 |

General Notes:
CONTRACTOR AND SUB-CONTRACTORS SHALL VERIFY ALL DIMENSIONS OF THIS DRAWING AND SITE CONDITIONS PRIOR TO ANY WORK COMMENCING.

ALL SHOP DRAWINGS SHALL BE SUBMITTED TO THE ARCHITECT. THE MANUFACTURER SHALL NOT COMMENCE ANY WORKS PRIOR TO THE RETURN OF APPROVED SHOP DRAWINGS SIGNED BY THE RELEVANT CONSULTANT.

FIGURED DIMENSIONS TAKE PRECEDENCE OVER SCALES DIMENSIONS.

THIS DRAWING SHOULD BE READ IN CONJUNCTION WITH ALL RELEVANT CONTRACTS, SPECIFICATIONS, DRAWINGS AND CONSULTANT DOCUMENTS.

COPYRIGHT OF THIS DRAWING IS VESTED IN THE PRINCIPAL

NOTE: ALL REVISIONS TO DRAWINGS WILL BE CLOUDED AND TAGGED

Structure Notes:

STRUCTURAL ELEMENTS SHOWN IN ARCHITECTURAL DRAWINGS ARE INDICATIVE ONLY AND INCLUDED FOR SPATIAL CO-ORDINATION PURPOSES ONLY.

FOR FULL STRUCTURAL DESIGN INCLUDING SUPERSTRUCTURE, BOWL STRUCTURE, SUPERSTRUCTURE SIZES & DETAILS, SLAB SIZES & DETAILS, SUB-SOIL & SHORING DETAILS, FOOTING SIZES, STRUCTURAL WALL SIZES & DETAILS REFER STRUCTURAL ENGINEER'S REPORT

FINAL ENGINEERING CONNECTIONS AND MEMBER TYPES TO MATCH ARCHITECTURAL INTENT.

Notes:
REFER TO SERVICE ENGINEER'S DRAWINGS FOR LOCATION OF S.D.F BOXES, GPO'S AND SKIRTING DUCTS. REFER TO SERVICES ENGINEER'S DRAWINGS FOR CO-ORDINATION OF SLAB & WALL 'BLOCKOUTS' AND 'CORED' PENETRATIONS.

REFER TO HYDRAULIC ENGINEER'S SERVICE PLAN FOR LOCATION OF SUB-FLOOR SERVICES.

REFER TO DOOR SCHEDULES FOR DOOR HARDWARE AND FURNITURE DETAILS
REFER TO MECHANICAL ENGINEER'S DRAWINGS AND SHOP DRAWINGS TO CONFIRM SIZES OF ALL DUCT PENETRATIONS AND LOUVRE OPENING SIZES.

REFER TO MECHANICAL ENGINEER'S DETAILS FOR PENETRATIONS AND BUILDING IN OF DUCTS, GRILLES, PLANT AND CEILING PLENUMS.

BUILD IN HIGH LEVEL OPENINGS FOR PLENUMS IN CEILING SPACES. REFER TO MECHANICAL ENGINEER'S DRAWING.

FOR ADDITIONAL SETOUT INFORMATION WHERE NO DIMENSIONING SHOWN, REFER TO REFERENCE TAGS FOR DETAILED ARCHITECTURAL DRAWINGS.

REFER TO ARCHITECTURAL SPECIFICATION, SCHEDULES AND ROOM DATA SHEETS FOR FF&E AND FINISHES CODES FOR FURTHER DETAIL AND OTHER MISCELLANEOUS ITEMS.

insw Infrastructure New South Wales

**Cox Architecture**
Level 6, 155 Clarence Street,
Sydney, NSW 2000, Australia
T + 61 2 9267 9599
F + 61 2 9264 5844
www.coxarchitecture.com.au

**ASPECT Studios**
78/80 George St, Redfern,
NSW, 2016, Australia
T + 61 2 9699 7182
www.aspect-studios.com/au

**Nominated Architects**
Jon Agius no. 6367
Russell Lee no. 6367

COX ASPECT Studios

**Consultants**

Roof Structure & Super Structure
NAME: ARUP
ADDRESS: Level 5 , Barrack Place, 151 Clarence St, Sydney, NSW, 2000
TEL/FAX: 9320 9320

NAME:
ADDRESS:
TEL/FAX:

NAME:
ADDRESS:
TEL/FAX:

**Client**
INSW

**Project No.**
218018.00

**Project**
SYDNEY FOOTBALL STADIUM
Driver Ave, Moore Park NSW 2021

**Drawing Title**
FLOOR PLAN LEVEL 3 (SUITE PLAN)


**Document Control Status:**
DESIGN DEVELOPMENT

| | |
|---|---|
| A0 DRAWING SHEET | **Drawn:** Author |
| **Co-ordinated:** Checker | **Scale:** As indicated @ A0 |
| **Project Architect:** Designer | **Date:** 20.09.19 |
| **Project Director:** Approver | **Revision:** C |
| **Drawing Number:** A13.L3.05 | **North:** |

Cox Architecture Pty Ltd ACN 002 535 891

PLOT STAMP DATE: 23/09/2019 10:48:10 AM

| Room Type ID | Name |
|---|---|
| C09 | SERVICE / BOH CORRIDORS |
| C14 | CONCOURSE - GENERAL |
| C18 | PASSENGER LIFT |
| C20 | STAIR |
| C24 | ACCESS SHAFT |
| C25 | ATRIUM - GENERAL |
| D21 | FIRST AID POST |
| E45 | FHR |
| E46 | FIRE RISER |
| E47 | HOT WATER ROOM |
| E51 | MECH RISER |
| E70 | COMMS ROOM |
| F17 | STORE - GENERAL |
| G01 | GA TOILET (M) |
| G02 | GA TOILET (F) |
| G03 | GA TOILET (UA-R) |
| G04 | GA TOILET (UA-L) |
| H28 | STORE - KEGS |
| H29 | OUTLET - FOOD |
| H30 | OUTLET - BAR |
| P17 | PREM PARENTING RM |
| S02 | BOWL - SEATING POSITION - SEATED UB |
| W03 | BIN STORE |
| W05 | BIN BAY |
| W06 | CLEANERS ROOM |
| Z04 | OUTDOOR TERRACE |

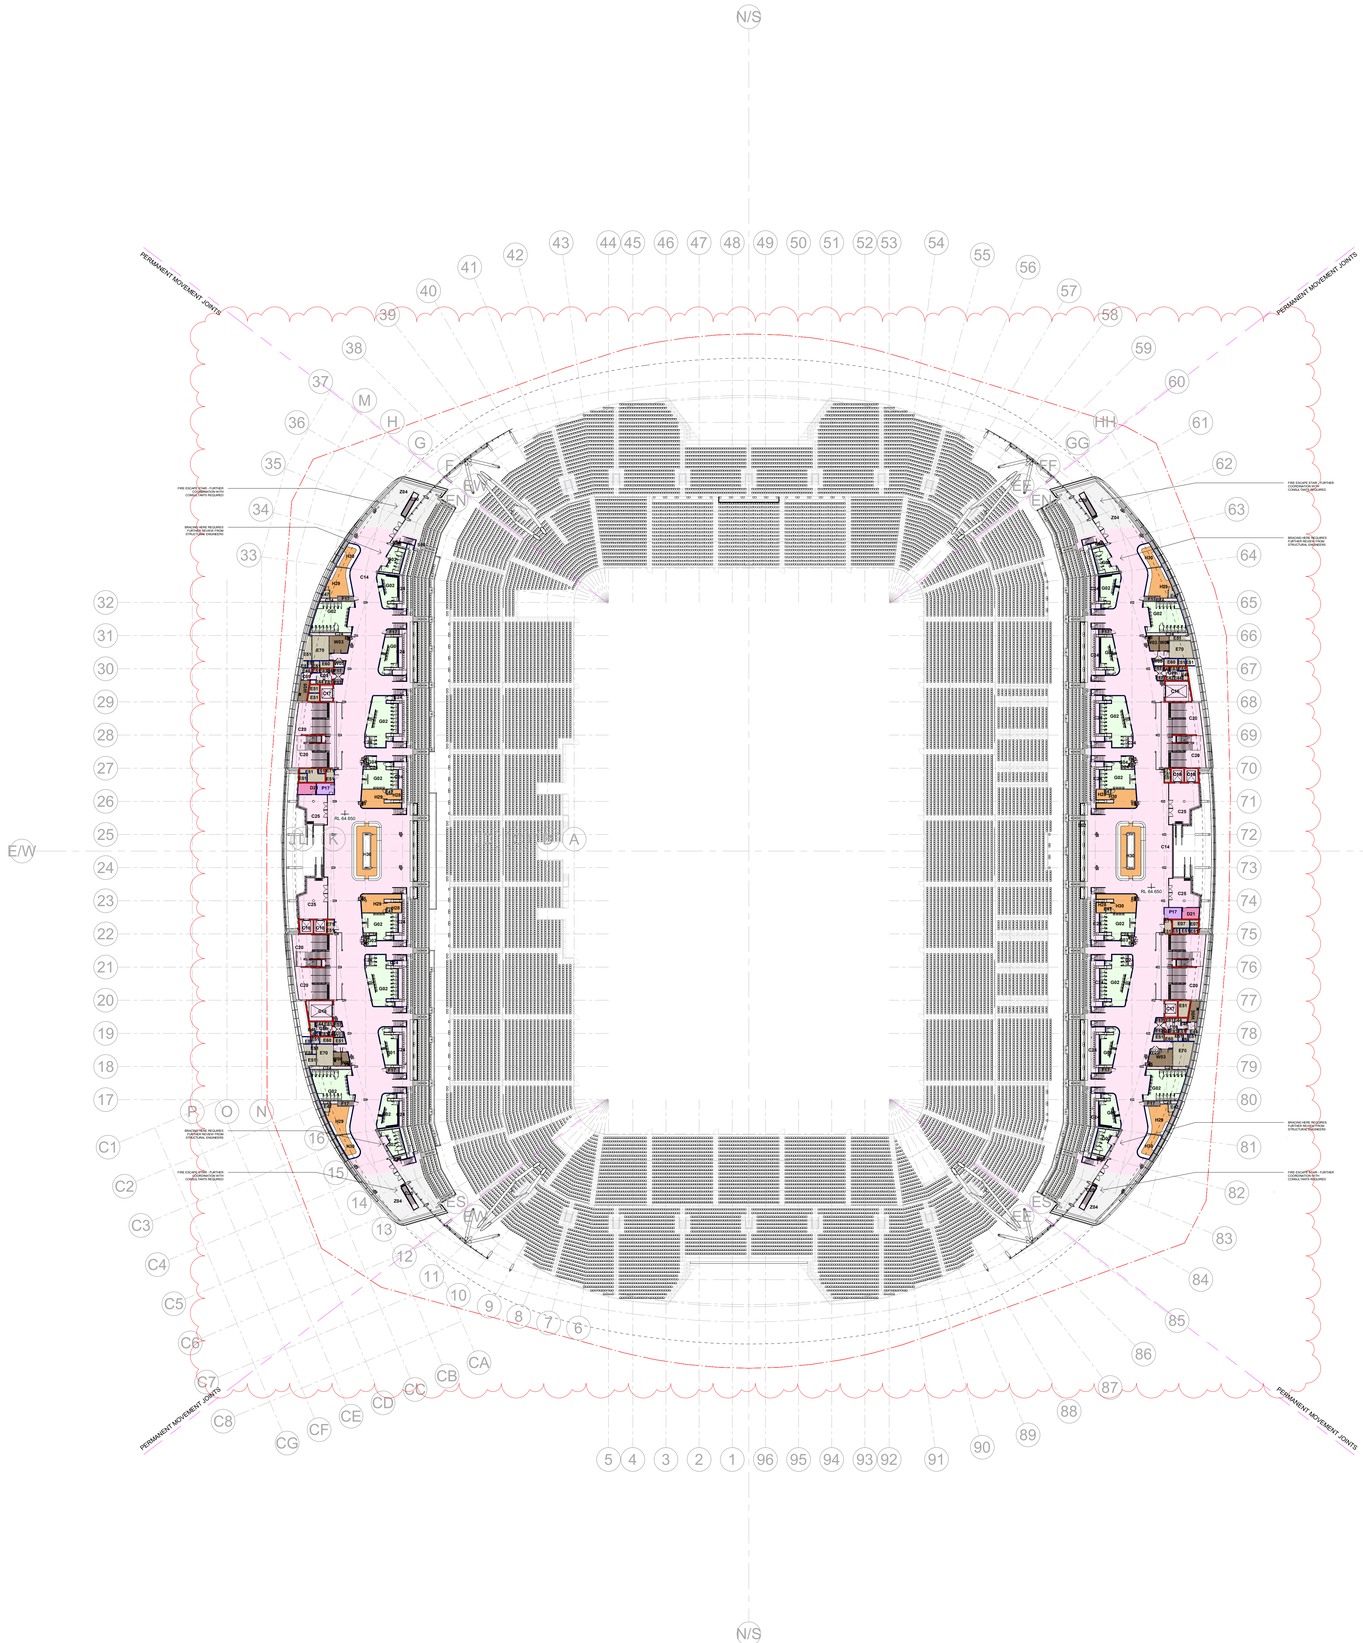


## DEPARTMENT LEGEND

- CATERING FACILITIES
- CIRCULATION AREAS
- CLEANING AND WASTE FACILITIES
- ENGINEERING SERVICES
- EVENT DAY FACILITIES
- FACILITY MANAGEMENT AREAS
- GENERAL ADMISSION AREAS
- OTHER
- PREMIUM AREAS
- SEATING BOWL

© COPYRIGHT COX ARCHITECTURE PTY LTD
ANY FORM OF REPRODUCTION OF THIS DRAWING IN FULL OR IN PART WITHOUT THE WRITTEN PERMISSION OF COX ARCHITECTURE PTY LTD CONSTITUTES AN INFRINGEMENT OF COPYRIGHT



LOCATION PLAN

REFER DWG
- A40.00.01
- A30.EW.01
- A30.NS.01

FOR FACADE EXTENT/TYPE

| Rev | Description | By | Date |
|---|---|---|---|
| A | SSDA Stage 2 Issue | | 11.06.19 |
| B | SSDA Stage 2 Issue | | 13.08.19 |
| C | SSDA Stage 2 Issue | | 20.09.19 |

General Notes:
CONTRACTOR AND SUB-CONTRACTORS SHALL VERIFY ALL DIMENSIONS OF THIS DRAWING AND SITE CONDITIONS PRIOR TO ANY WORK COMMENCING.

ALL SHOP DRAWINGS SHALL BE SUBMITTED TO THE ARCHITECT. THE MANUFACTURER SHALL NOT COMMENCE ANY WORKS PRIOR TO THE RETURN OF APPROVED SHOP DRAWINGS SIGNED BY THE RELEVANT CONSULTANT.

FIGURED DIMENSIONS TAKE PRECEDENCE OVER SCALED DIMENSIONS.

THIS DRAWING SHOULD BE READ IN CONJUNCTION WITH ALL RELEVANT CONTRACTS, SPECIFICATIONS, DRAWINGS AND CONSULTANT DOCUMENTS.

COPYRIGHT OF THIS DRAWING IS VESTED IN THE PRINCIPAL.

NOTE: ALL REVISIONS TO DRAWINGS WILL BE CLOUDED AND TAGGED

Structure Notes:

STRUCTURAL ELEMENTS SHOWN IN ARCHITECTURAL DRAWINGS ARE INDICATIVE ONLY AND INCLUDED FOR SPATIAL CO-ORDINATION PURPOSES ONLY.

FOR FULL STRUCTURAL DESIGN INCLUDING SUPERSTRUCTURE, BOWL STRUCTURE, FOUNDATION SIZES & DETAILS, SLAB SIZES & DETAILS, SUB-SOIL & SHORING SUPERSTRUCTURE, STRUCTURAL WALL SIZES & DETAILS REFER STRUCTURAL ENGINEER'S REPORT

FINAL ENGINEERING CONNECTIONS AND MEMBER TYPES TO MATCH ARCHITECTURAL INTENT.

Notes:
REFER TO SERVICE ENGINEER'S DRAWINGS FOR LOCATION OF S.D.F BOXES, GPO'S AND SKIRTING DUCTS. REFER TO SERVICES ENGINEER'S DRAWINGS FOR CO-ORDINATION OF SLAB & WALL 'BLOCKOUTS' AND 'CORED' PENETRATIONS.

REFER TO HYDRAULIC ENGINEER'S SERVICE PLAN FOR LOCATION OF SUB-FLOOR SERVICES.

REFER TO DOOR SCHEDULES FOR DOOR HARDWARE AND FURNITURE DETAILS
REFER TO MECHANICAL ENGINEER'S DRAWINGS AND SHOP DRAWINGS TO CONFIRM SIZES OF ALL DUCT PENETRATIONS AND LOUVRE OPENING SIZES.

REFER TO MECHANICAL ENGINEER'S DETAILS FOR PENETRATIONS AND BUILDING IN OF DUCTS, GRILLES, PLANT AND CEILING PLENUMS.

BUILD IN HIGH LEVEL OPENINGS FOR PLENUMS IN CEILING SPACES. REFER TO MECHANICAL ENGINEER'S DRAWING.

FOR ADDITIONAL SETOUT INFORMATION WHERE NO DIMENSIONING SHOWN, REFER TO REFERENCE TAGS FOR DETAILED ARCHITECTURAL DRAWINGS.

REFER TO ARCHITECTURAL SPECIFICATION, SCHEDULES AND ROOM DATA SHEETS FOR FF&E AND FINISHES CODES FOR FURTHER DETAIL AND OTHER MISCELLANEOUS ITEMS.

NSW GOVERNMENT Planning, Industry & Environment

*Issued under the Environmental Planning and Assessment Act 1979*

Approved Application No: SSD-9835 Signed:

Granted on the: 6 Dec 2019 Sheet No: 6 of 83

WALL LOADING LEGEND:

MINIMUM - 2kN
MINIMUM - 3kN

LEGEND:

LOOSE FIT LINE
SSD BOUNDARY
EXTENT OF FUTURE MEZZANINE TO BE DEMOLISHED

SP POP UP CARTS - SERVICE POINT

Notes:
ALLOW FOR SUB ROOF TO THE FOLLOWING ROOMS IN ORDER TO PROTECT EQUIPMENT AGAINST WET SERVICES ABOVE (WHERE APPLICABLE):
- DAS, MCR, COMMS, MDF, GENERATOR, UPS, MAIN SWITCH, HV INTAKE

SUB ROOF TO HAVE SPRINKLER PROTECTION OVER VOID SPACE.
TO BE COORDINATED WITH STRUCTURAL ENGINEER AND SERVICES CONSULTANTS.

REFER TO LANDSCAPE ARCHITECT'S DRAWINGS FOR LANDSCAPE LAYOUT, DETAILS AND DESIGN

LOOSE FURNITURE SHOWN INDICATIVELY ONLY, NOT TO BE INCLUDED IN TENDER COSTING UNLESS INSTRUCTED OTHERWISE

Notes:
PODIUM LEVELS REQUIRE FURTHER COORDINATION. REFER TO LANDSCAPE ARCHITECT DRAWINGS FOR LATEST INFORMATION

**Cox Architecture**
Level 6, 155 Clarence Street,
Sydney, NSW 2000, Australia
T + 61 2 9267 9599
F + 61 2 9264 5844
www.coxarchitecture.com.au

**Nominated Architects**
Joe Agius no. 6481
Russell Lee no. 6367

**ASPECT Studios**
78/80 George St. Redfern,
NSW, 2016, Australia
T + 61 2 9699 7182

www.aspect-studios.com/au

**Consultants**

Roof Structure & Super Structure
NAME: ARUP
ADDRESS: Level 5, Barrack Place, 151 Clarence St, Sydney, NSW, 2000
TEL/FAX: 9320 9320

NAME:
ADDRESS:
TEL/FAX:

NAME:
ADDRESS:
TEL/FAX:

**Client**
INSW

**Project No.**
218018.00

**Project**
SYDNEY FOOTBALL STADIUM
Driver Ave, Moore Park NSW 2021

**Drawing Title**
FLOOR PLAN LEVEL 4


**Document Control Status:**
DESIGN DEVELOPMENT

| | |
|---|---|
| A0 DRAWING SHEET | **Drawn:** Author |
| **Co-ordinated:** Checker | **Scale:** As indicated @ A0 |
| **Project Architect:** Designer | **Date:** 20.09.19 |
| **Project Director:** Approver | **Revision:** C |
| **Drawing Number:** A13.L4.06 | **North:** |

© Cox Architecture Pty Ltd ACN 002 535 861

PLOT STAMP DATE: 20/09/2019 2:10:18 PM

| X - LEGEND - LEVEL 5 | |
|---|---|
| Room Type ID | Name |
| C20 | STAIR |
| E07 | MECH OTHER |
| E47 | HOT WATER ROOM |

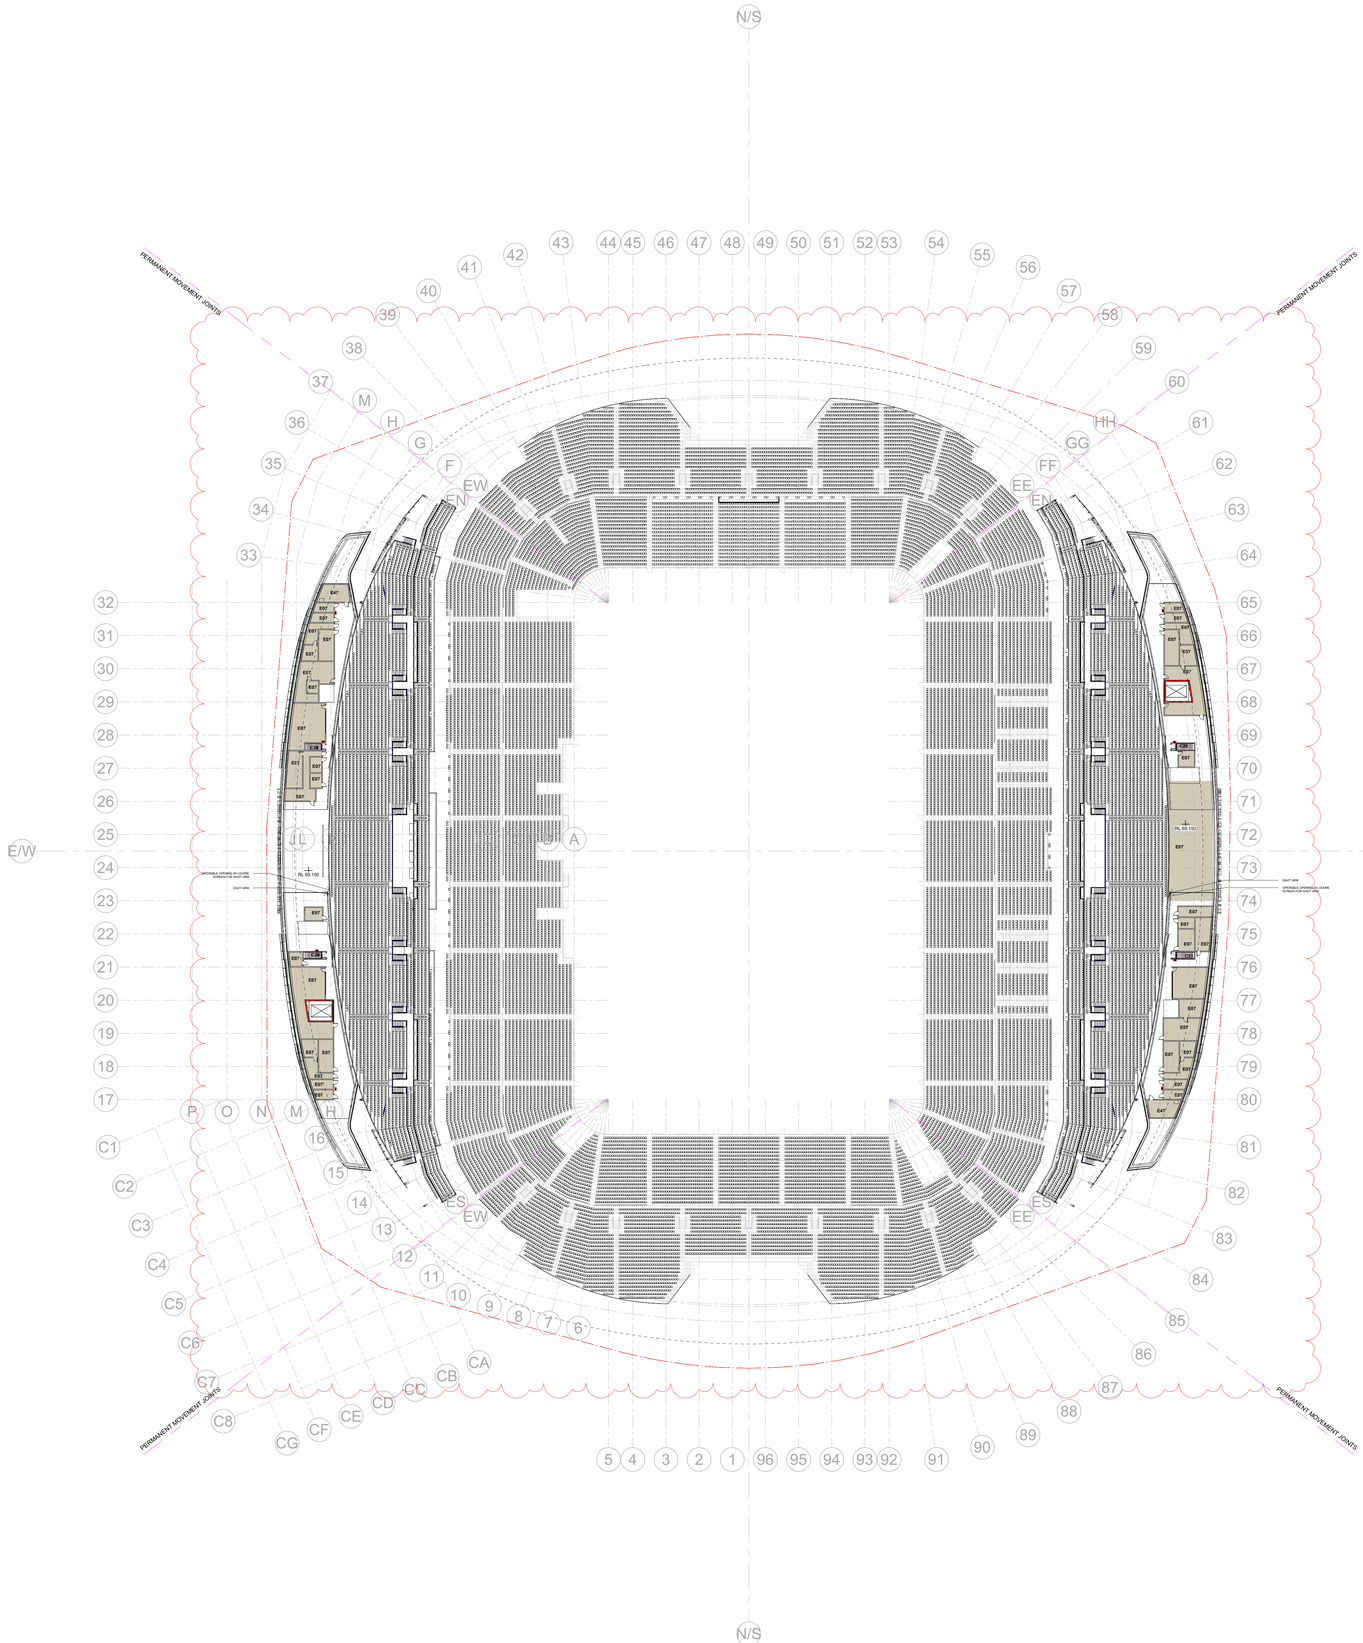


## DEPARTMENT LEGEND

- CIRCULATION AREAS
- ENGINEERING SERVICES

© COPYRIGHT COX ARCHITECTURE PTY LTD

ANY FORM OF REPRODUCTION OF THIS DRAWING IN FULL OR IN PART WITHOUT THE WRITTEN PERMISSION OF COX ARCHITECTURE PTY LTD CONSTITUTES AN INFRINGEMENT OF COPYRIGHT

LOCATION PLAN

REFER DWG
- A40.00.01
- A30.EW.01
- A30.NS.01

FOR FACADE EXTENT/TYPE

| Rev | Description | By | Date |
|---|---|---|---|
| A | SSDA Stage 2 Issue | | 11.06.19 |
| B | SSDA Stage 2 Issue | | 13.08.19 |
| C | SSDA Stage 2 Issue | | 20.09.19 |

NSW GOVERNMENT Planning, Industry & Environment

*Issued under the Environmental Planning and Assessment Act 1979*

Approved Application No: SSD-9835 Signed:

Granted on the: 6 Dec 2019 Sheet No: 7 of 83

General Notes:
CONTRACTOR AND SUB-CONTRACTORS SHALL VERIFY ALL DIMENSIONS OF THIS DRAWING AND SITE CONDITIONS PRIOR TO ANY WORK COMMENCING.

ALL SHOP DRAWINGS SHALL BE SUBMITTED TO THE ARCHITECT. THE MANUFACTURER SHALL NOT COMMENCE ANY WORKS PRIOR TO THE RETURN OF APPROVED SHOP DRAWINGS SIGNED BY THE RELEVANT CONSULTANT.

FIGURED DIMENSIONS TAKE PRECEDENCE OVER SCALES DIMENSIONS.

THIS DRAWING SHOULD BE READ IN CONJUNCTION WITH ALL RELEVANT CONTRACTS, SPECIFICATIONS, DRAWINGS AND CONSULTANT DOCUMENTS.

COPYRIGHT OF THIS DRAWING IS VESTED IN THE PRINCIPAL

NOTE: ALL REVISIONS TO DRAWINGS WILL BE CLOUDED AND TAGGED

Structure Notes:

STRUCTURAL ELEMENTS SHOWN IN ARCHITECTURAL DRAWINGS ARE INDICATIVE ONLY AND INCLUDED FOR SPATIAL CO-ORDINATION PURPOSES ONLY.

FOR FULL STRUCTURAL DESIGN INCLUDING SUPERSTRUCTURE, BOWL STRUCTURE, SUBSTRUCTURE SIZES & DETAILS, SLAB SIZES & DETAILS, SUB-SOIL & SHORING SUBSTRUCTURE SIZES & DETAILS, STRUCTURAL WALL SIZES & DETAILS REFER STRUCTURAL ENGINEER'S REPORT

FINAL ENGINEERING CONNECTIONS AND MEMBER TYPES TO MATCH ARCHITECTURAL INTENT.

Notes:
REFER TO SERVICE ENGINEER'S DRAWINGS FOR LOCATION OF S.D.F BOXES, GPO'S AND SKIRTING DUCTS. REFER TO SERVICES ENGINEER'S DRAWINGS FOR CO-ORDINATION OF SLAB & WALL 'BLOCKOUTS' AND 'CORED' PENETRATIONS.

REFER TO HYDRAULIC ENGINEER'S SERVICE PLAN FOR LOCATION OF SUB-FLOOR SERVICES.

REFER TO DOOR SCHEDULES FOR DOOR HARDWARE AND FURNITURE DETAILS
REFER TO MECHANICAL ENGINEER'S DRAWINGS AND SHOP DRAWINGS TO CONFIRM SIZES OF ALL DUCT PENETRATIONS AND LOUVRE OPENING SIZES.

REFER TO MECHANICAL ENGINEER'S DETAILS FOR PENETRATIONS AND BUILDING IN OF DUCTS, GRILLES, PLANT AND CEILING PLENUMS.

BUILD IN HIGH LEVEL OPENINGS FOR PLENUMS IN CEILING SPACES. REFER TO MECHANICAL ENGINEER'S DRAWING.

FOR ADDITIONAL SETOUT INFORMATION WHERE NO DIMENSIONING SHOWN, REFER TO REFERENCE TAGS FOR DETAILED ARCHITECTURAL DRAWINGS.

REFER TO ARCHITECTURAL SPECIFICATION, SCHEDULES AND ROOM DATA SHEETS FOR FF&E AND FINISHES CODES FOR FURTHER DETAIL AND OTHER MISCELLANEOUS ITEMS.

WALL LOADING LEGEND:

MINIMUM - 2kN
MINIMUM - 3kN

LEGEND:

LOOSE FIT LINE
SSD BOUNDARY
EXTENT OF FUTURE MEZZANINE TO BE DEMOLISHED

SP POP UP CARTS - SERVICE POINT

Notes:
ALLOW FOR SUB ROOF TO THE FOLLOWING ROOMS IN ORDER TO PROTECT EQUIPMENT AGAINST WET SERVICES ABOVE (WHERE APPLICABLE):
- DAS, MCR, COMMS, MDF, GENERATOR, UPS, MAIN SWITCH, HV INTAKE

SUB ROOF TO HAVE SPRINKLER PROTECTION OVER VOID SPACE.
TO BE COORDINATED WITH STRUCTURAL ENGINEER AND SERVICES CONSULTANTS.

REFER TO LANDSCAPE ARCHITECT'S DRAWINGS FOR LANDSCAPE LAYOUT, DETAILS AND DESIGN

LOOSE FURNITURE SHOWN INDICATIVELY ONLY, NOT TO BE INCLUDED IN TENDER COSTING UNLESS INSTRUCTED OTHERWISE

Notes:
PODIUM LEVELS REQUIRE FURTHER COORDINATION. REFER TO LANDSCAPE ARCHITECT DRAWINGS FOR LATEST INFORMATION


**Cox Architecture**
Level 6, 155 Clarence Street,
Sydney, NSW 2000, Australia
T + 61 2 9267 9599
F + 61 2 9264 5844
www.coxarchitecture.com.au

**ASPECT Studios**
78/80 George St. Redfern,
NSW, 2016, Australia
T + 61 2 9699 7182

www.aspect-studios.com/au

**Nominated Architects**
Jon Agius no. 6481
Russell Lee no. 6367


**Consultants**

Roof Structure & Super Structure
NAME: ARUP
ADDRESS: Level 5, Barrack Place, 151 Clarence St, Sydney, NSW, 2000
TEL/FAX: 9320 9320

NAME:
ADDRESS:
TEL/FAX:

NAME:
ADDRESS:
TEL/FAX:

**Client**

INSW

**Project No.**

218018.00

**Project**

SYDNEY FOOTBALL STADIUM
Driver Ave, Moore Park NSW 2021

**Drawing Title**


FLOOR PLAN LEVEL 5

**Document Control Status:**

DESIGN DEVELOPMENT

| | |
|---|---|
| A0 DRAWING SHEET | **Drawn:** Author |
| **Co-ordinated:** Checker | **Scale:** As indicated @ A0 |
| **Project Architect:** Designer | **Date:** 20.09.19 |
| **Project Director:** Approver | **Revision:** C |
| **Drawing Number:** A13.L5.06 | **North:** |

© Cox Architecture Pty Ltd ACN 002 535 881

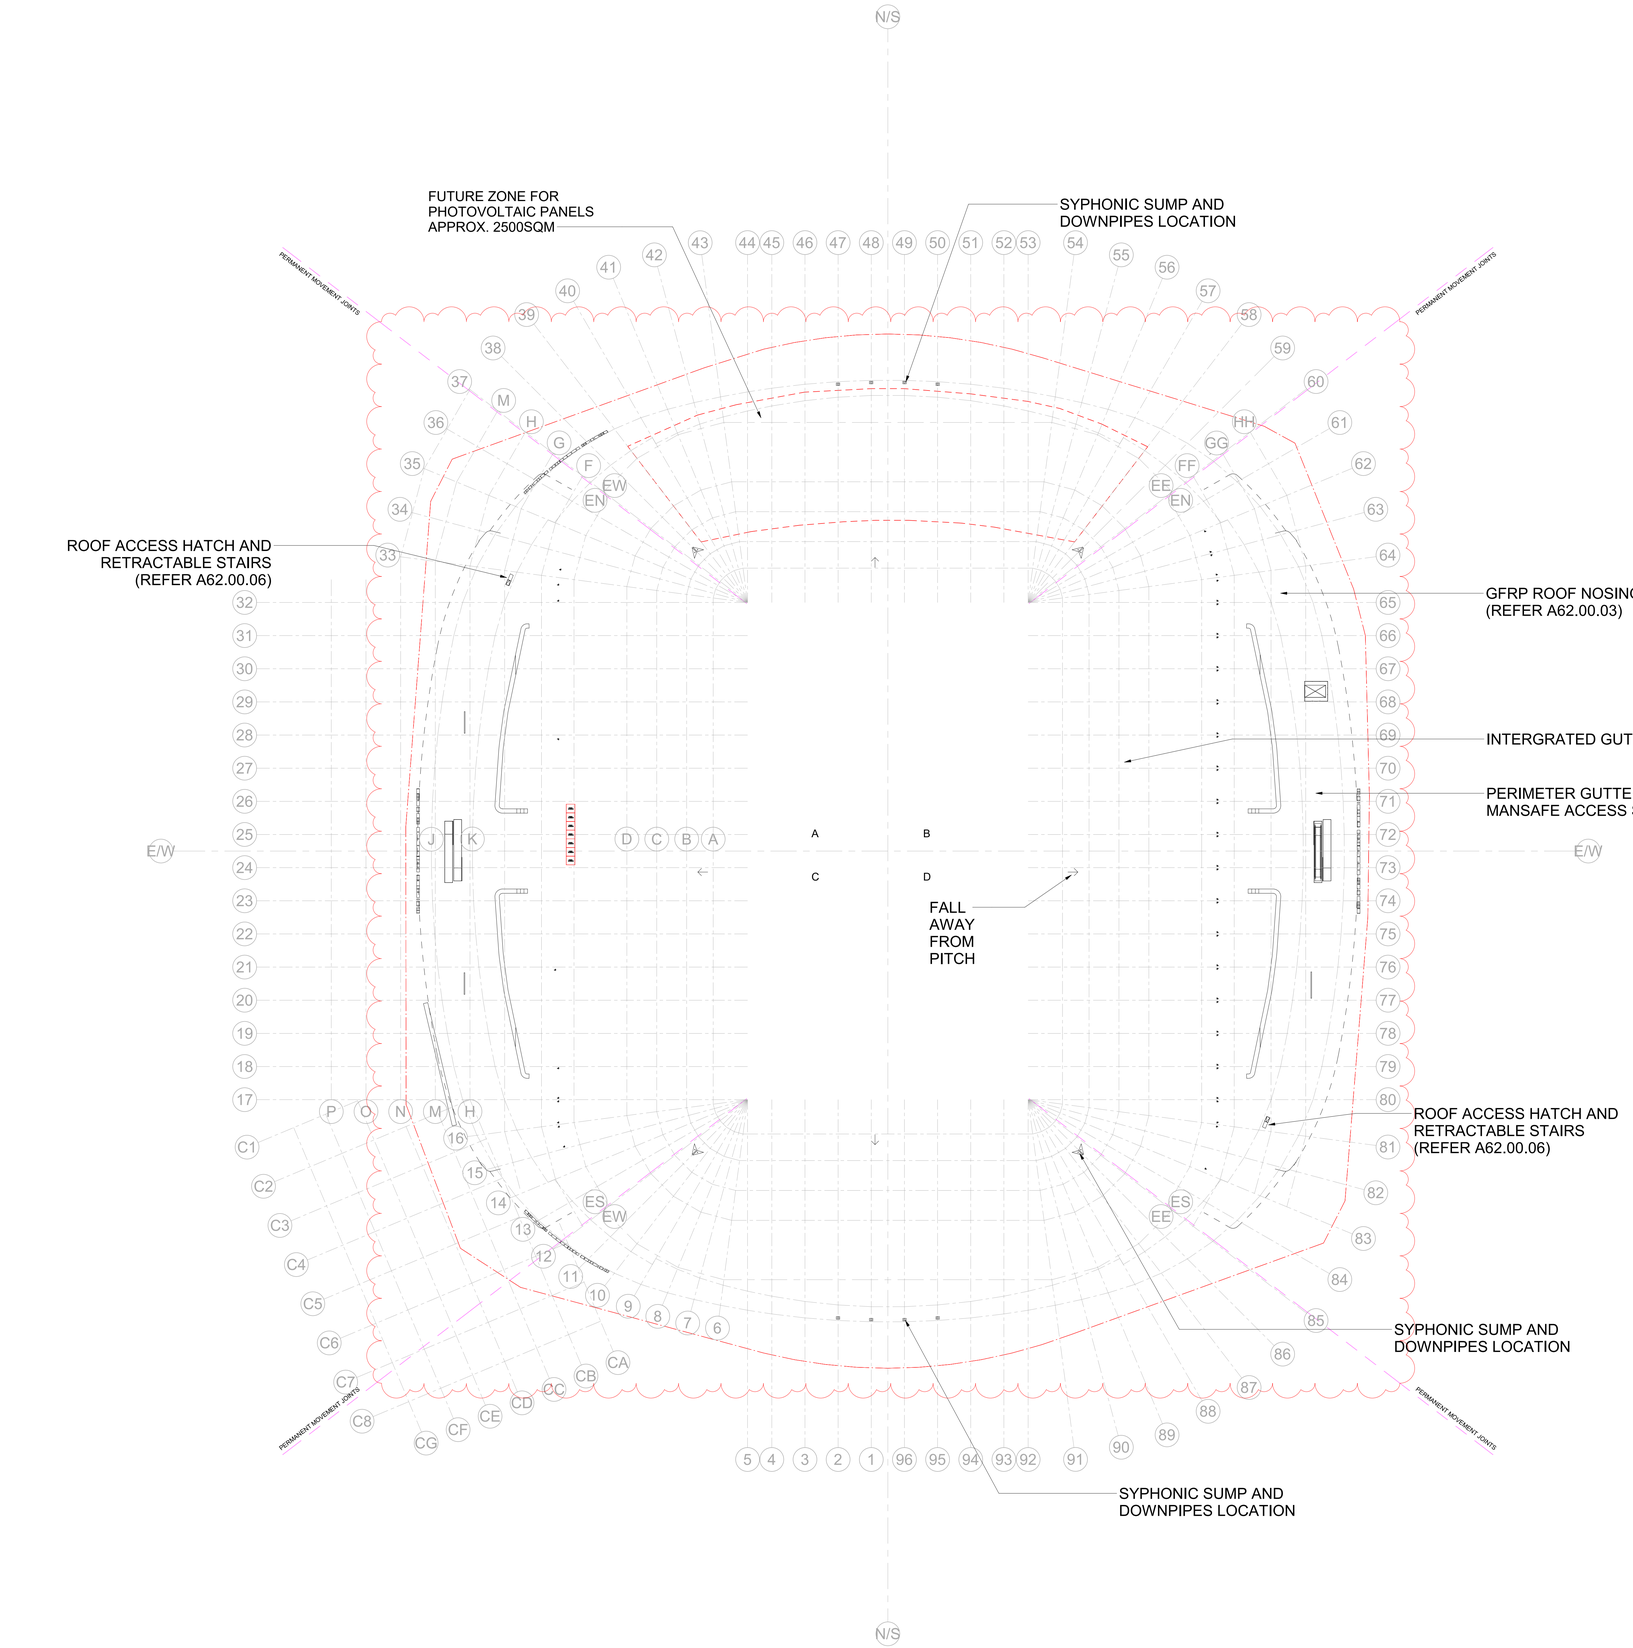


## ROOF MATERIALS AREA LEGEND:

- ETFE CLADDING (MBR3) AREA: 3,838 M²
- PTFE CLADDING (MBR2) AREA: 20,840 M²

LOCATION PLAN

© COPYRIGHT COX ARCHITECTURE PTY LTD
ANY FORM OF REPRODUCTION OF THIS DRAWING IN FULL OR IN PART WITHOUT THE WRITTEN PERMISSION OF COX ARCHITECTURE PTY LTD CONSTITUTES AN INFRINGEMENT OF COPYRIGHT

NSW GOVERNMENT Planning, Industry & Environment

*Issued under the Environmental Planning and Assessment Act 1979*

Approved Application No: SSD-9835 Signed:

Granted on the: 6 Dec 2019 Sheet No: 8 of 83

| Rev | Description | By | Date |
|---|---|---|---|
| A | SSDA Stage 2 Issue | | 11.06.19 |
| B | SSDA Stage 2 Issue | | 13.08.19 |
| C | SSDA Stage 2 Issue | | 20.09.19 |

General Notes:
CONTRACTOR AND SUB-CONTRACTORS SHALL VERIFY ALL DIMENSIONS OF THIS DRAWING AND SITE CONDITIONS PRIOR TO ANY WORK COMMENCING.

ALL SHOP DRAWINGS SHALL BE SUBMITTED TO THE ARCHITECT. THE MANUFACTURER SHALL NOT COMMENCE ANY WORKS PRIOR TO THE RETURN OF APPROVED SHOP DRAWINGS SIGNED BY THE RELEVANT CONSULTANT.

FIGURED DIMENSIONS TAKE PRECEDENCE OVER SCALES DIMENSIONS.

THIS DRAWING SHOULD BE READ IN CONJUNCTION WITH ALL RELEVANT CONTRACTS, SPECIFICATIONS, DRAWINGS AND CONSULTANT DOCUMENTS.

COPYRIGHT OF THIS DRAWING IS VESTED IN THE PRINCIPAL

NOTE: ALL REVISIONS TO DRAWINGS WILL BE CLOUDED AND TAGGED

Structure Notes:

STRUCTURAL ELEMENTS SHOWN IN ARCHITECTURAL DRAWINGS ARE INDICATIVE ONLY AND INCLUDED FOR SPATIAL CO-ORDINATION PURPOSES ONLY.

FOR FULL STRUCTURAL DESIGN INCLUDING SUPERSTRUCTURE, BOWL STRUCTURE, SUPERSTRUCTURE SIZES & DETAILS, SLAB SIZES & DETAILS, SUB-SOIL & SHORING DETAILS, COLUMN & STRUCTURAL WALL SIZES & DETAILS REFER STRUCTURAL ENGINEER'S REPORT

FINAL ENGINEERING CONNECTIONS AND MEMBER TYPES TO MATCH ARCHITECTURAL INTENT.

Notes:
REFER TO SERVICE ENGINEER'S DRAWINGS FOR LOCATION OF S.D.F BOXES, GPO'S AND SKIRTING DUCTS. REFER TO SERVICES ENGINEER'S DRAWINGS FOR CO-ORDINATION OF SLAB & WALL 'BLOCKOUTS' AND 'CORED' PENETRATIONS.

REFER TO HYDRAULIC ENGINEER'S SERVICE PLAN FOR LOCATION OF SUB-FLOOR SERVICES.

REFER TO DOOR SCHEDULES FOR DOOR HARDWARE AND FURNITURE DETAILS
REFER TO MECHANICAL ENGINEER'S DRAWINGS AND SHOP DRAWINGS TO CONFIRM SIZES OF ALL DUCT PENETRATIONS AND LOUVRE OPENING SIZES.

REFER TO MECHANICAL ENGINEER'S DETAILS FOR PENETRATIONS AND BUILDING IN OF DUCTS, GRILLES, PLANT AND CEILING PLENUMS.

BUILD IN HIGH LEVEL OPENINGS FOR PLENUMS IN CEILING SPACES. REFER TO MECHANICAL ENGINEER'S DRAWING.

FOR ADDITIONAL SETOUT INFORMATION WHERE NO DIMENSIONING SHOWN, REFER TO REFERENCE TAGS FOR DETAILED ARCHITECTURAL DRAWINGS

REFER TO ARCHITECTURAL SPECIFICATION, SCHEDULES AND ROOM DATA SHEETS FOR FF&E AND FINISHES CODES FOR FURTHER DETAIL AND OTHER MISCELLANEOUS ITEMS.

INSW Infrastructure New South Wales

**Cox Architecture**
Level 6, 155 Clarence Street,
Sydney, NSW 2000, Australia
T + 61 2 9267 9599
F + 61 2 9264 5844
www.coxarchitecture.com.au

**ASPECT Studios**
78/80 George St, Redfern,
NSW, 2016, Australia
T + 61 2 9699 7182

www.aspect-studios.com/au

**Nominated Architects**
Joe Agius no. 8491
Russell Lee no. 6367

COX ASPECT Studios®

**Consultants**

Roof Structure & Super Structure
NAME: ARUP
ADDRESS: Level 8 , Barrack Place, 151 Clarence St, Sydney, NSW, 2000
TEL/FAX: 9320 9320

NAME:
ADDRESS:
TEL/FAX:

NAME:
ADDRESS:
TEL/FAX:

**Client**
INSW

**Project No.**
218018.00

**Project**
SYDNEY FOOTBALL STADIUM
Driver Ave, Moore Park NSW 2021


**Drawing Title**
ROOF PLAN

**Document Control Status:**
DESIGN DEVELOPMENT


| | |
|---|---|
| A0 DRAWING SHEET | **Drawn:** Author |
| **Co-ordinated:** Checker | **Scale:** 1 : 500 @ A0 |
| **Project Architect:** Designer | **Date:** 20.09.19 |
| **Project Director:** Approver | **Revision:** C |
| **Drawing Number:** A13.RL.08 | **North:** |

Cox Architecture Pty Ltd ACN 002 535 891

PLOT STAMP DATE: 20/09/2019 2:24:39 PM

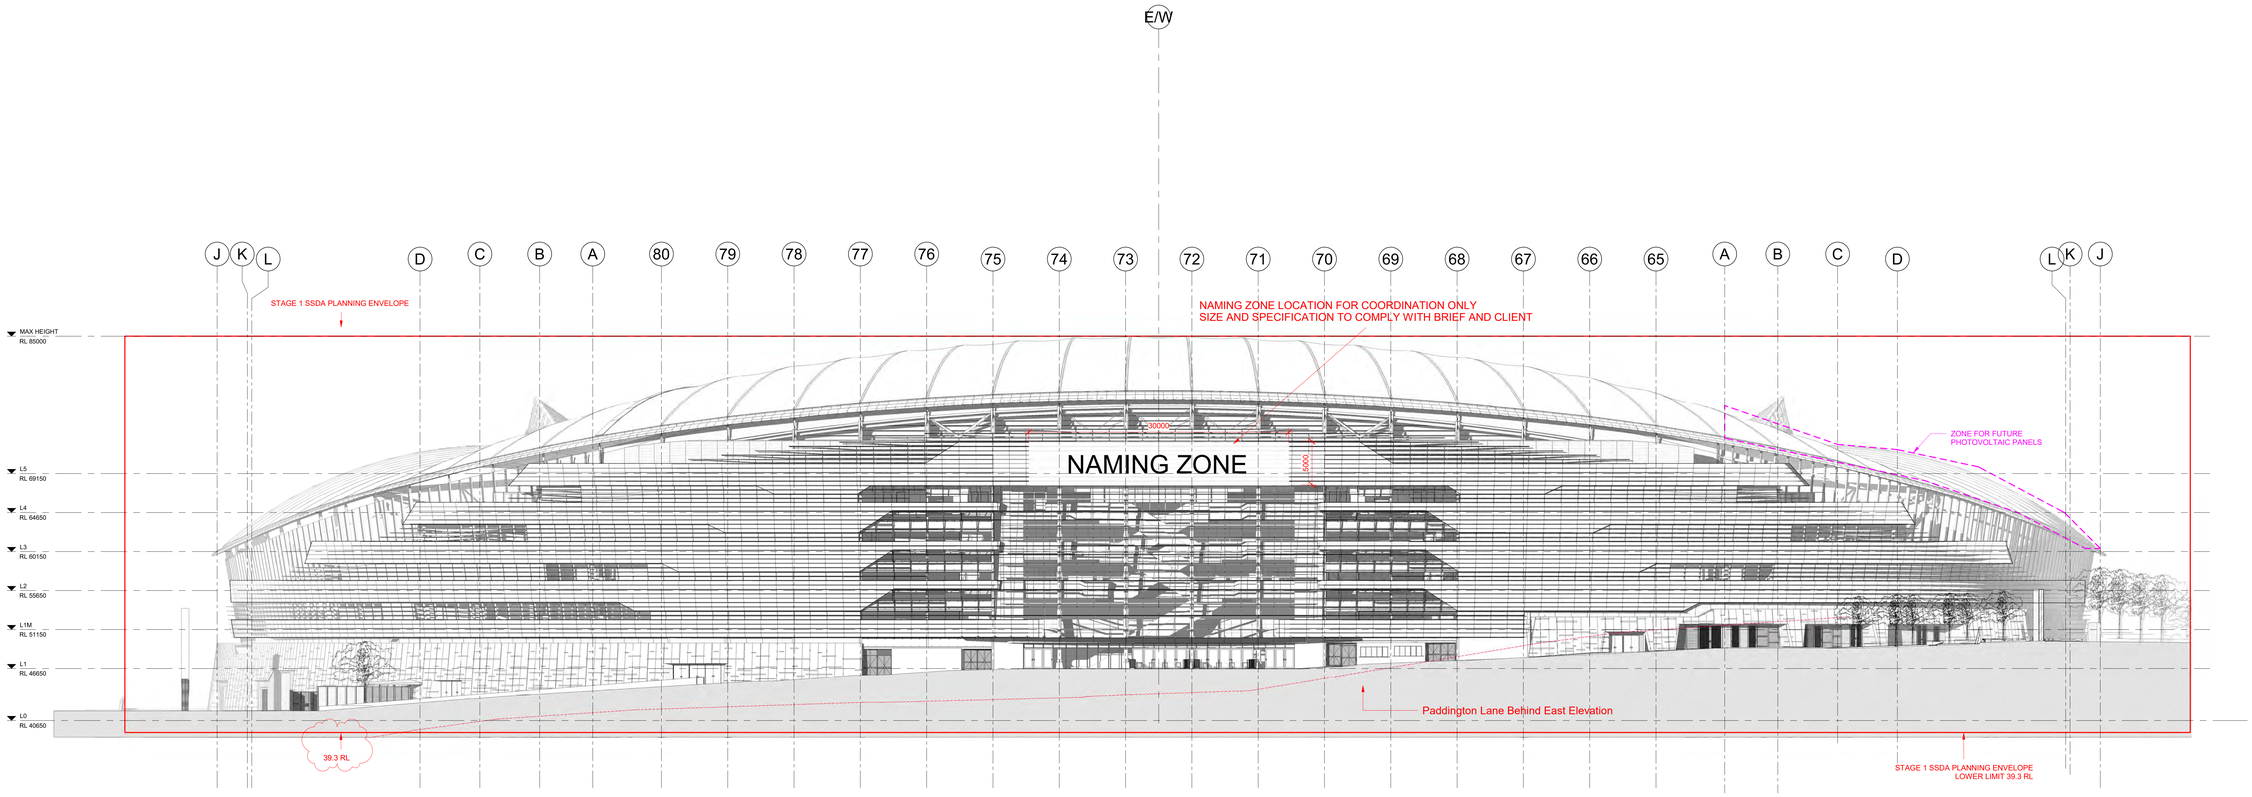


1 EAST ELEVATION
A11.09 SCALE 1 : 250

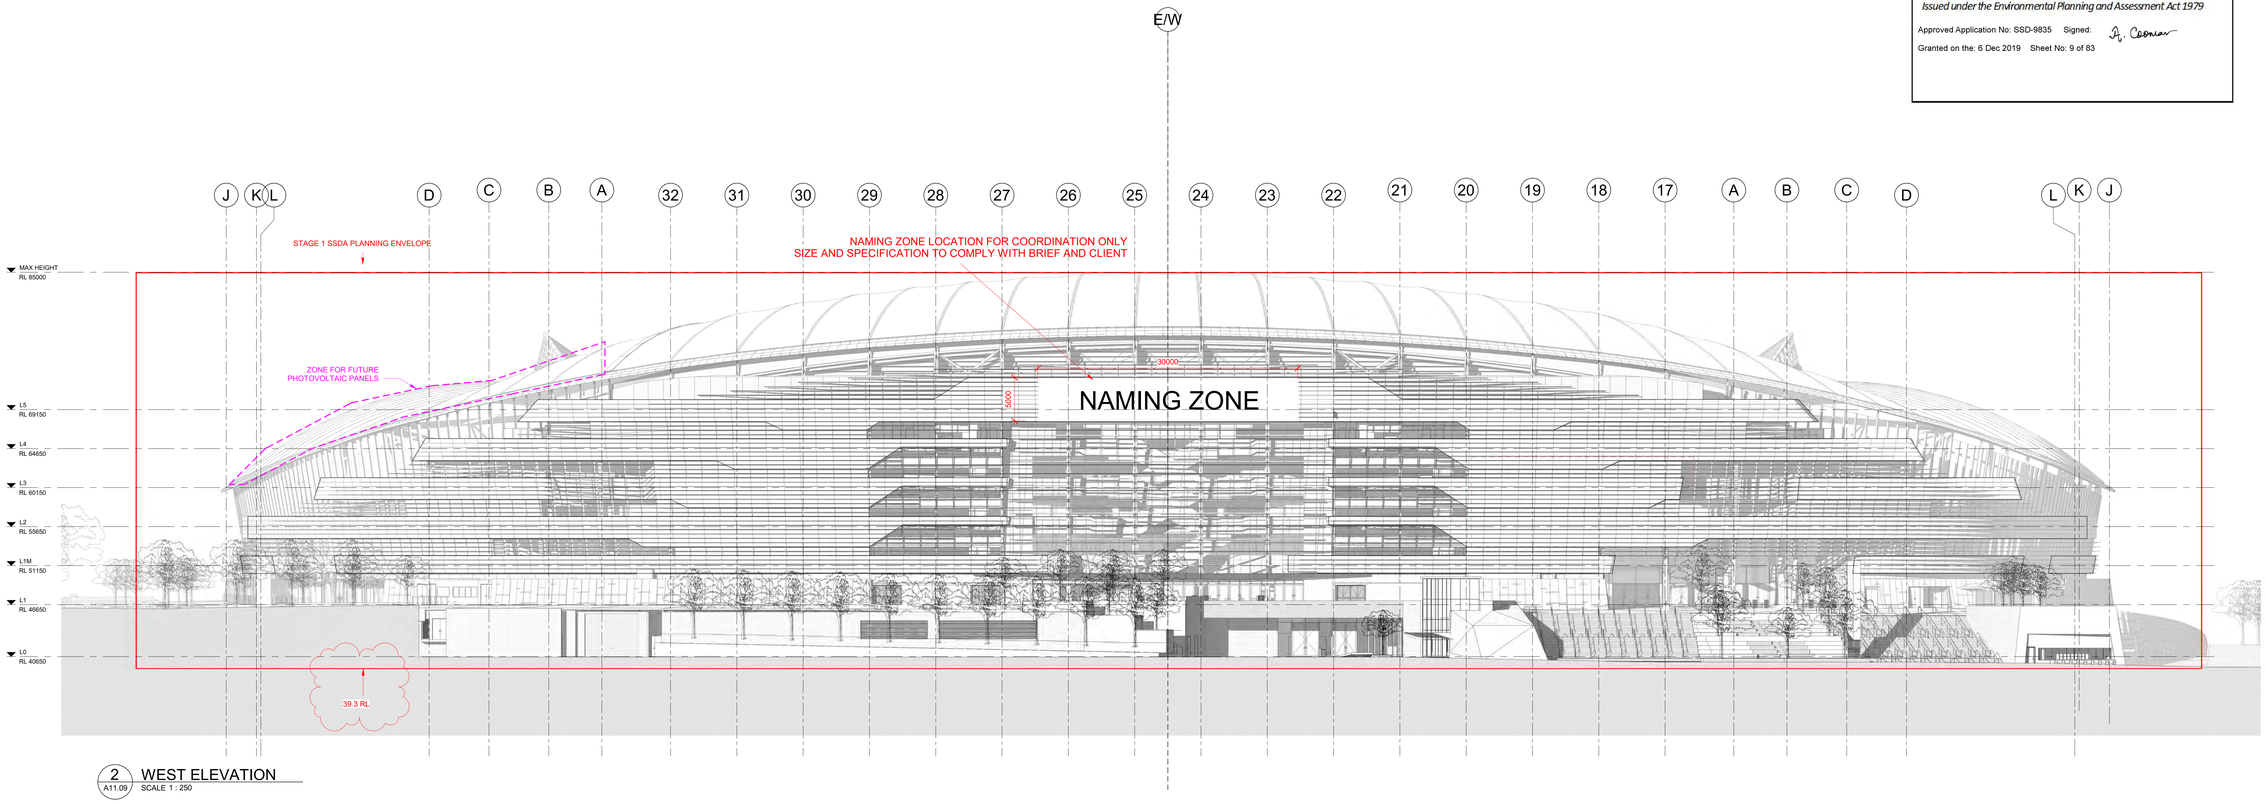


2 WEST ELEVATION
A11.09 SCALE 1 : 250

© COPYRIGHT COX ARCHITECTURE PTY LTD
ANY FORM OF REPRODUCTION OF THIS DRAWING IN FULL OR IN PART WITHOUT THE WRITTEN PERMISSION OF COX ARCHITECTURE PTY LTD CONSTITUTES AN INFRINGEMENT OF COPYRIGHT

LOCATION PLAN

| Rev | Description | By | Date |
|---|---|---|---|
| A | SSDA Stage 2 Issue | | 11.06.19 |
| B | SSDA Stage 2 Issue | | 13.08.19 |
| C | SSDA Stage 2 Issue | | 20.09.19 |

General Notes:
CONTRACTOR AND SUB-CONTRACTORS SHALL VERIFY ALL DIMENSIONS OF THIS DRAWING AND SITE CONDITIONS PRIOR TO ANY WORK COMMENCING.

ALL SHOP DRAWINGS SHALL BE SUBMITTED TO THE ARCHITECT. THE MANUFACTURER SHALL NOT COMMENCE ANY WORKS PRIOR TO THE RETURN OF APPROVED SHOP DRAWINGS SIGNED BY THE RELEVANT CONSULTANT.

FIGURED DIMENSIONS TAKE PRECEDENCE OVER SCALES DIMENSIONS.

THIS DRAWING SHOULD BE READ IN CONJUNCTION WITH ALL RELEVANT CONTRACTS, SPECIFICATIONS, DRAWINGS AND CONSULTANT DOCUMENTS.

COPYRIGHT OF THIS DRAWING IS VESTED IN THE PRINCIPAL.

NOTE: ALL REVISIONS TO DRAWINGS WILL BE CLOUDED AND TAGGED

Structure Notes:

STRUCTURAL ELEMENTS SHOWN IN ARCHITECTURAL DRAWINGS ARE INDICATIVE ONLY AND INCLUDED FOR SPATIAL CO-ORDINATION PURPOSES ONLY.

FOR FULL STRUCTURAL DESIGN INCLUDING SUPERSTRUCTURE, BOWL STRUCTURE, SUBSTRUCTURE SIZES & DETAILS, SLAB SIZES & DETAILS, SUB-SOIL & SHORING SYSTEMS, FOOTING SIZES & DETAILS, STRUCTURAL WALL SIZES & DETAILS REFER STRUCTURAL ENGINEER'S REPORT.

FINAL ENGINEERING CONNECTIONS AND MEMBER TYPES TO MATCH ARCHITECTURAL INTENT.

Notes:
REFER TO SERVICE ENGINEER'S DRAWINGS FOR LOCATION OF S.D.F BOXES, GPO'S AND SKIRTING DUCTS. REFER TO SERVICES ENGINEER'S DRAWINGS FOR CO-ORDINATION OF SLAB & WALL 'BLOCKOUTS' AND 'CORED' PENETRATIONS.

REFER TO HYDRAULIC ENGINEER'S SERVICE PLAN FOR LOCATION OF SUB-FLOOR SERVICES.

REFER TO DOOR SCHEDULES FOR DOOR HARDWARE AND FURNITURE DETAILS
REFER TO MECHANICAL ENGINEER'S DRAWINGS AND SHOP DRAWINGS TO CONFIRM SIZES OF ALL DUCT PENETRATIONS AND LOUVRE OPENING SIZES.

REFER TO MECHANICAL ENGINEER'S DETAILS FOR PENETRATIONS AND BUILDING IN OF DUCTS, GRILLES, PLANT AND CEILING PLENUMS.

BUILD IN HIGH LEVEL OPENINGS FOR PLENUMS IN CEILING SPACES. REFER TO MECHANICAL ENGINEERS DRAWING.

FOR ADDITIONAL SETOUT INFORMATION WHERE NO DIMENSIONING SHOWN, REFER TO REFERENCE TAGS FOR DETAILED ARCHITECTURAL DRAWINGS

REFER TO ARCHITECTURAL SPECIFICATION, SCHEDULES AND ROOM DATA SHEETS FOR FF&E AND FINISHES CODES FOR FURTHER DETAIL AND OTHER MISCELLANEOUS ITEMS.

NSW GOVERNMENT | Planning, Industry & Environment

*Issued under the Environmental Planning and Assessment Act 1979*

Approved Application No: SSD-9835 Signed:

Granted on the: 6 Dec 2019 Sheet No: 9 of 83

**Cox Architecture**
Level 6, 155 Clarence Street,
Sydney, NSW 2000, Australia
T + 61 2 9267 9599
F + 61 2 9264 5844
www.coxarchitecture.com.au

**ASPECT Studios**
78/80 George St, Redfern,
NSW, 2016, Australia
T + 61 2 9699 7182

www.aspect-studios.com/au

**Nominated Architects**
Joe Agius no. 6491
Russell Lee no. 6367

**Consultants**

Roof Structure & Super Structure
NAME: ARUP
ADDRESS: Level 5 - Barrack Place, 151 Clarence St, Sydney, NSW, 2000
TEL/FAX: 9320 9320

NAME:
ADDRESS:
TEL/FAX:

NAME:
ADDRESS:
TEL/FAX:

**Client**
INSW

**Project No.**
218018.00

**Project**
SYDNEY FOOTBALL STADIUM
Driver Ave, Moore Park NSW 2021

**Drawing Title**
EAST AND WEST ELEVATIONS

**Document Control Status:**
DESIGN DEVELOPMENT

| | |
|---|---|
| A0 DRAWING SHEET | **Drawn:** Author |
| **Co-ordinated:** Checker | **Scale:** 1 : 250 @ A0 |
| **Project Architect:** Designer | **Date:** 20.09.19 |
| **Project Director:** Approver | **Revision:** C |
| **Drawing Number:** A30.EW.01 | **North:** |

Cox Architecture Pty Ltd ACN 002 535 891

PLOT STAMP DATE: 23/09/2019 11:04:26 AM


© COPYRIGHT COX ARCHITECTURE PTY LTD
ANY FORM OF REPRODUCTION OF THIS DRAWING IN FULL OR IN PART WITHOUT THE WRITTEN PERMISSION OF COX ARCHITECTURE PTY LTD CONSTITUTES AN INFRINGEMENT OF COPYRIGHT

NSW GOVERNMENT
Planning, Industry & Environment


*Issued under the Environmental Planning and Assessment Act 1979*

Approved Application No: SSD-9835 Signed:

Granted on the: 6 Dec 2019 Sheet No: 10 of 83

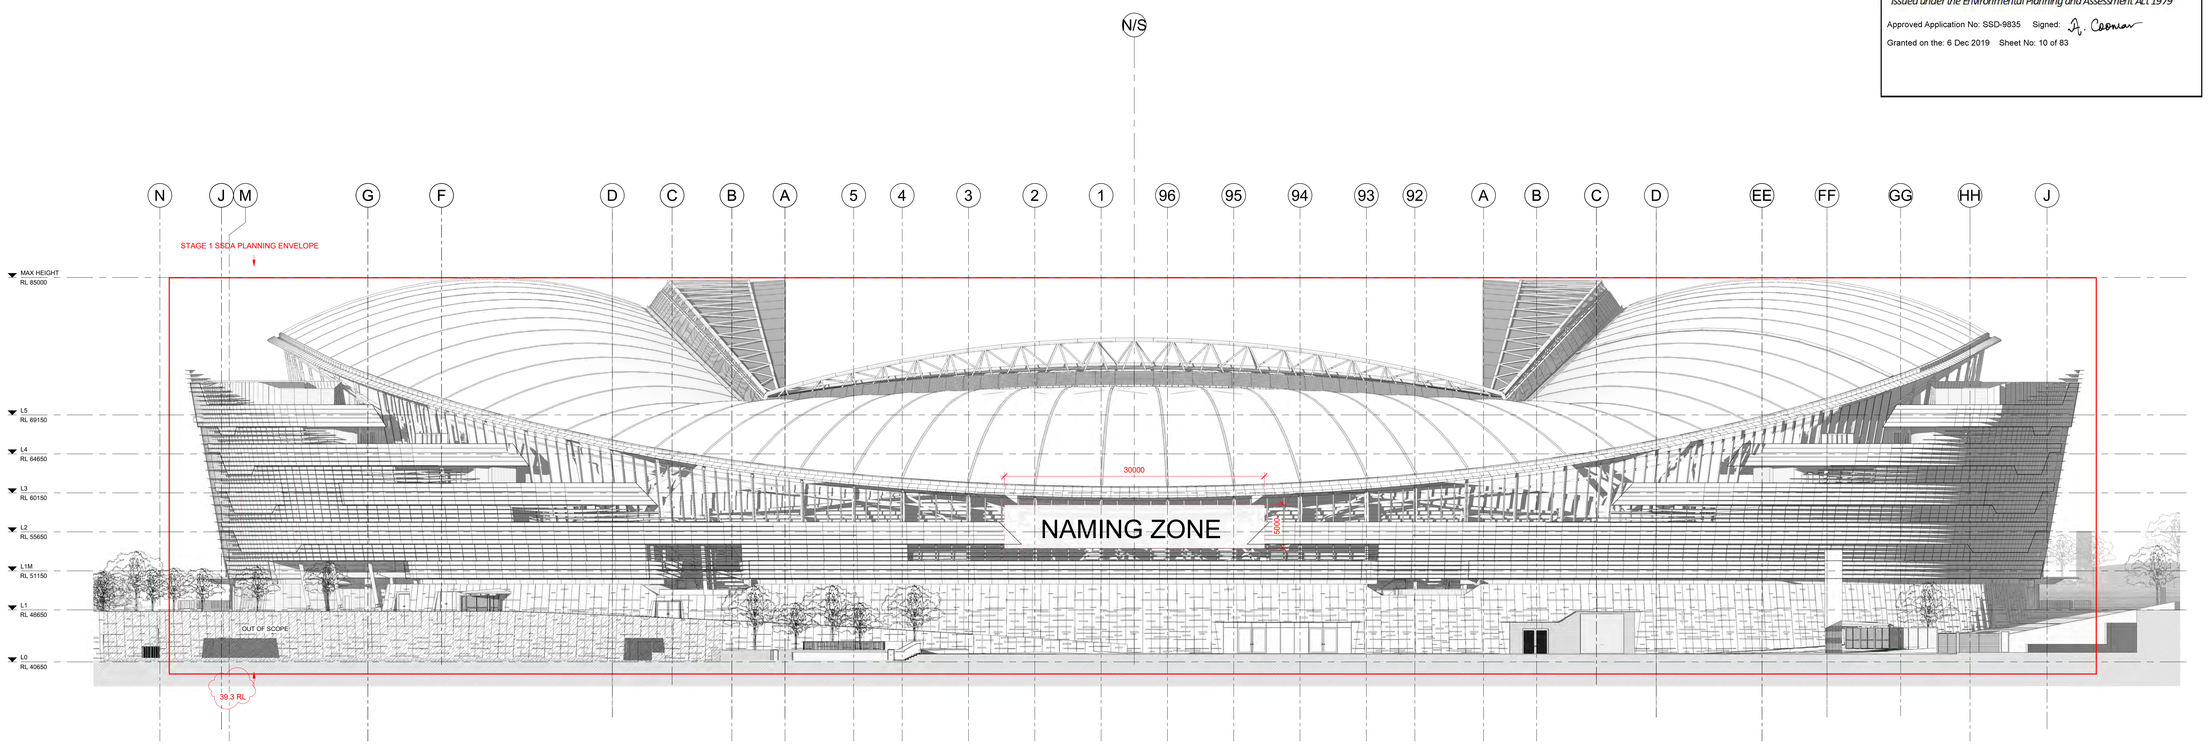


1 A11.09 SOUTH ELEVATION
SCALE 1 : 250

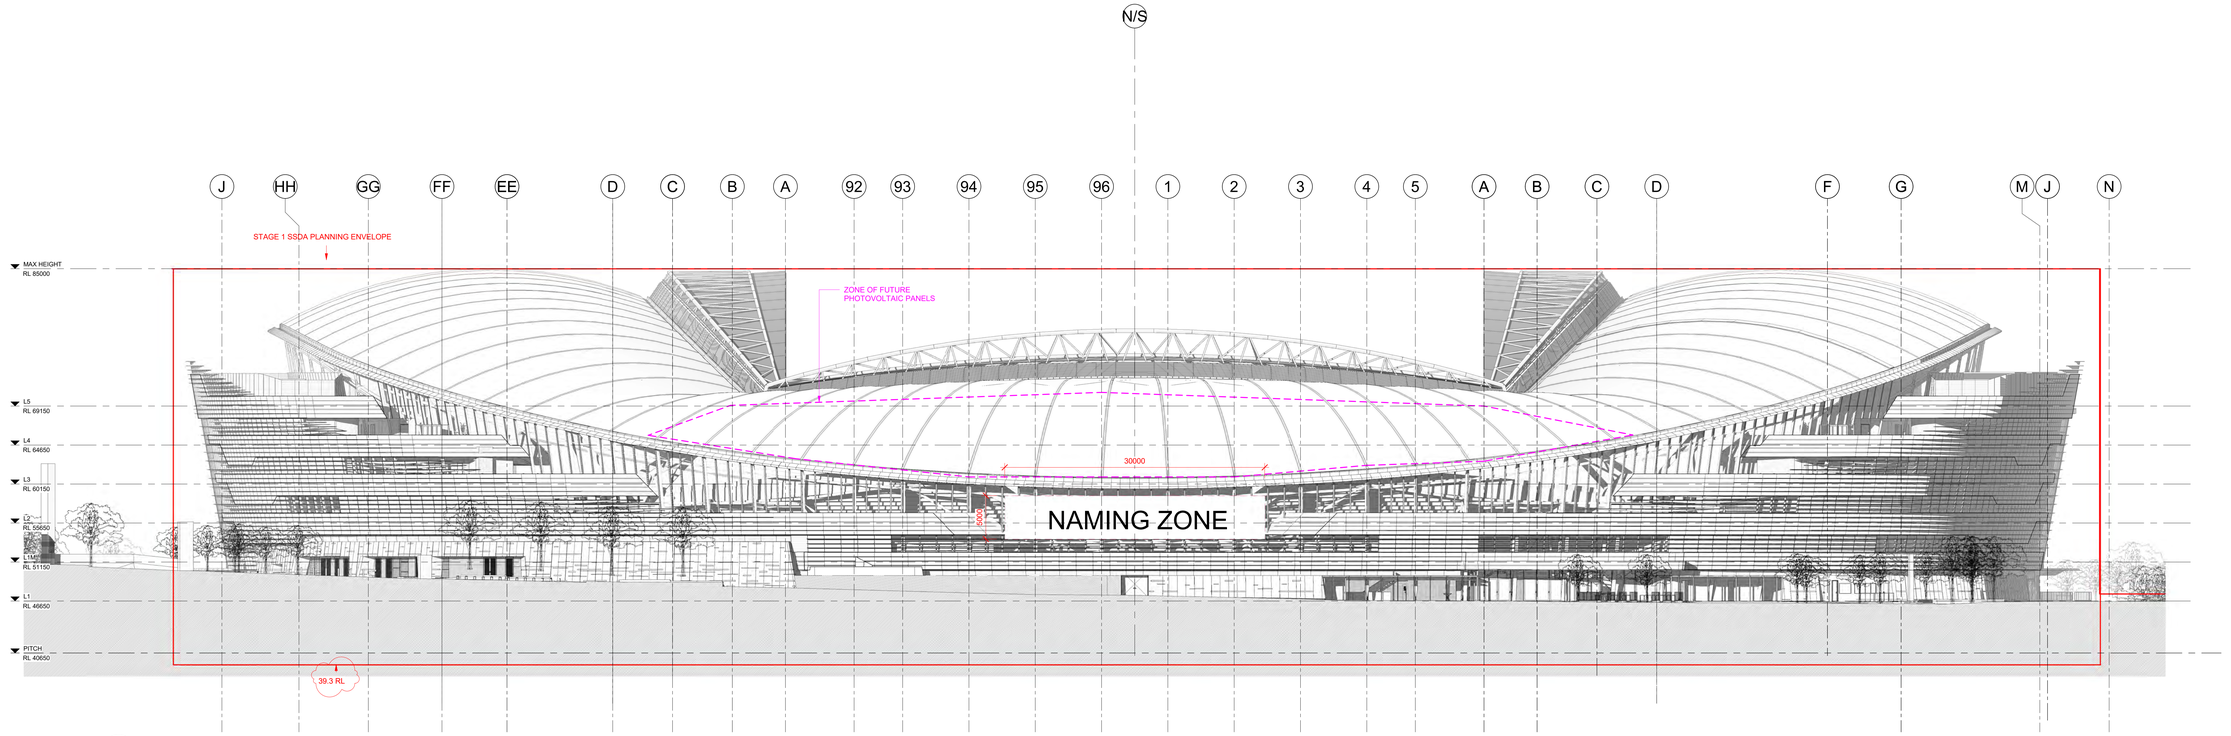


2 A11.09 NORTH ELEVATION
SCALE 1 : 250

| Rev | Description | By | Date |
|---|---|---|---|
| A | SSDA Stage 2 Issue | | 11.06.19 |
| B | SSDA Stage 2 Issue | | 13.08.19 |
| C | SSDA Stage 2 Issue | | 20.09.19 |

General Notes:
CONTRACTOR AND SUB-CONTRACTORS SHALL VERIFY ALL DIMENSIONS OF THIS DRAWING AND SITE CONDITIONS PRIOR TO ANY WORK COMMENCING.

ALL SHOP DRAWINGS SHALL BE SUBMITTED TO THE ARCHITECT. THE MANUFACTURER SHALL NOT COMMENCE ANY WORKS PRIOR TO THE RETURN OF APPROVED SHOP DRAWINGS SIGNED BY THE RELEVANT CONSULTANT.

FIGURED DIMENSIONS TAKE PRECEDENCE OVER SCALED DIMENSIONS.

THIS DRAWING SHOULD BE READ IN CONJUNCTION WITH ALL RELEVANT CONTRACTS, SPECIFICATIONS, DRAWINGS AND CONSULTANT DOCUMENTS.

COPYRIGHT OF THIS DRAWING IS VESTED IN THE PRINCIPAL.

NOTE: ALL REVISIONS TO DRAWINGS WILL BE CLOUDED AND TAGGED

Structure Notes:

STRUCTURAL ELEMENTS SHOWN IN ARCHITECTURAL DRAWINGS ARE INDICATIVE ONLY AND INCLUDED FOR SPATIAL CO-ORDINATION PURPOSES ONLY.

FOR FULL STRUCTURAL DESIGN INCLUDING SUPERSTRUCTURE, BOWL STRUCTURE, SUBSTRUCTURE, FOUNDATIONS, SLAB SIZES & DETAILS, SUB-SOIL & SHORING CONSTRUCTION, STRUCTURAL WALL SIZES & DETAILS REFER STRUCTURAL ENGINEER'S REPORT.

FINAL ENGINEERING CONNECTIONS AND MEMBER TYPES TO MATCH ARCHITECTURAL INTENT.

Notes:
REFER TO SERVICE ENGINEER'S DRAWINGS FOR LOCATION OF S.D.F BOXES, GPO'S AND SKIRTING DUCTS. REFER TO SERVICES ENGINEER'S DRAWINGS FOR CO-ORDINATION OF SLAB & WALL 'BLOCKOUTS' AND 'CORED' PENETRATIONS.

REFER TO HYDRAULIC ENGINEER'S SERVICE PLAN FOR LOCATION OF SUB-FLOOR SERVICES.

REFER TO DOOR SCHEDULES FOR DOOR HARDWARE AND FURNITURE DETAILS
REFER TO MECHANICAL ENGINEER'S DRAWINGS AND SHOP DRAWINGS TO CONFIRM SIZES OF ALL DUCT PENETRATIONS AND LOUVRE OPENING SIZES.

REFER TO MECHANICAL ENGINEER'S DETAILS FOR PENETRATIONS AND BUILDING IN OF DUCTS, GRILLES, PLANT AND CEILING PLENUMS.

BUILD IN HIGH LEVEL OPENINGS FOR PLENUMS IN CEILING SPACES. REFER TO MECHANICAL ENGINEER'S DRAWING.

FOR ADDITIONAL SETOUT INFORMATION WHERE NO DIMENSIONING SHOWN, REFER TO REFERENCE TAGS FOR DETAILED ARCHITECTURAL DRAWINGS.

REFER TO ARCHITECTURAL SPECIFICATION, SCHEDULES AND ROOM DATA SHEETS FOR FF&E AND FINISHES CODES FOR FURTHER DETAIL AND OTHER MISCELLANEOUS ITEMS.

INSW Infrastructure New South Wales

**Cox Architecture**
Level 6, 155 Clarence Street,
Sydney, NSW 2000, Australia
T + 61 2 9267 9599
F + 61 2 9264 5844
www.coxarchitecture.com.au

**ASPECT Studios**
78/80 George St, Redfern,
NSW, 2016, Australia
T + 61 2 9699 7182

www.aspectstudios.com/au

**Nominated Architects**
Joe Agius no. 6491
Russell Lee no. 6367

COX ASPECT Studios®

**Consultants**

Roof Structure & Super Structure
NAME: ARUP
ADDRESS: Level 5 , Barrack Place, 151 Clarence St, Sydney, NSW, 2000
TEL/FAX: 9320 9320

NAME:
ADDRESS:
TEL/FAX:

NAME:
ADDRESS:
TEL/FAX:

**Client**
INSW

**Project No.**
218018.00

**Project**
SYDNEY FOOTBALL STADIUM
Driver Ave, Moore Park NSW 2021

**Drawing Title**
NORTH AND SOUTH ELEVATIONS


**Document Control Status:**
DESIGN DEVELOPMENT

| | |
|---|---|
| A0 DRAWING SHEET | **Drawn:** Author |
| **Co-ordinated:** Checker | **Scale:** 1 : 250 @ A0 |
| **Project Architect:** Designer | **Date:** 20.09.19 |
| **Project Director:** Approver | **Revision:** C |
| **Drawing Number:** A30.NS.01 | **North:** |

Cox Architecture Pty Ltd ACN 002 535 891


PLOT STAMP DATE: 23/09/2019 11:33:40 AM

© COPYRIGHT COX ARCHITECTURE PTY LTD
ANY FORM OF REPRODUCTION OF THIS DRAWING IN FULL OR IN PART WITHOUT THE WRITTEN PERMISSION OF COX ARCHITECTURE PTY LTD CONSTITUTES AN INFRINGEMENT OF COPYRIGHT

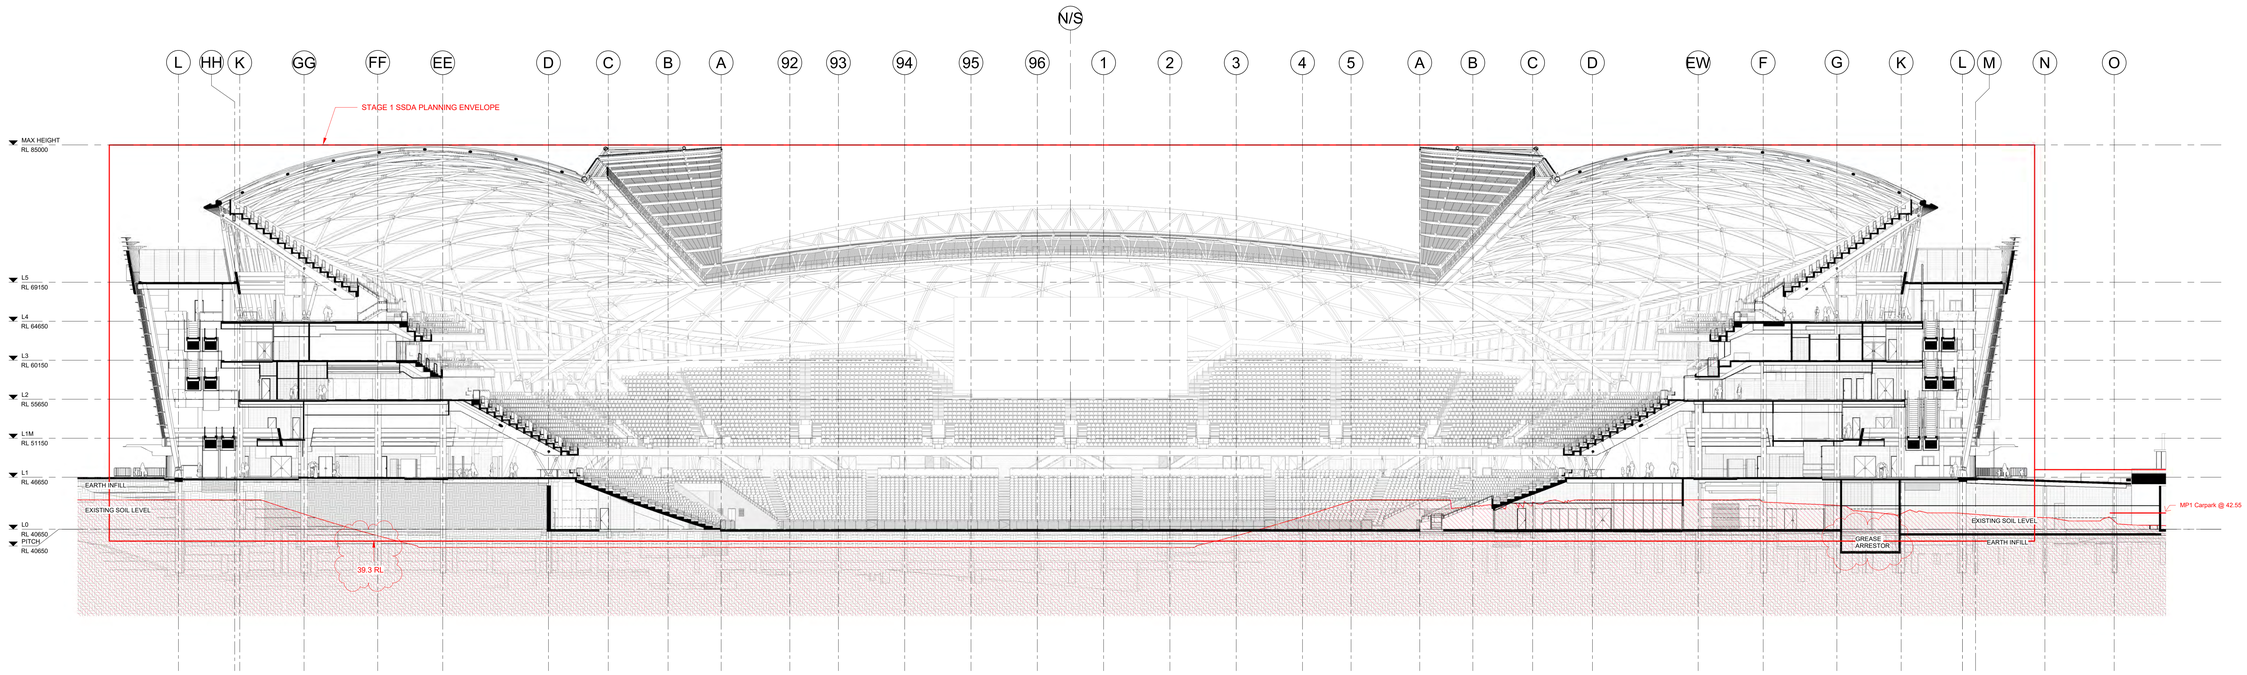



1 A11.09 A40.01 SECTION EAST WEST LOOKING SOUTH
SCALE 1 : 250

EXISTING SOIL FOOTPRINT

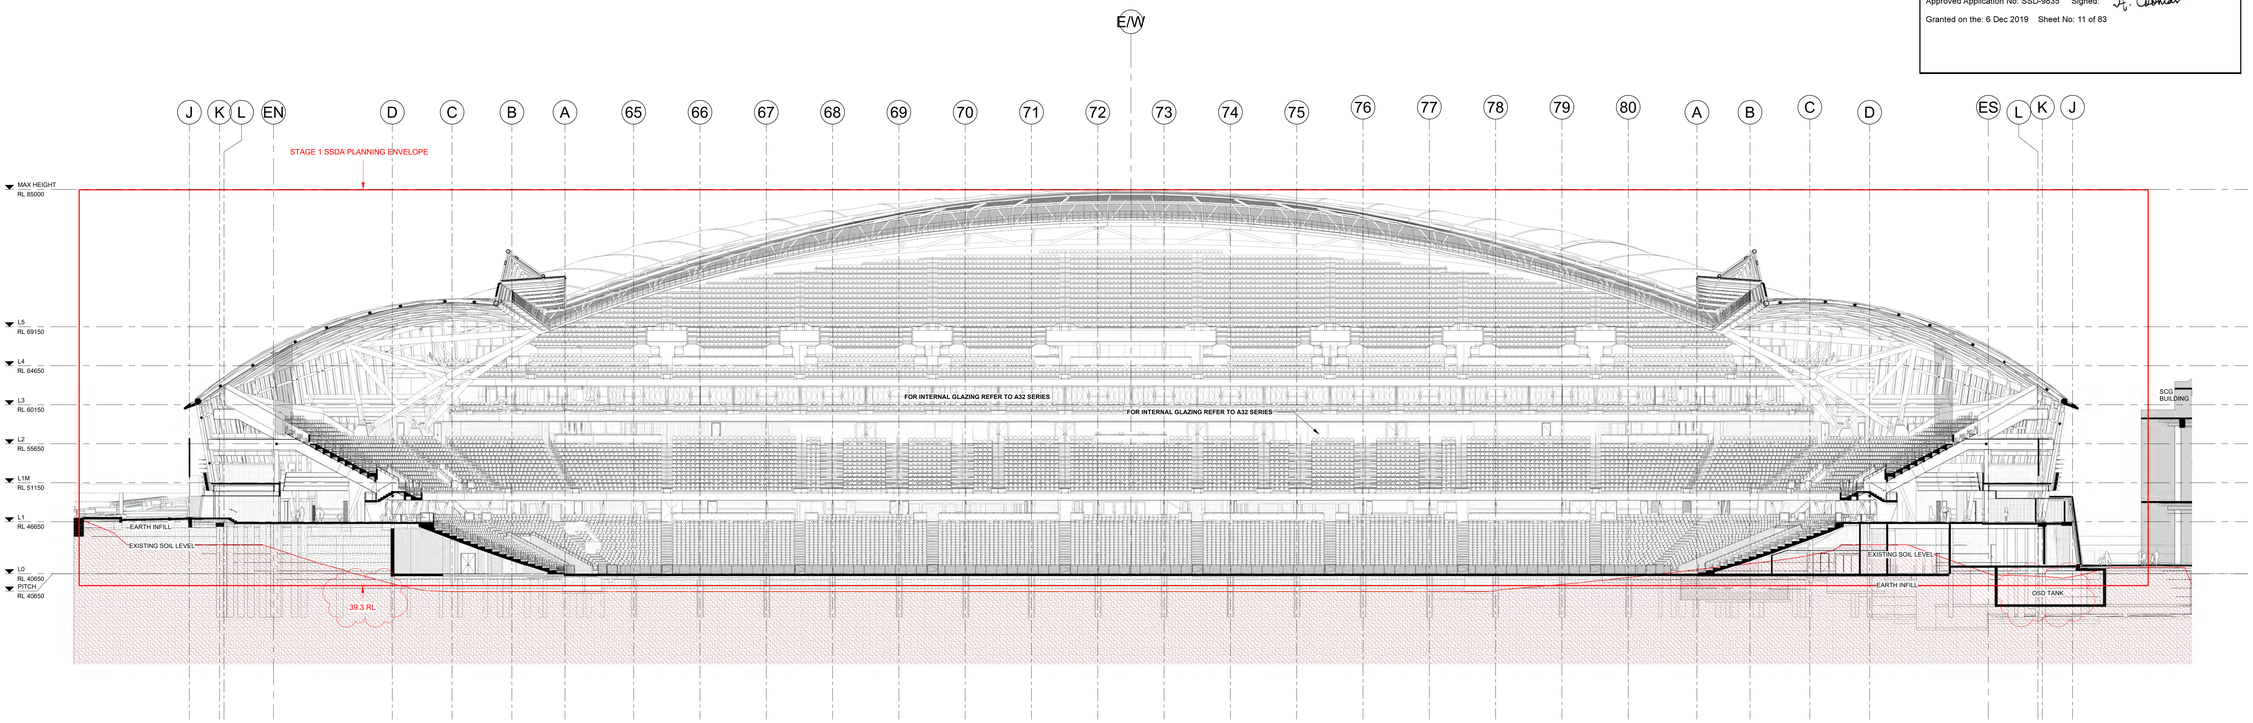


2 A11.09 A40.01 SECTION NORTH SOUTH LOOKING EAST
SCALE 1 : 250

EXISTING SOIL FOOTPRINT

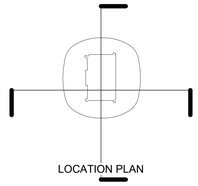


| Rev | Description | By | Date |
|---|---|---|---|
| A | SSDA Stage 2 Issue | | 11.06.19 |
| B | SSDA Stage 2 Issue | | 13.08.19 |
| C | SSDA Stage 2 Issue | | 20.09.19 |

General Notes:
CONTRACTOR AND SUB-CONTRACTORS SHALL VERIFY ALL DIMENSIONS OF THIS DRAWING AND SITE CONDITIONS PRIOR TO ANY WORK COMMENCING.

ALL SHOP DRAWINGS SHALL BE SUBMITTED TO THE ARCHITECT. THE MANUFACTURER SHALL NOT COMMENCE ANY WORKS PRIOR TO THE RETURN OF APPROVED SHOP DRAWINGS SIGNED BY THE RELEVANT CONSULTANT.

FIGURED DIMENSIONS TAKE PRECEDENCE OVER SCALED DIMENSIONS.

THIS DRAWING SHOULD BE READ IN CONJUNCTION WITH ALL RELEVANT CONTRACTS, SPECIFICATIONS, DRAWINGS AND CONSULTANT DOCUMENTS.

COPYRIGHT OF THIS DRAWING IS VESTED IN THE PRINCIPAL

NOTE: ALL REVISIONS TO DRAWINGS WILL BE CLOUDED AND TAGGED

Structure Notes:

STRUCTURAL ELEMENTS SHOWN IN ARCHITECTURAL DRAWINGS ARE INDICATIVE ONLY AND INCLUDED FOR SPATIAL CO-ORDINATION PURPOSES ONLY.

FOR FULL STRUCTURAL DESIGN INCLUDING SUPERSTRUCTURE, BOWL STRUCTURE, FOOTING SIZES & DETAILS, SLAB SIZES & DETAILS, SUB-SOIL & SHORING CONSTRUCTION, STRUCTURAL WALL SIZES & DETAILS REFER STRUCTURAL ENGINEER'S REPORT

FINAL ENGINEERING CONNECTIONS AND MEMBER TYPES TO MATCH ARCHITECTURAL INTENT.

Notes:
REFER TO SERVICE ENGINEER'S DRAWINGS FOR LOCATION OF S.D.F BOXES, GPO'S AND SKIRTING DUCTS. REFER TO SERVICES ENGINEER'S DRAWINGS FOR CO-ORDINATION OF SLAB & WALL 'BLOCKOUTS' AND 'CORED' PENETRATIONS.

REFER TO HYDRAULIC ENGINEER'S SERVICE PLAN FOR LOCATION OF SUB-FLOOR SERVICES.

REFER TO DOOR SCHEDULES FOR DOOR HARDWARE AND FURNITURE DETAILS
REFER TO MECHANICAL ENGINEER'S DRAWINGS AND SHOP DRAWINGS TO CONFIRM SIZES OF ALL DUCT PENETRATIONS AND LOUVRE OPENING SIZES.

REFER TO MECHANICAL ENGINEER'S DETAILS FOR PENETRATIONS AND BUILDING IN OF DUCTS, GRILLES, PLANT AND CEILING PLENUMS.

BUILD IN HIGH LEVEL OPENINGS FOR PLENUMS IN CEILING SPACES. REFER TO MECHANICAL ENGINEERS DRAWING.

FOR ADDITIONAL SETOUT INFORMATION WHERE NO DIMENSIONING SHOWN, REFER TO REFERENCE TAGS FOR DETAILED ARCHITECTURAL DRAWINGS.

REFER TO ARCHITECTURAL SPECIFICATION, SCHEDULES AND ROOM DATA SHEETS FOR FF&E AND FINISHES CODES FOR FURTHER DETAIL AND OTHER MISCELLANEOUS ITEMS.

NSW GOVERNMENT | Planning, Industry & Environment

*Issued under the Environmental Planning and Assessment Act 1979*

Approved Application No: SSD-9835 Signed:

Granted on the: 6 Dec 2019 Sheet No: 11 of 83

INSW Infrastructure New South Wales

**Cox Architecture**
Level 6, 155 Clarence Street,
Sydney, NSW 2000, Australia
T + 61 2 9267 9599
F + 61 2 9264 5844
www.coxarchitecture.com.au

**ASPECT Studios**
78/80 George St, Redfern,
NSW, 2016, Australia
T + 61 2 9699 7182

www.aspect-studios.com/au

**Nominated Architects**
Joe Agius no. 6491
Russell Lee no. 6367

COX ASPECT Studios®

**Consultants**

Roof Structure & Super Structure
NAME: ARUP
ADDRESS: Level 5 , Barrack Place, 151 Clarence St, Sydney, NSW, 2000
TEL/FAX: 9320 9320

NAME:
ADDRESS:
TEL/FAX:

NAME:
ADDRESS:
TEL/FAX:

**Client**
INSW

**Project No.**
218018.00

**Project**
SYDNEY FOOTBALL STADIUM
Driver Ave, Moore Park NSW 2021


**Drawing Title**
GENERAL SECTIONS - GA

**Document Control Status:**
DESIGN DEVELOPMENT

| | |
|---|---|
| A0 DRAWING SHEET | **Drawn:** Author |
| **Co-ordinated:** Checker | **Scale:** 1 : 250 @ A0 |
| **Project Architect:** Designer | **Date:** 20.09.19 |
| **Project Director:** Approver | **Revision:** C |
| **Drawing Number:** A40.00.01 | **North:** |

Cox Architecture Pty Ltd ACN 002 535 891

PLOT STAMP DATE: 20/09/2019 1:17:50 PM

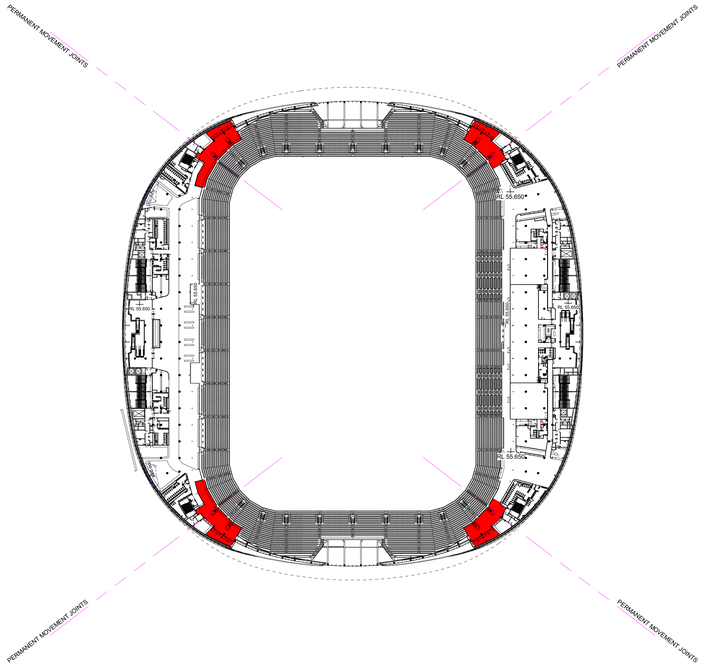
PERMANENT MOVEMENT JOINTS
PERMANENT MOVEMENT JOINTS
PERMANENT MOVEMENT JOINTS
PERMANENT MOVEMENT JOINTS
RL 55.650
RL 55.650
RL 55.650

# LEGEND

## GENERAL

SCOPE OF WORKS

PLANNING BOUNDARY

## TREE RETENTION + REMOVAL PLAN

TN.
XXX

**TREE NUMBER |** REFER ARBORIST REPORT FOR FURTHER INFORMATION

**EXISTING TREE |** TO BE RETAINED AND PROTECTED

**TREE PROTECTION ZONE (TPZ)**

**STRUCTURAL ROOT ZONE (SRZ)**

**EXISTING TREE |** APPROVED FOR REMOVAL STAGE 1 DA

**EXISTING TREE |** APPROVED FOR REMOVAL STAGE 2 DA

NOTE: PROJECT ARBORIST TO REVIEW DESIGN AND CONFIRM EXTENT OF TREE REMOVAL AND RETENTION. REFER TO ARBORICULTURAL IMPACT ASSESSMENT.

## PAVING + SURFACES

REFER TO SELECTION SCHEDULE, DETAILS & CIVIL ENGINEERS DETAILS

PV1 — **PAVING TYPE 1I** INSITU CONCRETE
REFER TO PAVING PLANS

PV1A — **PAVING TYPE 1A I** ON GRADE

PV1B — **PAVING TYPE 1B I** ON PODIUM

PV1C — **PAVING TYPE 1C I** OVER TREE ROOTS

PV1.1 — **PAVING TYPE 1.1 I** LIGHT SHOT BLAST TO HONED FINISH

PV1.2 — **PAVING TYPE 1.2 I** MEDIUM SHOT BLAST TO HONED FINISH

PV1.3 — **PAVING TYPE 1.3 I** BROOM FINISH

PV2 — **PAVING TYPE 2 I** BRICK PAVING
REFER TO PAVING PLANS

PV2A — **PAVING TYPE 2A I** ON GRADE

PV2B — **PAVING TYPE 2B I** ON PODIUM

PV2C — **PAVING TYPE 2C I** OVER TREE ROOTS

PV2.1 — **PAVING TYPE 2.1 I** PAVING ARRANGEMENT 1

PV2.2 — **PAVING TYPE 2.2 I** PAVING ARRANGEMENT 2

XPV2.3 — **PAVING TYPE 2.3 I** PAVING ARRANGEMENT 3

PV3 — **PAVING TYPE 3 I** BRICK PAVER

PV4 — **PAVING TYPE 4 I** PLEXIPAVE SURFACE AND LINEMARKING

PV5 — **PAVING TYPE 5 I** BRONZE INTERPRETIVE PAVING INLAY

**INTERPRETATION ZONE I** TO FUTURE DETAIL. REFER PAVING PLANS

SU1 — **SURFACE TYPE 1 I** DECO GRANITE — R — NEW SURFACE ADDED

T1 — **TACTILE TYPE 1 I** TACTILE INDICATORS

EJ — **EXPANSION JOINT**

SC — **SAW CUT JOINT**

## STAIRS, WALLS & KERBS

REFER TO SELECTION SCHEDULE, DETAILS & CIVIL ENGINEERS DETAILS

ST1 — **STAIR TYPE 1 I** ACCESS STAIRS - PRECAST CONCRETE
ST1.1, ST1.2, ST1.3, ST1.4, ST1.5, ST1.6, ST1.7, ST1.8

ST2 — **STAIR TYPE 2 I** ACCESS STAIRS - INSITU CONCRETE
ST2.1, ST2.2

TR1 — **TERRACES I** SEATING TERRACES
TR1

W1 — **WALL TYPE 1 I** PRECAST CONCRETE WALL WITH INTEGRATED TIMBER BENCH

W2 — **WALL TYPE 2 I** 1.1m INSITU CONCRETE WALL WITH HR2

W3 — **WALL TYPE 3 I** 1.55m INSITU CONCRETE WALL WITH FIXED BENCH

W4 — **WALL TYPE 4 I** SPLAYED WALL WITH BRICK FACE
W4.1, W4.2, W4.3, W4.4, W4.5, W4.6

W5.1 — **WALL TYPE 5.1 I** BRICK STAIR ABUTMENT WALL

W5.2 — **WALL TYPE 5.2 I** BRICK STAIR ABUTMENT WALL

W6 — **WALL TYPE 6 I** RAKING STEEL WALL

W7 — **WALL TYPE 7 I** STEEL WALL

W8.1 — **WALL TYPE 8.1 I** RETAINING WALL BY OTHERS WITH DECORATIVE TREATMENT

W8.2 — **WALL TYPE 8.2 I** RETAINING WALL BY OTHERS WITH HR2 HAND RAIL

W9 — **WALL TYPE 9 I** PRE CAST CONCRETE WALL

W10 — **WALL TYPE 10 I** BRICK WALL

W11 — **WALL TYPE 11 I** RETAINING WALL BY OTHERS (REFER TO ENGINEERS DETAIL)

K1 — **KERB TYPE 1 I** KERB TO CARPARK (BY OTHERS)

E1 — **EDGE TYPE 1 I** FLUSH IRON EDGE

E2 — **EDGE TYPE 2 I** EXPRESSED STEEL EDGE

E3 — **EDGE TYPE 3 I** EXPRESSED STEEL EDGE

E4 — **EDGE TYPE 4 I** FEATURE IRON EDGE

VD — **VEHICULAR CROSSING I** VEHICULAR DRIVEWAY

PR1 — **PRAM RAMP TYPE 1 I** INSITU CONCRETE

## FURNITURE + FIXTURES

REFER TO SELECTION SCHEDULE, DETAILS & MANUFACTURERS SPECIFICATIONS

B1 — **BOLLARD TYPE 1 |** FEATURE, FIXED

B2 — **BOLLARD TYPE 2 |** FIXED

B3 — **BOLLARD TYPE 3 |** REMOVABLE

B4 — **BOLLARD TYPE 4 |** TEMPORARY VEHICULAR RESISTANT

BE1 — **BENCH TYPE 1 |** PRECAST CONCRETE WITH TIMBER INLAY

~~BE2 — **BENCH TYPE 2 |** PRECAST CONCRETE WITH TIMBER INLAY~~

BE3 — **BENCH TYPE 3 |** CUSTOM SEATING BENCH

BE4 — **BENCH TYPE 4 |** TIMBER BENCH

BE5 — **BENCH TYPE 5 |** CUSTOM STEEL BENCH

TD1 — **TIMBER DECK TYPE 1 |** RAISED TIMBER DECK

TD2 — **TIMBER DECK TYPE 2 |** RAISED TIMBER DECK

F1 — **FURNITURE ELEMENT TYPE 1 |** BICYCLE HOOP

~~F2 — **FURNITURE ELEMENT TYPE 2 |** TABLE TENNIS TABLE~~

F3 — **FURNITURE ELEMENT TYPE 3 |** DRINKING FOUNTAIN

F4 — **FURNITURE ELEMENT TYPE 4 |** CUSTOM FRAME

HR1 — **HANDRAIL TYPE 1 |** FIXED

HR2 — **HANDRAIL TYPE 2 |** WALL FIXED WITH KICK RAIL

HR3 — **HANDRAIL TYPE 3 |** FREESTANDING WITH KICK RAIL

BA1 — **BALUSTRADE TYPE 1 |**

TG1 — **TREE GRATE TYPE 1 |** CONCRETE + BRICK INFILL

TG2 — **TREE GRATE TYPE 2 |** PLEXIPAVE

S1 — **STATUE 1 |** RELOCATED STATUE

WF — **WAYFINDING |** REFER TO WAYFINDING PACKAGE FOR DETAIL

**BUSBY'S BORE**

## FITNESS EQUIPMENT

REFER TO SELECTION SCHEDULE, DETAILS & MANUFACTURERS SPECIFICATIONS

FE1 — **FITNESS EQUIPMENT |** BASKETBALL HOOPS

FE2 — **FITNESS EQUIPMENT |** MULTI NET

FE3 — **FITNESS EQUIPMENT |** DECLINE BENCH

FE4 — **FITNESS EQUIPMENT |** OVERHEAD LADDER

FE5 — **FITNESS EQUIPMENT |** PARALLEL BARS

FE6 — **FITNESS EQUIPMENT |** STREETWORKOUT PRO

## INDICATIVE GRADING + LEVELS (INDICATIVE)

REFER TO CIVIL ENGINEERS DETAILS

+ EX 0.00 — **EXISTING LEVELS**

+ RL 0.00 — **PROPOSED LEVELS**

+ TW 0.00 — **PROPOSED TOP OF WALL LEVELS**

+ BW 0.00 — **PROPOSED BOTTOM OF WALL LEVELS**

+ TOS 0.00 — **PROPOSED TOP OF STAIR LEVELS**

+ BOS 0.00 — **PROPOSED BOTTOM OF STAIR LEVELS**

1:100 — **GRADIENT**

## FIXED ELEMENTS AND SERVICES

FX1 — **FIXTURE TYPE 1 |** PERMANENT SECURITY FENCING AND GATE

FX2 — **FIXTURE TYPE 2 |** TEMPORARY SECURITY FENCING AND GATE

FX3 — **FIXTURE TYPE 3 |** SCG METER

FX4 — **FIXTURE TYPE 4 |** RELOCATED AUSGRID SERVICE

**SYDNEY WATER LINE**

## PLANTING

FOR PLANTING AREAS REFER TO PLANTING PLANS, DETAILS & SELECTIONS SCHEDULE

**PROPOSED TREE**

TV — **SUBSURFACE TREE VAULTS I** STRATA VAULT

MP1 — **MASS PLANTING TYPE 1 I** ON GRADE

MP2 — **MASS PLANTING TYPE 2 I** ON SLAB

~~MP3 — **MASS PLANTING TYPE 3 I** UPPER LEVELS + ROOF GARDEN~~

MP4 — **MASS PLANTING TYPE 4 I** EXISTING TREE ON GRADE

**MASS PLANTING MIX A I** FEATURE SEATING PLANTING

**MASS PLANTING MIX B I** FEATURE STAIR PLANTING

**MASS PLANTING MIX C I** EDGE PLANTING

**MASS PLANTING MIX D I** EX. FIG UNDERPLANTING

**MASS PLANTING MIX E I** FEATURE TREE PLANTING

**MASS PLANTING MIX F I** WSUD PLANTING

**MASS PLANTING MIX G I** SOUTHERN EDGE PLANTING

**MASS PLANTING MIX H I** GREEN WALL EDGE

~~**MASS PLANTING MIX I I** NORTH FACING UPPER PLANTING~~

~~**MASS PLANTING MIX J I** SOUTH FACING UPPER PLANTING~~

## SOIL DEPTH PLANS

REFER TO SOIL DEPTH PLANS & DETAILS

**DEEP SOIL AREAS**

**1.2m SOIL DEPTH AREAS**

~~**600mm SOIL DEPTH AREAS**~~

**NOTES**

These drawings are shown in colour and shall be read in digital format or print colour hardcopy.

These drawings shall be read in conjunction with all relevant information (not limited to legends, schedules, specifications)

These drawings shall be read in conjunction with any Engineers, Architects or other consultant information. (not limited to drawings, legends, schedules, specifications)

Check all dimensions and site conditions prior to commencement of any work and the procurement of any services, materials, fittings, fabrication or equipment.

Do not scale drawings – refer to figured drawings only. Any discrepancies shall immediately be referred to the Landscape Architect for clarification.

All drawings shall not be reproduced or distributed without prior permission of the Landscape Architect.

WARNING

DIAL BEFORE YOU DIG www.1100.com.au

Services shown on this drawing are approximate only. The exact location is to be confirmed on site by contractor prior to commencement of work.

| DATE | REV | AMENDMENTS |
|---|---|---|
| 1/2/19 | A | END OF JANUARY PACKAGE - ISSUED FOR INFORMATION |
| 25/2/19 | B | END OF FEBRUARY PACKAGE - FOR INFORMATION |
| 29/3/19 | C | 80% DD - FOR INFORMATION |
| 24/7/19 | D | REVISED TENDER - FOR INFORMATION |
| 8/8/19 | E | REVISED TENDER - FOR INFORMATION |
| 14/8/19 | F | EARLY WORKS - FOR INFORMATION |
| 16/8/19 | G | EARLY WORKS - FOR INFORMATION |

NSW GOVERNMENT Planning, Industry & Environment

*Issued under the Environmental Planning and Assessment Act 1979*

Approved Application No: SSD-9835 Signed:

Granted on the: 6 Dec 2019 Sheet No: 13 of 83

**ADJUSTMENTS TO PUBLIC DOMAIN PROPOSALS**

DENOTES DRAWINGS NO LONGER IN USE

ASPECT Studios™
ASPECT Studios Pty Ltd
Level 1, 78-80 George Street
Redfern NSW 2016
Australia
T 02 9699 7182
www.aspect-studios.com
sydney@aspect-studios.com
ABN 11 120 219 561

CLIENT
we are insw Infrastructure New South Wales

PROJECT
SYDNEY FOOTBALL STADIUM
Moore Park, New South Wales
S18030

DRAWING
LEGEND

| DRAWN | CHECKED | SCALE A0 \| SCALE A2 |
|---|---|---|
| TL \| DC | JH | NOT TO SCALE |

STATUS — NORTH

FOR INFORMATION
NOT FOR CONSTRUCTION

DRAWING NO. — REVISION

LA-002 G

## Plant Schedule: Trees Ground Level

| ID | Botanical Name | Common Name | Mature Height | Mature Spread | Pot Size | Quantity |
|---|---|---|---|---|---|---|
| **Trees** | | | | | | |
| Afj | Acer freemanii "JeffersRed" | JeffersRed | 13m | 10m | 400L | 10 |
| Bi | Banksia integrifolia | Coast Banksia | 3-15m | 6m | 200L | 10 |
| Can | Cupaniopsis anacardioides | Tuckeroo | 30m | 5m | 200L | 12 |
| Cci | Corymbia citriodora | Lemon Scented Gum | 8-15m | 10m | 400L | 5 |
| Cm | Corymbia maculata | Spotted gum | 30m | 10m | 200L | 17 |
| Cm | Corymbia maculata | Spotted gum | 30m | 10m | 400L | 26 |
| Fa | Flindersia australis | Crows ash | | 1-6m | 200L | 35 |
| Fr | Ficus rugibinosa | Port Jackson fig | 20m | 15m | 1000L | 2 |

## Plant Schedule: Mass Planting Mix A [MPA] Ground Level. AREA: 940m2

| Category / ID | Botanical Name | Common Name | Mature Height | Mature Spread | Pot Size | Spacing | Quantity | Percentage % |
|---|---|---|---|---|---|---|---|---|
| **Shrubs** | | | | | | | | |
| Cl | Callistemon 'Little John' | Callistemon | 0.5m-1m | 0.75m | 200mm | 5 p/m2 | 245 | 5.3 |
| Cr | Correa reflexa | Native Fuchsia | 0.5-2m | 0.5-1.5m | 200 mm | 5 p/m2 | 245 | 5.3 |
| Cw | Callistemon 'White Anzac' | Callistemon | 0.5m-1m | 0.5-1.5m | 200mm | 5 p/m2 | 245 | 5.3 |
| Dos | Darwinia fascicularis 'Seaspray' | Seaspray | 0.75-1.5m | 0.75-1.5m | 200mm | 5 p/m2 | 245 | 5.3 |
| De | Doryanthes excelsa | Gymea Lily | 2-3m | 1.5-3m | 300 mm | 5 p/m2 | 245 | 5.3 |
| Eg | Eremophila glabra | Tar Brush | 0.1-3m | 1-2m | | 5 p/m2 | 245 | 5.3 |
| Gmt | Grevillea 'Mt Tambonthа' | Woolly Grevillea | 0.3-.5m | 0.6-1.5m | 300 mm | 5 p/m2 | 245 | 5.3 |
| Pmp | Philotheca myoporoides | Profusion | 0.8-1m | 0.8-1m | 200mm | 5 p/m2 | 245 | 5.3 |
| Wz | Westringia fruticosa 'Zena' | Coastal Rosemary | 1-2m | 1.5-2.5m | 200 mm | 5 p/m2 | 245 | 5.3 |
| **Groundcovers** | | | | | | | | |
| Brm-1 | Brachyscome multifida 'Break O Day' | Native Daisy | 0.2 - 0.3m | 0.4 - 0.5m | 300 | 7 p/m2 | 484 | 7.4 |
| Cg | Carpobrotus glaucescens | Pig Face | 0.3m | 1-2m | 200 | 7 p/m2 | 484 | 7.4 |
| Gp | Grevillea 'Poorinda Royal Mantle' | Grevillea | 0.1 - 0.2m | 3.0 - 5.0m | 300 mm | 7 p/m2 | 484 | 7.4 |
| Hve | Hardenbergia violaceae | False Sarsparilla | 0.3m | 1-2m | 200 mm | 7 p/m2 | 484 | 7.4 |
| **Grasses** | | | | | | | | |
| Ar | Anigozanthus 'Red Endeavour' | Red endeavour | 0.6-1.2m | 0.5-1m | 200mm | 7 p/m2 | 484 | 7.4 |
| Dcl | Dianella caerulea 'Little Jess' | Blue Flax Lily | 0.5m | .5m | 400 mm | 7 p/m2 | 484 | 7.4 |
| Lk | Lomandra longifolia "Katies Belle" | Katies Belle | 0.5-1m | 0.5-1mm | 400 mm | 7 p/m2 | 484 | 7.4 |

## Plant Schedule: Mass Planting Mix B [MPB] Ground Level. AREA: 270m2

| Category / ID | Botanical Name | Common Name | Mature Height | Mature Spread | Pot Size | Spacing | Quantity | Percentage % |
|---|---|---|---|---|---|---|---|---|
| **Shrubs** | | | | | | | | |
| Bks | Banksia serrata | Old Man Banksia | 1.0 - 2.0m | 1.0 - 2.0m | 200 mm | 5 p/m2 | 85 | 6.4 |
| Ca-1 | Correa alba | Correa | 0.45 - 0.6m | 0.3 - 0.6m | | 5 p/m2 | 85 | 6.4 |
| Wm | Westringia fruticosa 'mundi' | | 0.45 - 0.6m | 0.3 - 0.6m | | 5 p/m2 | 85 | 6.4 |
| **Grasses** | | | | | | | | |
| Fn | Ficinia nodosa | Knobby Club Rush | 0.8m | 0.6m | 200 mm | 7 p/m2 | 168 | 9 |
| **Groundcovers** | | | | | | | | |
| Am | Aloe 'Moonglow' | Aloe 'Moonglow' | 0.5m | 0.8m | 400 mm | 7 p/m2 | 168 | 9 |
| Cg | Carpobrotus glaucescens | Pig Face | 0.3m | 1-2m | 200 | 7 p/m2 | 168 | 9 |
| Dsf | Dichondra 'Silver Falls' | Dichondra Silver Falls | 0.1m | 0.8m | 300 mm | 7 p/m2 | 168 | 9 |
| Gg | Grevillea juniperina 'Gold Cluster' | 'Gold Cluster' Grevillea | 0.3m | 0.8-1m | 300 mm | 7 p/m2 | 168 | 9 |
| Gp | Grevillea 'Poorinda Royal Mantle' | Grevillea | 0.1 - 0.2m | 3.0 - 5.0m | 300 mm | 7 p/m2 | 168 | 9 |
| Hve | Hardenbergia violaceae | False Sarsparilla | 0.3m | 1-2m | 200 mm | 7 p/m2 | 168 | 9 |
| Mpy | Myoporum parvifolium 'Yareena' | Creeping boobialla | 0 -0.2m | 1.5 - 2m | 300 mm | 7 p/m2 | 168 | 9 |
| Ss | Senecio serpens | Blue Chalkstick | 0.2m | 0.5-1m | 150 | 7 p/m2 | 168 | 9 |

## Plant Schedule: Mass Planting Mix C [MPC] Ground Level. AREA: 1375m2

| Category / ID | Botanical Name | Common Name | Mature Height | Mature Spread | Pot Size | Spacing | Quantity | Percentage % |
|---|---|---|---|---|---|---|---|---|
| **Shrubs** | | | | | | | | |
| Ble | Banksia 'Little Eric" | Banksia 'Little Eric" | 1.5-2m | 1.5m | | 5 p/m2 | 549 | 8.1 |
| Dos | Darwinia fascicularis 'Seaspray' | Seaspray | 0.75-1.5m | 0.75-1.5m | 200mm | 5 p/m2 | 549 | 8.1 |
| Ea | Eriostemon australasius | Wax Flower | 1m | 1m | 300mm | 5 p/m2 | 549 | 8.1 |
| Pmp | Philotheca myoporoides | Profusion | 0.8-1m | 0.8-1m | 200mm | 5 p/m2 | 549 | 8.1 |
| Wz | Westringia fruticosa 'Zena' | Coastal Rosemary | 1-2m | 1.5-2.5m | 200 mm | 5 p/m2 | 549 | 8.1 |
| **Grasses** | | | | | | | | |
| Dcl | Dianella caerulea 'Little Jess' | Blue Flax Lily | 0.5m | .5m | 400 mm | 7 p/m2 | 1079 | 11.3 |
| Lk | Lomandra longifolia "Katies Belle" | Katies Belle | 0.5-1m | 0.5-1mm | 400 mm | 7 p/m2 | 1079 | 11.3 |
| Lt | Lomandra 'Tanika' | Tanika | 0.45 - 0.6m | 0.3 - 0.6m | 200mm | 7 p/m2 | 1079 | 11.3 |
| **Groundcovers** | | | | | | | | |
| Ahe | Actinotus helianthii | Flannel FLower | 0.3-1.2m | 0.3 - 0.6m | | 7 p/m2 | 1079 | 11.3 |
| Mpy | Myoporum parvifolium 'Yareena' | Creeping boobialla | 0 -0.2m | 1.5 - 2m | 300 mm | 7 p/m2 | 1079 | 11.3 |

## Plant Schedule: Mass Planting Mix D [MPD] Ground Level. AREA: 590m2

| Category / ID | Botanical Name | Common Name | Mature Height | Mature Spread | Pot Size | Spacing | Quantity | Percentage % |
|---|---|---|---|---|---|---|---|---|
| **Shrubs** | | | | | | | | |
| **Grasses** | | | | | | | | |
| **Groundcovers** | | | | | | | | |
| Kr | Kennedia rubicunda | Dusky coral pea | 0.1m | 0.8m | 300 mm | 7 p/m2 | 1373 | 33.3 |
| Mc | Muehlenbeckia complexa | Maiden Hair Vine | 0.5m | 5m | 200 mm | 7 p/m2 | 1373 | 33.3 |
| Tj | Trachelospermum jasminoides | Chinese Star Jasmine | 0.3-0.5m | 3.5 - 6m | 300 mm | 7 p/m2 | 1373 | 33.3 |

## Plant Schedule: Mass Planting Mix E [MPE] Ground Level. AREA: 125m2

| Category / ID | Botanical Name | Common Name | Mature Height | Mature Spread | Pot Size | Spacing | Quantity | Percentage % |
|---|---|---|---|---|---|---|---|---|
| **Shrubs** | | | | | | | | |
| Cea | Carissa "Emerald Star" | Carissa "Emerald Star" | 0.5-1m | 1m | 300mm | 5 p/m2 | 62 | 10 |
| Wfm | Westringia fruticosa 'Mundi' | Coastal Rosemary | 0.1 -0.5m | 1.0 -1.5m | 200 mm | 5 p/m2 | 62 | 10 |
| Wz | Westringia fruticosa 'Zena' | Coastal Rosemary | 1-2m | 1.5-2.5m | 200 mm | 5 p/m2 | 62 | 10 |
| **Grasses** | | | | | | | | |
| Dcl | Dianella caerulea 'Little Jess' | Blue Flax Lily | 0.5m | .5m | 400 mm | 7 p/m2 | 122 | 14 |
| Dr | Dianella revoluta | Blue Flax Lily | 0.3m | 0.4m | 200 mm | 7 p/m2 | 122 | 14 |
| Drb | Dianella revoluta 'Blue Stream' | Blue Flax Lily | 0.3m | 0.4m | 200 mm | 7 p/m2 | 122 | 14 |
| Le | Liriope muscari 'Evergreen Giant' | Evergreen Giant Lilyturf | 0.45 -0.6m | 0.3 -0.6m | 200 | 7 p/m2 | 122 | 14 |
| **Groundcovers** | | | | | | | | |
| Mpy | Myoporum parvifolium 'Yareena' | Creeping boobialla | 0 -0.2m | 1.5 - 2m | 300 mm | 7 p/m2 | 122 | 14 |

## Plant Schedule: Mass Planting Mix F [MPF] Ground Level. AREA: 155m2

| Category / ID | Botanical Name | Common Name | Mature Height | Mature Spread | Pot Size | Spacing | Quantity | Percentage % |
|---|---|---|---|---|---|---|---|---|
| **Shrubs** | | | | | | | | |
| Bks | Banksia serrata | Old Man Banksia | 1.0 - 2.0m | 1.0 - 2.0m | 200 mm | 5 p/m2 | 84 | 11.1 |
| Wm | Westringia fruticosa 'mundi' | | 0.45 - 0.6m | 0.3 - 0.6m | | 5 p/m2 | 84 | 11.1 |
| **Grasses** | | | | | | | | |
| Cap | Carex appressa | Tall Sedge | 0.9 - 1.5m | 0.3 - 0.6m | 150 mm | 7 p/m2 | 168 | 15.6 |
| Fn | Ficinia nodosa | Knobby Club Rush | 0.8m | 0.6m | 200 mm | 7 p/m2 | 168 | 15.6 |
| Ju | Juncus usitatus | Common Rush | 0.9m | 0.8m | 400 mm | 7 p/m2 | 168 | 15.6 |
| Pa | Poa affinis | Grey Tussock Grass | 0.5m | 0.7-1m | 400 mm | 7 p/m2 | 168 | 15.6 |
| Rs-1 | Restio fastigiata | Tassel Rush | 0.45 - 0.6m | 0.3 - 0.6m | | 7 p/m2 | 168 | 15.6 |
| **Groundcovers** | | | | | | | | |

## Plant Schedule: Mass Planting Mix G [MPG] Ground Level. AREA: 270m2

| Category / ID | Botanical Name | Common Name | Mature Height | Mature Spread | Pot Size | Spacing | Quantity | Percentage % |
|---|---|---|---|---|---|---|---|---|
| **Shrubs** | | | | | | | | |
| Aau | Asplenium australasicum | Bird's Nest Fern | 0.9 - 1.5m | 2.0 - 3.5m | 400 | 5 p/m2 | 101 | 7.5 |
| Aci | Anthropodium cirratum | NZ Rock Lilly | 0.5m-1m | 0.5m | 300 mm | 5 p/m2 | 101 | 7.5 |
| Ces | Carissa "Emerald Star" | Carissa "Emerald Star" | 0.5-1m | 1m | 300mm | 5 p/m2 | 101 | 7.5 |
| Dth | Dichroysandra thrysifolia | Blue ginger | 2.5m | 1m | 300 mm | 5 p/m2 | 101 | 7.5 |
| Px | Philodendron 'Xanadu' | Xanadu | 0.45 - 0.6m | 0.3 - 1m | 300mm | 5 p/m2 | 101 | 7.5 |
| **Grasses** | | | | | | | | |
| Da | Doodia aspera | Prickly Rasp Fern | 0.5m | 0.5m | 200 mm | 7 p/m2 | 197 | 10.4 |
| **Groundcovers** | | | | | | | | |
| Caa | Cissus antarctica | Kangaroo Vine | 3 -5m | 2.0 -3.5m | 200 | 7 p/m2 | 197 | 10.4 |
| Dr-1 | Dichondra repens | Kidney Plant | 0.45 -0.6m | 0.3 -0.6m | | 7 p/m2 | 197 | 10.4 |
| His | Hibbertia scandens | Hibbertia | 0.45 -0.6m | 0.3 -0.6m | | 7 p/m2 | 197 | 10.4 |
| Tj | Trachelospermum jasminoides | Chinese Star Jasmine | 0.3-0.5m | 3.5 - 6m | 300 mm | 7 p/m2 | 197 | 10.4 |
| Vh | Viola hederacea | Native Violet | <0.15m | 0.6 - 1.0m | 140 mm | 7 p/m2 | 197 | 10.4 |

## Plant Schedule: Mass Planting Mix H [MPH] Ground Level. AREA: 200m2

| Category / ID | Botanical Name | Common Name | Mature Height | Mature Spread | Pot Size | Spacing | Quantity | Percentage % |
|---|---|---|---|---|---|---|---|---|
| **Shrubs** | | | | | | | | |
| Ble | Banksia 'Little Eric" | Banksia 'Little Eric" | 1.5-2m | 1.5m | | 5 p/m2 | 81 | 8.1 |
| Dos | Darwinia fascicularis 'Seaspray' | Seaspray | 0.75-1.5m | 0.75-1.5m | 200mm | 5 p/m2 | 81 | 8.1 |
| Ea | Eriostemon australasius | Wax Flower | 1m | 1m | 300mm | 5 p/m2 | 81 | 8.1 |
| Pmp | Philotheca myoporoides | Profusion | 0.8-1m | 0.8-1m | 200mm | 5 p/m2 | 81 | 8.1 |
| Wz | Westringia fruticosa 'Zena' | Coastal Rosemary | 1-2m | 1.5-2.5m | 200 mm | 5 p/m2 | 81 | 8.1 |
| **Grasses** | | | | | | | | |
| Dcl | Dianella caerulea 'Little Jess' | Blue Flax Lily | 0.5m | 5m | 400 mm | 7 p/m2 | 161 | 11.3 |
| Lk | Lomandra longifolia "Katies Belle" | Katies Belle | 0.5-1m | 0.5-1mm | 400 mm | 7 p/m2 | 161 | 11.3 |
| Lt | Lomandra 'Tanika' | Tanika | 0.45 - 0.6m | 0.3 - 0.6m | 200mm | 7 p/m2 | 161 | 11.3 |
| **Groundcovers** | | | | | | | | 11.3 |
| Ahe | Actinotus helianthii | Flannel FLower | 0.3-1.2m | 0.3 - 0.6m | | 7 p/m2 | 161 | 11.3 |
| Mpy | Myoporum parvifolium 'Yareena' | Creeping boobialla | 0 -0.2m | 1.5 - 2m | 300 mm | 7 p/m2 | 161 | 11.3 |

## Plant Schedule: Trees Level 2

| Category / ID | Botanical Name | Common Name | Mature Height | Mature Spread | Pot Size | Pot / m² | Quantity |
|---|---|---|---|---|---|---|---|
| **Trees** | | | | | | | |
| Bi | Banksia integrifolia | Coast Banksia | 3-10m | 1-5m | 200L | AS SHOWN | 2 |
| Ht | Hibiscus tiliaceous | Cottonwood Hibiscus | 8m | 5m | 200L | AS SHOWN | 2 |

## Plant Schedule: Trees Level 3

| Category / ID | Botanical Name | Common Name | Mature Height | Mature Spread | Pot Size | Pot / m² | Quantity |
|---|---|---|---|---|---|---|---|
| **Trees** | | | | | | | |
| Bi | Banksia integrifolia | Coast Banksia | 3-15m | 1-6m | 200L | AS SHOWN | 4 |
| Ht | Hibiscus tiliaceous | Cottonwood Hibiscus | 8m | 5m | 200L | AS SHOWN | 4 |

## Plant Schedule: Trees Level 4

| Category / ID | Botanical Name | Common Name | Mature Height | Mature Spread | Pot Size | Pot / m² | Quantity |
|---|---|---|---|---|---|---|---|
| **Trees** | | | | | | | |
| Bi | Banksia integrifolia | Coast Banksia | 3-15m | 1-6m | 200L | AS SHOWN | 5 |
| Ht | Hibiscus tiliaceous | Cottonwood Hibiscus | 8m | 5m | 200L | AS SHOWN | 4 |

## Plant Schedule: Mass Planting Mix J [MPJ] Level 2

Total Area 139m²

| Category / ID | Botanical Name | Common Name | Mature Height | Mature Spread | Pot Size | Pot / m² | Quantity |
|---|---|---|---|---|---|---|---|
| **Trees** | | | | | | | |
| **Shrubs** | | | | | | | |
| Aau | Asplenium australasicum | Bird's Nest Fern | 0.9 - 1.5m | 2.0 - 3.5m | 300mm | AS SHOWN | |
| Aci | Anthropodium cirratum | NZ Rock Lilly | 0.5m-1m | 0.5m | 300 mm | AS SHOWN | |
| Ces | Carissa "Emerald Star" | Carissa "Emerald Star" | 0.5-1m | 1m | 300mm | AS SHOWN | |
| Dth | Dichroysandra thrysifolia | Blue ginger | 2.5m | 1m | 300 mm | AS SHOWN | |
| Px | Philodendron 'Xanadu' | Xanadu | 0.45 - 0.6m | 0.3 - 1m | 300mm | AS SHOWN | |
| **Grasses** | | | | | | | |
| Da | Doodia aspera | Prickly Rasp Fern | 0.5m | 0.5m | 300mm | AS SHOWN | |
| **Groundcovers** | | | | | | | |
| Hc | Hedera canariensis | Canary Islands Ivy | 0.2-0.5m | 5m | 200mm | AS SHOWN | |
| Tj | Trachelospermum jasminoides | Chinese Star Jasmine | 0.3-0.5m | 3.5 - 6m | 300 mm | AS SHOWN | |
| Tja | Trachelospermum 'Tricolour' | Tricolour Jasmine | 1.5 - 3m | 3.5 - 6m | 300 mm | AS SHOWN | |
| Vh | Viola hederacea | Native Violet | <0.15m | 0.6 - 1.0m | 140 mm | AS SHOWN | |

## Plant Schedule: Mass Planting Mix I [MPI] Level 2

Total Area 207m²

| Category / ID | Botanical Name | Common Name | Mature Height | Mature Spread | Pot Size | Pot / m² | Quantity |
|---|---|---|---|---|---|---|---|
| **Trees** | | | | | | | |
| **Shrubs** | | | | | | | |
| Ble | Banksia 'Little Eric" | Banksia 'Little Eric" | 1.5-2m | 1.5m | 300mm | AS SHOWN | |
| Wm | Westringia fruticosa 'mundi' | Coastal Rosemary | 0.45 - 0.6m | 0.3 - 0.6m | 300mm | AS SHOWN | |
| Wz | Westringia fruticosa 'Zena' | Coastal Rosemary | 1-2m | 1.5-2.5m | 300mm | AS SHOWN | |
| **Grasses** | | | | | | | |
| **Groundcovers** | | | | | | | |
| Ced | Carpobrotus edulis | Hottentot Fig | 0.3m | 1-2m | 150mm | AS SHOWN | |
| Cg | Carpobrotus glaucescens | Pig Face | 0.3m | 1-2m | 150mm | AS SHOWN | |
| Dsf | Dichondra 'Silver Falls' | Dichondra Silver Falls | 0.1m | 0.8m | 150mm | AS SHOWN | |
| Gp | Grevillea 'Poorinda Royal Mantle' | Grevillea | 0.1 - 0.2m | 3.0 - 5.0m | 300mm | AS SHOWN | |
| Ss | Senecio serpens | Blue Chalkstick | 0.2m | 0.5-1m | 150mm | AS SHOWN | |

## Plant Schedule: Mass Planting Mix J [MPJ] Level 3

Total Area 1,210m²

| Category / ID | Botanical Name | Common Name | Mature Height | Mature Spread | Pot Size | Pot / m² | Quantity |
|---|---|---|---|---|---|---|---|
| **Shrubs** | | | | | | | |
| Ble | Banksia 'Little Eric" | Banksia 'Little Eric" | 1.5-2m | 1.5m | 300mm | AS SHOWN | |
| Wm | Westringia fruticosa 'mundi' | Coastal Rosemary | 0.45 - 0.6m | 0.3 - 0.6m | 300mm | AS SHOWN | |
| Wz | Westringia fruticosa 'Zena' | Coastal Rosemary | 1-2m | 1.5-2.5m | 300mm | AS SHOWN | |
| **Groundcovers** | | | | | | | |
| Ced | Carpobrotus edulis | Hottentot Fig | 0.3m | 1-2m | 150mm | AS SHOWN | |
| Cg | Carpobrotus glaucescens | Pig Face | 0.3m | 1-2m | 150mm | AS SHOWN | |
| Dsf | Dichondra 'Silver Falls' | Dichondra Silver Falls | 0.1m | 0.8m | 150mm | AS SHOWN | |
| Gp | Grevillea 'Poorinda Royal Mantle' | Grevillea | 0.1 - 0.2m | 3.0 - 5.0m | 300mm | AS SHOWN | |
| Ss | Senecio serpens | Blue Chalkstick | 0.2m | 0.5-1m | 150mm | AS SHOWN | |
| **Grasses** | | | | | | | |

## Plant Schedule: Mass Planting Type I [MPI] Level 3

Total Area 1,210m²

| Category / ID | Botanical Name | Common Name | Mature Height | Mature Spread | Pot Size | Pot / m² | Quantity |
|---|---|---|---|---|---|---|---|
| **Shrubs** | | | | | | | |
| Aau | Asplenium australasicum | Bird's Nest Fern | 0.9 - 1.5m | 2.0 - 3.5m | 300mm | AS SHOWN | |
| Aci | Anthropodium cirratum | NZ Rock Lilly | 0.5m-1m | 0.5m | 300 mm | AS SHOWN | |
| Ces | Carissa "Emerald Star" | Carissa "Emerald Star" | 0.5-1m | 1m | 300mm | AS SHOWN | |
| Dth | Dichroysandra thrysifolia | Blue ginger | 2.5m | 1m | 300 mm | AS SHOWN | |
| Px | Philodendron 'Xanadu' | Xanadu | 0.45 - 0.6m | 0.3 - 1m | 300mm | AS SHOWN | |
| **Groundcovers** | | | | | | | |
| Hc | Hedera canariensis | Canary Islands Ivy | 0.2-0.5m | 5m | 200mm | AS SHOWN | |
| Tj | Trachelospermum jasminoides | Chinese Star Jasmine | 0.3-0.5m | 3.5 - 6m | 300 mm | AS SHOWN | |
| Tja | Trachelospermum 'Tricolour' | Tricolour Jasmine | 1.5 - 3m | 3.5 - 6m | 300 mm | AS SHOWN | |
| Vh | Viola hederacea | Native Violet | <0.15m | 0.6 - 1.0m | 140 mm | AS SHOWN | |
| **Grasses** | | | | | | | |
| Da | Doodia aspera | Prickly Rasp Fern | 0.5m | 0.5m | 300mm | AS SHOWN | |

## Plant Schedule: Mass Planting Mix J [MPJ] Level 4

Total Area 1,210m²

| Category / ID | Botanical Name | Common Name | Mature Height | Mature Spread | Pot Size | Pot / m² | Quantity |
|---|---|---|---|---|---|---|---|
| **Shrubs** | | | | | | | |
| Aau | Asplenium australasicum | Bird's Nest Fern | 0.9 - 1.5m | 2.0 - 3.5m | 300mm | AS SHOWN | |
| Aci | Anthropodium cirratum | NZ Rock Lilly | 0.5m-1m | 0.5m | 300 mm | AS SHOWN | |
| Ces | Carissa "Emerald Star" | Carissa "Emerald Star" | 0.5-1m | 1m | 300mm | AS SHOWN | |
| Dth | Dichroysandra thrysifolia | Blue ginger | 2.5m | 1m | 300 mm | AS SHOWN | |
| Px | Philodendron 'Xanadu' | Xanadu | 0.45 - 0.6m | 0.3 - 1m | 300mm | AS SHOWN | |
| **Groundcovers** | | | | | | | |
| Hc | Hedera canariensis | Canary Islands Ivy | 0.2-0.5m | 5m | 200mm | AS SHOWN | |
| Tj | Trachelospermum jasminoides | Chinese Star Jasmine | 0.3-0.5m | 3.5 - 6m | 300 mm | AS SHOWN | |
| Tja | Trachelospermum 'Tricolour' | Tricolour Jasmine | 1.5 - 3m | 3.5 - 6m | 300 mm | AS SHOWN | |
| Vh | Viola hederacea | Native Violet | <0.15m | 0.6 - 1.0m | 140 mm | AS SHOWN | |
| **Grasses** | | | | | | | |

## Plant Schedule: Mass Planting Mix J [MPJ] Level 2

Total Area 139m²

| Category / ID | Botanical Name | Common Name | Mature Height | Mature Spread | Pot Size | Pot / m² | Quantity |
|---|---|---|---|---|---|---|---|
| **Trees** | | | | | | | |
| **Shrubs** | | | | | | | |
| Aau | Asplenium australasicum | Bird's Nest Fern | 0.9 - 1.5m | 2.0 - 3.5m | 300mm | AS SHOWN | |
| Aci | Anthropodium cirratum | NZ Rock Lilly | 0.5m-1m | 0.5m | 300 mm | AS SHOWN | |
| Ces | Carissa "Emerald Star" | Carissa "Emerald Star" | 0.5-1m | 1m | 300mm | AS SHOWN | |
| Dth | Dichroysandra thrysifolia | Blue ginger | 2.5m | 1m | 300 mm | AS SHOWN | |
| Px | Philodendron 'Xanadu' | Xanadu | 0.45 - 0.6m | 0.3 - 1m | 300mm | AS SHOWN | |
| **Grasses** | | | | | | | |
| Da | Doodia aspera | Prickly Rasp Fern | 0.5m | 0.5m | 300mm | AS SHOWN | |
| **Groundcovers** | | | | | | | |
| Def | Dichondra 'Silver Falls' | Dichondra Silver Falls | 0.1m | 0.8m | 150mm | AS SHOWN | |
| Gp | Grevillea 'Poorinda Royal Mantle' | Grevillea | 0.1 - 0.2m | 3.0 - 5.0m | 300mm | AS SHOWN | |
| Ss | Senecio serpens | Blue Chalkstick | 0.2m | 0.5-1m | 150mm | AS SHOWN | |

## Plant Schedule: Mass Planting Mix I [MPI] Level 2

Total Area 207m²

| Category / ID | Botanical Name | Common Name | Mature Height | Mature Spread | Pot Size | Pot / m² | Quantity |
|---|---|---|---|---|---|---|---|
| **Trees** | | | | | | | |
| **Shrubs** | | | | | | | |
| Ble | Banksia 'Little Eric" | Banksia 'Little Eric" | 1.5-2m | 1.5m | 300mm | AS SHOWN | |
| Wm | Westringia fruticosa 'mundi' | Coastal Rosemary | 0.45 - 0.6m | 0.3 - 0.6m | 300mm | AS SHOWN | |
| Wz | Westringia fruticosa 'Zena' | Coastal Rosemary | 1-2m | 1.5-2.5m | 300mm | AS SHOWN | |
| **Grasses** | | | | | | | |
| **Groundcovers** | | | | | | | |
| Ced | Carpobrotus edulis | Hottentot Fig | 0.3m | 1-2m | 150mm | AS SHOWN | |
| Cg | Carpobrotus glaucescens | Pig Face | 0.3m | 1-2m | 150mm | AS SHOWN | |
| Dsf | Dichondra 'Silver Falls' | Dichondra Silver Falls | 0.1m | 0.8m | 150mm | AS SHOWN | |
| Gp | Grevillea 'Poorinda Royal Mantle' | Grevillea | 0.1 - 0.2m | 3.0 - 5.0m | 300mm | AS SHOWN | |
| Ss | Senecio serpens | Blue Chalkstick | 0.2m | 0.5-1m | 150mm | AS SHOWN | |

## Plant Schedule: Mass Planting Type I [MPI] Level 3

Total Area 1,210m²

| Category / ID | Botanical Name | Common Name | Mature Height | Mature Spread | Pot Size | Pot / m² | Quantity |
|---|---|---|---|---|---|---|---|
| **Shrubs** | | | | | | | |
| Aau | Asplenium australasicum | Bird's Nest Fern | 0.9 - 1.5m | 2.0 - 3.5m | 300mm | AS SHOWN | |
| Aci | Anthropodium cirratum | NZ Rock Lilly | 0.5m-1m | 0.5m | 300 mm | AS SHOWN | |
| Ces | Carissa "Emerald Star" | Carissa "Emerald Star" | 0.5-1m | 1m | 300mm | AS SHOWN | |
| Dth | Dichroysandra thrysifolia | Blue ginger | 2.5m | 1m | 300 mm | AS SHOWN | |
| Px | Philodendron 'Xanadu' | Xanadu | 0.45 - 0.6m | 0.3 - 1m | 300mm | AS SHOWN | |
| **Groundcovers** | | | | | | | |
| Hc | Hedera canariensis | Canary Islands Ivy | 0.2-0.5m | 5m | 200mm | AS SHOWN | |
| Tj | Trachelospermum jasminoides | Chinese Star Jasmine | 0.3-0.5m | 3.5 - 6m | 300 mm | AS SHOWN | |
| Tja | Trachelospermum 'Tricolour' | Tricolour Jasmine | 1.5 - 3m | 3.5 - 6m | 300 mm | AS SHOWN | |
| Vh | Viola hederacea | Native Violet | <0.15m | 0.6 - 1.0m | 140 mm | AS SHOWN | |
| **Grasses** | | | | | | | |
| Da | Doodia aspera | Prickly Rasp Fern | 0.5m | 0.5m | 300mm | AS SHOWN | |

NO LONGER IN USE
NO LONGER IN USE

NOTES

These drawings are shown in colour and shall be read in digital format or print colour hardcopy.

These drawings shall be read in conjunction with all relevant information (not limited to legends, schedules, specifications)

These drawings shall be read in conjunction with any Engineers, Architects or other consultant information. (not limited to drawings, legends, schedules, specifications)

Check all dimensions and site conditions prior to commencement of any work and the procurement of any services, materials, fittings, fabrication or equipment.

Do not scale drawings – refer to figured drawings only. Any discrepancies shall immediately be referred to the Landscape Architect for clarification.

All drawings shall not be reproduced or distributed without prior permission of the Landscape Architect.

WARNING

DIAL BEFORE YOU DIG www.1100.com.au ® Services shown on this drawing are approximate only. The exact location is to be confirmed on site by contractor prior to commencement of work.

| DATE | REV | AMENDMENTS |
|---|---|---|
| 28/2/19 | A | END OF FEBRUARY PACKAGE - FOR INFORMATION |
| 29/3/19 | B | 80% DD - FOR INFORMATION |
| 24/7/19 | C | REVISED TENDER - FOR INFORMATION |
| 8/8/19 | D | REVISED TENDER - FOR INFORMATION |
| 26/9/19 | E | RESPONSE TO SUBMISSIONS - FOR INFORMATION |

NSW GOVERNMENT Planning, Industry & Environment

*Issued under the Environmental Planning and Assessment Act 1979*

Approved Application No: SSD-9835 Signed: A. Coorman

Granted on the: 6 Dec 2019 Sheet No: 14 of 83

**ADJUSTMENTS TO PUBLIC DOMAIN PROPOSALS**

—— ALL MASS PLANTING AND TREES REMOVED FROM UPPER LEVELS OF THE STADIUM

ASPECT Studios™
ASPECT Studios Pty Ltd
Level 1, 78-80 George Street
Redfern NSW 2016
Australia
T 02 9699 7182
www.aspect-studios.com
sydney@aspect-studios.com
ABN 11 120 219 561

CLIENT
we are inSW Infrastructure New South Wales

PROJECT
SYDNEY FOOTBALL STADIUM
Moore Park, New South Wales
S18030

DRAWING
SCHEDULES

| DRAWN | CHECKED | SCALE A0 \| SCALE A2 |
|---|---|---|
| TL \| DC | JH | NOT TO SCALE |

STATUS NORTH

FOR INFORMATION
NOT FOR CONSTRUCTION

DRAWING NO. LA-003 REVISION E

**QUAD A**
LA_101 MATERIALS AND FINISHES PLAN
LA_111 PAVING ARRANGEMENT PLAN
LA_201 GRADING AND LEVELS PLAN
LA_301 SETOUT PLAN
LA_401 PLANTING PLAN

**QUAD B**
LA_102 MATERIALS AND FINISHES PLAN
LA_112 PAVING ARRANGEMENT PLAN
LA_202 GRADING AND LEVELS PLAN
LA_302 SETOUT PLAN
LA_402 PLANTING PLAN

501

**NORTH EAST DETAIL PLAN**
LA_501 MATERIALS AND FINISHES PLAN
LA_502 GRADING AND LEVELS PLAN
LA_503 SETOUT PLAN
LA_504 PLANTING PLAN

JOINS SHEET 103
JOINS SHEET 101
JOINS SHEET 104
JOINS SHEET 102

**QUAD C**
LA_103 MATERIALS AND FINISHES PLAN
LA_113 PAVING ARRANGEMENT PLAN
LA_203 GRADING AND LEVELS PLAN
LA_303 SETOUT PLAN
LA_403 PLANTING PLAN

505

**MOORE PARK TERRACE**
LA_505 DETAILS PLAN

**QUAD D**
LA_104 MATERIALS AND FINISHES PLAN
LA_114 PAVING ARRANGEMENT PLAN
LA_204 GRADING AND LEVELS PLAN
LA_304 SETOUT PLAN
LA_404 PLANTING PLAN

JOINS SHEET 102
JOINS SHEET 104
JOINS SHEET 101
JOINS SHEET 103

**NOTES**

These drawings are shown in colour and shall be read in digital format or print colour hardcopy.

These drawings shall be read in conjunction with all relevant information (not limited to legends, schedules, specifications)

These drawings shall be read in conjunction with any Engineers, Architects or other consultant information. (not limited to drawings, legends, schedules, specifications)

Check all dimensions and site conditions prior to commencement of any work and the procurement of any services, materials, fittings, fabrication or equipment.

Do not scale drawings – refer to figured drawings only. Any discrepancies shall immediately be referred to the Landscape Architect for clarification.

All drawings shall not be reproduced or distributed without prior permission of the Landscape Architect.

WARNING

DIAL BEFORE YOU DIG www.1100.com.au

Services shown on this drawing are approximate only. The exact location is to be confirmed on site by contractor prior to commencement of work.

| DATE | REV | AMENDMENTS |
|---|---|---|
| 1/2/19 | A | END OF JANUARY PACKAGE - ISSUED FOR INFORMATION |
| 25/2/19 | B | END OF FEBRUARY PACKAGE - FOR INFORMATION |
| 29/3/19 | C | 60% DD - FOR INFORMATION |
| 24/7/19 | D | REVISED TENDER - FOR INFORMATION |
| 8/8/19 | E | REVISED TENDER - FOR INFORMATION |

NSW GOVERNMENT Planning, Industry & Environment

*Issued under the Environmental Planning and Assessment Act 1979*

Approved Application No: SSD-9835 Signed:

Granted on the: 6 Dec 2019 Sheet No: 15 of 83

**ASPECT Studios™**
ASPECT Studios Pty Ltd
Level 1, 79-80 George Street
Redfern NSW 2016
Australia
T 02 9699 7182
www.aspect-studios.com
sydney@aspect-studios.com
ABN 11 120 219 561

CLIENT
we are infrastructure New South Wales

PROJECT
SYDNEY FOOTBALL STADIUM
Moore Park, New South Wales
S18030

DRAWING
SHEET LAYOUT
Ground Level

| DRAWN | CHECKED | SCALE A0 \| SCALE A2 |
|---|---|---|
| TL | JH | 1:500 1:1000 |

0 10 20 40M

STATUS
FOR INFORMATION
NOT FOR CONSTRUCTION

NORTH

DRAWING NO. LA-010 REVISION E

05_PRODUCTION\02_Phase 02 (SSDA)\01_CAD\18030_LA_000 [Legends & Context Plan].vwx

MOORE PARK ROAD

OATLEY ROAD

RUGBY AUSTRALIA BUILDING

MOORE PARK ROAD

DRIVER AVENUE

KIPPAX LAKE

CRICKET NSW

SYDNEY CRICKET GROUND

FOX STUDIOS

TREE A

TN 142 TN 145 TN 146 TN 149 TN 154 TN 156 TN 306 TN 305 TN 304 TN 143 TN 155 TN 147 TN 148 TN 303 TN 151 TN 241 TN 125 TN 245 GROUP TN 124 TN 249 TN 250 TN 251 TN 252 TN 301 TN 302 TN 308 GROUP TN 307 TN 248 GROUP TN 240 GROUP TN 239 TN 232 TN 233 TN 234 TN 235 TN 236 TN 237 TN 238 TN 180 TN 181 TN 195 TN 196 TN 187 TN 188 TN 186 TN 185 TN 190 TN 165 TN 189 TN 193 TN 194 TN 192 TN 191 TN 241 GROUP TN 242 TN 255 TN 256 TN 257 TN 258-260 TN 226 TN 227 TN 228 TN 229 TN 230 TN 223 TN 221 TN 222 TN 220 TN 224 TN 225

NOTES

These drawings are shown in colour and shall be read in digital format or print colour hardcopy.

These drawings shall be read in conjunction with all relevant information (not limited to legends, schedules, specifications)

These drawings shall be read in conjunction with any Engineers, Architects or other consultant information. (not limited to drawings, legends, schedules, specifications)

Check all dimensions and site conditions prior to commencement of any work and the procurement of any services, materials, fittings, fabrication or equipment.

Do not scale drawings – refer to figured drawings only. Any discrepancies shall immediately be referred to the Landscape Architect for clarification.

All drawings shall not be reproduced or distributed without prior permission of the Landscape Architect.

WARNING

DIAL BEFORE YOU DIG www.1100.com.au

Services shown on this drawing are approximate only. The exact location is to be confirmed on site by contractor prior to commencement of work.

| DATE | REV | AMENDMENTS |
|---|---|---|
| 28/2/19 | A | END OF FEBRUARY PACKAGE - FOR INFORMATION |
| 29/3/19 | B | 80% DD - FOR INFORMATION |
| 10/5/19 | C | FOR INFORMATION - STAGE 2 PLANNING |
| 24/7/19 | D | REVISED TENDER - FOR INFORMATION |
| 8/8/19 | E | REVISED TENDER - FOR INFORMATION |
| 19/8/19 | F | RESPONSE TO SUBMISSIONS - FOR INFORMATION |

LEGEND

- STAGE 2 PLANNING BOUNDARY
- TN XXX — TREE NUMBER — REFER TO ARBORIST REPORT FOR FURTHER INFORMATION
- EXISTING TREE — RETAIN AND PROTECT
- TREE PROTECTION ZONE (TPZ) — ALL WORKS TO BE HAND EXCAVATION AND HYDROVAC ONLY
- STRUCTURAL ROOT ZONE (SRZ) — ALL WORKS TO BE HAND EXCAVATION AND HYDROVAC ONLY
- EXISTING TREE — SEEKING REMOVAL STAGE 2 DA
- EXISTING TREE — APPROVED FOR REMOVAL STAGE 1 DA

NOTES:
PROJECT ARBORIST TO REVIEW DESIGN AND CONFIRM EXTEND OF TREE REMOVAL

ADJUSTMENTS TO PUBLIC DOMAIN PROPOSALS

1. 2NO ADDITIONAL TREES TO BE REMOVED

NSW GOVERNMENT Planning, Industry & Environment

*Issued under the Environmental Planning and Assessment Act 1979*

Approved Application No: SSD-9835 Signed:

Granted on the: 6 Dec 2019 Sheet No: 16 of 83

ASPECT Studios™
ASPECT Studios Pty Ltd
Level 1, 78-80 George Street
Redfern NSW 2016
Australia
T 02 9699 7182
www.aspect-studios.com
sydney@aspect-studios.com
ABN 11 120 219 561

CLIENT
we are iNSW Infrastructure New South Wales

PROJECT
SYDNEY FOOTBALL STADIUM
Moore Park, New South Wales
S18030

DRAWING
TREE RETENTION & REMOVAL
Ground Plan

| DRAWN | CHECKED | SCALE A0 \| SCALE A2 |
|---|---|---|
| JR \| KB | JH | 1:100 \| 1:200 |

0 2.5 5 7.5 M


STATUS
FOR INFORMATION
NOT FOR CONSTRUCTION

NORTH

DRAWING NO. LA-015

REVISION F

05_PRODUCTION\02_Phase 02 (SSDA)\01_CAD\18030_LA_000 [Legends & Context Plan].vwx

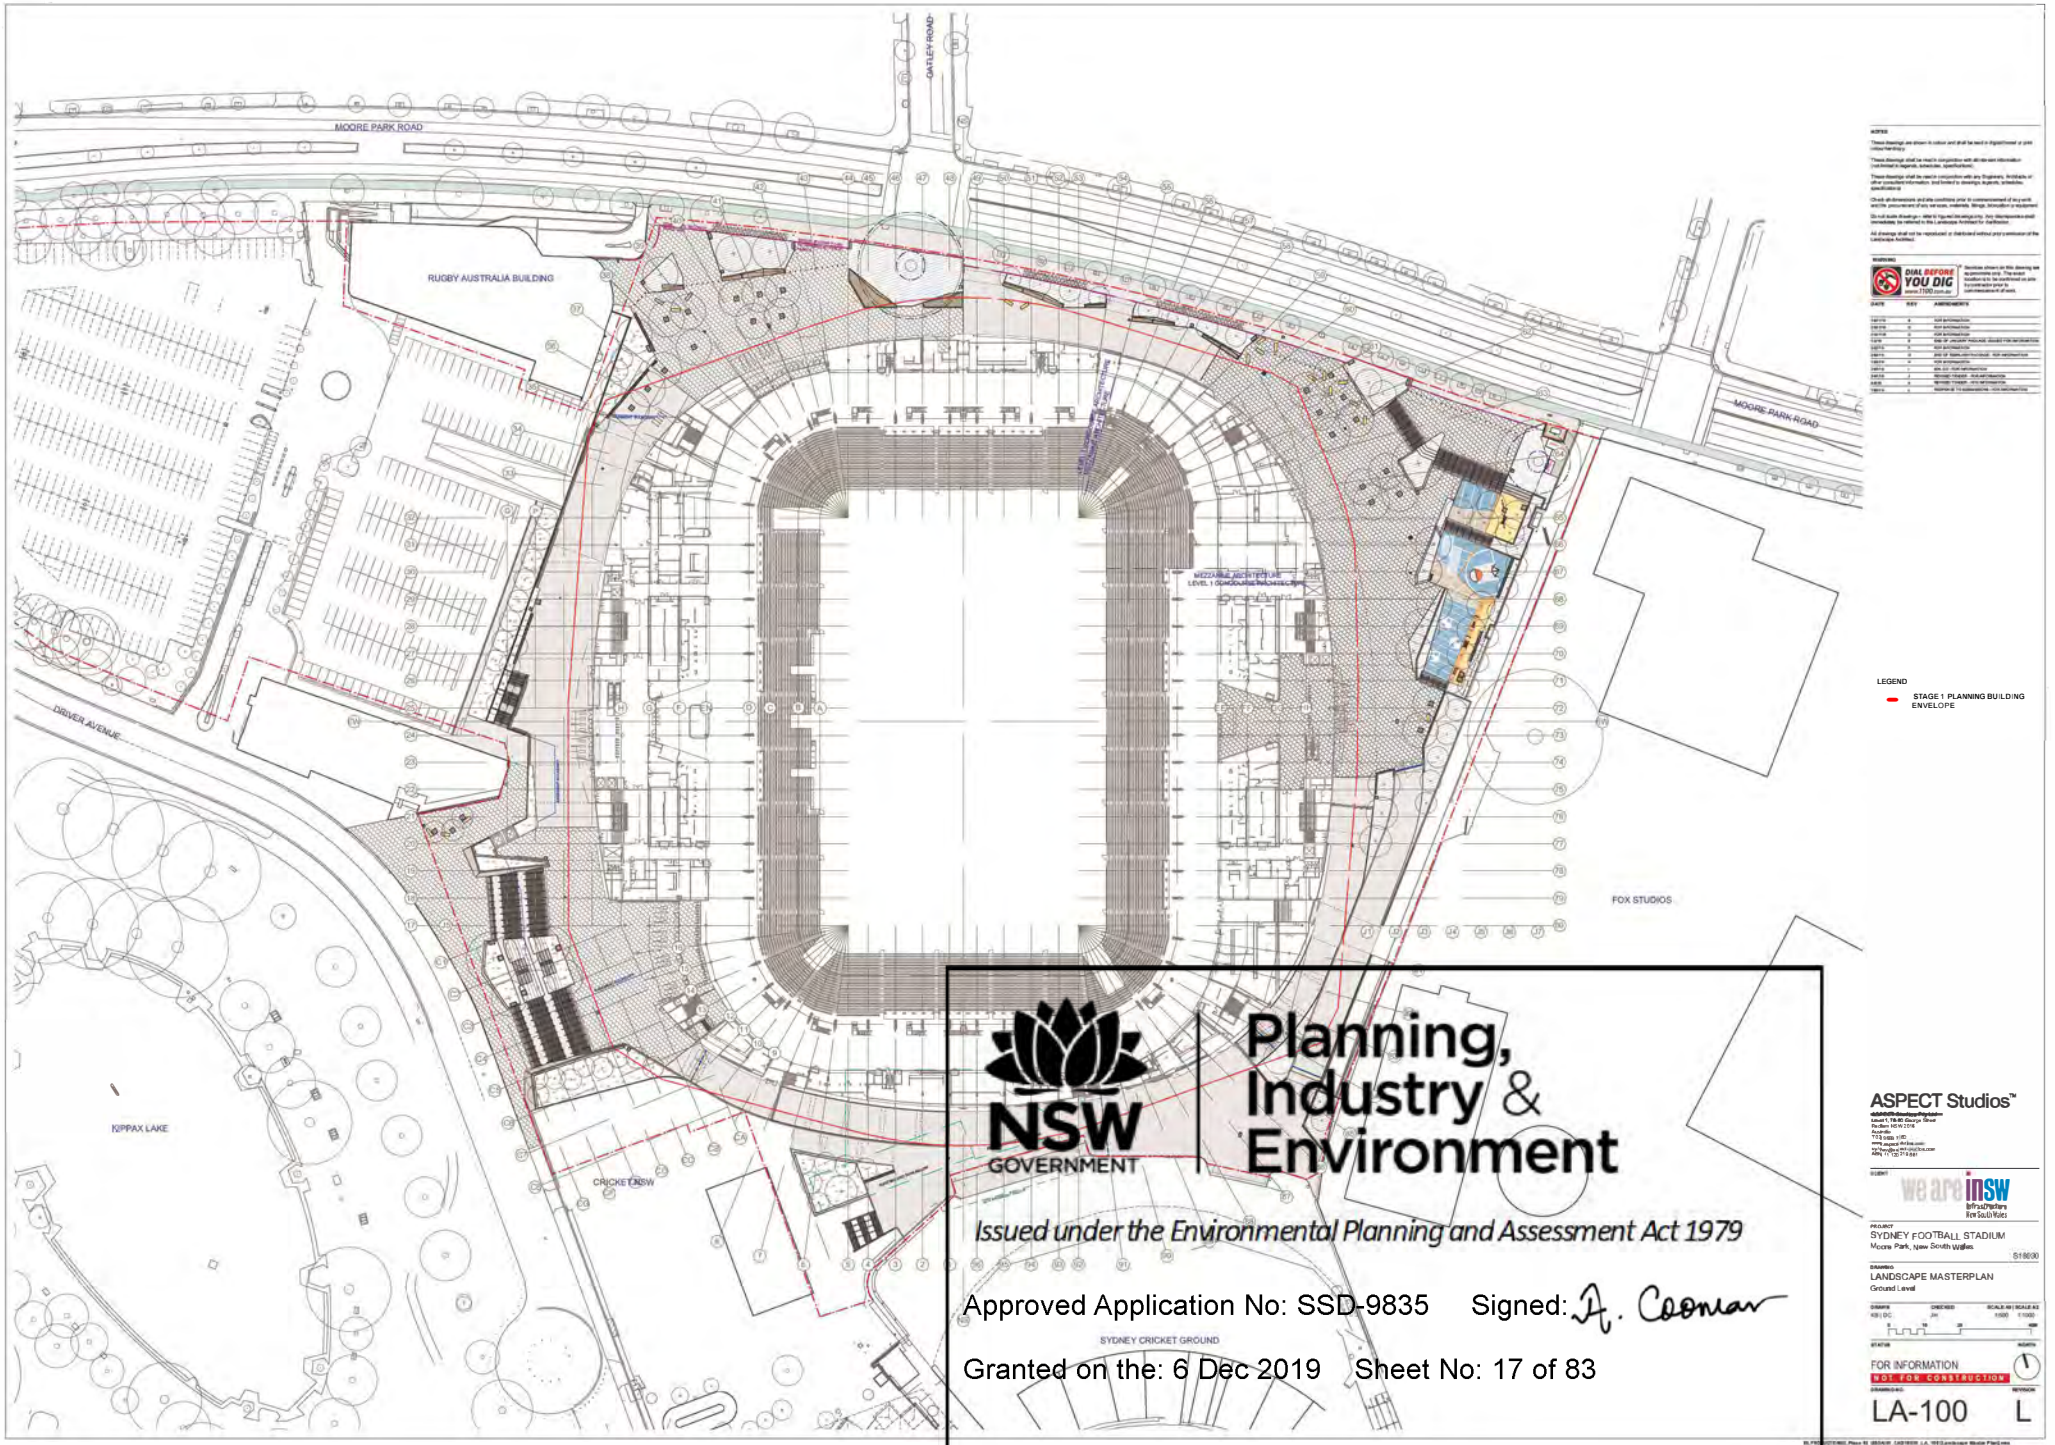


NSW GOVERNMENT
Planning, Industry & Environment

*Issued under the Environmental Planning and Assessment Act 1979*

Approved Application No: SSD-9835 Signed:

Granted on the: 6 Dec 2019 Sheet No: 17 of 83


ASPECT Studios™

PROJECT
SYDNEY FOOTBALL STADIUM
Moore Park, New South Wales

DRAWING
LANDSCAPE MASTERPLAN
Ground Level

FOR INFORMATION
NOT FOR CONSTRUCTION

LA-100 L

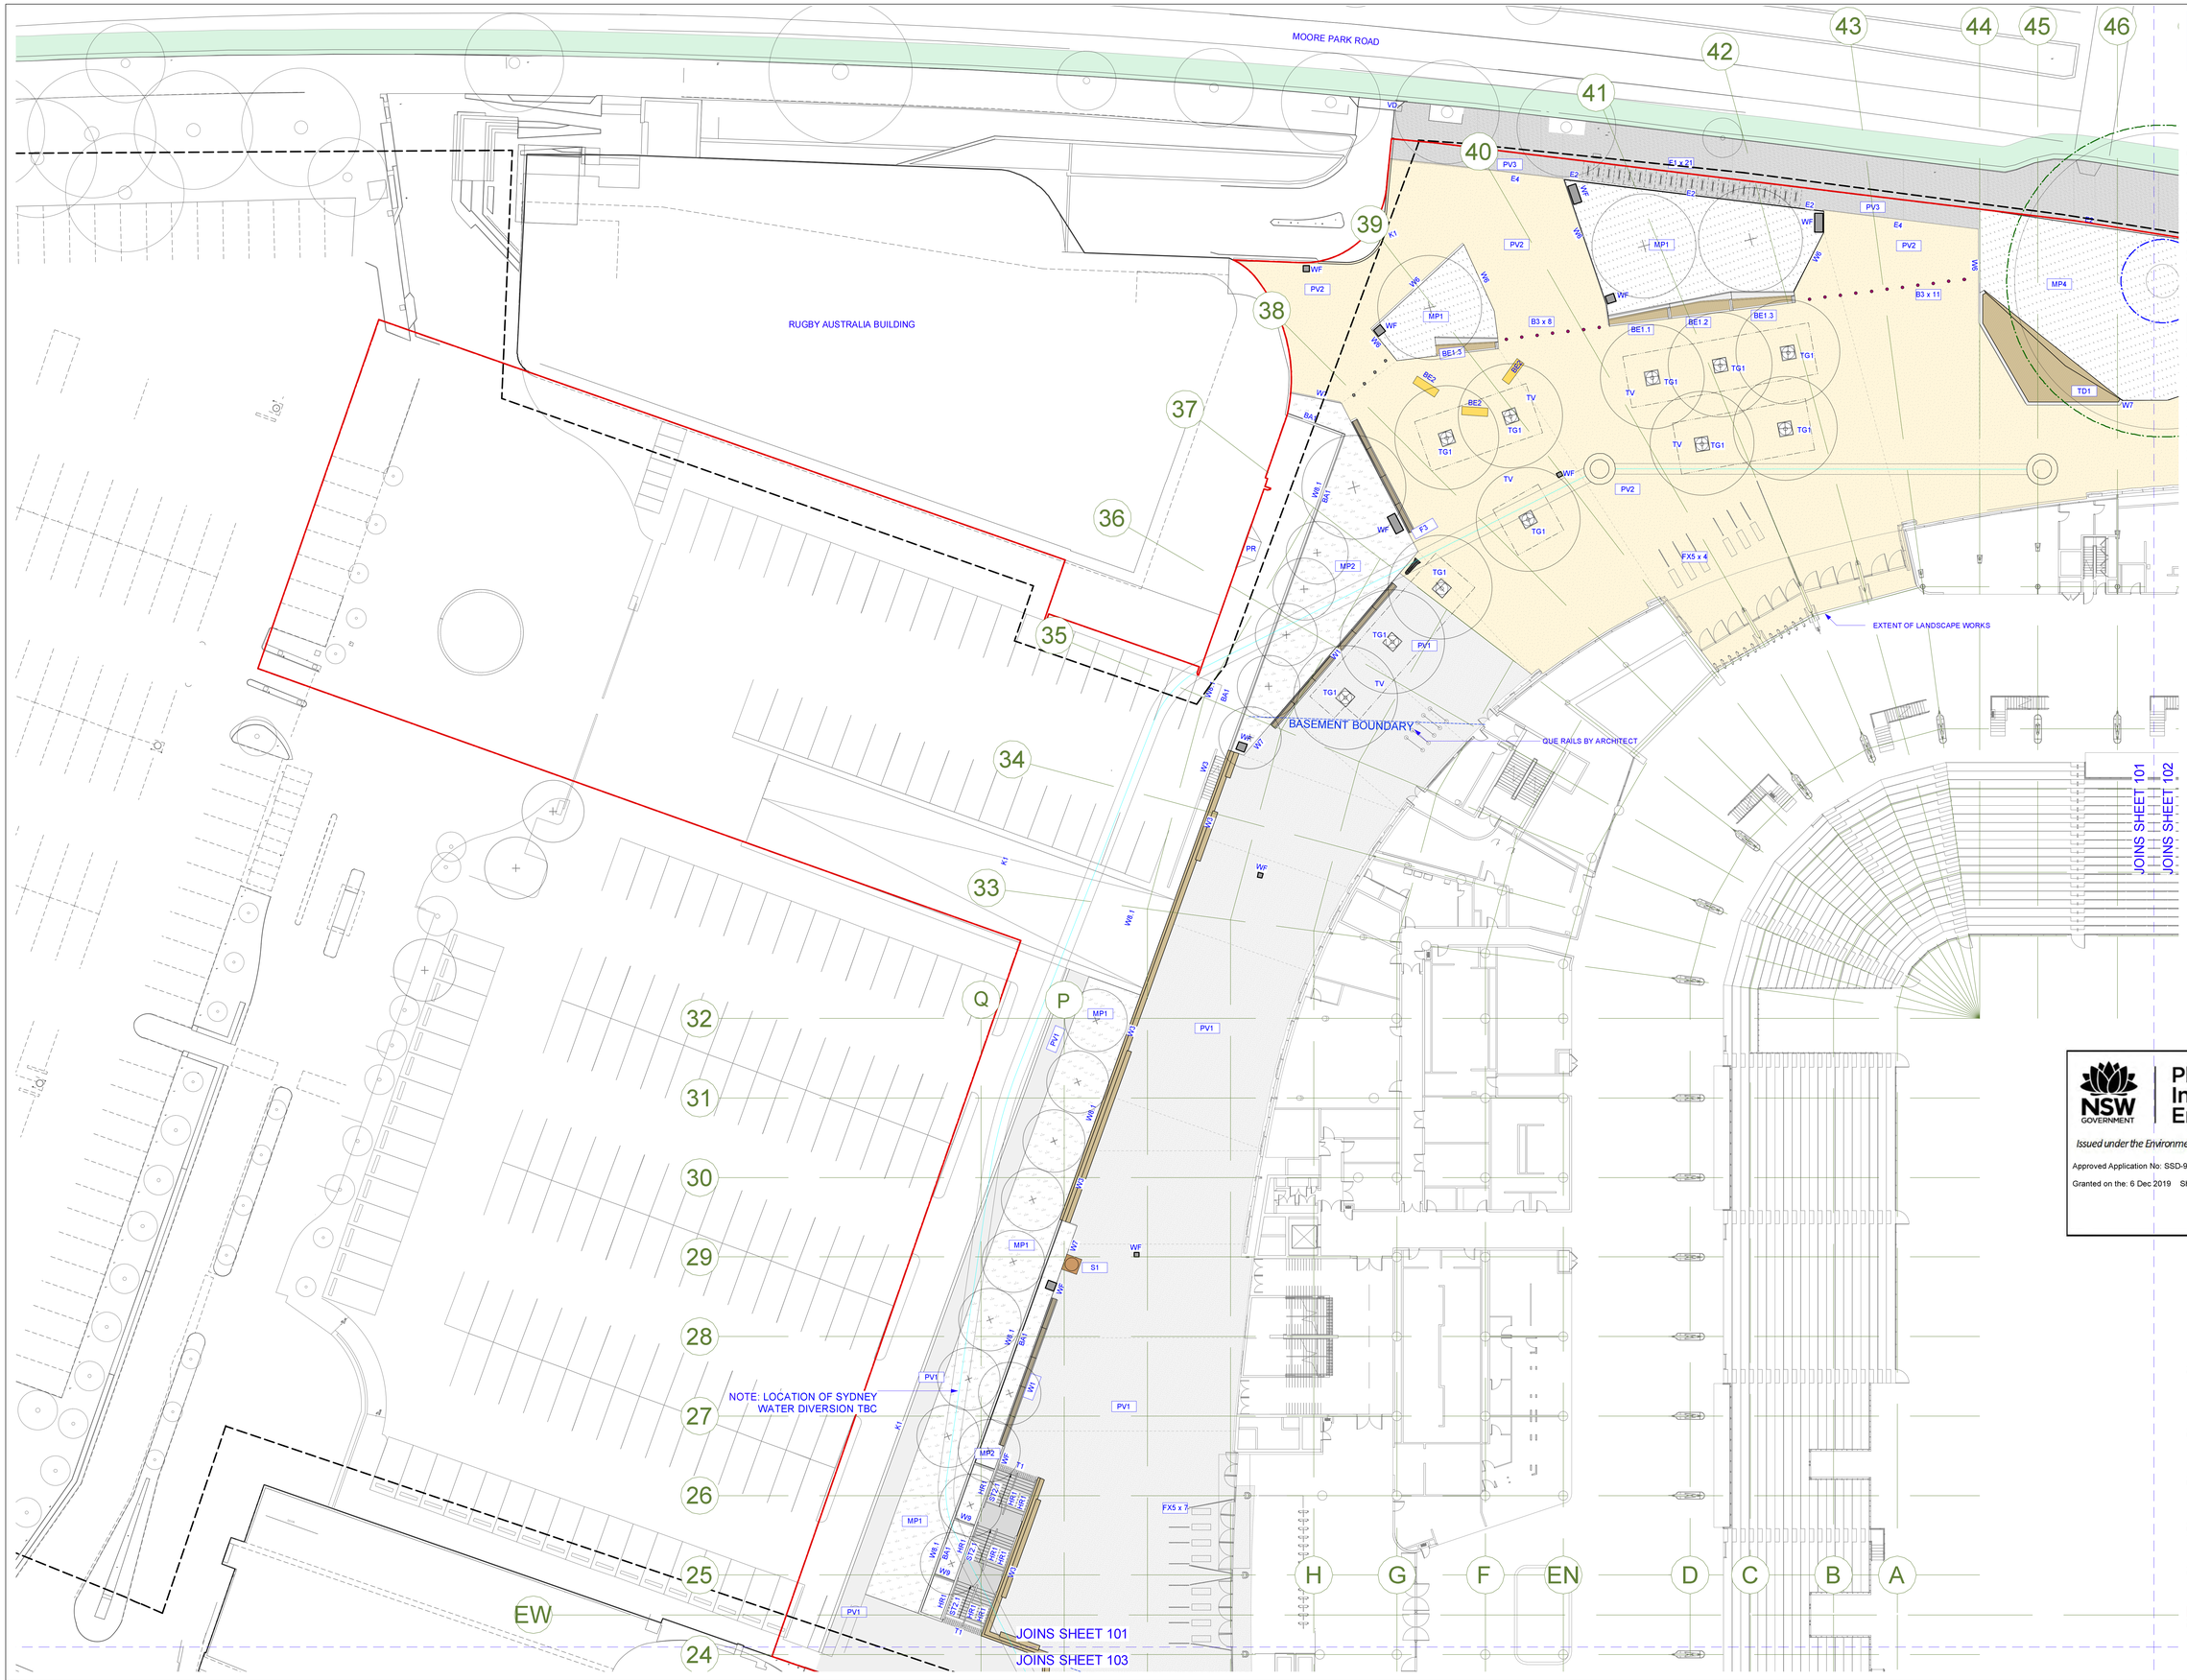


NOTE:
* CONCOURSE LIGHTING TBC
* STORMWATER TBC

**NOTES**

These drawings are shown in colour and shall be read in digital format or print colour hardcopy.

These drawings shall be read in conjunction with all relevant information (not limited to legends, schedules, specifications)

These drawings shall be read in conjunction with any Engineers, Architects or other consultant information. (not limited to drawings, legends , schedules, specifications)

Check all dimensions and site conditions prior to commencement of any work and the procurement of any services , materials, fittings, fabrication or equipment.

Do not scale drawings – refer to figured drawings only. Any discrepancies shall immediately be referred to the Landscape Architect for clarification.

All drawings shall not be reproduced or distributed without prior permission of the Landscape Architect.

**WARNING**

DIAL BEFORE YOU DIG www.1100.com.au

Services shown on this drawing are approximate only. The exact location is to be confirmed on site by contractor prior to commencement of work.

| DATE | REV | AMENDMENTS |
|---|---|---|
| 1/2/19 | A | END OF JANUARY PACKAGE -ISSUED FOR INFORMATION |
| 25/2/19 | B | END OF FEBRUARY PACKAGE - FOR INFORMATION |
| 29/3/19 | C | 60% DD - FOR INFORMATION |
| 24/7/19 | D | REVISED TENDER - FOR INFORMATION |
| 8/8/19 | E | REVISED TENDER - FOR INFORMATION |

NSW GOVERNMENT | Planning, Industry & Environment

*Issued under the Environmental Planning and Assessment Act 1979*

Approved Application No: SSD-9835 Signed:

Granted on the: 6 Dec 2019 Sheet No: 18 of 83


**ASPECT Studios™**

**ASPECT Studios Pty Ltd**
Level 1, 78-80 George Street
Redfern NSW 2016
Australia
T 02 9699 7182
www.aspect-studios.com
sydney@aspect-studios.com
ABN 11 120 219 561


CLIENT
we are insw Infrastructure New South Wales

PROJECT
SYDNEY FOOTBALL STADIUM
Moore Park, New South Wales
S18030

DRAWING
MATERIALS AND FINISHES PLAN
Ground Level - Quad A

| DRAWN | CHECKED | SCALE A0 \| SCALE A2 |
|---|---|---|
| TL \| DC | JH | 1:200 1:400 |

0 5 10 15 M

STATUS
FOR INFORMATION
NOT FOR CONSTRUCTION

NORTH

DRAWING NO. LA-101

REVISION E

NOTE:
* CONCOURSE LIGHTING TBC
* STORMWATER TBC

**NOTES**

These drawings are shown in colour and shall be read in digital format or print colour hardcopy.

These drawings shall be read in conjunction with all relevant information (not limited to legends, schedules, specifications)

These drawings shall be read in conjunction with any Engineers, Architects or other consultant information. (not limited to drawings, legends , schedules, specifications)

Check all dimensions and site conditions prior to commencement of any work and the procurement of any services , materials, fittings, fabrication or equipment.

Do not scale drawings – refer to figured drawings only. Any discrepancies shall immediately be referred to the Landscape Architect for clarification.

All drawings shall not be reproduced or distributed without prior permission of the Landscape Architect.

**WARNING**

DIAL BEFORE YOU DIG www.1100.com.au

Services shown on this drawing are approximate only. The exact location is to be confirmed on site by contractor prior to commencement of work.

| DATE | REV | AMENDMENTS |
|---|---|---|
| 1/2/19 | A | END OF JANUARY PACKAGE -ISSUED FOR INFORMATION |
| 25/2/19 | B | END OF FEBRUARY PACKAGE - FOR INFORMATION |
| 29/3/19 | C | 60% DD - FOR INFORMATION |
| 24/7/19 | D | REVISED TENDER - FOR INFORMATION |
| 8/8/19 | E | REVISED TENDER - FOR INFORMATION |

MOORE PARK ROAD

JOINS SHEET 101

JOINS SHEET 102

LEVEL 1 CONCOURSE ARCHITECTURE

MEZZANINE ARCHITECTURE

MP4 PV3 PV1.2 B1 x 6 WF WT TD2 PV2 PV1 BE2.1 BE2.2 BE2.3 MP1 B1 x 4 B1 x 25 B3 x 10 TG1 TV VD

REFER TO DETAIL PLAN LA-501

FOX STUDIOS

MEZZANINE ARCHITECTURE
LEVEL 1 CONCOURSE ARCHITECTURE

EXTENT OF LANDSCAPE WORKS

JOINS SHEET 102

JOINS SHEET 104

47 48 49 50 51 52 53 54 55 56 57 58 59 60 61 62 63 64 65 66 67 68 69 70 71 72 73

EE FF GG HH EW

Planning, Industry & Environment

*Issued under the Environmental Planning and Assessment Act 1979*

Approved Application No: SSD-9835 Signed:

Granted on the: 6 Dec 2019 Sheet No: 19 of 83


**ASPECT Studios™**

**ASPECT Studios Pty Ltd**
Level 1, 78-80 George Street
Redfern NSW 2016
Australia
T 02 9699 7182
www.aspect-studios.com
sydney@aspect-studios.com
ABN 11 120 219 561


CLIENT

we are inswInfrastructure New South Wales

PROJECT

SYDNEY FOOTBALL STADIUM

Moore Park, New South Wales

S18030

DRAWING

MATERIALS AND FINISHES PLAN

Ground Level - Quad B

| DRAWN | CHECKED | SCALE A0 \| SCALE A2 |
|---|---|---|
| TL \| DC | JH | 1:200 \| 1:400 |

0 5 10 15 M


STATUS

FOR INFORMATION

NOT FOR CONSTRUCTION

NORTH

DRAWING NO. LA-102 REVISION E

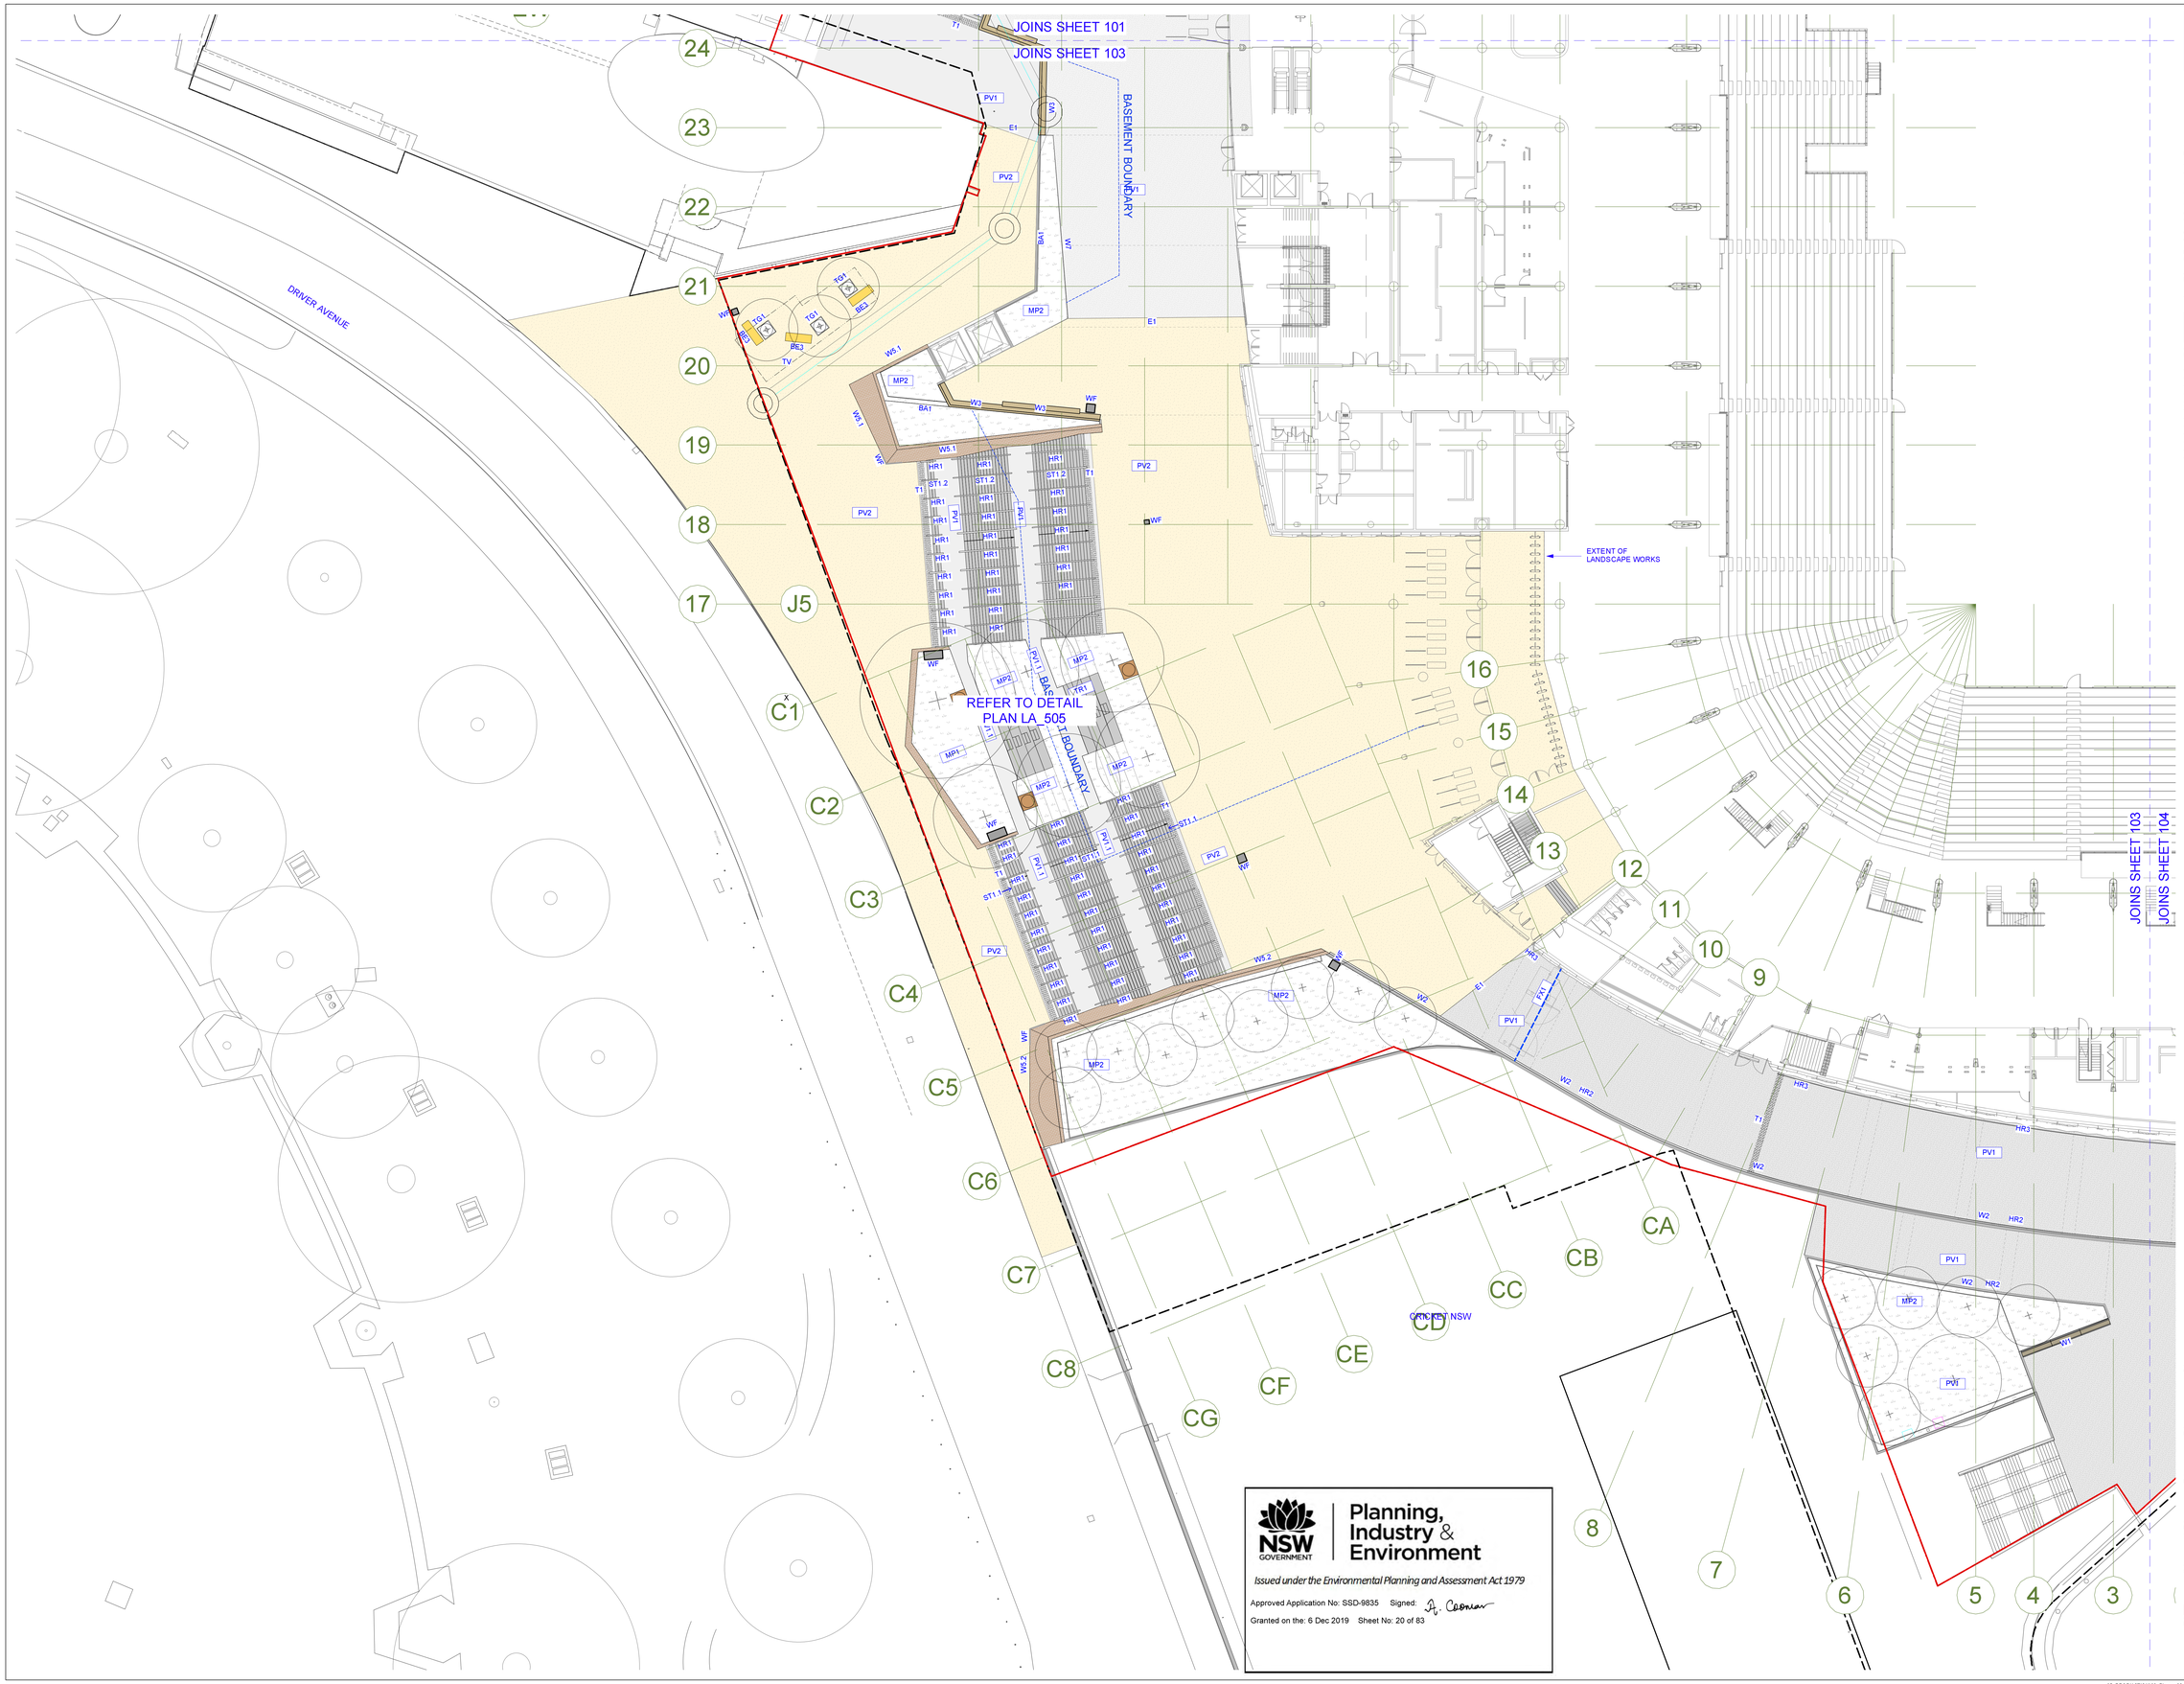


NOTE:
- CONCOURSE LIGHTING TBC
- STORMWATER TBC

**NOTES**

These drawings are shown in colour and shall be read in digital format or print colour hardcopy.

These drawings shall be read in conjunction with all relevant information (not limited to legends, schedules, specifications)

These drawings shall be read in conjunction with any Engineers, Architects or other consultant information. (not limited to drawings, legends , schedules, specifications)

Check all dimensions and site conditions prior to commencement of any work and the procurement of any services , materials, fittings, fabrication or equipment.

Do not scale drawings – refer to figured drawings only. Any discrepancies shall immediately be referred to the Landscape Architect for clarification.

All drawings shall not be reproduced or distributed without prior permission of the Landscape Architect.

WARNING

DIAL BEFORE YOU DIG www.1100.com.au

Services shown on this drawing are approximate only. The exact location is to be confirmed on site by contractor prior to commencement of work.

| DATE | REV | AMENDMENTS |
|---|---|---|
| 1/2/19 | A | END OF JANUARY PACKAGE -ISSUED FOR INFORMATION |
| 25/2/19 | B | END OF FEBRUARY PACKAGE - FOR INFORMATION |
| 29/3/19 | C | 83% DD - FOR INFORMATION |
| 24/7/19 | D | REVISED TENDER - FOR INFORMATION |
| 8/8/19 | E | REVISED TENDER - FOR INFORMATION |

NSW GOVERNMENT Planning, Industry & Environment

*Issued under the Environmental Planning and Assessment Act 1979*

Approved Application No: SSD-9835 Signed:

Granted on the: 6 Dec 2019 Sheet No: 20 of 83

ASPECT Studios™
ASPECT Studios Pty Ltd
Level 1, 78-80 George Street
Redfern NSW 2016
Australia
T 02 9699 7182
www.aspect-studios.com
sydney@aspect-studios.com
ABN 11 120 219 561

CLIENT

we are insw Infrastructure New South Wales

PROJECT

SYDNEY FOOTBALL STADIUM
Moore Park, New South Wales

S18030

DRAWING

MATERIALS AND FINISHES PLAN
Ground Level - Quad C

| DRAWN | CHECKED | SCALE A0 \| SCALE A2 |
|---|---|---|
| TL \| DC | JH | 1:200 \| 1:400 |

0 5 10 15 M

STATUS

FOR INFORMATION
NOT FOR CONSTRUCTION

NORTH

DRAWING NO. LA-103

REVISION E

JOINS SHEET 102

JOINS SHEET 104

EXTENT OF LANDSCAPE WORKS

JOINS SHEET 103

JOINS SHEET 104

SCG BASEMENT BELOW

SCG BASEMENT BELOW

SYDNEY CRICKET GROUND

FOX STUDIOS

PV1 PV2 MP2 T1 E1 WF W4 W5 W6 1 W6 2 HR2 HR3 FX1 FX2

J1 J2 J3 J4 J5 J6 J7

1 2 73 74 75 76 77 78 79 80 81 82 83 84 85 86 87 88 89 90 91 92 93 94 95 96

NOTE:
* CONCOURSE LIGHTING TBC
* STORMWATER TBC

**NOTES**

These drawings are shown in colour and shall be read in digital format or print colour hardcopy.

These drawings shall be read in conjunction with all relevant information (not limited to legends, schedules, specifications)

These drawings shall be read in conjunction with any Engineers, Architects or other consultant information. (not limited to drawings, legends , schedules, specifications)

Check all dimensions and site conditions prior to commencement of any work and the procurement of any services , materials, fittings, fabrication or equipment.

Do not scale drawings – refer to figured drawings only. Any discrepancies shall immediately be referred to the Landscape Architect for clarification.

All drawings shall not be reproduced or distributed without prior permission of the Landscape Architect.

**WARNING**

DIAL BEFORE YOU DIG www.1100.com.au

Services shown on this drawing are approximate only. The exact location is to be confirmed on site by contractor prior to commencement of work.

| DATE | REV | AMENDMENTS |
|---|---|---|
| 1/2/19 | A | END OF JANUARY PACKAGE -ISSUED FOR INFORMATION |
| 25/2/19 | B | END OF FEBRUARY PACKAGE - FOR INFORMATION |
| 29/3/19 | C | 60% DD - FOR INFORMATION |
| 24/7/19 | D | REVISED TENDER - FOR INFORMATION |
| 8/8/19 | E | REVISED TENDER - FOR INFORMATION |

NSW GOVERNMENT | Planning, Industry & Environment

*Issued under the Environmental Planning and Assessment Act 1979*

Approved Application No: SSD-9835 Signed:

Granted on the: 6 Dec 2019 Sheet No: 21 of 83

**ASPECT Studios™**
ASPECT Studios Pty Ltd
Level 1, 78-80 George Street
Redfern NSW 2016
Australia
T 02 9699 7182
www.aspect-studios.com
sydney@aspect-studios.com
ABN 11 120 219 561

CLIENT

we are iNSW Infrastructure New South Wales

PROJECT

SYDNEY FOOTBALL STADIUM

Moore Park, New South Wales

S18030

DRAWING

MATERIALS AND FINISHES PLAN

Ground Level - Quad D

| DRAWN | CHECKED | SCALE A0 \| SCALE A2 |
|---|---|---|
| TL \| DC | JH | 1:200 \| 1:400 |

0 5 10 15 M

STATUS

FOR INFORMATION

NOT FOR CONSTRUCTION

NORTH

DRAWING NO. LA-104

REVISION E

05_PRODUCTION\02_Phase 02 (SSDA)\01_CAD\S8030_LA_101 [Ground - Materials + Finishes].vwx

MOORE PARK ROAD

RUGBY AUSTRALIA BUILDING

BASEMENT BOUNDARY

JOINS SHEET 111

JOINS SHEET 113

JOINS SHEET 111

JOINS SHEET 112

**NOTES**

These drawings are shown in colour and shall be read in digital format or print colour hardcopy.

These drawings shall be read in conjunction with all relevant information (not limited to legends, schedules, specifications).

These drawings shall be read in conjunction with any Engineers, Architects or other consultant information. (not limited to drawings, legends , schedules, specifications)

Check all dimensions and site conditions prior to commencement of any work and the procurement of any services , materials, fittings, fabrication or equipment.

Do not scale drawings – refer to figured drawings only. Any discrepancies shall immediately be referred to the Landscape Architect for clarification.

All drawings shall not be reproduced or distributed without prior permission of the Landscape Architect.

**WARNING**

DIAL BEFORE YOU DIG www.1100.com.au

Services shown on this drawing are approximate only. The exact location is to be confirmed on site by contractor prior to commencement of work.

| DATE | REV | AMENDMENTS |
|---|---|---|
| 29/3/19 | A | 60% DD - FOR INFORMATION |
| 24/7/19 | B | REVISED TENDER - FOR INFORMATION |
| 8/8/19 | C | REVISED TENDER - FOR INFORMATION |

NSW GOVERNMENT | Planning, Industry & Environment

*Issued under the Environmental Planning and Assessment Act 1979*

Approved Application No: SSD-9835 Signed:

Granted on the: 6 Dec 2019 Sheet No: 22 of 83

**ASPECT Studios™**

**ASPECT Studios Pty Ltd**
Level 1, 79-80 George Street
Redfern NSW 2016
Australia
T 02 9699 7182
www.aspect-studios.com
sydney@aspect-studios.com
ABN 11 120 219 561

CLIENT

we are inSW Infrastructure New South Wales

PROJECT

SYDNEY FOOTBALL STADIUM
Moore Park, New South Wales

S18030

DRAWING

PAVING ARRANGEMENT PLAN
Ground Level - Quad A

| DRAWN | CHECKED | SCALE A0 \| SCALE A2 |
|---|---|---|
| DC | JH | 1:200 1:400 |

0 5 10 15 M

STATUS: FOR INFORMATION
NOT FOR CONSTRUCTION

NORTH

DRAWING NO. LA-111

REVISION C

05_PRODUCTION\02_Phase 02 (SSDA)\01_CAD\18030_LA_110 [Ground - Paving Plans].vwx

47 48 49 50 51 52 53 54 55 56 57 58 59 60 61 62 63 64 65 66 67 68 69 70 71 72 73

MOORE PARK ROAD

PV5 PV5 PV5

E1 E2 E3 E4

LEVEL 1 CONCOURSE ARCHITECTURE
MEZZANINE ARCHITECTURE

JOINS SHEET 111
JOINS SHEET 112

MEZZANINE ARCHITECTURE
LEVEL 1 CONCOURSE ARCHITECTURE

EE FF GG HH EW

JOINS SHEET 112
JOINS SHEET 114

**NOTES**

These drawings are shown in colour and shall be read in digital format or print colour hardcopy.

These drawings shall be read in conjunction with all relevant information (not limited to legends, schedules, specifications)

These drawings shall be read in conjunction with any Engineers, Architects or other consultant information. (not limited to drawings, legends, schedules, specifications)

Check all dimensions and site conditions prior to commencement of any work and the procurement of any services, materials, fittings, fabrication or equipment.

Do not scale drawings – refer to figured drawings only. Any discrepancies shall immediately be referred to the Landscape Architect for clarification.

All drawings shall not be reproduced or distributed without prior permission of the Landscape Architect.

**WARNING**

DIAL BEFORE YOU DIG www.1100.com.au

Services shown on this drawing are approximate only. The exact location is to be confirmed on site by contractor prior to commencement of work.

| DATE | REV | AMENDMENTS |
|---|---|---|
| 29/3/19 | A | 60% DD - FOR INFORMATION |
| 24/5/19 | B | REVISED TENDER - FOR INFORMATION |
| 8/8/19 | C | REVISED TENDER - FOR INFORMATION |

NSW GOVERNMENT Planning, Industry & Environment

*Issued under the Environmental Planning and Assessment Act 1979*

Approved Application No: SSD-9835 Signed:

Granted on the: 6 Dec 2019 Sheet No: 23 of 83


ASPECT Studios™
**ASPECT Studios Pty Ltd**
Level 1, 78-80 George Street
Redfern NSW 2016
Australia
T 02 9699 7182
www.aspect-studios.com
sydney@aspect-studios.com
ABN 11 120 219 561


CLIENT
we are inSW Infrastructure New South Wales

PROJECT
SYDNEY FOOTBALL STADIUM
Moore Park, New South Wales
S18030

DRAWING
PAVING ARRANGEMENT PLAN
Ground Level - Quad B

| DRAWN | CHECKED | SCALE A0 \| SCALE A2 |
|---|---|---|
| DC | JH | 1:200 1:400 |

0 5 10 15 M

STATUS
FOR INFORMATION
NOT FOR CONSTRUCTION

NORTH

DRAWING NO. LA-112 REVISION C

JOINS SHEET 111

JOINS SHEET 113

JOINS SHEET 113

JOINS SHEET 114

DRIVER AVENUE

BASEMENT BOUNDARY

BASEMENT BOUNDARY

24 23 22 21 20 19 18 17 16 15 14 13 12 11 10 9 8 7 6 5 4 3

J5

C1 C2 C3 C4 C5 C6 C7 C8

CA CB CC CD CE CF CG

EJ E4 P45

**NOTES**

These drawings are shown in colour and shall be read in digital format or print colour hardcopy.

These drawings shall be read in conjunction with all relevant information (not limited to legends, schedules, specifications)

These drawings shall be read in conjunction with any Engineers, Architects or other consultant information. (not limited to drawings, legends , schedules, specifications)

Check all dimensions and site conditions prior to commencement of any work and the procurement of any services , materials, fittings, fabrication or equipment.

Do not scale drawings – refer to figured drawings only. Any discrepancies shall immediately be referred to the Landscape Architect for clarification.

All drawings shall not be reproduced or distributed without prior permission of the Landscape Architect.

**WARNING**

DIAL BEFORE YOU DIG www.1100.com.au

Services shown on this drawing are approximate only. The exact location is to be confirmed on site by contractor prior to commencement of work.

| DATE | REV | AMENDMENTS |
|---|---|---|
| 29/3/19 | A | 60% DC - FOR INFORMATION |
| 24/7/19 | B | REVISED TENDER - FOR INFORMATION |
| 8/8/19 | C | REVISED TENDER - FOR INFORMATION |

NSW GOVERNMENT | Planning, Industry & Environment

*Issued under the Environmental Planning and Assessment Act 1979*

Approved Application No: SSD-9835 Signed:

Granted on the: 6 Dec 2019 Sheet No: 24 of 83


**ASPECT Studios™**

**ASPECT Studios Pty Ltd**
Level 1, 78-80 George Street
Redfern NSW 2016
Australia
T 02 9699 7182
www.aspect-studios.com
sydney@aspect-studios.com
ABN 11 120 219 561


CLIENT

we are insw Infrastructure New South Wales

PROJECT

SYDNEY FOOTBALL STADIUM
Moore Park, New South Wales

S18030

DRAWING

PAVING ARRANGEMENT PLAN
Ground Level - Quad C

| DRAWN | CHECKED | SCALE A0 | SCALE A2 |
|---|---|---|---|
| DC | JH | 1:200 | 1:400 |

0 5 10 15 M

STATUS

FOR INFORMATION
NOT FOR CONSTRUCTION

NORTH

DRAWING NO. LA-113

REVISION C

JOINS SHEET 112

JOINS SHEET 114

JOINS SHEET 113

JOINS SHEET 114

SCG BASEMENT BELOW

SCG BASEMENT BELOW

J1 J2 J3 J4 J5 J6 J7

73 74 75 76 77 78 79 80 81 82 83 84 85 86 87 88 89 90 91 92 93 94 95 96 1 2

**NOTES**

These drawings are shown in colour and shall be read in digital format or print colour hardcopy.

These drawings shall be read in conjunction with all relevant information (not limited to legends, schedules, specifications)

These drawings shall be read in conjunction with any Engineers, Architects or other consultant information. (not limited to drawings, legends , schedules, specifications)

Check all dimensions and site conditions prior to commencement of any work and the procurement of any services , materials, fittings, fabrication or equipment.

Do not scale drawings – refer to figured drawings only. Any discrepancies shall immediately be referred to the Landscape Architect for clarification.

All drawings shall not be reproduced or distributed without prior permission of the Landscape Architect.

**WARNING**

DIAL BEFORE YOU DIG www.1100.com.au

Services shown on this drawing are approximate only. The exact location is to be confirmed on site by contractor prior to commencement of work.

| DATE | REV | AMENDMENTS |
|---|---|---|
| 29/3/19 | A | 60% DD - FOR INFORMATION |
| 24/5/19 | B | REVISED TENDER - FOR INFORMATION |
| 8/8/19 | C | REVISED TENDER - FOR INFORMATION |

NSW GOVERNMENT Planning, Industry & Environment

*Issued under the Environmental Planning and Assessment Act 1979*

Approved Application No: SSD-9835 Signed:

Granted on the: 6 Dec 2019 Sheet No: 25 of 83

**ASPECT Studios™**

ASPECT Studios Pty Ltd
Level 1, 78-80 George Street
Redfern NSW 2016
Australia
T 02 9699 7182
www.aspect-studios.com
sydney@aspect-studios.com
ABN 11 120 219 561

CLIENT

we are inSW Infrastructure New South Wales

PROJECT

SYDNEY FOOTBALL STADIUM
Moore Park, New South Wales

S18030

DRAWING

PAVING ARRANGEMENT PLAN
Ground Level - Quad D

| DRAWN | CHECKED | SCALE A0 \| SCALE A2 |
|---|---|---|
| DC | JH | 1:200 \| 1:400 |

0 5 10 15 M

STATUS

FOR INFORMATION
NOT FOR CONSTRUCTION

NORTH

DRAWING NO. REVISION

LA-114 C

05_PRODUCTION\02_Phase 02 (SSDA)\01_CAD\S18030_LA_110 [Ground - Paving Plans].vwx

RUGBY AUSTRALIA BUILDING

MOORE PARK ROAD

BASEMENT BOUNDARY

NOTE: LOCATION OF SYDNEY WATER DIVERSION TBC

NOTE: CONCOURSE GRADING TO CONTINUE INTO STADIUM

NOTE: GRADING AND LEVELS PLANS ARE SUBJECT TO REVIEW BY ACCESS / BCA CONSULTANT

JOINS SHEET 201

JOINS SHEET 202

JOINS SHEET 203

JOINS SHEET 201

EX 45.600 RL 45.600 EX 45.950 RL 45.800 RL 45.950 EX 46.012 RL 46.012 RL 46.300 TB 47.135 1:40

EX 45.990 EX 45.900 RL 45.960 TB 46.200 RL 45.710 1:43.5 RL 45.720 1:27.5 EX 45.900

TB 46.600 1:40 RL 46.310 TB 46.760 1:40 1:56 RL 46.294 1:50 RL 46.650 RL 46.278 47.5 RL 46.270 RL 46.650 RL 46.254 1:45.5 RL 46.650 RL 46.238 1:41.5 RL 46.650 RL 46.222 1:40.5 RL 46.650 RL 46.206 RL 46.198 1:43.5 RL 46.650 RL 46.182 1:43 RL 46.650 RL 46.166 1:42 RL 46.650 RL 46.150 1:43.5 RL 46.650 RL 46.650 RL 46.650

RL 46.340 RL 46.350 RL 46.330 RL 46.275 1:40 RL 46.650 RL 46.650 RL 46.650

TOS 46.150 RL 46.150 BOS 44.500 TOS 44.475 TW 47.600 BOS 42.825 TOS 42.800 TB 46.475 BOS 41.150 1:90 EX 41.008

| DATE | REV | AMENDMENTS |
|---|---|---|
| 1/2/19 | A | END OF JANUARY PACKAGE - ISSUED FOR INFORMATION |
| 25/2/19 | B | END OF FEBRUARY PACKAGE - FOR INFORMATION |
| 28/5/19 | C | 85% DD - FOR INFORMATION |
| 24/7/19 | D | REVISED TENDER - FOR INFORMATION |
| 8/8/19 | E | REVISED TENDER - FOR INFORMATION |
| 20/9/19 | F | RESPONSE TO SUBMISSIONS - FOR INFORMATION |

NOTES

These drawings are shown in colour and shall be read in digital format or print colour hardcopy.

These drawings shall be read in conjunction with all relevant information (not limited to legends, schedules, specifications)

These drawings shall be read in conjunction with any Engineers, Architects or other consultant information. (not limited to drawings, legends, schedules, specifications)

Check all dimensions and site conditions prior to commencement of any work and the procurement of any services, materials, fittings, fabrication or equipment.

Do not scale drawings – refer to figured drawings only. Any discrepancies shall immediately be referred to the Landscape Architect for clarification.

All drawings shall not be reproduced or distributed without prior permission of the Landscape Architect.

WARNING

DIAL BEFORE YOU DIG www.1100.com.au

Services shown on this drawing are approximate only. The exact location is to be confirmed on site by contractor prior to commencement of work.

NSW GOVERNMENT Planning, Industry & Environment

*Issued under the Environmental Planning and Assessment Act 1979*

Approved Application No: SSD-9835 Signed:

Granted on the: 6 Dec 2019 Sheet No: 26 of 83

ASPECT Studios™
ASPECT Studios Pty Ltd
Level 1, 78-80 George Street
Redfern NSW 2016
Australia
T 02 9698 7182
www.aspect-studios.com
sydney@aspect-studios.com
ABN 11 120 219 561

CLIENT

we are insw Infrastructure New South Wales

PROJECT

SYDNEY FOOTBALL STADIUM
Moore Park, New South Wales
S18030

DRAWING

GRADING & LEVELS PLANS
Ground Level - Quad A

| DRAWN | CHECKED | SCALE A0 \| SCALE A2 |
|---|---|---|
| XX | JH | 1:200 \| 1:400 |

0 5 10 15 M

STATUS

FOR INFORMATION
NOT FOR CONSTRUCTION

NORTH

DRAWING NO. LA-201 REVISION F

05_PRODUCTION\02_Phase 02 (SSDA)\01_CAD\18030_LA_201 [Ground - Grading + Levels].vwx

NOTES

These drawings are shown in colour and shall be read in digital format or print colour hardcopy.

These drawings shall be read in conjunction with all relevant information (not limited to legends, schedules, specifications)

These drawings shall be read in conjunction with any Engineers, Architects or other consultant information. (not limited to drawings, legends, schedules, specifications)

Check all dimensions and site conditions prior to commencement of any work and the procurement of any services, materials, fittings, fabrication or equipment.

Do not scale drawings – refer to figured drawings only. Any discrepancies shall immediately be referred to the Landscape Architect for clarification.

All drawings shall not be reproduced or distributed without prior permission of the Landscape Architect.

WARNING

DIAL BEFORE YOU DIG www.1100.com.au

Services shown on this drawing are approximate only. The exact location is to be confirmed on site by contractor prior to commencement of work.

| DATE | REV | AMENDMENTS |
|---|---|---|
| 1/2/19 | A | END OF JANUARY PACKAGE -ISSUED FOR INFORMATION |
| 25/2/19 | B | END OF FEBRUARY PACKAGE - FOR INFORMATION |
| 28/5/19 | C | 85% DD - FOR INFORMATION |
| 24/7/19 | D | REVISED TENDER - FOR INFORMATION |
| 8/8/19 | E | REVISED TENDER - FOR INFORMATION |
| 20/9/19 | F | RESPONSE TO SUBMISSIONS - FOR INFORMATION |

NOTE:
1. ALL LEVELS AND GRADING ARE SUBJECT TO STORMWATER AND FLOOD DESIGN
2. GRADING AND LEVELS PLANS ARE STORMWATER SUBJECT TO REVIEW BY ACCESS / BCA CONSULTANT

NSW GOVERNMENT | Planning, Industry & Environment

*Issued under the Environmental Planning and Assessment Act 1979*

Approved Application No: SSD-9835 Signed:

Granted on the: 6 Dec 2019 Sheet No: 27 of 83

ASPECT Studios™
ASPECT Studios Pty Ltd
Level 1, 76-80 George Street
Redfern NSW 2016
Australia
T 02 9699 7182
www.aspect-studios.com
sydney@aspect-studios.com
ABN 11 120 219 561

CLIENT
we are insw Infrastructure New South Wales

PROJECT
SYDNEY FOOTBALL STADIUM
Moore Park, New South Wales
S18030

DRAWING
GRADING & LEVELS PLANS
Ground Level - Quad B

| DRAWN | CHECKED | SCALE A0 \| SCALE A2 |
|---|---|---|
| XX | JH | 1:200 1:400 |

0 5 10 15 M

STATUS: FOR INFORMATION
NOT FOR CONSTRUCTION

NORTH

DRAWING NO. LA-202 REVISION F

05_PRODUCTION\02_Phase 02 (SSDA)\01_CAD\18030_LA_201 [Ground - Grading + Levels].vwx

JOINS SHEET 203

JOINS SHEET 201

EX 41.008

NOTE: LOCATION OF SYDNEY WATER DIVERSION TBC

EX 41.000

DRIVER AVE

BASEMENT BOUNDARY

RL 45.875

RL 46.650

1:90

1:57

RL 41.000

RL 45.880

1:29

RL 46.463

RL 41.000

EX 40.010

RL 45.760

RL 45.817

1:33

RL 46.323

1:90

1:57

TB 46.185

RL 45.735

1:27

RL 46.263

TW 47.185

TW 44.280

1:57

BOS 40.185

BOS 43.125

TOS 43.095

RL 46.055

RL 46.495

RL 46.650

1:46

TOS 40.505

TOS 45.685

EX 39.930

1:40

BOS 40.535

RL 45.735

TW 40.505

1:40

RL 46.650

BOS 43.125

RL 45.735

BOS 40.535

TOS 45.045

TOS 42.455

TW 40.505

1:40

NOTE: CONCOURSE GRADING TO CONTINUE INTO STADIUM.

RL 45.735

EX 39.900

RL 46.100

TOS 45.685

TW 40.505

1:40

46.650

TOS 46.48

BOS 40.535

BOS 43.125

BOS 45.880

RL 45.835

TOS 40.505

TOS 43.095

EX 39.450

RL 45.760

RL 45.760

TW 47.185

RL 45.680

BOS 39.545

RL 45.695

RL 45.090

1:25

RL 44.925

RL 45.650

EX 39.400

TW 46.650

1:40

RL 44.285

RL 44.255

RL 43.615

RL 43.585

RL 42.945

RL 42.915

RL 42.275

1:14

TW 44.280

RL 45.000

1:14

1:14

1:14

RL 44.835

RL 44.195

RL 44.165

RL 43.525

RL 43.495

RL 42.855

RL 42.825

RL 42.185

RL 39.655

RL 40.260

RL 40.290

RL 40.930

RL 40.960

RL 41.600

EXISTING OSD TANK F

CRICKET NSW

EX 41.620

JOINS SHEET 203

JOINS SHEET 204

24 23 22 21 20 19 18 17 16 15 14 13 12 11 10 9 8 7 6 5 4 3

J5 C1 C2 C3 C4 C5 C6 C7 C8 CA CB CC CD CE CF CG

NOTES

These drawings are shown in colour and shall be read in digital format or print colour hardcopy.

These drawings shall be read in conjunction with all relevant information (not limited to legends, schedules, specifications)

These drawings shall be read in conjunction with any Engineers, Architects or other consultant information. (not limited to drawings, legends, schedules, specifications)

Check all dimensions and site conditions prior to commencement of any work and the procurement of any services, materials, fittings, fabrication or equipment.

Do not scale drawings – refer to figured drawings only. Any discrepancies shall immediately be referred to the Landscape Architect for clarification.

All drawings shall not be reproduced or distributed without prior permission of the Landscape Architect.

WARNING

DIAL BEFORE YOU DIG www.1100.com.au

Services shown on this drawing are approximate only. The exact location is to be confirmed on site by contractor prior to commencement of work.

| DATE | REV | AMENDMENTS |
|---|---|---|
| 1/2/19 | A | END OF JANUARY PACKAGE - ISSUED FOR INFORMATION |
| 25/2/19 | B | END OF FEBRUARY PACKAGE - FOR INFORMATION |
| 28/5/19 | C | 85% DD - FOR INFORMATION |
| 24/7/19 | D | REVISED TENDER - FOR INFORMATION |
| 8/8/19 | E | REVISED TENDER - FOR INFORMATION |
| 20/9/19 | F | RESPONSE TO SUBMISSIONS - FOR INFORMATION |

NOTE: GRADING AND LEVELS PLANS ARE SUBJECT TO REVIEW BY ACCESS / BCA CONSULTANT

NSW GOVERNMENT Planning, Industry & Environment

*Issued under the Environmental Planning and Assessment Act 1979*

Approved Application No: SSD-9835 Signed:

Granted on the: 6 Dec 2019 Sheet No: 28 of 83

ASPECT Studios™

ASPECT Studios Pty Ltd
Level 1, 78-80 George Street
Redfern NSW 2016
Australia
T 02 9698 7182
www.aspect-studios.com
sydney@aspect-studios.com
ABN 11 120 219 561

CLIENT

we are insw Infrastructure New South Wales

PROJECT

SYDNEY FOOTBALL STADIUM

Moore Park, New South Wales

S18030

DRAWING

GRADING & LEVELS PLANS

Ground Level - Quad C

| DRAWN | CHECKED | SCALE A0 \| SCALE A2 |
|---|---|---|
| XX | JH | 1:200 \| 1:400 |

0 5 10 15 M

STATUS

FOR INFORMATION

NOT FOR CONSTRUCTION

NORTH

DRAWING NO. LA-203

REVISION F

05_PRODUCTION\02_Phase 02 (SSDA)\01_CAD\18030_LA_201 [Ground - Grading + Levels].vwx

JOINS SHEET 202

JOINS SHEET 204

JOINS SHEET 203

JOINS SHEET 204

1:100 1:100

TW 47.215

RL 46.625

EX 43.00

TW 47.515

RL 46.650 RL 46.650

RL 46.380 1:14 RL 46.380

RL 46.290 1:40 RL 46.290

1:14

RL 45.710 RL 45.710

RL 45.615 1:40 RL 45.615

1:8

EX 42.000

1:14

RL 44.975 RL 45.005 1:40 RL 45.005

RL 44.945

RL 44.915

RL 44.490 1:14

RL 44.430 RL 41.420

RL 44.335 1:40 43.220 EX 41.420

RL 44.275 1:27

1:14 RL 41.340

RL 43.695 RL 43.665 1:40 RL 43.635 RL 43.605 RL 43.605 EX 41.340

RL 43.025 RL 42.995 1:14

RL 42.455 1:40 RL 42.965 RL 42.935 1:14

RL 42.240 1:40 RL 42.395

SCG BASEMENT BELOW

RL 41.985 1:17 RL 42.180

RL 41.925 RL 41.600

RL 41.600

RL 42.275 RL 42.245 RL 41.725

1:14 1:14

RL 42.185 RL 42.155 RL 41.635

TW 42.845

41.600

PROPOSED OSD TANK BELOW

SCG BASEMENT BELOW

EX 41.640 EX 41.640 EX 41.640 EX 41.640 EX 41.650 EX 41.660

SYDNEY CRICKET GROUND

FOX STUDIOS

J1 J2 J3 J4 J5 J6 J7

73 74 75 76 77 78 79 80 81 82 83 84 85 86 87 88 89 90 91 92 93 94 95 96 1 2

NOTES

These drawings are shown in colour and shall be read in digital format or print colour hardcopy.

These drawings shall be read in conjunction with all relevant information (not limited to legends, schedules, specifications)

These drawings shall be read in conjunction with any Engineers, Architects or other consultant information. (not limited to drawings, legends, schedules, specifications)

Check all dimensions and site conditions prior to commencement of any work and the procurement of any services, materials, fittings, fabrication or equipment.

Do not scale drawings – refer to figured drawings only. Any discrepancies shall immediately be referred to the Landscape Architect for clarification.

All drawings shall not be reproduced or distributed without prior permission of the Landscape Architect.

WARNING

DIAL BEFORE YOU DIG www.1100.com.au

Services shown on this drawing are approximate only. The exact location is to be confirmed on site by contractor prior to commencement of work.

| DATE | REV | AMENDMENTS |
|---|---|---|
| 1/2/19 | A | END OF JANUARY PACKAGE -ISSUED FOR INFORMATION |
| 25/2/19 | B | END OF FEBRUARY PACKAGE - FOR INFORMATION |
| 29/5/19 | C | 85% DD - FOR INFORMATION |
| 24/7/19 | D | REVISED TENDER - FOR INFORMATION |
| 8/8/19 | E | REVISED TENDER - FOR INFORMATION |
| 20/9/19 | F | RESPONSE TO SUBMISSIONS - FOR INFORMATION |

NOTE: GRADING AND LEVELS PLANS ARE SUBJECT TO REVIEW BY ACCESS / BCA CONSULTANT

NSW GOVERNMENT Planning, Industry & Environment

*Issued under the Environmental Planning and Assessment Act 1979*

Approved Application No: SSD-9835 Signed:

Granted on the: 6 Dec 2019 Sheet No: 29 of 83

ASPECT Studios™

ASPECT Studios Pty Ltd
Level 1, 78-80 George Street
Redfern NSW 2016
Australia
T 02 9699 7182
www.aspect-studios.com
sydney@aspect-studios.com
ABN 11 120 219 561

CLIENT

we are inSW Infrastructure New South Wales

PROJECT

SYDNEY FOOTBALL STADIUM
Moore Park, New South Wales
S18030

DRAWING

GRADING & LEVELS PLANS
Ground Level - Quad D

| DRAWN | CHECKED | SCALE A0 \| SCALE A2 |
|---|---|---|
| XX | JH | 1:200 1:400 |

0 5 10 15 M

STATUS

FOR INFORMATION
NOT FOR CONSTRUCTION

NORTH

DRAWING NO. REVISION

LA-204 F




NOTES

These drawings are shown in colour and shall be read in digital format or print colour hardcopy.

These drawings shall be read in conjunction with all relevant information (not limited to legends, schedules, specifications)

These drawings shall be read in conjunction with any Engineers, Architects or other consultant information. (not limited to drawings, legends, schedules, specifications)

Check all dimensions and site conditions prior to commencement of any work and the procurement of any services, materials, fittings, fabrication or equipment.

Do not scale drawings – refer to figured drawings only. Any discrepancies shall immediately be referred to the Landscape Architect for clarification.

All drawings shall not be reproduced or distributed without prior permission of the Landscape Architect.

WARNING

DIAL BEFORE YOU DIG www.1100.com.au

Services shown on this drawing are approximate only. The exact location is to be confirmed on site by contractor prior to commencement of work.

| DATE | REV | AMENDMENTS |
|---|---|---|
| 26/2/19 | A | END OF FEBRUARY PACKAGE - FOR INFORMATION |
| 29/3/19 | B | 80% DD - FOR INFORMATION |
| 24/7/19 | C | REVISED TENDER - FOR INFORMATION |
| 8/8/19 | D | REVISED TENDER - FOR INFORMATION |

NSW GOVERNMENT Planning, Industry & Environment

*Issued under the Environmental Planning and Assessment Act 1979*

Approved Application No: SSD-9835 Signed:

Granted on the: 6 Dec 2019 Sheet No: 30 of 83


ASPECT Studios™

**ASPECT Studios Pty Ltd**
Level 1, 79-80 George Street
Redfern NSW 2016
Australia
T 02 9699 7182
www.aspect-studios.com
sydney@aspect-studios.com
ABN 11 120 219 561


CLIENT

we are insw Infrastructure New South Wales

PROJECT

SYDNEY FOOTBALL STADIUM
Moore Park, New South Wales

S18030

DRAWING

PLANTING PLANS
Ground Level - Quad A

| DRAWN | CHECKED | SCALE A0 \| SCALE A2 |
|---|---|---|
| JR \| DC | JH | 1:200 1:400 |

0 5 10 15 M


STATUS: FOR INFORMATION
NOT FOR CONSTRUCTION

NORTH

DRAWING NO. LA-401

REVISION D

05_PRODUCTION\02_Phase 02 (SSDA)\01_CAD\18030_LA_401 [Ground - Planting].vwx

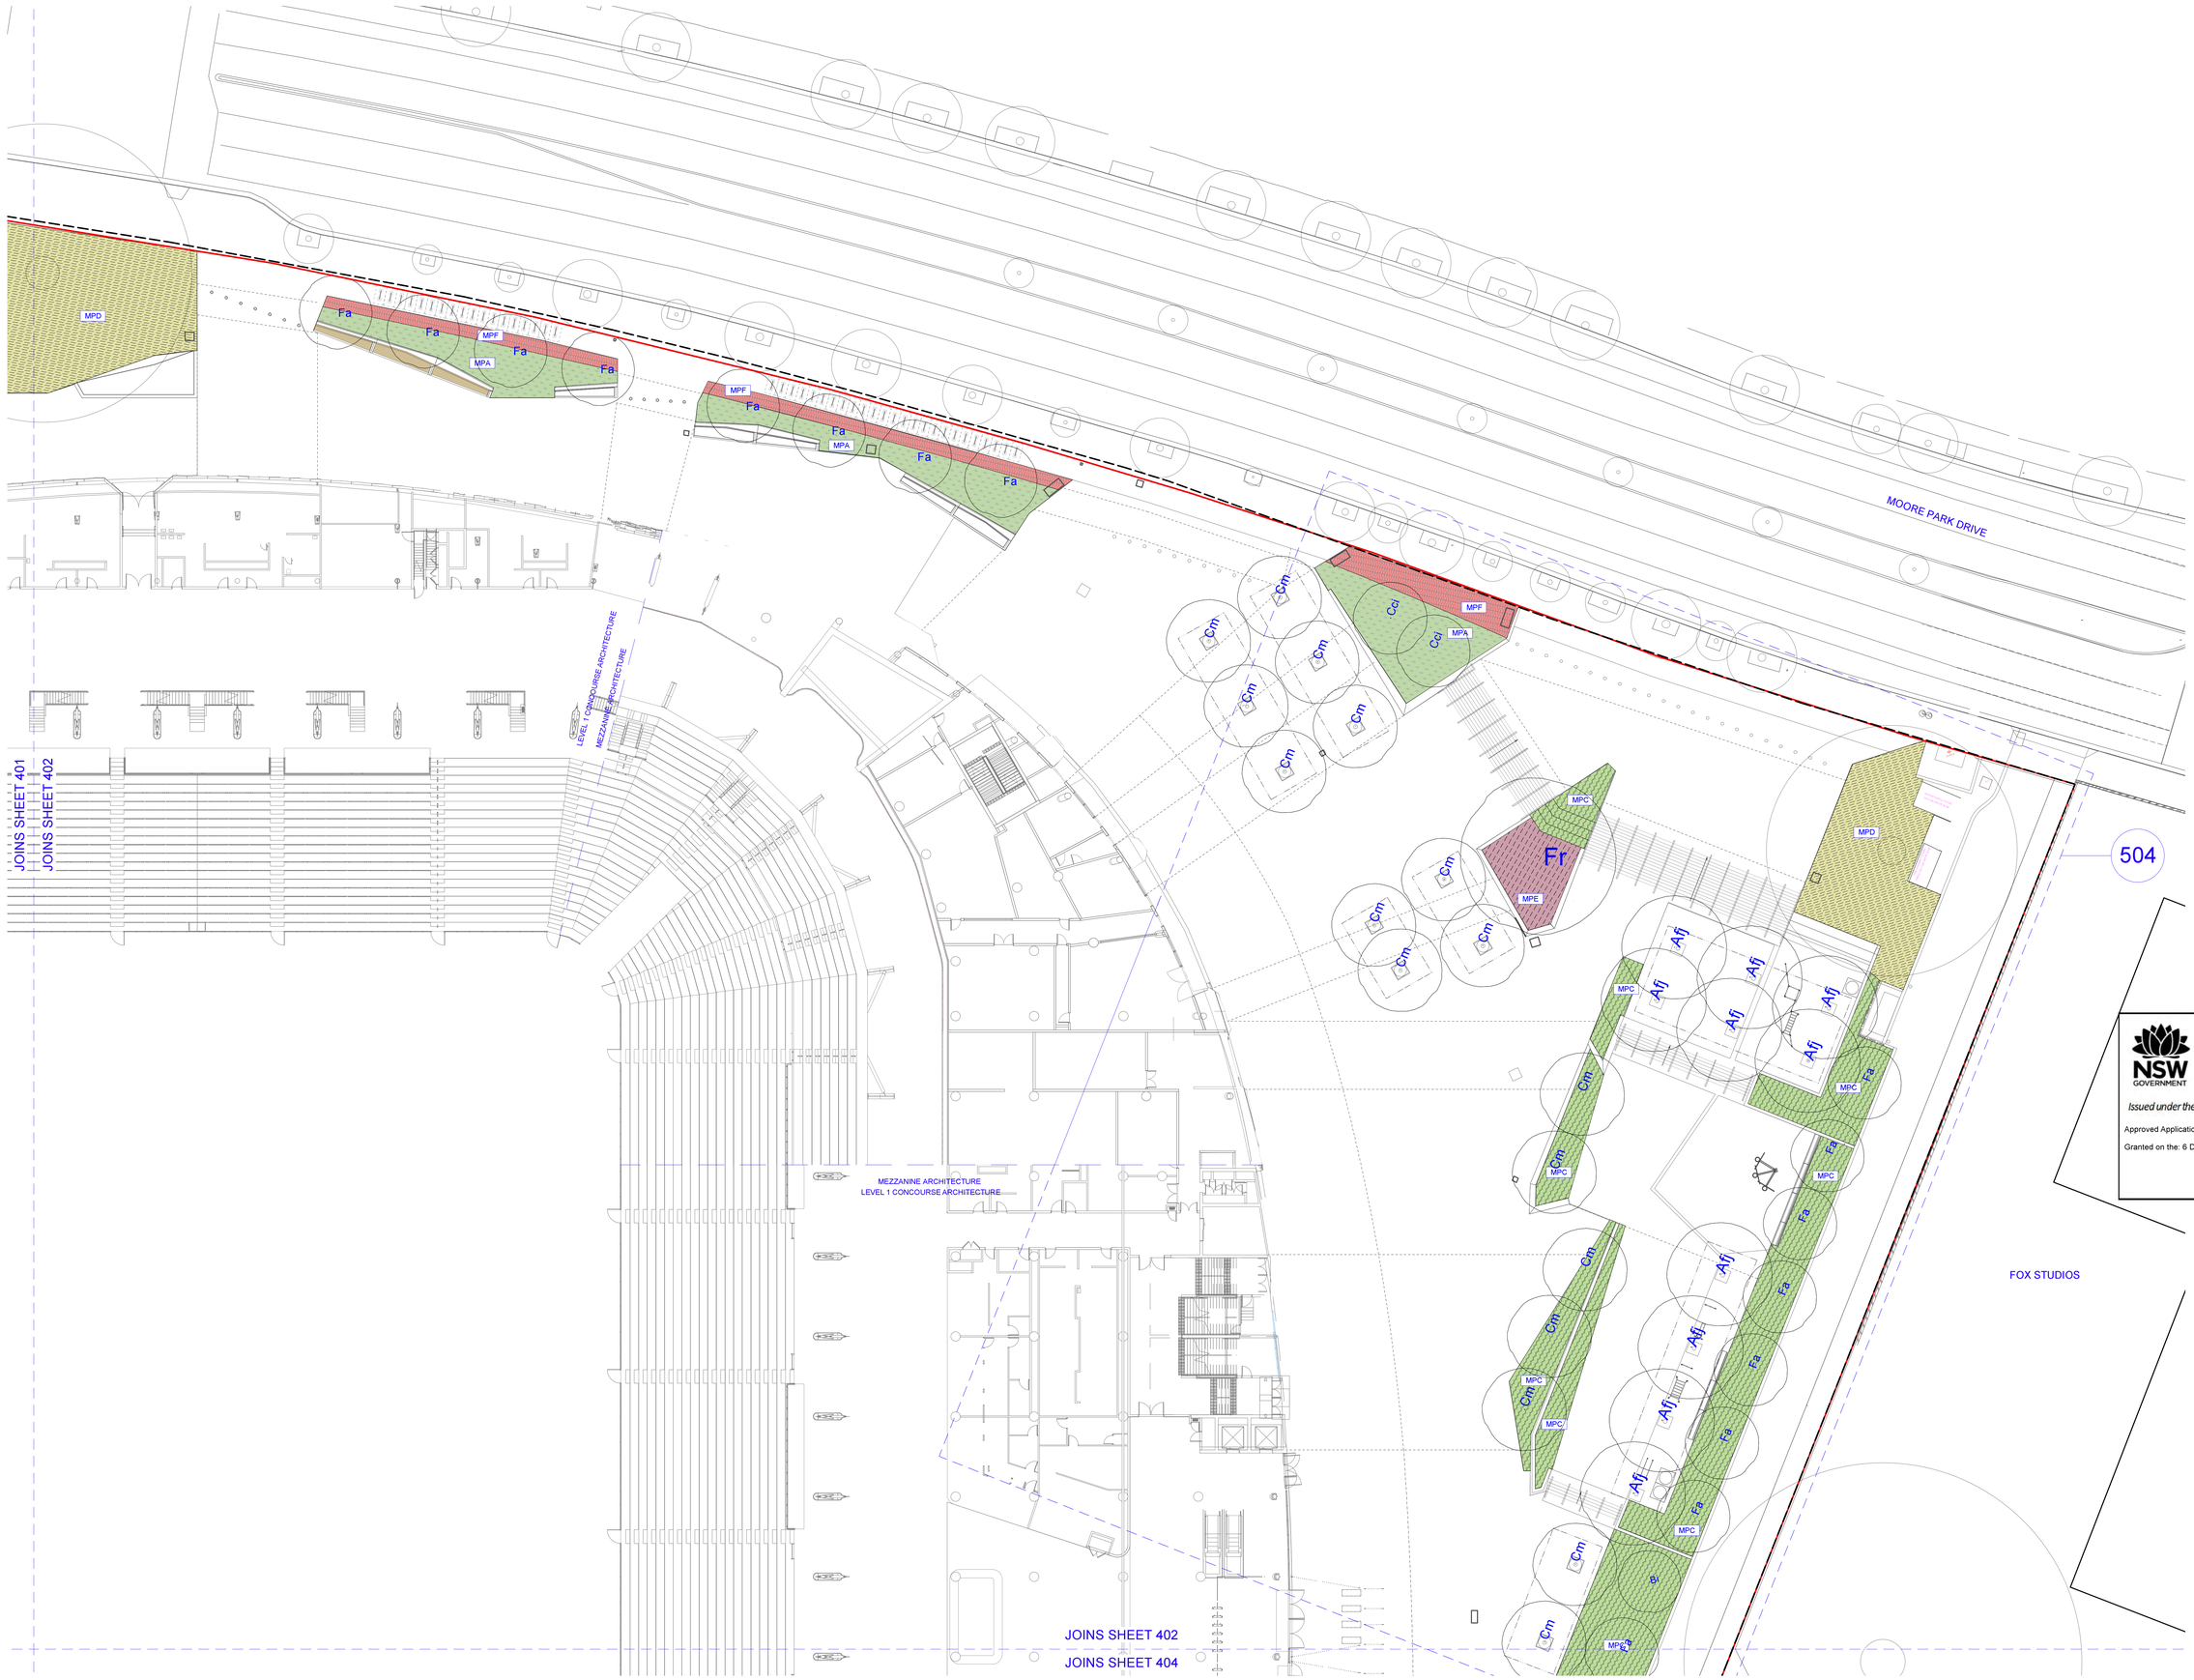


NOTES

These drawings are shown in colour and shall be read in digital format or print colour hardcopy.

These drawings shall be read in conjunction with all relevant information (not limited to legends, schedules, specifications)

These drawings shall be read in conjunction with any Engineers, Architects or other consultant information. (not limited to drawings, legends, schedules, specifications)

Check all dimensions and site conditions prior to commencement of any work and the procurement of any services, materials, fittings, fabrication or equipment.

Do not scale drawings – refer to figured drawings only. Any discrepancies shall immediately be referred to the Landscape Architect for clarification.

All drawings shall not be reproduced or distributed without prior permission of the Landscape Architect.

WARNING

DIAL BEFORE YOU DIG www.1100.com.au

Services shown on this drawing are approximate only. The exact location is to be confirmed on site by contractor prior to commencement of work.

| DATE | REV | AMENDMENTS |
|---|---|---|
| 26/3/19 | A | END OF FEBRUARY PACKAGE - FOR INFORMATION |
| 29/3/19 | B | 80% DD - FOR INFORMATION |
| 24/7/19 | C | REVISED TENDER - FOR INFORMATION |
| 8/8/19 | D | REVISED TENDER - FOR INFORMATION |

NSW GOVERNMENT Planning, Industry & Environment

*Issued under the Environmental Planning and Assessment Act 1979*

Approved Application No: SSD-9835 Signed:

Granted on the: 6 Dec 2019 Sheet No: 31 of 83


ASPECT Studios™

**ASPECT Studios Pty Ltd**
Level 1, 79-80 George Street
Redfern NSW 2016
Australia
T 02 9699 7182
www.aspect-studios.com
sydney@aspect-studios.com
ABN 11 120 219 561


CLIENT

we are inSW Infrastructure New South Wales

PROJECT

SYDNEY FOOTBALL STADIUM
Moore Park, New South Wales

S18030

DRAWING

PLANTING PLANS
Ground Level - Quad B

| DRAWN | CHECKED | SCALE A0 \| SCALE A2 |
|---|---|---|
| JR \| DC | JH | 1:200 \| 1:400 |

0 5 10 15 M

STATUS: FOR INFORMATION
NOT FOR CONSTRUCTION

NORTH

DRAWING NO. LA-402

REVISION D

05_PRODUCTION\02_Phase 02 (SSDA)\01_CAD\18030_LA_401 [Ground - Planting].vwx

DRIVER AVENUE

BASEMENT BOUNDARY

BASEMENT BOUNDARY

505

Cm
Cm
Cm
MPA
MPA
MPB
MPB
MPB
Fr
Cm
Cm
Cm
Cm
Can
Can
Can
Can
Can
Can
Can
Can
MPA
Bi
Bi
Bi
Bi
Bi
MPG
Cm
Bi

CRICKET NSW

JOINS SHEET 403

JOINS SHEET 404

NOTES

These drawings are shown in colour and shall be read in digital format or print colour hardcopy.

These drawings shall be read in conjunction with all relevant information (not limited to legends, schedules, specifications)

These drawings shall be read in conjunction with any Engineers, Architects or other consultant information. (not limited to drawings, legends, schedules, specifications)

Check all dimensions and site conditions prior to commencement of any work and the procurement of any services, materials, fittings, fabrication or equipment.

Do not scale drawings – refer to figured drawings only. Any discrepancies shall immediately be referred to the Landscape Architect for clarification.

All drawings shall not be reproduced or distributed without prior permission of the Landscape Architect.

WARNING

DIAL BEFORE YOU DIG www.1100.com.au

Services shown on this drawing are approximate only. The exact location is to be confirmed on site by contractor prior to commencement of work.

| DATE | REV | AMENDMENTS |
|---|---|---|
| 26/3/19 | A | END OF FEBRUARY PACKAGE - FOR INFORMATION |
| 29/3/19 | B | 80% DD - FOR INFORMATION |
| 24/7/19 | C | REVISED TENDER - FOR INFORMATION |
| 8/8/19 | D | REVISED TENDER - FOR INFORMATION |

NSW GOVERNMENT Planning, Industry & Environment

*Issued under the Environmental Planning and Assessment Act 1979*

Approved Application No: SSD-9835 Signed:

Granted on the: 6 Dec 2019 Sheet No: 32 of 83


ASPECT Studios™

**ASPECT Studios Pty Ltd**
Level 1, 78-80 George Street
Redfern NSW 2016
Australia
T 02 9699 7182
www.aspect-studios.com
sydney@aspect-studios.com
ABN 11 120 219 561


CLIENT

we are iNSW Infrastructure New South Wales

PROJECT

SYDNEY FOOTBALL STADIUM

Moore Park, New South Wales

S18030

DRAWING

PLANTING PLANS

Ground Level - Quad C

| DRAWN | CHECKED | SCALE A0 \| SCALE A2 |
|---|---|---|
| JR \| DC | JH | 1:200 1:400 |

0 5 10 15 M

STATUS

FOR INFORMATION

NOT FOR CONSTRUCTION

NORTH

DRAWING NO. LA-403

REVISION D




NOTES

These drawings are shown in colour and shall be read in digital format or print colour hardcopy.

These drawings shall be read in conjunction with all relevant information (not limited to legends, schedules, specifications)

These drawings shall be read in conjunction with any Engineers, Architects or other consultant information. (not limited to drawings, legends, schedules, specifications)

Check all dimensions and site conditions prior to commencement of any work and the procurement of any services, materials, fittings, fabrication or equipment.

Do not scale drawings – refer to figured drawings only. Any discrepancies shall immediately be referred to the Landscape Architect for clarification.

All drawings shall not be reproduced or distributed without prior permission of the Landscape Architect.

WARNING

DIAL BEFORE YOU DIG www.1100.com.au

Services shown on this drawing are approximate only. The exact location is to be confirmed on site by contractor prior to commencement of work.

| DATE | REV | AMENDMENTS |
|---|---|---|
| 26/2/19 | A | END OF FEBRUARY PACKAGE - FOR INFORMATION |
| 29/3/19 | B | 80% DD - FOR INFORMATION |
| 24/7/19 | C | REVISED TENDER - FOR INFORMATION |
| 8/8/19 | D | REVISED TENDER - FOR INFORMATION |

NSW GOVERNMENT | Planning, Industry & Environment

*Issued under the Environmental Planning and Assessment Act 1979*

Approved Application No: SSD-9835 Signed:

Granted on the: 6 Dec 2019 Sheet No: 33 of 83


ASPECT Studios™

**ASPECT Studios Pty Ltd**
Level 1, 78-80 George Street
Redfern NSW 2016
Australia
T 02 9699 7182
www.aspect-studios.com
sydney@aspect-studios.com
ABN 11 120 219 561


CLIENT

we are inSW Infrastructure New South Wales

PROJECT

SYDNEY FOOTBALL STADIUM
Moore Park, New South Wales
S18030

DRAWING

PLANTING PLANS
Ground Level - Quad D

| DRAWN | CHECKED | SCALE A0 \| SCALE A2 |
|---|---|---|
| JR \| DC | JH | 1:200 \| 1:400 |

0 5 10 15 M

STATUS


FOR INFORMATION
NOT FOR CONSTRUCTION

NORTH

DRAWING NO. LA-404

REVISION D

05_PRODUCTION\02_Phase 02 (SSDA)\01_CAD\18030_LA_401 [Ground - Planting].vwx

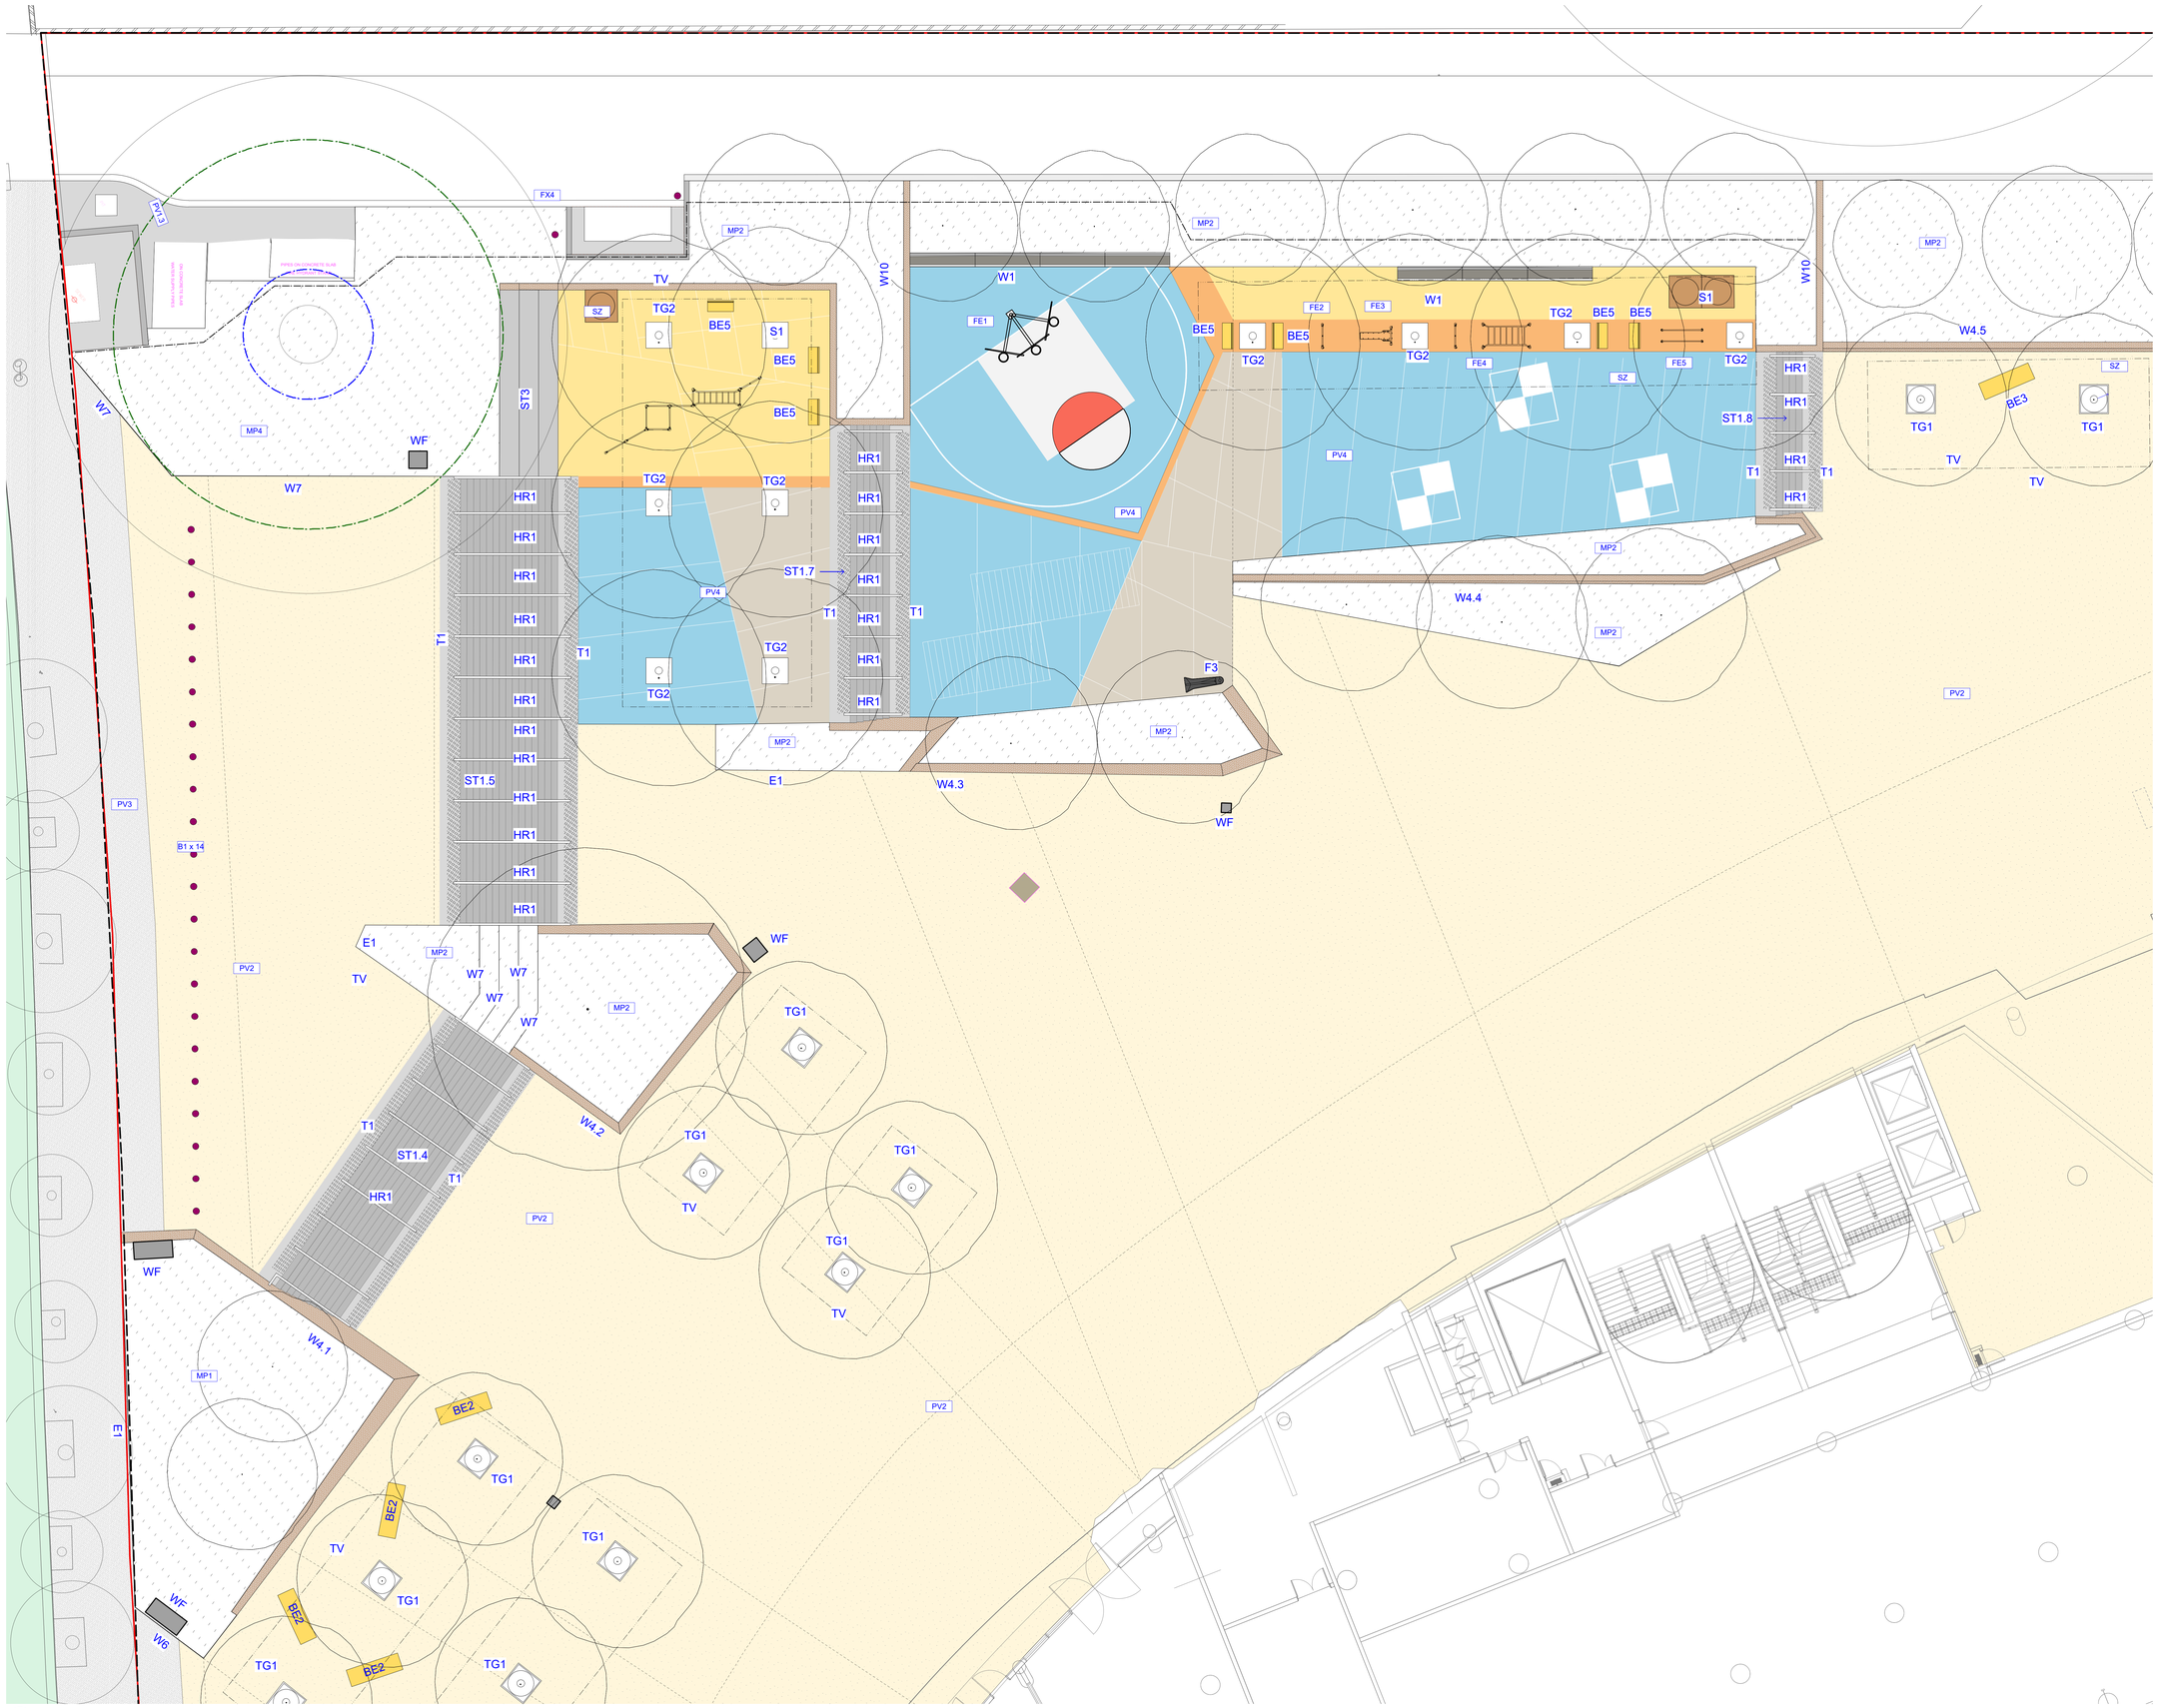


1 DETAIL AREA 1 | MATERIALS + FINISHES PLAN
SCALE 1:100

**NOTES**

These drawings are shown in colour and shall be read in digital format or print colour hardcopy.

These drawings shall be read in conjunction with all relevant information (not limited to legends, schedules, specifications)

These drawings shall be read in conjunction with any Engineers, Architects or other consultant information. (not limited to drawings, legends, schedules, specifications)

Check all dimensions and site conditions prior to commencement of any work and the procurement of any services, materials, fittings, fabrication or equipment.

Do not scale drawings – refer to figured drawings only. Any discrepancies shall immediately be referred to the Landscape Architect for clarification.

All drawings shall not be reproduced or distributed without prior permission of the Landscape Architect.


**WARNING**

DIAL BEFORE YOU DIG www.1100.com.au

Services shown on this drawing are approximate only. The exact location is to be confirmed on site by contractor prior to commencement of work.

| DATE | REV | AMENDMENTS |
|---|---|---|
| 29/3/19 | A | 80% DD - FOR INFORMATION |
| 24/7/19 | B | REVISED TENDER - FOR INFORMATION |
| 8/8/19 | C | REVISED TENDER - FOR INFORMATION |

KEY PLAN

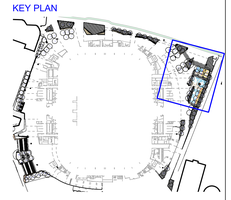

NSW GOVERNMENT | Planning, Industry & Environment

*Issued under the Environmental Planning and Assessment Act 1979*

Approved Application No: SSD-9835 Signed:

Granted on the: 6 Dec 2019 Sheet No: 34 of 83


**ASPECT Studios™**

**ASPECT Studios Pty Ltd**
Level 1, 78-80 George Street
Redfern NSW 2016
Australia
T 02 9699 7182
www.aspect-studios.com
sydney@aspect-studios.com
ABN 11 120 219 561


CLIENT
we are inSW Infrastructure New South Wales

PROJECT
SYDNEY FOOTBALL STADIUM
Moore Park, New South Wales
S18030

DRAWING
DETAIL PLAN-MATERIAL + FINISHES
Ground Level - North East Detail Plan

| DRAWN | CHECKED | SCALE A0 \| SCALE A2 |
|---|---|---|
| JR \| DC | JH | 1:100 \| 1:200 |

0 2.5 5 7.5 M


STATUS
FOR INFORMATION
NOT FOR CONSTRUCTION

NORTH

DRAWING NO. LA-501

REVISION C

05_PRODUCTION\02_Phase 02 (SSDA)\01_CAD\18030_LA_501 [Ground - Detail Plans].vwx

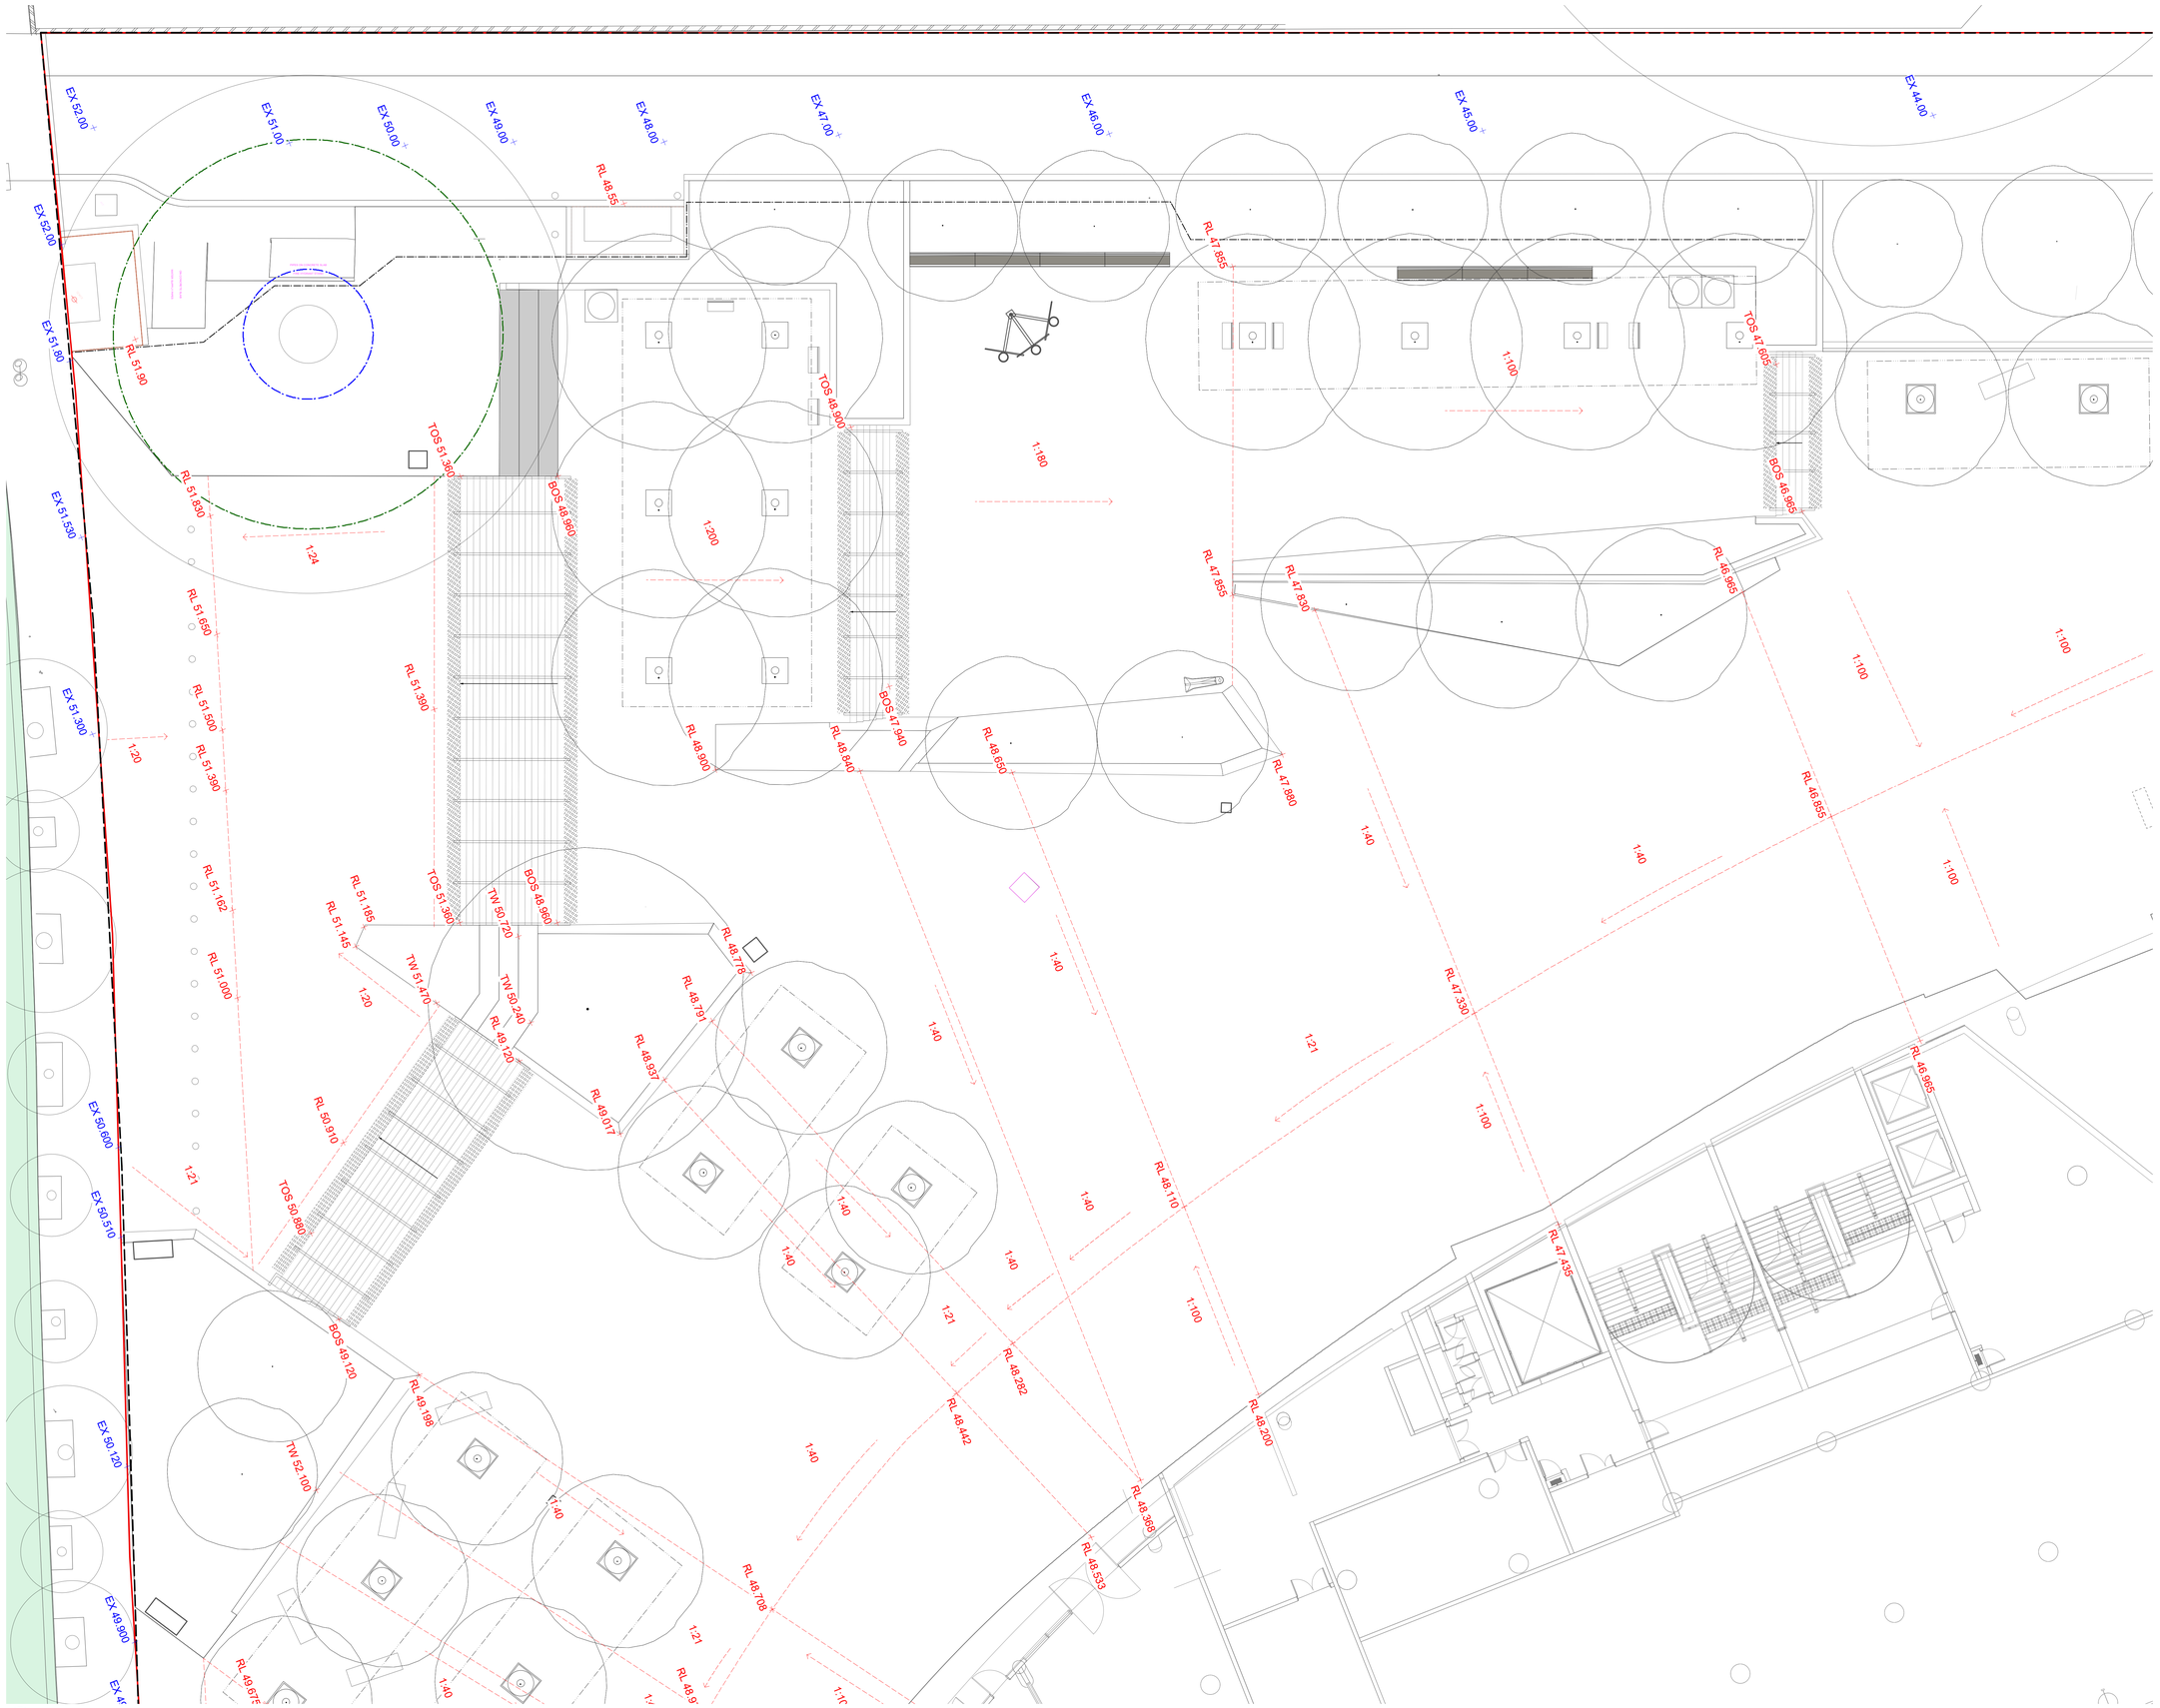


1 DETAIL AREA 1 | GRADING + LEVELS PLAN
SCALE 1:100

**NOTES**

These drawings are shown in colour and shall be read in digital format or print colour hardcopy.

These drawings shall be read in conjunction with all relevant information (not limited to legends, schedules, specifications)

These drawings shall be read in conjunction with any Engineers, Architects or other consultant information. (not limited to drawings, legends, schedules, specifications)

Check all dimensions and site conditions prior to commencement of any work and the procurement of any services, materials, fittings, fabrication or equipment.

Do not scale drawings – refer to figured drawings only. Any discrepancies shall immediately be referred to the Landscape Architect for clarification.

All drawings shall not be reproduced or distributed without prior permission of the Landscape Architect.


**WARNING**

DIAL BEFORE YOU DIG www.1100.com.au

Services shown on this drawing are approximate only. The exact location is to be confirmed on site by contractor prior to commencement of work.

| DATE | REV | AMENDMENTS |
|---|---|---|
| 29/3/19 | A | 80% DD - FOR INFORMATION |
| 24/7/19 | B | REVISED TENDER - FOR INFORMATION |
| 8/8/19 | C | REVISED TENDER - FOR INFORMATION |

KEY PLAN

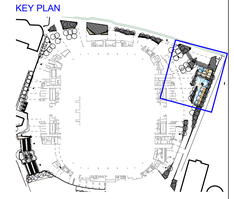

NSW GOVERNMENT | Planning, Industry & Environment

*Issued under the Environmental Planning and Assessment Act 1979*

Approved Application No: SSD-9835 Signed:

Granted on the: 6 Dec 2019 Sheet No: 35 of 83


**ASPECT Studios™**

**ASPECT Studios Pty Ltd**
Level 1, 78-80 George Street
Redfern NSW 2016
Australia
T 02 9699 7182
www.aspect-studios.com
sydney@aspect-studios.com
ABN 11 120 219 561


CLIENT

we are inSW Infrastructure New South Wales

PROJECT

SYDNEY FOOTBALL STADIUM
Moore Park, New South Wales
S18030

DRAWING

DETAIL PLAN - LEVELS + GRADING
Ground Level - North East Detail Plan

| DRAWN | CHECKED | SCALE A0 \| SCALE A2 |
|---|---|---|
| JR \| DC | JH | 1:100 1:200 |

0 2.5 5 7.5 M


STATUS NORTH

FOR INFORMATION
NOT FOR CONSTRUCTION

DRAWING NO. REVISION

LA-502 C

05_PRODUCTION\02_Phase 02 (SSDA)\01_CAD\18030_LA_501 [Ground - Detail Plans].vwx

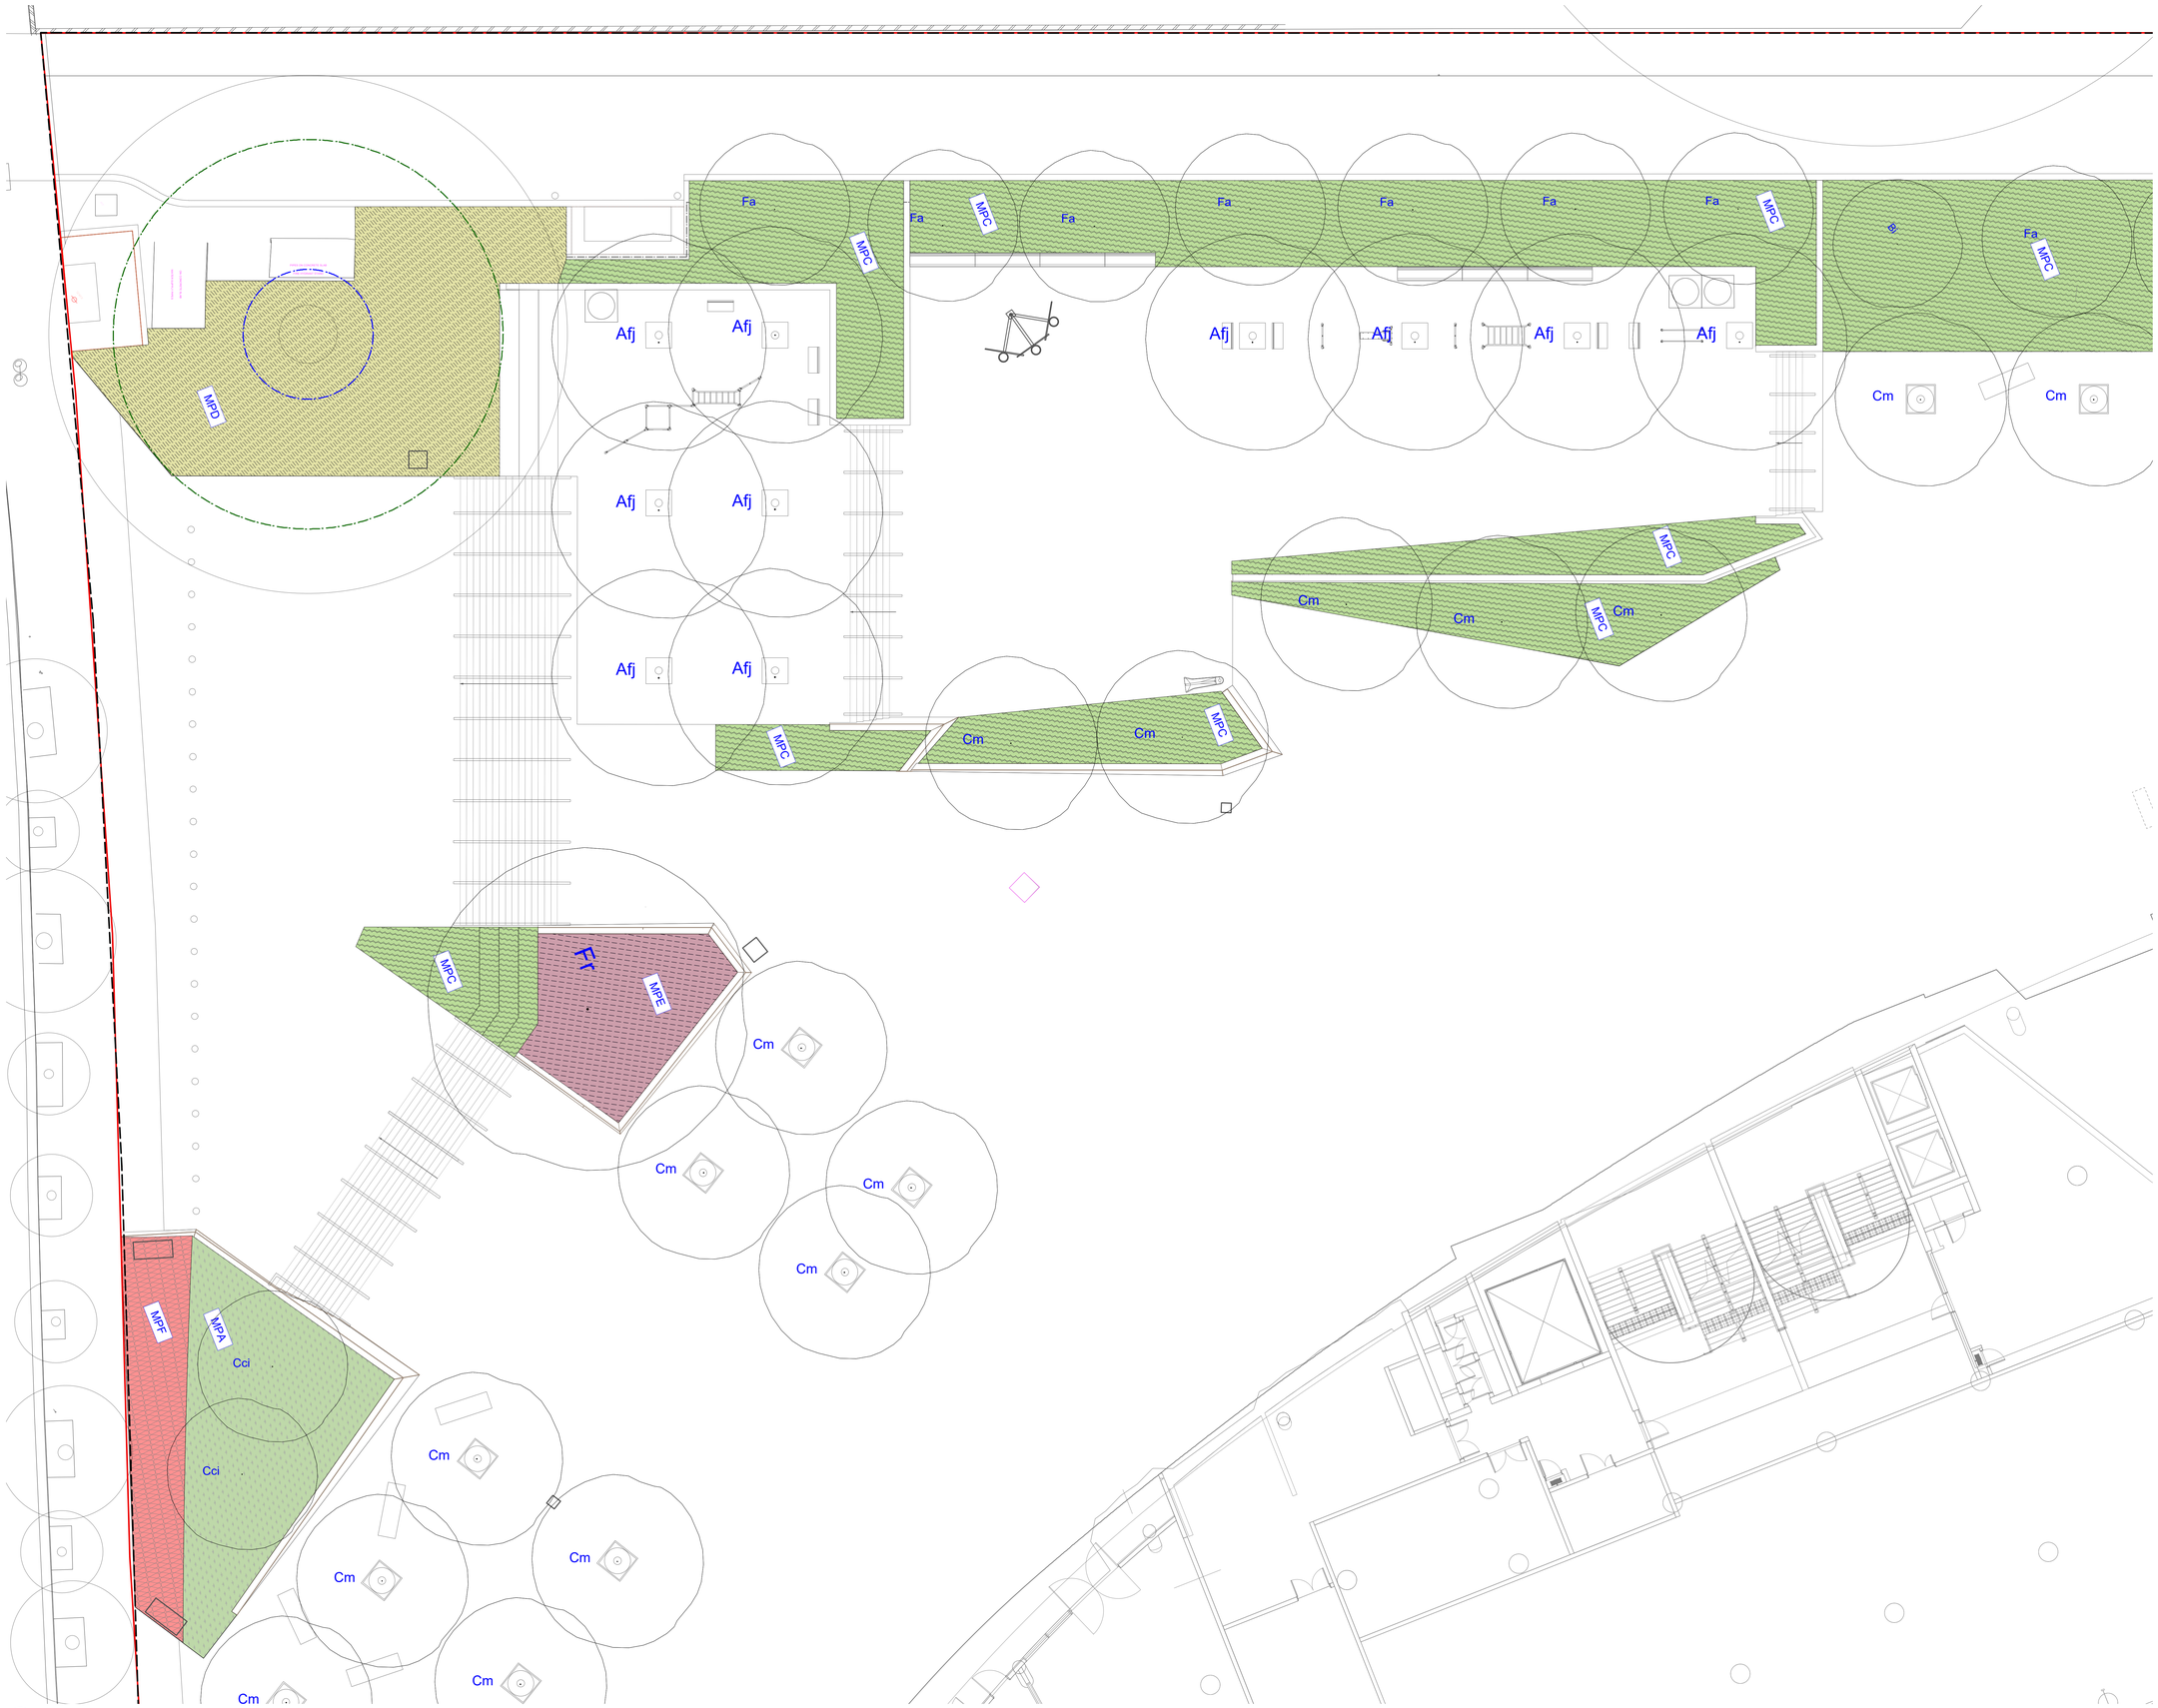


1 DETAIL AREA 1 | PLANTING PLAN
SCALE 1:100

**NOTES**

These drawings are shown in colour and shall be read in digital format or print colour hardcopy.

These drawings shall be read in conjunction with all relevant information (not limited to legends, schedules, specifications)

These drawings shall be read in conjunction with any Engineers, Architects or other consultant information. (not limited to drawings, legends, schedules, specifications)

Check all dimensions and site conditions prior to commencement of any work and the procurement of any services, materials, fittings, fabrication or equipment.

Do not scale drawings – refer to figured drawings only. Any discrepancies shall immediately be referred to the Landscape Architect for clarification.

All drawings shall not be reproduced or distributed without prior permission of the Landscape Architect.


**WARNING**

DIAL BEFORE YOU DIG www.1100.com.au

Services shown on this drawing are approximate only. The exact location is to be confirmed on site by contractor prior to commencement of work.

| DATE | REV | AMENDMENTS |
|---|---|---|
| 29/3/19 | A | 80% DD - FOR INFORMATION |
| 24/7/19 | B | REVISED TENDER - FOR INFORMATION |
| 8/8/19 | C | REVISED TENDER - FOR INFORMATION |

KEY PLAN

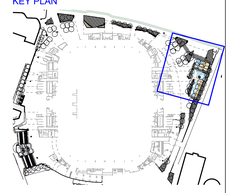

NSW GOVERNMENT | Planning, Industry & Environment

*Issued under the Environmental Planning and Assessment Act 1979*

Approved Application No: SSD-9835 Signed:

Granted on the: 6 Dec 2019 Sheet No: 36 of 83


ASPECT Studios™

**ASPECT Studios Pty Ltd**
Level 1, 78-80 George Street
Redfern NSW 2016
Australia
T 02 9699 7182
www.aspect-studios.com
sydney@aspect-studios.com
ABN 11 120 219 561


CLIENT

we are iNSW Infrastructure New South Wales

PROJECT

SYDNEY FOOTBALL STADIUM
Moore Park, New South Wales

S18030

DRAWING

DETAIL PLAN - PLANTING PLAN
Ground Level - North East Detail Plan

| DRAWN | CHECKED | SCALE A0 \| SCALE A2 |
|---|---|---|
| JR \| DC | JH | 1:100 \| 1:200 |

0 2.5 5 7.5 M

STATUS


FOR INFORMATION
NOT FOR CONSTRUCTION

NORTH


DRAWING NO. LA-504

REVISION C


05_PRODUCTION\02_Phase 02 (SSDA)\01_CAD\18030_LA_501 [Ground - Detail Plans].vwx

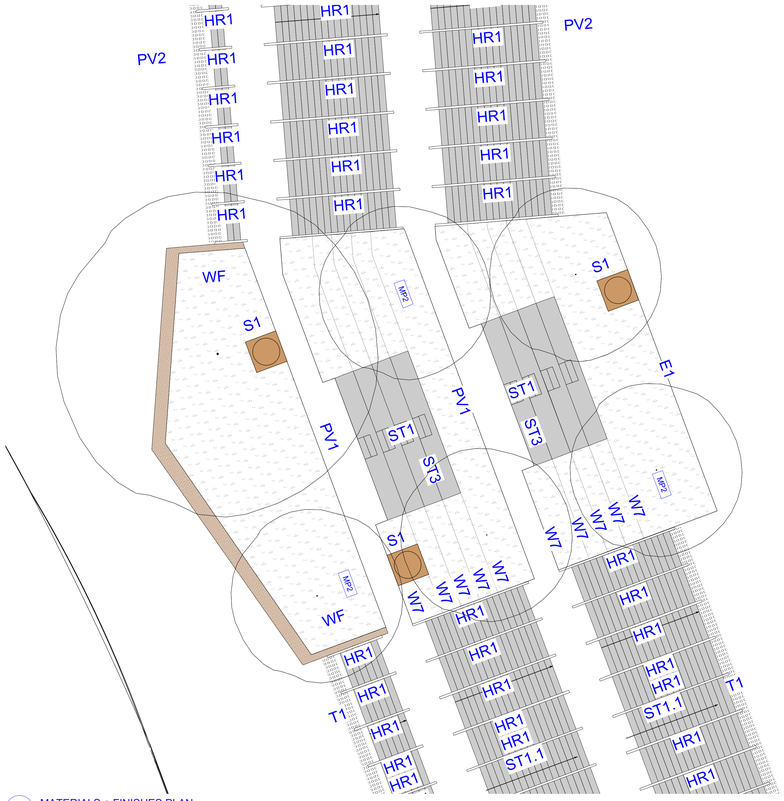


1 MATERIALS + FINISHES PLAN
Scale: 1:100

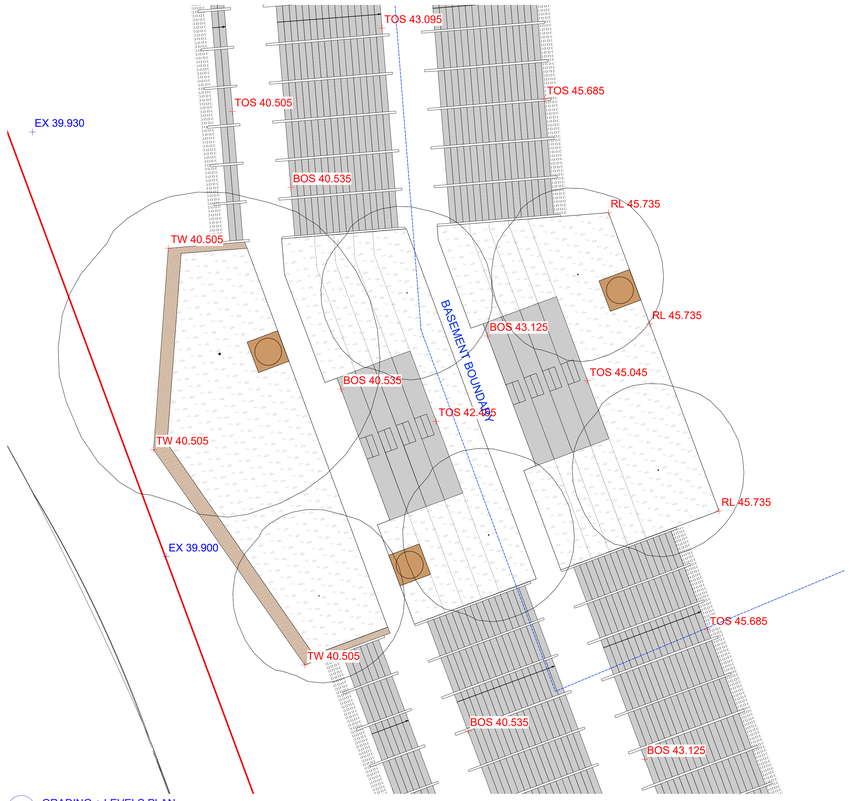


2 GRADING + LEVELS PLAN
Scale: 1:100

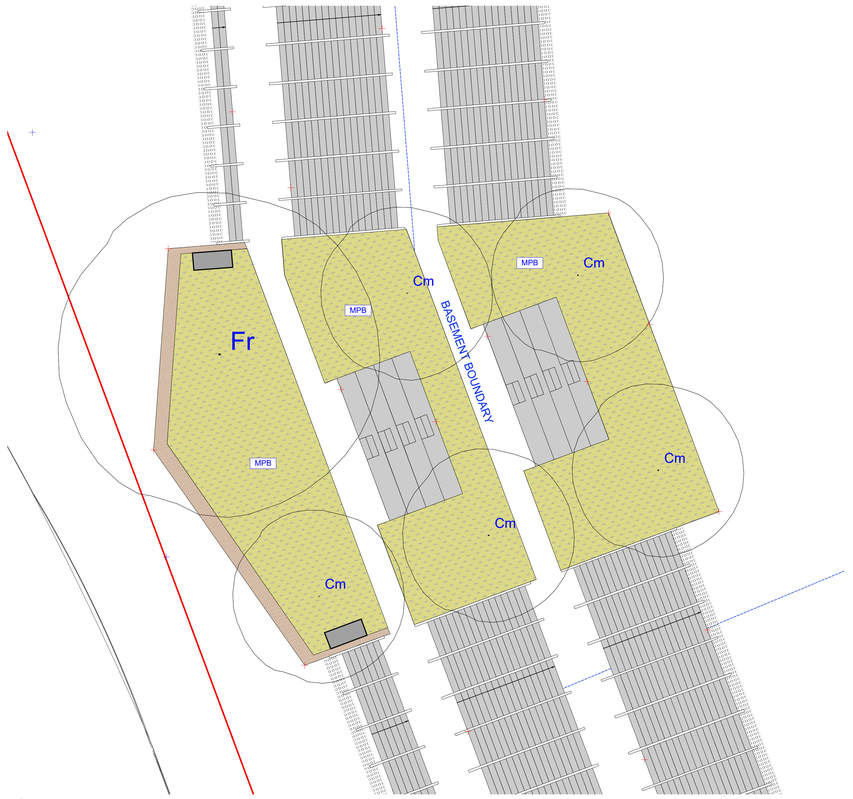


4 PLANTING PLAN
Scale: 1:100

**NOTES**

These drawings are shown in colour and shall be read in digital format or print colour hardcopy.

These drawings shall be read in conjunction with all relevant information (not limited to legends, schedules, specifications)

These drawings shall be read in conjunction with any Engineers, Architects or other consultant information. (not limited to drawings, legends, schedules, specifications)

Check all dimensions and site conditions prior to commencement of any work and the procurement of any services, materials, fittings, fabrication or equipment.

Do not scale drawings – refer to figured drawings only. Any discrepancies shall immediately be referred to the Landscape Architect for clarification.

All drawings shall not be reproduced or distributed without prior permission of the Landscape Architect.


**WARNING**

DIAL BEFORE YOU DIG www.1100.com.au

Services shown on this drawing are approximate only. The exact location is to be confirmed on site by contractor prior to commencement of work.

| DATE | REV | AMENDMENTS |
|---|---|---|
| 29/3/19 | A | 90% DD - FOR INFORMATION |

KEY PLAN

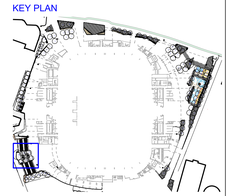

NSW GOVERNMENT Planning, Industry & Environment

*Issued under the Environmental Planning and Assessment Act 1979*

Approved Application No: SSD-9835 Signed:

Granted on the: 6 Dec 2019 Sheet No: 37 of 83


ASPECT Studios™

**ASPECT Studios Pty Ltd**
Level 1, 79-80 George Street
Redfern NSW 2016
Australia
T 02 9699 7182
www.aspect-studios.com
sydney@aspect-studios.com
ABN 11 120 219 561


CLIENT

we are insw Infrastructure New South Wales

PROJECT

SYDNEY FOOTBALL STADIUM
Moore Park, New South Wales

S18030

DRAWING

DETAIL PLANS
Ground Level - South West Detail Plan

| DRAWN | CHECKED | SCALE A0 \| SCALE A2 |
|---|---|---|
| JR \| DC | JH | 1:100 1:200 |

0 2.5 5 7.5 M

STATUS


FOR INFORMATION
NOT FOR CONSTRUCTION

NORTH

DRAWING NO. LA-505


REVISION A

05_PRODUCTION\02_Phase 02 (SSDA)\01_CAD\18030_LA_501 [Ground - Detail Plans].vwx

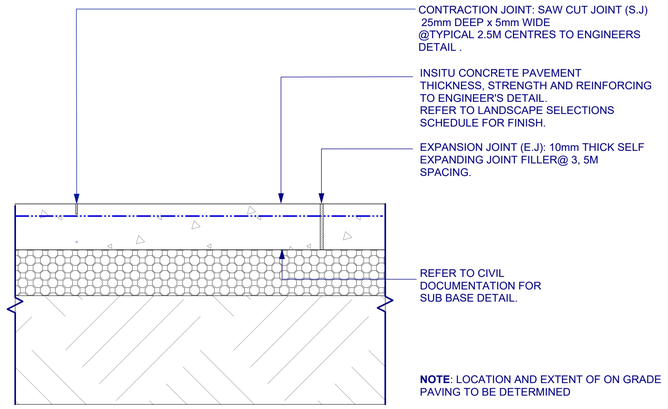



1 PAVING TYPE 1A - INSITU CONCRETE ON GRADE
1:10 SECTION

PV1.1 PV1.2 PV1.3

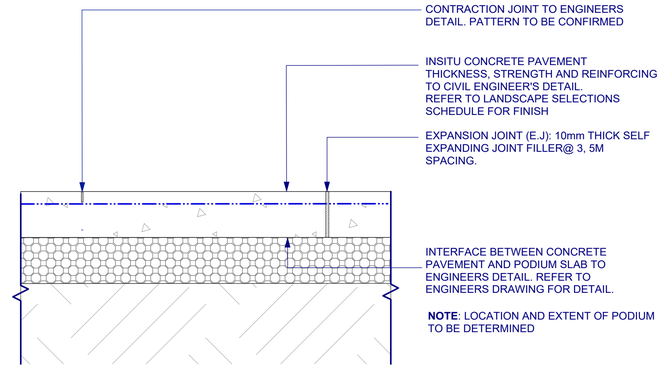


2 PAVING TYPE 1B - INSITU CONCRETE ON PODIUM
1:10 SECTION

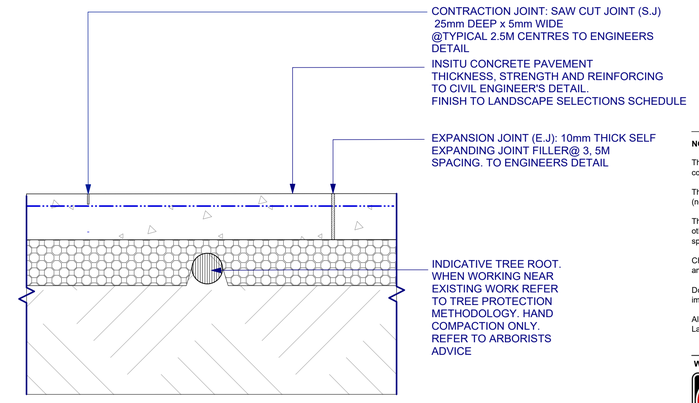


3 PAVING TYPE 1C - INSITU CONCRETE ON EXISTING TREE ROOTS
1:10 SECTION

**NOTES:**
PAVING DETAILS TO BE REVIEWED BY CIVIL ENGINEER
ALL PATTERN AND COLOUR ARRANGEMENTS TO FUTURE DETAIL

**NOTES**

These drawings are shown in colour and shall be read in digital format or print colour hardcopy.

These drawings shall be read in conjunction with all relevant information (not limited to legends, schedules, specifications)

These drawings shall be read in conjunction with any Engineers, Architects or other consultant information. (not limited to drawings, legends, schedules, specifications)

Check all dimensions and site conditions prior to commencement of any work and the procurement of any services, materials, fittings, fabrication or equipment.

Do not scale drawings – refer to figured drawings only. Any discrepancies shall immediately be referred to the Landscape Architect for clarification.

All drawings shall not be reproduced or distributed without prior permission of the Landscape Architect.

**WARNING**

DIAL BEFORE YOU DIG www.1100.com.au®

Services shown on this drawing are approximate only. The exact location is to be confirmed on site by contractor prior to commencement of work.

| DATE | REV | AMENDMENTS |
|---|---|---|
| 28/2/19 | A | END OF FEBRUARY PACKAGE - FOR INFORMATION |
| 29/3/19 | B | 60% DD - FOR INFORMATION |
| 24/7/19 | C | REVISED TENDER - FOR INFORMATION |

NSW GOVERNMENT | Planning, Industry & Environment

*Issued under the Environmental Planning and Assessment Act 1979*

Approved Application No: SSD-9835 Signed:

Granted on the: 6 Dec 2019 Sheet No: 38 of 83

ASPECT Studios™
**ASPECT Studios Pty Ltd**
Level 1, 78-80 George Street
Redfern NSW 2016
Australia
T 02 9699 7182
www.aspect-studios.com
sydney@aspect-studios.com
ABN 11 120 219 561

CLIENT
we are insw Infrastructure New South Wales

PROJECT
SYDNEY FOOTBALL STADIUM
Moore Park, New South Wales
S18030

DRAWING
HARDWORKS DETAILS
Concrete Finishes


| DRAWN | CHECKED | SCALE A1 \| SCALE A3 |
|---|---|---|
| JR \| DC | JH | |

STATUS NORTH


FOR INFORMATION
NOT FOR CONSTRUCTION

DRAWING NO. REVISION
LA-601 C


05_PRODUCTION\02_Phase 02 (SSDA)\01_CAD\

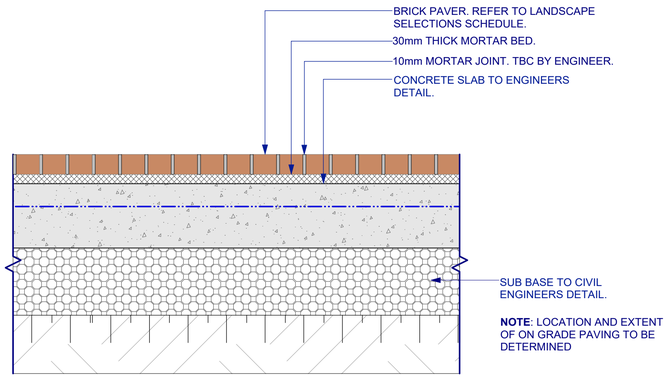



1 PAVEMENT TYPE 2A -BRICK PAVING ON GRADE
1:10 SECTION PV2.1 PV2.2 PV2.3

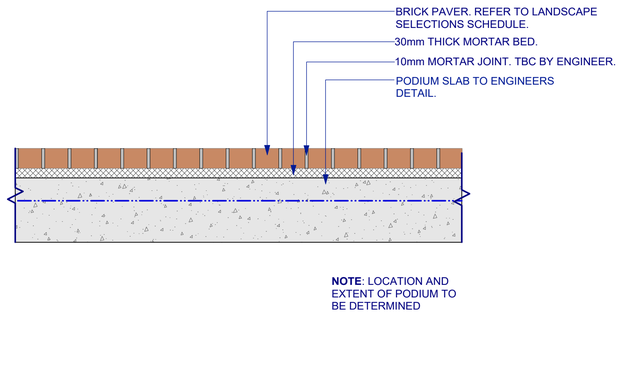



2 PAVEMENT TYPE 2B - BRICK PAVING ON PODIUM
1:10 SECTION PV2.1 PV2.2 PV2.3

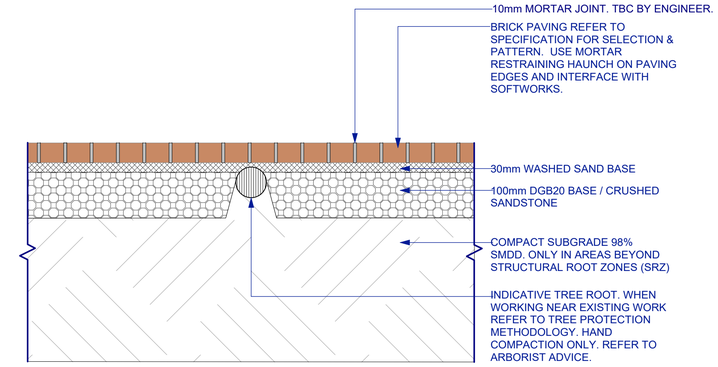



3 PAVEMENT TYPE 2C - BRICK PAVING ON EXISTING TREE ROOTS
1:10 SECTION PV2.1 PV2.2 PV2.3 .PV3

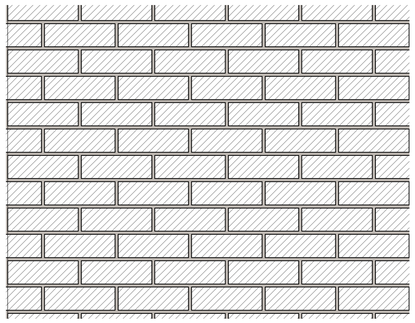


4 PAVEMENT TYPE 2.1 - BRICK PAVING | STRETCHER BOND PATTERN
1:10 PLAN PV2.1

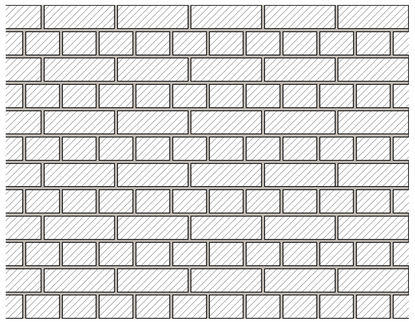

5 PAVEMENT TYPE 2.2 -BRICK PAVING | ENGLISH BOND PATTERN
1:10 PLAN PV2.2

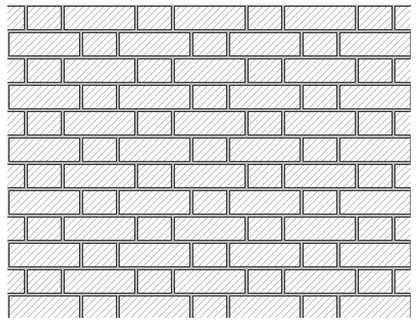

8 PAVEMENT TYPE 2.3 - BRICK PAVING | FLEMISH BOND PATTERN
1:10 PLAN PV2.3

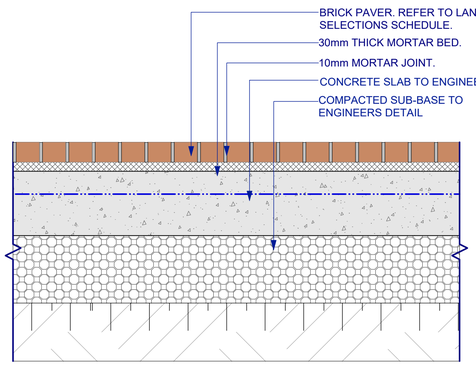


7 PAVEMENT TYPE 3 | BRICK PAVING | MOORE PARK ROAD | CITY OF SYDNEY STANDARD
1:10 SECTION PV3

**NOTES:**
PAVING DETAILS TO BE REVIEWED BY CIVIL ENGINEER
ALL PATTERN AND COLOUR ARRANGEMENTS TO FUTURE DETAIL

**NOTES**

These drawings are shown in colour and shall be read in digital format or print colour hardcopy.

These drawings shall be read in conjunction with all relevant information (not limited to legends, schedules, specifications)

These drawings shall be read in conjunction with any Engineers, Architects or other consultant information. (not limited to drawings, legends, schedules, specifications)

Check all dimensions and site conditions prior to commencement of any work and the procurement of any services, materials, fittings, fabrication or equipment.

Do not scale drawings – refer to figured drawings only. Any discrepancies shall immediately be referred to the Landscape Architect for clarification.

All drawings shall not be reproduced or distributed without prior permission of the Landscape Architect.

**WARNING**

DIAL BEFORE YOU DIG www.1100.com.au®

Services shown on this drawing are approximate only. The exact location is to be confirmed on site by contractor prior to commencement of work.

| DATE | REV | AMENDMENTS |
|---|---|---|
| 28/2/19 | A | END OF FEBRUARY PACKAGE - FOR INFORMATION |
| 29/3/19 | B | 60% DD - FOR INFORMATION |
| 24/7/19 | C | REVISED TENDER - FOR INFORMATION |

NSW GOVERNMENT | Planning, Industry & Environment

*Issued under the Environmental Planning and Assessment Act 1979*

Approved Application No: SSD-9835 Signed:

Granted on the: 6 Dec 2019 Sheet No: 39 of 83

ASPECT Studios™
**ASPECT Studios Pty Ltd**
Level 1, 78-80 George Street
Redfern NSW 2016
Australia
T 02 9699 7182
www.aspect-studios.com
sydney@aspect-studios.com
ABN 11 120 219 561

CLIENT
we are NSW Infrastructure New South Wales

PROJECT
SYDNEY FOOTBALL STADIUM
Moore Park, New South Wales
S18030


DRAWING
HARDWORKS DETAILS
Brick Finishes

| DRAWN | CHECKED | SCALE A1 \| SCALE A3 |
|---|---|---|
| JR \| DC | JH | |


STATUS NORTH

FOR INFORMATION
NOT FOR CONSTRUCTION


DRAWING NO. REVISION
LA-602 C

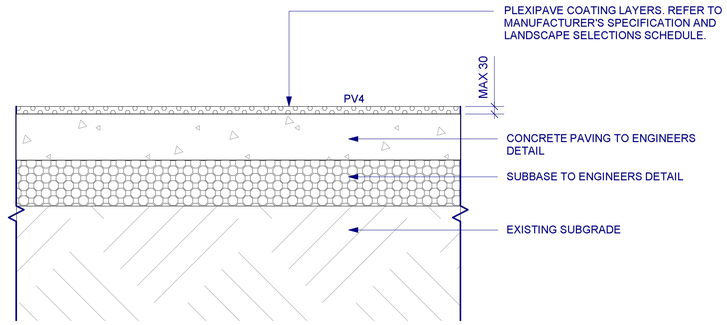



1 PAVEMENT TYPE 4 | PLEXIPAVE SURFACING AND LINEMARKING
1:10 SECTION PV4

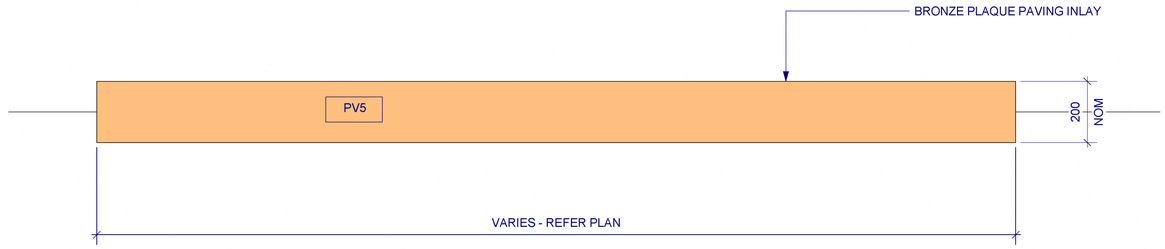


4 PAVEMENT TYPE 5 | INTERPRETIVE PAVING INLAY
1:10 PLAN PV5

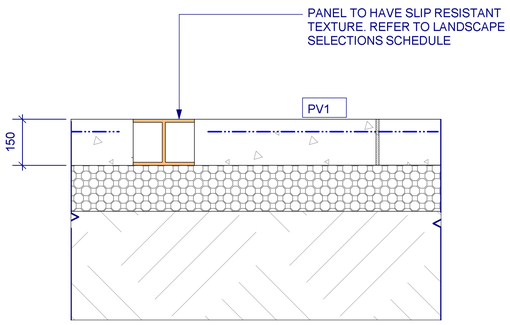


3 PAVEMENT TYPE 5 | INTERPRETIVE PAVING INLAY INTO CONCRETE
1:10 SECTION PV6

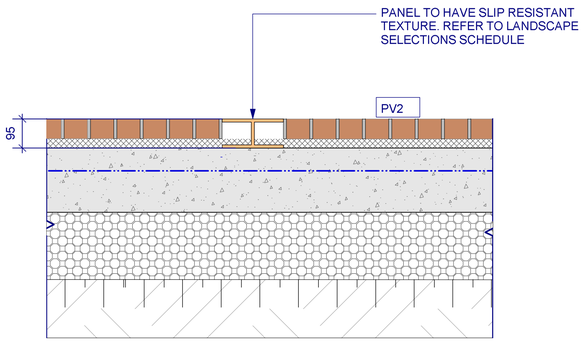


5 PAVEMENT TYPE 5 | INTERPRETIVE PAVING INLAY | INTO BRICK PAVING
1:10 SECTION PV6

**NOTES:**
PAVING DETAILS TO BE REVIEWED BY CIVIL ENGINEER
ALL PATTERN AND COLOUR ARRANGEMENTS TO FUTURE DETAIL

**NOTES**

These drawings are shown in colour and shall be read in digital format or print colour hardcopy.

These drawings shall be read in conjunction with all relevant information (not limited to legends, schedules, specifications)

These drawings shall be read in conjunction with any Engineers, Architects or other consultant information. (not limited to drawings, legends, schedules, specifications)

Check all dimensions and site conditions prior to commencement of any work and the procurement of any services, materials, fittings, fabrication or equipment.

Do not scale drawings – refer to figured drawings only. Any discrepancies shall immediately be referred to the Landscape Architect for clarification.

All drawings shall not be reproduced or distributed without prior permission of the Landscape Architect.

**WARNING**

DIAL BEFORE YOU DIG www.1100.com.au®
Services shown on this drawing are approximate only. The exact location is to be confirmed on site by contractor prior to commencement of work.

| DATE | REV | AMENDMENTS |
|---|---|---|
| 28/2/19 | A | END OF FEBRUARY PACKAGE - FOR INFORMATION |
| 29/3/19 | B | 60% DD - FOR INFORMATION |
| 24/7/19 | C | REVISED TENDER - FOR INFORMATION |

NSW GOVERNMENT | Planning, Industry & Environment

*Issued under the Environmental Planning and Assessment Act 1979*

Approved Application No: SSD-9835 Signed:

Granted on the: 6 Dec 2019 Sheet No: 40 of 83

**ASPECT Studios™**
**ASPECT Studios Pty Ltd**
Level 1, 78-80 George Street
Redfern NSW 2016
Australia
T 02 9699 7182
www.aspect-studios.com
sydney@aspect-studios.com
ABN 11 120 219 561

CLIENT
we are insw Infrastructure New South Wales

PROJECT
SYDNEY FOOTBALL STADIUM
Moore Park, New South Wales
S18030

DRAWING
HARDWORKS DETAILS
Ancillary Paving


| DRAWN | CHECKED | SCALE A1 \| SCALE A3 |
|---|---|---|
| JR \| DC | JH | 1:100 1:200 |

0 2.5 5 7.5 M


STATUS NORTH

FOR INFORMATION
NOT FOR CONSTRUCTION


DRAWING NO. REVISION
LA-603 C

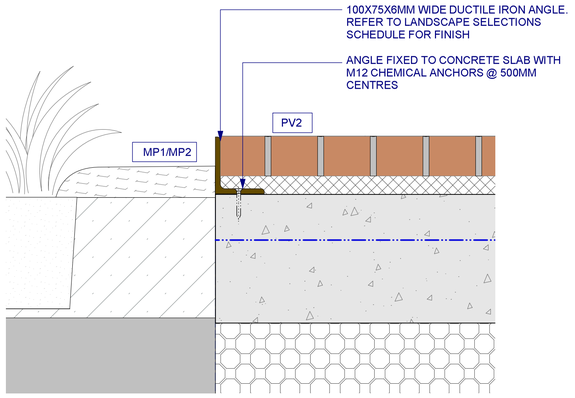


1 EDGE TYPE 1 | STEEL EDGE TO MASS PLANTING E1
1:10 SECTION

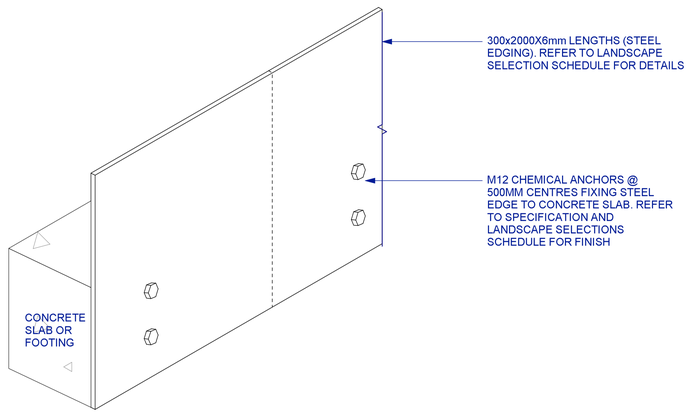


2 EDGE TYPE 2 | EXPRESSED STEEL EDGE E2
NTS ORTHOGONAL

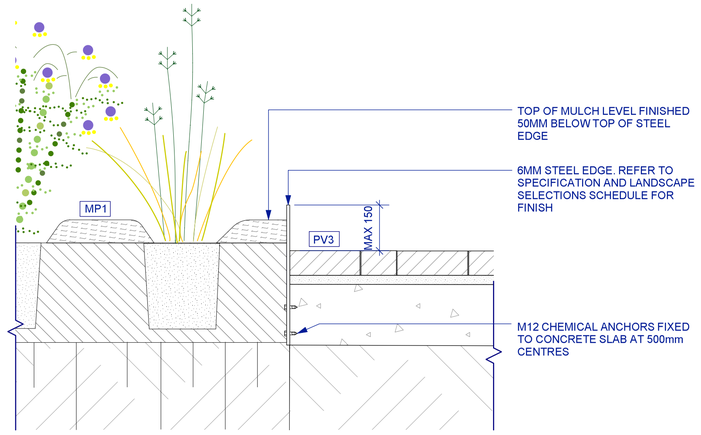


3 EDGE TYPE 2 | EXPRESSED STEEL EDGE TO BRICK PAVING JUNCTION E2
1:10 SECTION

**NOTES**

These drawings are shown in colour and shall be read in digital format or print colour hardcopy.

These drawings shall be read in conjunction with all relevant information (not limited to legends, schedules, specifications)

These drawings shall be read in conjunction with any Engineers, Architects or other consultant information. (not limited to drawings, legends, schedules, specifications)

Check all dimensions and site conditions prior to commencement of any work and the procurement of any services, materials, fittings, fabrication or equipment.

Do not scale drawings – refer to figured drawings only. Any discrepancies shall immediately be referred to the Landscape Architect for clarification.

All drawings shall not be reproduced or distributed without prior permission of the Landscape Architect.

**WARNING**

DIAL BEFORE YOU DIG www.1100.com.au®

Services shown on this drawing are approximate only. The exact location is to be confirmed on site by contractor prior to commencement of work.

| DATE | REV | AMENDMENTS |
|---|---|---|
| 28/2/19 | A | END OF FEBRUARY PACKAGE - FOR INFORMATION |
| 29/3/19 | B | 60% DD - FOR INFORMATION |
| 24/7/19 | C | REVISED TENDER - FOR INFORMATION |




4 EDGE TYPE 3 | STEEL EDGE TO MASS PLANTING E3
1:10 SECTION




5 EDGE TYPE 4 | FEATURE EDGE E4
1:5 SECTION




6 SPIGOT FIXING
1:5 SECTION




7 TYPICAL INFILL PIT LID
1:10 SECTION

NSW GOVERNMENT | Planning, Industry & Environment

*Issued under the Environmental Planning and Assessment Act 1979*

Approved Application No: SSD-9835 Signed:

Granted on the: 6 Dec 2019 Sheet No: 41 of 83


**ASPECT Studios™**

**ASPECT Studios Pty Ltd**
Level 1, 78-80 George Street
Redfern NSW 2016
Australia
T 02 9699 7182
www.aspect-studios.com
sydney@aspect-studios.com
ABN 11 120 219 561


CLIENT

we are insw Infrastructure New South Wales

PROJECT

SYDNEY FOOTBALL STADIUM
Moore Park, New South Wales
S18030

DRAWING

HARDWORKS DETAILS
Edges


| DRAWN | CHECKED | SCALE A1 \| SCALE A3 |
|---|---|---|
| JR \| DC | JH | |

STATUS NORTH


FOR INFORMATION
NOT FOR CONSTRUCTION

DRAWING NO. REVISION

LA-604 C

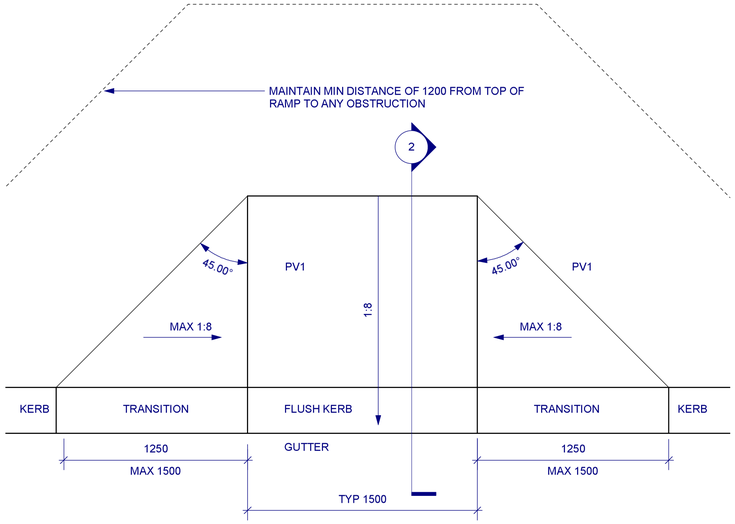


1 PRAM RAMP TYPE 1 | CONCRETE PRAM RAMP
1:20 PLAN PR1

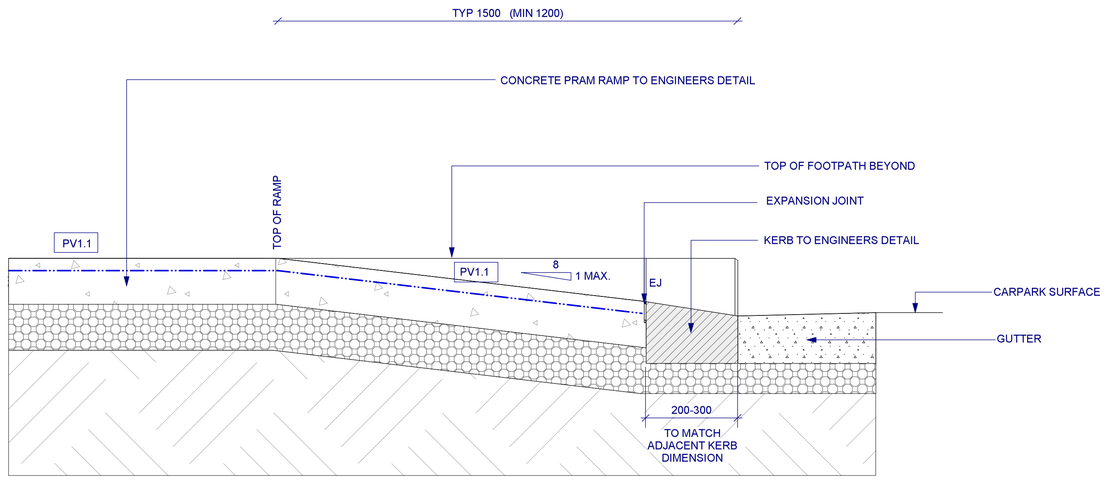


2 PRAM RAMP TYPE 1 | CONCRETE PRAM RAMP
1:10 SECTION PR1

**NOTES:**
PAVING DETAILS TO BE REVIEWED BY CIVIL ENGINEER

**NOTES**

These drawings are shown in colour and shall be read in digital format or print colour hardcopy.

These drawings shall be read in conjunction with all relevant information (not limited to legends, schedules, specifications)

These drawings shall be read in conjunction with any Engineers, Architects or other consultant information. (not limited to drawings, legends, schedules, specifications)

Check all dimensions and site conditions prior to commencement of any work and the procurement of any services, materials, fittings, fabrication or equipment.

Do not scale drawings – refer to figured drawings only. Any discrepancies shall immediately be referred to the Landscape Architect for clarification.

All drawings shall not be reproduced or distributed without prior permission of the Landscape Architect.

**WARNING**

DIAL BEFORE YOU DIG www.1100.com.au®

Services shown on this drawing are approximate only. The exact location is to be confirmed on site by contractor prior to commencement of work.


| DATE | REV | AMENDMENTS |
|---|---|---|
| 28/2/19 | A | END OF FEBRUARY PACKAGE - FOR INFORMATION |
| 29/3/19 | B | 60% DD - FOR INFORMATION |
| 24/7/19 | C | REVISED TENDER - FOR INFORMATION |

NSW GOVERNMENT | Planning, Industry & Environment

*Issued under the Environmental Planning and Assessment Act 1979*

Approved Application No: SSD-9835 Signed:

Granted on the: 6 Dec 2019 Sheet No: 42 of 83

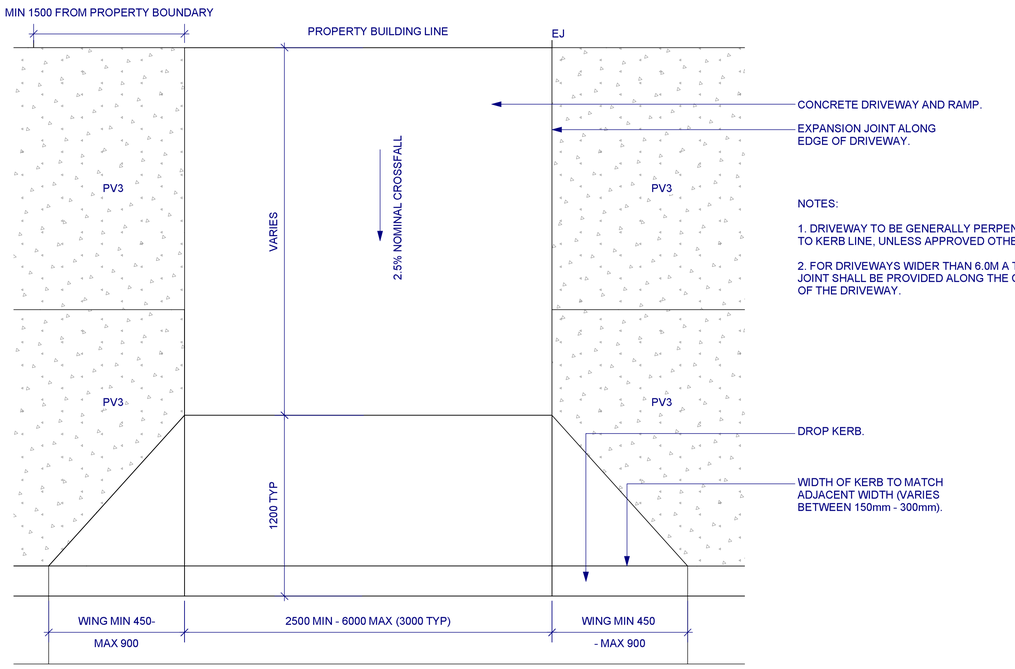



NOTES:

1. DRIVEWAY TO BE GENERALLY PERPENDICULAR TO KERB LINE, UNLESS APPROVED OTHERWISE.

2. FOR DRIVEWAYS WIDER THAN 6.0M A TOOL JOINT SHALL BE PROVIDED ALONG THE CENTRE OF THE DRIVEWAY.

3 VEHICULAR CROSSING | CONCRETE | CITY OF SYDNEY STANDARD
1:20 PLAN VD

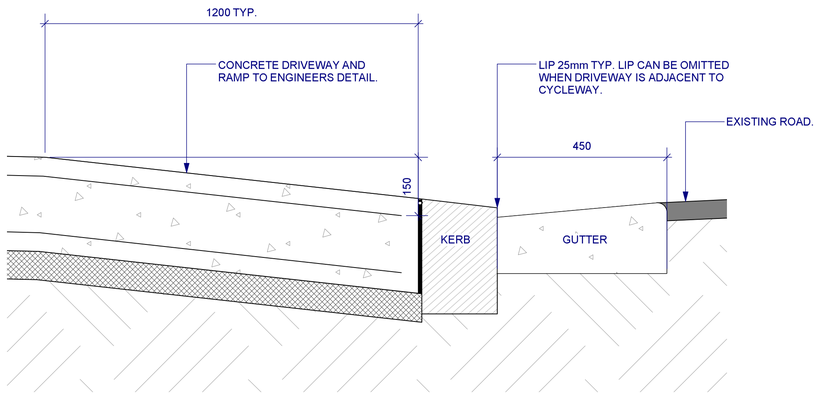


4 VEHICULAR CROSSING | CONCRETE | CITY OF SYDNEY STANDARD
1:20 SECTION VD


ASPECT Studios™
ASPECT Studios Pty Ltd
Level 1, 78-80 George Street
Redfern NSW 2016
Australia
T 02 9699 7182
www.aspect-studios.com
sydney@aspect-studios.com
ABN 11 120 219 561


CLIENT
we are insw Infrastructure New South Wales

PROJECT
SYDNEY FOOTBALL STADIUM
Moore Park, New South Wales
S18030

DRAWING
HARDWORKS DETAILS
Kerbs and Ramps


| DRAWN | CHECKED | SCALE A1 \| SCALE A3 |
|---|---|---|
| JR \| DC | JH | |


STATUS NORTH

FOR INFORMATION
NOT FOR CONSTRUCTION

DRAWING NO. REVISION

LA-605 C

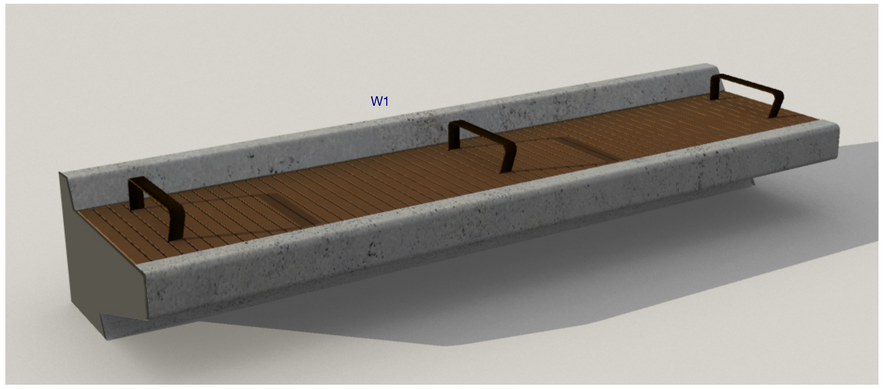


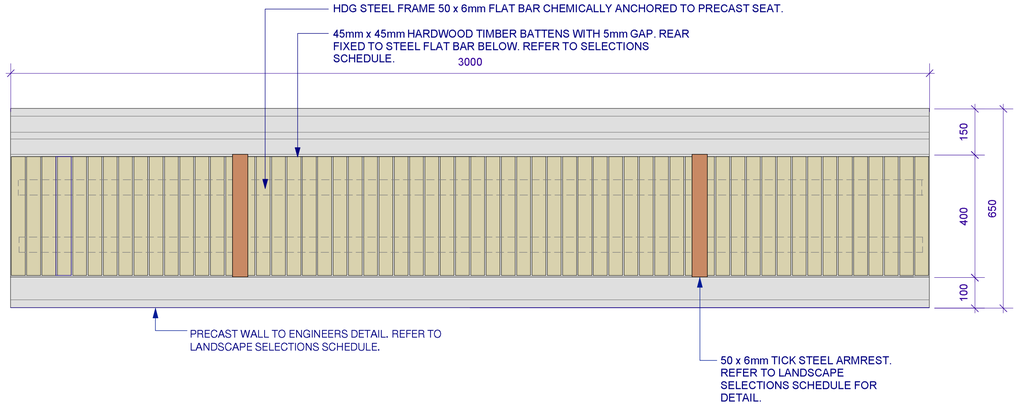




1 WALL TYPE 1 - PRECAST CONCRETE WALL WITH INTEGRATED TIMBER BENCH
NTS PERSPECTIVE

2 WALL TYPE 1 - PRECAST CONCRETE WALL WITH INTEGRATED TIMBER BENCH
1:10 PLAN W1A

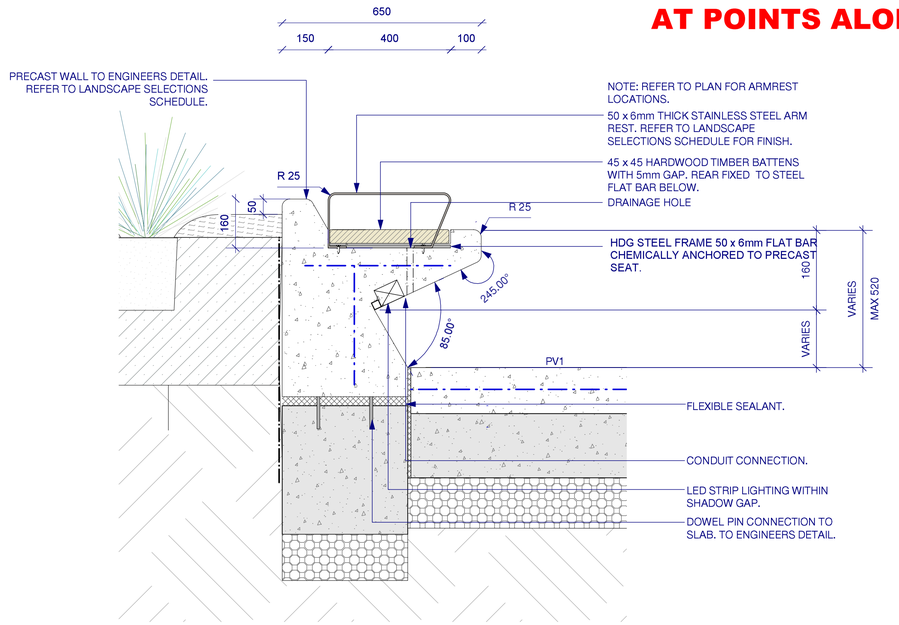
**TO BE UPDATED TO INCORPORATE BACKRESTS AT POINTS ALONG WALL TYPE 1**

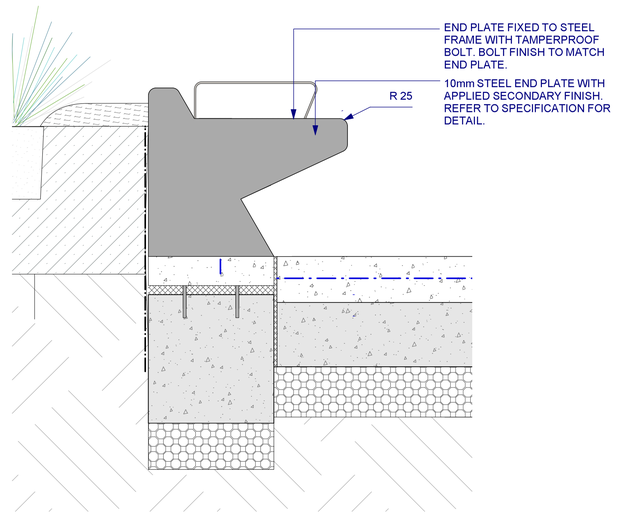


3 WALL TYPE 1 - PRECAST CONCRETE WALL WITH INTEGRATED TIMBER BENCH
1:10 TYPICAL SECTION W1A

4 WALL TYPE 1 - PRECAST CONCRETE WALL WITH INTEGRATED TIMBER BENCH
1:10 TYPICAL ELEVATION W1A

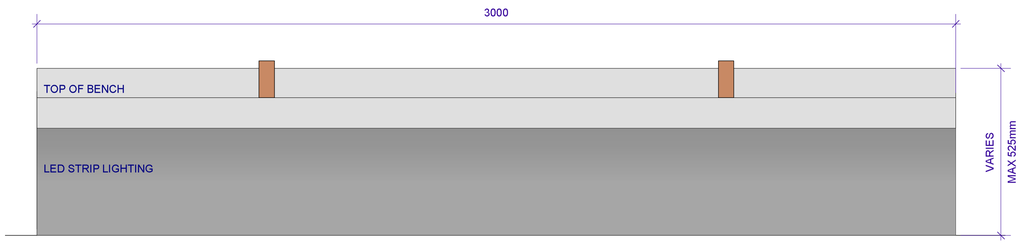


5 WALL TYPE 1 - PRECAST CONCRETE WALL WITH INTEGRATED TIMBER BENCH
1:10 FRONT ELEVATION W1A

**NOTES**

These drawings are shown in colour and shall be read in digital format or print colour hardcopy.

These drawings shall be read in conjunction with all relevant information (not limited to legends, schedules, specifications)

These drawings shall be read in conjunction with any Engineers, Architects or other consultant information. (not limited to drawings, legends, schedules, specifications)

Check all dimensions and site conditions prior to commencement of any work and the procurement of any services, materials, fittings, fabrication or equipment.

Do not scale drawings – refer to figured drawings only. Any discrepancies shall immediately be referred to the Landscape Architect for clarification.

All drawings shall not be reproduced or distributed without prior permission of the Landscape Architect.

**WARNING**

DIAL BEFORE YOU DIG www.1100.com.au®

Services shown on this drawing are approximate only. The exact location is to be confirmed on site by contractor prior to commencement of work.

| DATE | REV | AMENDMENTS |
|---|---|---|
| 28/2/19 | A | END OF FEBRUARY PACKAGE - FOR INFORMATION |
| 29/3/19 | B | 60% DD - FOR INFORMATION |
| 24/7/19 | C | REVISED TENDER - FOR INFORMATION |

NSW GOVERNMENT | Planning, Industry & Environment

*Issued under the Environmental Planning and Assessment Act 1979*

Approved Application No: SSD-9835 Signed:

Granted on the: 6 Dec 2019 Sheet No: 43 of 83

ASPECT Studios™
ASPECT Studios Pty Ltd
Level 1, 78-80 George Street
Redfern NSW 2016
Australia
T 02 9699 7182
www.aspect-studios.com
sydney@aspect-studios.com
ABN 11 120 219 561

CLIENT
we are insw Infrastructure New South Wales

PROJECT
SYDNEY FOOTBALL STADIUM
Moore Park, New South Wales
S18030


DRAWING
HARDWORKS DETAILS
Wall Type 1

| DRAWN | CHECKED | SCALE A1 \| SCALE A3 |
|---|---|---|
| JR \| DC | JH | |


STATUS NORTH

FOR INFORMATION
NOT FOR CONSTRUCTION


DRAWING NO. REVISION
LA-621 C

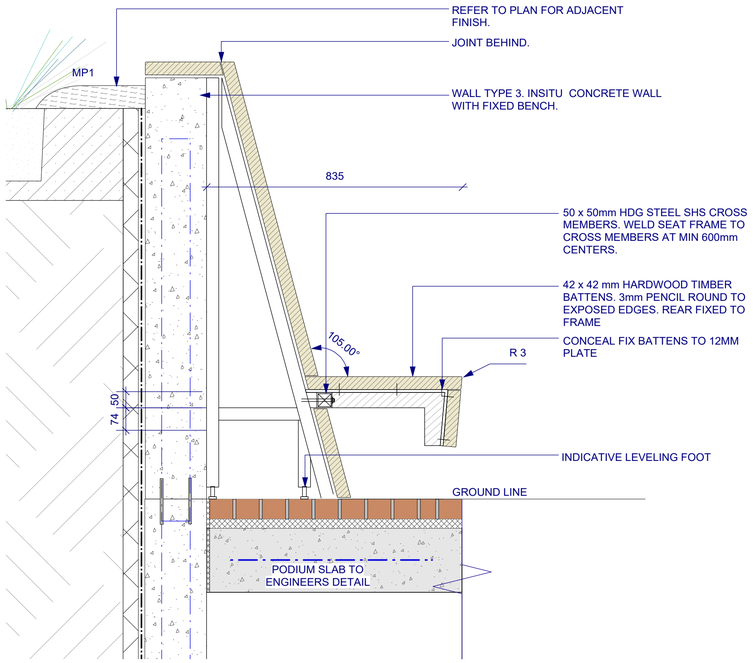



1 WALL TYPE 3 -INSITU CONCRETE WALL WITH FIXED BENCH
1:10 SECTION W3

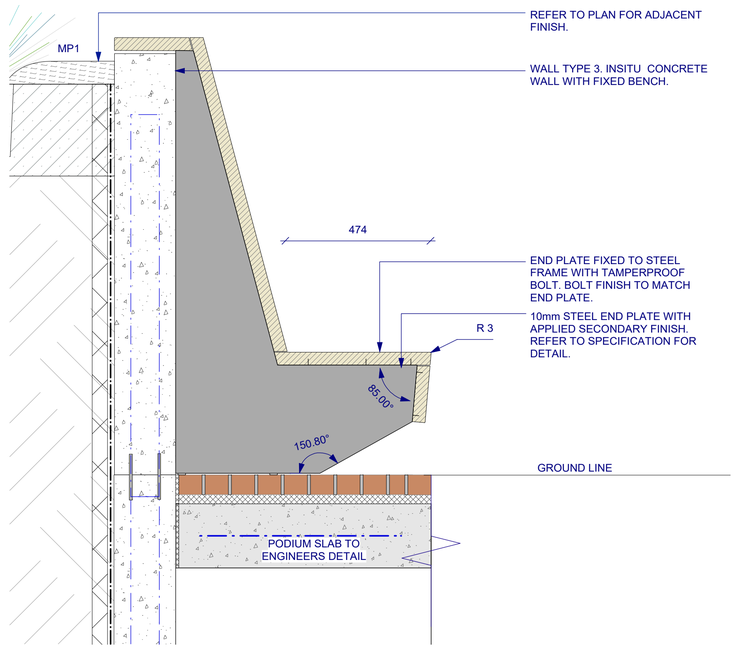


2 WALL TYPE 3 -INSITU CONCRETE WALL WITH FIXED BENCH
1:10 END ELEVATION W3

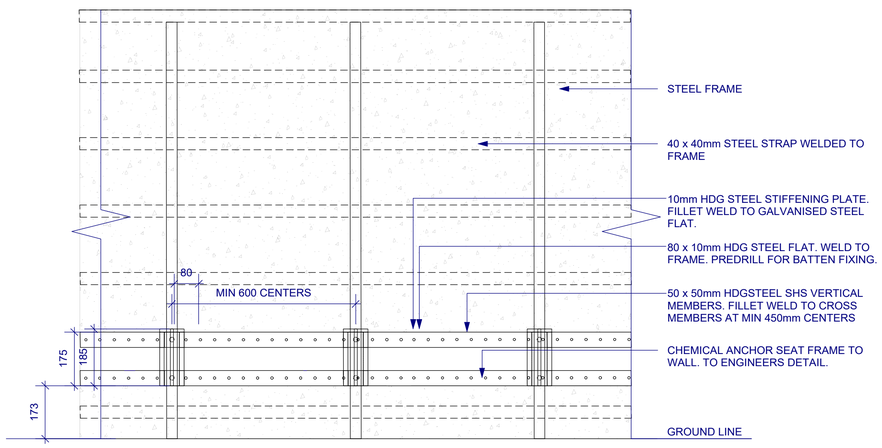


3 WALL TYPE 3 -INSITU CONCRETE WALL - FRAME
1:10 ELEVATION W3

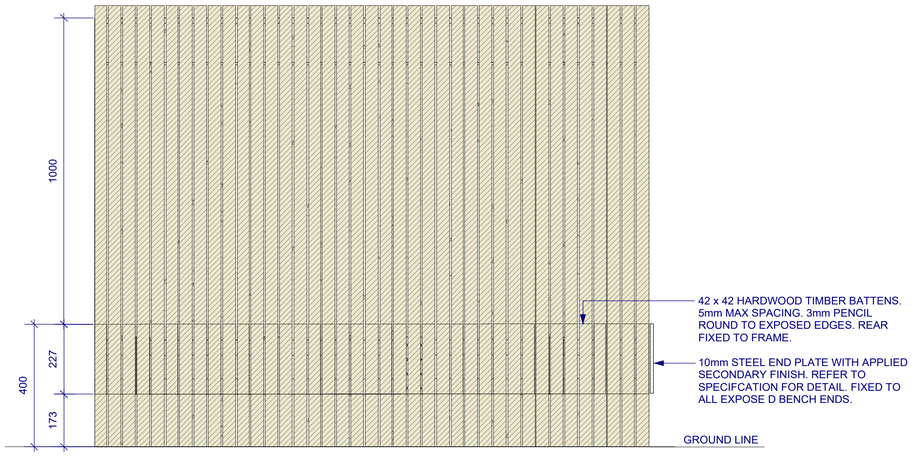


4 WALL TYPE 3 -INSITU CONCRETE WALL - TIMBER
1:10 ELEVATION W3

**NOTES**

These drawings are shown in colour and shall be read in digital format or print colour hardcopy.

These drawings shall be read in conjunction with all relevant information (not limited to legends, schedules, specifications)

These drawings shall be read in conjunction with any Engineers, Architects or other consultant information. (not limited to drawings, legends, schedules, specifications)

Check all dimensions and site conditions prior to commencement of any work and the procurement of any services, materials, fittings, fabrication or equipment.

Do not scale drawings – refer to figured drawings only. Any discrepancies shall immediately be referred to the Landscape Architect for clarification.

All drawings shall not be reproduced or distributed without prior permission of the Landscape Architect.

**WARNING**

DIAL BEFORE YOU DIG www.1100.com.au®

Services shown on this drawing are approximate only. The exact location is to be confirmed on site by contractor prior to commencement of work.

| DATE | REV | AMENDMENTS |
|---|---|---|
| 29/3/19 | A | 60% DD - FOR INFORMATION |
| 24/7/19 | B | REVISED TENDER - FOR INFORMATION |
| 8/8/19 | C | REVISED TENDER - FOR INFORMATION |

NSW GOVERNMENT | Planning, Industry & Environment

*Issued under the Environmental Planning and Assessment Act 1979*

Approved Application No: SSD-9835 Signed:

Granted on the: 6 Dec 2019 Sheet No: 44 of 83


ASPECT Studios™

**ASPECT Studios Pty Ltd**
Level 1, 78-80 George Street
Redfern NSW 2016
Australia
T 02 9699 7182
www.aspect-studios.com
sydney@aspect-studios.com
ABN 11 120 219 561


**CLIENT**

we are insw Infrastructure New South Wales

**PROJECT**

SYDNEY FOOTBALL STADIUM
Moore Park, New South Wales
S18030

**DRAWING**

HARDWORKS DETAILS
Walls Type 2 & 6/7


| DRAWN | CHECKED | SCALE A1 \| SCALE A3 |
|---|---|---|
| JR \| DC | JH | |

**STATUS** **NORTH**


FOR INFORMATION
NOT FOR CONSTRUCTION

**DRAWING NO.** **REVISION**


LA-625 C

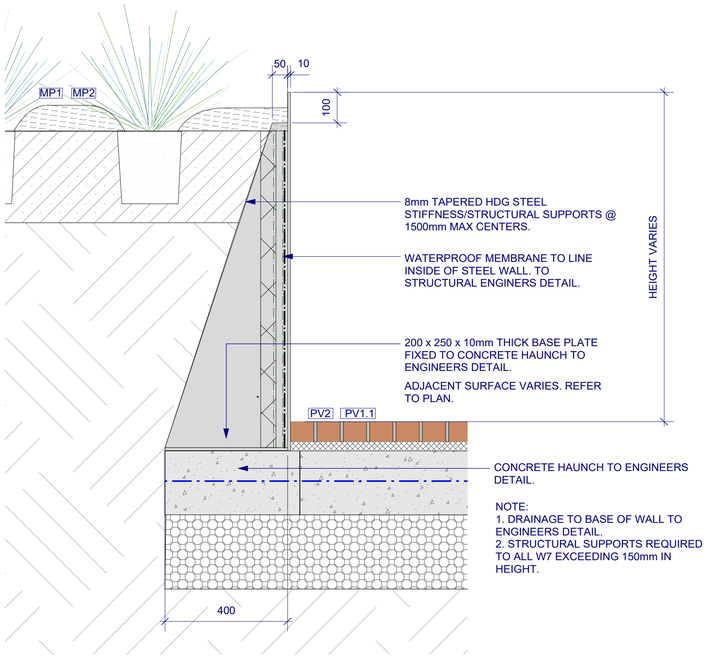



1 WALL TYPE 6/7 - STEEL EDGE STRUCTURAL SUPPORT
1:10 SECTION W6/7

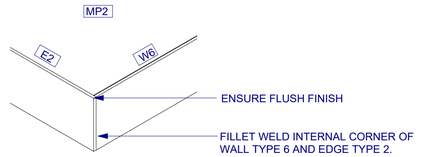



2 W6 - INTERFACE FIXING TO E2
1:10 AXONOMETRIC

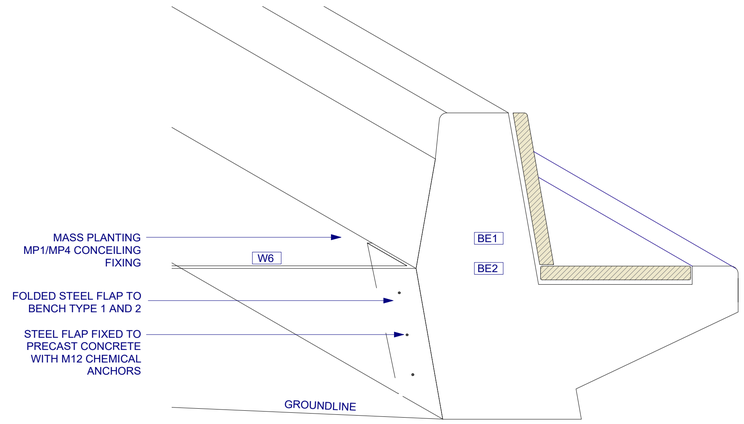


3 W7 - INTERFACE FIXING TO BE1 AND BE2
1:10 AXONOMETRIC

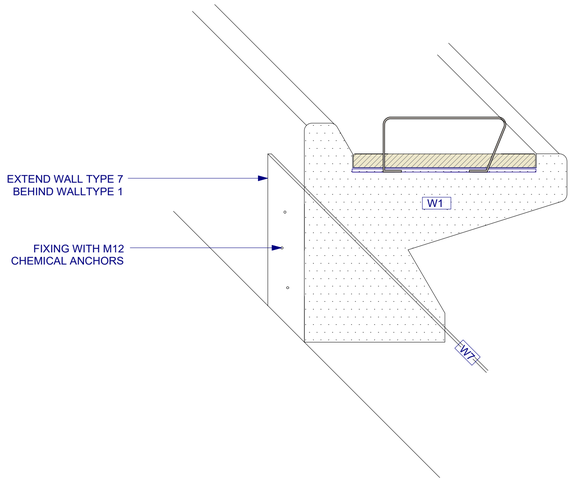


4 W7 - INTERFACE FIXING TO W1 PARALLEL ARRANGEMENT
1:10 AXONOMETRIC

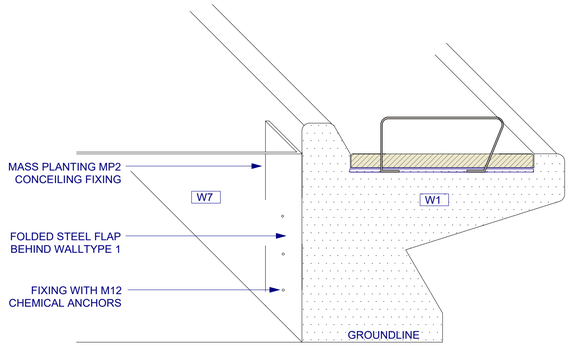


5 W7 - INTERFACE FIXING TO W1 PERPENDICULAR ARRANGEMENT
1:10 AXONOMETRIC

**NOTES**

These drawings are shown in colour and shall be read in digital format or print colour hardcopy.

These drawings shall be read in conjunction with all relevant information (not limited to legends, schedules, specifications)

These drawings shall be read in conjunction with any Engineers, Architects or other consultant information. (not limited to drawings, legends, schedules, specifications)

Check all dimensions and site conditions prior to commencement of any work and the procurement of any services, materials, fittings, fabrication or equipment.

Do not scale drawings – refer to figured drawings only. Any discrepancies shall immediately be referred to the Landscape Architect for clarification.

All drawings shall not be reproduced or distributed without prior permission of the Landscape Architect.

**WARNING**

DIAL BEFORE YOU DIG www.1100.com.au®

Services shown on this drawing are approximate only. The exact location is to be confirmed on site by contractor prior to commencement of work.

| DATE | REV | AMENDMENTS |
|---|---|---|
| 29/3/19 | A | 60% DD - FOR INFORMATION |
| 24/7/19 | B | REVISED TENDER - FOR INFORMATION |

NSW GOVERNMENT | Planning, Industry & Environment

*Issued under the Environmental Planning and Assessment Act 1979*

Approved Application No: SSD-9835 Signed:

Granted on the: 6 Dec 2019 Sheet No: 45 of 83

ASPECT Studios™
ASPECT Studios Pty Ltd
Level 1, 78-80 George Street
Redfern NSW 2016
Australia
T 02 9699 7182
www.aspect-studios.com
sydney@aspect-studios.com
ABN 11 120 219 561

CLIENT
we are insw Infrastructure New South Wales

PROJECT
SYDNEY FOOTBALL STADIUM
Moore Park, New South Wales
S18030


DRAWING
HARDWORKS DETAILS
Walls Type 8 & 10

| DRAWN | CHECKED | SCALE A1 \| SCALE A3 |
|---|---|---|
| JR \| DC | JH | |


STATUS NORTH

FOR INFORMATION
NOT FOR CONSTRUCTION


DRAWING NO. REVISION
LA-626 B

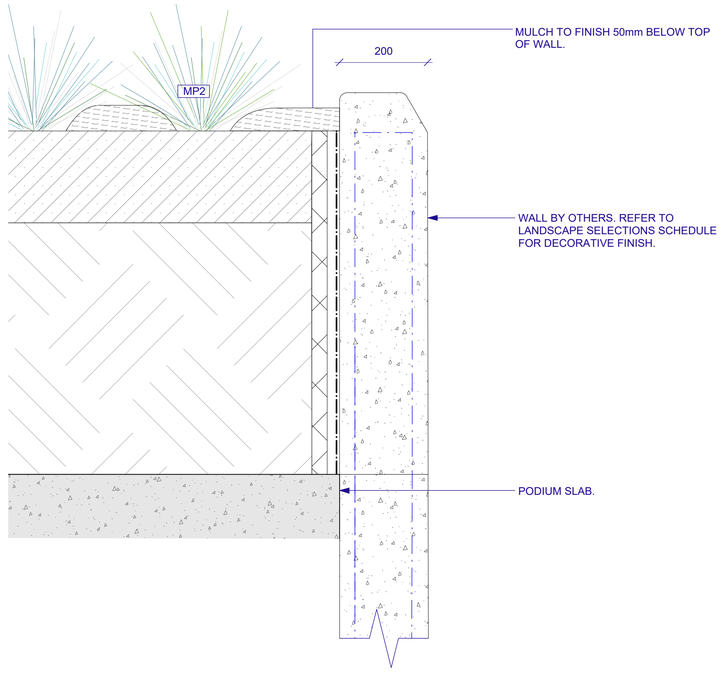


1 WALL TYPE 8.1 -IINSITU CONCRETE WALL (BY OTHERS) W8.1
1:10 SECTION

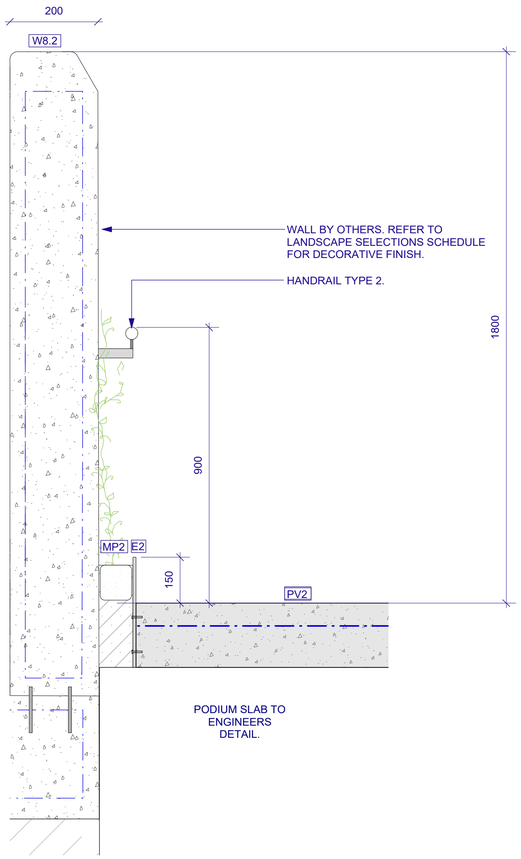


2 WALL TYPE 8.2 -IINSITU CONCRETE WALL (BY OTHERS) W8.2
1:10 SECTION

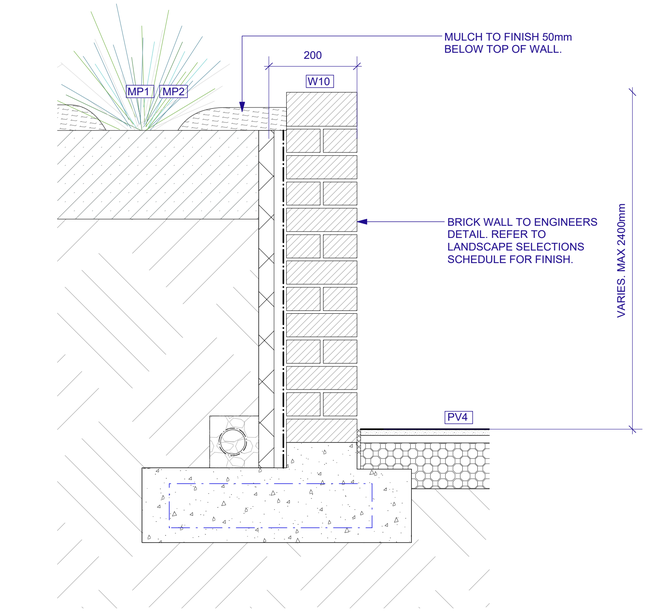


3 WALL TYPE 10 -IINSITU CONCRETE WALL W10
1:10 SECTION

**NOTES**

These drawings are shown in colour and shall be read in digital format or print colour hardcopy.

These drawings shall be read in conjunction with all relevant information (not limited to legends, schedules, specifications)

These drawings shall be read in conjunction with any Engineers, Architects or other consultant information. (not limited to drawings, legends, schedules, specifications)

Check all dimensions and site conditions prior to commencement of any work and the procurement of any services, materials, fittings, fabrication or equipment.

Do not scale drawings – refer to figured drawings only. Any discrepancies shall immediately be referred to the Landscape Architect for clarification.

All drawings shall not be reproduced or distributed without prior permission of the Landscape Architect.

**WARNING**

DIAL BEFORE YOU DIG www.1100.com.au®

Services shown on this drawing are approximate only. The exact location is to be confirmed on site by contractor prior to commencement of work.

| DATE | REV | AMENDMENTS |
|---|---|---|
| 29/3/19 | A | 60% DD - FOR INFORMATION |
| 24/7/19 | B | REVISED TENDER - FOR INFORMATION |

NSW GOVERNMENT | Planning, Industry & Environment

*Issued under the Environmental Planning and Assessment Act 1979*

Approved Application No: SSD-9835 Signed:

Granted on the: 6 Dec 2019 Sheet No: 46 of 83

ASPECT Studios™
**ASPECT Studios Pty Ltd**
Level 1, 78-80 George Street
Redfern NSW 2016
Australia
T 02 9699 7182
www.aspect-studios.com
sydney@aspect-studios.com
ABN 11 120 219 561

**CLIENT**

we are insw Infrastructure New South Wales

**PROJECT**

SYDNEY FOOTBALL STADIUM
Moore Park, New South Wales
S18030

**DRAWING**

HARDWORKS DETAILS
Wall Type 8 & 10


| DRAWN | CHECKED | SCALE A1 \| SCALE A3 |
|---|---|---|
| JR \| DC | JH | |

**STATUS** **NORTH**


FOR INFORMATION
NOT FOR CONSTRUCTION

**DRAWING NO.** **REVISION**


LA-627 B

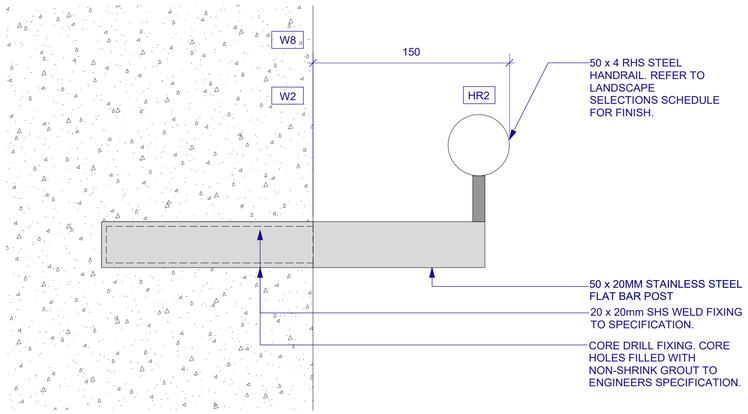


1 HANDRAIL TYPE 2 - HANDRAIL DETAIL
1:10 SECTION HR2

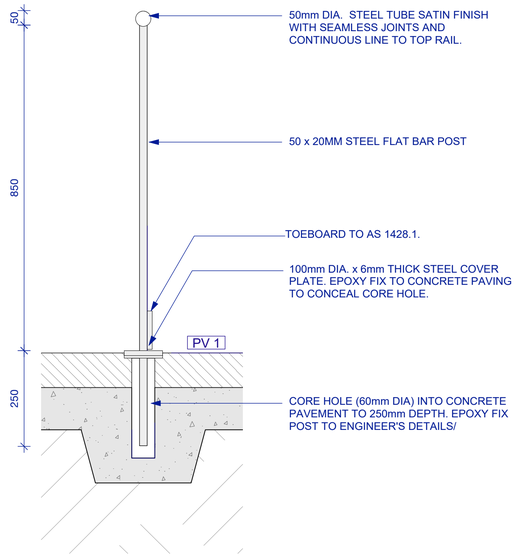


2 HANDRAIL TYPE 3 - FREESTANDING HANDRAIL DETAIL
1:8 SECTION HR3

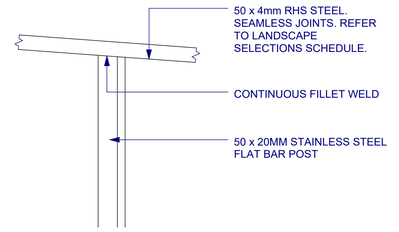


3 HANDRAIL TYPE 3 - FREESTANDING HANDRAIL DETAIL
1:8 SECTION HR3

**NOTES**

These drawings are shown in colour and shall be read in digital format or print colour hardcopy.

These drawings shall be read in conjunction with all relevant information (not limited to legends, schedules, specifications)

These drawings shall be read in conjunction with any Engineers, Architects or other consultant information. (not limited to drawings, legends, schedules, specifications)

Check all dimensions and site conditions prior to commencement of any work and the procurement of any services, materials, fittings, fabrication or equipment.

Do not scale drawings – refer to figured drawings only. Any discrepancies shall immediately be referred to the Landscape Architect for clarification.


All drawings shall not be reproduced or distributed without prior permission of the Landscape Architect.

**WARNING**


DIAL BEFORE YOU DIG www.1100.com.au®

Services shown on this drawing are approximate only. The exact location is to be confirmed on site by contractor prior to commencement of work.

| DATE | REV | AMENDMENTS |
|---|---|---|
| 29/3/19 | A | 60% DD - FOR INFORMATION |
| 24/7/19 | B | REVISED TENDER - FOR INFORMATION |

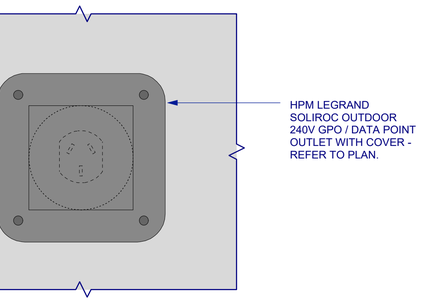


5 GPO | WALL MOUNTED
1:10 ELEVATION GPO

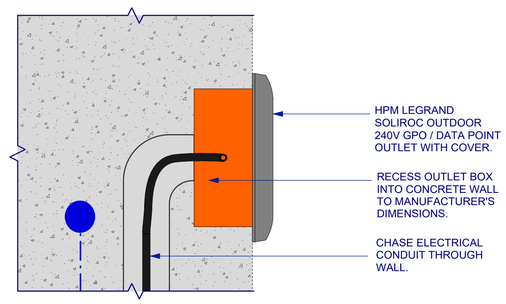


6 GPO | WALL MOUNTED
1:10 SECTION GPO

NSW GOVERNMENT | Planning, Industry & Environment

*Issued under the Environmental Planning and Assessment Act 1979*

Approved Application No: SSD-9835 Signed:

Granted on the: 6 Dec 2019 Sheet No: 47 of 83

**ASPECT Studios™**

**ASPECT Studios Pty Ltd**
Level 1, 78-80 George Street
Redfern NSW 2016
Australia
T 02 9699 7182
www.aspect-studios.com
sydney@aspect-studios.com
ABN 11 120 219 561

**CLIENT**

we are insw Infrastructure New South Wales

**PROJECT**

SYDNEY FOOTBALL STADIUM
Moore Park, New South Wales
S18030

**DRAWING**

HARDWORKS DETAILS
Handrail Details & GPOs


| DRAWN | CHECKED | SCALE A1 \| SCALE A3 |
|---|---|---|
| JR \| DC | JH | |

**STATUS** **NORTH**


FOR INFORMATION
NOT FOR CONSTRUCTION

**DRAWING NO.** **REVISION**


LA-628 B

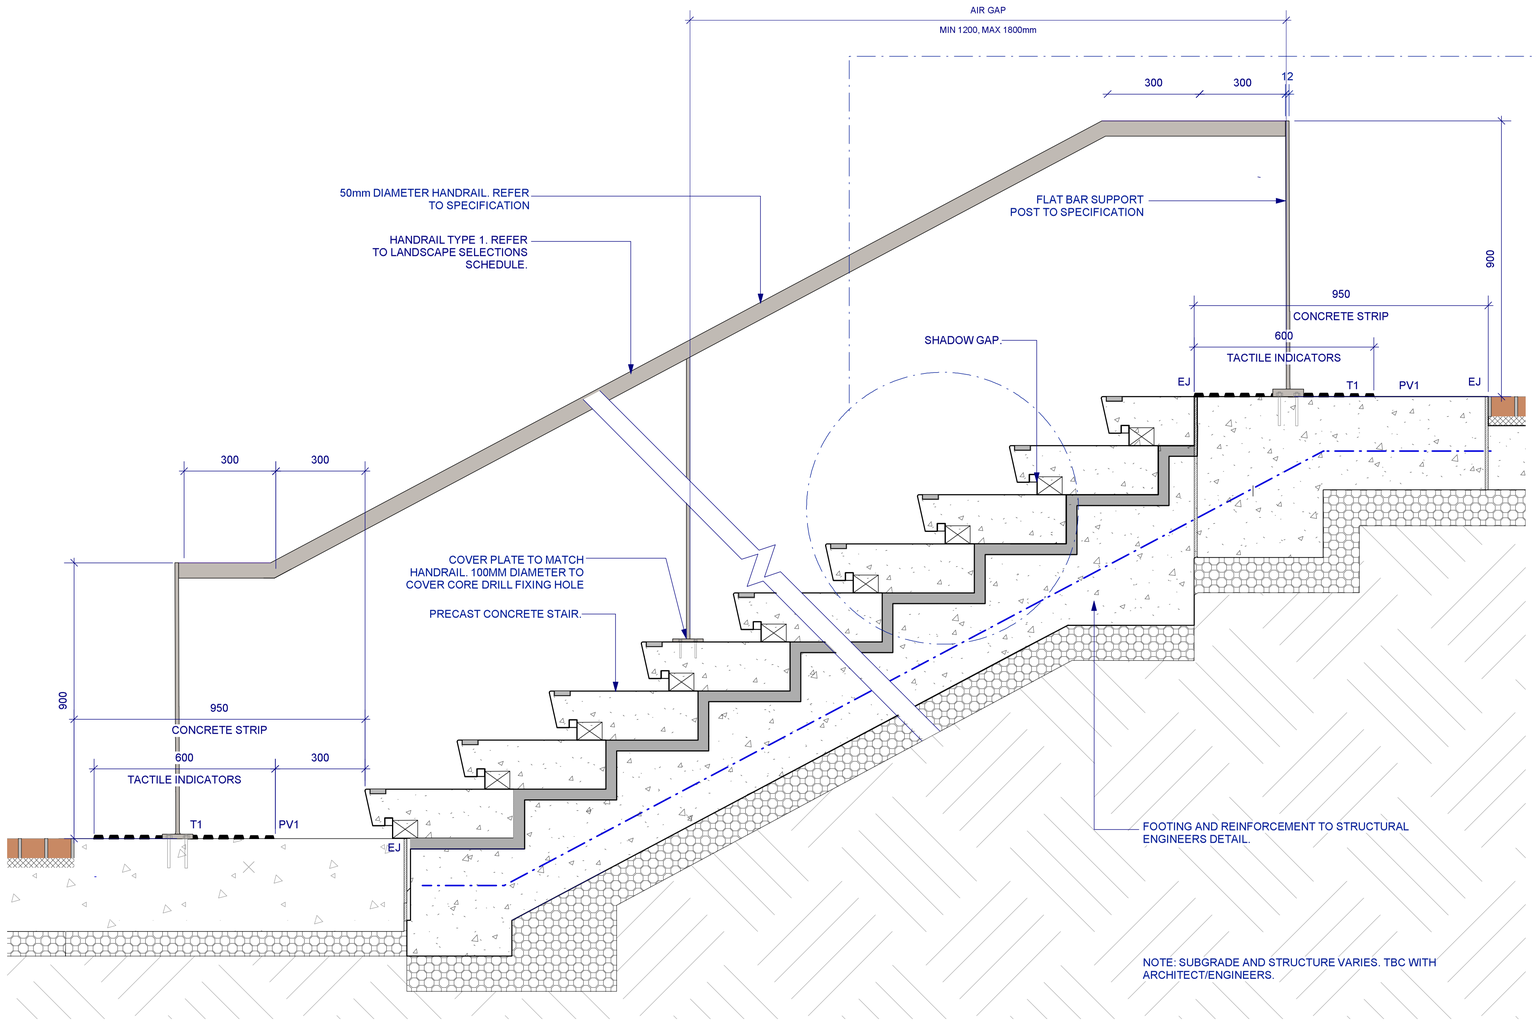



1 STAIR TYPE 1 & HANDRAIL TYPE 1 | TYPICAL DETAIL
1:10
SECTION ST1 HR1

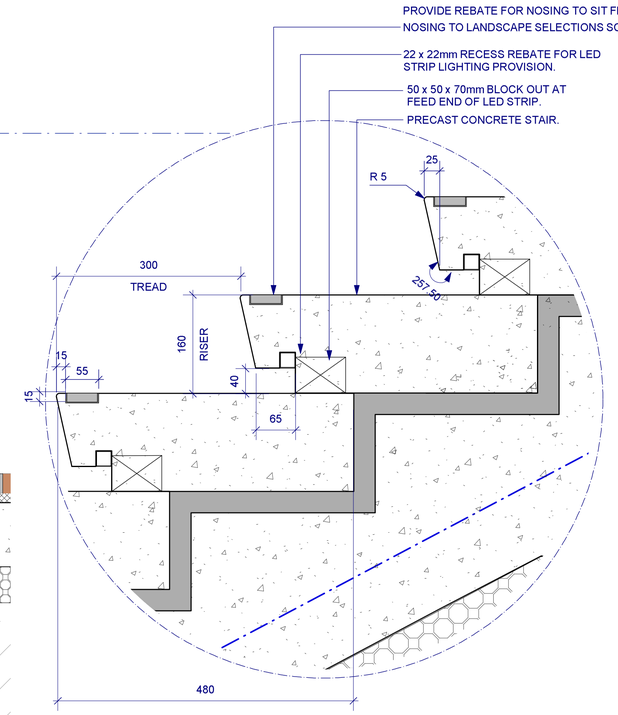



2 STAIR TYPE 1 | TYPICAL VISIBILITY NOSING
1:5

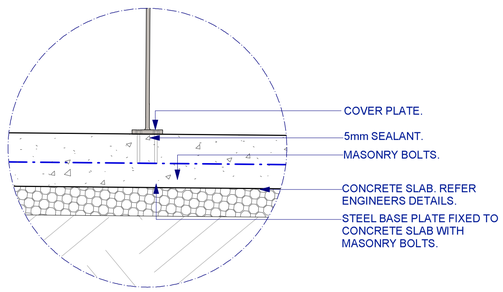


3 HANDRAIL TYPE 1 | POST FIXING
1:10
SECTION

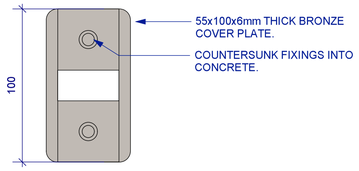


4 HANDRAIL TYPE 1 | POST COVER PLATE
1:2
PLAN

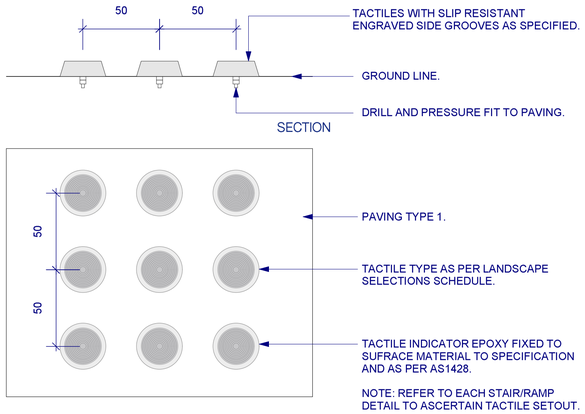


5 TACTILE TYPE 1 | TYPICAL LAYOUT
1:2
PLAN

**NOTES**

These drawings are shown in colour and shall be read in digital format or print colour hardcopy.

These drawings shall be read in conjunction with all relevant information (not limited to legends, schedules, specifications)

These drawings shall be read in conjunction with any Engineers, Architects or other consultant information. (not limited to drawings, legends, schedules, specifications)

Check all dimensions and site conditions prior to commencement of any work and the procurement of any services, materials, fittings, fabrication or equipment.

Do not scale drawings – refer to figured drawings only. Any discrepancies shall immediately be referred to the Landscape Architect for clarification.

All drawings shall not be reproduced or distributed without prior permission of the Landscape Architect.

**WARNING**

DIAL BEFORE YOU DIG www.1100.com.au® Services shown on this drawing are approximate only. The exact location is to be confirmed on site by contractor prior to commencement of work.

| DATE | REV | AMENDMENTS |
|---|---|---|
| 29/3/19 | A | 60% DD - FOR INFORMATION |
| 24/7/19 | B | REVISED TENDER - FOR INFORMATION |
| 8/8/19 | C | REVISED TENDER - FOR INFORMATION |

NSW GOVERNMENT | Planning, Industry & Environment

*Issued under the Environmental Planning and Assessment Act 1979*

Approved Application No: SSD-9835 Signed: A. Coonan

Granted on the: 6 Dec 2019 Sheet No: 48 of 83


ASPECT Studios™
ASPECT Studios Pty Ltd
Level 1, 78-80 George Street
Redfern NSW 2016
Australia
T 02 9699 7182
www.aspect-studios.com
sydney@aspect-studios.com
ABN 11 120 219 561


CLIENT
we are inSW Infrastructure New South Wales

PROJECT
SYDNEY FOOTBALL STADIUM
Moore Park, New South Wales
S18030


DRAWING
HARDWORKS DETAILS
Typical Stair Type 1 Details

| DRAWN | CHECKED | SCALE A1 \| SCALE A3 |
|---|---|---|
| JR \| DC | JH | |


STATUS NORTH

FOR INFORMATION
NOT FOR CONSTRUCTION

DRAWING NO. REVISION
LA-640 C

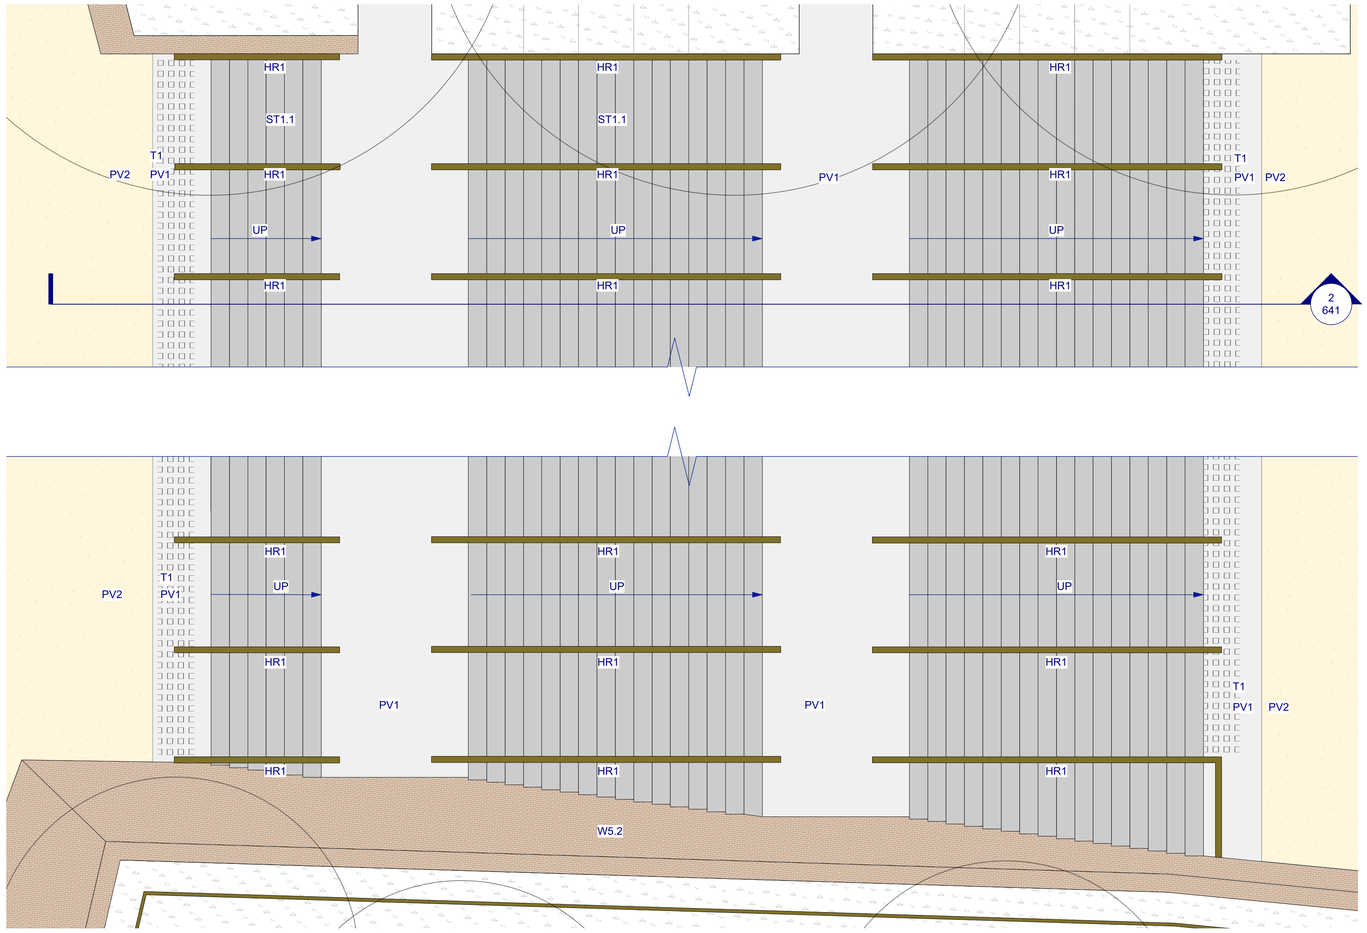


1 STAIR TYPE 1.1- PRECAST CONCRETE| MAIN ENTRANCE | DETAIL PLAN ST1.1
1:50
PLAN

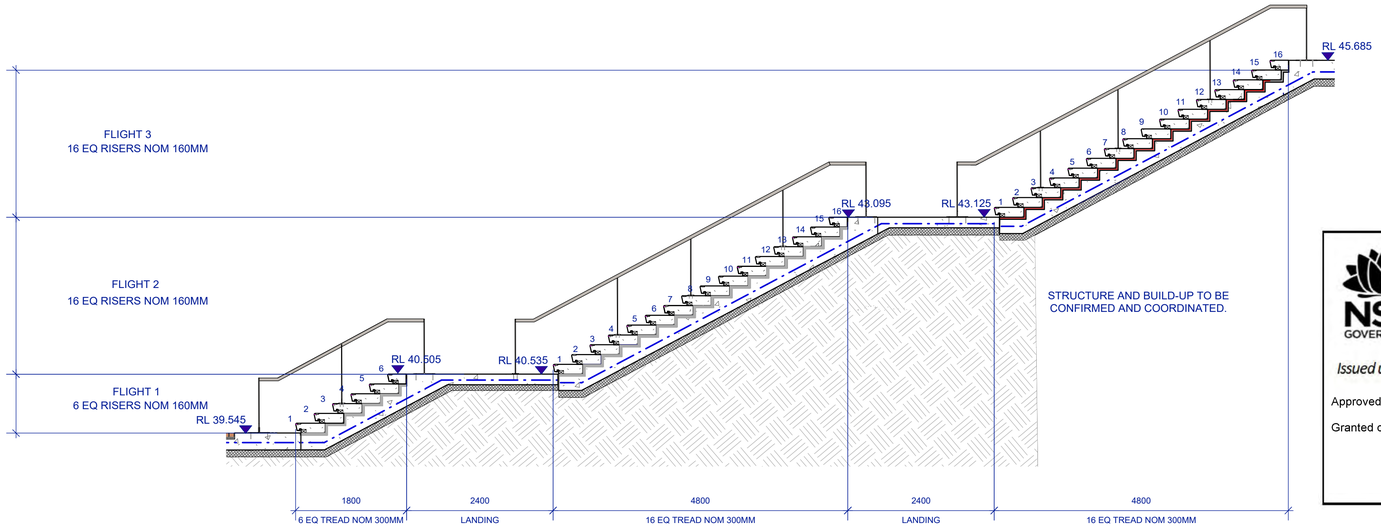


2 STAIR TYPE 1.1- PRECAST CONCRETE| MAIN ENTRANCE | TYPICAL DETAIL ST1.1
1:50
SECTION

**NOTES**

These drawings are shown in colour and shall be read in digital format or print colour hardcopy.

These drawings shall be read in conjunction with all relevant information (not limited to legends, schedules, specifications)

These drawings shall be read in conjunction with any Engineers, Architects or other consultant information. (not limited to drawings, legends, schedules, specifications)

Check all dimensions and site conditions prior to commencement of any work and the procurement of any services, materials, fittings, fabrication or equipment.

Do not scale drawings – refer to figured drawings only. Any discrepancies shall immediately be referred to the Landscape Architect for clarification.


All drawings shall not be reproduced or distributed without prior permission of the Landscape Architect.

**WARNING**

DIAL BEFORE YOU DIG www.1100.com.au®

Services shown on this drawing are approximate only. The exact location is to be confirmed on site by contractor prior to commencement of work.

| DATE | REV | AMENDMENTS |
|---|---|---|
| 29/3/19 | A | 60% DD - FOR INFORMATION |
| 24/7/19 | B | REVISED TENDER - FOR INFORMATION |
| 8/8/19 | C | REVISED TENDER - FOR INFORMATION |

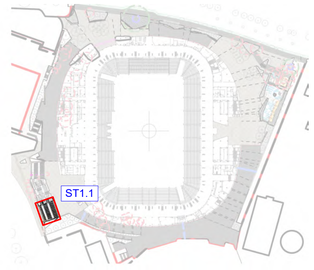


KEY PLAN : NOT TO SCALE

NSW GOVERNMENT | Planning, Industry & Environment

*Issued under the Environmental Planning and Assessment Act 1979*

Approved Application No: SSD-9835 Signed:

Granted on the: 6 Dec 2019 Sheet No: 49 of 83

**ASPECT Studios™**

**ASPECT Studios Pty Ltd**
Level 1, 78-80 George Street
Redfern NSW 2016
Australia
T 02 9699 7182
www.aspect-studios.com
sydney@aspect-studios.com
ABN 11 120 219 561

CLIENT

we are insw Infrastructure New South Wales

PROJECT

SYDNEY FOOTBALL STADIUM
Moore Park, New South Wales
S18030

DRAWING

HARDWORKS DETAILS
Stair Type 1.1


| DRAWN | CHECKED | SCALE A1 \| SCALE A3 |
|---|---|---|
| JR \| DC | JH | |

STATUS NORTH


FOR INFORMATION
NOT FOR CONSTRUCTION

DRAWING NO. REVISION

LA-641 C

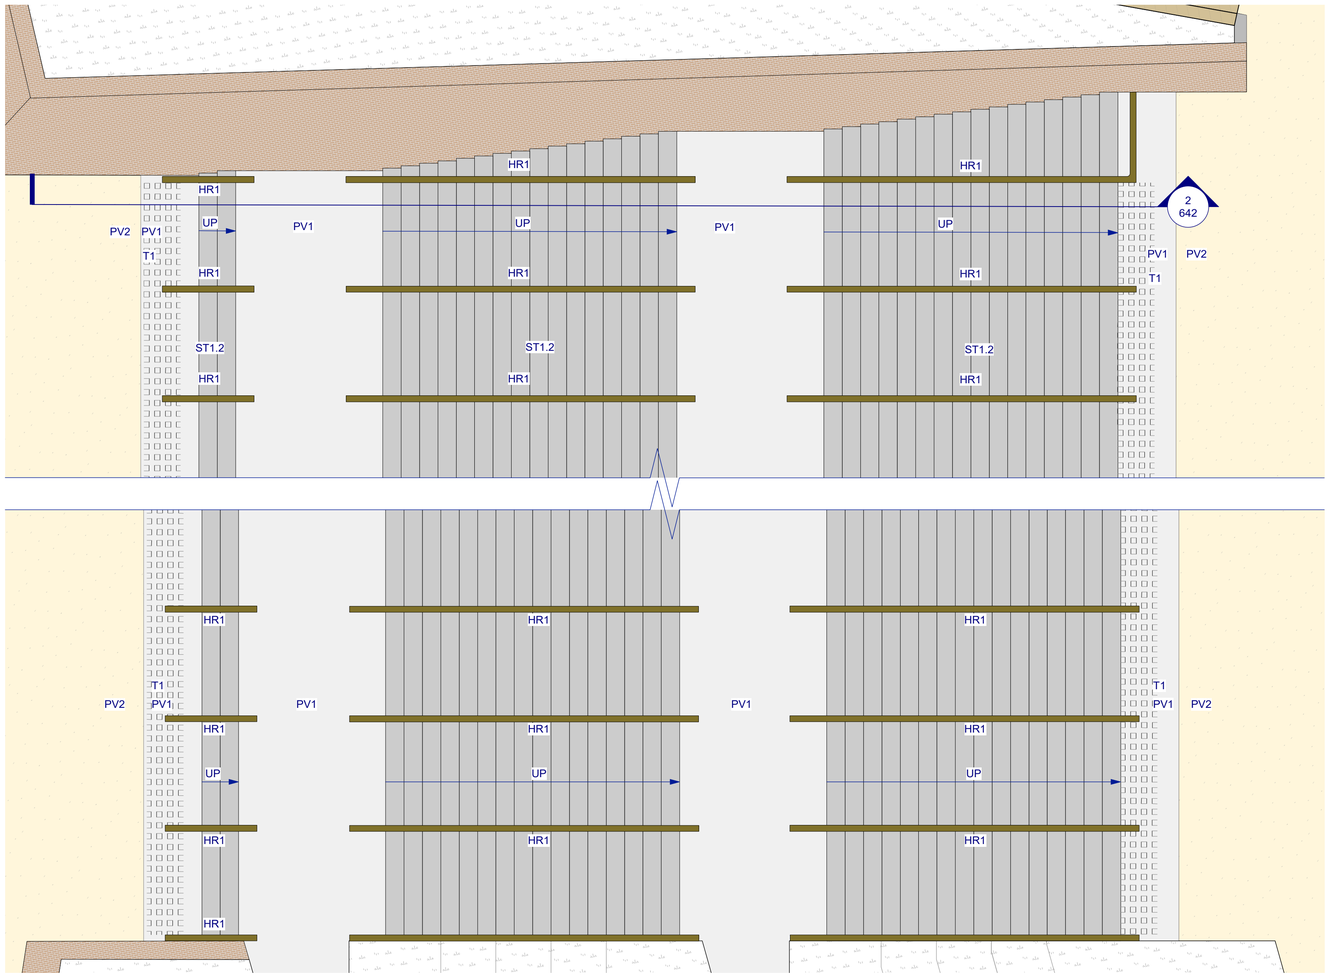


1 STAIR TYPE 1.2- PRECAST CONCRETE| MAIN ENTRANCE | TYPICAL DETAIL
1:50 PLAN ST1.2

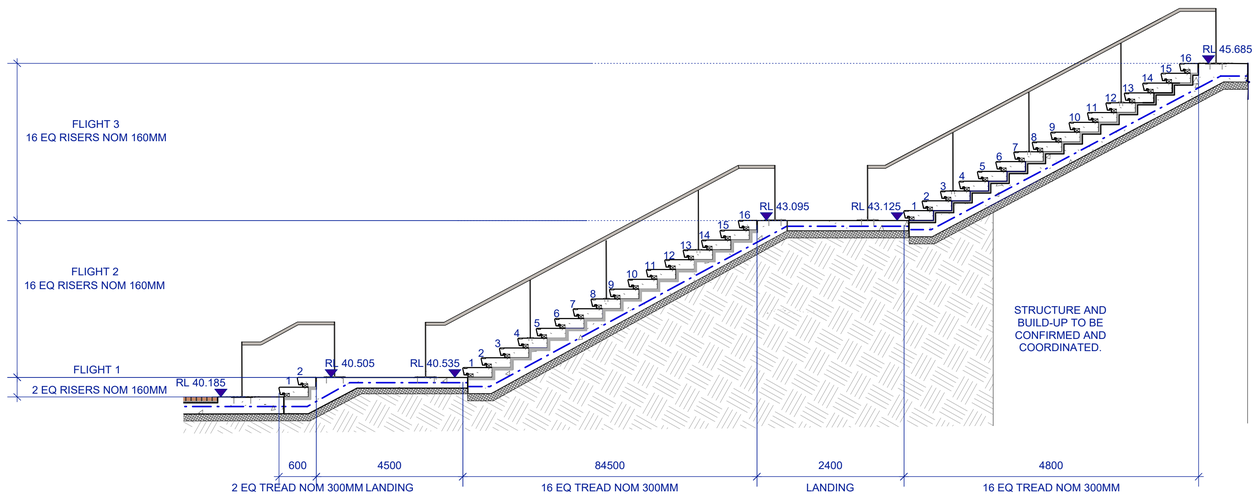


2 STAIR TYPE 1.2- PRECAST CONCRETE| MAIN ENTRANCE | DETAIL PLAN
1:50 SECTION ST1.2

**NOTES**

These drawings are shown in colour and shall be read in digital format or print colour hardcopy.

These drawings shall be read in conjunction with all relevant information (not limited to legends, schedules, specifications)

These drawings shall be read in conjunction with any Engineers, Architects or other consultant information. (not limited to drawings, legends, schedules, specifications)

Check all dimensions and site conditions prior to commencement of any work and the procurement of any services, materials, fittings, fabrication or equipment.

Do not scale drawings – refer to figured drawings only. Any discrepancies shall immediately be referred to the Landscape Architect for clarification.


All drawings shall not be reproduced or distributed without prior permission of the Landscape Architect.

**WARNING**

DIAL BEFORE YOU DIG www.1100.com.au®

Services shown on this drawing are approximate only. The exact location is to be confirmed on site by contractor prior to commencement of work.

| DATE | REV | AMENDMENTS |
|---|---|---|
| 29/3/19 | A | 60% DD - FOR INFORMATION |
| 24/7/19 | B | REVISED TENDER - FOR INFORMATION |
| 8/8/19 | C | REVISED TENDER - FOR INFORMATION |

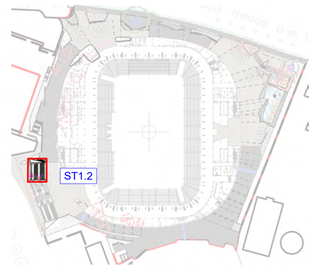


KEY PLAN : NOT TO SCALE

NSW GOVERNMENT | Planning, Industry & Environment

*Issued under the Environmental Planning and Assessment Act 1979*

Approved Application No: SSD-9835 Signed:

Granted on the: 6 Dec 2019 Sheet No: 50 of 83

**ASPECT Studios™**

**ASPECT Studios Pty Ltd**
Level 1, 78-80 George Street
Redfern NSW 2016
Australia
T 02 9699 7182
www.aspect-studios.com
sydney@aspect-studios.com
ABN 11 120 219 561

CLIENT

we are insw Infrastructure New South Wales

PROJECT

SYDNEY FOOTBALL STADIUM
Moore Park, New South Wales
S18030

DRAWING

HARDWORKS DETAILS
Stair Type 1.2

| DRAWN | CHECKED | SCALE A1 \| SCALE A3 |
|---|---|---|
| JR \| DC | JH | |

STATUS NORTH

FOR INFORMATION

NOT FOR CONSTRUCTION


DRAWING NO. REVISION

LA-642 C

DETAIL NO LONGER IN USE




1 STAIR TYPE 1.3- PRECAST CONCRETE| MAIN ENTRANCE | DETAIL PLAN
1:50 PLAN ST1.3

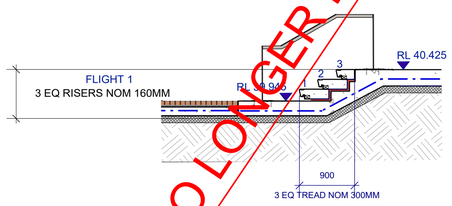



3 STAIR TYPE 1.3- PRECAST CONCRETE| MAIN ENTRANCE | DETAIL PLAN
1:50 SECTION ST1.3

DETAIL NO LONGER IN USE

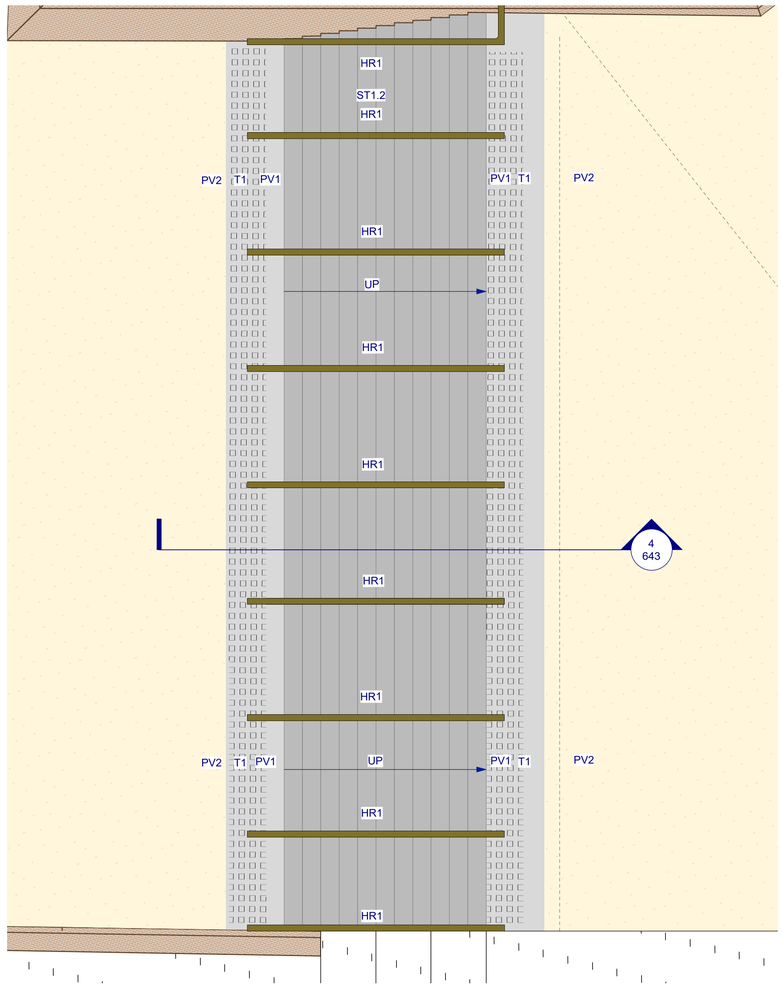


2 STAIR TYPE 1.4- PRECAST CONCRETE| NORTH EAST ENTRANCE| DETAIL PLAN
1:50 PLAN ST1.4

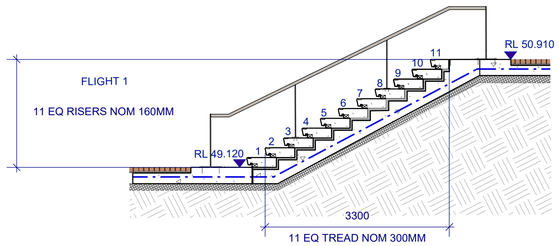


4 STAIR TYPE 1.4- PRECAST CONCRETE| MAIN ENTRANCE | TYPICAL DETAIL
1:50 SECTION ST1.4

NSW GOVERNMENT | Planning, Industry & Environment

*Issued under the Environmental Planning and Assessment Act 1979*

Approved Application No: SSD-9835 Signed:

Granted on the: 6 Dec 2019 Sheet No: 51 of 83

**NOTES**

These drawings are shown in colour and shall be read in digital format or print colour hardcopy.

These drawings shall be read in conjunction with all relevant information (not limited to legends, schedules, specifications)

These drawings shall be read in conjunction with any Engineers, Architects or other consultant information. (not limited to drawings, legends, schedules, specifications)

Check all dimensions and site conditions prior to commencement of any work and the procurement of any services, materials, fittings, fabrication or equipment.

Do not scale drawings – refer to figured drawings only. Any discrepancies shall immediately be referred to the Landscape Architect for clarification.


All drawings shall not be reproduced or distributed without prior permission of the Landscape Architect.

**WARNING**

DIAL BEFORE YOU DIG www.1100.com.au®

Services shown on this drawing are approximate only. The exact location is to be confirmed on site by contractor prior to commencement of work.

| DATE | REV | AMENDMENTS |
|---|---|---|
| 29/3/19 | A | 60% DD - FOR INFORMATION |
| 24/7/19 | B | REVISED TENDER - FOR INFORMATION |
| 8/8/19 | C | REVISED TENDER - FOR INFORMATION |

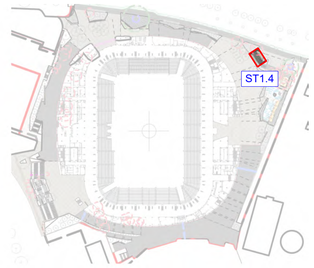


KEY PLAN : NOT TO SCALE

**ASPECT Studios™**

**ASPECT Studios Pty Ltd**
Level 1, 78-80 George Street
Redfern NSW 2016
Australia
T 02 9699 7182
www.aspect-studios.com
sydney@aspect-studios.com
ABN 11 120 219 561

CLIENT

we are insw Infrastructure New South Wales

PROJECT

SYDNEY FOOTBALL STADIUM
Moore Park, New South Wales
S18030

DRAWING

HARDWORKS DETAILS
Stair Type 1.3 & 1.4

| DRAWN | CHECKED | SCALE A1 \| SCALE A3 |
|---|---|---|
| JR \| DC | JH | |


STATUS NORTH

FOR INFORMATION
NOT FOR CONSTRUCTION


DRAWING NO. REVISION

LA-643 C

05_PRODUCTION\02_Phase 02 (SSDA)\01_CAD\

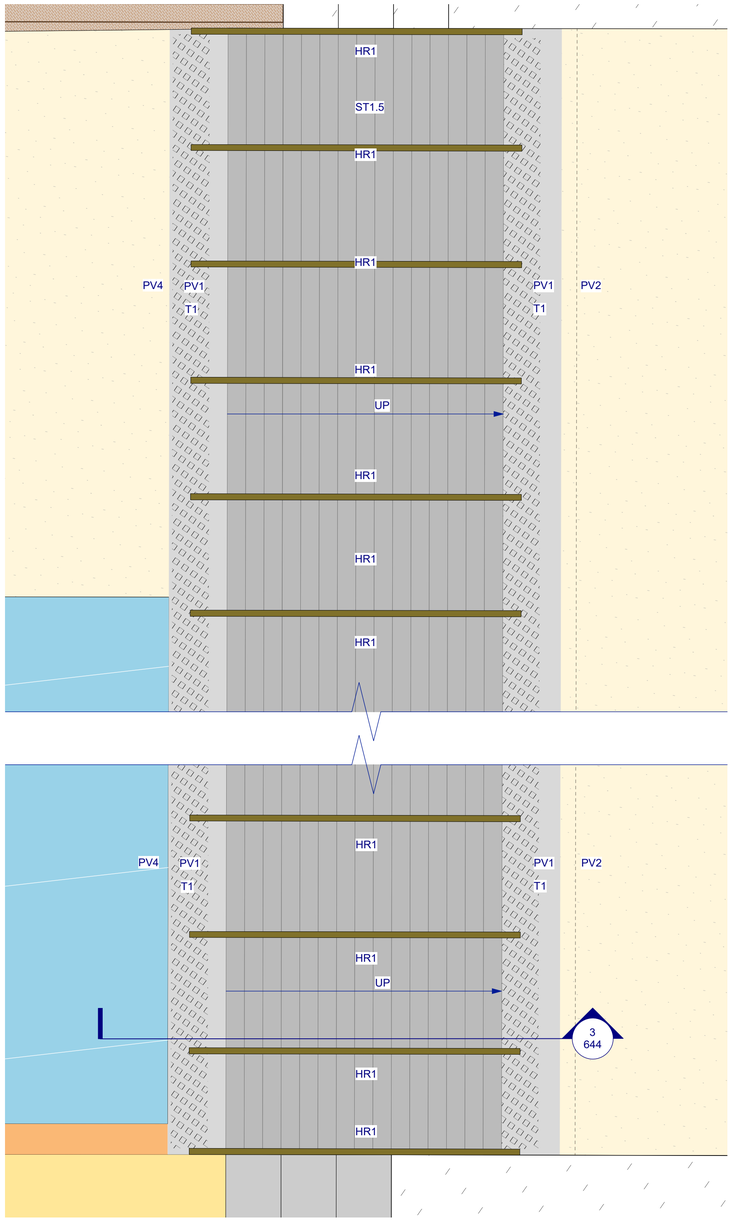



1 STAIR TYPE 1.5- PRECAST CONCRETE| MAIN ENTRANCE | DETAIL PLAN ST1.5
1:50 PLAN

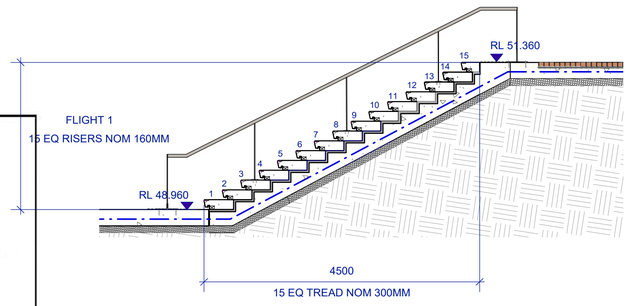


3 STAIR TYPE 1.5- PRECAST CONCRETE| MAIN ENTRANCE | DETAIL PLAN ST1.5
1:50 SECTION

DETAIL NO LONGER IN USE

2 STAIR TYPE 1.6- PRECAST CONCRETE| MAIN ENTRANCE | DETAIL PLAN ST1.6
1:50 PLAN

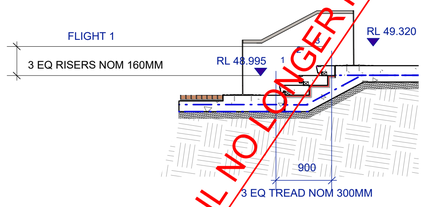


DETAIL NO LONGER IN USE

4 STAIR TYPE 1.6- PRECAST CONCRETE ST1.6
1:50 SECTION

NSW GOVERNMENT | Planning, Industry & Environment

*Issued under the Environmental Planning and Assessment Act 1979*

Approved Application No: SSD-9835 Signed:

Granted on the: 6 Dec 2019 Sheet No: 52 of 83

**NOTES**

These drawings are shown in colour and shall be read in digital format or print colour hardcopy.

These drawings shall be read in conjunction with all relevant information (not limited to legends, schedules, specifications)

These drawings shall be read in conjunction with any Engineers, Architects or other consultant information. (not limited to drawings, legends, schedules, specifications)

Check all dimensions and site conditions prior to commencement of any work and the procurement of any services, materials, fittings, fabrication or equipment.

Do not scale drawings – refer to figured drawings only. Any discrepancies shall immediately be referred to the Landscape Architect for clarification.

All drawings shall not be reproduced or distributed without prior permission of the Landscape Architect.

**WARNING**

DIAL BEFORE YOU DIG www.1100.com.au®

Services shown on this drawing are approximate only. The exact location is to be confirmed on site by contractor prior to commencement of work.

| DATE | REV | AMENDMENTS |
|---|---|---|
| 29/3/19 | A | 60% DD - FOR INFORMATION |
| 24/7/19 | B | REVISED TENDER - FOR INFORMATION |
| 8/8/19 | C | REVISED TENDER - FOR INFORMATION |




KEY PLAN : NOT TO SCALE

**ASPECT Studios™**

**ASPECT Studios Pty Ltd**
Level 1, 78-80 George Street
Redfern NSW 2016
Australia
T 02 9699 7182
www.aspect-studios.com
sydney@aspect-studios.com
ABN 11 120 219 561

CLIENT

we are insw Infrastructure New South Wales

PROJECT

SYDNEY FOOTBALL STADIUM
Moore Park, New South Wales
S18030

DRAWING

HARDWORKS DETAILS
Stair Type 1.5 & 1.6

| DRAWN | CHECKED | SCALE A1 \| SCALE A3 |
|---|---|---|
| JR \| DC | JH | |


STATUS NORTH

FOR INFORMATION
NOT FOR CONSTRUCTION


DRAWING NO. REVISION

LA-644 C


05_PRODUCTION\02_Phase 02 (SSDA)\01_CAD\

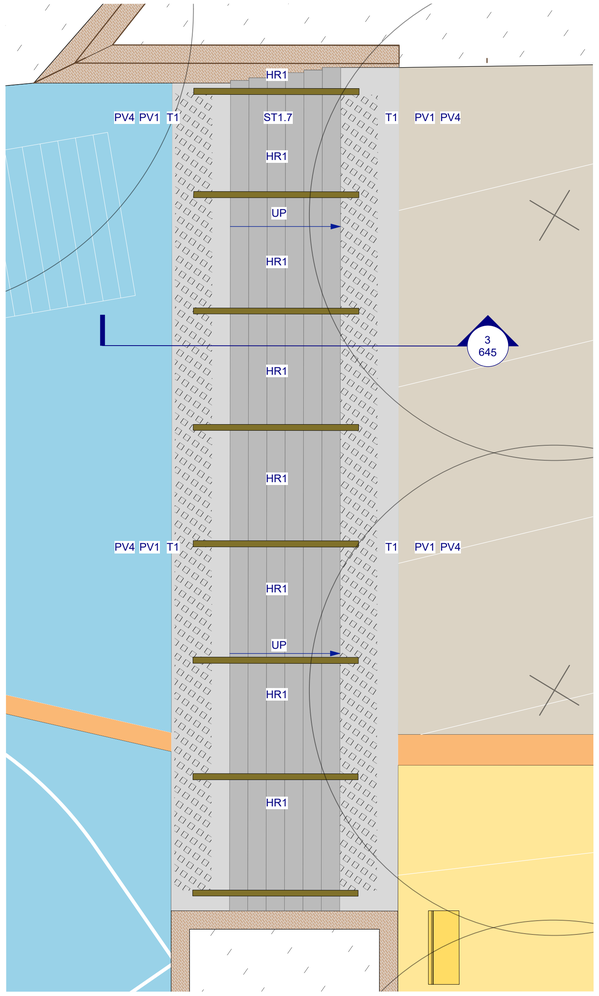



1 STAIR TYPE 1.7- PRECAST CONCRETE| MAIN ENTRANCE | DETAIL PLAN
1:50 PLAN ST1.7

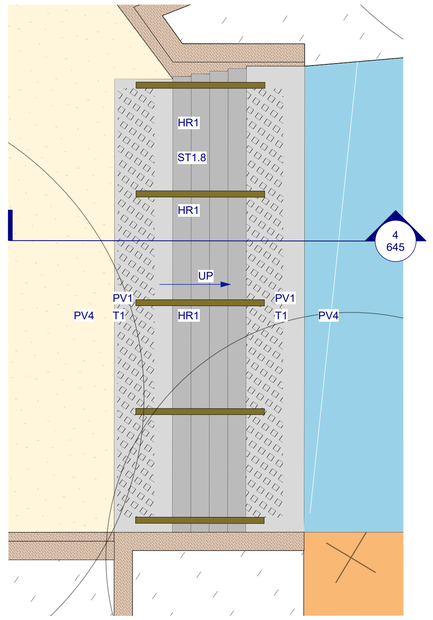


2 STAIR TYPE 1.8- PRECAST CONCRETE| MAIN ENTRANCE | DETAIL PLAN
1:50 PLAN ST1.8

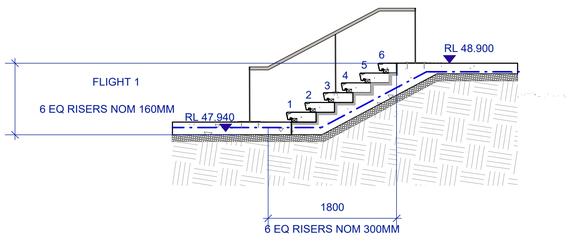


3 STAIR TYPE 1.7- PRECAST CONCRETE
1:50 SECTION ST1.7

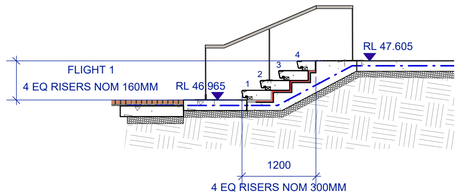


4 STAIR TYPE 1.8- PRECAST CONCRETE| MAIN ENTRANCE
1:50 SECTION ST1.8

NSW GOVERNMENT | Planning, Industry & Environment

*Issued under the Environmental Planning and Assessment Act 1979*

Approved Application No: SSD-9835 Signed:

Granted on the: 6 Dec 2019 Sheet No: 53 of 83

**NOTES**

These drawings are shown in colour and shall be read in digital format or print colour hardcopy.

These drawings shall be read in conjunction with all relevant information (not limited to legends, schedules, specifications)

These drawings shall be read in conjunction with any Engineers, Architects or other consultant information. (not limited to drawings, legends, schedules, specifications)

Check all dimensions and site conditions prior to commencement of any work and the procurement of any services, materials, fittings, fabrication or equipment.

Do not scale drawings – refer to figured drawings only. Any discrepancies shall immediately be referred to the Landscape Architect for clarification.


All drawings shall not be reproduced or distributed without prior permission of the Landscape Architect.

**WARNING**

DIAL BEFORE YOU DIG www.1100.com.au®

Services shown on this drawing are approximate only. The exact location is to be confirmed on site by contractor prior to commencement of work.

| DATE | REV | AMENDMENTS |
|---|---|---|
| 29/3/19 | A | 60% DD - FOR INFORMATION |
| 24/7/19 | B | REVISED TENDER - FOR INFORMATION |
| 8/8/19 | C | REVISED TENDER - FOR INFORMATION |

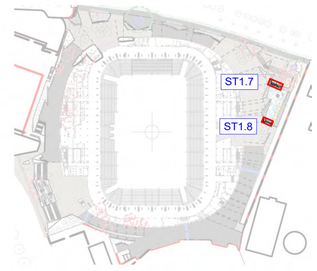


KEY PLAN : NOT TO SCALE

ASPECT Studios™
ASPECT Studios Pty Ltd
Level 1, 78-80 George Street
Redfern NSW 2016
Australia
T 02 9699 7182
www.aspect-studios.com
sydney@aspect-studios.com
ABN 11 120 219 561

CLIENT
we are insw Infrastructure New South Wales

PROJECT
SYDNEY FOOTBALL STADIUM
Moore Park, New South Wales
S18030


DRAWING
HARDWORKS DETAILS
Stair Type 1.7 & 1.8

| DRAWN | CHECKED | SCALE A1 \| SCALE A3 |
|---|---|---|
| JR \| DC | JH | |

STATUS NORTH

FOR INFORMATION
NOT FOR CONSTRUCTION


DRAWING NO. REVISION
LA-645 C

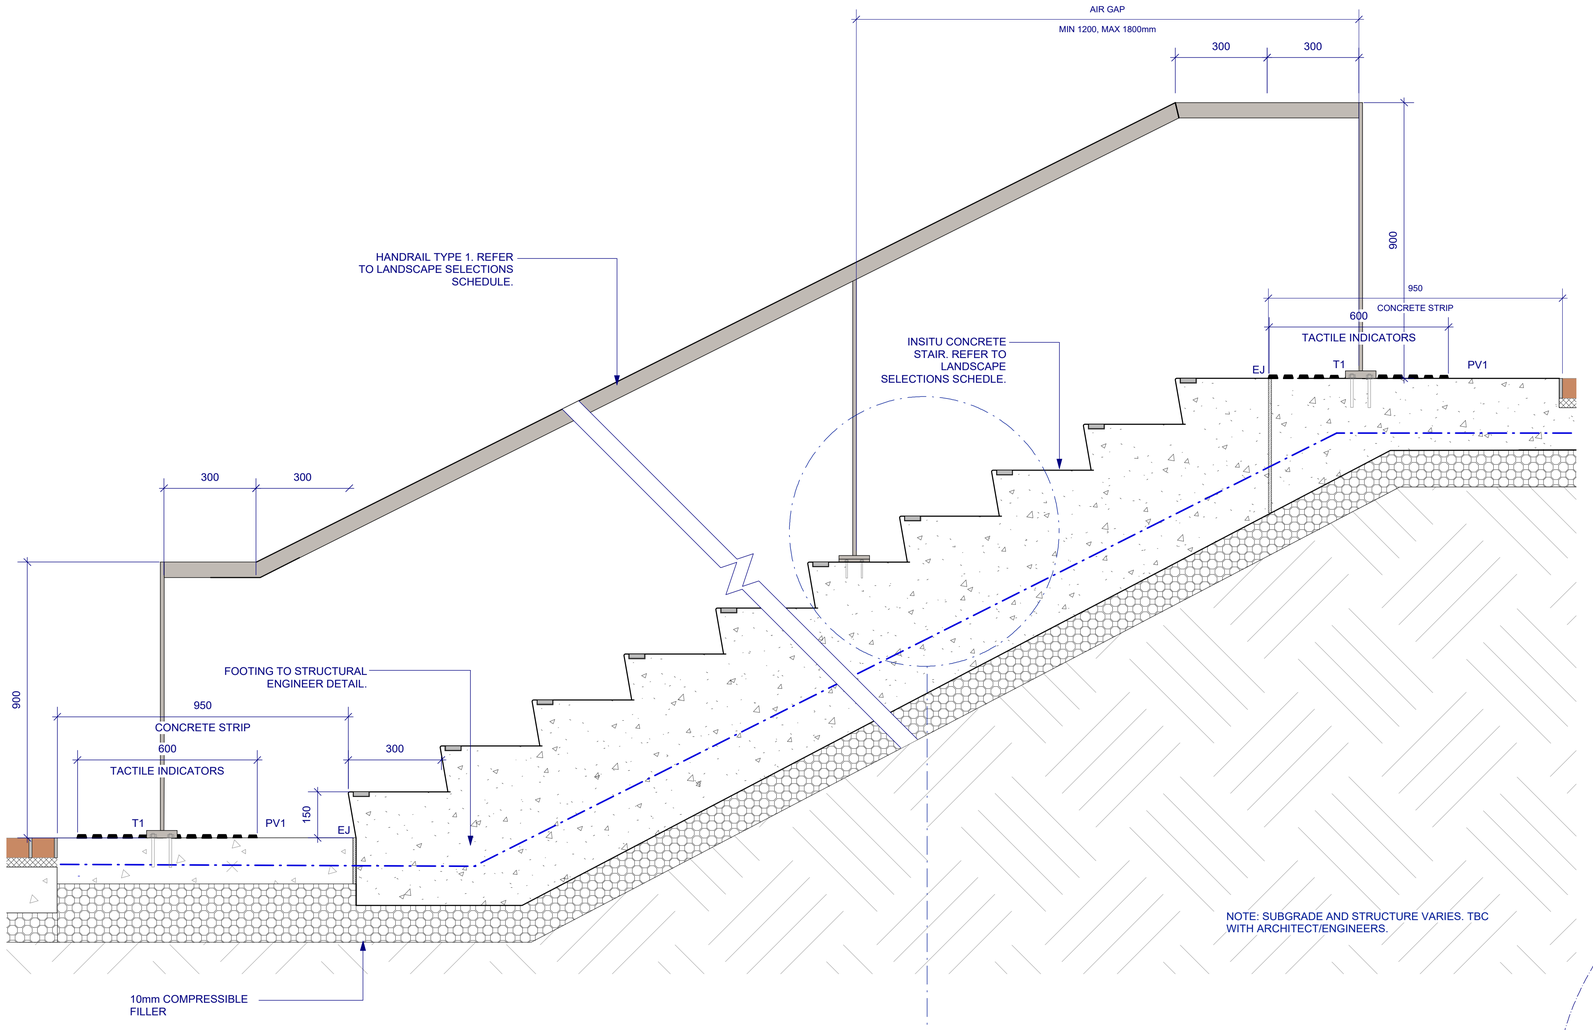



1 STAIR TYPE 2 & HANDRAIL TYPE 1 | TYPICAL DETAIL
1:10 SECTION

ST2
HR1


NOTE: SUBGRADE AND STRUCTURE VARIES. TBC WITH ARCHITECT/ENGINEERS.

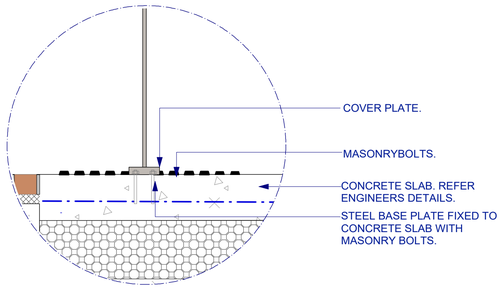



2 HANDRAIL TYPE 1 | END POST DETAIL
1:10 SECTION

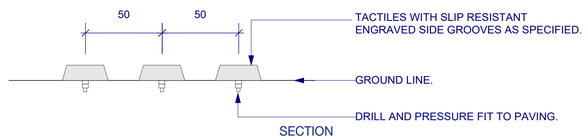



SECTION

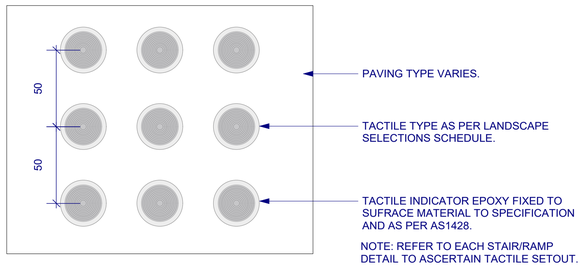


4 TACTILE TYPE 1 | TYPICAL LAYOUT
1:2 PLAN

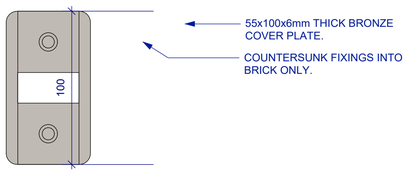


3 HANDRAIL TYPE 1 | TYPICAL FIXING TO ST2 CONCRETE
1:2 SECTION

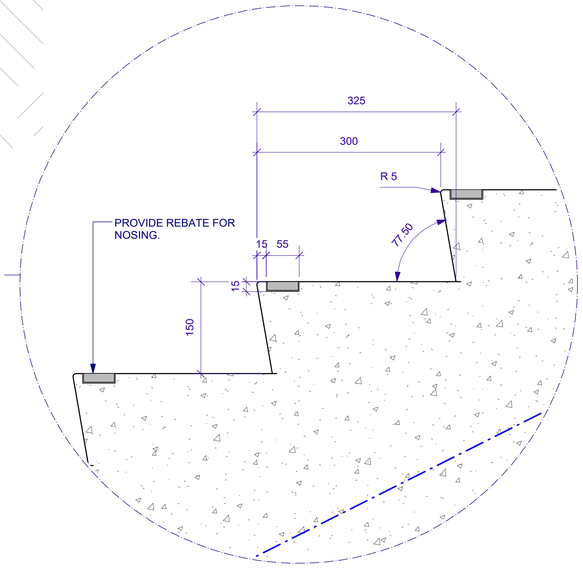


5 STAIR TYPE 2 | TYPICAL VISIBILITY NOSING
1:5 SECTION

NSW GOVERNMENT Planning, Industry & Environment

*Issued under the Environmental Planning and Assessment Act 1979*

Approved Application No: SSD-9835 Signed: A. Coonan

Granted on the: 6 Dec 2019 Sheet No: 54 of 83

**NOTES**

These drawings are shown in colour and shall be read in digital format or print colour hardcopy.

These drawings shall be read in conjunction with all relevant information (not limited to legends, schedules, specifications)

These drawings shall be read in conjunction with any Engineers, Architects or other consultant information. (not limited to drawings, legends, schedules, specifications)

Check all dimensions and site conditions prior to commencement of any work and the procurement of any services, materials, fittings, fabrication or equipment.

Do not scale drawings – refer to figured drawings only. Any discrepancies shall immediately be referred to the Landscape Architect for clarification.

All drawings shall not be reproduced or distributed without prior permission of the Landscape Architect.

**WARNING**

DIAL BEFORE YOU DIG www.1100.com.au®

Services shown on this drawing are approximate only. The exact location is to be confirmed on site by contractor prior to commencement of work.

| DATE | REV | AMENDMENTS |
|---|---|---|
| 29/3/19 | A | 60% DD - FOR INFORMATION |
| 24/7/19 | B | REVISED TENDER - FOR INFORMATION |
| 8/8/19 | C | REVISED TENDER - FOR INFORMATION |


ASPECT Studios™
ASPECT Studios Pty Ltd
Level 1, 78-80 George Street
Redfern NSW 2016
Australia
T 02 9699 7182
www.aspect-studios.com
sydney@aspect-studios.com
ABN 11 120 219 561


CLIENT

we are insw Infrastructure New South Wales

PROJECT

SYDNEY FOOTBALL STADIUM
Moore Park, New South Wales
S18030

DRAWING

HARDWORKS DETAILS
Typical Stair Type 2 Details

| DRAWN | CHECKED | SCALE A1 \| SCALE A3 |
|---|---|---|
| JR \| DC | JH | |


STATUS NORTH

FOR INFORMATION
NOT FOR CONSTRUCTION


DRAWING NO. REVISION

LA-646 C

05_PRODUCTION\02_Phase 02 (SSDA)\01_CAD\

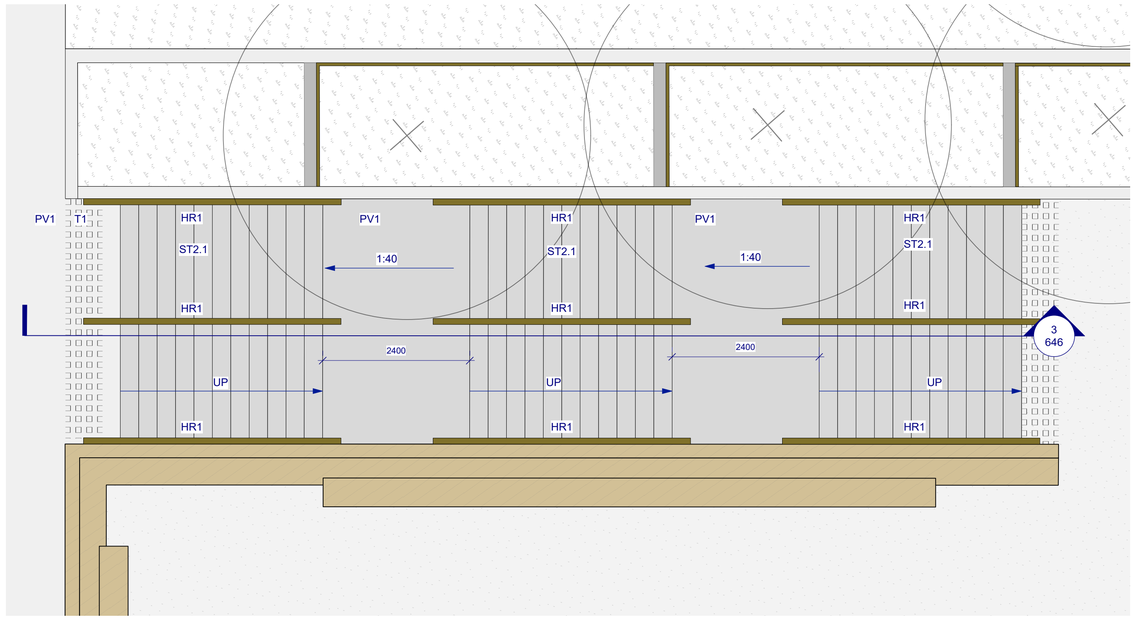


1 STAIR TYPE 2.1- INSITU CONCRETE| CARPARK | DETAIL PLAN
1:50 PLAN ST2.1

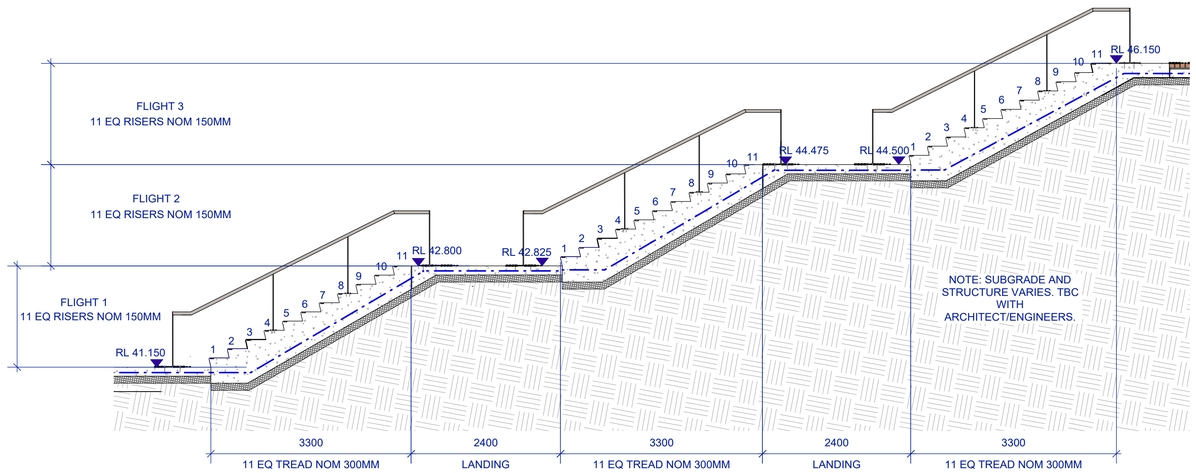


2 STAIR TYPE 2.1- INSITU CONCRETE| CARPARK
1:50 SECTION ST2.1

**NOTES**

These drawings are shown in colour and shall be read in digital format or print colour hardcopy.

These drawings shall be read in conjunction with all relevant information (not limited to legends, schedules, specifications)

These drawings shall be read in conjunction with any Engineers, Architects or other consultant information. (not limited to drawings, legends, schedules, specifications)

Check all dimensions and site conditions prior to commencement of any work and the procurement of any services, materials, fittings, fabrication or equipment.

Do not scale drawings – refer to figured drawings only. Any discrepancies shall immediately be referred to the Landscape Architect for clarification.


All drawings shall not be reproduced or distributed without prior permission of the Landscape Architect.

**WARNING**

DIAL BEFORE YOU DIG www.1100.com.au®

Services shown on this drawing are approximate only. The exact location is to be confirmed on site by contractor prior to commencement of work.

| DATE | REV | AMENDMENTS |
|---|---|---|
| 29/3/19 | A | 60% DD - FOR INFORMATION |
| 24/7/19 | B | REVISED TENDER - FOR INFORMATION |
| 8/8/19 | C | REVISED TENDER - FOR INFORMATION |

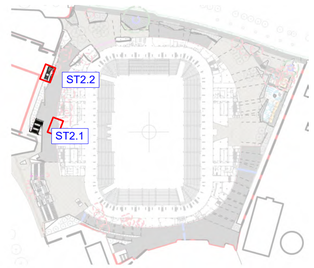


KEY PLAN : NOT TO SCALE

NSW GOVERNMENT | Planning, Industry & Environment

*Issued under the Environmental Planning and Assessment Act 1979*

Approved Application No: SSD-9835 Signed:

Granted on the: 6 Dec 2019 Sheet No: 55 of 83

**ASPECT Studios™**

**ASPECT Studios Pty Ltd**
Level 1, 78-80 George Street
Redfern NSW 2016
Australia
T 02 9699 7182
www.aspect-studios.com
sydney@aspect-studios.com
ABN 11 120 219 561

**CLIENT**

we are insw Infrastructure New South Wales

**PROJECT**

SYDNEY FOOTBALL STADIUM
Moore Park, New South Wales
S18030

**DRAWING**

HARDWORKS DETAILS
Stair Type 2.1 & 2.2


| DRAWN | CHECKED | SCALE A1 \| SCALE A3 |
|---|---|---|
| JR \| DC | JH | |

**STATUS** **NORTH**

FOR INFORMATION
NOT FOR CONSTRUCTION

**DRAWING NO.** **REVISION**

LA-647 C

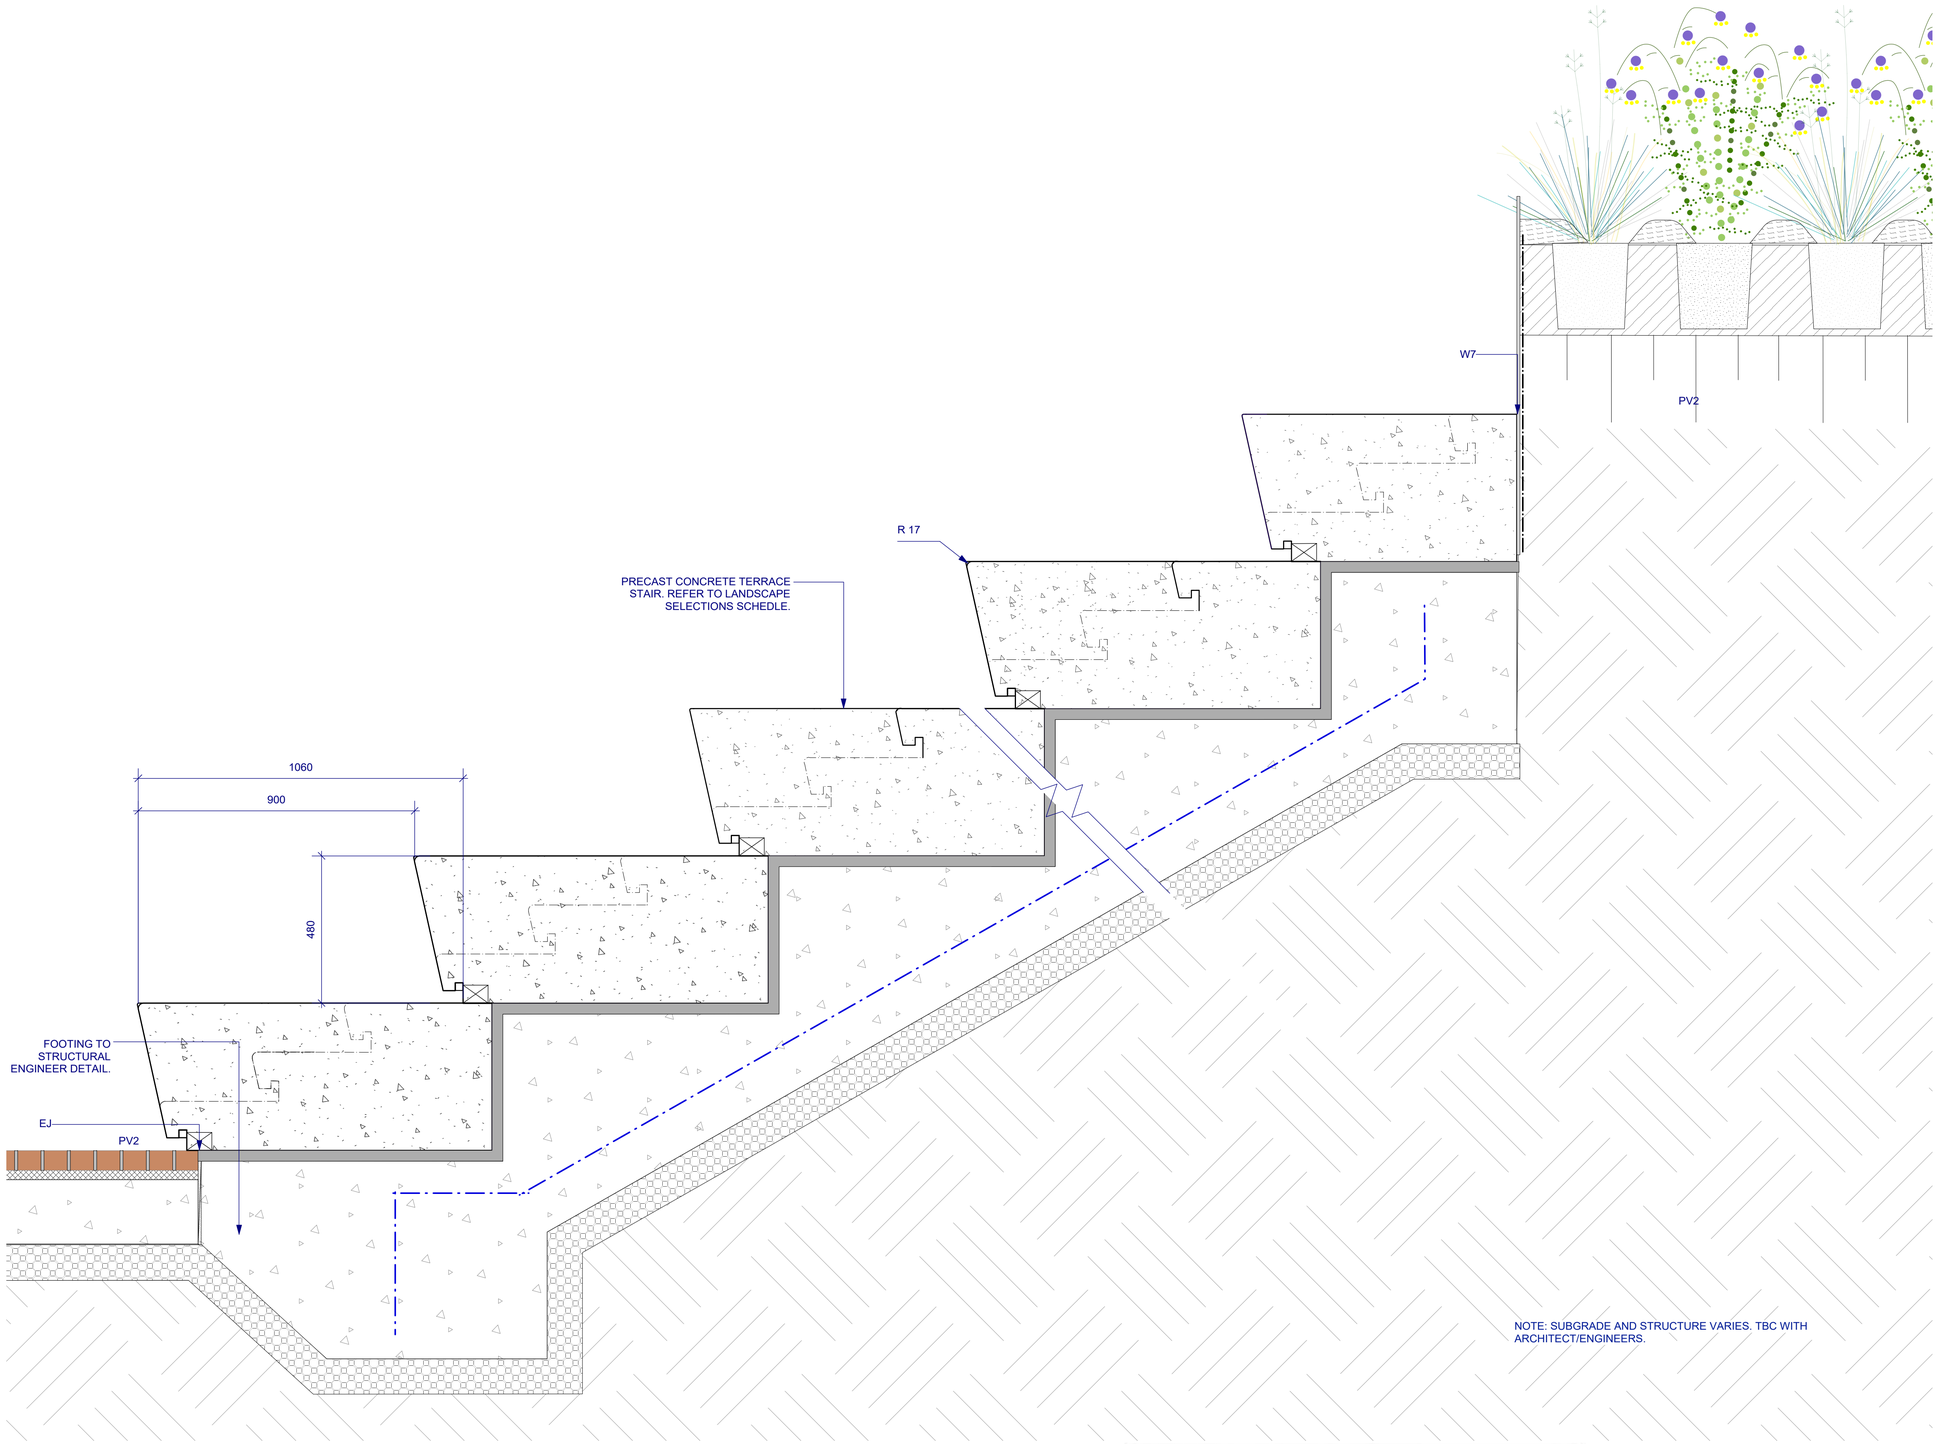


1 1:10
TERRACE STAIR TYPE 1 | PRECAST TERRACE SEATING | TYPICAL DETAIL SECTION TR1

**NOTES**

These drawings are shown in colour and shall be read in digital format or print colour hardcopy.

These drawings shall be read in conjunction with all relevant information (not limited to legends, schedules, specifications)

These drawings shall be read in conjunction with any Engineers, Architects or other consultant information. (not limited to drawings, legends, schedules, specifications)

Check all dimensions and site conditions prior to commencement of any work and the procurement of any services, materials, fittings, fabrication or equipment.

Do not scale drawings – refer to figured drawings only. Any discrepancies shall immediately be referred to the Landscape Architect for clarification.

All drawings shall not be reproduced or distributed without prior permission of the Landscape Architect.

**WARNING**

DIAL BEFORE YOU DIG www.1100.com.au®

Services shown on this drawing are approximate only. The exact location is to be confirmed on site by contractor prior to commencement of work.

| DATE | REV | AMENDMENTS |
|---|---|---|
| 29/3/19 | A | 60% DD - FOR INFORMATION |
| 24/7/19 | B | REVISED TENDER - FOR INFORMATION |
| 8/8/19 | C | REVISED TENDER - FOR INFORMATION |

NSW GOVERNMENT | Planning, Industry & Environment

*Issued under the Environmental Planning and Assessment Act 1979*

Approved Application No: SSD-9835 Signed:

Granted on the: 6 Dec 2019 Sheet No: 56 of 83

**ASPECT Studios™**

**ASPECT Studios Pty Ltd**
Level 1, 78-80 George Street
Redfern NSW 2016
Australia
T 02 9699 7182
www.aspect-studios.com
sydney@aspect-studios.com
ABN 11 120 219 561

**CLIENT**

we are insw Infrastructure New South Wales

**PROJECT**

SYDNEY FOOTBALL STADIUM
Moore Park, New South Wales
S18030

**DRAWING**

HARDWORKS DETAILS
Typical Terrace Type 1 Details


| DRAWN | CHECKED | SCALE A1 \| SCALE A3 |
|---|---|---|
| JR \| DC | JH | |

**STATUS** **NORTH**


FOR INFORMATION
NOT FOR CONSTRUCTION

**DRAWING NO.** **REVISION**


LA-648 C

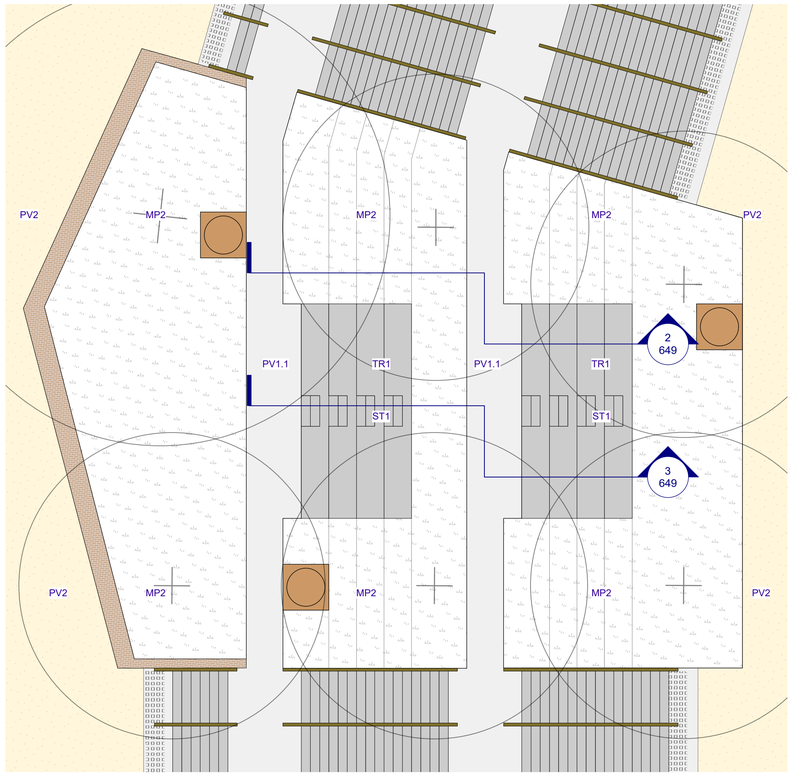


1 TERRACE TYPE 1- CONCRETE TERRACES | DETAIL PLAN
1:100 PLAN TR1

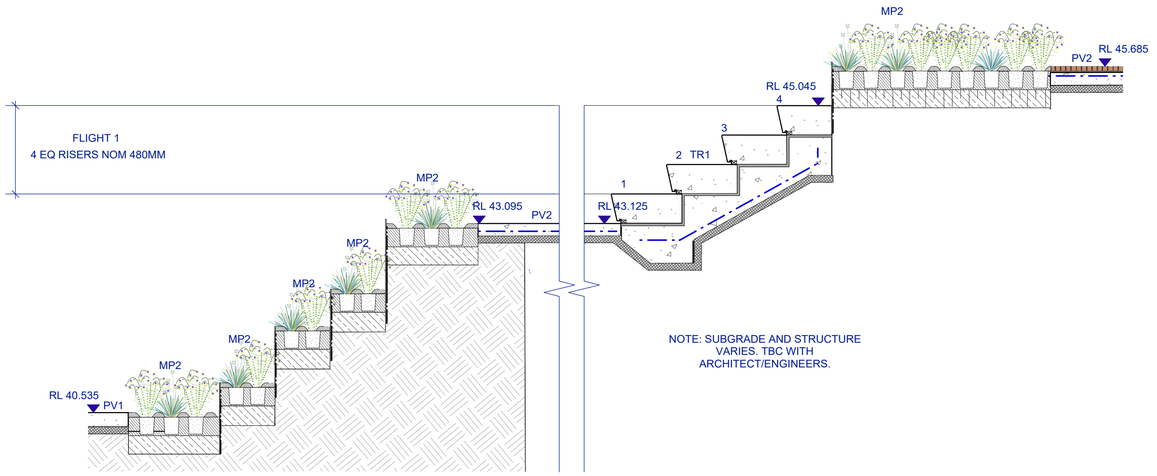


2 TERRACE TYPE 1- CONCRETE TERRACES | DETAIL PLAN
1:50 SECTION TR1

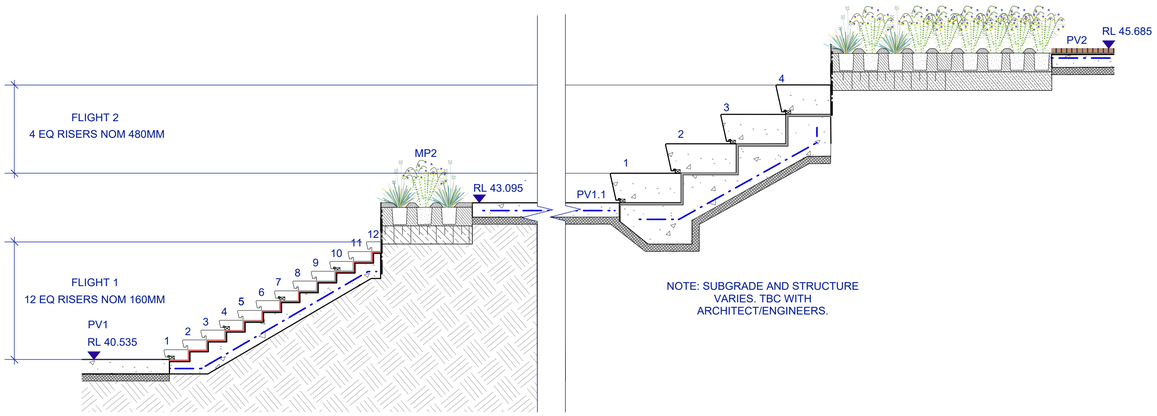


3 TERRACE TYPE 1- CONCRETE TERRACES | DETAIL PLAN
1:50 SECTION TR1

NSW GOVERNMENT | Planning, Industry & Environment

*Issued under the Environmental Planning and Assessment Act 1979*

Approved Application No: SSD-9835 Signed:

Granted on the: 6 Dec 2019 Sheet No: 57 of 83

**NOTES**

These drawings are shown in colour and shall be read in digital format or print colour hardcopy.

These drawings shall be read in conjunction with all relevant information (not limited to legends, schedules, specifications)

These drawings shall be read in conjunction with any Engineers, Architects or other consultant information. (not limited to drawings, legends, schedules, specifications)

Check all dimensions and site conditions prior to commencement of any work and the procurement of any services, materials, fittings, fabrication or equipment.

Do not scale drawings – refer to figured drawings only. Any discrepancies shall immediately be referred to the Landscape Architect for clarification.


All drawings shall not be reproduced or distributed without prior permission of the Landscape Architect.

**WARNING**

DIAL BEFORE YOU DIG www.1100.com.au®

Services shown on this drawing are approximate only. The exact location is to be confirmed on site by contractor prior to commencement of work.

| DATE | REV | AMENDMENTS |
|---|---|---|
| 29/3/19 | A | 60% DD - FOR INFORMATION |
| 24/7/19 | B | REVISED TENDER - FOR INFORMATION |
| 8/8/19 | C | REVISED TENDER - FOR INFORMATION |

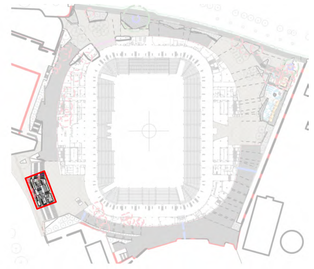

KEY PLAN : NOT TO SCALE


ASPECT Studios™

**ASPECT Studios Pty Ltd**
Level 1, 78-80 George Street
Redfern NSW 2016
Australia
T 02 9699 7182
www.aspect-studios.com
sydney@aspect-studios.com
ABN 11 120 219 561


CLIENT

we are insw Infrastructure New South Wales

PROJECT

SYDNEY FOOTBALL STADIUM
Moore Park, New South Wales
S18030

DRAWING

HARDWORKS DETAILS
Terrace Type 1


| DRAWN | CHECKED | SCALE A1 \| SCALE A3 |
|---|---|---|
| JR \| DC | JH | |

STATUS NORTH


FOR INFORMATION
NOT FOR CONSTRUCTION

DRAWING NO. REVISION


LA-649 C

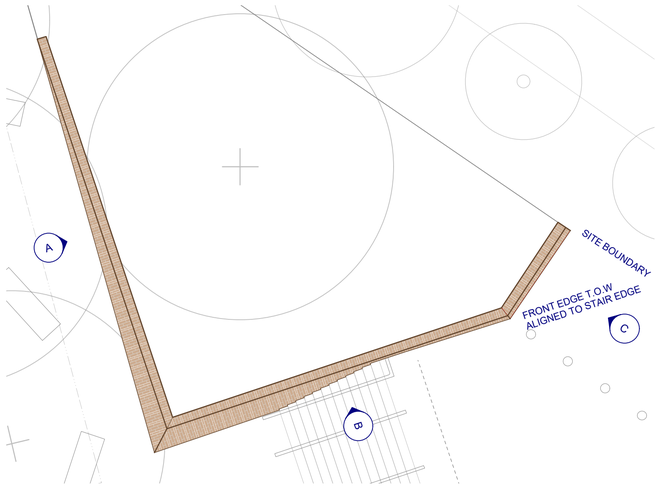



1 WALL TYPE WT4.1 - PLAN
Scale: 1:100

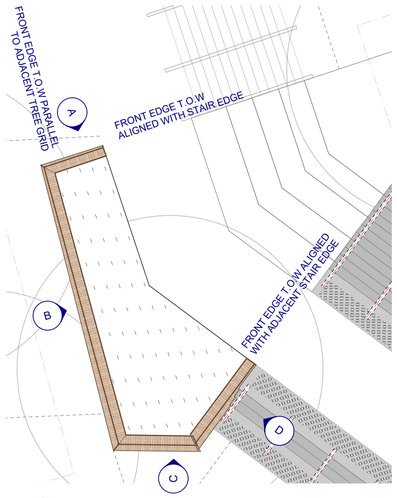


2 WALL TYPE WT4.2 - PLAN
Scale: 1:100

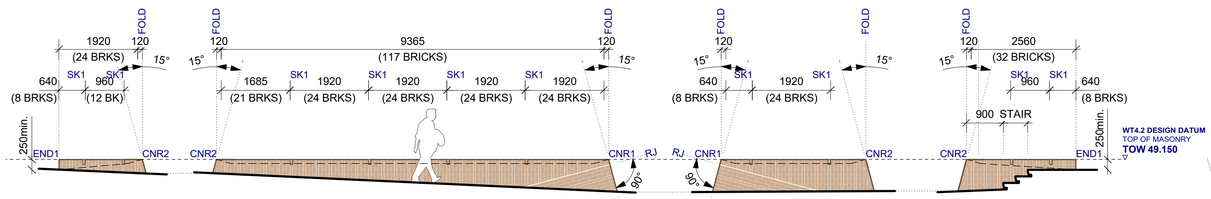



5 WALL TYPE WT4.2 - ELEVATIONS A, B, C & D
Scale: 1:75

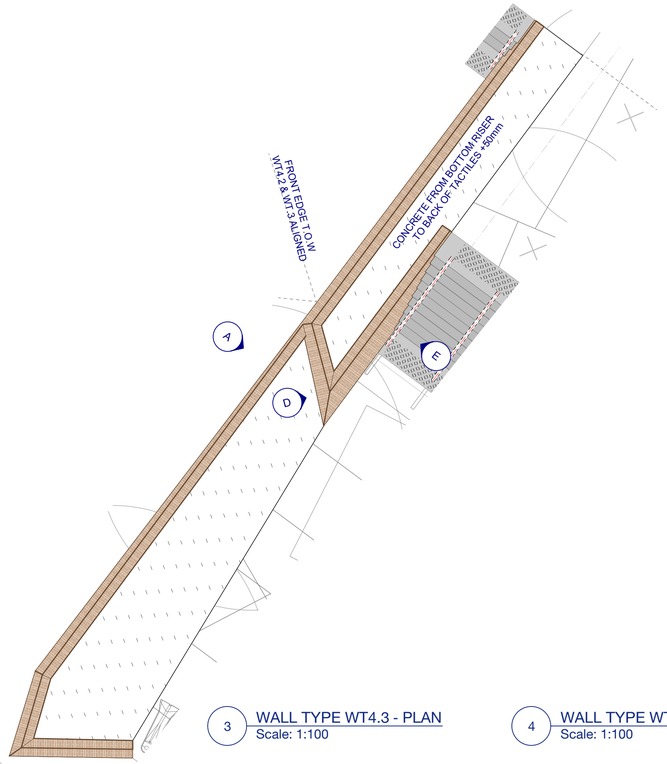



3 WALL TYPE WT4.3 - PLAN
Scale: 1:100

4 WALL TYPE WT4.4 - PLAN
Scale: 1:100

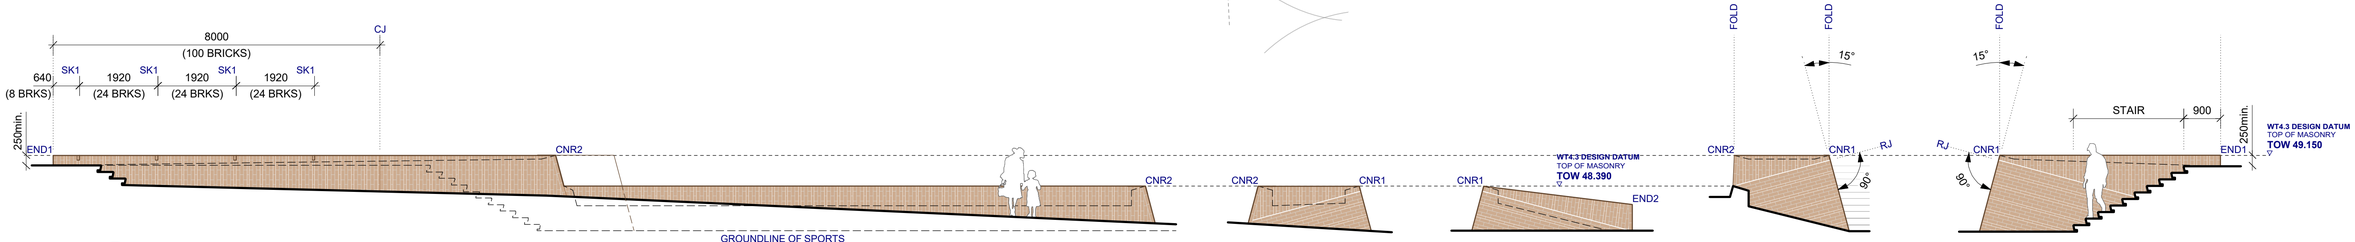


6 WALL TYPE WT4.3 - ELEVATIONS A, B, C, D & E
Scale: 1:75

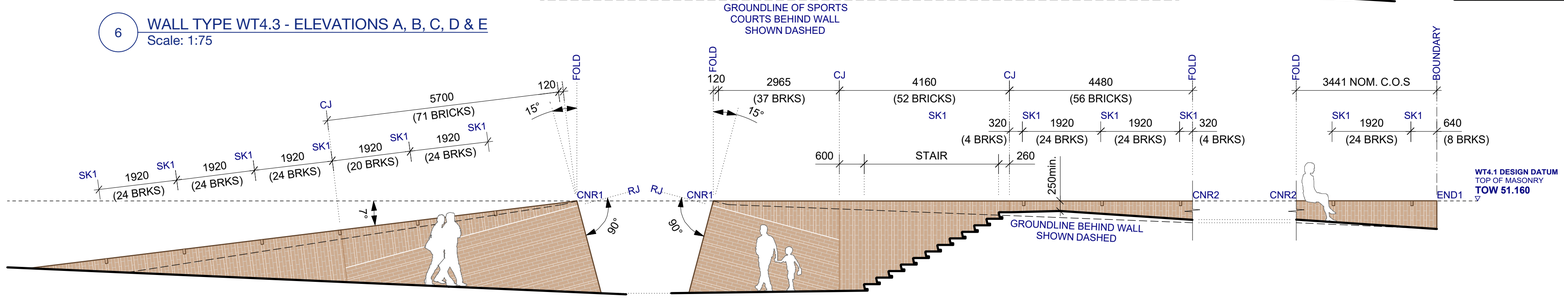


7 WALL TYPE WT4.1 - ELEVATIONS A, B & C
Scale: 1:75

8 WALL TYPE WT4.4 - ELEVATIONS A, B, & C
Scale: 1:75

NSW GOVERNMENT | Planning, Industry & Environment

*Issued under the Environmental Planning and Assessment Act 1979*

Approved Application No: SSD-9835 Signed:

Granted on the: 6 Dec 2019 Sheet No: 58 of 83

**NOTES**

These drawings are shown in colour and shall be read in digital format or print colour hardcopy.

These drawings shall be read in conjunction with all relevant information (not limited to legends, schedules, specifications)

These drawings shall be read in conjunction with any Engineers, Architects or other consultant information. (not limited to drawings, legends, schedules, specifications)

Check all dimensions and site conditions prior to commencement of any work and the procurement of any services, materials, fittings, fabrication or equipment.

Do not scale drawings – refer to figured drawings only. Any discrepancies shall immediately be referred to the Landscape Architect for clarification.

All drawings shall not be reproduced or distributed without prior permission of the Landscape Architect.

**WARNING**

DIAL BEFORE YOU DIG www.1100.com.au®

Services shown on this drawing are approximate only. The exact location is to be confirmed on site by contractor prior to commencement of work.

| DATE | REV | AMENDMENTS |
|---|---|---|
| 29/3/19 | A | 60% DD - FOR INFORMATION |

**ASPECT Studios™**

**ASPECT Studios Pty Ltd**
Level 1, 78-80 George Street
Redfern NSW 2016
Australia
T 02 9699 7182
www.aspect-studios.com
sydney@aspect-studios.com
ABN 11 120 219 561

**CLIENT**

we are insw Infrastructure New South Wales

**PROJECT**

SYDNEY FOOTBALL STADIUM
Moore Park, New South Wales
S18030

**DRAWING**

HARDWORKS DETAILS
Wall Type 4 Plans & Elevations


| DRAWN | CHECKED | SCALE A1 \| SCALE A3 |
|---|---|---|
| GW | JH | VARIES AS SHOWN |

**STATUS** **NORTH**


FOR INFORMATION
NOT FOR CONSTRUCTION

**DRAWING NO.** **REVISION**


LA-633 A

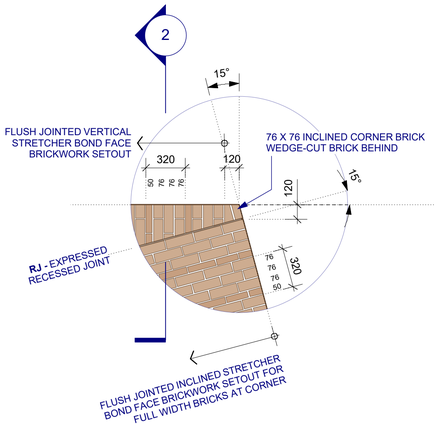



1 WT4 CNR1 - CORNER DETAIL ELEVATION
Scale: 1:25

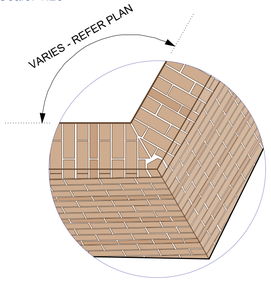



3 WT4 CNR1 - CORNER DETAIL PLAN
Scale: 1:20

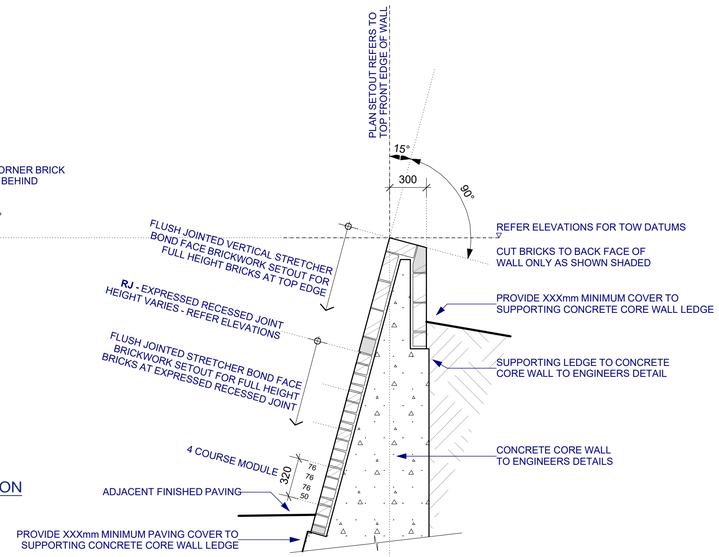


2 WT4 - DETAIL SECTION CNR1
Scale: 1:25

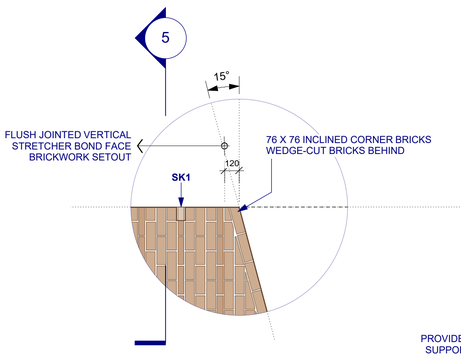


4 WT4 - CORNER DETAIL CNR2
Scale: 1:25

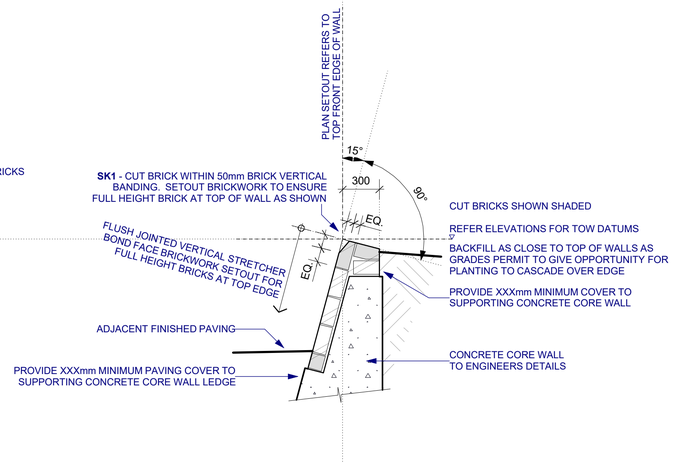


5 WT4 - TYPICAL DETAIL SECTION
Scale: 1:25

**NOTES**

These drawings are shown in colour and shall be read in digital format or print colour hardcopy.

These drawings shall be read in conjunction with all relevant information (not limited to legends, schedules, specifications)

These drawings shall be read in conjunction with any Engineers, Architects or other consultant information. (not limited to drawings, legends, schedules, specifications)

Check all dimensions and site conditions prior to commencement of any work and the procurement of any services, materials, fittings, fabrication or equipment.

Do not scale drawings – refer to figured drawings only. Any discrepancies shall immediately be referred to the Landscape Architect for clarification.

All drawings shall not be reproduced or distributed without prior permission of the Landscape Architect.

**WARNING**

DIAL BEFORE YOU DIG www.1100.com.au®

Services shown on this drawing are approximate only. The exact location is to be confirmed on site by contractor prior to commencement of work.

| DATE | REV | AMENDMENTS |
|---|---|---|
| 29/3/19 | A | 60% DD - FOR INFORMATION |

NSW GOVERNMENT | Planning, Industry & Environment

*Issued under the Environmental Planning and Assessment Act 1979*

Approved Application No: SSD-9835 Signed: A. Coonan

Granted on the: 6 Dec 2019 Sheet No: 59 of 83

ASPECT Studios™
ASPECT Studios Pty Ltd
Level 1, 78-80 George Street
Redfern NSW 2016
Australia
T 02 9699 7182
www.aspect-studios.com
sydney@aspect-studios.com
ABN 11 120 219 561

CLIENT
we are insw Infrastructure New South Wales

PROJECT
SYDNEY FOOTBALL STADIUM
Moore Park, New South Wales
S18030


DRAWING
HARDWORKS DETAILS
Wall Type 4 Sections & Details

| DRAWN | CHECKED | SCALE A1 \| SCALE A3 |
|---|---|---|
| GW | JH | VARIES AS SHOWN |


STATUS NORTH

FOR INFORMATION
NOT FOR CONSTRUCTION


DRAWING NO. REVISION
LA-634 A

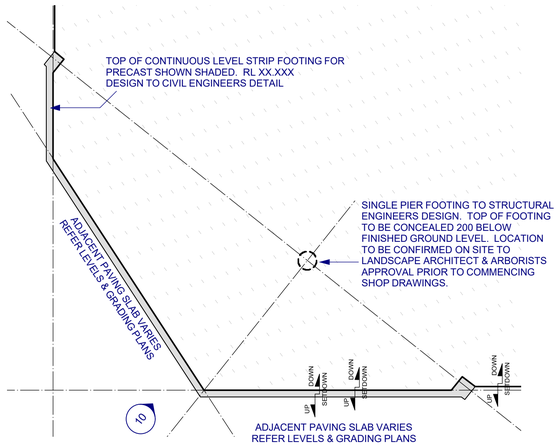



2 DECK 1 - SLAB & FOOTING PLAN
Scale: 1:100

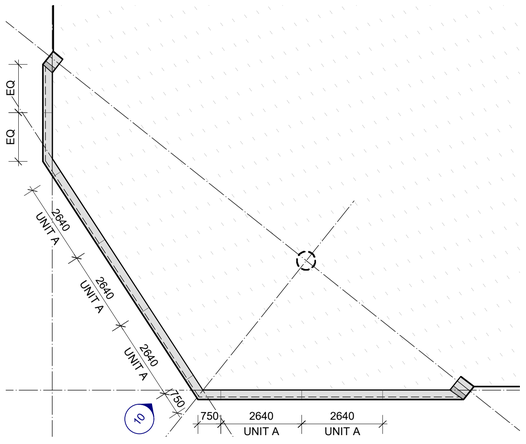



3 DECK 1 - PRECAST CONCRETE PLAN
Scale: 1:100

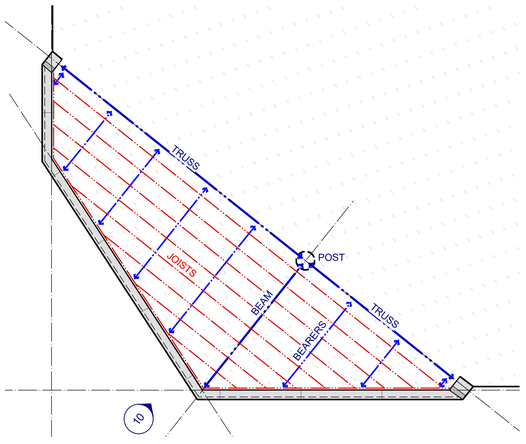



4 DECK 1 - INDICATIVE STEEL & TIMBER FRAMING PLAN
Scale: 1:100

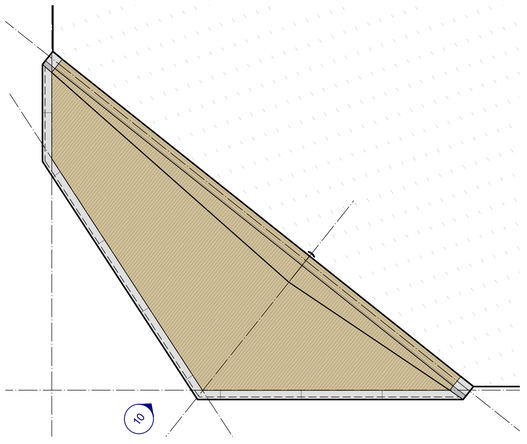



5 DECK 1 - TIMBER DECKING
Scale: 1:100

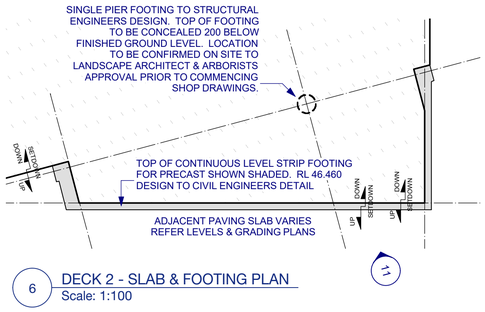



6 DECK 2 - SLAB & FOOTING PLAN
Scale: 1:100

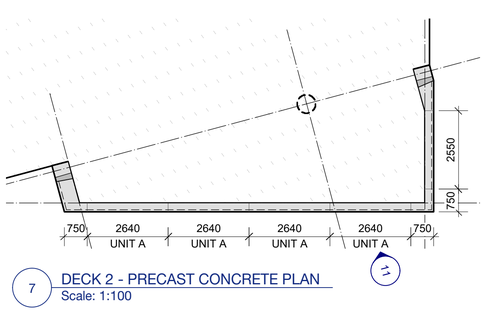



7 DECK 2 - PRECAST CONCRETE PLAN
Scale: 1:100

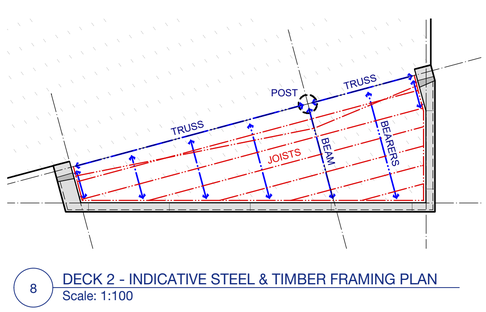



8 DECK 2 - INDICATIVE STEEL & TIMBER FRAMING PLAN
Scale: 1:100

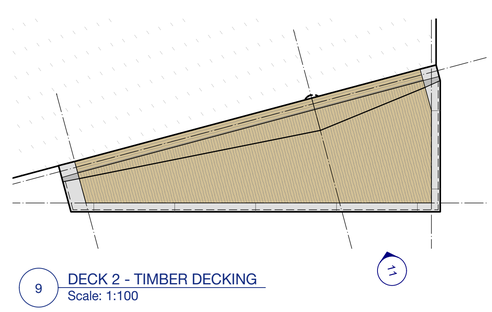



9 DECK 2 - TIMBER DECKING
Scale: 1:100

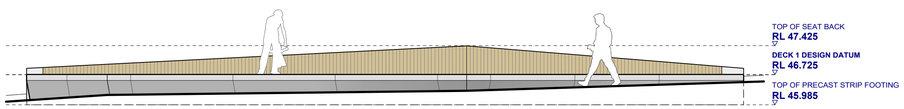



10 DECK 1 - ELEVATION
Scale: 1:75

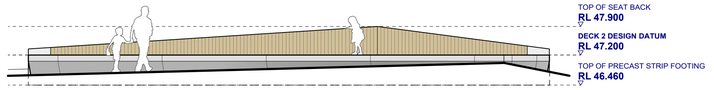



11 DECK 2 - ELEVATION
Scale: 1:75

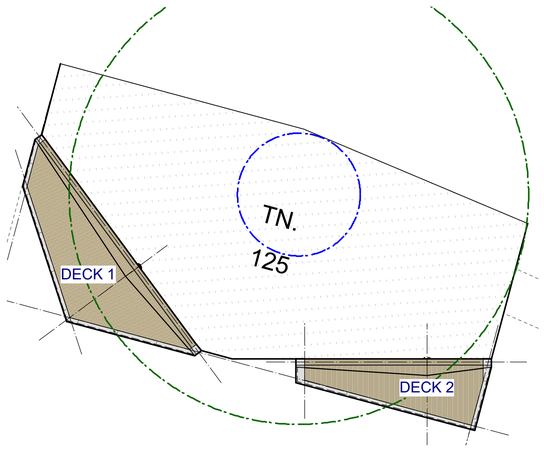


1 TIMBER DECKS DETAIL PLAN
Scale: 1:200

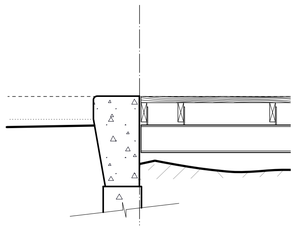

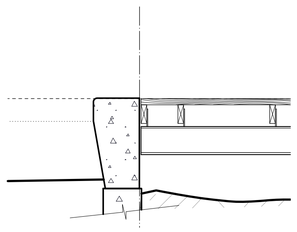

**NOTES**

These drawings are shown in colour and shall be read in digital format or print colour hardcopy.

These drawings shall be read in conjunction with all relevant information (not limited to legends, schedules, specifications)

These drawings shall be read in conjunction with any Engineers, Architects or other consultant information. (not limited to drawings, legends, schedules, specifications)

Check all dimensions and site conditions prior to commencement of any work and the procurement of any services, materials, fittings, fabrication or equipment.

Do not scale drawings – refer to figured drawings only. Any discrepancies shall immediately be referred to the Landscape Architect for clarification.

All drawings shall not be reproduced or distributed without prior permission of the Landscape Architect.

**WARNING**

DIAL BEFORE YOU DIG www.1100.com.au®

Services shown on this drawing are approximate only. The exact location is to be confirmed on site by contractor prior to commencement of work.

| DATE | REV | AMENDMENTS |
|---|---|---|
| 29/3/19 | A | 60% DD - FOR INFORMATION |
| 24/7/19 | B | REVISED TENDER - FOR INFORMATION |

NSW GOVERNMENT | Planning, Industry & Environment

*Issued under the Environmental Planning and Assessment Act 1979*

Approved Application No: SSD-9835 Signed: A. Coonan

Granted on the: 6 Dec 2019 Sheet No: 60 of 83


**ASPECT Studios™**

**ASPECT Studios Pty Ltd**
Level 1, 78-80 George Street
Redfern NSW 2016
Australia
T 02 9699 7182
www.aspect-studios.com
sydney@aspect-studios.com
ABN 11 120 219 561


CLIENT

we are insw Infrastructure New South Wales

PROJECT

SYDNEY FOOTBALL STADIUM
Moore Park, New South Wales
S18030

DRAWING

FURNITURE & FIXTURES DETAILS
Precast & Timber Decks

| DRAWN | CHECKED | SCALE A1 \| SCALE A3 |
|---|---|---|
| GW | JH | VARIES AS SHOWN |


STATUS

FOR INFORMATION
NOT FOR CONSTRUCTION


NORTH

DRAWING NO. LA-730

REVISION B

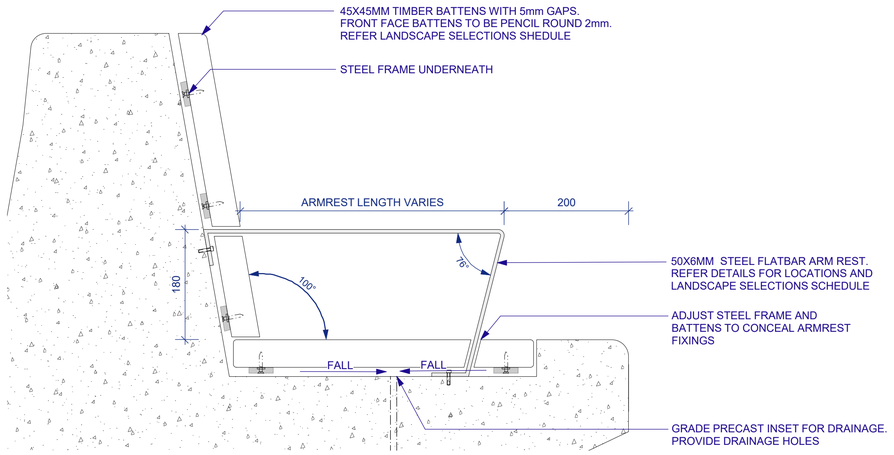


1 BE1 + BE2 | TYPICAL ARMREST AND TIMBER BATTEN FIXING TO FRAME
1:5

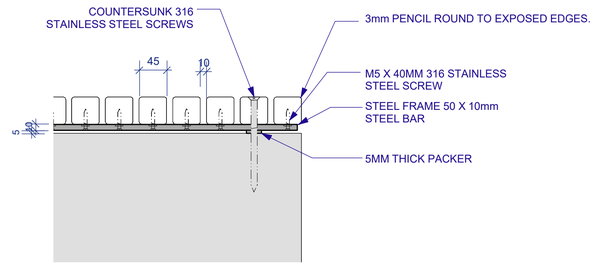


3 BE1 + BE2 + W1 | TYPICAL TIMBER AND FRAME FIXING
1:5

**NOTES**

These drawings are shown in colour and shall be read in digital format or print colour hardcopy.

These drawings shall be read in conjunction with all relevant information (not limited to legends, schedules, specifications)

These drawings shall be read in conjunction with any Engineers, Architects or other consultant information. (not limited to drawings, legends, schedules, specifications)

Check all dimensions and site conditions prior to commencement of any work and the procurement of any services, materials, fittings, fabrication or equipment.

Do not scale drawings – refer to figured drawings only. Any discrepancies shall immediately be referred to the Landscape Architect for clarification.

All drawings shall not be reproduced or distributed without prior permission of the Landscape Architect.

**WARNING**

DIAL BEFORE YOU DIG www.1100.com.au® Services shown on this drawing are approximate only. The exact location is to be confirmed on site by contractor prior to commencement of work.

| DATE | REV | AMENDMENTS |
|---|---|---|
| 28/2/19 | A | END OF FEBRUARY PACKAGE - FOR INFORMATION |
| 29/3/19 | B | 60% DD - FOR INFORMATION |
| 24/7/19 | C | REVISED TENDER - FOR INFORMATION |

NSW GOVERNMENT Planning, Industry & Environment

*Issued under the Environmental Planning and Assessment Act 1979*

Approved Application No: SSD-9835 Signed:

Granted on the: 6 Dec 2019 Sheet No: 61 of 83

ASPECT Studios™
**ASPECT Studios Pty Ltd**
Level 1, 78-80 George Street
Redfern NSW 2016
Australia
T 02 9699 7182
www.aspect-studios.com
sydney@aspect-studios.com
ABN 11 120 219 561

**CLIENT**
we are insw Infrastructure New South Wales

**PROJECT**
SYDNEY FOOTBALL STADIUM
Moore Park, New South Wales
S18030

**DRAWING**
FURNITURE & FIXTURES DETAILS
Typical Bench Details


| DRAWN | CHECKED | SCALE A1 \| SCALE A3 |
|---|---|---|
| JR \| DC | JH | |

**STATUS** **NORTH**


FOR INFORMATION
NOT FOR CONSTRUCTION

**DRAWING NO.** **REVISION**


LA-701 C

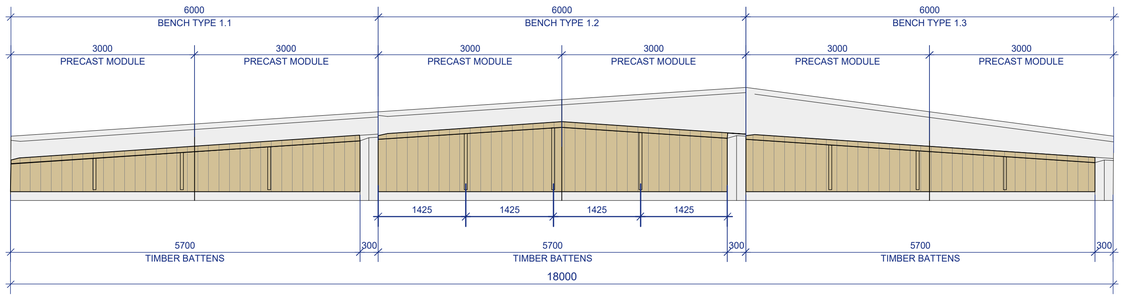



1 BENCH TYPE 1 | PRECAST CONCRETE WITH TIMBER INLAY
1:50 PLAN

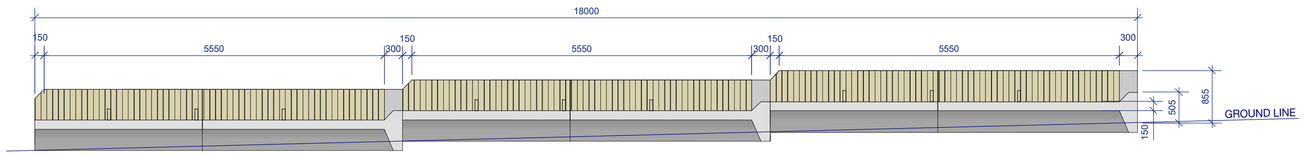



2 BENCH TYPE 1 | PRECAST CONCRETE WITH TIMBER INLAY
1:50 FRONT ELEVATION

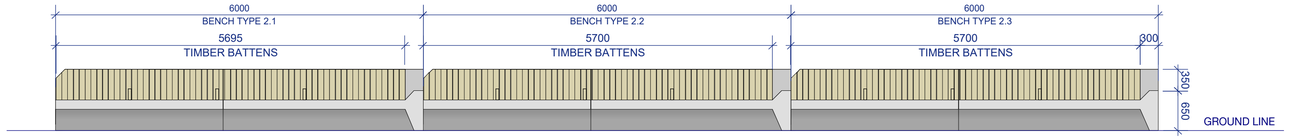



3 BENCH TYPE 2 | PRECAST CONCRETE WITH TIMBER INLAY
1:50 FRONT ELEVATION

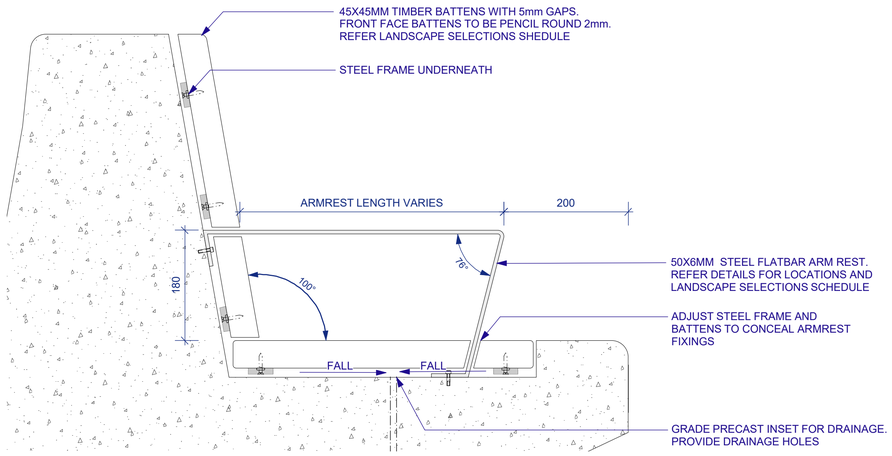


4 BE1 + BE2 | TYPICAL ARMREST AND TIMBER BATTEN FIXING TO FRAME
1:5

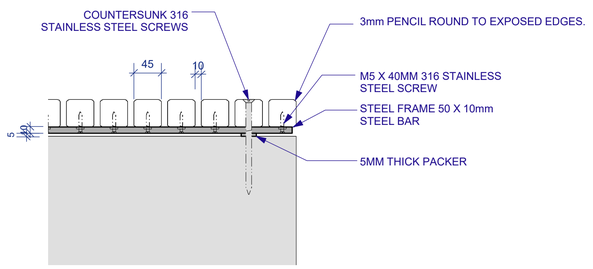


5 BE1 + BE2 + W1 | TYPICAL TIMBER AND FRAME FIXING
1:5

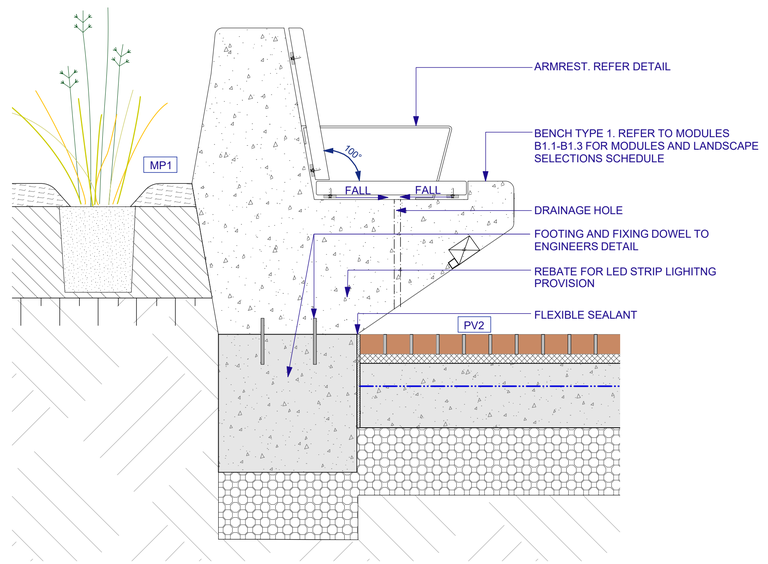


6 BENCH TYPE 1 | PRECAST CONCRETE | FIXING TO SLAB
1:10

**NOTES**

These drawings are shown in colour and shall be read in digital format or print colour hardcopy.

These drawings shall be read in conjunction with all relevant information (not limited to legends, schedules, specifications)

These drawings shall be read in conjunction with any Engineers, Architects or other consultant information. (not limited to drawings, legends, schedules, specifications)

Check all dimensions and site conditions prior to commencement of any work and the procurement of any services, materials, fittings, fabrication or equipment.

Do not scale drawings – refer to figured drawings only. Any discrepancies shall immediately be referred to the Landscape Architect for clarification.

All drawings shall not be reproduced or distributed without prior permission of the Landscape Architect.

**WARNING**

DIAL BEFORE YOU DIG www.1100.com.au®

Services shown on this drawing are approximate only. The exact location is to be confirmed on site by contractor prior to commencement of work.

| DATE | REV | AMENDMENTS |
|---|---|---|
| 28/2/19 | A | END OF FEBRUARY PACKAGE - FOR INFORMATION |
| 29/3/19 | B | 60% DD - FOR INFORMATION |
| 24/7/19 | C | REVISED TENDER - FOR INFORMATION |

NSW GOVERNMENT | Planning, Industry & Environment

*Issued under the Environmental Planning and Assessment Act 1979*

Approved Application No: SSD-9835 Signed:

Granted on the: 6 Dec 2019 Sheet No: 62 of 83

**ASPECT Studios™**

**ASPECT Studios Pty Ltd**
Level 1, 78-80 George Street
Redfern NSW 2016
Australia
T 02 9699 7182
www.aspect-studios.com
sydney@aspect-studios.com
ABN 11 120 219 561

CLIENT

we are insw Infrastructure New South Wales

PROJECT

SYDNEY FOOTBALL STADIUM
Moore Park, New South Wales
S18030

DRAWING

FURNITURE & FIXTURES DETAILS
Bench Type 1


| DRAWN | CHECKED | SCALE A1 \| SCALE A3 |
|---|---|---|
| JR \| DC | JH | |

STATUS NORTH


FOR INFORMATION
NOT FOR CONSTRUCTION

DRAWING NO. REVISION


LA-702 C

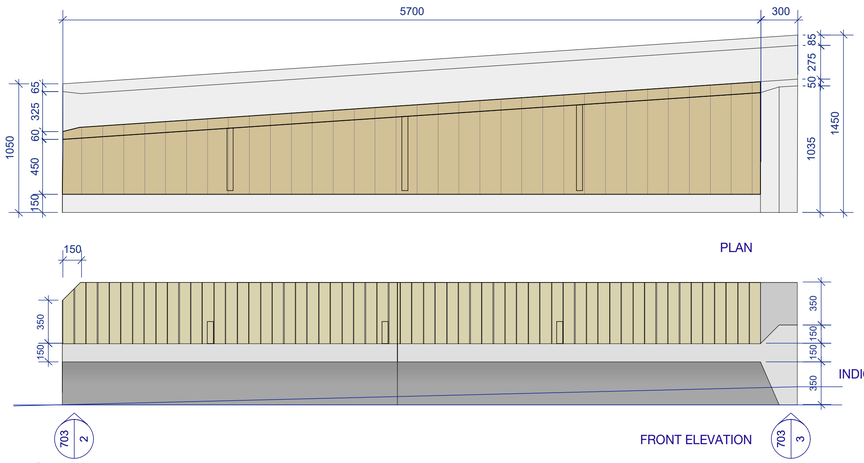


1 BENCH TYPE 1.1 | PRECAST CONCRETE WITH TIMBER INLAY
1:25

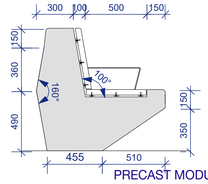



PRECAST MODULE

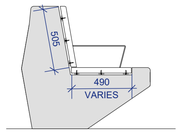



TIMBER BATTENS

2 BE1.1 | END ELEVATION
1:25

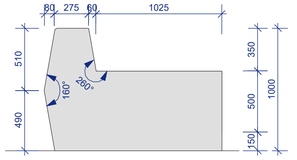



PRECAST MODULE


3 BE1.1 | END ELEVATION
1:25

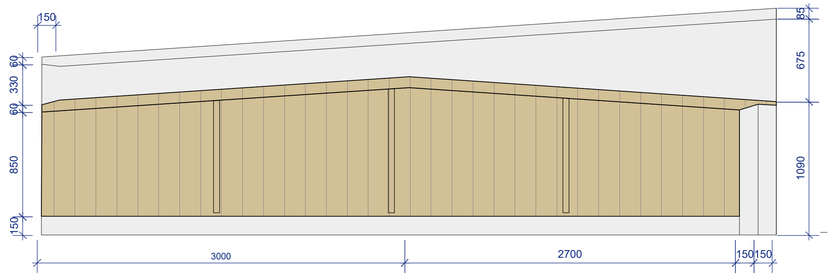


4 BENCH TYPE 1.2 | PRECAST CONCRETE WITH TIMBER INLAY
1:25

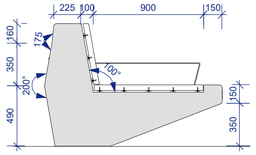



PRECAST MODULE

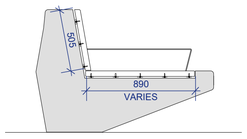



TIMBER BATTENS

5 BE1.2 | END ELEVATION
1:25

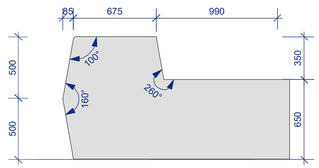


PRECAST MODULE

6 BE1.2 | END ELEVATION
1:25

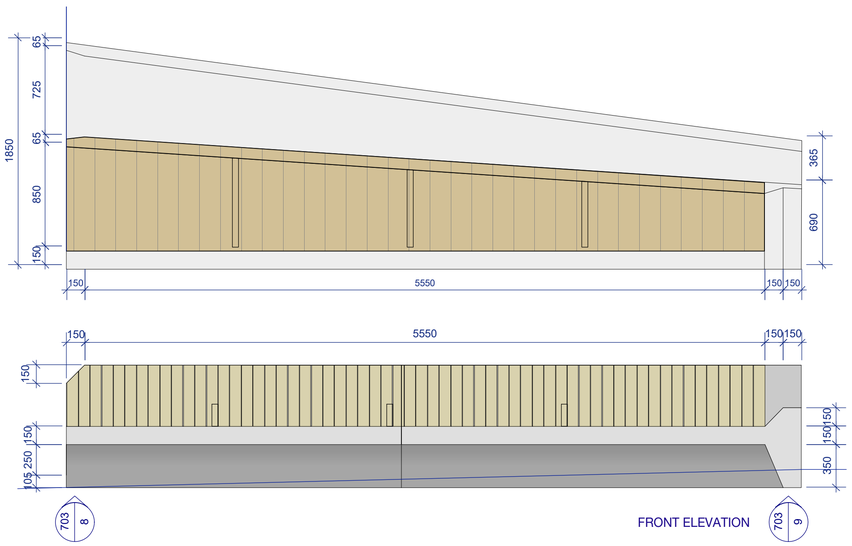



7 BENCH TYPE 1.3 | PRECAST CONCRETE WITH TIMBER INLAY
1:25

Planning, Industry & Environment
NSW GOVERNMENT


*Issued under the Environmental Planning and Assessment Act 1979*

Approved Application No: SSD-9835 Signed:


Granted on the: 6 Dec 2019 Sheet No: 63 of 83

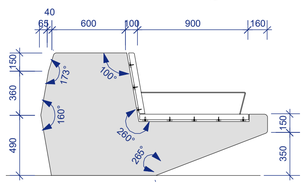


PRECAST MODULE

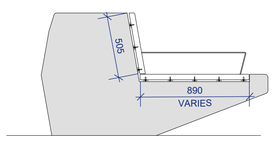


TIMBER BATTENS

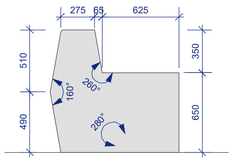


PRECAST MODULE

8 BE1.3 | END ELEVATION
1:25

9 BE1.3 | END ELEVATION
1:25

**NOTES**

These drawings are shown in colour and shall be read in digital format or print colour hardcopy.

These drawings shall be read in conjunction with all relevant information (not limited to legends, schedules, specifications)

These drawings shall be read in conjunction with any Engineers, Architects or other consultant information. (not limited to drawings, legends, schedules, specifications)

Check all dimensions and site conditions prior to commencement of any work and the procurement of any services, materials, fittings, fabrication or equipment.

Do not scale drawings – refer to figured drawings only. Any discrepancies shall immediately be referred to the Landscape Architect for clarification.

All drawings shall not be reproduced or distributed without prior permission of the Landscape Architect.

**WARNING**

DIAL BEFORE YOU DIG www.1100.com.au®

Services shown on this drawing are approximate only. The exact location is to be confirmed on site by contractor prior to commencement of work.

| DATE | REV | AMENDMENTS |
|---|---|---|
| 28/2/19 | A | END OF FEBRUARY PACKAGE - FOR INFORMATION |
| 29/3/19 | B | 60% DD - FOR INFORMATION |
| 24/7/19 | C | REVISED TENDER - FOR INFORMATION |

ASPECT Studios™
**ASPECT Studios Pty Ltd**
Level 1, 78-80 George Street
Redfern NSW 2016
Australia
T 02 9699 7182
www.aspect-studios.com
sydney@aspect-studios.com
ABN 11 120 219 561

**CLIENT**

we are insw Infrastructure New South Wales

**PROJECT**

SYDNEY FOOTBALL STADIUM
Moore Park, New South Wales
S18030

**DRAWING**

FURNITURE & FIXTURES DETAILS
Bench Type 1


| DRAWN | CHECKED | SCALE A1 \| SCALE A3 |
|---|---|---|
| JR \| DC | JH | |

**STATUS** **NORTH**


FOR INFORMATION
NOT FOR CONSTRUCTION

**DRAWING NO.** **REVISION**

LA-703 C

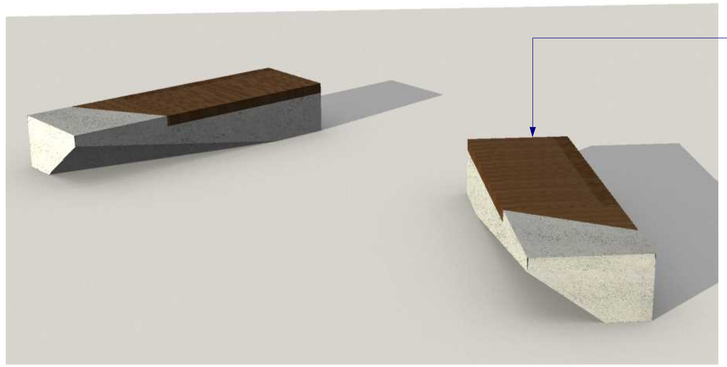


1 BENCH TYPE 3 | PRECAST CONCRETE WITH TIMBER INLAY
NTS PERSPECTIVE

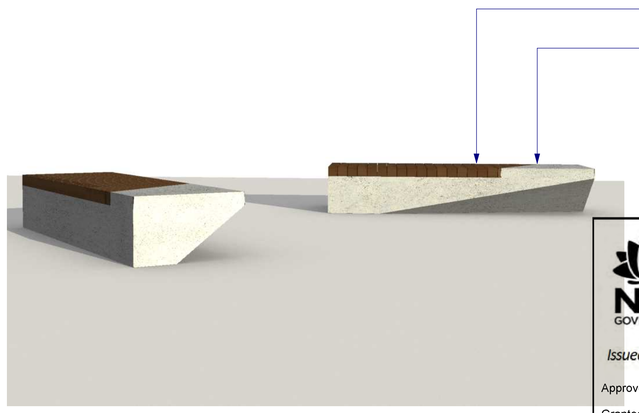


2 BENCH TYPE 3 | PRECAST CONCRETE WITH TIMBER INLAY
NTS PERSPECTIVE

NSW GOVERNMENT | Planning, Industry & Environment

*Issued under the Environmental Planning and Assessment Act 1979*

Approved Application No: SSD-9835 Signed:

Granted on the: 6 Dec 2019 Sheet No: 64 of 83

**NOTES**

These drawings are shown in colour and shall be read in digital format or print colour hardcopy.

These drawings shall be read in conjunction with all relevant information (not limited to legends, schedules, specifications)

These drawings shall be read in conjunction with any Engineers, Architects or other consultant information. (not limited to drawings, legends, schedules, specifications)

Check all dimensions and site conditions prior to commencement of any work and the procurement of any services, materials, fittings, fabrication or equipment.


Do not scale drawings – refer to figured drawings only. Any discrepancies shall immediately be referred to the Landscape Architect for clarification.

All drawings shall not be reproduced or distributed without prior permission of the Landscape Architect.

**WARNING**


DIAL BEFORE YOU DIG www.1100.com.au® Services shown on this drawing are approximate only. The exact location is to be confirmed on site by contractor prior to commencement of work.

| DATE | REV | AMENDMENTS |
|---|---|---|
| 28/2/19 | A | END OF FEBRUARY PACKAGE - FOR INFORMATION |
| 29/3/19 | B | 60% DD - FOR INFORMATION |
| 24/7/19 | C | REVISED TENDER - FOR INFORMATION |

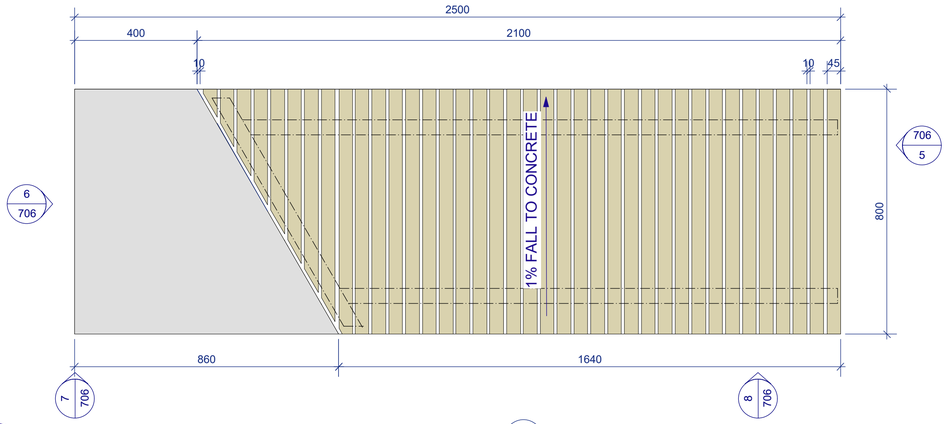



3 BENCH TYPE 3 | PRECAST CONCRETE WITH TIMBER INLAY
1:10 PLAN


BE3

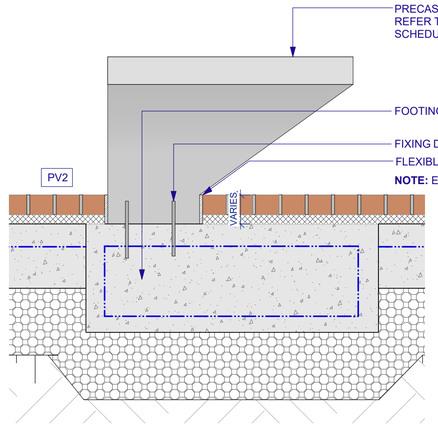



4 BENCH TYPE 3 | TYPICAL FIXING DETAIL
1:10

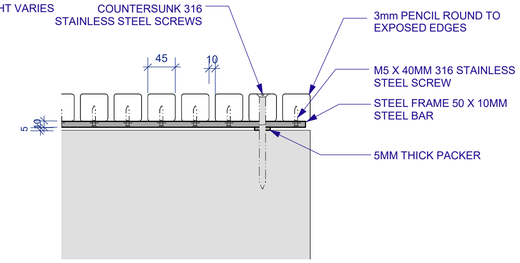



5 BENCH TYPE 3 | TYPICAL TIMBER AND FRAME FIXING
1:5

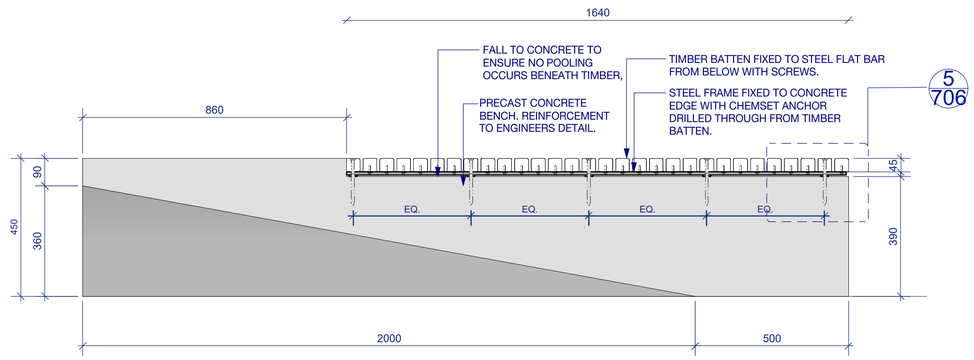


6 BENCH TYPE 3 | PRECAST CONCRETE WITH TIMBER INLAY
1:10 FRONT ELEVATION

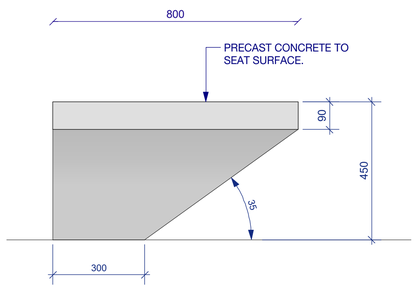


7 BENCH TYPE 3 | PRECAST CONCRETE WITH TIMBER INLAY
1:10 END ELEVATION

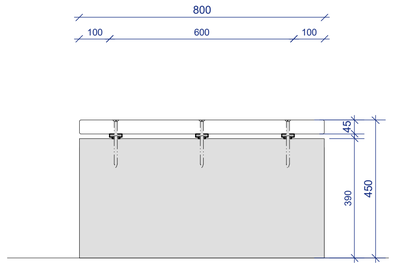


8 BENCH TYPE 3 | PRECAST CONCRETE WITH TIMBER INLAY
1:10 END ELEVATION


**ASPECT Studios™**

**ASPECT Studios Pty Ltd**
Level 1, 78-80 George Street
Redfern NSW 2016
Australia
T 02 9699 7182
www.aspect-studios.com
sydney@aspect-studios.com
ABN 11 120 219 561


**CLIENT**

we are insw Infrastructure New South Wales

**PROJECT**

SYDNEY FOOTBALL STADIUM
Moore Park, New South Wales

S18030

**DRAWING**

FURNITURE & FIXTURES DETAILS
Bench Type 3


| DRAWN | CHECKED | SCALE A1 \| SCALE A3 |
|---|---|---|
| JR \| DC | JH | |

**STATUS** **NORTH**

FOR INFORMATION
NOT FOR CONSTRUCTION


**DRAWING NO.** **REVISION**

LA-706 C

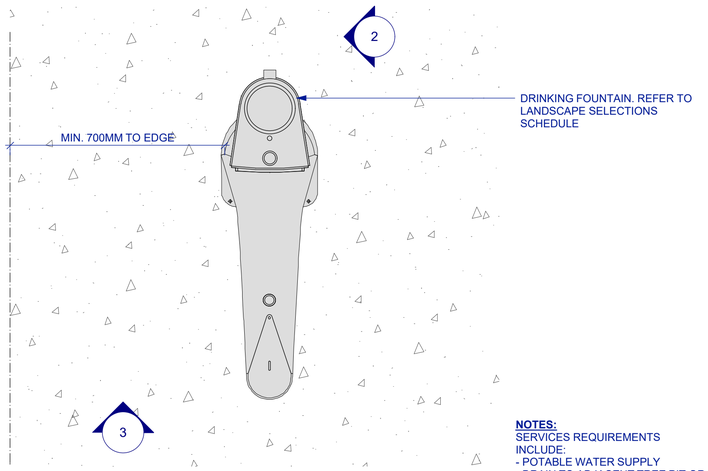



**NOTES:**
SERVICES REQUIREMENTS INCLUDE:
- POTABLE WATER SUPPLY
- DRAIN TO ADJACENT TREE PIT OR STORMWATER DRAINAGE SYSTEM

1 FURNITURE ELEMENT TYPE 3 | DRINKING FOUNTAIN
SCALE 1:10 FRONT ELEVATION F3

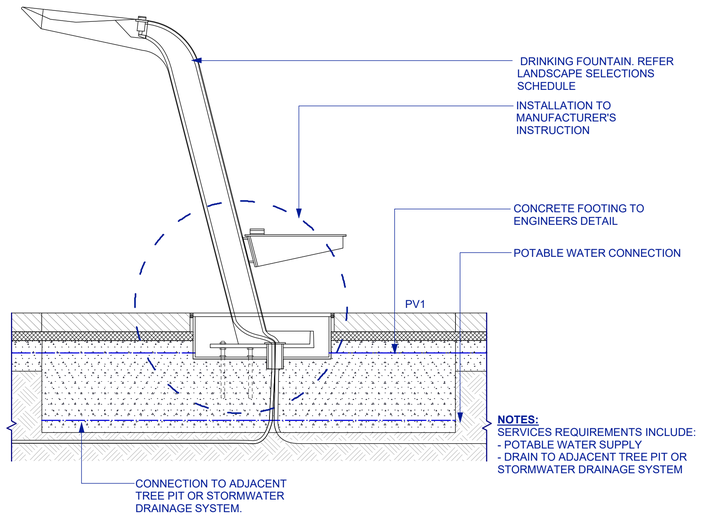


**NOTES:**
SERVICES REQUIREMENTS INCLUDE:
- POTABLE WATER SUPPLY
- DRAIN TO ADJACENT TREE PIT OR STORMWATER DRAINAGE SYSTEM

2 FURNITURE ELEMENT TYPE 3 | DRINKING FOUNTAIN
SCALE 1:10 SIDE ELEVATION F3

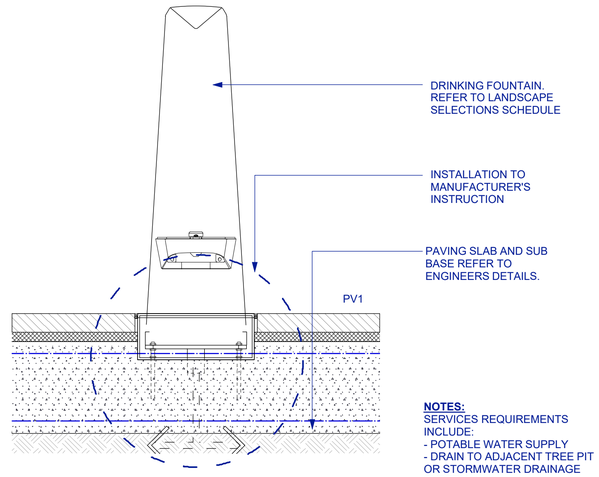


**NOTES:**
SERVICES REQUIREMENTS INCLUDE:
- POTABLE WATER SUPPLY
- DRAIN TO ADJACENT TREE PIT OR STORMWATER DRAINAGE SYSTEM

3 FURNITURE ELEMENT TYPE 3 | DRINKING FOUNTAIN
1:10 ELEVATION F3

**NOTES**

These drawings are shown in colour and shall be read in digital format or print colour hardcopy.

These drawings shall be read in conjunction with all relevant information (not limited to legends, schedules, specifications)

These drawings shall be read in conjunction with any Engineers, Architects or other consultant information. (not limited to drawings, legends, schedules, specifications)

Check all dimensions and site conditions prior to commencement of any work and the procurement of any services, materials, fittings, fabrication or equipment.

Do not scale drawings – refer to figured drawings only. Any discrepancies shall immediately be referred to the Landscape Architect for clarification.


All drawings shall not be reproduced or distributed without prior permission of the Landscape Architect.

**WARNING**


DIAL BEFORE YOU DIG www.1100.com.au®

Services shown on this drawing are approximate only. The exact location is to be confirmed on site by contractor prior to commencement of work.


| DATE | REV | AMENDMENTS |
|---|---|---|
| 28/2/19 | A | END OF FEBRUARY PACKAGE - FOR INFORMATION |
| 29/3/19 | B | 60% DD - FOR INFORMATION |
| 24/7/19 | C | REVISED TENDER - FOR INFORMATION |

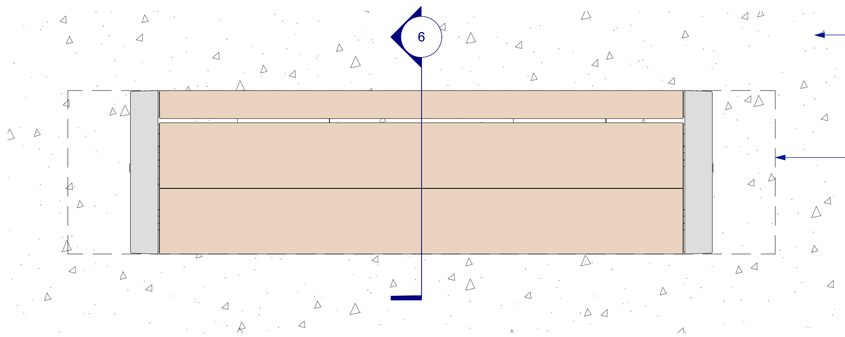


4 BENCH TYPE 5
SCALE 1:10 PLAN BE5

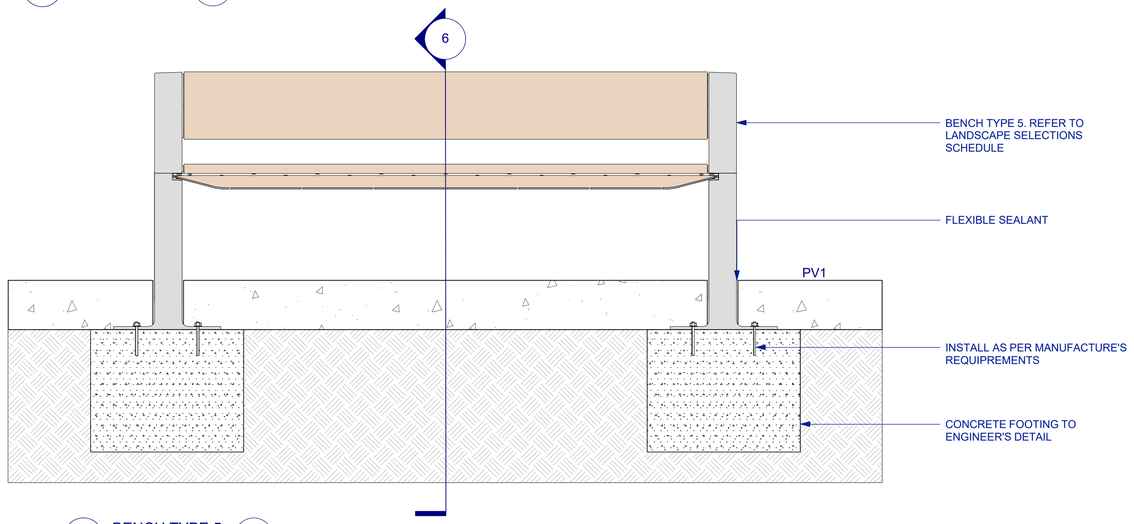


5 BENCH TYPE 5
SCALE 1:10 PLAN BE5

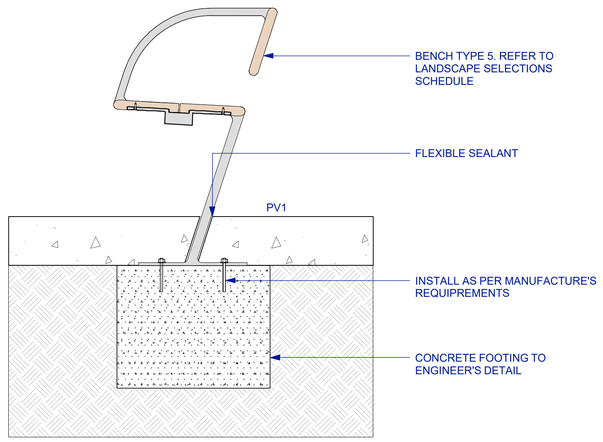


6 BENCH TYPE 5
SCALE 1:10 PLAN BE5

NSW GOVERNMENT | Planning, Industry & Environment

*Issued under the Environmental Planning and Assessment Act 1979*

Approved Application No: SSD-9835 Signed: A. Coomar

Granted on the: 6 Dec 2019 Sheet No: 65 of 83


**ASPECT Studios™**

**ASPECT Studios Pty Ltd**
Level 1, 78-80 George Street
Redfern NSW 2016
Australia
T 02 9699 7182
www.aspect-studios.com
sydney@aspect-studios.com
ABN 11 120 219 561


CLIENT
we are inSW Infrastructure New South Wales

PROJECT
SYDNEY FOOTBALL STADIUM
Moore Park, New South Wales
S18030


DRAWING
FURNITURE & FIXTURES DETAILS
Proprietary Furniture

| DRAWN | CHECKED | SCALE A1 \| SCALE A3 |
|---|---|---|
| JR \| DC | JH | |


STATUS NORTH

FOR INFORMATION
NOT FOR CONSTRUCTION


DRAWING NO. REVISION
LA-707 C

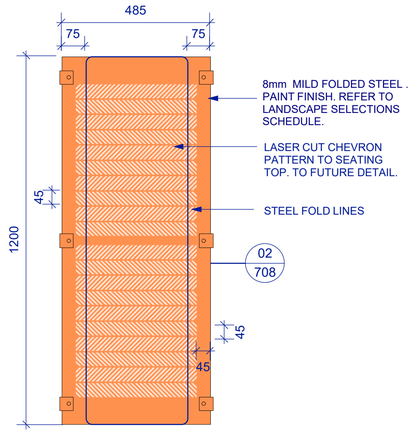


1 BENCH TYPE 5 | CUSTOM STEEL — PLAN
1:10 — B5

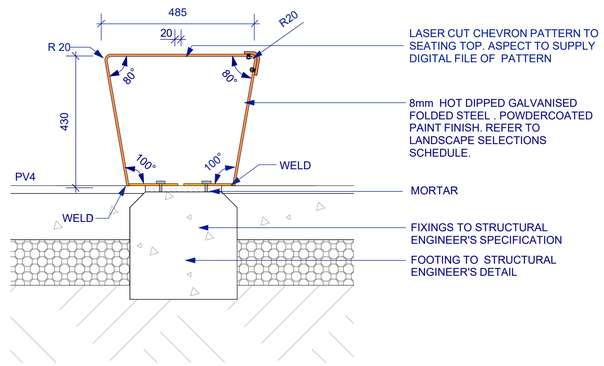


2 BENCH TYPE 5 | CUSTOM STEEL | FIXING DETAIL — SECTION
1:10 — B5

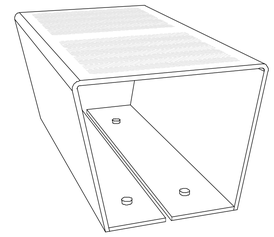

3 BENCH TYPE 5 | CUSTOM STEEL — 3D VIEW
1:10 — B5

**NOTES**

These drawings are shown in colour and shall be read in digital format or print colour hardcopy.

These drawings shall be read in conjunction with all relevant information (not limited to legends, schedules, specifications)

These drawings shall be read in conjunction with any Engineers, Architects or other consultant information. (not limited to drawings, legends, schedules, specifications)

Check all dimensions and site conditions prior to commencement of any work and the procurement of any services, materials, fittings, fabrication or equipment.

Do not scale drawings – refer to figured drawings only. Any discrepancies shall immediately be referred to the Landscape Architect for clarification.


All drawings shall not be reproduced or distributed without prior permission of the Landscape Architect.

**WARNING**


DIAL BEFORE YOU DIG www.1100.com.au®

Services shown on this drawing are approximate only. The exact location is to be confirmed on site by contractor prior to commencement of work.

| DATE | REV | AMENDMENTS |
|---|---|---|
| 29/3/19 | A | 60% DD - FOR INFORMATION |
| 24/7/19 | B | REVISED TENDER - FOR INFORMATION |

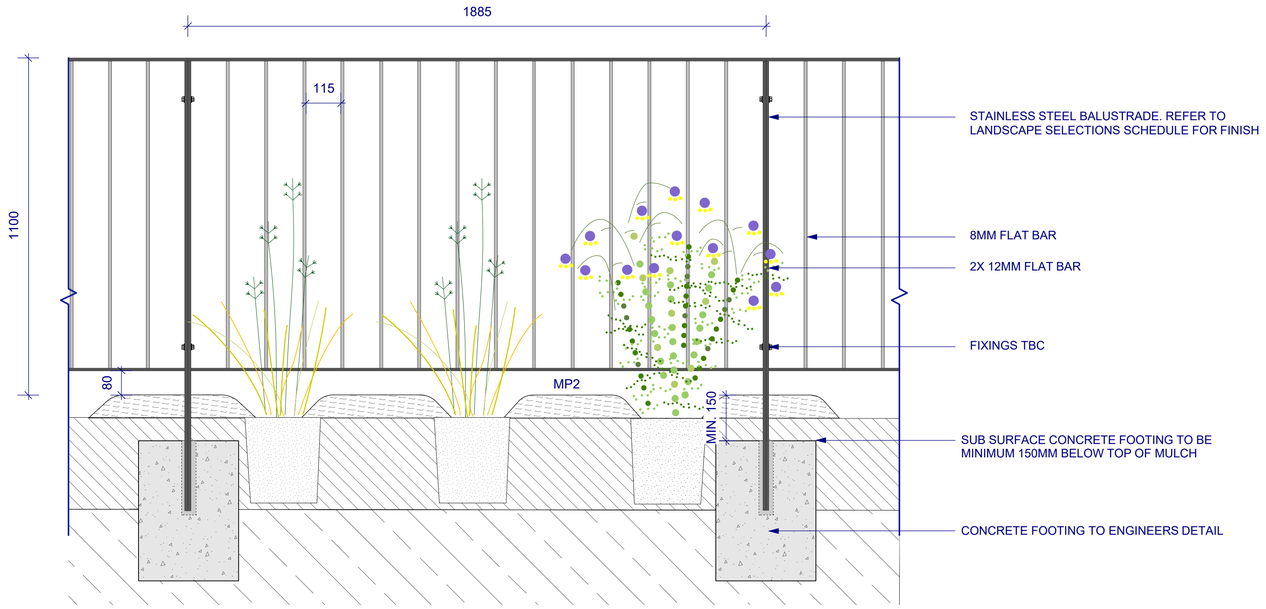


4 BALUSTRADE TYPE 1 | SECTION
1:10 — ELEVATION

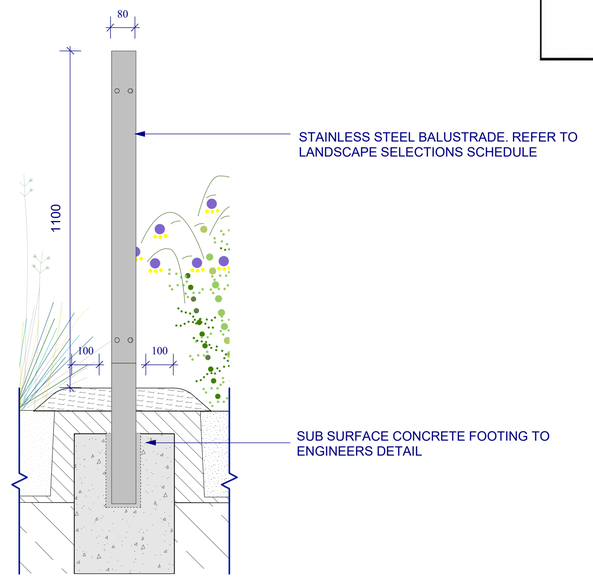


5 BALUSTRADE TYPE 1 | POST DETAIL
1:10 — ELEVATION

NSW GOVERNMENT | Planning, Industry & Environment

*Issued under the Environmental Planning and Assessment Act 1979*

Approved Application No: SSD-9835 Signed: A. Coonan

Granted on the: 6 Dec 2019 Sheet No: 66 of 83

**ASPECT Studios™**

**ASPECT Studios Pty Ltd**
Level 1, 78-80 George Street
Redfern NSW 2016
Australia
T 02 9699 7182
www.aspect-studios.com
sydney@aspect-studios.com
ABN 11 120 219 561

CLIENT

we are insw Infrastructure New South Wales

PROJECT

SYDNEY FOOTBALL STADIUM
Moore Park, New South Wales
S18030

DRAWING

FURNITURE & FIXTURES DETAILS
Balustrade Type 1


| DRAWN | CHECKED | SCALE A1 \| SCALE A3 |
|---|---|---|
| JR \| DC | JH | |

STATUS — NORTH


FOR INFORMATION
NOT FOR CONSTRUCTION

DRAWING NO. — REVISION


LA-708 B

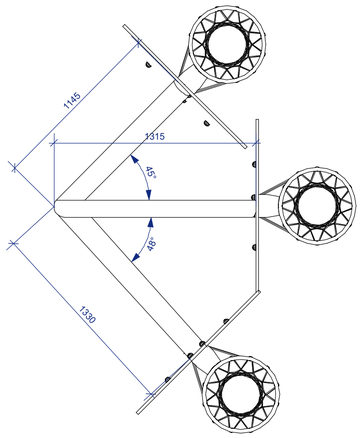


1 FITNESS EQUIPMENT TYPE 1 | BASKETBALL HOOP
1:10 PLAN

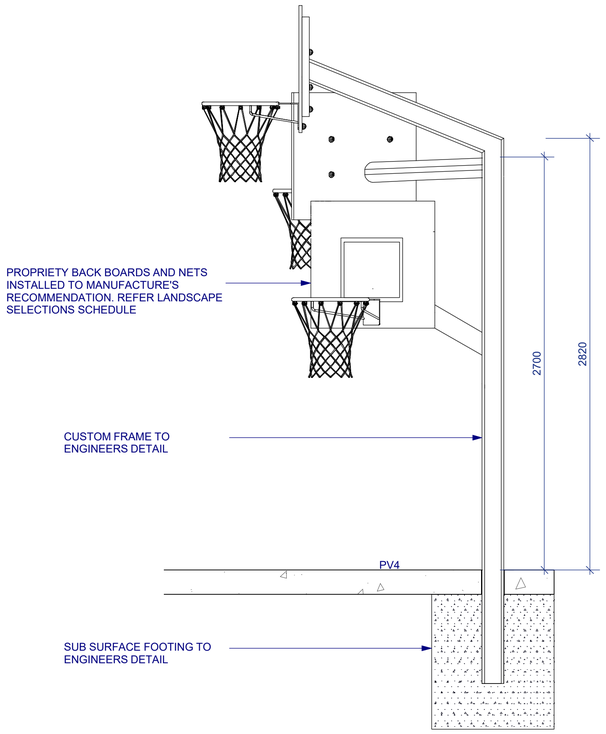


2 FITNESS EQUIPMENT TYPE 1 | POST DETAIL
1:10 PLAN SIDE ELEVATION

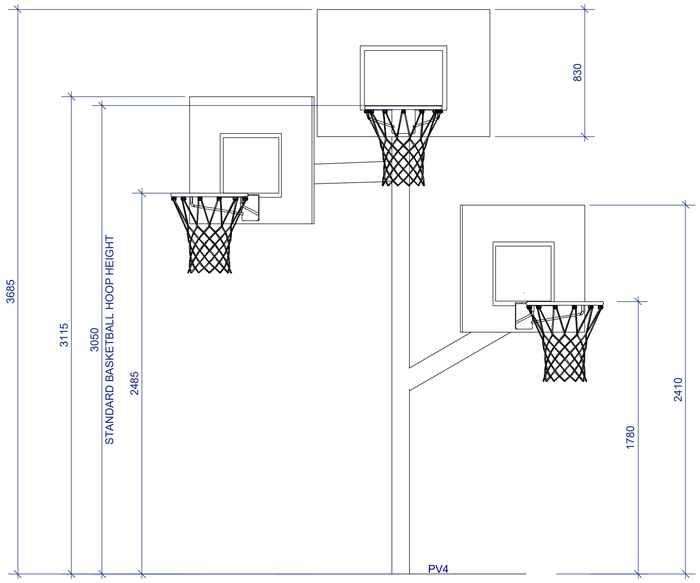


3 FITNESS EQUIPMENT TYPE 1 | BASKETBALL BACK BOARD AND NET
1:10 FRONT ELEVATION

**NOTES**

These drawings are shown in colour and shall be read in digital format or print colour hardcopy.

These drawings shall be read in conjunction with all relevant information (not limited to legends, schedules, specifications)

These drawings shall be read in conjunction with any Engineers, Architects or other consultant information. (not limited to drawings, legends, schedules, specifications)

Check all dimensions and site conditions prior to commencement of any work and the procurement of any services, materials, fittings, fabrication or equipment.

Do not scale drawings – refer to figured drawings only. Any discrepancies shall immediately be referred to the Landscape Architect for clarification.

All drawings shall not be reproduced or distributed without prior permission of the Landscape Architect.

**WARNING**

DIAL BEFORE YOU DIG www.1100.com.au® Services shown on this drawing are approximate only. The exact location is to be confirmed on site by contractor prior to commencement of work.


| DATE | REV | AMENDMENTS |
|---|---|---|
| 29/3/19 | A | 60% DD - FOR INFORMATION |
| 24/7/19 | B | REVISED TENDER - FOR INFORMATION |

NSW GOVERNMENT | Planning, Industry & Environment


*Issued under the Environmental Planning and Assessment Act 1979*

Approved Application No: SSD-9835 Signed: A. Coomes

Granted on the: 6 Dec 2019 Sheet No: 67 of 83

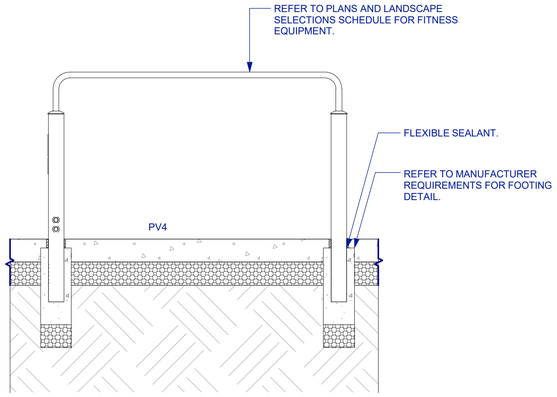


4 FITNESS EQUIPMENT | TYPICAL FIXING
1:10 SECTION

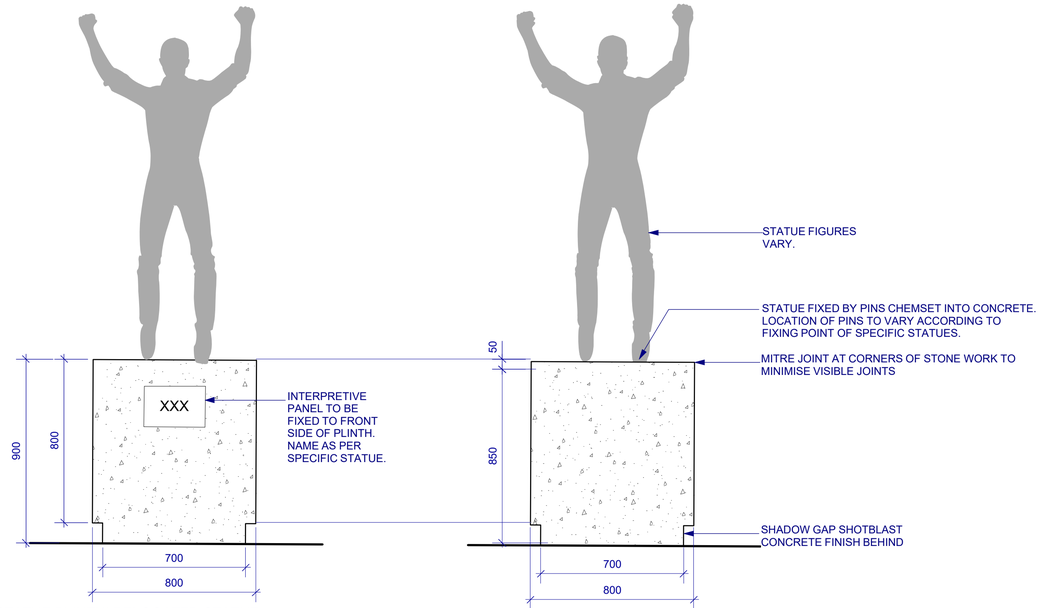


5 STATUE PLINTH| RELOCATED STATUE
1:10 SECTION


ASPECT Studios™

**ASPECT Studios Pty Ltd**
Level 1, 78-80 George Street
Redfern NSW 2016
Australia
T 02 9699 7182
www.aspect-studios.com
sydney@aspect-studios.com
ABN 11 120 219 561


**CLIENT**

we are insw Infrastructure New South Wales

**PROJECT**

SYDNEY FOOTBALL STADIUM
Moore Park, New South Wales
S18030

**DRAWING**

FURNITURE & FIXTURES DETAILS
Fitness Equipment and Statues


| DRAWN | CHECKED | SCALE A1 \| SCALE A3 |
|---|---|---|
| JR \| DC | JH | |

**STATUS** **NORTH**


FOR INFORMATION
NOT FOR CONSTRUCTION

**DRAWING NO.** **REVISION**


LA-709 B

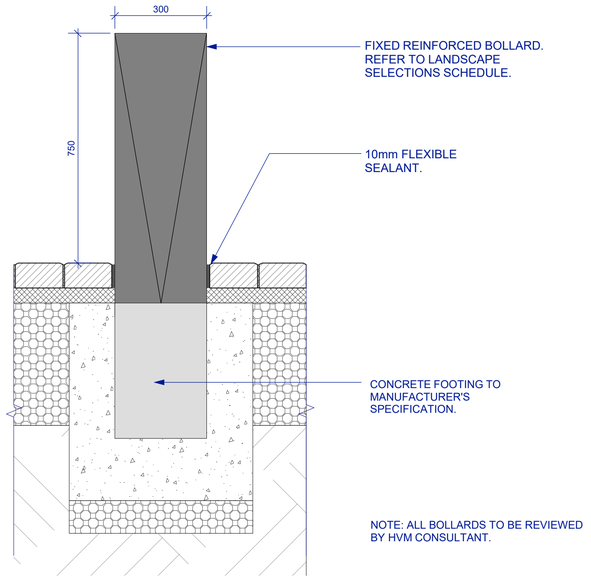


1 BOLLARD TYPE 1 -FEATURE FIXED
1:10 SECTION BL1

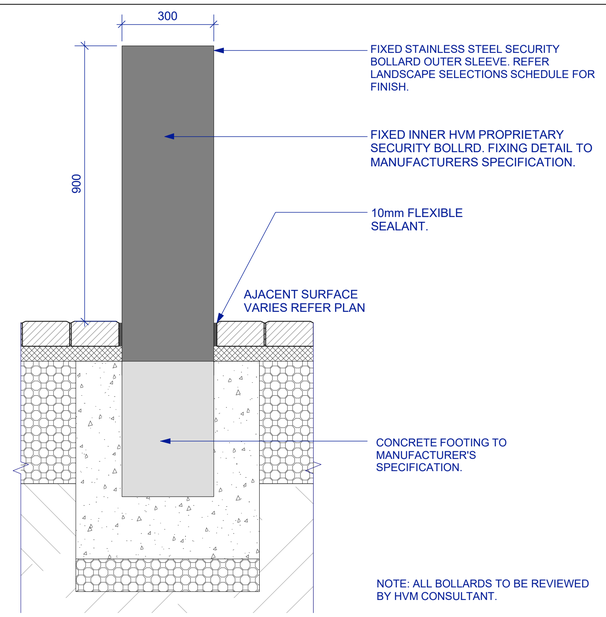


2 BOLLARD TYPE 2 -FIXED
1:10 SECTION BL2

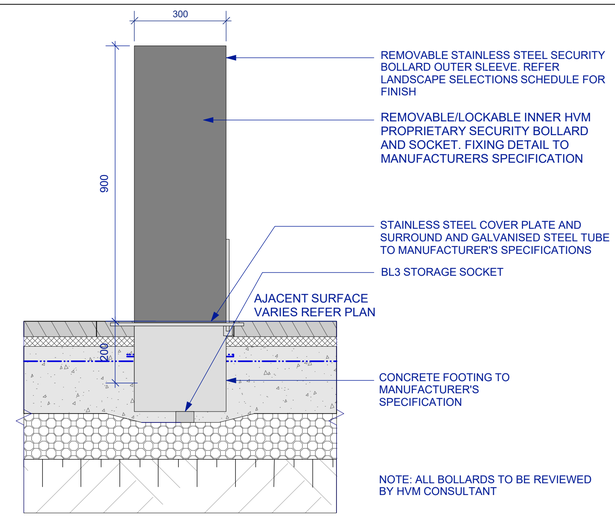


3 BOLLARD TYPE 3 -REMOVABLE
1:10 SECTION BL3

**NOTES**

These drawings are shown in colour and shall be read in digital format or print colour hardcopy.

These drawings shall be read in conjunction with all relevant information (not limited to legends, schedules, specifications)

These drawings shall be read in conjunction with any Engineers, Architects or other consultant information. (not limited to drawings, legends, schedules, specifications)

Check all dimensions and site conditions prior to commencement of any work and the procurement of any services, materials, fittings, fabrication or equipment.


Do not scale drawings – refer to figured drawings only. Any discrepancies shall immediately be referred to the Landscape Architect for clarification.

All drawings shall not be reproduced or distributed without prior permission of the Landscape Architect.


**WARNING**

DIAL BEFORE YOU DIG www.1100.com.au® Services shown on this drawing are approximate only. The exact location is to be confirmed on site by contractor prior to commencement of work.

| DATE | REV | AMENDMENTS |
|---|---|---|
| 29/3/19 | A | 60% DD - FOR INFORMATION |
| 24/7/19 | B | REVISED TENDER - FOR INFORMATION |

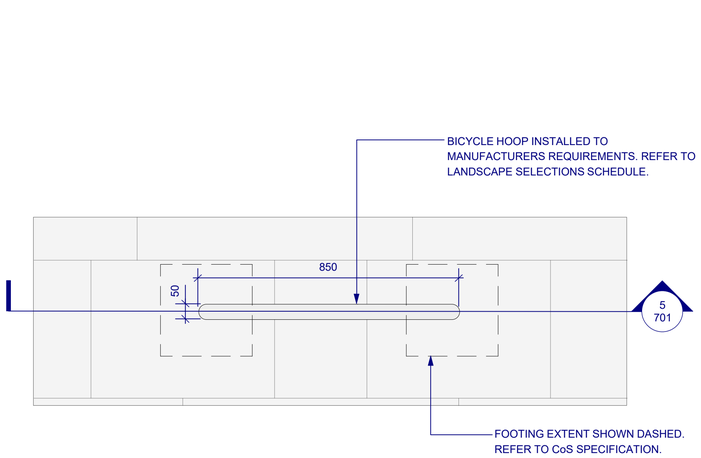


4 FURNITURE ELEMENT TYPE 1 | BICYCLE HOOP
1:10 PLAN F1

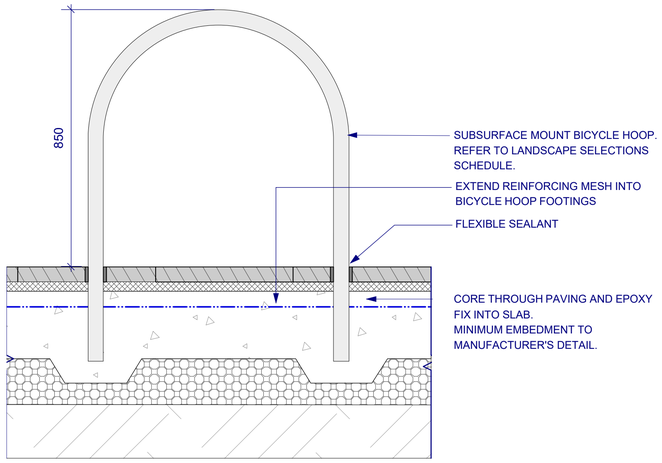


5 FURNITURE ELEMENT TYPE 1 | BICYCLE HOOP
1:10 SECTION F1

NSW GOVERNMENT | Planning, Industry & Environment

*Issued under the Environmental Planning and Assessment Act 1979*

Approved Application No: SSD-9835 Signed: A. Coonan

Granted on the: 6 Dec 2019 Sheet No: 68 of 83

**ASPECT Studios™**

**ASPECT Studios Pty Ltd**
Level 1, 78-80 George Street
Redfern NSW 2016
Australia
T 02 9699 7182
www.aspect-studios.com
sydney@aspect-studios.com
ABN 11 120 219 561

CLIENT
we are insw Infrastructure New South Wales

PROJECT
SYDNEY FOOTBALL STADIUM
Moore Park, New South Wales
S18030


DRAWING
FURNITURE & FIXTURES DETAILS
Furniture & Fixtures 11

| DRAWN | CHECKED | SCALE A1 \| SCALE A3 |
|---|---|---|
| JR \| DC | JH | |


STATUS NORTH

FOR INFORMATION
NOT FOR CONSTRUCTION

DRAWING NO. REVISION
LA-711 B

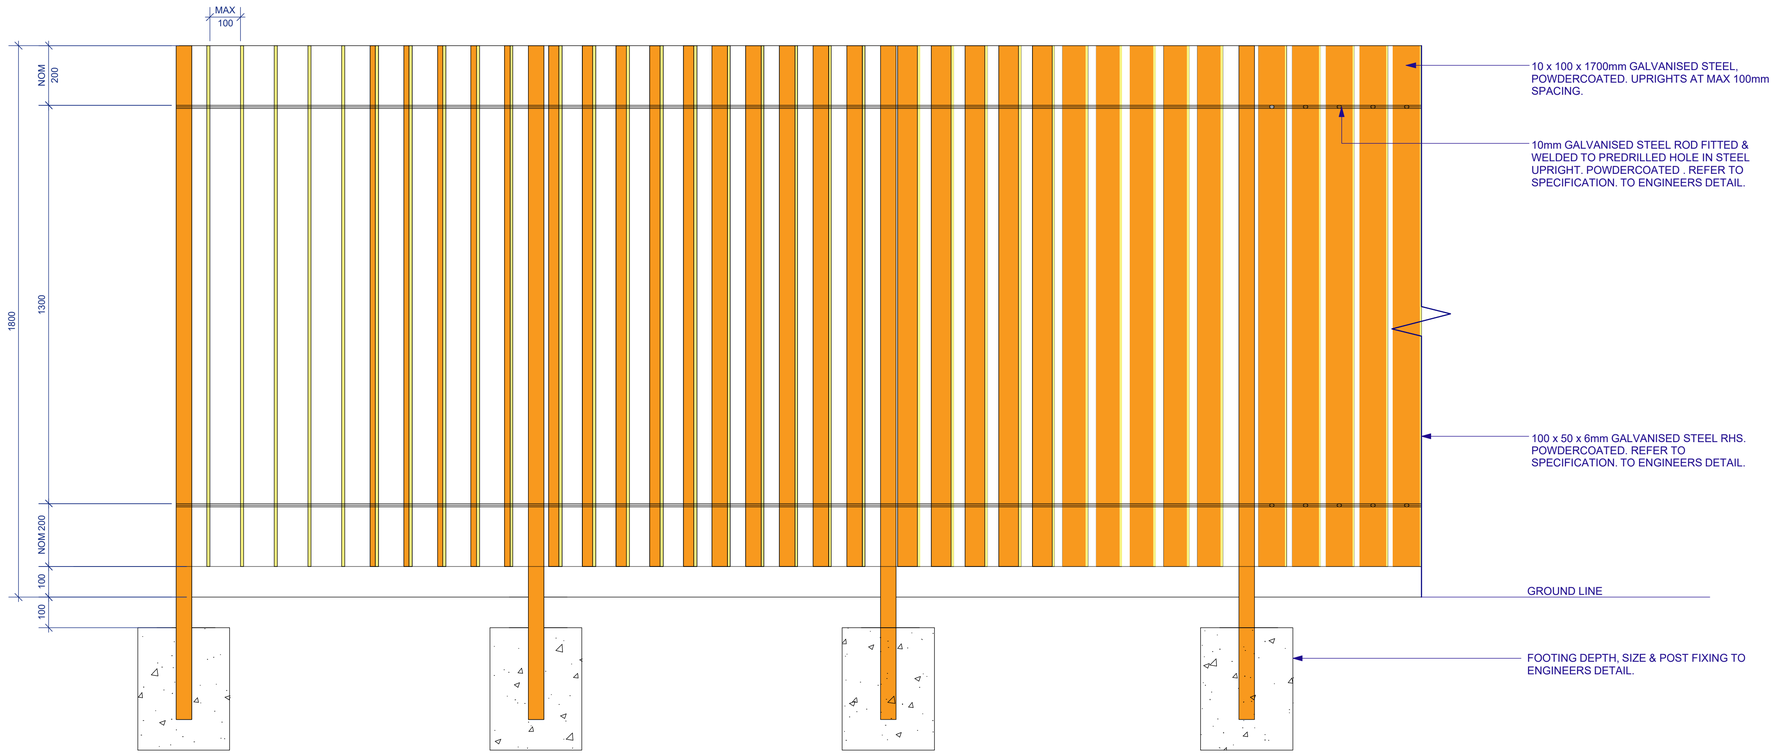


1 FURNITURE ELEMENT TYPE 4 | CUSTOM FRAME
1:10 ELEVATION

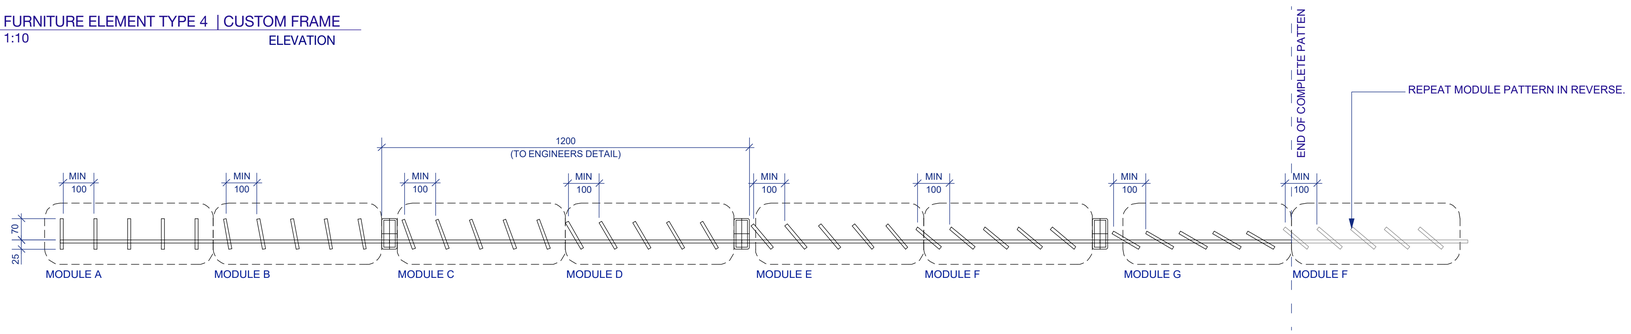


2 FURNITURE ELEMENT TYPE 4 | CUSTOM FRAME
1:10 PLAN

**NOTES**

These drawings are shown in colour and shall be read in digital format or print colour hardcopy.

These drawings shall be read in conjunction with all relevant information (not limited to legends, schedules, specifications)

These drawings shall be read in conjunction with any Engineers, Architects or other consultant information. (not limited to drawings, legends, schedules, specifications)

Check all dimensions and site conditions prior to commencement of any work and the procurement of any services, materials, fittings, fabrication or equipment.

Do not scale drawings – refer to figured drawings only. Any discrepancies shall immediately be referred to the Landscape Architect for clarification.

All drawings shall not be reproduced or distributed without prior permission of the Landscape Architect.

**WARNING**

DIAL BEFORE YOU DIG www.1100.com.au®

Services shown on this drawing are approximate only. The exact location is to be confirmed on site by contractor prior to commencement of work.

| DATE | REV | AMENDMENTS |
|---|---|---|
| 29/3/19 | A | 60% DD - FOR INFORMATION |
| 24/7/19 | B | REVISED TENDER - FOR INFORMATION |

NSW GOVERNMENT | Planning, Industry & Environment

*Issued under the Environmental Planning and Assessment Act 1979*

Approved Application No: SSD-9835 Signed:

Granted on the: 6 Dec 2019 Sheet No: 69 of 83

**ASPECT Studios™**

**ASPECT Studios Pty Ltd**
Level 1, 78-80 George Street
Redfern NSW 2016
Australia
T 02 9699 7182
www.aspect-studios.com
sydney@aspect-studios.com
ABN 11 120 219 561

CLIENT
we are insw Infrastructure New South Wales

PROJECT
SYDNEY FOOTBALL STADIUM
Moore Park, New South Wales
S18030

DRAWING
FURNITURE & FIXTURES DETAILS
Custom Screen


| DRAWN | CHECKED | SCALE A1 \| SCALE A3 |
|---|---|---|
| JR \| DC | JH | |

STATUS NORTH


FOR INFORMATION
NOT FOR CONSTRUCTION

DRAWING NO. REVISION

LA-712 B

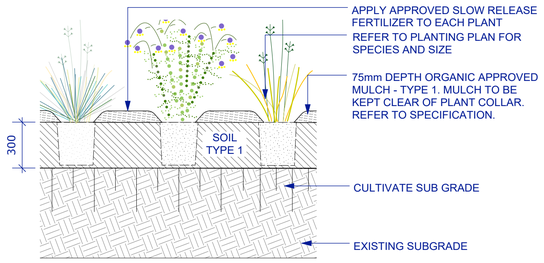


1 MASS PLANTING TYPE 1 | ON GRADE
SCALE 1:20 SECTION

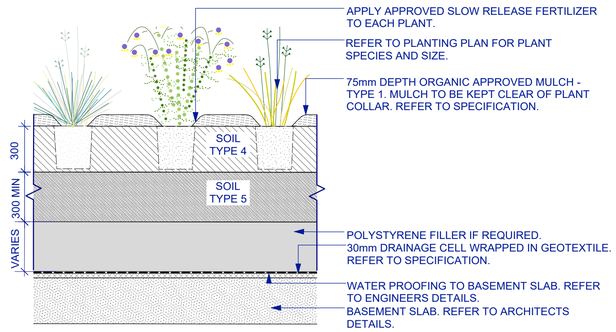


2 MASS PLANTING TYPE 2 | ON STRUCTURE
SCALE 1:20 SECTION

**NOTE:**

**SOIL TYPES (REFER TO SPECIFICATION)**

SOIL TYPE 1 - 'A' HORIZON ON GRADE

SOIL TYPE 2 - 'B' HORIZON ON GRADE

SOIL TYPE 3 - 'A' HORIZON FOR TURF ON GRADE

SOIL TYPE 4 - 'A' HORIZON ON SLAB

SOIL TYPE 5 - 'B' HORIZON ON SLAB

SOIL TYPE 6 - STRATA CELL WITH SOIL TYPES 1 & 2

SOIL TYPE 7 - RAINGARDEN AND STORMWATER FILTRATION SOIL

**NOTES**

These drawings are shown in colour and shall be read in digital format or print colour hardcopy.

These drawings shall be read in conjunction with all relevant information (not limited to legends, schedules, specifications)

These drawings shall be read in conjunction with any Engineers, Architects or other consultant information. (not limited to drawings, legends, schedules, specifications)

Check all dimensions and site conditions prior to commencement of any work and the procurement of any services, materials, fittings, fabrication or equipment.

Do not scale drawings – refer to figured drawings only. Any discrepancies shall immediately be referred to the Landscape Architect for clarification.

All drawings shall not be reproduced or distributed without prior permission of the Landscape Architect.

**WARNING**

DIAL BEFORE YOU DIG www.1100.com.au

Services shown on this drawing are approximate only. The exact location is to be confirmed on site by contractor prior to commencement of work.


| DATE | REV | AMENDMENTS |
|---|---|---|
| 28/2/19 | A | END OF FEBRUARY PACKAGE - FOR INFORMATION |
| 29/3/19 | B | 60% DD - FOR INFORMATION |
| ~~24/7/19~~ | C | ~~REVISED TENDER - FOR INFORMATION~~ |

NSW GOVERNMENT | Planning, Industry & Environment


*Issued under the Environmental Planning and Assessment Act 1979*

Approved Application No: SSD-9835 Signed: A. Coleman


Granted on the: 6 Dec 2019 Sheet No: 70 of 83

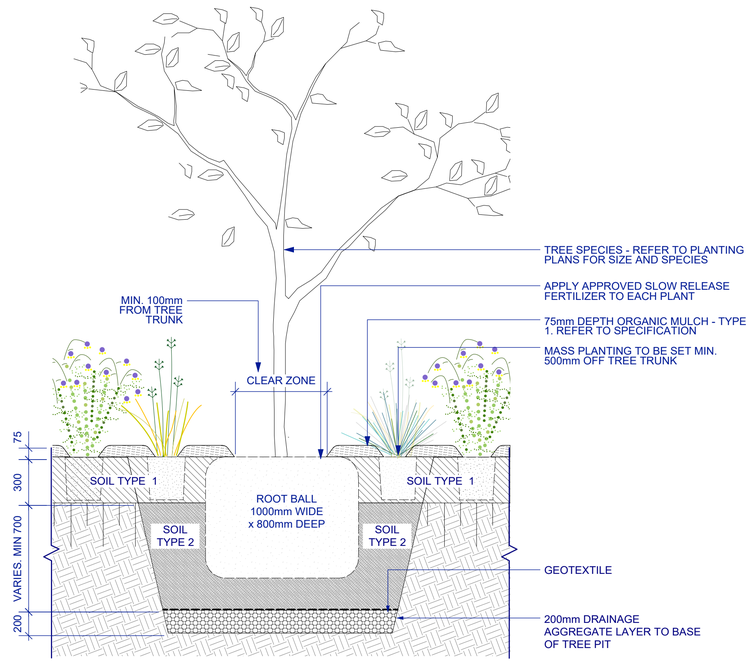


3 MASS PLANTING TYPE 1 | PROPOSED TREE | ON GRADE
SCALE 1:20 SECTION

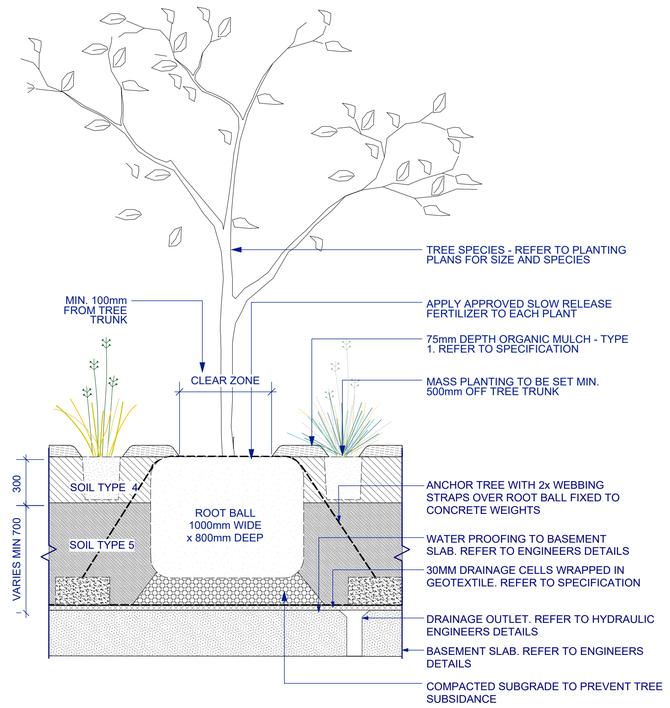


4 MASS PLANTING TYPE 2 | PROPOSED TREE | ON STRUCTURE
SCALE 1:20 SECTION

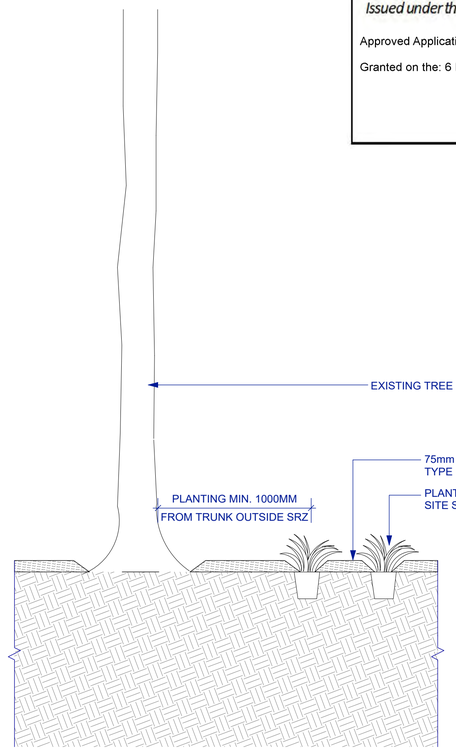


5 MASS PLANTING TYPE 4| TO EXISITING TREE
SCALE 1:20 SECTION

**ASPECT Studios™**

**ASPECT Studios Pty Ltd**
Level 1, 78-80 George Street
Redfern NSW 2016
Australia
T 02 9699 7182
www.aspect-studios.com
sydney@aspect-studios.com
ABN 11 120 219 561

**CLIENT**

we are insw Infrastructure New South Wales

**PROJECT**

SYDNEY FOOTBALL STADIUM
Moore Park, New South Wales
S18030

**DRAWING**

SOFTWORKS DETAILS
Softworks Details 1


| DRAWN | CHECKED | SCALE A1 \| SCALE A3 |
|---|---|---|
| JR \| DC | JH | |

**STATUS** **NORTH**


FOR INFORMATION
NOT FOR CONSTRUCTION

**DRAWING NO.** **REVISION**

LA-801 C

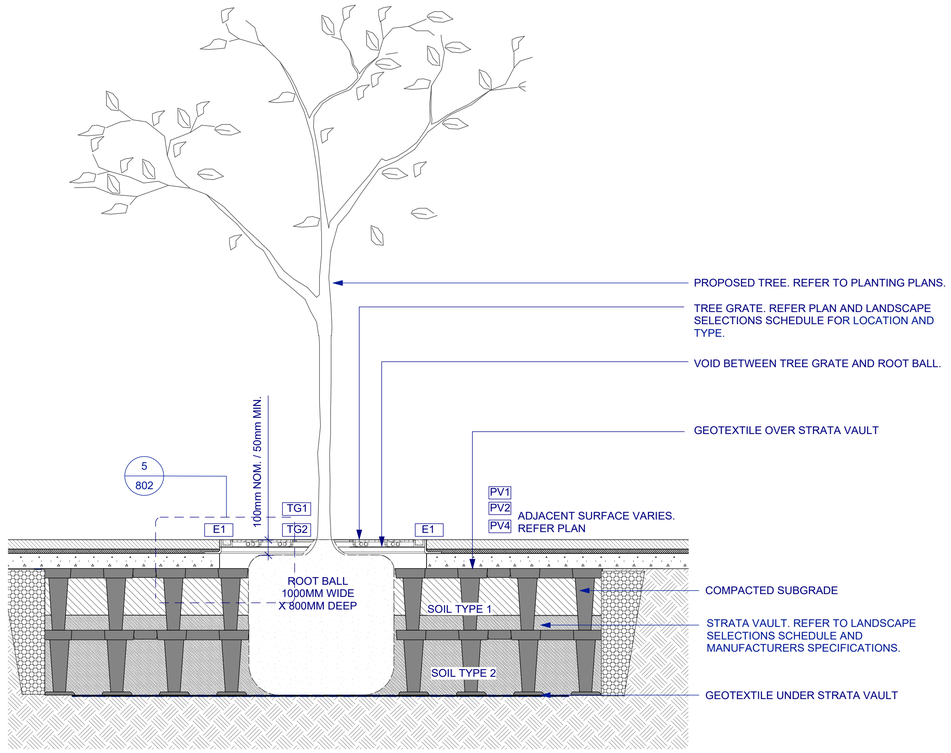


1 TREE GRATE TYPE 1 | WITH STRATA VAULT | ON GRADE
SCALE 1:20
SECTION

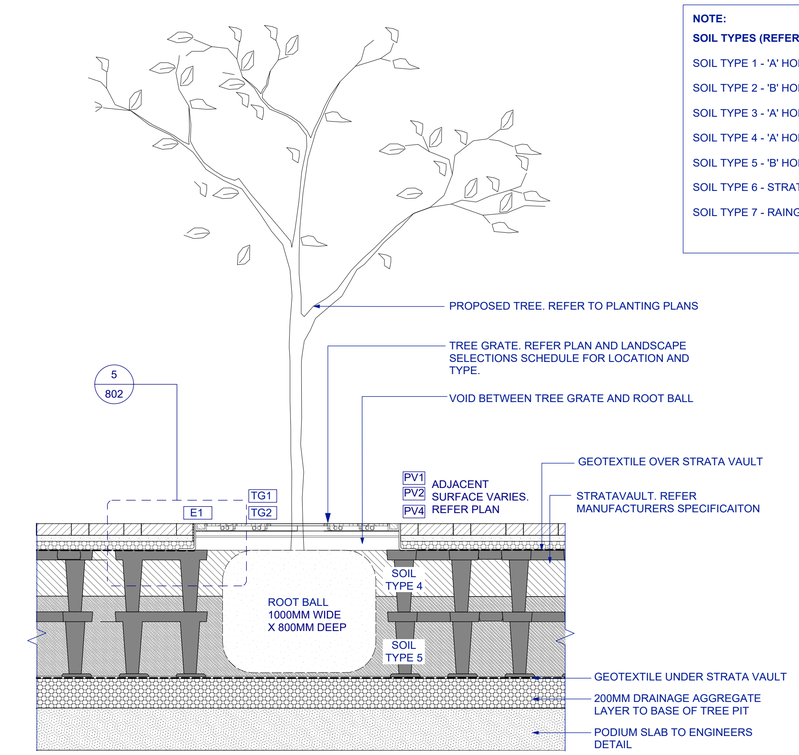


2 TREE GRATE TYPE 1 | WITH STRATA VAULT | ON STRUCTURE
SCALE 1:20
SECTION

**NOTE:**

**SOIL TYPES (REFER TO SPECIFICATION)**

SOIL TYPE 1 - 'A' HORIZON ON GRADE

SOIL TYPE 2 - 'B' HORIZON ON GRADE

SOIL TYPE 3 - 'A' HORIZON FOR TURF ON GRADE

SOIL TYPE 4 - 'A' HORIZON ON SLAB

SOIL TYPE 5 - 'B' HORIZON ON SLAB

SOIL TYPE 6 - STRATA CELL WITH SOIL TYPES 1 & 2

SOIL TYPE 7 - RAINGARDEN AND STORMWATER FILTRATION SOIL

**NOTES**

These drawings are shown in colour and shall be read in digital format or print colour hardcopy.

These drawings shall be read in conjunction with all relevant information (not limited to legends, schedules, specifications)

These drawings shall be read in conjunction with any Engineers, Architects or other consultant information. (not limited to drawings, legends, schedules, specifications)

Check all dimensions and site conditions prior to commencement of any work and the procurement of any services, materials, fittings, fabrication or equipment.

Do not scale drawings – refer to figured drawings only. Any discrepancies shall immediately be referred to the Landscape Architect for clarification.

All drawings shall not be reproduced or distributed without prior permission of the Landscape Architect.

**WARNING**

DIAL BEFORE YOU DIG www.1100.com.au

Services shown on this drawing are approximate only. The exact location is to be confirmed on site by contractor prior to commencement of work.


| DATE | REV | AMENDMENTS |
|---|---|---|
| 28/2/19 | A | END OF FEBRUARY PACKAGE - FOR INFORMATION |
| 29/3/19 | B | 60% DD - FOR INFORMATION |
| ~~24/7/19~~ | C | REVISED TENDER - FOR INFORMATION |

NSW GOVERNMENT | Planning, Industry & Environment


*Issued under the Environmental Planning and Assessment Act 1979*

Approved Application No: SSD-9835 Signed:


Granted on the: 6 Dec 2019 Sheet No: 71 of 83

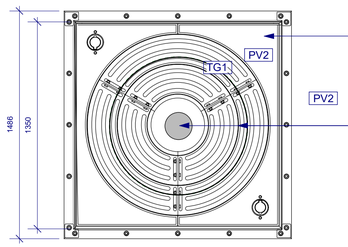


3 TREE GRATE TYPE 1 - PAVER INFILL
SCALE 1:20
PLAN

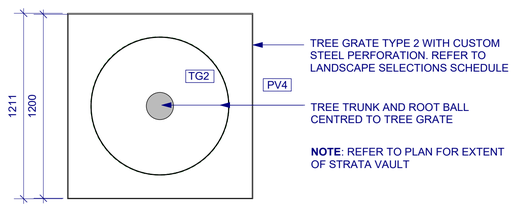


4 TREE GRATE TYPE 2 - INSTALLATION INTO PLEXIPAVE
SCALE 1:20
PLAN

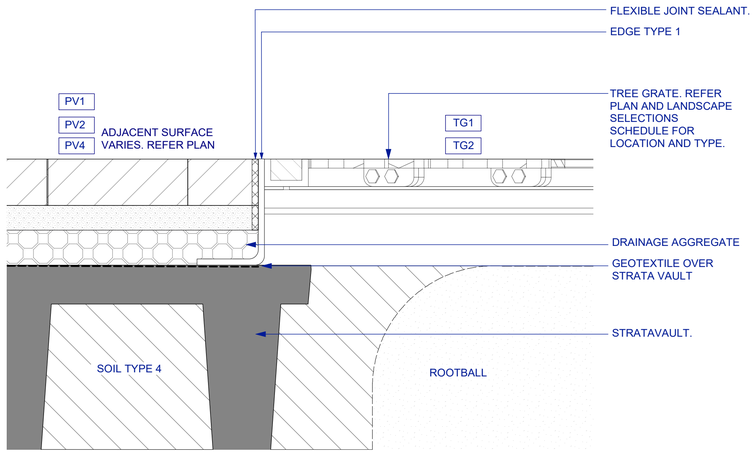


5 TREE GRATE TYPE 1 AND 2 | EDGE FIXING DETAIL
SCALE 1:5
SECTION

**ASPECT Studios™**

**ASPECT Studios Pty Ltd**
Level 1, 78-80 George Street
Redfern NSW 2016
Australia
T 02 9699 7182
www.aspect-studios.com
sydney@aspect-studios.com
ABN 11 120 219 561

**CLIENT**

we are insw Infrastructure New South Wales

**PROJECT**

SYDNEY FOOTBALL STADIUM
Moore Park, New South Wales
S18030

**DRAWING**

SOFTWORKS DETAILS
Tree Grate and Strata Vault

| DRAWN | CHECKED | SCALE A1 \| SCALE A3 |
|---|---|---|
| JR \| DC | JH | |

**STATUS** **NORTH**

FOR INFORMATION
NOT FOR CONSTRUCTION

**DRAWING NO.** **REVISION**

LA-802 C

MOORE PARK ROAD

OATLEY ROAD

RUGBY AUSTRALIA BUILDING

DRIVER AVENUE

KIPPAX LAKE

CRICKET NSW

SYDNEY CRICKET GROUND

FOX STUDIOS

PROPOSED OSD TANK BELOW

EXISTING OSD TANK BELOW

EXISTING OSD TANK BELOW

NOTES

These drawings are shown in colour and shall be read in digital format or print colour hardcopy.

These drawings shall be read in conjunction with all relevant information (not limited to legends, schedules, specifications)

These drawings shall be read in conjunction with any Engineers, Architects or other consultant information. (not limited to drawings, legends, schedules, specifications)

Check all dimensions and site conditions prior to commencement of any work and the procurement of any services, materials, fittings, fabrication or equipment.

Do not scale drawings – refer to figured drawings only. Any discrepancies shall immediately be referred to the Landscape Architect for clarification.

All drawings shall not be reproduced or distributed without prior permission of the Landscape Architect.

WARNING

DIAL BEFORE YOU DIG www.1100.com.au

Services shown on this drawing are approximate only. The exact location is to be confirmed on site by contractor prior to commencement of work.

| DATE | REV | AMENDMENTS |
|---|---|---|
| 29/3/19 | A | 60% DO - FOR INFORMATION |
| 24/7/19 | B | REVISED TENDER - FOR INFORMATION |
| 6/8/19 | C | REVISED TENDER - FOR INFORMATION |

LEGEND

DEEP SOIL AREAS

1.2m SOIL DEPTH AREAS

NSW GOVERNMENT | Planning, Industry & Environment

*Issued under the Environmental Planning and Assessment Act 1979*

Approved Application No: SSD-9835 Signed:

Granted on the: 6 Dec 2019 Sheet No: 72 of 83

**ASPECT Studios™**

**ASPECT Studios Pty Ltd**
Level 1, 78-80 George Street
Redfern NSW 2016
Australia
T 02 9699 7182
www.aspect-studios.com
sydney@aspect-studios.com
ABN 11 120 219 561

CLIENT

we are iNSW Infrastructure New South Wales

PROJECT

SYDNEY FOOTBALL STADIUM
Moore Park, New South Wales

S18030

DRAWING

SOFTWORKS DETAILS
Ground Level Soil Depths

| DRAWN | CHECKED | SCALE A0 \| SCALE A2 |
|---|---|---|
| DC | JH | 1:500 1:1000 |

0 10 20 40M

STATUS

FOR INFORMATION
NOT FOR CONSTRUCTION

NORTH

DRAWING NO. LA-810

REVISION C

05_PRODUCTION\02_Phase 02 (SSDA)\01_CAD\18030_LA_810 [Landscape Soils Diagram].vwx

# ASPECT Studios
## PROJECT NAME

## LANDSCAPE SELECTIONS SCHEDULE

| | |
|---|---|
| **Document No:** | **S18030-LS-001** |
| **Date:** | **24.07.2019** |
| **Revision:** | **Revised Tender – For Information** |
| **Issue** | **B** |
| **Notes:** | **Items shown in red represent change within current version** |

| CODE | DESCRIPTION | SPECIFICATION SECTION | SPECIFICATION<br>NOTE: all selections are in draft and are subject to refinement prior to issue of final tender package | RECOMMENDED SUPPLIER (OR SIMILAR APPROVED) | SAMPLE & PROTOTYPE REQUIREMENTS (to be submitted 5 days prior to required sign-off) | SHOP DRAWING REQUIREMENTS (to be submitted 5 days prior to required sign-off) |
|---|---|---|---|---|---|---|
| **PAVEMENTS & SURFACES** | | | | | | |
| **PV1** | **INSITU CONCRETE PAVING** | **274 315** | **Colour:** Portland Grey cement<br>**Aggregate**: Riverina Granite 55%, Sunset Gold Marble 20%, White Felspar 15% and Black Granite 10% (subject to review and approval of prototype).<br>**Aggregate size:** 6-14mm (subject to review and approval of prototype)<br>**Finish:** varies as below<br>PV1.1: Light grit blast to honed finish<br>PV1.2: Medium grit blast to honed finish<br>PV1.3: Broom Finish – no tooled edges<br>PV1.4: Medium grit blast to honed finish<br>**Thickness**: THICKNESS TO BE CONFIRMED BY CIVIL ENGINEER<br>**Slip Resistance Classification (AS4586)**: P4 where grade is less than 1:33 (3%), P5 where grade is steeper than 1:33 (3%)<br>**Pattern**: NA<br>**Joints**: SUBJECT TO CONFIRMATION BY CIVIL ENGINEER Refer to pavements section for application method<br>**Bedding type / fixing**: SUBJECT TO CONFIRMATION BY CIVIL ENGINEER<br>**Basecourse**: Refer to Civil Engineers Drawing<br>**Subgrade**: Refer to Civil Engineers Drawing<br>**Sealer**: TBA | **Supplier**: TBC<br>**Contact**: TBC | **Samples**: None<br>**Prototype**: Up to 3 1m x 1m with substrate, finish, joints and expressed edges as documented. Prototype will not form part of final landscape | |
| **PV2** | **BRICK PAVING** | **331** | **Selection and Surface Finish: London** Brick paving<br>**Side Finish:** TBC<br>**Plan dimension: A:** 230 x 114mm<br>**Thickness:** 65mm<br>**Slip Resistance Classification (AS4586):** P4 where grade is less than 1:33 (3%), P5 where grade is steeper than 1:33 (3%)<br>**Pattern:** Varies as below:<br>PV2.1: Stretcher Bond<br>PV2.2: English Bond<br>PV2.3: Flemish Bond<br>**Colour:** Maple (60%), Chestnut (40%)<br>**Joint:** mortar joint. Refer to pavements section for application method<br>**Bedding type / fixing:** Mortar **SUBJECT TO CONFIRMATION BY CIVIL ENGINEER**<br>**Basecourse:** Refer to Civil Engineers Drawing<br>**Subgrade:** Refer to Civil Engineers Drawing<br>**Sealer:** TBA<br>**Note:** Clay bricks and pavers shall be made from naturally occurring minerals that are kiln fired to lock in their colour and strength for life. Clay paving units shall be sound, firm, dense, free of distortion, dimensionally stable and consistent, with a smooth upper surface and with un-rumbled units having unbroken edges as specified evenly all round. Units which exhibit cracking, bloating or are considered by the Landscape Architect or superintendent to be excessively porous, brittle or friable shall be liable to rejection. | **Supplier:** Austral Bricks<br>**Contact:** | **Samples:** 3 x samples required for product approval to be signed by landscape architect and client. Must be approved prior to installation.<br>**Prototype**: Up to 3 1m x 1m with substrate, finish, joints and expressed edges as documented. Prototype will not form part of final landscape | |

NSW GOVERNMENT | Planning, Industry & Environment

*Issued under the Environmental Planning and Assessment Act 1979*

Approved Application No: SSD-9835 Signed: A. Coonan

Granted on the: 6 Dec 2019 Sheet No: 73 of 83

| CODE | DESCRIPTION | SPECIFICATION SECTION | SPECIFICATION<br>NOTE: all selections are in draft and are subject to refinement prior to issue of final tender package | RECOMMENDED SUPPLIER (OR SIMILAR APPROVED) | SAMPLE & PROTOTYPE REQUIREMENTS (to be submitted 5 days prior to required sign-off) | SHOP DRAWING REQUIREMENTS (to be submitted 5 days prior to required sign-off) |
|---|---|---|---|---|---|---|
| **PV3** | **BRICK PAVING (CoS STANDARD)** | **331** | **Selection and Surface Finish:** Brick paving<br>Maple<br>Chestnut<br>**Side Finish:** TBC<br>**Plan dimension: A:** 230 x 114mm<br>**Thickness:** 65mm<br>**Slip Resistance Classification (AS4586):** P4 where grade is less than 1:33 (3%), P5 where grade is steeper than 1:33 (3%)<br>**Pattern:** Stretcher Bond<br>**Joint:** mortar joint. Refer to pavements section for application method<br>**Bedding type / fixing:** Mortar **SUBJECT TO CONFIRMATION BY CIVIL ENGINEER**<br>**Basecourse:** Refer to Civil Engineers Drawing<br>**Subgrade:** Refer to Civil Engineers Drawing<br>**Sealer:** DuPont StoneTech Professional Heavy Duty Exterior Sealer<br>**Note:** Clay bricks and pavers shall be made from naturally occurring minerals that are kiln fired to lock in their colour and strength for life. Clay paving units shall be sound, firm, dense, free of distortion, dimensionally stable and consistent, with a smooth upper surface and with un-rumbled units having unbroken edges as specified evenly all round. Units which exhibit cracking, bloating or are considered by the Landscape Architect or superintendent to be excessively porous, brittle or friable shall be liable to rejection. | **Supplier:** Austral Bricks<br>**Contact:** | **Samples:** 3 x samples required for product approval to be signed by landscape architect and client. Must be approved prior to installation.<br>**Prototype:** 1m x 1m with substrate & finish as documented. Prototype may form part of final landscape if approved. | |
| **PV4** | **PLEXIPAVE** | **274**<br>**315** | **Plexipave**<br>**Selection**: 3 coats Plexipave Allsports surface or equivalent, max 30mm depth<br>**Linemarking**: Plexicolor multi-sport marking<br>**Colour**: multiple colours - Allow 4<br>**Slip Resistance Classification (AS4586**): P4 where grade is less than 1:33 (3%), P5 where grade is steeper than 1:33 (3%)<br>**Note**: Application as per manufacturer's specification<br>**Concrete Paving**<br>**Thickness**: THICKNESS TO BE CONFIRMED BY CIVIL ENGINEER<br>**Joints**: SUBJECT TO CONFIRMATION BY CIVIL ENGINEER<br>**Bedding type / fixing**: SUBJECT TO CONFIRMATION BY CIVIL ENGINEER<br>**Basecourse**: Refer to Civil Engineers Drawing<br>**Subgrade**: Refer to Civil Engineers Drawing | **Supplier:**<br>**Contact:** | **Samples**: Provide sample colour swatches for final approval prior to application/prototyping<br>**Prototype**: 1m x 1m with substrate & finish as documented. Prototype will not form part of final landscape | |
| **PV5** | **INTERPRETIVE PAVING INLAY** | **275** | **Custom:** to future detail<br>**Material:** Cast Bronze<br>**Finish**: Anti-Slip | **Supplier:**<br>**Contact:** | **Samples**: TBC<br>**Test panel**: TBC | **Shop Drawing**: Shop Drawings to be provided for Approval by Landscape Architect prior to manufacture. |
| **PIT** | **PIT WITH PAVING INFILL** | **314** | **Type and Size:** SUBJECT TO CONFIRMATION BY CIVIL ENGINEER<br>**Class Loading:** SUBJECT TO CONFIRMATION BY CIVIL ENGINEER<br>**Finish:** Paving infill to match adjacent paving | **Supplier:**<br>**Contact:** | **Samples:** 1x samples required for product approval to be signed by landscape architect and client. Must be approved prior to installation.<br>**Prototype:** 1m x 1m with substrate & finish as documented. Prototype may form part of final landscape if approved. | |
| **DRAINS** | | | | | | |
| | **STRIP DRAIN** | | **Product:** Type 676D Iron Intercept Heelsafe Anti-Slip grate<br>**Material:** Ductile Iron<br>**Finish**: Anti-Slip<br>**Class**: SUBJECT TO CONFIRMATION BY CIVIL ENGINEER<br>**Fixings:** to manufacturers recommendation | **Supplier: ACO** | | |
| **EDGES** | | | | | | |
| **E1** | **FLUSH STEEL EDGE** | 241<br>**345** | **Material:** Ductile Iron Angle<br>**Finish**: Natural sand cast and polished finish, to surface face. Replicated if not achieved during casting process<br>**Thickness:** 6mm<br>**Fixings:** Fixing to concrete slab / concrete footing prior to waterproofing being applied to engineers specification. | **Supplier:** -<br>**Contact:** - | **Samples:** 1 x 1m length | |
| **E2** | **EXPRESSED STEEL EDGE** | 241<br>**345** | **Material:** Galvanised Steel<br>**Finish**: Micaceous Iron Oxide<br>**Colour**: Natural Grey<br>**Thickness:** 6mm<br>**Fixings:** Fixing to concrete slab / concrete hob prior to waterproofing being applied to engineers specification. | **Supplier:** -<br>**Contact:** - | **Samples:** 1 x 1m length | |

NSW GOVERNMENT | Planning, Industry & Environment

*Issued under the Environmental Planning and Assessment Act 1979*

Approved Application No: SSD-9835 Signed: A. Coonan

Granted on the: 6 Dec 2019 Sheet No: 74 of 83

| CODE | DESCRIPTION | SPECIFICATION SECTION | SPECIFICATION<br>NOTE: all selections are in draft and are subject to refinement prior to issue of final tender package | RECOMMENDED SUPPLIER (OR SIMILAR APPROVED) | SAMPLE & PROTOTYPE REQUIREMENTS (to be submitted 5 days prior to required sign-off) | SHOP DRAWING REQUIREMENTS (to be submitted 5 days prior to required sign-off) |
|---|---|---|---|---|---|---|
| **E3** | **EXPRESSED STEEL EDGE** | 241<br>**345** | **Material:** Galvanised Steel<br>**Finish**: Micaceous Iron Oxide<br>**Colour**: Natural Grey<br>**Thickness:** 6mm<br>**Fixings:** Fixing to concrete slab / concrete hob prior to waterproofing being applied to engineers specification. | **Supplier:** -<br>**Contact:** - | **Samples:** 1 x 1m length | |
| **E4** | **FEATURE STEEL EDGE** | **241** | **Type:** Cast Ductile Iron paving inlay<br>**Material:** Ductile Iron<br>**Description**: 20mm rod with anchor and 20mm thick surface face<br>**Grade**: EN-GJS-400-18 Austempered Ductile Iron<br>**Finish**: Natural sand cast and polished finish, to surface face. Replicated if not achieved during casting process<br>**Standards**: AS1428.1<br>**Fixing:** Refer to details | **Supplier:** -<br>**Contact:** - | **Samples:** 1 x 1m length | |
| | **SPIGOT FIXING** | **241** | **Cover Plate:**<br>**Material:** Cast Iron<br>**Finish**: TBA<br>**Fixing:** Refer to details | | **Samples:** 1 cover plate | |
| **STAIRS AND RAMPS** | | | | | | |
| **ST1** | **PRECAST CONCRETE STAIRS** | **241**<br>**321** | **Selection:** Precast concrete<br>**Size:** Refer to details<br>**Colour:** Portland Grey cement<br>**Aggregate**: Riverina Granite 55%, Sunset Gold Marble 20%, White Felspar 15% and Black Granite 10% (subject to review and approval of prototype).<br>**Aggregate size:** 6-14mm (subject to review and approval of prototype)<br>**Surface finish:** Milled with light shot blast to top surface only as required to meet slip resistance requirements.<br>**Slip Resistance Classification (AS4586):** P4<br>**Joints:** Refer to engineer's details<br>**Reinforcing:** To Structural Engineer's details<br>**Nosing:** Latham Asbrabronz Solid Brass Safety Inset Tread (BFA771SB) with brown grit infill Final colour selection subject to receipt of samples | **Supplier:** -<br>**Contact:** - | **Samples**: 1 x length sample required for product approval to be signed by Landscape Architect and client. Must be approved prior to installation. 2x lengths laid in place as detailed to confirm fit and finish.<br>**Prototype**: Small set of steps for prototype. Steps for prototype to be decided on site with contractor prior to commencement of construction. | **Shop Drawing**: Shop Drawings to be provided for Approval by Landscape Architect prior to manufacture. |
| **ST2** | **INSITU CONCRETE STAIRS** | **241** | **Size:** Refer to details<br>**Colour:** Portland Grey cement<br>**Aggregate**: Riverina Granite 55%, Sunset Gold Marble 20%, White Felspar 15% and Black Granite 10% (subject to review and approval of prototype).<br>**Aggregate size:** 6-14mm (subject to review and approval of prototype)<br>**Colour control:** 1<br>**Surface finish class to AS 3610.1:** 2<br>**Supplementary finish:** Milled<br>**Top surface finish type:** Steel trowelled<br>**Formwork Lining:** Non-staining mineral oil, grease or other approved agent to ensure non-adhesion of the concrete.<br>**Joints:** Refer to engineer's details<br>**Slip Resistance Classification (AS4586):** P4<br>**Joints:** Refer to engineer's details<br>**Reinforcing:** To Structural Engineer's details<br>**Nosing:** Latham Asbrabronz Solid Brass Safety Inset Tread (BFA771SB) with brown grit infill Final colour selection subject to receipt of samples | **Supplier:** -<br>**Contact:** - | **Samples**: 1 x length sample required for product approval to be signed by Landscape Architect and client. Must be approved prior to installation. 2x lengths laid in place as detailed to confirm fit and finish.<br>**Prototype**: 300 x 300mm sample concrete panel demonstrating oxide colour, aggregate colour and size and finish for approval | |
| **TR1** | **PRECAST CONCRETE TERRACES** | **241**<br>**321** | **Selection:** Precast concrete<br>**Size:** Refer to details<br>**Colour:** Portland Grey cement<br>**Aggregate**: Riverina Granite 55%, Sunset Gold Marble 20%, White Felspar 15% and Black Granite 10% (subject to review and approval of prototype).<br>**Aggregate size:** 6-14mm (subject to review and approval of prototype)<br>**Surface finish:** Milled with light shot blast to top surface only as required to meet slip resistance requirements.<br>**Slip Resistance Classification (AS4586):** P4<br>**Joints:** Refer to engineers details<br>**Reinforcing:** To Structural Engineer's details | **Supplier:** -<br>**Contact:** - | **Samples**: 1 x length sample required for product approval to be signed by Landscape Architect and client. Must be approved prior to installation. 2x lengths laid in place as detailed to confirm fit and finish.<br>**Prototype**: 300 x 300mm sample concrete panel demonstrating oxide colour, aggregate colour and size and finish for approval | **Shop Drawing**: Shop Drawings to be provided for Approval by Landscape Architect prior to manufacture. |
| **PR1** | **PEDESTRIAN RAMP TYPE 1** | **314** | **TO MATCH PV1.3** | **Supplier:**<br>**Contact:** | | |
| **VC** | **VEHICULAR CROSSING** | **314** | **TO MATCH PV1.3** | **Supplier:**<br>**Contact:** | | |

NSW GOVERNMENT Planning, Industry & Environment
*Issued under the Environmental Planning and Assessment Act 1979*
Approved Application No: SSD-9835 Signed: A. Coonan
Granted on the: 6 Dec 2019 Sheet No: 75 of 83

| CODE | DESCRIPTION | SPECIFICATION SECTION | SPECIFICATION<br>NOTE: all selections are in draft and are subject to refinement prior to issue of final tender package | RECOMMENDED SUPPLIER (OR SIMILAR APPROVED) | SAMPLE & PROTOTYPE REQUIREMENTS (to be submitted 5 days prior to required sign-off) | SHOP DRAWING REQUIREMENTS (to be submitted 5 days prior to required sign-off) |
|---|---|---|---|---|---|---|
| **HR1** | **HANDRAIL TYPE 1 - SINGLE** | **261<br>345** | **Handrail Material:** 316 S/S<br>**Handrail Finish:** electroplated and aged bronze finish<br>**Support Material:** 316 S/S, electroplated and aged bronze finish<br>**Handrail Size:** Nom. 50mm diameter. Refer to Details<br>**Support Thickness:** nom. 12mm Refer to Details<br>**Support Fixing:** Refer to Details | **Supplier:** -<br>**Contact:** - | **Samples:** 300mm CHS sample of electroplated finish for approval prior to manufacture<br>**Prototype:** 1 x full handrail installed. Approved prototype may form part of final landscape. | **Shop Drawing**: Shop Drawings to be provided for Approval by Landscape Architect prior to manufacture. |
| **HR2** | **HANDRAIL TYPE 2 - SINGLE** | **261<br>345** | **Handrail Material:** 316 S/S<br>**Handrail Finish:** electroplated and aged bronze finish<br>**Support Material:** 316 S/S, electroplated and aged bronze finish<br>**Handrail Size:** Nom. 50mm diameter. Refer to Details<br>**Support Thickness:** nom. 12mm Refer to Details<br>**NOTES:** Integrated lighting to lighting engineer's specification | **Supplier:** -<br>**Contact:** - | **Samples:** 300mm CHS sample of electroplated finish for approval prior to manufacture<br>**Prototype:** 1 x full handrail installed. Approved prototype may form part of final landscape. | **Shop Drawing**: Shop Drawings to be provided for Approval by Landscape Architect prior to manufacture. |
| **HR3** | **HANDRAIL TYPE 3 - SINGLE** | **261<br>345** | **Handrail Material:** 316 S/S<br>**Handrail Finish:** electroplated and aged bronze finish<br>**Support Material:** 316 S/S, electroplated and aged bronze finish<br>**Handrail Size:** Nom. 50mm diameter. Refer to Details<br>**Support Thickness:** nom. 12mm Refer to Details<br>**Support Fixing:** Refer to Details | **Supplier:** -<br>**Contact:** - | **Samples:** 300mm CHS sample of electroplated finish for approval prior to manufacture<br>**Prototype:** 1 x full handrail installed. Approved prototype may form part of final landscape. | **Shop Drawing**: Shop Drawings to be provided for Approval by Landscape Architect prior to manufacture. |
| **BA1** | **BALUSTRADE TYPE 1** | **261<br>345** | **Balustrade and Support Material:** Galvanised Steel<br>**Balustrade and Support Finish:** Micaceous Iron Oxide<br>**Colour**: Natural Grey<br>**Support Thickness:** nom. 12mm Refer to Details<br>**Support Fixing:** Refer to Details | **Supplier:** -<br>**Contact:** - | **Samples:** 300mm flat bar sample of electroplated finish for approval prior to manufacture<br>**Prototype:** 1 x full balustrade installed. Approved prototype may form part of final landscape. | **Shop Drawing**: Shop Drawings to be provided for Approval by Landscape Architect prior to manufacture. |
| **T1** | **TACTILE INDICATORS TYPE 1** | **195P<br>261** | **Selection:** DTAC - Warning Tactile Terraced in Classic Brass<br>**Finish:** CNC turning method completed to a mill finish.<br>**NOTES: Item has been selected based on contrast to selected adjacent paving materials, however this must be tested in-situ after paving is installed and finished. Using sample, confirm on site that tactile indicator complies with AS1428.4 (2009) requirement for 45% luminance contrast with surrounding pavement. Contractor to engage a qualified consultant such as Safe Environments to perform insitu testing prior to completing order of tactiles. If samples do not comply, notify landscape architect prior to making alternative selection.** | **Supplier:** DTAC or approved equivalent.<br>**Contact:** 1300 793 478<br><br>**Testing consultant:** Safe Environments<br>**Contact:** 02 9621 3706 | **Samples:** 3 x tactile indicators. Must be approved prior to installation.<br>**Prototype:** 1 x 600mm width x min 1000mm length to be installed. Approved prototype may form part of final landscape | |
| **EXPANSION AND CONTROL JOINTS** | | | | | | |
| | **EXPANSION AND CONTROL JOINTS** | | **Material:** To Engineers Specification<br>**Sealant:** To Engineers Specification<br>**Sealant Colour:** To match surrounding paving area<br>**Other notes:** Sealant to be smooth and recessed 3mm below paving | **Supplier:** -<br>**Contact:** - | **Samples:** colour sample chart for selection and approval prior to install | |
| **WALLS** | | | | | | |
| **W1** | **PRECAST CONCRETE WITH TIMBER INLAY AND ARMREST** | **241<br>321** | **Size:** Refer to details<br>**Colour:** Portland Grey cement<br>**Aggregate**: Riverina Granite 55%, Sunset Gold Marble 20%, White Felspar 15% and Black Granite 10% (subject to review and approval of prototype).<br>**Aggregate size:** 6-14mm (subject to review and approval of prototype)<br>**Surface finish:** Medium grit blast to honed finish<br>**Joints:** Refer to engineers details<br>**Reinforcing:** To Structural Engineer's details<br>**Timber battens**<br>**Durability Class**: 2 or better<br>**Batten Size**: 45 x 45mm. **NOTE**: thickness of boards is required so that cupping of boards does not occur over time, do not substitute unless prevention of cupping is demonstrable.<br>**Surface Finish**: Kiln dried, all DAR. Exposed faces sanded, all exposed edges to be 3mm pencil rounded. Exterior oil finish equal to feast Watson Woodshield applied to manufacturer's recommendation.<br>**Fixings**: 316 Stainless Steel fixings concealed on underside of battens<br>**Nominated Species**: Spotted Gum (FSC Compliant, Australian plantation or recycled only)<br>**Frame (batten substructure):**<br>**Material**: Hot dipped galvanised Steel<br>**Fixings**: fixed with masonry anchors with stainless steel antitamper barrel nuts<br>**Packers**: inert material<br>**Armrests** | **Supplier:** -<br>**Contact:** - | **Samples**: 1 x length sample required for product approval to be signed by Landscape Architect and client. Must be approved prior to installation. 2x lengths laid in place as detailed to confirm fit and finish.<br>**Prototype**: 300 x 300mm sample concrete panel demonstrating oxide colour, aggregate colour and size and finish for approval. | **Shop Drawing**: Shop Drawings to be provided for Approval by Landscape Architect prior to manufacture. |

NSW GOVERNMENT | Planning, Industry & Environment
*Issued under the Environmental Planning and Assessment Act 1979*
Approved Application No: SSD-9835 Signed: A. Coonan
Granted on the: 6 Dec 2019 Sheet No: 76 of 83

| CODE | DESCRIPTION | SPECIFICATION SECTION | SPECIFICATION<br>NOTE: all selections are in draft and are subject to refinement prior to issue of final tender package | RECOMMENDED SUPPLIER (OR SIMILAR APPROVED) | SAMPLE & PROTOTYPE REQUIREMENTS (to be submitted 5 days prior to required sign-off) | SHOP DRAWING REQUIREMENTS (to be submitted 5 days prior to required sign-off) |
|---|---|---|---|---|---|---|
| | | | **Custom:** Refer detail<br>**Material:** Stainless Steel (316)<br>**Finish**: electroplated and aged bronze finish<br>**Dimensions:** Refer to details<br>**Sealant**: TBA | | | |
| **W2** | **INSITU CONCRETE WALL WITH HAND RAIL TYPE 2** | **241**<br>**341** | **Colour:** Portland Grey cement<br>**Aggregate**: Riverina Granite 55%, Sunset Gold Marble 20%, White Felspar 15% and Black Granite 10% (subject to review and approval of prototype).<br>**Aggregate size:** 6-14mm (subject to review and approval of prototype)<br>**Colour control:** 1<br>**Surface finish class to AS 3610.1:** 2<br>**Supplementary finish:** Milled<br>**Top surface finish type:** Steel trowelled<br>**Formwork Lining:** Non-staining mineral oil, grease or other approved agent to ensure non-adhesion of the mortar.<br>**Joints:** Refer to engineers details<br>**Refer HR2 for Handrail Detail** | | **Samples**: 1 x length sample required for product approval to be signed by Landscape Architect and client. Must be approved prior to installation. 2x lengths laid in place as detailed to confirm fit and finish.<br>**Prototype**: Section of wall to be selected for prototype. Wall for prototype to be decided on site with contractor prior to commencement of construction. | |
| **W3** | **INSITU CONCRETE WALL WITH FIXED BENCH** | **241**<br>**341** | **Insitu concrete wall**<br>**Colour:** Portland Grey cement<br>**Aggregate**: Riverina Granite 55%, Sunset Gold Marble 20%, White Felspar 15% and Black Granite 10% (subject to review and approval of prototype).<br>**Aggregate size:** 6-14mm (subject to review and approval of prototype)<br>**Colour control:** 1<br>**Surface finish class to AS 3610.1:** 2<br>**Supplementary finish:** Milled<br>**Top surface finish type:** Steel trowelled<br>**Formwork Lining:** Non-staining mineral oil, grease or other approved agent to ensure non-adhesion of the mortar.<br>**Joints:** Refer to engineers details<br>**Timber battens**<br>**Durability Class**: 2 or better (battens, joists and bearers)<br>**Batten Size**: 42 x 42mm. **NOTE**: thickness of boards is required so that cupping of boards does not occur over time, do not substitute unless prevention of cupping is demonstrable.<br>**Surface Finish**: Kiln dried, all DAR. Exposed faces sanded, all exposed edges to be 3mm pencil rounded. Exterior oil finish equal to feast Watson Woodshield applied to manufacturer's recommendation.<br>**Fixings**: Stainless Steel (316) fixings concealed on underside of battens<br>**Nominated Species**: Spotted Gum (FSC Compliant, Australian plantation or recycled only)<br>**Frame (batten substructure):**<br>**Material**: Hot dipped galvanised Steel<br>**Fixings**: fixed with masonry anchors with stainless steel antitamper barrel nuts<br>**Packers**: inert material<br>**Dimensions**: Refer detail<br>**End Plate:**<br>**Material:** Galvanised Steel<br>**Finish**: Micaceous Iron Oxide<br>**Colour**: Natural Grey | | **Samples**: 1 x length sample required for product approval to be signed by Landscape Architect and client. Must be approved prior to installation. 2x lengths laid in place as detailed to confirm fit and finish.<br>**Prototype**: Section of wall to be selected for prototype. Wall for prototype to be decided on site with contractor prior to commencement of construction. | |
| **W4** | **SPLAYED INSITU CONCRETE WALL WITH BRICK FACE** | **241**<br>**331** | **Insitu concrete wall**<br>**Colour:** Portland Grey cement<br>**Colour control:** 1<br>**Surface finish class to AS 3610.1:** 2<br>**Supplementary finish:** Milled<br>**Top surface finish type:** TBA<br>**Formwork Lining:** Non-staining mineral oil, grease or other approved agent to ensure non-adhesion of the mortar.<br>**Joints:** Refer to engineers details<br>**Brick Face**<br>**Product:** Bowral Bricks<br>**Colour:** Capital Red (60%), Bowral Brown (40%)<br>**Dimensions:**<br>Brick Type 1: 230 x 110 x 76mm<br>Brick Type 2: 230 x 110 x 50mm<br>**Pattern**: refer details<br>**Joints:** mortar joint to match brick paving<br>**Sealant**: TBA<br>**NOTE:** Brick ties required on splayed brick walls | **Supplier:** Austral Bricks<br>**Contact:** | **Samples**: 1 x length sample required for product approval to be signed by Landscape Architect and client. Must be approved prior to installation. 2x lengths laid in place as detailed to confirm fit and finish.<br>**Prototype**: Section of wall to be selected for prototype. Wall for prototype to be decided on site with contractor prior to commencement of construction. | **Shop Drawing**: Shop Drawings to be provided for Approval by Landscape Architect prior to manufacture. |
| **W5.1** | **BRICK STAIR ABUTMENT** | | **Structure by others and finish specified below**<br>**Brick Face**<br>**Product:** Bowral Bricks | **Supplier:** Austral Bricks<br>**Contact:** | **Samples**: 1 x length sample required for product approval to be signed by Landscape | **Shop Drawing**: Shop Drawings to be provided for Approval by Landscape Architect prior to |

NSW GOVERNMENT | Planning, Industry & Environment
*Issued under the Environmental Planning and Assessment Act 1979*
Approved Application No: SSD-9835 Signed: A. Coonan
Granted on the: 6 Dec 2019 Sheet No: 77 of 83

| CODE | DESCRIPTION | SPECIFICATION SECTION | SPECIFICATION<br>NOTE: all selections are in draft and are subject to refinement prior to issue of final tender package | RECOMMENDED SUPPLIER (OR SIMILAR APPROVED) | SAMPLE & PROTOTYPE REQUIREMENTS (to be submitted 5 days prior to required sign-off) | SHOP DRAWING REQUIREMENTS (to be submitted 5 days prior to required sign-off) |
|---|---|---|---|---|---|---|
| | | | **Colour:** Capital Red (60%), Bowral Brown (40%)<br>**Dimensions:**<br>Brick Type 1: 230 x 110 x 76mm<br>Brick Type 2: 230 x 110 x 50mm<br>**Pattern**: refer details<br>**Joints:** mortar joint to match brick paving<br>**Sealant**: TBA<br>**NOTE:** Brick ties required on splayed brick walls | | Architect and client. Must be approved prior to installation. 2x lengths laid in place as detailed to confirm fit and finish.<br>**Prototype**: Section of wall to be selected for prototype. Wall for prototype to be decided on site with contractor prior to commencement of construction. | manufacture |
| **W5.2** | **BRICK STAIR ABUTMENT** | | **Structure by others and finish specified below**<br>**Brick Face**<br>**Product:** Bowral Bricks<br>**Colour:** Capital Red (60%), Bowral Brown (40%)<br>**Dimensions:**<br>Brick Type 1: 230 x 110 x 76mm<br>Brick Type 2: 230 x 110 x 50mm<br>**Pattern**: refer details<br>**Joints:** mortar joint to match brick paving<br>**Sealant**: TBA<br>**NOTE:** Brick ties required on splayed brick walls | **Supplier:** Austral Bricks<br>**Contact:** | **Samples**: 1 x length sample required for product approval to be signed by Landscape Architect and client. Must be approved prior to installation. 2x lengths laid in place as detailed to confirm fit and finish.<br>**Prototype**: Section of wall to be selected for prototype. Wall for prototype to be decided on site with contractor prior to commencement of construction. | **Shop Drawing**: Shop Drawings to be provided for Approval by Landscape Architect prior to manufacture |
| **W6** | **RAKING STEEL WALL** | **241**<br>**345** | **Material:** Galvanised Steel<br>**Finish**: Micaceous Iron Oxide<br>**Colour**: Natural Grey<br>**Thickness:** 6mm<br>**Framing/structure:** To Structural Engineer's details<br>**Fixings:** Fixing to concrete slab / concrete hob with structural supports prior to waterproofing being applied to engineer's specification. | | **Samples:** 1 x length sample required for product approval to be signed by landscape architect and client. Must be approved prior to installation.<br>**Prototype:** 300 x 300mm sample panel demonstrating finish for approval | |
| **W7** | **STEEL WALL** | **241**<br>**345** | **Material:** Galvanised Steel<br>**Finish**: Micaceous Iron Oxide<br>**Colour**: Natural Grey<br>**Thickness:** 6mm<br>**Framing/structure:** To Structural Engineer's details<br>**Fixings:** Fixing to concrete slab / concrete hob with structural supports prior to waterproofing being applied to engineer's specification. | | **Samples:** 1 x length sample required for product approval to be signed by landscape architect and client. Must be approved prior to installation.<br>**Prototype:** 300 x 300mm sample panel demonstrating finish for approval | |
| **W8.1** | **RETAINING WALL** | **671** | **Wall**: By others and as specified below<br>**Colour:** Portland Grey cement<br>**Aggregate**: Riverina Granite 55%, Sunset Gold Marble 20%, White Felspar 15% and Black Granite 10% (subject to review and approval of prototype).<br>**Aggregate size:** 6-14mm (subject to review and approval of prototype)<br>**Colour control:** 1<br>**Surface finish class to AS 3610.1:** 2<br>**Supplementary finish:** Milled<br>**Top surface finish type:** Steel trowelled<br>**Formwork Lining:** Non-staining mineral oil, grease or other approved agent to ensure non-adhesion of the mortar.<br>**Joints:** Refer to engineer's details | | **Samples:** 1 x length sample required for product approval to be signed by landscape architect and client. Must be approved prior to installation.<br>**Prototype:** 300 x 300mm sample concrete panel demonstrating decorative finish for approval. | |
| **W8.2** | **RETAINING WALL** | **671** | **Wall**: By others and as specified below<br>**Colour:** Portland Grey cement<br>**Aggregate**: Riverina Granite 55%, Sunset Gold Marble 20%, White Felspar 15% and Black Granite 10% (subject to review and approval of prototype).<br>**Aggregate size:** 6-14mm (subject to review and approval of prototype)<br>**Colour control:** 1<br>**Surface finish class to AS 3610.1:** 2<br>**Supplementary finish:** Milled<br>**Top surface finish type:** Steel trowelled<br>**Formwork Lining:** Non-staining mineral oil, grease or other approved agent to ensure non-adhesion of the mortar.<br>**Joints:** Refer to engineers details<br>**Refer HR2 for Handrail details** | | | |
| **W9** | **RETAINING WALL** | **671** | **Wall**: By others and as specified below<br>**Colour:** Portland Grey cement<br>**Aggregate**: Riverina Granite 55%, Sunset Gold Marble 20%, White Felspar 15% and Black Granite 10% (subject to review and approval of prototype).<br>**Aggregate size:** 6-14mm (subject to review and approval of prototype)<br>**Colour control:** 1 | | **Samples:** 1 x length sample required for product approval to be signed by landscape architect and client. Must be approved prior to installation.<br>**Prototype:** 300 x 300mm | |

NSW GOVERNMENT Planning, Industry & Environment
*Issued under the Environmental Planning and Assessment Act 1979*
Approved Application No: SSD-9835 Signed: A. Coomar
Granted on the: 6 Dec 2019 Sheet No: 78 of 83

| CODE | DESCRIPTION | SPECIFICATION SECTION | SPECIFICATION<br>NOTE: all selections are in draft and are subject to refinement prior to issue of final tender package | RECOMMENDED SUPPLIER (OR SIMILAR APPROVED) | SAMPLE & PROTOTYPE REQUIREMENTS (to be submitted 5 days prior to required sign-off) | SHOP DRAWING REQUIREMENTS (to be submitted 5 days prior to required sign-off) |
|---|---|---|---|---|---|---|
| | | | **Surface finish class to AS 3610.1:** 2<br>**Supplementary finish:** Milled<br>**Top surface finish type:** Steel trowelled<br>**Formwork Lining:** Non-staining mineral oil, grease or other approved agent to ensure non-adhesion of the mortar.<br>**Joints:** Refer to engineers details | | sample decorative treatment for approval | |
| **W10** | **LOW BRICK WALL** | **274**<br>**315**<br>**341** | **Brick Face**<br>**Product:** Bowral Bricks<br>**Colour:** Capital Red (60%), Bowral Brown (40%)<br>**Dimensions:** 230 x 110 x 76mm<br>**Pattern**: refer details<br>**Joints:** mortar joint to match brick paving<br>**Sealant**: TBA | **Supplier:** Austral Bricks | **Samples**: 1 x length sample required for product approval to be signed by Landscape Architect and client. Must be approved prior to installation. 2x lengths laid in place as detailed to confirm fit and finish.<br>**Prototype**: Section of wall to be selected for prototype. Wall for prototype to be decided on site with contractor prior to commencement of construction | |
| **SOFT SURFACES, MULCHES** | | | | | | |
| **MP1** | **MASS PLANTING ON GRADE** | **251**<br>**253**<br>**254**<br>**255**<br>**256** | **Refer to details**<br>**Mulch type:** Horticultural grade pine bark mini nuggets.<br>Product from ANL – Australian Native Landscapes<br>**Depth:** 75mm (as shown on details)<br>**Soil:** refer to details and technical specification | **Supplier:**<br>ANL Landscapes<br>317 Mona Vale Road,<br>Terrey Hills, NSW 2084<br>T: (02) 9450 1444 | **Samples**: Provide all samples below to Landscape Architect for approval prior to installation<br>**Soil test results**: for all soil types<br>**Mulch**: 2kg sample<br>**Plants**: 1 plant species for each 100 of type<br>**Trees**: Inspection of all trees prior to installation | |
| **MP2** | **MASS PLANTING ON SLAB** | **251**<br>**253**<br>**254**<br>**255**<br>**256** | **Refer to details**<br>**Mulch type:** Horticultural grade pine bark mini nuggets.<br>Product from ANL – Australian Native Landscapes<br>**Depth:** 75mm (as shown on details)<br>**Soil:** refer to details and technical specification | **Supplier:**<br>ANL Landscapes<br>317 Mona Vale Road,<br>Terrey Hills, NSW 2084<br>T: (02) 9450 1444 | **Samples**: Provide all samples below to Landscape Architect for approval prior to installation<br>**Soil test results**: for all soil types<br>**Mulch**: 2kg sample<br>**Plants**: 1 plant species for each 100 of type<br>**Trees**: Inspection of all trees prior to installation | |
| ~~**MP3**~~ | ~~**MASS PLANTING ON SLAB UPPER LEVELS**~~ | ~~**251**~~<br>~~**253**~~<br>~~**254**~~<br>~~**255**~~<br>~~**256**~~ | **DETAIL NO LONGER IN USE**<br>~~**Refer to details**~~<br>~~**Mulch type:** Horticultural grade pine bark mini nuggets.~~<br>~~Product from ANL – Australian Native Landscapes~~<br>~~**Depth:** 75mm (as shown on details)~~<br>~~**Soil:** refer to details and technical specification~~ | ~~**Supplier:**~~<br>~~ANL Landscapes~~<br>~~317 Mona Vale Road,~~<br>~~Terrey Hills, NSW 2084~~<br>~~T: (02) 9450 1444~~ | ~~**Samples**: Provide all samples below to Landscape Architect for approval prior to installation~~<br>~~**Soil test results**: for all soil types~~<br>~~**Mulch**: 2kg sample~~<br>~~**Plants**: 1 plant species for each 100 of type~~<br>~~**Trees**: Inspection of all trees prior to installation~~ | |
| **MP4** | **MASS PLANTING AROUND EXISTING TREE** | **251**<br>**253**<br>**254**<br>**255**<br>**256** | **Refer to details**<br>**Mulch type:** Horticultural grade pine bark mini nuggets.<br>Product from ANL – Australian Native Landscapes<br>**Depth:** 75mm (as shown on details)<br>**Soil:** refer to details and technical specification | **Supplier:**<br>ANL Landscapes<br>317 Mona Vale Road,<br>Terrey Hills, NSW 2084<br>T: (02) 9450 1444 | **Samples**: Provide all samples below to Landscape Architect for approval prior to installation<br>**Soil test results**: for all soil types<br>**Mulch**: 2kg sample<br>**Plants**: 1 plant species for each 100 of type<br>**Trees**: Inspection of all trees prior to installation | |
| **FURNITURE AND FIXTURES** | | | | | | |
| **BE1** | **CUSTOM PRECAST CONCRETE BENCH WITH TIMBER INLAY** | **241**<br>**344**<br>**382**<br>**552** | **Precast concrete**<br>**Colour**: Portland Grey cement<br>**Exposed Aggregate**: Riverina Granite 55%, Sunset Gold Marble 20%, White Felspar 15% and Black Granite 10%<br>**Aggregate size**: 6-14mm<br>**Finish**: Medium grit blast to honed finish<br>**Colour Control**: 1<br>**Top surface finish type**: Steel trowelled | **Supplier:** -<br>**Contact:** - | **Samples:** 1 x bench. Must be approved prior to installation.<br>**Prototype:** 1x bench installed. Approved prototype may form part of the final landscape. | **Shop Drawing**: Shop Drawings to be provided for Approval by Landscape Architect prior to manufacture. |

NSW GOVERNMENT | Planning, Industry & Environment
*Issued under the Environmental Planning and Assessment Act 1979*
Approved Application No: SSD-9835 Signed:
Granted on the: 6 Dec 2019 Sheet No: 79 of 83

| CODE | DESCRIPTION | SPECIFICATION SECTION | SPECIFICATION<br>NOTE: all selections are in draft and are subject to refinement prior to issue of final tender package | RECOMMENDED SUPPLIER (OR SIMILAR APPROVED) | SAMPLE & PROTOTYPE REQUIREMENTS (to be submitted 5 days prior to required sign-off) | SHOP DRAWING REQUIREMENTS (to be submitted 5 days prior to required sign-off) |
|---|---|---|---|---|---|---|
| | | | **Supplementary Finish**: Light grit blast to honed<br>**Formwork Lining**: Non-staining mineral oil, grease or other approved agent to ensure non-adhesion of the mortar.<br>**Sub base**: SUBJECT TO CONFIRMATION BY CIVIL ENGINEER<br>**Reinforcing**: SUBJECT TO CONFIRMATION BY CIVIL ENGINEER<br>**Sealant:** TBA<br>**Timber battens**<br>**Durability Class**: 2 or better (battens, joists and bearers)<br>**Batten Size**: 45 x 45mm. **NOTE**: thickness of boards is required so that cupping of boards does not occur over time, do not substitute unless prevention of cupping is demonstrable.<br>**Surface Finish**: Kiln dried, all DAR. Exposed faces sanded, all exposed edges to be 3mm pencil rounded.<br>Exterior oil finish equal to Feast Watson Matt Look Decking Oil applied to manufacturer's recommendation.<br>**Fixings**: Stainless Steel (316) fixings concealed on underside of battens<br>**Nominated Species**: Spotted Gum (FSC Compliant, Australian plantation or recycled only)<br>**Frame (batten substructure):**<br>**Material**: Hot dipped galvanised Steel<br>**Fixings**: fixed with masonry anchors with stainless steel antitamper barrel nuts<br>**Packers**: inert material | | | |
| ~~**BE2**~~ | ~~**CUSTOM PRECAST CONCRETE BENCH WITH TIMBER INLAY**~~ | ~~**241**~~<br>~~**344**~~<br>~~**382**~~<br>~~**552**~~ | DETAIL NO LONGER IN USE<br>~~**Precast concrete**~~<br>~~**Colour**: Portland Grey cement~~<br>~~**Exposed Aggregate**: Riverina Granite 55%, Sunset Gold Marble 20%, White Felspar 15% and Black Granite 10%~~<br>~~**Aggregate size**: 6-14mm~~<br>~~**Finish**: Medium grit blast to honed finish~~<br>~~**Colour Control**: 1~~<br>~~**Top surface finish type**: Steel trowelled~~<br>~~**Supplementary Finish**: Light grit blast to honed~~<br>~~**Formwork Lining**: Non-staining mineral oil, grease or other approved agent to ensure non-adhesion of the mortar.~~<br>~~**Sub base**: SUBJECT TO CONFIRMATION BY CIVIL ENGINEER~~<br>~~**Reinforcing**: SUBJECT TO CONFIRMATION BY CIVIL ENGINEER~~<br>~~**Sealant:** TBA~~<br>~~**Timber battens**~~<br>~~**Durability Class**: 2 or better (battens, joists and bearers)~~<br>~~**Batten Size**: 45 x 45mm. **NOTE**: thickness of boards is required so that cupping of boards does not occur over time, do not substitute unless prevention of cupping is demonstrable.~~<br>~~**Surface Finish**: Kiln dried, all DAR. Exposed faces sanded, all exposed edges to be 3mm pencil rounded.~~<br>~~Exterior oil finish equal to Feast Watson Matt Look Decking Oil applied to manufacturer's recommendation.~~<br>~~**Fixings**: Stainless Steel (316) fixings concealed on underside of battens~~<br>~~**Nominated Species**: Spotted Gum (FSC Compliant, Australian plantation or recycled only)~~<br>~~**Frame (batten substructure):**~~<br>~~**Material**: Hot dipped galvanised Steel~~<br>~~**Fixings**: fixed with masonry anchors with stainless steel antitamper barrel nuts~~<br>~~**Packers**: inert material~~ | ~~**Supplier:** -~~<br>~~**Contact:** -~~ | ~~**Samples:** 1 x bench. Must be approved prior to installation.~~<br>~~**Prototype:** 1x bench installed. Approved prototype may form part of the final landscape.~~ | ~~**Shop Drawing**: Shop Drawings to be provided for Approval by Landscape Architect prior to manufacture.~~ |
| **BE3** | **CUSTOM PRECAST CONCRETE BENCH WITH TIMBER INLAY** | **241**<br>**344**<br>**382**<br>**552** | **Precast concrete**<br>**Colour**: Portland Grey cement<br>**Exposed Aggregate**: Riverina Granite 55%, Sunset Gold Marble 20%, White Felspar 15% and Black Granite 10%<br>**Aggregate size**: 6-14mm<br>**Finish**: Medium grit blast to honed finish<br>**Colour Control**: 1<br>**Top surface finish type**: Steel trowelled<br>**Supplementary Finish**: Light grit blast to honed<br>**Formwork Lining**: Non-staining mineral oil, grease or other approved agent to ensure non-adhesion of the mortar.<br>**Sub base**: SUBJECT TO CONFIRMATION BY CIVIL ENGINEER<br>**Reinforcing**: SUBJECT TO CONFIRMATION BY CIVIL ENGINEER<br>**Sealant:** TBA<br>**Timber battens**<br>**Durability Class**: 2 or better (battens, joists and bearers)<br>**Batten Size**: 45 x 45mm. **NOTE**: thickness of boards is required so that cupping of boards does not occur over time, do not substitute unless prevention of cupping is demonstrable.<br>**Surface Finish**: Kiln dried, all DAR. Exposed faces sanded, all exposed edges to be 3mm pencil rounded.<br>Exterior oil finish equal to Feast Watson Matt Look Decking Oil applied to manufacturer's recommendation.<br>**Fixings**: Stainless Steel (316) fixings concealed on underside of battens<br>**Nominated Species**: Spotted Gum (FSC Compliant, Australian plantation or recycled only)<br>**Frame (batten substructure):**<br>**Material**: Hot dipped galvanised Steel<br>**Fixings**: fixed with masonry anchors with stainless steel antitamper barrel nuts<br>**Packers**: inert material | **Supplier:** -<br>**Contact:** - | **Samples:** 1 x bench. Must be approved prior to installation.<br>**Prototype:** 1x bench installed. Approved prototype may form part of the final landscape. | **Shop Drawing**: Shop Drawings to be provided for Approval by Landscape Architect prior to manufacture. |

NSW GOVERNMENT | Planning, Industry & Environment

*Issued under the Environmental Planning and Assessment Act 1979*

Approved Application No: SSD-9835 Signed: A. Coonan

Granted on the: 6 Dec 2019 Sheet No: 80 of 83

| CODE | DESCRIPTION | SPECIFICATION SECTION | SPECIFICATION<br>NOTE: all selections are in draft and are subject to refinement prior to issue of final tender package | RECOMMENDED SUPPLIER (OR SIMILAR APPROVED) | SAMPLE & PROTOTYPE REQUIREMENTS (to be submitted 5 days prior to required sign-off) | SHOP DRAWING REQUIREMENTS (to be submitted 5 days prior to required sign-off) |
|---|---|---|---|---|---|---|
| | | | **Dimensions**: Refer detail | | | |
| **BE4** | **PROPRIETRY BENCH WITH BACKREST** | **261** | **Description**: CoS Standard Timber and Silver Bench Seat (Tzannes Design) or similar approved<br>**Dimensions**: 1900 x 450mm<br>**Materials**: Stainless Streel (316)<br>**Finish**: electroplated and aged bronze finish<br>**Nominated Species**: Spotted Gum (FSC Compliant, Australian plantation or recycled only)<br>**Fixings**: Tamper proof sub surface mount to manufacturers specifications | **Supplier**: ABUD: Australian Built Urban Designs | **Sample**: 1x product on site prior to installation | |
| **BE5** | **CUSTOM BENCH** | **241**<br>**344**<br>**382**<br>**552** | **Custom:** refer details<br>**Description**: Folded and Powdercoated Mild Steel Bench<br>**Dimensions**: 1000 x 500 x 430mm<br>**Materials**: 8mm thick Mild Steel<br>**Finish**: Powdercoat<br>**Colour**: TBC<br>**Fixings**: Tamper proof sub surface mount to manufacturers specifications | **Supplier:**<br>**Contact:** | **Samples**: 1 x bench for product approval to be signed by Landscape Architect and client.<br>**Prototype**: 1 x bench installed. Approved prototype may form part of the final landscape. | **Shop Drawing**: Shop Drawings to be provided for Approval by Landscape Architect prior to manufacture. |
| **TD1** | **TIMBER DECK TYPE 1** | **241**<br>**344**<br>**382**<br>**552** | **Timber battens**<br>**Durability Class**: 2 or better (battens, joists and bearers)<br>**Batten Size**: 86 x 45mm. **NOTE**: thickness of boards is required so that cupping of boards does not occur over time, do not substitute unless prevention of cupping is demonstrable.<br>**Surface Finish**: Kiln dried, all DAR. Exposed faces sanded, all exposed edges to be 3mm pencil rounded. Exterior oil finish equal to Feast Watson Matt Look Decking Oil applied to manufacturer's recommendation.<br>**Fixings**: Silicon bronze countersunk fixings, pre drilled timber battens<br>**Nominated** Species: Spotted Gum (FSC Compliant, Australian plantation or recycled only)<br>**Frame (batten substructure):**<br>**Material**: Hot dipped galvanised Steel<br>**Fixings**: fixed with masonry anchors with stainless steel antitamper barrel nuts<br>**Packers**: inert material<br>**Precast Edge**<br>**Colour**: Portland Grey cement<br>**Exposed Aggregate**: Riverina Granite 55%, Sunset Gold Marble 20%, White Felspar 15% and Black Granite 10%<br>**Aggregate size**: 6-14mm<br>**Finish**: Varies. Refer side panel<br>**Colour Control**: 1<br>**Top surface finish type**: Steel trowelled<br>**Supplementary Finish**: Light grit blast to honed<br>**Formwork Lining**: Non-staining mineral oil, grease or other approved agent to ensure non-adhesion of the mortar.<br>**Sub base**: **SUBJECT TO CONFIRMATION BY CIVIL ENGINEER**<br>**Reinforcing**: **SUBJECT TO CONFIRMATION BY CIVIL ENGINEER**<br>**Sealant:** TBA | | **Samples**: 1 x unit sample timber, frame required for product approval to be signed by Landscape Architect and client.<br>**Prototype**: 1 x deck installed. Approved prototype may form part of the final landscape. | **Shop Drawing**: Shop Drawings to be provided for Approval by Landscape Architect prior to manufacture. |
| **TD2** | **TIMBER DECK TYPE 2** | **241**<br>**344**<br>**382**<br>**552** | **Timber battens**<br>**Durability Class**: 2 or better (battens, joists and bearers)<br>**Batten Size**: 86 x 45mm. **NOTE**: thickness of boards is required so that cupping of boards does not occur over time, do not substitute unless prevention of cupping is demonstrable.<br>**Surface Finish**: Kiln dried, all DAR. Exposed faces sanded, all exposed edges to be 3mm pencil rounded. Exterior oil finish equal to Feast Watson Matt Look Decking Oil applied to manufacturer's recommendation.<br>**Fixings**: Silicon bronze countersunk fixings, pre drilled timber battens<br>**Nominated** Species: Spotted Gum (FSC Compliant, Australian plantation or recycled only)<br>**Frame (batten substructure):**<br>**Material**: Hot dipped galvanised Steel<br>**Fixings**: fixed with masonry anchors with stainless steel antitamper barrel nuts<br>**Packers**: inert material<br>**Precast Edge**<br>**Colour**: Portland Grey cement<br>**Exposed Aggregate**: Riverina Granite 55%, Sunset Gold Marble 20%, White Felspar 15% and Black Granite 10%<br>**Aggregate size**: 6-14mm<br>**Finish**: Varies. Refer side panel<br>**Colour Control**: 1<br>**Top surface finish type**: Steel trowelled<br>**Supplementary Finish**: Light grit blast to honed<br>**Formwork Lining**: Non-staining mineral oil, grease or other approved agent to ensure non-adhesion of the mortar.<br>**Sub base**: **SUBJECT TO CONFIRMATION BY CIVIL ENGINEER**<br>**Reinforcing**: **SUBJECT TO CONFIRMATION BY CIVIL ENGINEER**<br>**Sealant:** TBA | | **Samples**: 1 x unit sample timber, frame required for product approval to be signed by Landscape Architect and client.<br>**Prototype**: 1x deck installed. Approved prototype may form part of the final landscape. | **Shop Drawing**: Shop Drawings to be provided for Approval by Landscape Architect prior to manufacture. |

NSW GOVERNMENT | Planning, Industry & Environment

*Issued under the Environmental Planning and Assessment Act 1979*

Approved Application No. SSD-9835 Signed:

Granted on the: 6 Dec 2019 Sheet No: 81 of 83

| CODE | DESCRIPTION | SPECIFICATION SECTION | SPECIFICATION<br>NOTE: all selections are in draft and are subject to refinement prior to issue of final tender package | RECOMMENDED SUPPLIER (OR SIMILAR APPROVED) | SAMPLE & PROTOTYPE REQUIREMENTS (to be submitted 5 days prior to required sign-off) | SHOP DRAWING REQUIREMENTS (to be submitted 5 days prior to required sign-off) |
|---|---|---|---|---|---|---|
| F1 | **PROPRIETRY BICYCLE HOOP** | **261** | **Product:** Bicycle hitch rail sub surface mount BR85F<br>**Materials**: Stainless Streel (316)<br>**Finish**: electroplated and aged bronze finish<br>**Fixings:** sub surface installation | **Supplier:** Leda Security | **Sample**: 1x product on site prior to installation | |
| ~~F2~~ | ~~**CUSTOM TABLE TENNIS TABLE**~~ | ~~**241**~~<br>~~**261**~~ | **DETAIL NO LONGER IN USE**<br>~~**Precast Concrete**~~<br>~~**Colour**: Portland Grey cement~~<br>~~**Exposed Aggregate**: Riverina Granite 55%, Sunset Gold Marble 20%, White Felspar 15% and Black Granite 10%~~<br>~~**Aggregate size**: 6-14mm~~<br>~~**Finish**: Varies. Refer side panel~~<br>~~**Colour Control**: 1~~<br>~~**Top surface finish type**: Steel trowelled~~<br>~~**Supplementary Finish**: Light grit blast to honed~~<br>~~**Formwork Lining**: Non staining mineral oil, grease or other approved agent to ensure non-adhesion of the mortar.~~<br>~~**Sub base**: **SUBJECT TO CONFIRMATION BY CIVIL ENGINEER**~~<br>~~**Reinforcing**: **SUBJECT TO CONFIRMATION BY CIVIL ENGINEER**~~<br>~~**Sealant:** TBA~~<br>~~**Custom net**~~<br>~~**Material**: Painted Mild Steel with custom graphic~~<br>~~**Dimensions**: TBC~~<br>~~**Colour**: RAL201 – Signal Orange~~ | | ~~**Samples**: TBC~~<br>~~**Prototype**: TBC~~ | ~~**Shop Drawing**: Shop Drawings to be provided for Approval by Landscape Architect prior to manufacture.~~ |
| F3 | **PROPRIETARY DRINKING FOUNTAIN** | **261** | **Product:** CoS Standard Drinking Fountain (Tzannes Design) or similar approved<br>**Materials**: Stainless Streel (316)<br>**Dimensions**: refer detail<br>**Finish**: electroplated and aged bronze finish<br>**Fixings**: Tamper proof surface mount to manufacturers specifications | Supplier: ABUD: Australian Built Urban Designs | | |
| F4 | **CUSTOM SCREEN** | **382** | **Uprights:**<br>**Custom:** Refer details<br>**Material**: Galvanised steel<br>**Finish**: Powdercoated<br>**Colour**: TBC<br>**Frame:**<br>**Material**: Galvanised Steel<br>**Finish**: Powdercoated<br>**Colour**: TBC | | **Samples**: 1 x screen. Must be approved prior to installation.<br>**Prototype**: 1x screen installed. Approved prototype may form part of the final landscape. | **Shop Drawing**: Shop Drawings to be provided for Approval by Landscape Architect prior to manufacture. |
| FE1 | **CUSTOM BASKETBALL HOOPS** | **552**<br>**261** | **Frame**<br>**Custom:** Refer details<br>**Material**: Hot dipped galvanised Steel<br>**Backboard**<br>**Backboard**: Heavy Duty Backboard BB847 or similar approved equivalent<br>**Fixing**: to manufacturers recommendation<br>**Net**:<br>**Product**: BB829 Classic heavy duty Basketball Ring 20mm<br>**Fixing**: to manufacturers recommendation | **Supplier**: Grand Slam Sports Equipment | **Samples**: 1 x basketball hoop. Must be approved prior to installation.<br>**Prototype**: 1x basketball hoop installed. Approved prototype may form part of the final landscape. | **Shop Drawing**: Shop Drawings to be provided for Approval by Landscape Architect prior to manufacture. |
| FE2 | **PROPRIETRY FITNESS EQUIPMENT TYPE 2** | **261** | **Product**: Multi Net FSW207 or similar approved equivalent<br>**Colour**: RAL201 – Signal Orange<br>**Dimensions**: 120 x 1190mm<br>**Fixings**: Tamper proof<br>**Installation**: sub surface mount to manufacturers specifications | **Supplier**: Kompan<br>**NSW Agent**: Play by Design | **Sample**: 1x product on site prior to installation | |
| FE3 | **PROPRIETRY FITNESS EQUIPMENT TYPE 3** | **261** | **Product**: Decline Bench FSW204 or similar approved equivalent<br>**Colour**: RAL201 – Signal Orange<br>**Dimensions**: 1530 x 880mm<br>**Fixings**: Tamper proof<br>**Installation**: sub surface mount to manufacturers specifications | **Supplier**: Kompan<br>**NSW Agent**: Play by Design | **Sample**: 1x product on site prior to installation | |
| FE4 | **PROPRIETRY FITNESS EQUIPMENT TYPE 4** | **261** | **Product**: Overhead Ladder FSW205 or similar approved equivalent<br>**Colour**: RAL201 – Signal Orange<br>**Dimensions**: 1200 x 2250mm<br>**Fixings**: Tamper proof<br>**Installation**: sub surface mount to manufacturers specifications | **Supplier**: Kompan<br>**NSW Agent**: Play by Design | **Sample**: 1x product on site prior to installation | |
| FE5 | **PROPRIETRY FITNESS EQUIPMENT TYPE 5** | **261** | **Product**: Parallel Bars FSW201 or similar approved equivalent<br>**Colour**: RAL201 – Signal Orange<br>**Dimensions**: 1960 x 640mm<br>**Fixings**: Tamper proof<br>**Installation**: sub surface mount to manufacturers specifications | **Supplier**: Kompan<br>**NSW Agent**: Play by Design | **Sample**: 1x product on site prior to installation | |

NSW GOVERNMENT | Planning, Industry & Environment
*Issued under the Environmental Planning and Assessment Act 1979*
Approved Application No: SSD-9835 Signed:
Granted on the: 6 Dec 2019 Sheet No: 82 of 83

| CODE | DESCRIPTION | SPECIFICATION SECTION | SPECIFICATION<br>NOTE: all selections are in draft and are subject to refinement prior to issue of final tender package | RECOMMENDED SUPPLIER (OR SIMILAR APPROVED) | SAMPLE & PROTOTYPE REQUIREMENTS (to be submitted 5 days prior to required sign-off) | SHOP DRAWING REQUIREMENTS (to be submitted 5 days prior to required sign-off) |
|---|---|---|---|---|---|---|
| **FE6** | **PROPRIETRY FITNESS EQUIPMENT TYPE 6** | **261** | **Product**: COMBI 3 PRO FSW10301 or similar approved equivalent<br>**Colour**: RAL201 – Signal Orange<br>**Dimensions**: 10800 x 790mm<br>**Fixings**: Tamper proof<br>**Installation**: sub surface mount to manufacturers specifications | **Supplier**: Kompan<br>**NSW Agent**: Play by Design | **Sample**: 1x product on site prior to installation | |
| **GPO** | **GENERAL POWER OUTLET** | **261** | **Product**: HPM Soliroc weatherproof single power point<br>**Dimensions**: TBC<br>**Installation**: Wall mounted | **Supplier**:<br>**Contact**: | **Sample**: 1x product on site prior to installation | |
| **TG1** | **TREE GRATE TYPE 1** | **261** | **Product**: Tree Grate City of Sydney Standard (Tzannes Design) or similar approved<br>**Materials**: Stainless Streel (316)<br>**Finish**: electroplated and aged bronze finish<br>**Dimensions**: 1486 x 1486mm (including concealed frame)<br>**Fixings**: Tamper proof surface mount to manufacturers specifications | **Supplier**: ABUD Australian Built Urban Designs | **Samples:** 1 x tree grate. Must be approved prior to installation.<br>**Prototype:** 1x tree grate installed. Approved prototype may form part of the final landscape. | |
| **TG2** | **TREE GRATE TYPE 2** | **261** | **Product**: Square Tree Grate TG4 or similar approved<br>**Materials**: Stainless Streel (316)<br>**Dimensions**: 1211 x 1211mm (including concealed frame)<br>**Fixings**: Tamper proof surface mount to manufacturers specifications<br>**Finish:** Powdercoat with anti-slip coating<br>**Colour:** TBC | **Supplier**: Urban Fountains and Furniture<br>**Contact:** 5 Telford Circuit<br>Yatala, Qld, 4207<br>Ph: (07) 3382 7372<br>Fax: (07) 3287 5598 | **Samples:** 1 x tree grate. Must be approved prior to installation.<br>**Prototype:** 1x tree grate installed. Approved prototype may form part of the final landscape. | |
| | **STRATACELL** | **251**<br>**253** | **Product**: Strata Vault – City Green or similar approved.<br>**Material Specifications**<br>30 Series - 100% recycled polypropylene<br>45 Series - 100% recycled ABS<br>**Dimensions**<br>Length : 600mm<br>Width : 600mm<br>Height : 404mm<br>**Capacity**<br>Free Volume: Module <83%<br>Assembled Matrix>90%<br>Ultimate Load Strength (Single cell & lab tested)<br>30 series - 300kPa/43.5psi<br>45 series - 450kPa/65.3psi | **Supplier**: Citygreen Australasia<br>821 Pacific Highway,<br>Sydney, NSW 2067<br>Phone: (+61) 1300 066 949<br>Email: info@citygreen.com<br>T. 1300 244 377<br>F. 1300 768 876 | **Samples:** 1 x stratacell. Must be approved prior to installation.<br>**Prototype:** 1x stratacell installed. Approved prototype may form part of the final landscape. | |
| | | | | | | |
| **BO1** | **CUSTOM BOLLARD TYPE 1 - FIXED** | **261** | **Product:** Ackord Bollard<br>**Product Code:** 16-80G Ackord bollard in standard light grey colour**Dimension:** 750 x 300 x 300mm<br>**Material**: Reinforced Concrete<br>**Finish**: Natural Grey<br>**Fixings**: tamper proof sub surface fixed<br>**NOTE: subject to security review for final sizing and impact rating** | **Supplier**: NOLA INDUSTRIER<br>**Contact**: | **Samples:** 1 x bollard. Must be approved prior to installation.<br>**Prototype:** 1x bollard installed. Approved prototype may form part of the final landscape. | |
| **B02** | **CUSTOM BOLLARD TYPE 2 - FIXED** | **261** | **Custom sleeve**<br>**Materials**: Stainless Streel (316)<br>**Finish**: electroplated and aged bronze finish<br>**Dimensions**: Refer to details<br>**Inner bollard**<br>**Product**: Fixed Truckstopper 9-40 (TS9-40) or similar approved equivalent<br>**Fixings**: tamper proof sub surface fixed<br>**NOTE: subject to security review for final sizing and impact rating** | **Supplier**: Ezi Security Systems | **Samples:** 1 x bollard. Must be approved prior to installation.<br>**Prototype:** 1x bollard installed. Approved prototype may form part of the final landscape. | **Shop Drawing**: Shop Drawings to be provided for Approval by Landscape Architect prior to manufacture. |
| **B03** | **CUSTOM BOLLARD TYPE 3 - REMOVABLE** | **261** | **Custom sleeve**<br>**Materials**: Stainless Streel (316)<br>**Finish**: electroplated and aged bronze finish<br>**Dimensions**: Refer to details<br>**Inner bollard**<br>**Product**: Removable Truckstopper 9-40 (TS9-40) or similar approved equivalent<br>**Fixings**: tamper proof sub surface fixed<br>**NOTE: subject to security review for final sizing and impact rating** | **Supplier**: Ezi Security Systems | **Samples:** 1 x bollard. Must be approved prior to installation.<br>**Prototype:** 1x bollard installed. Approved prototype may form part of the final landscape. | **Shop Drawing**: Shop Drawings to be provided for Approval by Landscape Architect prior to manufacture. |

NSW GOVERNMENT | Planning, Industry & Environment

*Issued under the Environmental Planning and Assessment Act 1979*

Approved Application No: SSD-9835 Signed: A. Coonan

Granted on the: 6 Dec 2019 Sheet No: 83 of 83