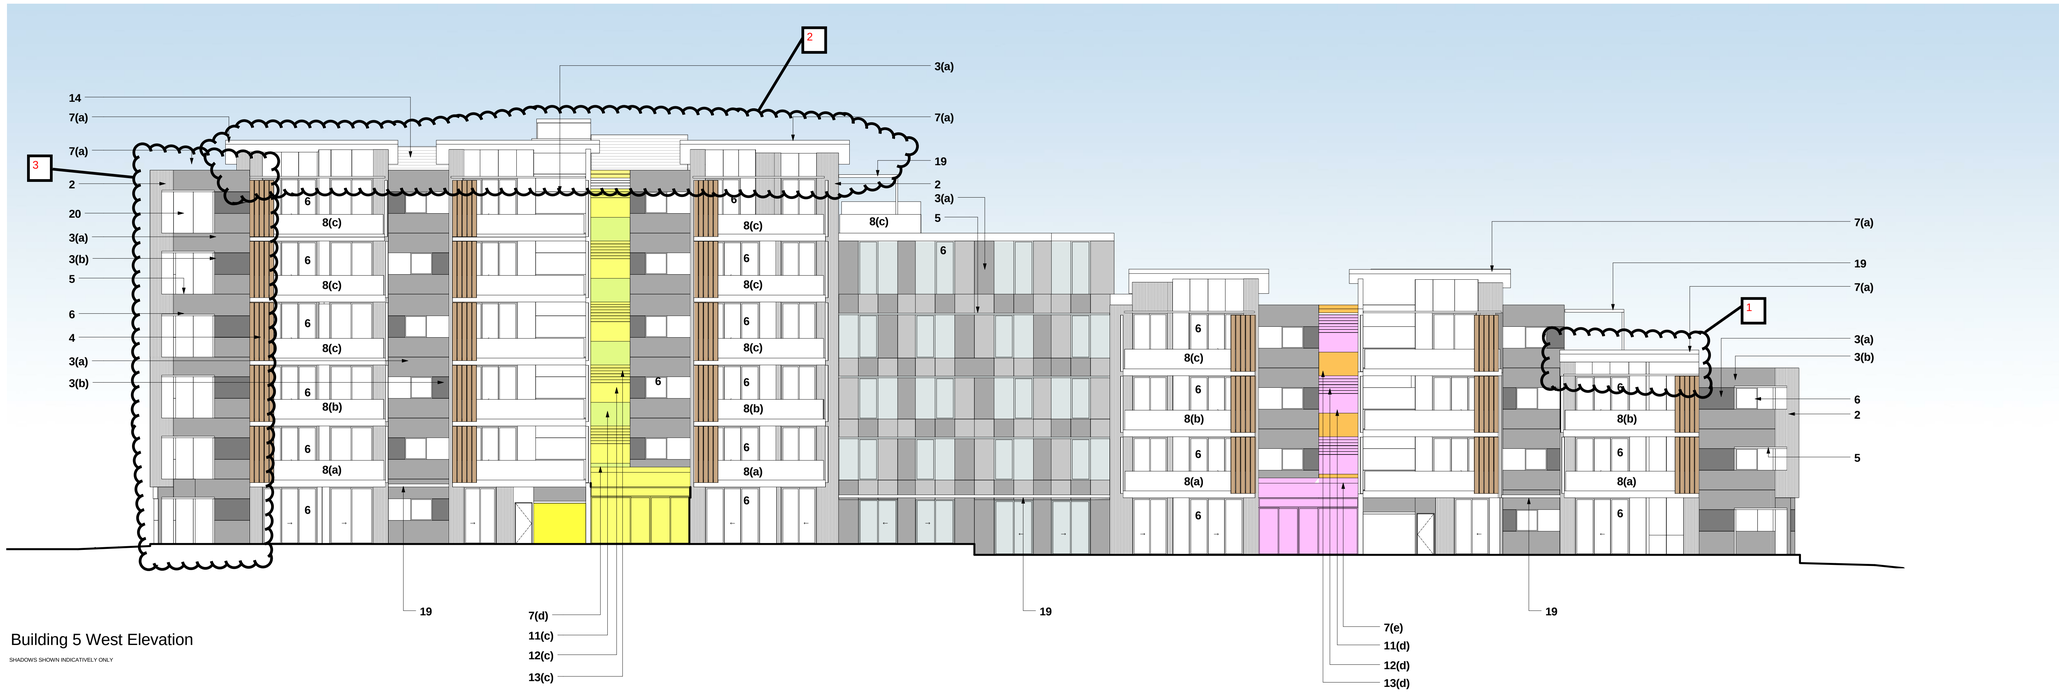

Building 5 West Elevation

SHADOWS SHOWN INDICATIVELY ONLY

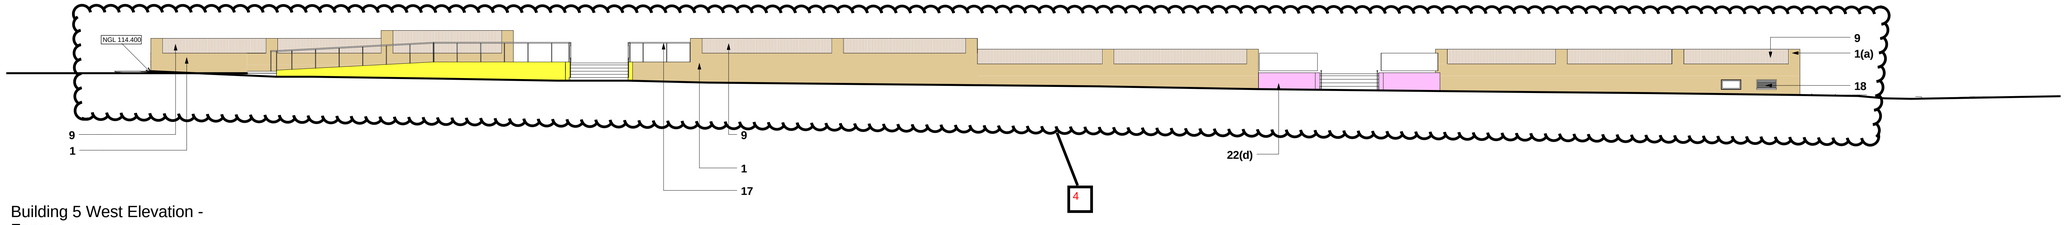

Building 5 West Elevation - Fence

SHADOWS SHOWN INDICATIVELY ONLY

LEGEND

1 SPLIT FACE CONCRETE BLOCK
2 TEXTURED/GROOVED PRECAST CONCRETE PANEL W/ PAINT FINISH
3 PRECAST CONCRETE PANEL AND PAINT FINISH
(a) COLOUR 1
(b) COLOUR 2
4 VERTICAL FIXED ALUMINIUM LOUVRES
5 ALUMINIUM EXTERNAL SUNSHADE
6 GLAZING WITH ALUMINIUM FRAMED DOORS AND WINDOWS
7 CONCRETE ROOF PAINT FINISH
(a) COLOUR 1
(b) COLOUR 2
(c) COLOUR 3
(d) COLOUR 4
(e) COLOUR 5
8 ALUMINIUM FRAMED GLASS BALUSTRADE
(a) OPACITY / TONE 1
(b) OPACITY / TONE 2
(c) OPACITY / TONE 3
9(a) FENCE TYPE A - POWDERCOATED ALUM.
9(b) FENCE TYPE B
10 METAL GATE
11 LOBBY SPANDREL PANEL
(a) COLOUR 1
(b) COLOUR 2
(c) COLOUR 3
(d) COLOUR 4
12 LOBBY GLAZING (VANCEVA GLAZING)
(a) COLOUR 1
(b) COLOUR 2
(c) COLOUR 3
(d) COLOUR 4
13 LOBBY OPERABLE WINDOW
(a) COLOUR 1
(b) COLOUR 2
(c) COLOUR 3
(d) COLOUR 4
14 ROOF PLANT ALUMINIUM LOUVRED SCREENS
15 OPERABLE EXTERNAL HORIZONTAL SCREEN
16 PAINT FINISH
17 METAL BALUSTRADE
18 CARPARK VENTILATION LOUVRES
19 TRELLIS / PERGOLA
20 SPANDREL PANEL PAINT FINISH
21 GARBAGE ROOM ROLLER SHUTTER
22 WALL TILES
(a) COLOUR 1
(b) COLOUR 2
(c) COLOUR 3
(d) COLOUR 4
23 OPAQUE WINDOW
24 CARPARK ENTRY DOOR (MAGIC DOOR INDUSTRY)
25 METAL WALL CLADDING - GALVANISED STEEL COLOUR

5

NOTE:

COLOURS NOMINATED ARE DESIGN INTENT AND ARE INDICATIVE ONLY.

FINAL BUILDING COLOURS MAY VARY FROM THOSE INDICATED & ARE SUBJECT TO MATERIAL COLOUR AVAILABILITY

NOTE:

PLEASE REFER TO A-4030 AND A-4031 FOR COLOUR SPECIFICATION

NOTE:

1. Furniture layout shown indicative only.
2. Site and Landscape shown for context only. Refer to Landscape Drawings .

Revision

-	PROJECT APPLICATION	28.06.2010
A	HEIGHT MARKUP	16.08.2010
B	UPDATE DRAWING, SECTION 75W ISSUE	14.04.2011

Revision

Revision

Do not scale from drawings. Verify all dimensions on site before commencing work. Copying or the reproduction of this drawing is strictly prohibited without the consent of Peddle Thorp & Walker P/L

Key Plan

Consultants

Landscape Architects	Sturt Associates	Suite 91, Level 5, 330 Wattle Street, Ultimo NSW 2007	Tel : 9211 3744
Waste Management	Elephants Foot	60B Kent Road, Mascot NSW 2020	Tel : 9667 4881
Structural	Meriton	Level 11, 528 Kent Street, NSW 2000	Tel : 9287 2888
Daylight/Solar Access	Higgies	2 Lincon Street, Lane Cove NSW 2066	Tel: 9427 8100
Traffic	Halcrow	Suite 20, 809 Pacific HWY, Chatswood NSW 2067	Tel: 9410 4100
Nathers/Basix	Efficient Living	24B/176 South Creek Road, Cromer NSW 2099	Tel: 9944 0332

Client

Meriton Apartments Pty Ltd

Level 11, 528 Kent Street
Sydney NSW 2000
T (02) 92872888
F (02) 92872777
www.meriton.com.au

Architect

PTW Architects

Level 17, 9 Castlereagh St
Sydney NSW Australia 2000
T 612 9232 5877
F 612 9221 4139
www.ptw.com.au

PTW

Title Building 5 West Elevation

1 2 4 1:100 @ A0

Drawing

PROJ NO 209002.3
SCALE: 1 : 100 @A0
DATE: 02.06.2010

APPROVED: SP

Project

Epping Park
61 Mobbs Lane, Epping
Stage 1 (Building 4+5)

A5200

REVISION B

SECTION 75W ISSUE