


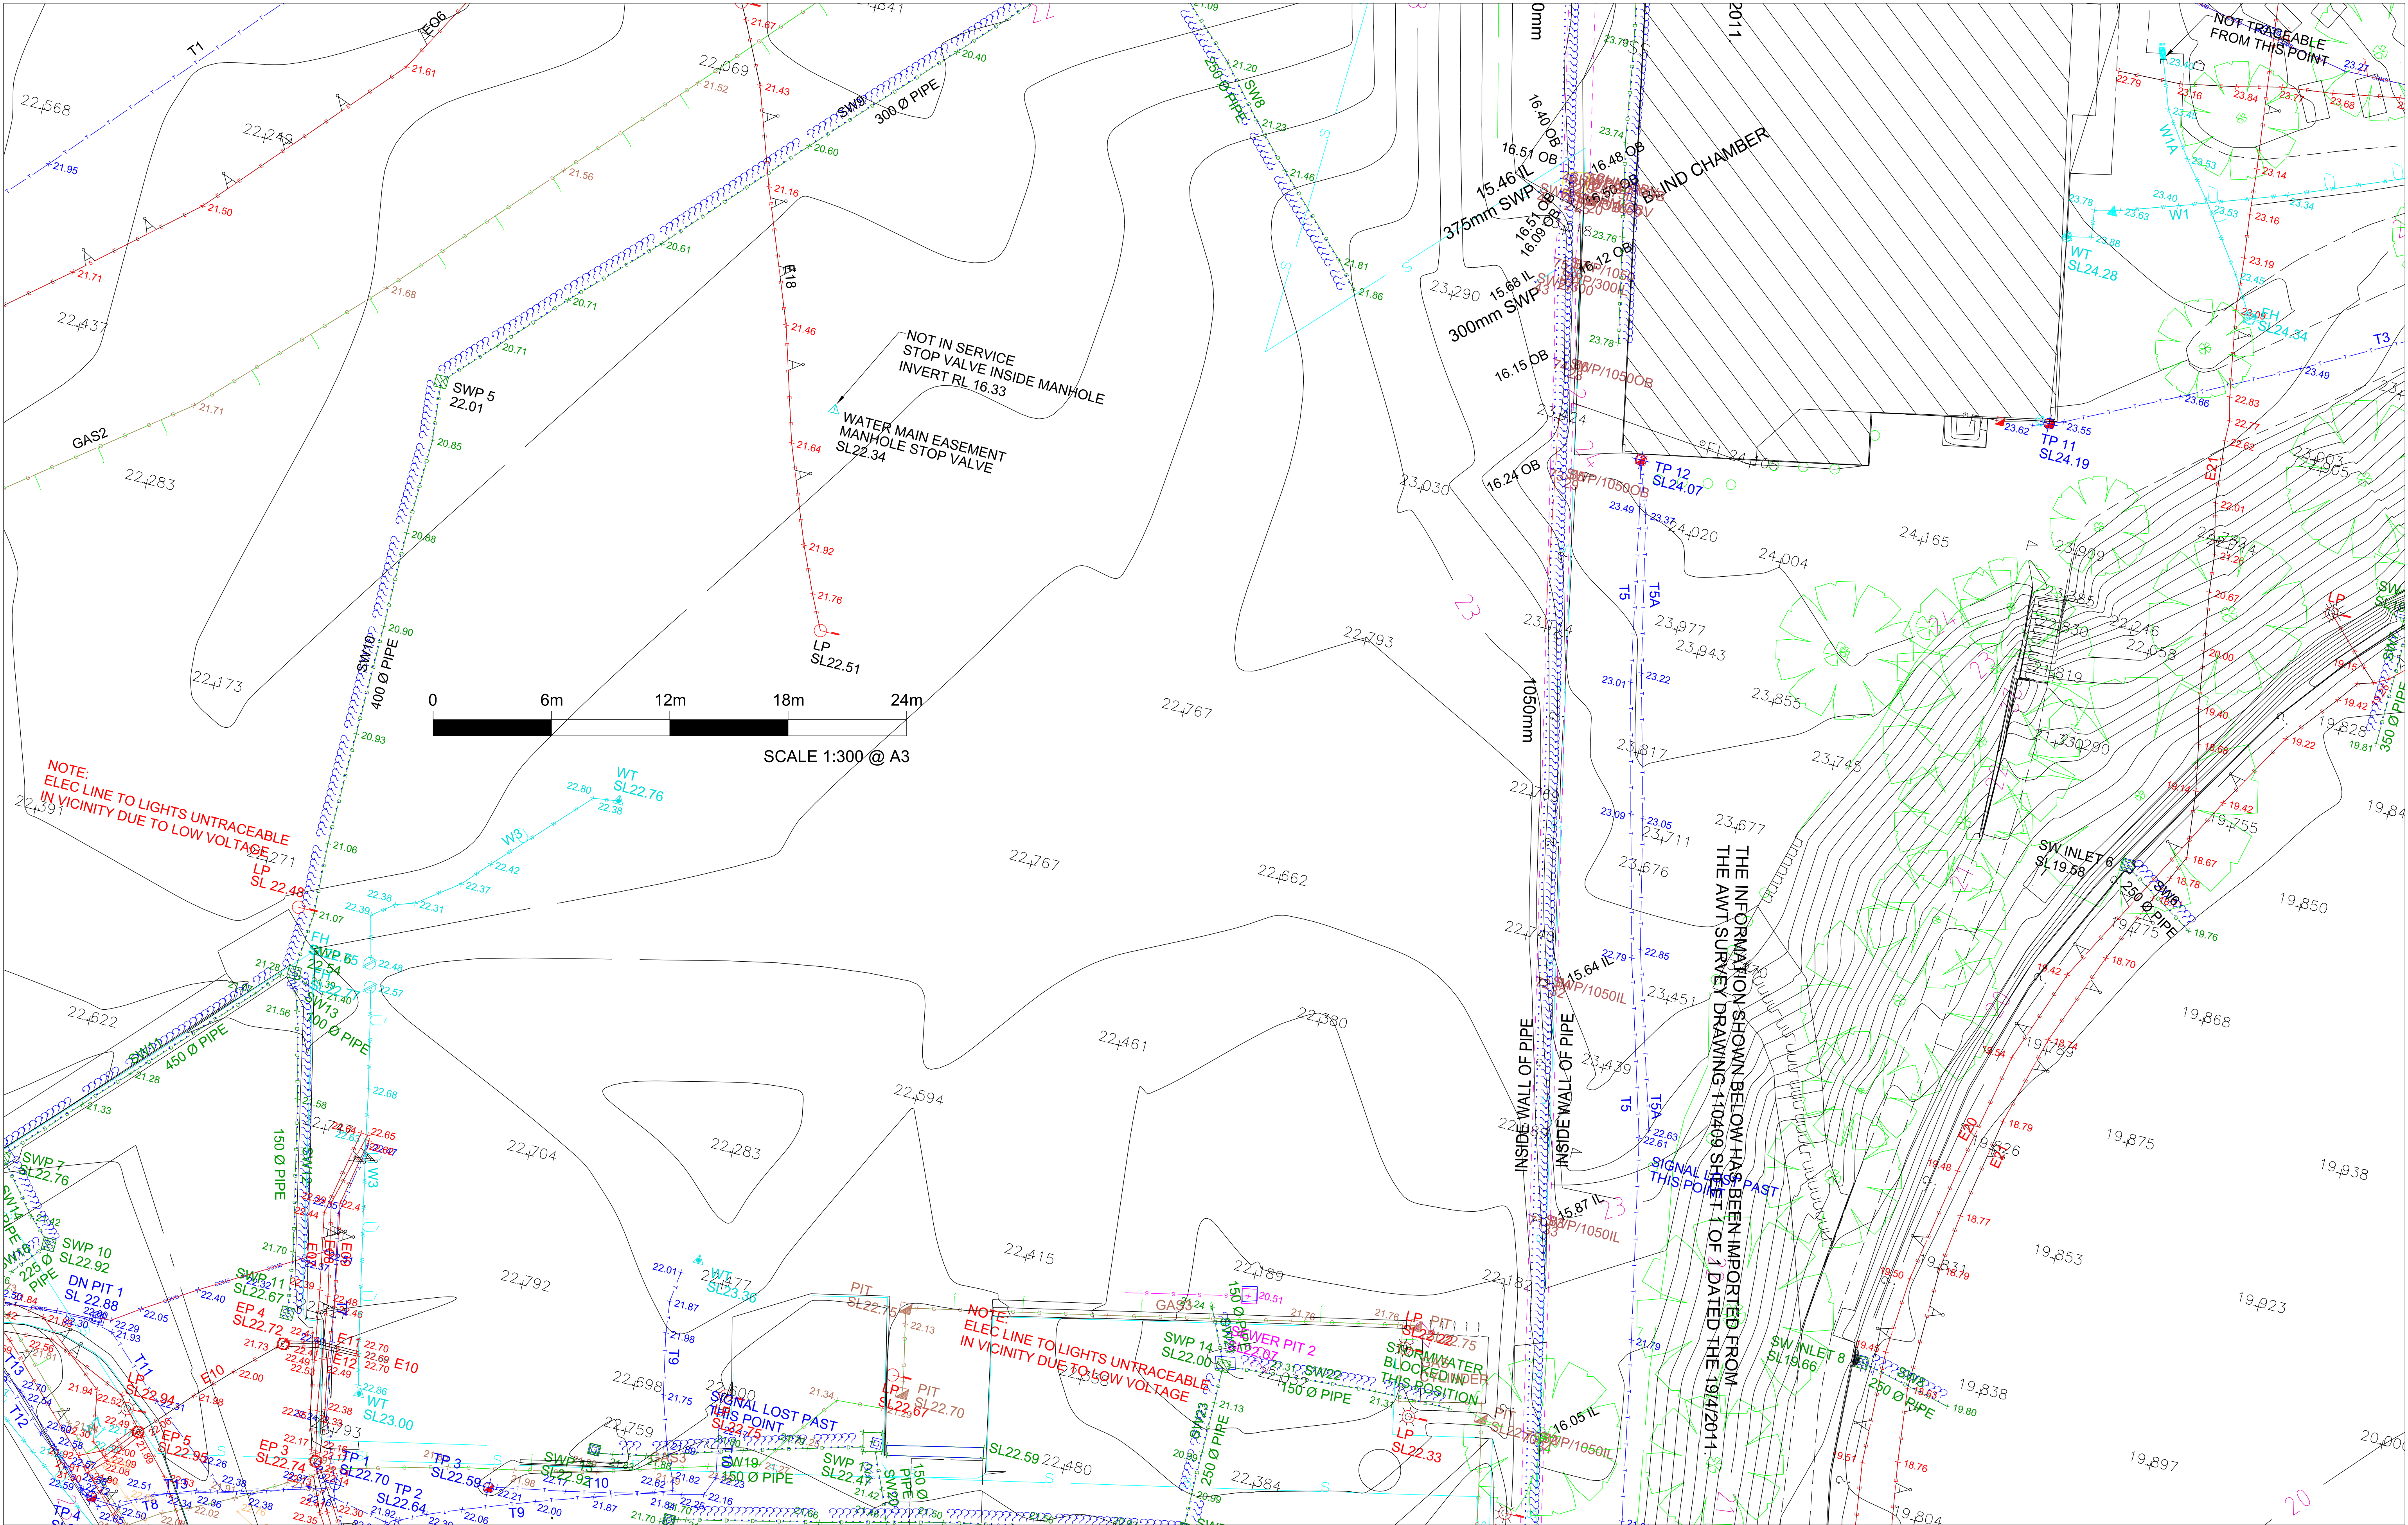

06	4/10/2011	ADD FENCE ADJACENT TO ST. JOHNS OVAL		MC
05	28.09.2011	ADD ELEC, COMMS, STWTR & PATH		MC
04	20.09.2011	ADD AS-BUILT PIPE ADJACENT TO PIT 1/8		MC
03	7.09.2011	ADD HK WARD, TANK & GRANDSTAND CARPARK		MC
02	25-08-11	ADD DETAIL		BMC
01	24-08-11	ADD DETAIL		BMC
00		ORIGINAL ISSUE		BMC
REVISION	DATE	DESCRIPTION	12D REF	APPROVED

h&f

Consulting Surveyors

Hard & Forester Pty Ltd ABN 67 003 541 348

HARD & FORESTER

HARD & FORESTER

23-25 Frederick Street
PO Box 175
Rockdale NSW 2216
DX111116 Kogarah
t: (02) 9597 9700
f: (02) 9599 2146
e: survey@hardforester.com.au
w: www.hardforester.com.au

PROJECT: COCDC BUILDING

SURVEY GROUND MODEL
FOR DESIGN AND FLOOD STUDY

CLIENT: UNIVERSITY OF SYDNEY

SURVEYED R.A/D.D	DRAWN J.T	CHECKED	PASSED
SCALE 1:300		SHT 14 OF 25 SHTS	
DRAWING NUMBER		REV	A3
113903515		06	