In accepting and utilising this document the recipient agrees that SJB Architecture (NSW) Pty. Ltd. ACN 081 094 724 T/A SJB Architects, retain all common law, statutory law and other rights including copyright and intellectual property rights. The recipient agrees not to use this document for any purpose other than its intended use; to waive all claims against SJB Architects resulting from unauthorised changes; or to reuse the document on other projects without the prior written consent of SJB Architects. Under no circumstances shall transfer of this document be deemed a sale. SJB Architects makes no warranties of fitness for any purpose.

The Builder/Contractor shall verify job dimensions prior to any work commencing. Figured dimensions shall take precedence over scaled work.

S75W - FOR APPROVAL

Rev.	Date	Revision
A	12/11/2010	DA Test of Adequacy
A-1	22/02/2011	Preferred Project
A-2	15/04/2012	S75W - March 2012

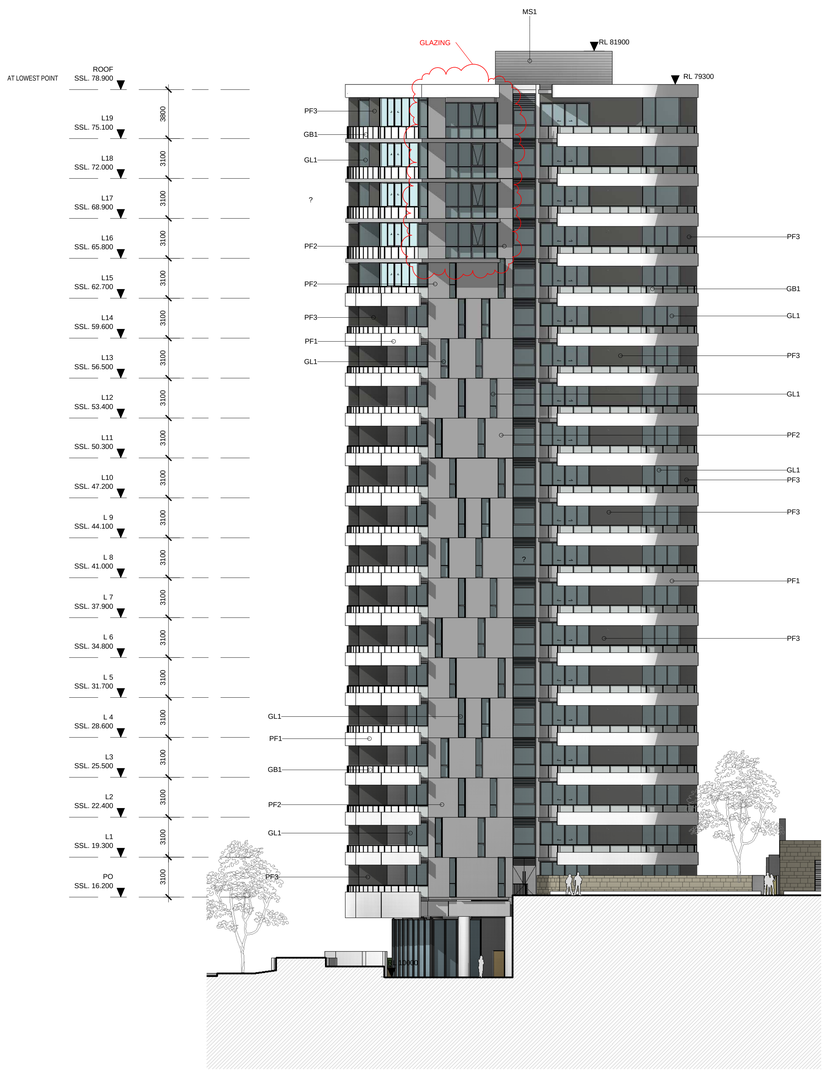

2 ELEVATION
BLDG C - SOUTH
1 : 200

1 ELEVATION
BLDG C - EAST
1 : 200

EXTERNAL FINISHES

CONCRETE

CN1 Concrete natural finish
CR1 Concrete render finish
RF1 Roof Finish - Gravel

MASONRY

PF1 Texture applied finish - White
PF2 Texture applied finish - Light Warm Grey
PF3 Texture applied finish - Dark Grey

ST1 Stone cladding - Stacked grey colour
ST2 Stone cladding - Sandstone Finish

GLAZING

GL1 Clear Glass Windows
GL2 Louvred Clear Glass Windows
GL3 Obscure Glazing Balustrade
GL4 Feature Coloured Glass
GB1 Clear glass balustrade with Metal handrail
WG Wintergarden

METALWORKS

MB1 Metal balustrade - Steel Galvanised
MF1 Metal Finish - Window + Door frames
MF2 Metal Finish - Shading blades
MF3 Metal Finish - Louvre screen
MS1 Metal Finish - Plant Screening
MS2 Metal Finish - Screen to apartment entries

TIMBER

TC1 External cladding - Timber Boards
TB1 Timber Floor Boards - Natural Stain

NOTE: AS BUILT LEVELS MAY VARY +/- 30mm FROM NOTMINATED SSL's

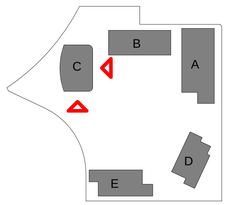

Client

Billbergia
creating communities®

Project

STAGE 2A + 3A
WALKER ST.
RHODES
for
Billbergia Developments

Drawing Name

Elevations - BLDG C
East & West

Date	Scale	Sheet Size
18.04.2012	1 : 200	@ B1
Reg No.	Drawn	Chk.
	MM/NH	JP
Job No.	Drawing No.	Revision
4410	A-0507	A-2

SJB Architects
Level 2, 490 Crown St
Surry Hills NSW
2010 Australia
T 61 2 9380 9911
F 61 2 9380 9922
www.sjb.com.au

Nominated Architects
Adam Haddow 7188
John Pradel 7004

2010/4/20 2:40:05 PM