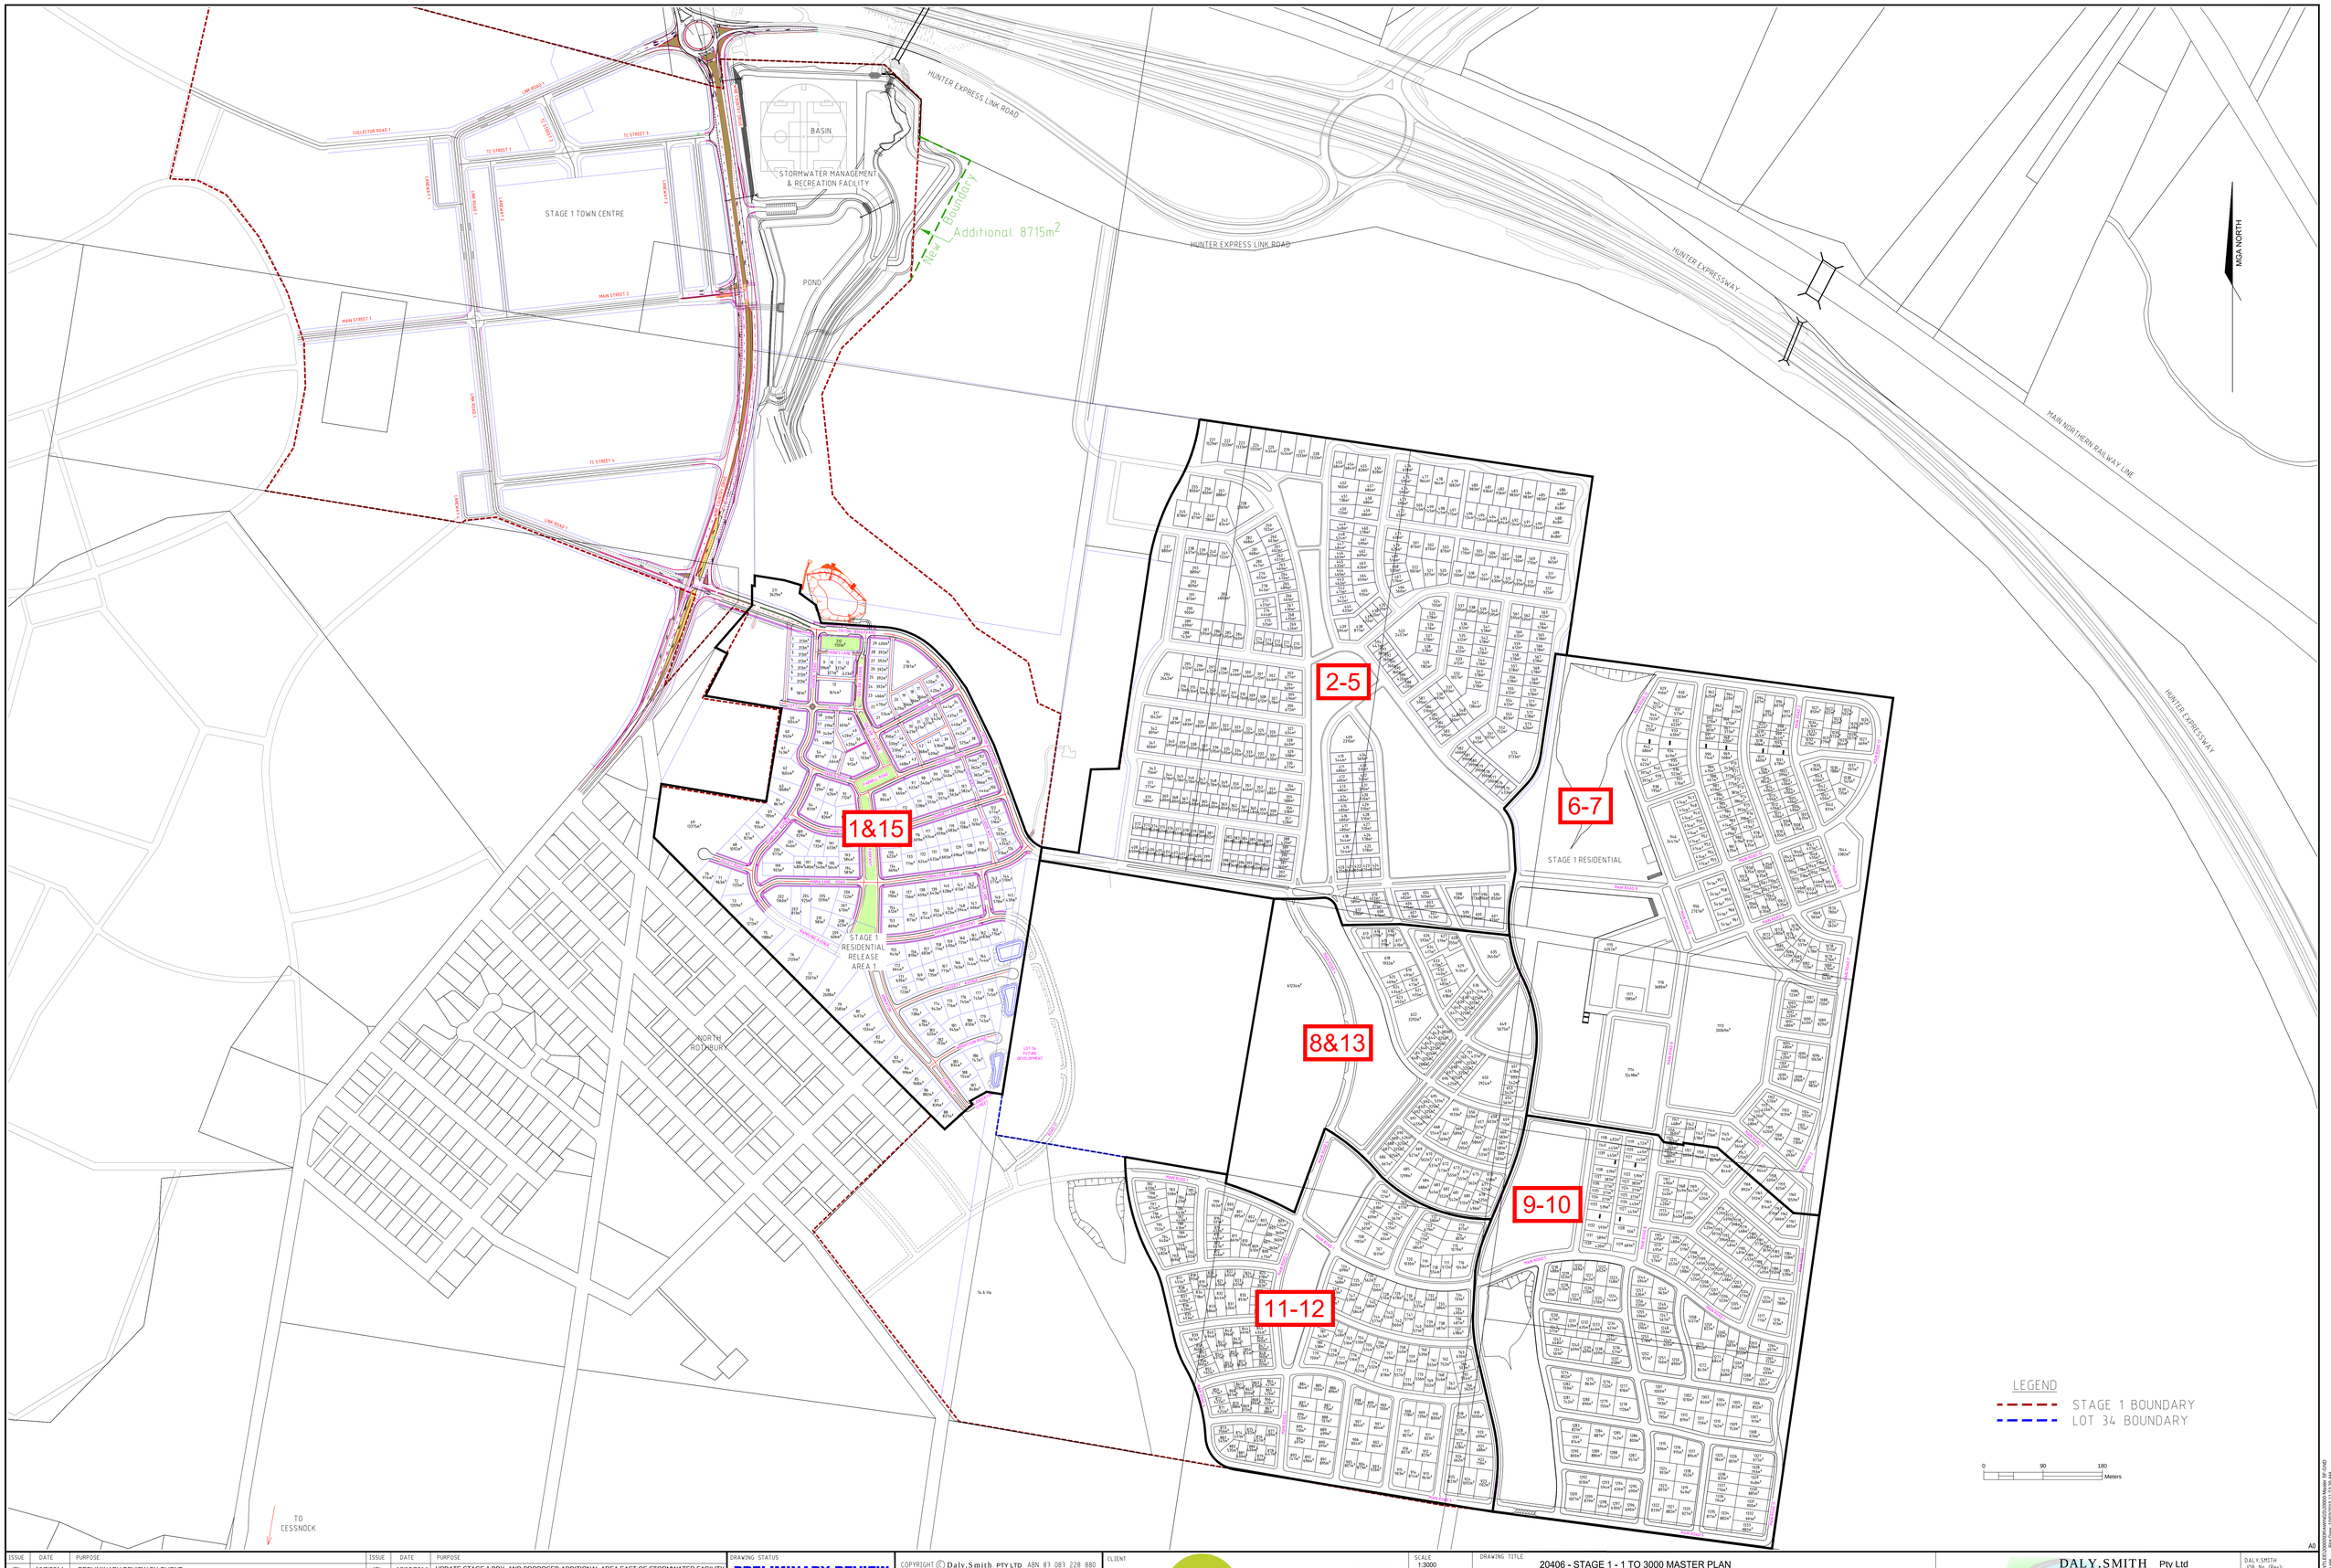

ISSUE	DATE	PURPOSE
(0)	16/7/2014	PRELIMINARY REVIEW BY CLIENT
(1)	6/8/2014	INCLUDE PROPOSED STAGE 5, AMEND ROAD NAMES
(2)	12/8/2014	REVISE LOT NUMBERS , CHECK AREAS WHERE RED LINES AND REMOVE RED LINEWORK
(3)	20/8/2014	REVISE LOT NUMBERS , UPDATE WP DESIGNS - TOWN CENTRE, REMOVE DIMENSIONS
(4)	21/8/2014	UPDATE WP DESIGNS
(5)	9/12/2014	UPDATE LOT 213, WCD RD WIDENING, EAST BDY STORMWATER FACILITY
(6)	16/12/2014	UPDATE STAGE 1 BDY, AND PROPOSED ADDITIONAL AREA EAST OF STORMWATER FACILITY
(7)	13/02/2015	MAJOR REVISION IN PRECINCT 2 AREA BETWEEN LOTS NUMBERED 214-617
(8)	18/02/2015	REVISION OF LOT NUMBERS IN PRECINCT 2 AREA BETWEEN LOTS NUMBERED 214-612
(9)	9/03/2015	ADDITION OF SUB-STAGES
(10)	10/03/2015	REMOVE SUB-STAGES, AMEND BOUNDARIES 202-205 & 210, AMEND LOT No.s 202-212

DRAWING STATUS

PRELIMINARY REVIEW
NOT FOR CONSTRUCTION

THIS IS A COLOUR DRAWING AND SHOULD NOT BE REPRODUCED IN BLACK AND WHITE

COPYRIGHT © Daly.Smith PTY LTD ABN 83 083 228 880

THE DRAWING IS PREPARED SOLELY FOR THE USE OF THE CONTRACTURAL CUSTOMER OF Daly.Smith PTY LTD AND Daly.Smith PTY LTD ASSUMES NO LIABILITY TO ANY OTHER PARTY FOR ANY REPRESENTATIONS CONTAINED IN THIS DRAWING.

CLIENT

Huntlee

LWP bringing communities to life

SCALE	1:3000
SHEET SIZE	A0
DRAWN BY	ADM
CHECKED BY	GJS
DRAWING TITLE	20406 - STAGE 1 - 1 TO 3000 MASTER PLAN
PROJECT	HUNTLEE STAGE 1 - DEVELOPMENT AREA WINE COUNTRY DRIVE, HUNTLEE
CLIENT	HUNTLEE PTY.LTD.

DALY.SMITH Pty Ltd
Surveying & Land Development Services
CENTRAL COAST & HUNTER
3/48 NEWCASTLE STREET, MORISSET
Ph (02) 49732745
Email: morisset@dalysmith.com.au
www.dalysmith.com.au

DALY.SMITH JOB No (Rev):
20406(10)

SHEET NO:
1 OF 1

A0

Drawing: X:\DRAWINGS\20406\ART\LEED\20406MASTER.DWG Model: SP-DWG
Plot Date: 10/03/2015 11:23:39 AM
Plot Style: 10/03/2015 9:58:49 AM