

LEGEND

ITEMS REQUIRING
DEMOLITION AND REMOVAL








EXISTING WALLS/ STRUCTURE

NOTE: TO BE READ IN CONJUNCTION WITH
ANNOTATED PHOTOGRAPHHS

NOTES :

ALL DESIGNS, PRINTS AND SPECIFICATIONS ARE
THE PROPERTY a+ INTERIORS AND CANNOT BE
USED WITHOUT THEIR WRITTEN PERMISSION.
DO NOT SCALE THIS DRAWING. USE FIGURED
DIMENSIONS ONLY.
CONTRACTOR MUST VERIFY ALL DIMENSIONS ON
SITE BEFORE COMMENCEMENT OF WORK.
THESE DRAWINGS ARE TO BE READ IN
CONJUNCTION WITH ARCHITECTURAL BASE
DRAWINGS AND RELEVANT CONSULTANT
DRAWINGS.
MANUFACTURER SHALL PREPARE SHOP DRAWINGS
OR PROTOTYPE SAMPLES PRO RELEVANT ITEMS
AND SUBMIT TO DESIGNER FOR APPROVAL.

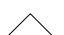REFERENCE :

- REFER TO THE
FINISHES SCHEDULE
- REFER TO THE FFE
FURNITURE DRAWINGS
- REFER TO THE FITTINGS
& FIXTURES SCHEDULE
- REFER TO THE DOOR
HARDWARE SCHEDULE
- REFER TO THE
ARTWORK SCHEDULE

ISSUE	DESCRIPTION	DATE
A	PRELIMINARY ISSUE	06.12.13
B	TENDER ISSUE	14.02.14
C	REVISED TENDER ISSUE - AMENDED AS PER CLIENT MARKUP	10.03.14



Level 2, 89 Chandos Street St Leonards
NSW 2065 AUSTRALIA
T : +61 2 9966 8116
www.aplusdg.com.au


Client: FOUR POINTS SHERATON

Project:
NORTHERN WAREHOUSE
RESTAURANT

Area:
ALL DAY DINING

Title: LEVEL 1 -
DEMOLITION PLAN

Scale : 1:100@A3		Project No.: I13005	
Drawn : MG	Checked : MW	Approved : MW	Date : 06.12.13
Drawing No.: ID - 04			Issue : C

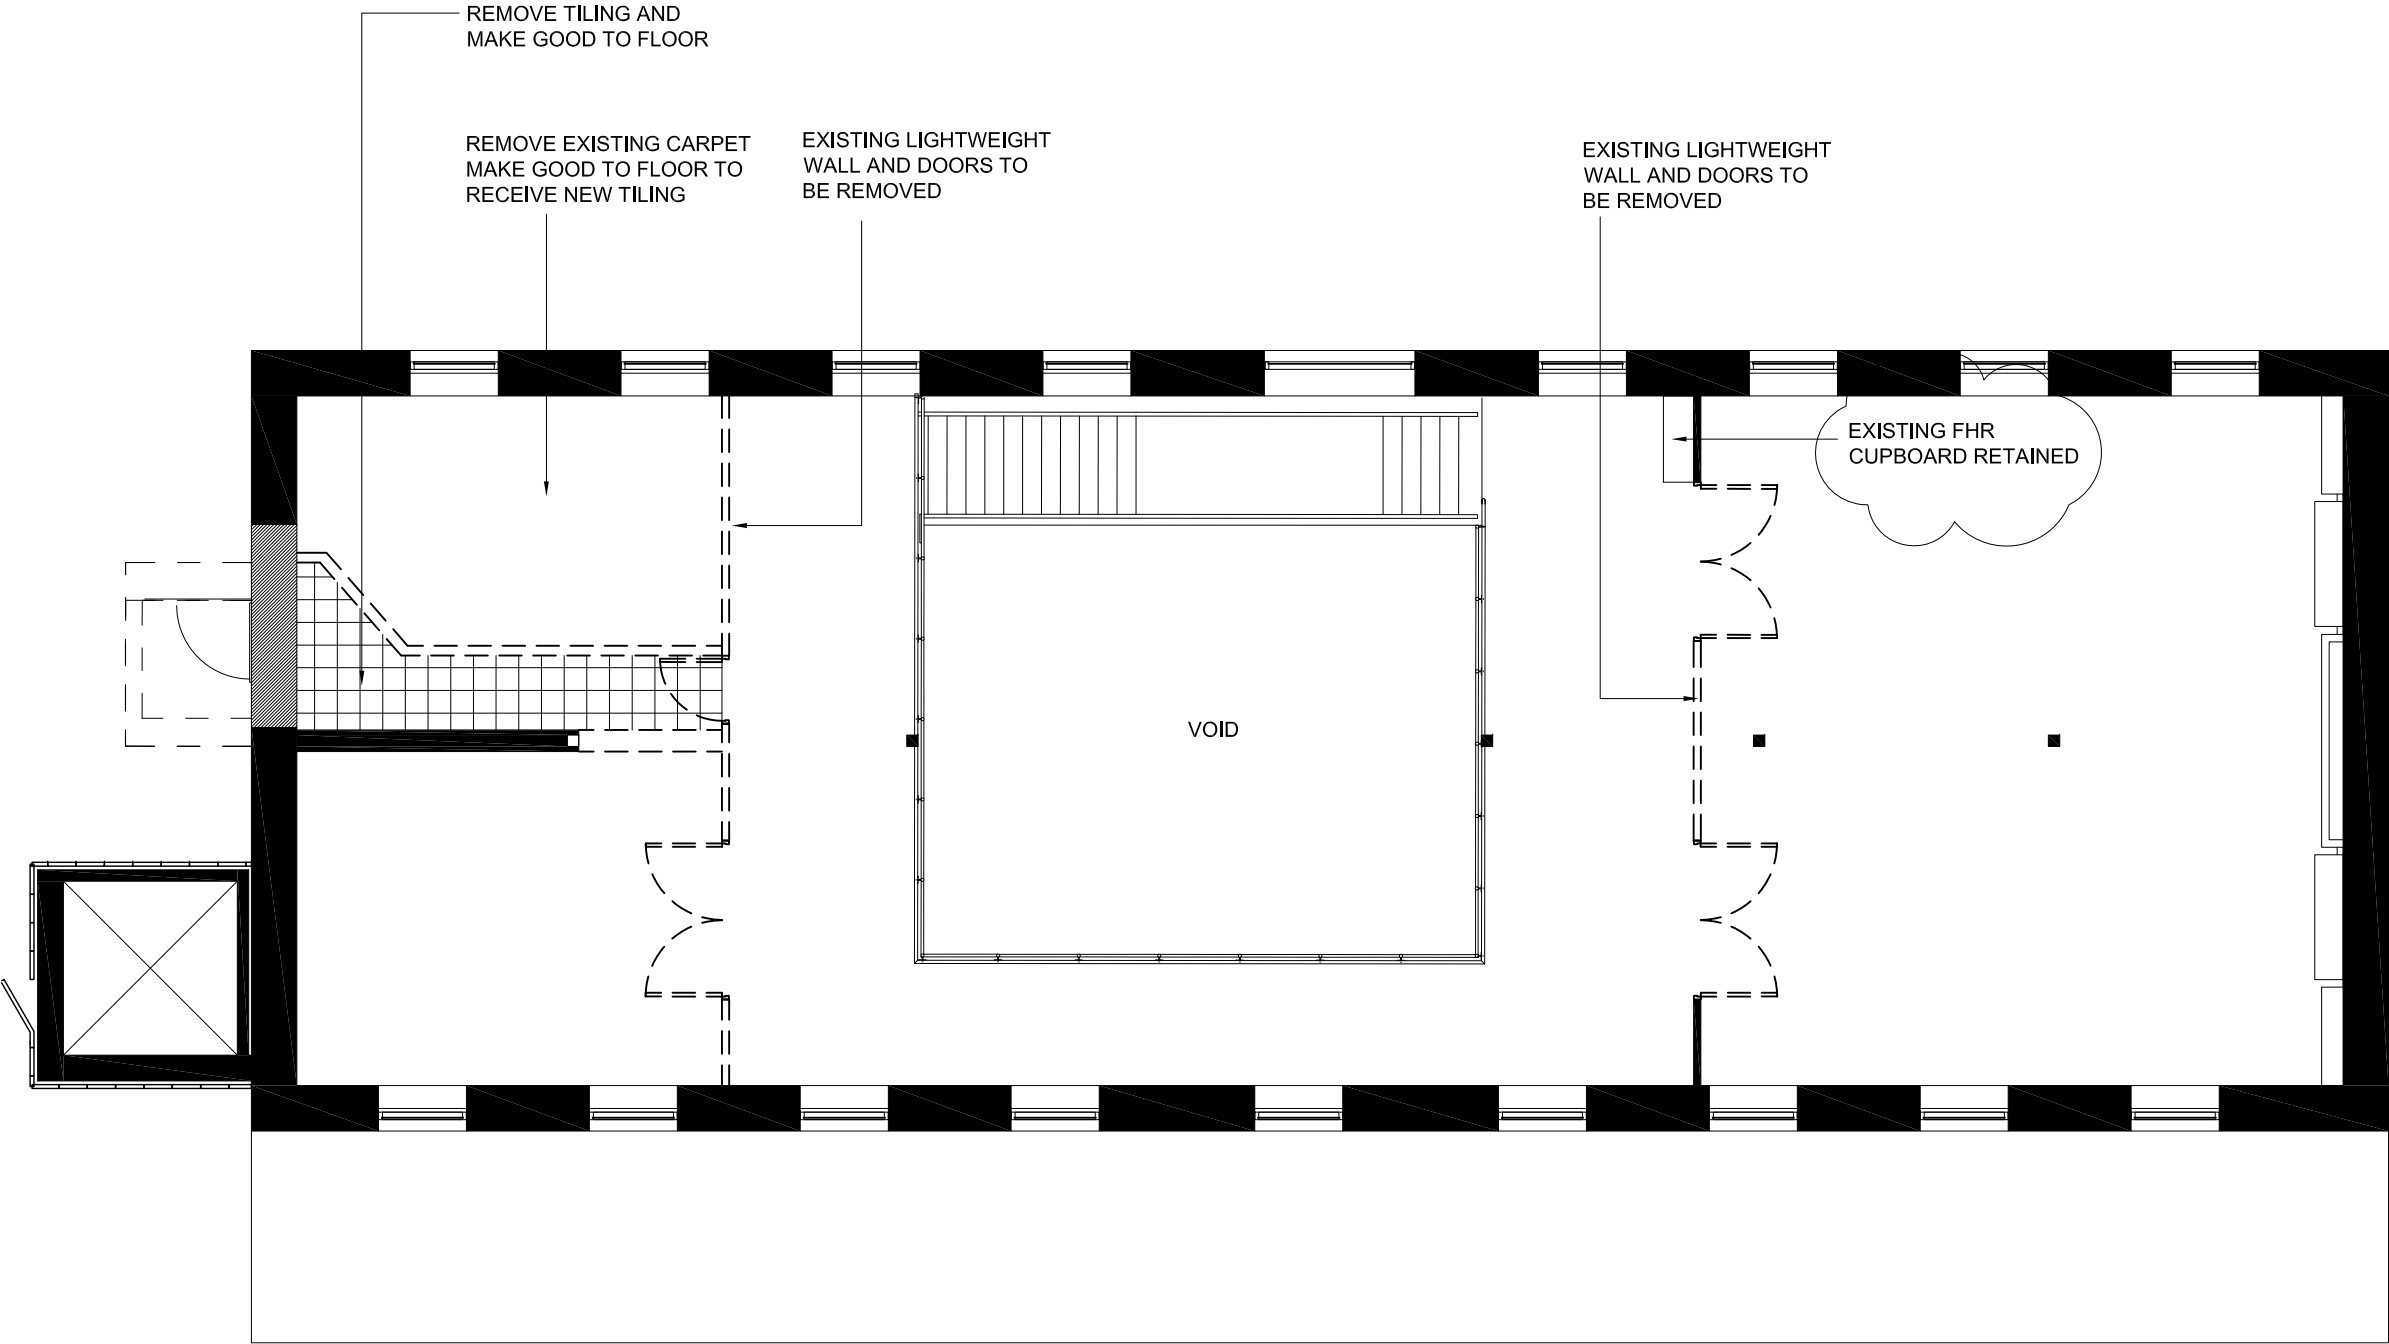

01 DEMOLITION PLAN

DESIGN INTENT