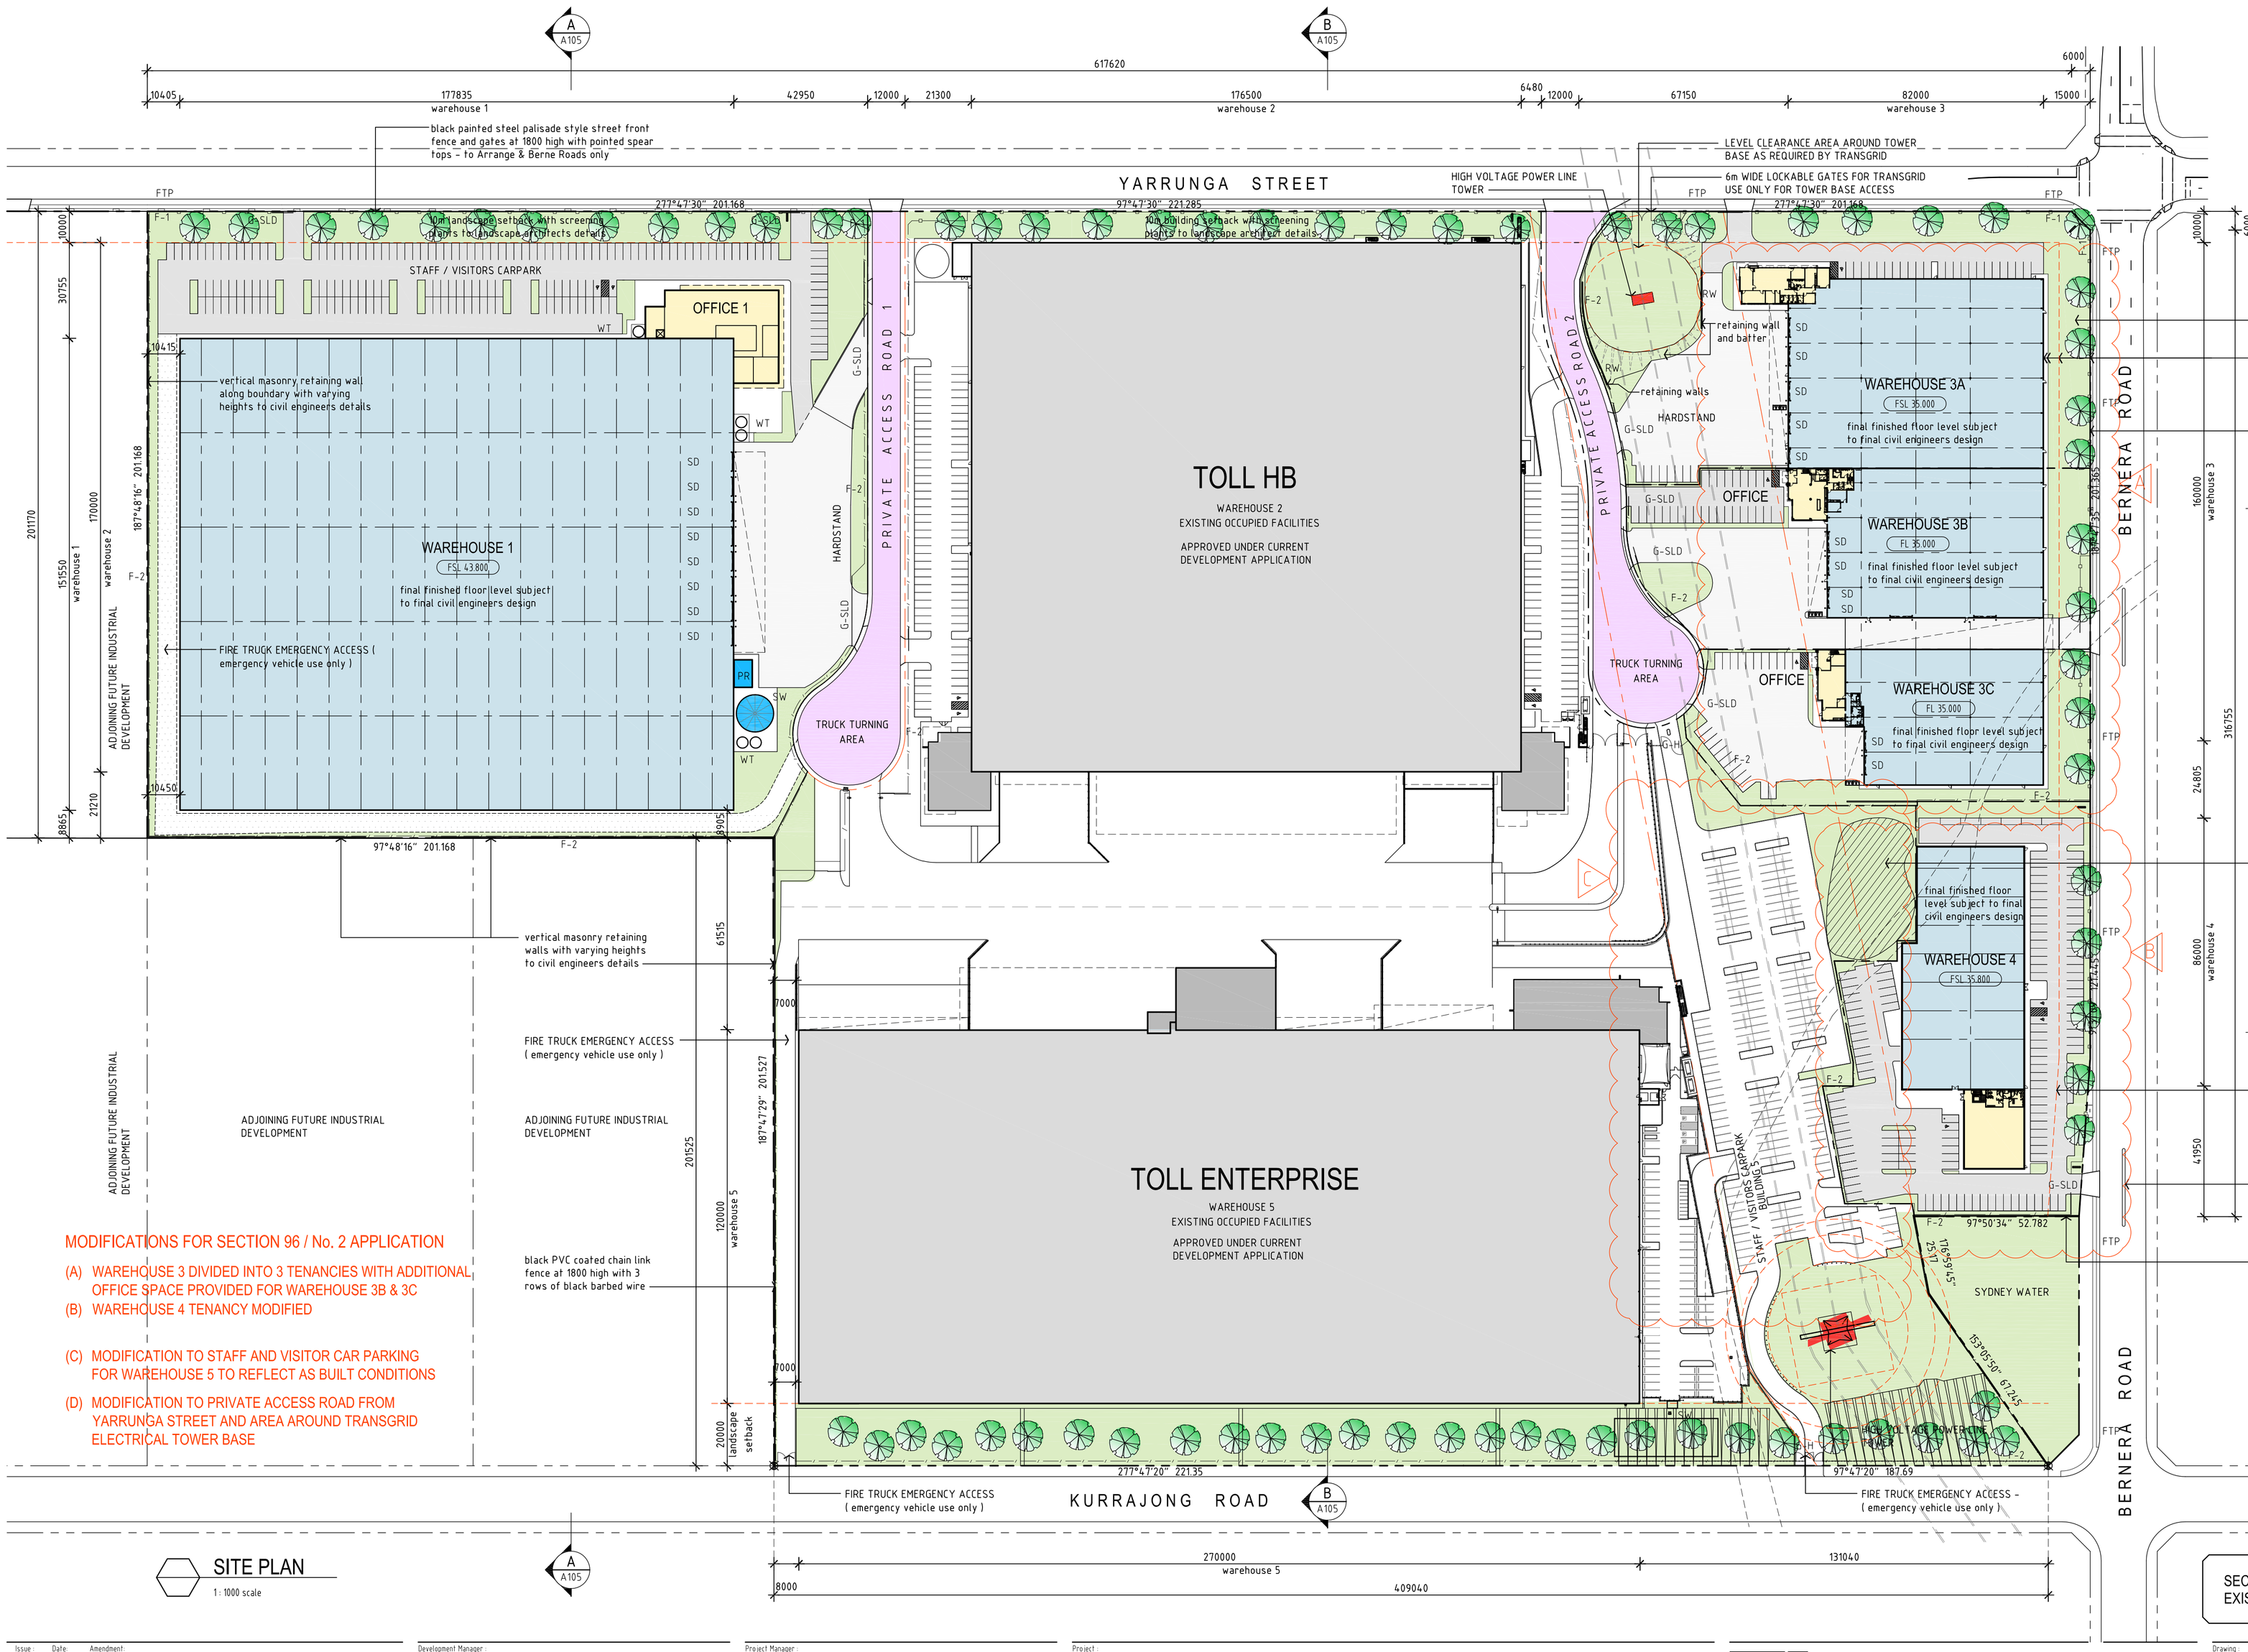

ABBREVIATIONS - GENERAL

FTP	footpath - street path 1.2m wide
F-1	fence type 1 - 1800 high black palisade fence with pointed spear tops
F-2	fence type 2 - 1800 high black chain link fence with 3 rows of barb wire
FL	finished structural level
G-SLD	gate - sliding
G-H	gate - hinged
PR	pump room for fire service
PS	pylon sign
SD	roller shutter door - power operated
WT	rain water tank
SW	sound barrier wall - 2.4m high lapped timber
SW	sprinkler water tank for fire service

MODIFICATIONS FOR SECTION 96 / No. 2 APPLICATION

(A) WAREHOUSE 3 DIVIDED INTO 3 TENANCIES WITH ADDITIONAL OFFICE SPACE PROVIDED FOR WAREHOUSE 3B & 3C

(B) WAREHOUSE 4 TENANCY MODIFIED

(C) MODIFICATION TO STAFF AND VISITOR CAR PARKING FOR WAREHOUSE 5 TO REFLECT AS BUILT CONDITIONS

(D) MODIFICATION TO PRIVATE ACCESS ROAD FROM YARRUNGA STREET AND AREA AROUND TRANSGRID ELECTRICAL TOWER BASE

SITE PLAN

1 : 1000 scale

SECTION 96 / No.2 APPLICATION TO MODIFY EXISTING DEVELOPMENT APPLICATION

Issue	Date	Amendment
I	12/05/16	LIFT FROM CARPARK RELOCATED ADJCENT TO BUILDING 5
J	28/09/16	ISSUED FOR SECTION 96 APPLICATION
K	15/06/17	ISSUED FOR SECTION 96 - No. 2 APPLICATION
L	08/08/17	access gate added from yarrunga street for transgrid tower base
M	30/10/17	BUILDING 4 NOTED AS WAREHOUSE AND OFFICE

0 10 20 30 40 50 100m - @ A1

0 20 40 60 80 100 200m - @ A3

1 : 1000 scale @ A1 / 1 : 2000 scale @ A3

Development Manager :
LOGOS Property Group
Suite 12.02 / 167 Macquarie Street
Sydney NSW 2000
t: + 61 2 9119 6066 F: + 61 2 9231 0948

Project Manager :
DBL PROPERTY
Project / Development Managers
Level 6 / 432 Kent Street
Sydney NSW 2000
t: + 61 2 9267 4267 F: + 61 2 9267 4265

Project :

PRESTONS INDUSTRIAL ESTATE

PROPOSED WAREHOUSE DEVELOPMENT

Cnr YARRUNGA STREET & BERNERA ROAD , PRESTONS NSW

AXIS ARCHITECTURAL
4 / 112 Cronulla Street, Cronulla NSW 2230
p + 02 9523 7858 / m + 0414 954 405
e + david@axisarchitects.com.au
AXIS ARCHITECTURAL Pty Ltd - ABN 18 086 853 376
Nominated Architect - David McDonald NSW ARB No. 7997
Member Australian Institute of Architects

Drawing :
SITE PLAN - COLOURED
OVERALL ESTATE PLAN

Drawn : AA	Project No :	Drawing No :	Issue :
Date : November 2015	140604	S96 - A 102	M
Scale : 1 : 1000 @ A1 1 : 2000 @ A3			