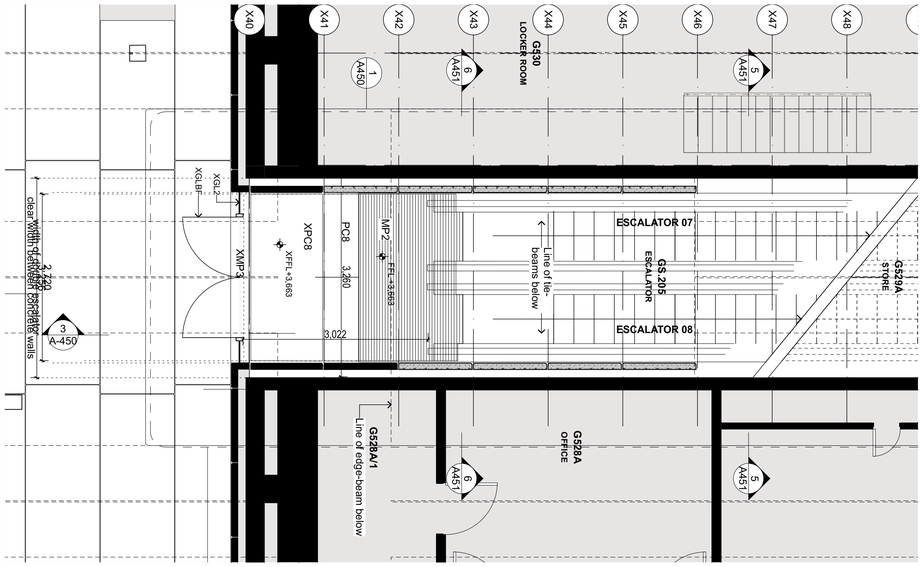

1 PROPOSED GROUND FLOOR DETAIL PLAN
1:50

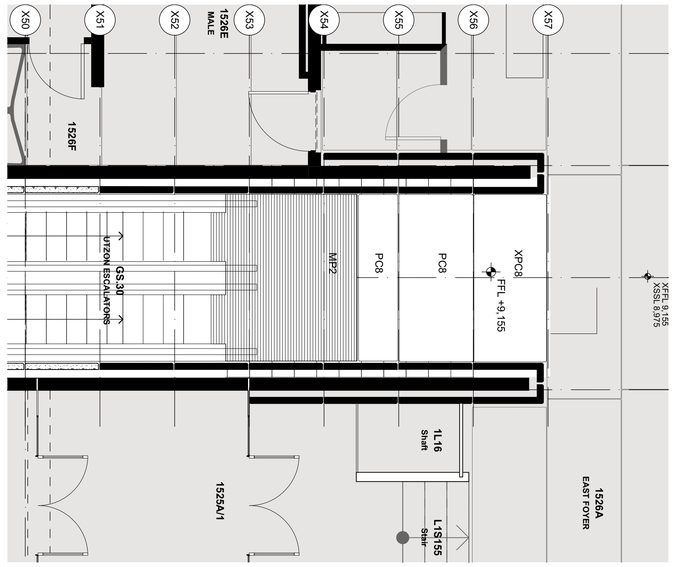

2 PROPOSED LEVEL 1 DETAIL PLAN
1:50

ESCALATOR SURVEY NOTES

The structure below Level GR+12 (FFL+3,663) is based on ARUP legacy drawings only and:

- has not been surveyed
- is not based on as-built drawings
- must be surveyed prior to any demolition works are started to confirm the proposed design

un-surveyed existing structure

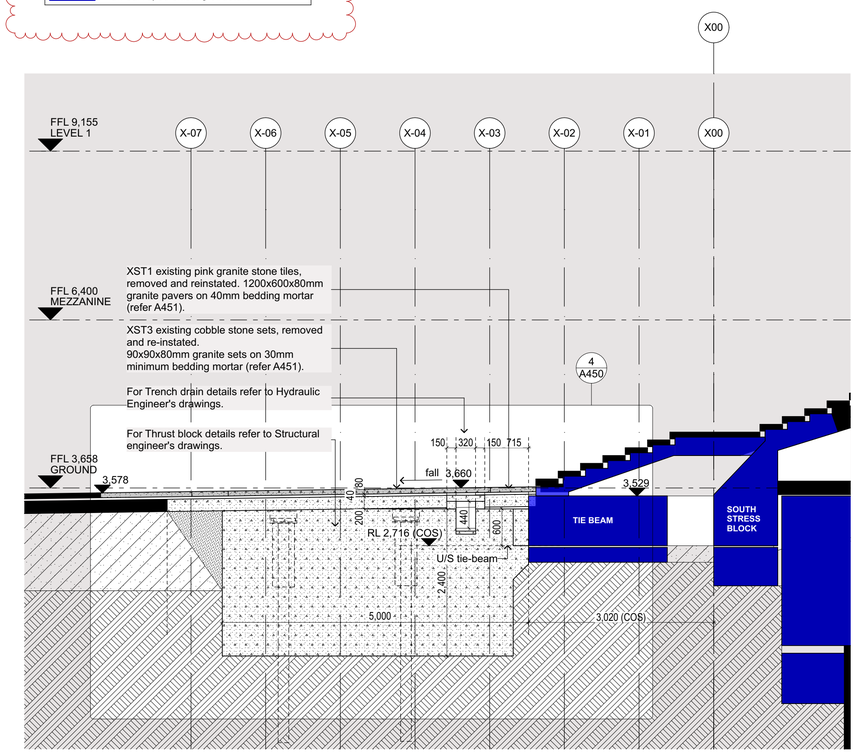

4 N-S SECTION THRUST BLOCK
1:50

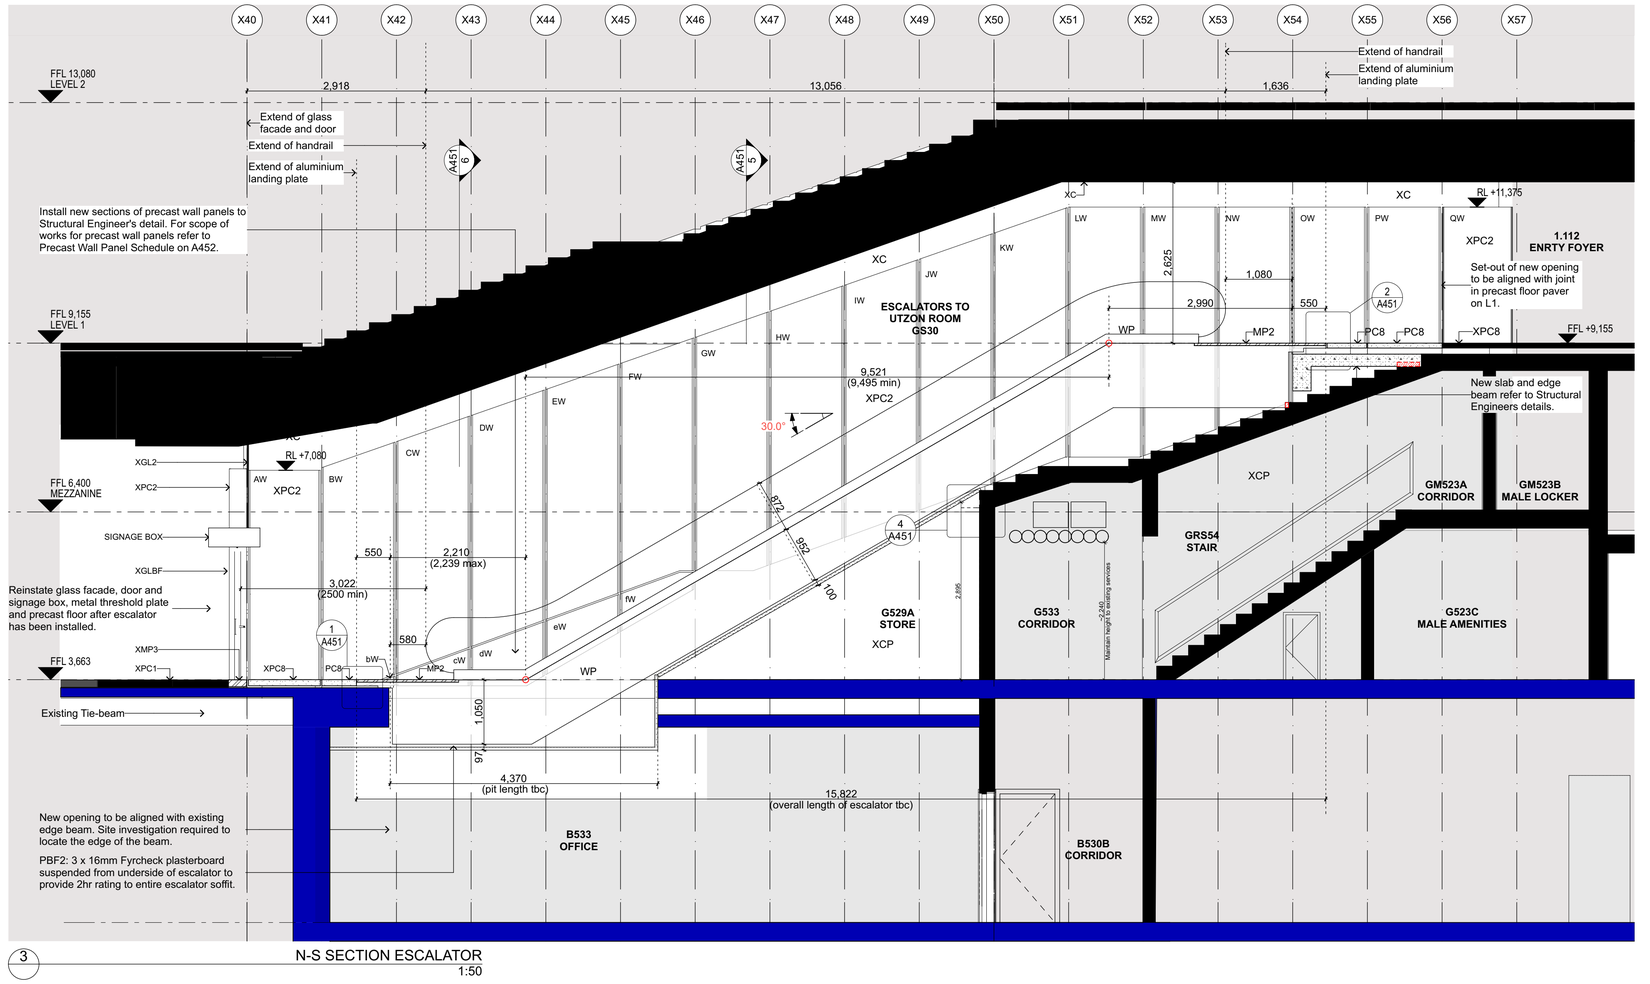

3 N-S SECTION ESCALATOR
1:50

Issue	Description	Drwn	Apvd	Date
1	ISSUED FOR TENDER	RM	TG	18.12.17
2	TENDER ADDENDUM 01	GD	TG	03.05.18
3	TENDER ADDENDUM 02	RM	TG	27.06.18
4	TENDER ADDENDUM 03 - REVISED NOTES	RM	TG	17.08.18

NOTES
1. ALL DIMENSIONS AND SIZES ARE IN MILLIMETRES.
2. DO NOT SCALE DRAWINGS. USE FIGURED DIMENSIONS ONLY.
3. INFORMATION INDICATED IN THIS DOCUMENT MAY BE CRUCIAL TO THE SAFE AND PROPER FUNCTIONING OF THE SYDNEY OPERA HOUSE. DO NOT ALTER ANY ASPECT WITHOUT WRITTEN PERMISSION.
4. ALL NEW WORKS MUST COMPLY WITH THE SYDNEY OPERA HOUSE BUILDING SERVICES STANDARD SPECIFICATION (BSSS) AND RELEVANT AUSTRALIAN STANDARDS. NEW WORKS MUST ALSO COMPLY WITH THE REQUIREMENTS OF THE BUILDING CODES OF AUSTRALIA.

COPYRIGHT
THIS DRAWING AND DESIGN ARE SUBJECT TO COPYRIGHT AND SHALL NOT BE COPIED IN ANY FORM WITHOUT THE WRITTEN PERMISSION OF THE SYDNEY OPERA HOUSE TRUST

VERTICAL TRANSPORT CONSULTANT LDY / Brendan Byrne	COST PLANNING CONSULTANT Altus Group / Jason Finn	MECHANICAL ENGINEER Aecom / Kheng Ip	BCA/PCA CONSULTANT Group DLA / Shane Berry
FIRE ENGINEERING Warren Smith Partners / David Bolt	AV CONSULTANT Arup / Tom Brickhill	FIRE CONSULTANT Arup / Alistair Morrison	ESD CONSULTANT Cundall / Iris Chan
KITCHEN CONSULTANT Mack Group / Nisha Dhanhwal	LIGHTING ARCHITECT Steensen Varming / Ashleigh Bretherton	ELECTRICAL ENGINEER Steensen Varming / Ivan Mra	FACADE CONSULTANT Prism / Toby Fuller & Heather Webster
ACOUSTIC ENGINEER Arup / Christopher Sims	HERITAGE CONSULTANT Design 5 / Alan Croker	STRUCTURAL ENGINEER AECOM / Jonathan Onslow	
HYDRAULIC ENGINEER Warren Smith Partners / Campbell Hazelton	SECURITY CONSULTANT Arup / Shane Norton	ACCESSIBILITY CONSULTANT I-Access / Richard Seidman	

NOTES:
Do not scale off drawings. Use figured dimensions only. Report any discrepencies to the architect. These designs, plans, specifications and the copyright therein are the property of Tonkin Zulaikha Greer Architects Pty Ltd, and must not be reproduced or copied wholly or in part without written permission of Tonkin Zulaikha Greer Architects Pty Ltd.

ARCHITECT
TONKIN ZULAIKHA GREER ARCHITECTS
117 Reservoir Street
ABN: 46002722349
P: (02) 9215 4900
F: (02) 9215 4901
EMAIL info@tzg.com.au
WEB www.tzg.com.au

Location

Status	FOR TENDER	Project	BUILDING RENEWAL PROGRAM ENTRY FOYER ESCALATORS
Contract	SOH-513	Title	ESCALATOR PLANS AND N-S SECTION
Dwn TS, RM	Date 17/8/18		
Ckd TG, RM	Scale 1:50 @ A1		

Sydney Opera House Trust
GPO Box 4274 Sydney NSW Australia 2001
Phone: +61 2 9250 7541
email: info@sydneyoperahouse.com

©Sydney Opera House Trust

Location	Drawing No:	Sheet:	Rev	Size:
BX VA	49 BR TZG09	A450	4	A1